



**A Honeywell Company**

UOPR SF-009

**PROJECT SPECIFICATION**

Job # J-488

PAGE 1 OF 4

Equipment #: SK2

P.O. #4500842732

**FABRICATORS PIPING & STRUCTURE INSPECTION  
PLAN**

**HONEYWELL UOP RUSSELL PROCESS PLANTS  
FOR CRYO, REFRIGERATION, AMINE,**

REV/DATE BY CHK APV REV/DATE BY CHK APV  
03/8/2016 JB

| REVISION | DESCRIPTION          |
|----------|----------------------|
| 0        | Fabricators Skid ITP |



**A Honeywell Company**

UOPR SF-009

**PROJECT SPECIFICATION**

Job # J-488

PAGE 2 OF 4

Equipment #: SK2

P.O. #4500842732

As a minimum, Fabricator shall review and inspect the Control Activities indicated below.

**FABRICATORS PIPING & STRUCTURE INSPECTION  
PLAN  
HONEYWELL UOP RUSSELL PROCESS PLANTS  
FOR CRYO, REFRIGERATION, AMINE,**

Fabricator shall provide inspectors (UOPR and Client) with Two (2) working days advance notice for inspection points (A1 and A2).

Fabricator shall provide UOPR QC with Two (2) working days written notification for hold points (H). E-mail is the preferred method of written notification.

**Inspection Code:**

- A1 – 100% Actual Inspection
- A2 – Random Inspection

- R1 – 100% Review of Documentation
- R2 – Random Review of Documentation

- H – Hold Point – do not proceed until inspection by party requesting the hold is complete.
- W—Witness Point -- do not proceed until inspection by party requesting the witness point is Complete or (waived.)

- AP – Approval Required
- NA – Not Applicable

| Control Activity  | Governing Code or Specification                            | Required Inspections Initials and Date |      |        |                              |
|---|--|--|------|--------|------------------------------|
|   |  | Fabricator/<br>vendor                  | UOPR | Client | A.I/3 <sup>rd</sup><br>party |
| <b>Fabrication Inspection and Testing plan</b>                  |  |  |      |        |                              |
| Review fabrication isometric drawings and PO Clarification SOP. | UOPR SOP-001<br>P&IDs<br>ENG-14cf<br>ENG-14ca<br>ENG-14cas | R1                                     | R1   |        |                              |

REV/DATE BY CHK APV REV/DATE BY CHK APV  
03/8/2016 JB



**A Honeywell Company**

UOPR SF-009

**PROJECT SPECIFICATION**

Job # J-488

PAGE 3 OF 4

Equipment #: SK2

P.O. #4500842732

**FABRICATORS PIPING & STRUCTURE INSPECTION  
PLAN  
HONEYWELL UOP RUSSELL PROCESS PLANTS  
FOR CRYO, REFRIGERATION, AMINE,**

| Control Activity   | Governing Code or Specification  | Required Inspections Initials and Date |             |                           |                              |
|--|--|--|-------------|---------------------------|------------------------------|
|  |  | Fabricator/<br>vendor                  | UOPR        | Client                    | A.I/3 <sup>rd</sup><br>party |
| Review WPS's and PQR's   | ENG-14cam<br>ENG-13ap<br><br>UOPR Quality Control Manual<br>ASME D1.1<br>Weld Maps<br><br>ASME Sec. IX |  | R1          |                           |                              |
| 100%VT/Dimensional check of skid top (Done on Ground).   | AWS D1.1<br>ENG-14de   | A1                                     | H           |                           | H                            |
| Visually examine weld quality and dimensional check of ALL structural components.  | AWS D1.1   | A1                                     | A1,H,<br>A2 |                           | A1,H<br>A2                   |
| Verify trial fit of upper and lower stacked skid structures, ladders, platforms, stairs, handrails and any additional bolt on attachments. |  | H, A1                                  | H, A1       |                           | H,A1                         |
| Visually examine piping weld quality.  | ENG-13aae<br>ASME B-31.3   | A1                                     | A1,AP       |                           | A1,AP<br><i>ms 10/16/18</i>  |
| Conduct dimensional piping and fitting orientation check.  | Structural Steel Plan, Elevation and Isometric drawings  | H, A1                                  | H, A1       |                           | H,A1<br><i>ms 10/16/18</i>   |
| Review radiographs and NDE test reports  | ASME B-31.3  | R1                                     | R1          | <i>Reader sheets only</i> | R1<br><i>ms 10/16/18</i>     |

REVDATE BY CHK APV REVDATE BY CHK APV  
03/8/2016 JB



**A Honeywell Company**

UOPR SF-009

**PROJECT SPECIFICATION**

Job # J-488

PAGE 4 OF 4

Equipment #: SK2

P.O. #4500842732

**FABRICATORS PIPING & STRUCTURE INSPECTION  
PLAN**

**HONEYWELL UOP RUSSELL PROCESS PLANTS  
FOR CRYO, REFRIGERATION, AMINE,**

| Control Activity   | Governing Code or Specification                   | Required Inspections Initials and Date |        |        |                         |
|--|---|--|--------|--------|-------------------------|
|  |   | Fabricator/<br>vendor                  | UOPR   | Client | A.I/3rd party           |
| Witness pressure testing of piping. Verify pressure test results. <b>Chart Required.</b> | Line List<br>ENG-13aae<br>ASME B-31.3<br>HUR-1000 |  | A1, R1 |        | A1,R1                   |
| Review skid documentation / data book.   | ENG-13aae   | R1                                     | R1, AP |        | R1,AP<br>MS<br>10/16/18 |

REVDATE BY CHK APV REVDTE BY CHK APV  
03/8/2016 JB

J-488 SK2

SPOOLS

NDE REPORTS



CUSTOMER DATA

NAME: CISPER WELDING INC.  
 ADDRESS: INOLA, OK.  
 PHONE: \_\_\_\_\_ ATTN: \_\_\_\_\_  
 W.O.#: J488 18-066 *SK 2* P.O.#: Z-3197305  
 JOB LOCATION: API  
 DESCRIPTION: SPOOL PIPE MATERIAL TYPE: CS

TECHNIQUE/INSPECTION REPORT  
 DATE: 10-1-18 DAY: MONDAY

DEFECT CODE

|                         |                             |                           |  |
|-------------------------|-----------------------------|---------------------------|--|
| AB - ARC BURN           | HB - HOLLOW BEAD            | SLI - SLAG INCLUSION      | SOD - SOURCE TO OBJECT DISTANCE              |
| AI - ALIGNED INDICATION | IF - INADEQUATE FUSION      | SLL - SLAG LINE           | OFD - SOURCE SIDE OF OBJECT TO FILM DISTANCE |
| BT - BURN THROUGH       | IP - INCOMPLETE PENETRATION | SURF - SURFACE INDICATION | OD - OUTER DIAMETER                          |
| CON - CONCAVITY         | MA - MISALIGNMENT           | UCE - UNDERCUT EXTERNAL   | WT - WELD THICKNESS                          |
| CRACK - CRACK           | POR - POROSITY              | UCI - UNDERCUT INTERNAL   | WR - WELD REINFORCEMENT                      |
|                         |                             |                           | REP - REPAIR                                 |
|                         |                             |                           | RES - RESHOOT                                |
|                         |                             |                           | RET - RETAKE                                 |

| WELD/FILM NUMBER | Sta NO / Stencil | OD    | BM | WR    | WT    | WITHIN STD'S |    | # FILM | FILM SIZE/MFG/TYPE | SOD         | OFD    | IQI S.F. | #EXP | DEFECT LOCATION |  |
|------------------|------------------|-------|----|-------|-------|--------------|----|--------|--------------------|-------------|--------|----------|------|-----------------|--|
|                  |                  |       |    |       |       | YES          | NO |        |                    |             |        |          |      |                 |  |
| 1                | SK2-035          | W-181 | 6" | .280" | .125" | .405"        | X  |        | 3                  | 3.5X10 F-80 | 6.595" | .405"    | BF   | 3               |  |
| 2                | SK2-035          | W-182 | 6" | .280" | .125" | .405"        | X  |        | 3                  | 3.5X10 F-80 | 6.595" | .405"    | BF   | 3               |  |
| 3                | SK2-035          | W-183 | 6" | .280" | .125" | .405"        | X  |        | 3                  | 3.5X10 F-80 | 6.595" | .405"    | BF   | 3               |  |
| 4                | SK2-035          | W-184 | 6" | .280" | .125" | .405"        | X  |        | 3                  | 3.5X10 F-80 | 6.595" | .405"    | BF   | 3               |  |
| 5                | SK2-035          | W-185 | 6" | .280" | .125" | .405"        | X  |        | 3                  | 3.5X10 F-80 | 6.595" | .405"    | BF   | 3               |  |
| 6                | SK2-035          | W-186 | 6" | .280" | .125" | .405"        | X  |        | 3                  | 3.5X10 F-80 | 6.595" | .405"    | BF   | 3               |  |
| 7                | SK2-129          | W-9   | 8" | .322" | .125" | .447"        | X  |        | 3                  | 3.5X17 F-80 | 8.553" | .447"    | BF   | 3               |  |
| 8                | SK2-129          | W-10  | 8" | .322" | .125" | .447"        | X  |        | 3                  | 3.5X17 F-80 | 8.553" | .447"    | BF   | 3               |  |
| 9                | SK2-129          | W-11  | 8" | .322" | .125" | .447"        | X  |        | 3                  | 3.5X17 F-80 | 8.553" | .447"    | BF   | 3               |  |
| 10               | SK2-129          | W-12  | 8" | .322" | .125" | .447"        | X  |        | 3                  | 3.5X17 F-80 | 8.553" | .447"    | BF   | 3               |  |
| 11               | SK2-101          | W-8   | 8" | .322" | .125" | .447"        | X  |        | 3                  | 3.5X17 F-80 | 8.553" | .447"    | BF   | 3               |  |
| 12               | SK2-101          | W-9   | 8" | .322" | .125" | .447"        | X  |        | 3                  | 3.5X17 F-80 | 8.553" | .447"    | BF   | 3               |  |
| 13               | SK2-101          | W-10  | 8" | .322" | .125" | .447"        | X  |        | 3                  | 3.5X17 F-80 | 8.553" | .447"    | BF   | 3               |  |
| 14               | SK2-101          | W-11  | 8" | .322" | .125" | .447"        | X  |        | 3                  | 3.5X17 F-80 | 8.553" | .447"    | BF   | 3               |  |
| 15               | SK2-101          | W-12  | 8" | .322" | .125" | .447"        | X  |        | 3                  | 3.5X17 F-80 | 8.553" | .447"    | BF   | 3               |  |
| 16               | SK2-133          | W-1   | 6" | .432" | .125" | .557"        | X  |        | 3                  | 3.5X10 F-80 | 6.443" | .557"    | BF   | 3               |  |
| 17               | SK2-133          | W-2   | 6" | .432" | .125" | .557"        | X  |        | 3                  | 3.5X10 F-80 | 6.443" | .557"    | BF   | 3               |  |
| 18               | SK2-133          | W-3   | 6" | .432" | .125" | .557"        | X  |        | 3                  | 3.5X10 F-80 | 6.443" | .557"    | BF   | 3               |  |
| 19               | SK2-133          | W-4   | 6" | .432" | .125" | .557"        | X  |        | 3                  | 3.5X10 F-80 | 6.443" | .557"    | BF   | 3               |  |
| 20               | SK2-133          | W-5   | 6" | .432" | .125" | .557"        | X  |        | 3                  | 3.5X10 F-80 | 6.443" | .557"    | BF   | 3               |  |
| 21               | SK-010           | W-65  | 6" | .432" | .125" | .557"        | X  |        | 3                  | 3.5X10 F-80 | 6.443" | .557"    | BF   | 3               |  |
| 22               | SK-010           | W-66  | 6" | .432" | .125" | .557"        | X  |        | 3                  | 3.5X10 F-80 | 6.443" | .557"    | BF   | 3               |  |
| 23               | SK-010           | W-67  | 6" | .432" | .125" | .557"        | X  |        | 3                  | 3.5X10 F-80 | 6.443" | .557"    | BF   | 3               |  |
| 24               | SK-010           | W-68  | 6" | .432" | .125" | .557"        | X  |        | 3                  | 3.5X10 F-80 | 6.443" | .557"    | BF   | 3               |  |
| 25               | SK-010           | W-69  | 6" | .432" | .125" | .557"        | X  |        | 3                  | 3.5X10 F-80 | 6.443" | .557"    | BF   | 3               |  |
| 26               |                  |       |    |       |       |              |    |        |                    |             |        |          |      |                 |  |
| 27               |                  |       |    |       |       |              |    |        |                    |             |        |          |      |                 |  |
| 28               |                  |       |    |       |       |              |    |        |                    |             |        |          |      |                 |  |
| 29               |                  |       |    |       |       |              |    |        |                    |             |        |          |      |                 |  |
| 30               |                  |       |    |       |       |              |    |        |                    |             |        |          |      |                 |  |

|                        |             |                   |      |             |                |                  |     |             |      |              |          |             |         |         |
|------------------------|-------------|-------------------|------|-------------|----------------|------------------|-----|-------------|------|--------------|----------|-------------|---------|---------|
| METHOD                 | RT          | SOURCE SIZE DIAG. | .124 | ISOTOPE     | IR 192         | NO. CURIES       | 114 | DEV. TIME   | AUTO | DEV. TEMP    | AUTO     | DENSITY     | 2.0-4.0 |         |
| NO. OF WELDS           | 25          | FT. LONG SEAMS    |      | STANDARDS   | B31.3 N        | PER DIEM         | Y N | NO. OF FILM | 75   | EXPOSURE:    | DBL WALL | S. WALL X   | MR/R    | SCREEN  |
|                        |             |                   |      |             |                |                  |     |             |      | VIEWING:     | DBL WALL | S. WALL X   | 2.8     | PB      |
| TRUCK NO.              | T-159       | REPORT NUMBER     | 1    | PAGE NUMBER | 1              | TECH HOURS       | 8   | ASST. HOURS | 8    | TRAVEL HOURS |          | TOTAL HOURS |         | MILEAGE |
| FILM INTERPRETER       | DREW DUCLOS |                   |      |             | ASSISTANT NAME | NATHANIEL DUCLOS |     |             |      | ASNT LEVEL   | I        |             |         |         |
| COMPANY REPRESENTATIVE |             |                   |      |             | NDT TECHNICIAN | DREW DUCLOS      |     |             |      | ASNT LEVEL   | II       |             |         |         |



TECHNIQUE/INSPECTION REPORT

DATE **10-2-18** DAY **TUESDAY**

CUSTOMER DATA

NAME **CISPER WELDING**  
 ADDRESS \_\_\_\_\_  
 PHONE \_\_\_\_\_ ATTN. \_\_\_\_\_  
 W O # **J-488 SK2** P O # **18-066**  
 JOB LOCATION: **INOLA,OK.**  
 DESCRIPTION: **SPOOL PIPE** MATERIAL TYPE: **CS**

DEFECT CODE

|                         |                             |                           |  |
|-------------------------|-----------------------------|---------------------------|--|
| AB - ARC BURN           | HB - HOLLOW BEAD            | SLI - SLAG INCLUSION      | SOD - SOURCE TO OBJECT DISTANCE              |
| AI - ALIGNED INDICATION | IF - INADEQUATE FUSION      | SLL - SLAG LINE           | OFD - SOURCE SIDE OF OBJECT TO FILM DISTANCE |
| BT - BURN THROUGH       | IP - INCOMPLETE PENETRATION | SURF - SURFACE INDICATION | OD - OUTER DIAMETER                          |
| CON - CONCAVITY         | MA - MISALIGNMENT           | UCE - UNDERCUT EXTERNAL   | WT - WELD THICKNESS                          |
| CRACK - CRACK           | POR - POROSITY              | UCI - UNDERCUT INTERNAL   | WR - WELD REINFORCEMENT                      |
|                         |                             |                           | REP - REPAIR                                 |
|                         |                             |                           | RES - RESHOOT                                |
|                         |                             |                           | RET - RETAKE                                 |
|                         |                             |                           | BM - BASE MATERIAL                           |

| WELD/FILM NUMBER | Sta. NO / Stencil | OD  | BM    | WR    | WT    | WITHIN STD'S |    | # FILM | FILM SIZE/MFG/TYPE | SOD   | OFD   | IQI S-F | #EXP | DEFECT LOCATION |
|------------------|-------------------|-----|-------|-------|-------|--------------|----|--------|--------------------|-------|-------|---------|------|-----------------|
|                  |                   |     |       |       |       | YES          | NO |        |                    |       |       |         |      |                 |
| 1 112 W-1        | 100%              | 12" | .375" | .125" | .500" | X            |    | 3      | 3.5X17 F-80        | 12.5" | .500" | BF      | 3    |                 |
| 2 108 W-1        | 100%              | 12" | .375" | .125" | .500" | X            |    | 3      | 3.5X17 F-80        | 12.5" | .500" | BF      | 3    |                 |
| 3 112 W-7        | 100%              | 12" | .375" | .125" | .500" |              | X  | 3      | 3.5X17 F-80        | 12.5" | .500" | BF      | 3    | 100% SLAG       |
| 4 112 W-5A       | 100%              | 12" | .375" | .125" | .500" | X            |    | 3      | 3.5X17 F-80        | 12.5" | .500" | BF      | 3    |                 |
| 5 108 W-6        | 100%              | 12" | .375" | .125" | .500" | X            |    | 3      | 3.5X17 F-80        | 12.5" | .500" | BF      | 3    |                 |
| 6                |                   |     |       |       |       |              |    |        |                    |       |       |         |      |                 |
| 7                |                   |     |       |       |       |              |    |        |                    |       |       |         |      |                 |
|                        |             |                   |      |             |                |            |     |             |                  |              |                    |             |            |    |
|------------------------|-------------|-------------------|------|-------------|----------------|------------|-----|-------------|------------------|--------------|--------------------|-------------|------------|----|
| METHOD                 | RT          | SOURCE SIZE DIAG. | .124 | ISOTOPE     | IR 192         | NO. CURIES | 113 | DEV. TIME   | AUTO             | DEV. TEMP    | AUTO               | DENSITY     | 2.0-4.0    |    |
| NO. OF WELDS           | 5           | FT. LONG SEAMS    |      | STANDARDS   | B31.3 N        | PER DIEM   | Y N | NO. OF FILM | 15               | EXPOSURE:    | DBL WALL X S WALL  | MR/R        | SCREEN     |    |
|                        |             |                   |      |             |                |            |     |             |                  | VIEWING:     | DBL WALL S. WALL X | 2.8         | PB         |    |
| TRUCK NO.              | T-159       | REPORT NUMBER     | 1    | PAGE NUMBER | 1              | TECH HOURS |     | ASST HOURS  |                  | TRAVEL HOURS |                    | TOTAL HOURS | MILEAGE    |    |
| FILM INTERPRETER       | DREW DUCLOS |                   |      |             | ASSISTANT NAME |            |     |             | NATHANIEL DUCLOS |              |                    |             | ASNT LEVEL | I  |
| COMPANY REPRESENTATIVE |             |                   |      |             | NDT TECHNICIAN |            |     |             | DREW DUCLOS      |              |                    |             | ASNT LEVEL | II |



CUSTOMER DATA

NAME: CISPER WELDING INC.  
 ADDRESS: INOLA, OK.  
 PHONE: \_\_\_\_\_ ATTN: \_\_\_\_\_  
 W.O.#: J488 18-066 SK2 P.O.#: \_\_\_\_\_  
 JOB LOCATION: INOLA  
 DESCRIPTION: SPOOL PIPE MATERIAL TYPE: CS

TECHNIQUE/INSPECTION REPORT

DATE 10-5-18 DAY FRIDAY

DEFECT CODE

AB - ARC BURN HB - HOLLOW BEAD SLI - SLAG INCLUSION SOD - SOURCE TO OBJECT DISTANCE  
 AI - ALIGNED INDICATION IF - INADEQUATE FUSION SLL - SLAG LINE OFD - SOURCE SIDE OF OBJECT TO FILM DISTANCE  
 BT - BURN THROUGH IP - INCOMPLETE PENETRATION SURF - SURFACE INDICATION OD - OUTER DIAMETER REP - REPAIR  
 CON - CONCAVITY MA - MISALIGNMENT UCE - UNDERCUT EXTERNAL WT - WELD THICKNESS RES - RESHOOT RET - RETAKE  
 CRACK - CRACK POR - POROSITY UCI - UNDERCUT INTERNAL WR - WELD REINFORCEMENT BM - BASE MATERIAL

| WELD/FILM NUMBER | Sta. NO / Stencil | OD   | BM  | WR    | WT    | WITHIN STD'S |    | # FILM | FILM SIZE/MFG/TYPE | SOD         | OFD     | IQI S-F | #EXP | DEFECT LOCATION |  |
|------------------|-------------------|------|-----|-------|-------|--------------|----|--------|--------------------|-------------|---------|---------|------|-----------------|--|
|                  |                   |      |     |       |       | YES          | NO |        |                    |             |         |         |      |                 |  |
| 1                | 114 W-1           | 100% | 12" | .375" | .125" | .500"        | X  |        | 3                  | 3.5X17 F-80 | 12.625" | 500"    | BF   | 3               |  |
| 2                | 114- W-2          | 100% | 12" | .375" | .125" | .500"        | X  |        | 3                  | 3.5X17 F-80 | 12.625" | 500"    | BF   | 3               |  |
| 3                | 114 W-3           | 100% | 10" | .365" | .125" | .490"        | X  |        | 3                  | 3.5X17 F-80 | 10.635" | .490"   | BF   | 3               |  |
| 4                | 114 W-4           | 100% | 10" | .365" | .125" | .490"        | X  |        | 3                  | 3.5X17 F-80 | 10.635" | .490"   | BF   | 3               |  |
| 5                | 114 W-5           | 100% | 10" | .365" | .125" | .490"        | X  |        | 3                  | 3.5X17 F-80 | 10.635" | .490"   | BF   | 3               |  |
| 6                | 114 W-6           | 100% | 10" | .365" | .125" | .490"        | X  |        | 3                  | 3.5X17 F-80 | 10.635" | .490"   | BF   | 3               |  |
| 7                | 009 W-56          | 100% | 6"  | .432" | .125" | .557"        | X  |        | 3                  | 3.5X10 F-80 | 6.443"  | .557"   | BF   | 3               |  |
| 8                | 009 W-57          | 100% | 6"  | .432" | .125" | .557"        | X  |        | 3                  | 3.5X10 F-80 | 6.443"  | .557"   | BF   | 3               |  |
| 9                | 009 W-58          | 100% | 6"  | .432" | .125" | .557"        | X  |        | 3                  | 3.5X10 F-80 | 6.443"  | .557"   | BF   | 3               |  |
| 10               | 009 W-59          | 100% | 6"  | .432" | .125" | .557"        | X  |        | 3                  | 3.5X10 F-80 | 6.443"  | .557"   | BF   | 3               |  |
| 11               | 009 W-60          | 100% | 6"  | .432" | .125" | .557"        | X  |        | 3                  | 3.5X10 F-80 | 6.443"  | .557"   | BF   | 3               |  |
| 12               | 002 W-14          | 100% | 8"  | .500" | .125" | .625"        | X  |        | 3                  | 3.5X17 F-80 | 8.5"    | .625"   | BF   | 3               |  |
| 13               | 002W-15           | 100% | 8"  | .500" | .125" | .625"        | X  |        | 3                  | 3.5X17 F-80 | 8.5"    | .625"   | BF   | 3               |  |
| 14               | 002 W-16          | 100% | 8"  | .500" | .125" | .625"        | X  |        | 3                  | 3.5X17 F-80 | 8.5"    | .625"   | BF   | 3               |  |
| 15               | 116 W-5           | 100% | 8"  | .500" | .125" | .625"        | X  |        | 3                  | 3.5X17 F-80 | 8.5"    | .625"   | BF   | 3               |  |
| 16               | 116 W-7           | 100% | 8"  | .500" | .125" | .625"        | X  |        | 3                  | 3.5X17 F-80 | 8.5"    | .625"   | BF   | 3               |  |
| 17               | 116 W-13          | 100% | 8"  | .500" | .125" | .625"        | X  |        | 3                  | 3.5X17 F-80 | 8.5"    | .625"   | BF   | 3               |  |
| 18               | 116 W-14          | 100% | 8"  | .500" | .125" | .625"        | X  |        | 3                  | 3.5X17 F-80 | 8.5"    | .625"   | BF   | 3               |  |
| 19               | 037 W-207         | 100% | 6"  | .280" | .125" | .405"        | X  |        | 3                  | 3.5X10 F-80 | 6.595"  | .405"   | BF   | 3               |  |
| 20               | 037 W-208         | 100% | 6"  | .280" | .125" | .405"        | X  |        | 3                  | 3.5X10 F-80 | 6.595"  | .405"   | BF   | 3               |  |
| 21               | 037 W-209         | 100% | 6"  | .280" | .125" | .405"        | X  |        | 3                  | 3.5X10 F-80 | 6.595"  | .405"   | BF   | 3               |  |
| 22               | 037 W-210         | 100% | 6"  | .280" | .125" | .405"        | X  |        | 3                  | 3.5X10 F-80 | 6.595"  | .405"   | BF   | 3               |  |
| 23               | 037 W-211         | 100% | 6"  | .280" | .125" | .405"        | X  |        | 3                  | 3.5X10 F-80 | 6.595"  | .405"   | BF   | 3               |  |
| 24               | 037 W-212         | 100% | 6"  | .280" | .125" | .405"        | X  |        | 3                  | 3.5X10 F-80 | 6.595"  | .405"   | BF   | 3               |  |
| 25               | 032 W-147         | 100% | 6"  | .280" | .125" | .405"        | X  |        | 3                  | 3.5X10 F-80 | 6.595"  | .405"   | BF   | 3               |  |
| 26               | 032 W-148         | 100% | 6"  | .280" | .125" | .405"        | X  |        | 3                  | 3.5X10 F-80 | 6.595"  | .405"   | BF   | 3               |  |
| 27               | 032 W-149         | 100% | 6"  | .280" | .125" | .405"        | X  |        | 3                  | 3.5X10 F-80 | 6.595"  | .405"   | BF   | 3               |  |
| 28               | 032 W-150         | 100% | 6"  | .280" | .125" | .405"        | X  |        | 3                  | 3.5X10 F-80 | 6.595"  | .405"   | BF   | 3               |  |
| 29               | 032 W-151         | 100% | 6"  | .280" | .125" | .405"        | X  |        | 3                  | 3.5X10 F-80 | 6.595"  | .405"   | BF   | 3               |  |
| 30               | 032W-152          | 100% | 6"  | .280" | .125" | .405"        | X  |        | 3                  | 3.5X10 F-80 | 6.595"  | .405"   | BF   | 3               |  |

|                        |       |------------------------|-------|-------------------|------|-------------|---------|-------------|-----|-------------|------|--------------|--------------------|----------------|---------|------------------|--|------------|--|-------------|--|------------|--|----|--|
| METHOD                 | RT    | SOURCE SIZE DIAG. | .124 | ISOTOPE     | IR 192  | NO. CURIES  | 97  | DEV. TIME   | AUTO | DEV. TEMP    | AUTO               | DENSITY        | 2.0-4.0 |                  |  |            |  |             |  |            |  |    |  |
| NO. OF WELDS           | 30    | FT. LONG SEAMS    |      | STANDARDS   | B31.3 N | PER DIEM    | Y N | NO. OF FILM | 90   | EXPOSURE:    | DBL WALL X S. WALL | MR/R           | SCREEN  |                  |  |            |  |             |  |            |  |    |  |
| TRUCK NO.              | T-159 | REPORT NUMBER     | 1    | PAGE NUMBER | 2       | TECH HOURS  | 8   | ASST. HOURS | 8    | VIEWING:     | DBL WALL S. WALL X | 2.8            | PB      |                  |  |            |  |             |  |            |  |    |  |
| TRUCK NO. T-159        |       | REPORT NUMBER     | 1    | PAGE NUMBER | 2       | TECH HOURS  | 8   | ASST. HOURS | 8    | TRAVEL HOURS |                    | TOTAL HOURS    |         | MILEAGE          |  |            |  |             |  |            |  |    |  |
| FILM INTERPRETER       |       |                   |      |             |         | DREW DUCLOS |     |             |      |              |                    | ASSISTANT NAME |         | NATHANIEL DUCLOS |  | ASNT LEVEL |  | I           |  |            |  |    |  |
| COMPANY REPRESENTATIVE |       |                   |      |             |         |             |     |             |      |              |                    | NDT TECHNICIAN |         |                  |  |            |  | DREW DUCLOS |  | ASNT LEVEL |  | II |  |



TECHNIQUE/INSPECTION REPORT

DATE **10-5-18** DAY **FRIDAY**

| CUSTOMER DATA |  |
|---------------|--|
| NAME          | <b>CISPER WELDING INC.</b>                 |
| ADDRESS       | <b>INOLA, OK.</b>                          |
| PHONE         | ATTN: _____                                |
| W.O.#         | <b>J488 18-066 SK2</b> P.O.# _____         |
| JOB LOCATION: | <b>INOLA</b>                               |
| DESCRIPTION:  | <b>SPOOL PIPE</b> MATERIAL TYPE: <b>CS</b> |

DEFECT CODE

|                         |                             |                           |  |
|-------------------------|-----------------------------|---------------------------|--|
| AB - ARC BURN           | HB - HOLLOW BEAD            | SLI - SLAG INCLUSION      | SOD - SOURCE TO OBJECT DISTANCE              |
| AI - ALIGNED INDICATION | IF - INADEQUATE FUSION      | SLL - SLAG LINE           | OFD - SOURCE SIDE OF OBJECT TO FILM DISTANCE |
| BT - BURN THROUGH       | IP - INCOMPLETE PENETRATION | SURF - SURFACE INDICATION | OD - OUTER DIAMETER                          |
| CON - CONCAVITY         | MA - MISALIGNMENT           | UCE - UNDERCUT EXTERNAL   | WT - WELD THICKNESS                          |
| CRACK - CRACK           | POR - POROSITY              | UCI - UNDERCUT INTERNAL   | WR - WELD REINFORCEMENT                      |
|                         |                             |                           | REP - REPAIR                                 |
|                         |                             |                           | RES - RESHOOT                                |
|                         |                             |                           | RET - RETAKE                                 |
|                         |                             |                           | BM - BASE MATERIAL                           |

| WELD/FILM NUMBER | Sta. NO / Stencil | OD   | BM | WR    | WT    | WITHIN STD'S |    | # FILM | FILM SIZE/MFG/TYPE | SOD         | OFD    | IQI S-F | #EXP | DEFECT LOCATION |  |
|------------------|-------------------|------|----|-------|-------|--------------|----|--------|--------------------|-------------|--------|---------|------|-----------------|--|
|                  |                   |      |    |       |       | YES          | NO |        |                    |             |        |         |      |                 |  |
| 1                | 036 W-187         | 100% | 6" | .280" | .125" | .405"        | X  |        | 3                  | 3.5X10 F-80 | 6.595" | .405"   | BF   | 3               |  |
| 2                |                   |      |    |       |       |              |    |        |                    |             |        |         |      |                 |  |
| 3                | 036 W-189         | 100% | 6" | .280" | .125" | .405"        | X  |        | 3                  | 3.5X10 F-80 | 6.595" | .405"   | BF   | 3               |  |
| 4                | 036 W-190         | 100% | 6" | .280" | .125" | .405"        | X  |        | 3                  | 3.5X10 F-80 | 6.595" | .405"   | BF   | 3               |  |
| 5                | 036 W-191         | 100% | 6" | .280" | .125" | .405"        | X  |        | 3                  | 3.5X10 F-80 | 6.595" | .405"   | BF   | 3               |  |
| 6                | 036 W-192         | 100% | 6" | .280" | .125" | .405"        | X  |        | 3                  | 3.5X10 F-80 | 6.595" | .405"   | BF   | 3               |  |
| 7                | 010 W-78          | 100% | 6" | .432" | .125" | .557"        | X  |        | 3                  | 3.5X10 F-80 | 6.443" | .557"   | BF   | 3               |  |
| 8                | 010 W-79          | 100% | 6" | .432" | .125" | .557"        | X  |        | 3                  | 3.5X10 F-80 | 6.443" | .557"   | BF   | 3               |  |
| 9                | 010 W-80          | 100% | 6" | .432" | .125" | .557"        | X  |        | 3                  | 3.5X10 F-80 | 6.443" | .557"   | BF   | 3               |  |
| 10               | 034 W169          | 100% | 6" | .280" | .125" | .405"        | X  |        | 3                  | 3.5X10 F-80 | 6.595" | .405"   | BF   | 3               |  |
| 11               | 034 W-170         | 100% | 6" | .280" | .125" | .405"        | X  |        | 3                  | 3.5X10 F-80 | 6.595" | .405"   | BF   | 3               |  |
| 12               | 034 W-171         | 100% | 6" | .280" | .125" | .405"        | X  |        | 3                  | 3.5X10 F-80 | 6.595" | .405"   | BF   | 3               |  |
| 13               | 034 W-172         | 100% | 6" | .280" | .125" | .405"        | X  |        | 3                  | 3.5X10 F-80 | 6.595" | .405"   | BF   | 3               |  |
| 14               | 034 W-173         | 100% | 6" | .280" | .125" | .405"        | X  |        | 3                  | 3.5X10 F-80 | 6.595" | .405"   | BF   | 3               |  |
| 15               | 034 W-174         | 100% | 6" | .280" | .125" | .405"        | X  |        | 3                  | 3.5X10 F-80 | 6.595" | .405"   | BF   | 3               |  |
| 16               | 034 W-175         | 100% | 6" | .280" | .125" | .405"        | X  |        | 3                  | 3.5X10 F-80 | 6.595" | .405"   | BF   | 3               |  |
| 17               | 034 W-176         | 100% | 6" | .280" | .125" | .405"        | X  |        | 3                  | 3.5X10 F-80 | 6.595" | .405"   | BF   | 3               |  |
| 18               |                   |      |    |       |       |              |    |        |                    |             |        |         |      |                 |  |
| 19               |                   |      |    |       |       |              |    |        |                    |             |        |         |      |                 |  |
|                        |             |                   |      |                |         |                  |     |             |            |              |                    |             |         |
|------------------------|-------------|-------------------|------|----------------|---------|------------------|-----|-------------|------------|--------------|--------------------|-------------|---------|
| METHOD                 | RT          | SOURCE SIZE DIAG. | .124 | ISOTOPE        | IR 192  | NO. CURIES       | 97  | DEV. TIME   | AUTO       | DEV. TEMP    | AUTO               | DENSITY     | 2.0-4.0 |
| NO. OF WELDS           | 16          | FT. LONG SEAMS    |      | STANDARDS      | B31.3 N | PER DIEM         | Y N | NO. OF FILM | 48         | EXPOSURE:    | DBL WALL X S. WALL | MR/R        | SCREEN  |
|                        |             |                   |      |                |         |                  |     |             |            | VIEWING:     | DBL WALL S. WALL X | 2.8         | PB      |
| TRUCK NO.              | T-159       | REPORT NUMBER     | 2    | PAGE NUMBER    | 2       | TECH HOURS       | 8   | ASST. HOURS | 8          | TRAVEL HOURS |                    | TOTAL HOURS | MILEAGE |
| FILM INTERPRETER       | DREW DUCLOS |                   |      | ASSISTANT NAME |         | NATHANIEL DUCLOS |     |             | ASNT LEVEL |              | I                  |             |         |
| COMPANY REPRESENTATIVE |             |                   |      | NDT TECHNICIAN |         | DREW DUCLOS      |     |             | ASNT LEVEL |              | II                 |             |         |



CUSTOMER DATA

NAME: CISPER WELDING  
 ADDRESS: \_\_\_\_\_  
 PHONE: \_\_\_\_\_ ATTN: \_\_\_\_\_  
 W.O.#: J-488 SK2 P.O.#: 18-066  
 JOB LOCATION: INOLA, OK.  
 DESCRIPTION: SPOOL PIPE MATERIAL TYPE: CS

TECHNIQUE/INSPECTION REPORT

DATE 10-2-18 DAY TUESDAY

DEFECT CODE

|                         |                             |                           |  |
|-------------------------|-----------------------------|---------------------------|--|
| AB - ARC BURN           | HB - HOLLOW BEAD            | SLI - SLAG INCLUSION      | SOD - SOURCE TO OBJECT DISTANCE              |
| AI - ALIGNED INDICATION | IF - INADEQUATE FUSION      | SLL - SLAG LINE           | OFD - SOURCE SIDE OF OBJECT TO FILM DISTANCE |
| BT - BURN THROUGH       | IP - INCOMPLETE PENETRATION | SURF - SURFACE INDICATION | OD - OUTER DIAMETER                          |
| CON - CONCAVITY         | MA - MISALIGNMENT           | UCE - UNDERCUT EXTERNAL   | REP - REPAIR                                 |
| CRACK - CRACK           | POR - POROSITY              | UCI - UNDERCUT INTERNAL   | RES - RESHOOT                                |
|                         |                             |                           | RET - RETAKE                                 |
|                         |                             |                           | WR - WELD REINFORCEMENT                      |
|                         |                             |                           | BM - BASE MATERIAL                           |

| WELD/FILM NUMBER | Sta NO / Stencil | OD   | BM  | WR    | WT    | WITHIN STD'S |    | # FILM | FILM SIZE/MFG/TYPE | SOD         | OFD   | IQI S-F | #EXP | DEFECT LOCATION |           |
|------------------|------------------|------|-----|-------|-------|--------------|----|--------|--------------------|-------------|-------|---------|------|-----------------|-----------|
|                  |                  |      |     |       |       | YES          | NO |        |                    |             |       |         |      |                 |           |
| 1                | 112 W-1          | 100% | 12" | .375" | .125" | .500"        | X  |        | 3                  | 3.5X17 F-80 | 12.5" | .500"   | BF   | 3               |           |
| 2                | 108 W-1          | 100% | 12" | .375" | .125" | .500"        | X  |        | 3                  | 3.5X17 F-80 | 12.5" | .500"   | BF   | 3               |           |
| 3                | 112 W-7          | 100% | 12" | .375" | .125" | .500"        |    | X      | 3                  | 3.5X17 F-80 | 12.5" | .500"   | BF   | 3               | 100% SLAG |
| 4                | 112 W-5A         | 100% | 12" | .375" | .125" | .500"        | X  |        | 3                  | 3.5X17 F-80 | 12.5" | .500"   | BF   | 3               |           |
| 5                | 108 W-6          | 100% | 12" | .375" | .125" | .500"        | X  |        | 3                  | 3.5X17 F-80 | 12.5" | .500"   | BF   | 3               |           |
| 6                |                  |      |     |       |       |              |    |        |                    |             |       |         |      |                 |           |
| 7                |                  |      |     |       |       |              |    |        |                    |             |       |         |      |                 |           |
|                        |             |                   |      |             |         |                |                  |            |      |              |                   |             |         |
|------------------------|-------------|-------------------|------|-------------|---------|----------------|------------------|------------|------|--------------|-------------------|-------------|---------|
| METHOD                 | RT          | SOURCE SIZE DIAG. | .124 | ISOTOPE     | IR 192  | NO. CURIES     | 113              | DEV. TIME  | AUTO | DEV. TEMP    | AUTO              | DENSITY     | 2.0-4.0 |
| NO OF WELDS            | 5           | FT LONG SEAMS     |      | STANDARDS   | B31.3 N | PER DIEM       | Y N              | NO OF FILM | 15   | EXPOSURE:    | DBL WALL X S WALL | MR/R        | SCREEN  |
|                        |             |                   |      |             |         |                |                  |            |      | VIEWING:     | DBL WALL S WALL X | 2.8         | PB      |
| TRUCK NO               | T-159       | REPORT NUMBER     | 1    | PAGE NUMBER | 1       | TECH HOURS     |                  | ASST HOURS |      | TRAVEL HOURS |                   | TOTAL HOURS | MILEAGE |
| FILM INTERPRETER       | DREW DUCLOS |                   |      |             |         | ASSISTANT NAME | NATHANIEL DUCLOS |            |      |              |                   | ASNT LEVEL  | I       |
| COMPANY REPRESENTATIVE |             |                   |      |             |         | NDT TECHNICIAN | DREW DUCLOS      |            |      |              |                   | ASNT LEVEL  | II      |



CUSTOMER DATA

NAME: CISPER WELDING  
 ADDRESS: \_\_\_\_\_  
 PHONE: \_\_\_\_\_ ATTN: \_\_\_\_\_  
 W.O.#: 18-066 UOP J-488 *SK2* P.O.# \_\_\_\_\_  
 JOB LOCATION: INOLA  
 DESCRIPTION: \_\_\_\_\_ MATERIAL TYPE: CS

TECHNIQUE/INSPECTION REPORT  
 DATE 10-9-18 DAY TUESDAY

DEFECT CODES

AB - ARC BURN HB - HOLLOW BEAD SL - SLAG INCLUSION SOD - SOURCE TO OBJECT DISTANCE  
 AI - ALIGNED INDICATOR IF - INADEQUATE FUSION SLL - SLAG LINE OFD - SOURCE SIDE OF OBJECT TO FILM DISTANCE  
 BT - BURN THROUGH IP - INCOMPLETE PENETRATION SURF - SURFACE INDICATION OD - OUTER DIAMETER REP - REPAIR  
 CON - CONCAVITY MA - MISALIGNMENT UCE - UNDERCUT EXTENSION WT - WELD THICKNESS RES - RESHOOT RET - RETAKE  
 CRACK - CRACK POR - POROSITY UCI - UNDERCUT INTERNAL WR - WELD REINFORCEMENT DIVI - BASE MATERIAL

| WELD/FILM NUMBER | Sta. NO / Stencil | OD      | BM  | WR   | WT   | WITHIN STD'S |    | # FILM | FILM SIZE/MFG/TYPE | SOD        | OFD | IQL S-F | #EXP | DEFECT LOCATION |  |
|------------------|-------------------|---------|-----|------|------|--------------|----|--------|--------------------|------------|-----|---------|------|-----------------|--|
|                  |                   |         |     |      |      | YES          | NO |        |                    |            |     |         |      |                 |  |
| 1                | W7                | SK2-128 | 3"  | .120 | .100 | .220         | X  |        | 3                  | 3.5X8 F50  | 3"  | .220    | 12   | 3               |  |
| 2                | W13T1             | SK2-124 | 3"  | .216 | .100 | .316         | X  |        | 3                  | 3.5X8 F50  | 3"  | .316    | 12   | 3               |  |
| 3                | W94               | SK2-011 | 3"  | .216 | .100 | .316         | X  |        | 3                  | 3.5X8 F50  | 3"  | .316    | 12   | 3               |  |
| 4                |                   |         |     |      |      |              |    |        |                    |            |     |         |      |                 |  |
| 5                | W1                | SK2-128 | 6"  | .280 | .100 | .380         | X  |        | 3                  | 3.5X10 F50 | 6"  | .380    | B    | 3               |  |
| 6                | W9                | SK2-128 | 6"  | .280 | .100 | .380         | X  |        | 3                  | 3.5X10 F50 | 6"  | .380    | B    | 3               |  |
| 7                | W15T2             | SK2-124 | 6"  | .280 | .100 | .380         | X  |        | 3                  | 3.5X10 F50 | 6"  | .380    | B    | 3               |  |
| 8                | W14               | SK2-124 | 6"  | .280 | .100 | .380         | X  |        | 3                  | 3.5X10 F50 | 6"  | .380    | B    | 3               |  |
| 9                | W8                | SK2-128 | 6"  | .280 | .100 | .380         | X  |        | 3                  | 3.5X10 F50 | 6"  | .380    | B    | 3               |  |
| 10               | W5                | SK2-128 | 6"  | .280 | .100 | .380         | X  |        | 3                  | 3.5X10 F50 | 6"  | .380    | B    | 3               |  |
| 11               |                   |         |     |      |      |              |    |        |                    |            |     |         |      |                 |  |
| 12               | W103              | SK2-015 | 8"  | .322 | .100 | .422         | X  |        | 3                  | 3.5X17 F80 | 8"  | .422    | B    | 3               |  |
| 13               | W104              | SK2-015 | 8"  | .322 | .100 | .422         | X  |        | 3                  | 3.5X17 F80 | 8"  | .422    | B    | 3               |  |
| 14               |                   |         |     |      |      |              |    |        |                    |            |     |         |      |                 |  |
| 15               | W114              | SK2-015 | 10" | .365 | .100 | .465         | X  |        | 3                  | 3.5X17 F80 | 10" | .465    | B    | 3               |  |
| 16               |                   |         |     |      |      |              |    |        |                    |            |     |         |      |                 |  |
| 17               | W-7R              | SK2-112 | 12" | .375 | .100 | .475         | X  |        | 3                  | 3.5X17 F80 | 12" | .475    | B    | 3               |  |
| 18               |                   |         |     |      |      |              |    |        |                    |            |     |         |      |                 |  |
| 19               |                   |         |     |      |      |              |    |        |                    |            |     |         |      |                 |  |
METHOD RT SOURCE SIZE DIAG. .152 ISOTOPE IR 192 NO. CURIES 52 DEV. TIME 5 DEV. TEMP 68 DENSITY 2-4

NO. OF WELDS 13 FT. LONG SEAMS STANDARDS B31.3 PER DIEM Y N NO. OF FILM 39 EXPOSURE: DBL WALL X S. WALL MR/R SCREEN PB VIEWING: DBL WALL S. WALL X

TRUCK NO. 219 REPORT NUMBER PAGE NUMBER TECH HOURS 7 ASST HOURS 7 TRAVEL HOURS TOTAL HOURS 7 MILEAGE

FILM INTERPRETER C. STEWART ASSISTANT NAME E. SHAFFER ASNT LEVEL I  
 COMPANY REPRESENTATIVE *Johnnie Stewart* NDT TECHNICIAN C. STEWART ASNT LEVEL II

# American Piping Inspection

17110 E Pine Tulsa, OK 74116  
918.234.6300



## OPERATOR QUALIFICATION & EMPLOYEE CERTIFICATION

Employee: Colby Stewart  
Method: RT  
Certification Date: 12/5/2017  
This certification expires in 3 years  
Latest Eye Examination Date: 12/5/2017  
Eye Examination Expires: 12/5/2018  
This individual is a participant in a DOT approved Drug and Alcohol Misuse Program  
Education Record:  
Grade School: X High School: X Vocational: College: Other:

Emp ID: 2844  
API Task No: RT II  
Restrictions: None  
Vision Acuity: Pass  
Color Contrast: Pass  
Natural: Corrected: x

### Experience Record:

| <u>Company</u>             | <u>Level</u> | <u>Months</u> |
|----------------------------|--------------|---------------|
| American Piping Inspection | I            | >12           |
| American Piping Inspection | II           | <6            |

### Training Record:

| <u>Course</u> | <u>By</u>                  | <u>Hours</u> |
|---------------|----------------------------|--------------|
| RT Level I    | American Piping Inspection | 40           |
| RT Level II   | American Piping Inspection | 40           |

Recertification based on documented previous certification and American Piping Inspection Examination

| <u>Examination Scores:</u> | <u>General</u> | <u>Specific</u> | <u>Practical</u> | <u>Average</u> |
|----------------------------|----------------|-----------------|------------------|----------------|
|                            | 94%            | 92%             | 96%              | 94%            |

AOC Test: Pass

The information provided in this certification record is in accordance with the latest edition of: The American Society of Nondestructive Testing's Recommended Practice SNT-TC-1A 49 CFR Part 192, Subpart N, and 49 CFR Part 149, Subpart G. All information provided is true and correct to the best of this company's knowledge. Copies of tests and testing procedures and requirements are on file at API.

This certification was administered by:

J. Orville McBride - President/Owner

# American Piping Inspection

17110 E Pine Tulsa, OK 74116  
918.234.6300



## OPERATOR QUALIFICATION & EMPLOYEE CERTIFICATION

Employee: Andrew Duclos Emp ID: 3152  
 Method: RT Level: II API Task No: RT II  
 Certification Date: 12/5/2017 Restrictions: None  
 This certification expires in 3 years Vision Acuity: Pass  
 Latest Eye Examination Date: 12/5/2017 Color Contrast: Pass  
 Eye Examination Expires: 12/5/2018 Natural: X Corrected:  
 This individual is a participant in a DOT approved Drug and Alcohol Misuse Program

### Education Record:

Grade School: X High School: X Vocational: College: Other:

### Experience Record:

| Company                    | Level | Months |
|----------------------------|-------|--------|
| American Piping Inspection | I     | <12    |
| American Piping Inspection | II    | >12    |

### Training Record:

| Course      | By                         | Hours |
|-------------|----------------------------|-------|
| RT Level I  | American Piping Inspection | 40    |
| RT Level II | American Piping Inspection | 40    |

Recertification based on documented previous certification and American Piping Inspection Examination

| Examination Scores: | General | Specific | Practical | Average |
|---------------------|---------|----------|-----------|---------|
|                     | 90%     | 88%      | 90%       | 89%     |

AOC Test: Pass

The information provided in this certification record is in accordance with the latest edition of: The American Society of Nondestructive Testing's Recommended Practice SNT-TC-1A 49 CFR Part 192, Subpart N, and 49 CFR Part 149, Subpart G. All information provided is true and correct to the best of this company's knowledge. Copies of tests and testing procedures and requirements are on file at API.

This certification was administered by:

J. Orville McBride - President/Owner

J-488 SK2

SPOOLS

WPQs

**CISPER WELDING, INC.**

15681 East 590

Inola, Oklahoma 74036

Phone (918) 543-2321

**Welder or Welding Operator Performance Qualification (WPQ)**

Welder's Name: Tim Ward Stamp: T Date: 10/20/2016  
 Test WPS No.: CWI-320-1

Welding process(es) type(s) used: GTAW/ Manual  
 Type of joint welded: Pipe Groove Weld Joint Type(s) qualified: Groove and fillet welds  
 Base material(s) welded: SA 106-B to SA 106-B

| Welder Variables (QW-350)          | Actual Values Used  | Range Qualified             |
|------------------------------------|---------------------|-----------------------------|
| P-No. to P-No.                     | P-No.1 to P-No. 1   | P- 1 thru P-11, P-34 & P-4X |
| Base metal thickness (in)          | 0.218               | Max. to be welded           |
| Pipe diameter (in)                 | 2.375               | 1.0" minimum/unlimited      |
|                                    | <u>GTAW/Manual</u>  | <u>GTAW/Manual</u>          |
| Backing **                         | No backing used     | With or without backing     |
| A W S Classification               | ER-70S-6            |                             |
| Filler metal specification (SFA)   | 5.18                | 5.xx                        |
| Filler metal F-No.                 | 6                   | F-No. 6                     |
| Filler metal product form          | Bare (Solid)        | Bare / metal cored          |
| Consumable insert                  | No insert used      | Without insert only         |
| Weld deposit thickness (in)        | 0.218               | 0.4360" maximum             |
| Welding position                   | 6G - 45 degree pipe | All Positions               |
| Weld progression                   | Vertical up         | Vertical up (n4)            |
| Backing gas                        | No backing gas used | With or Without backing gas |
| GTAW welding current/ polarity     | DCEN (straight)     | DCEN (straight)             |
| Machine Welding Variables (QW-360) | Actual Values Used  | Range Qualified             |
| Direct / remote visual control     | N/A                 | N/A                         |
| Automatic voltage control          | N/A                 | N/A                         |
| Automatic joint tracking           | N/A                 | N/A                         |
| Welding position                   | N/A                 | N/A                         |
| Consumable insert                  | N/A                 | N/A                         |
| Backing **                         | N/A                 | N/A                         |
| Single / multiple pass per side    | N/A                 | N/A                         |

**Fillet Welds:** Qualified to make fillet welds of any size on all base materials thickness and pipe diameters of any size.  
 \*\* Welds with backing include fillets and doubles-welded groove welds.  
 Notes:

**Guided Bend Test (QW-160)**

| Figure Number and Type | Result       | Figure Number And Type | Result       |
|------------------------|--------------|------------------------|--------------|
| QW-462.3 Face Bend     | Satisfactory | QW-462.3 Root Bend     | Satisfactory |
| QW-462.3 Face Bend     | Satisfactory | QW-462.3 Root Bend     | Satisfactory |
| None                   |              | None                   |              |

Visual examination results: Visual exam satisfactory per QW-302.4 and QW-194  
 Radiographic test results: None  
 Welding test conducted by: Cisper Welding, Inc.  
 Mechanical/Radiographic tests conducted by: Cisper Welding, inc. Lab test no: \_\_\_\_\_

We certify that the statements in this record are correct and that the test coupons were prepared, welded, and tested in accordance with the requirements of Section IX of the ASME Code.

Certified By: Cameron Munro Date: 10/20/2016  
 Cameron Munro - Cisper Welding - QA/QC Manager

CISPER WELDING, INC.

15681 East 590 Rd.

Inola, Oklahoma 74036

Phone (918) 543-7755

E-Mail: CisperWelding.com

Welder or Welding Operator Performance Qualification (WPQ)

Welder's Name: Tim Ward Stamp: A Date: 7/23/2015  
 Test WPS No.: CWI-161-1

Welding Process(es) type(s) used: GMAW/Semiautomatic FCAW/Semiautomatic  
 Type of Joint welded: Pipe Groove Weld Joint Type(s) qualified: Groove and fillet welds  
 Base material(s) welded: SA106B to SA-106B

| Welder Variables (QW-350)          | Actual Values Used |              | Range Qualified            |                   |
|------------------------------------|--------------------|--------------|----------------------------|-------------------|
|                                    | P-No.1 to P-No. 1  |              | P-1 thru P-11, P-34 & P-4X |                   |
| Base metal thickness (in)          | 0.906              |              | Max to be Welded           |                   |
| Pipe diameter (in)                 | 8" Nom             |              | 2.875" minimum/Unlimited   |                   |
| Backing **                         | GMAW/Semi.         | FCAW/Semi.   | GMAW/Semi.                 | FCAW/Semi.        |
| AWS Classification                 | No backing used    | Backing used | With or without backing    | With backing only |
| Filler metal specification (SFA)   | ER70S-6            | E71T-1       |                            |                   |
| Filler metal No.                   | 5.18               | 5.2          | 5.xx                       | 5.xx              |
| Filler metal product form          | 6                  | 6            | F-No. 6                    | F-No. 6           |
| Consumable insert                  | N/A                | N/A          | N/A                        | N/A               |
| Weld deposit thickness (in)        | N/A                | N/A          | N/A                        | N/A               |
| Welding position                   | 0.125              | 0.781        | 0.1375" maximum            | 8.0" maximum      |
| Weld progression                   | 6G                 | 6G           | All                        | All               |
| Backing gas                        | N/A                | N/A          | N/A                        | N/A               |
|                                    | No backing used    | N/A          | With/without backing gas   | N/A               |
| Machine Welding Variables (QW-360) | Actual Values Used |              | Range Qualified            |                   |
| Direct / remote visual control     | N/A                | N/A          | N/A                        | N/A               |
| Automatic voltage control          | N/A                | N/A          | N/A                        | N/A               |
| Automatic joint tracking           | N/A                | N/A          | N/A                        | N/A               |
| Welding position                   | N/A                | N/A          | N/A                        | N/A               |
| Consumable insert                  | N/A                | N/A          | N/A                        | N/A               |
| Backing **                         | N/A                | N/A          | N/A                        | N/A               |
| Single / multiple pass per side    | N/A                | N/A          | N/A                        | N/A               |

Fillet Welds: qualified to make fillet welds of any size on all base materials thickness and pipe diameters of any size.

\*\* Welds with backing include fillets and doubles-welded groove welds.


Notes:

Guided Bend Test (QW-160)

| Figure Number and Type | Result       | Figure Number And Type | Result       |
|------------------------|--------------|------------------------|--------------|
| QW-462.2 Side Bend     | Satisfactory | QW-462.2 Side Bend     | Satisfactory |
| QW-462.2 Side Bend     | Satisfactory | QW-462.2 Side Bend     | Satisfactory |
| None                   |              | None                   |              |

Visual examination results: Visual exam satisfactory per QW-302.4 and QW-194  
 Radiographic test results: None  
 Welding test conducted by: Cisper Welding, Inc.  
 Mechanical/Radiographic tests conducted by: Cisper Welding, inc. Lab test no: \_\_\_\_\_

We certify that the statements in this record are correct and that the test coupons were prepared, welded, and tested in accordance with the requirements of Section IX of the ASME Code.

Certified By:   
 Cameron Munro QA/QC Cisper Welding Inc.

Date: 7/23/15

**CISPER WELDING, INC.**

15681 East 590

Inola, Oklahoma 74036

Phone (918) 543-2321

**Welder or Welding Operator Performance Qualification (WPQ)**

Welder's Name: Casey Bryant Stamp: D Date: 12/3/2016  
 Test WPS No.: CWI 320-1

Welding process(es) type(s) used: GTAW/ Manual  
 Type of joint welded: Pipe Groove Weld Joint Type(s) qualified: Groove and fillet welds  
 Base material(s) welded: SA 106-B to SA 106-B

| Welder Variables (QW-350)          | Actual Values Used        | Range Qualified             |
|------------------------------------|---------------------------|-----------------------------|
| P-No. to P-No.                     | P-No.1 to P-No. 1         | P-1 thru P-11, P-34 & P-4X  |
| Base metal thickness (in)          | 0.218                     | Max. to be welded           |
| Pipe diameter (in)                 | 2.375                     | 1.0" minimum/unlimited      |
|                                    | <b>GTAW/Manual</b>        | <b>GTAW/Manual</b>          |
| Backing **                         | No backing used           | With or without backing     |
| A W S Classification               | ER-70S-6                  |                             |
| Filler metal specification (SFA)   | 5.18                      | 5.xx                        |
| Filler metal F-No.                 | 6                         | F-No. 6                     |
| Filler metal product form          | Bare (Solid)              | Bare / metal cored          |
| Consumable insert                  | No insert used            | Without insert only         |
| Weld deposit thickness (in)        | 0.218                     | 0.4360" maximum             |
| Welding position                   | 6G - 45 degree pipe       | All Positions               |
| Weld progression                   | Vertical up               | Vertical up (n4)            |
| Backing gas                        | No backing gas used       | With or Without backing gas |
| GTAW welding current/ polarity     | DCEN (straight)           | DCEN (straight)             |
|                                    | <b>Actual Values Used</b> | <b>Range Qualified</b>      |
| Machine Welding Variables (QW-360) |                           |                             |
| Direct / remote visual control     | N/A                       | N/A                         |
| Automatic voltage control          | N/A                       | N/A                         |
| Automatic joint tracking           | N/A                       | N/A                         |
| Welding position                   | N/A                       | N/A                         |
| Consumable insert                  | N/A                       | N/A                         |
| Backing **                         | N/A                       | N/A                         |
| Single / multiple pass per side    | N/A                       | N/A                         |

**Fillet Welds:** Qualified to make fillet welds of any size on all base materials thickness and pipe diameters of any size.

\*\* Welds with backing include fillets and doubles-welded groove welds.

Notes:

**Guided Bend Test (QW-160)**

| Figure Number and Type | Result       | Figure Number And Type | Result       |
|------------------------|--------------|------------------------|--------------|
| QW-462.3 Face Bend     | Satisfactory | QW-462.3 Root Bend     | Satisfactory |
| QW-462.3 Face Bend     | Satisfactory | QW-462.3 Root Bend     | Satisfactory |
| None                   |              | None                   |              |

Visual examination results: Visual exam satisfactory per QW-302.4 and QW-194  
 Radiographic test results: None  
 Welding test conducted by: Cisper Welding, Inc.  
 Mechanical/Radiographic tests conducted by: Cisper Welding, inc. Lab test no: \_\_\_\_\_

We certify that the statements in this record are correct and that the test coupons were prepared, welded, and tested in accordance with the requirements of Section IX of the ASME Code.

Certified By: Cameron Munro  
 Cameron Munro - Cisper Welding - QA/QC Manager

12/3/2016  
 Date

**CISPER WELDING, INC.**

15681 East 590 Rd.

Inola, Oklahoma 74036

Phone (918) 543-7755

E-Mail: CisperWelding.com

**Welder or Welding Operator Performance Qualification (WPQ)**

Welder's Name: Casey Bryant Stamp: D Date: 5/1/2015  
 Test WPS No.: CWI-161-1

Welding process(es) type(s) used: GMAW/Semiautomatic FCAW/Semiautomatic  
 Type of joint welded: Pipe Groove Weld Joint Type(s) qualified: Groove and fillet welds  
 Base material(s) welded: SA106B to SA-106B

**Welder Variables (QW-350)**

| P-No. to P-No.                   | Actual Values Used |              | Range Qualified            |                   |
|----------------------------------|--------------------|--------------|----------------------------|-------------------|
|                                  | P-No.1 to P-No. 1  |              | P-1 thru P-11, P-34 & P-4X |                   |
| Base metal thickness (in)        | 0.906              |              | Max to be Welded           |                   |
| Pipe diameter (in)               | 8" Nom             |              | 2.875" minimum/Unlimited   |                   |
| Backing **                       | GMAW/Seml.         | FCAW/Seml.   | GMAW/Seml.                 | FCAW/Seml.        |
|                                  | No backing used    | Backing used | With or without backing    | With backing only |
| A W S Classification             | ER70S-6            | E71T-1       |                            |                   |
| Filler metal specification (SFA) | 5.18               | 5.2          | 5.xx                       | 5.xx              |
| Filler metal F-No.               | 6                  | 6            | F-No. 6                    | F-No. 6           |
| Filler metal product form        | N/A                | N/A          | N/A                        | N/A               |
| Consumable insert                | N/A                | N/A          | N/A                        | N/A               |
| Weld deposit thickness (in)      | 0.125              | 0.781        | 0.1375" maximum            | 8.0" maximum      |
| Welding position                 | 6G                 | 6G           | All                        | All               |
| Weld progression                 | N/A                | N/A          | N/A                        | N/A               |
| Backing gas                      | No backing used    | N/A          | With/Without backing gas   | N/A               |

**Machine Welding Variables (QW-360)**

|                                 | Actual Values Used |     | Range Qualified |     |
|---------------------------------|--------------------|-----|-----------------|-----|
| Direct / remote visual control  | N/A                | N/A | N/A             | N/A |
| Automatic voltage control       | N/A                | N/A | N/A             | N/A |
| Automatic joint tracking        | N/A                | N/A | N/A             | N/A |
| Welding position                | N/A                | N/A | N/A             | N/A |
| Consumable Insert               | N/A                | N/A | N/A             | N/A |
| Backing **                      | N/A                | N/A | N/A             | N/A |
| Single / multiple pass per side | N/A                | N/A | N/A             | N/A |


**Fillet Welds:** Qualified to make fillet welds of any size on all base materials thickness and pipe diameters of any size.  
 \*\* Welds with backing include fillets and doubles-welded groove welds.  
 Notes:

**Guided Bend Test (QW-160)**

| Figure Number and Type | Result       | Figure Number And Type | Result       |
|------------------------|--------------|------------------------|--------------|
| QW-462.2 Side Bend     | Satisfactory | QW-462.2 Side Bend     | Satisfactory |
| QW-462.2 Side Bend     | Satisfactory | QW-462.2 Side Bend     | Satisfactory |
| None                   |              | None                   |              |

Visual examination results: Visual exam satisfactory per QW-302.4 and QW-194  
 Radiographic test results: None  
 Welding test conducted by: Cisper Welding, Inc.  
 Mechanical/Radiographic tests conducted by: Cisper Welding, Inc. Lab test no: \_\_\_\_\_

We certify that the statements in this record are correct and that the test coupons were prepared, welded, and tested in accordance with the requirements of Section IX of the ASME Code.

Certified By:   
 Cameron Myntro QA/QC Cisper Welding Inc.

Date: 5/1/15



**CISPER WELDING, INC.**

15681 East 590 Rd.

Inola, Oklahoma 74036

Phone (918) 543-7755

E-Mail: CisperWelding.com

**Welder or Welding Operator Performance Qualification (WPQ)**

Welder's Name: Jeff Pickle Stamp: Q Date: 6/19/2017  
 Test WPS No.: CWI-325-1

Welding process(es) type(s) used: GMAW/Semiautomatic FCAW/Semiautomatic  
 Type of joint welded: Pipe Groove Weld Joint Type(s) qualified: Groove and fillet welds  
 Base material(s) welded: SA106B to SA-106B

| Welder Variables (QW-350)        | Actual Values Used |                   | Range Qualified            |                   |
|----------------------------------|--------------------|-------------------|----------------------------|-------------------|
|                                  | P-No.1 to P-No. 1  |                   | P-1 thru P-11, P-34 & P-4X |                   |
| Base metal thickness (in)        | 0.906              |                   | Max to be Welded           |                   |
| Pipe diameter (in)               | 8" Nom             |                   | 2.875" minimum/Unlimited   |                   |
|                                  | <b>GMAW/Semi.</b>  | <b>FCAW/Semi.</b> | <b>GMAW/Semi.</b>          | <b>FCAW/Semi.</b> |
| Backing **                       | No backing used    | Backing used      | With or without backing    | With backing only |
| A W S Classification             | ER70S-6            | E71T-1            |                            |                   |
| Filler metal specification (SFA) | 5.18               | 5.2               | 5.xx                       | 5.xx              |
| Filler metal F-No.               | 6                  | 6                 | F-No. 6                    | F-No. 6           |
| Filler metal product form        | N/A                | N/A               | N/A                        | N/A               |
| Consumable insert                | N/A                | N/A               | N/A                        | N/A               |
| Weld deposit thickness (in)      | 0.125              | 0.781             | 0.1375" maximum            | 8.0" maximum      |
| Welding position                 | 6G                 | 6G                | All                        | All               |
| Weld progression                 | N/A                | N/A               | N/A                        | N/A               |
| Backing gas                      | No backing used    | N/A               | With/Without backing gas   | N/A               |

| Machine Welding Variables (QW-360) | Actual Values Used             |     | Range Qualified |     |
|------------------------------------|--------------------------------|-----|-----------------|-----|
|                                    | Direct / remote visual control | N/A | N/A             | N/A |
| Automatic voltage control          | N/A                            | N/A | N/A             | N/A |
| Automatic joint tracking           | N/A                            | N/A | N/A             | N/A |
| Welding position                   | N/A                            | N/A | N/A             | N/A |
| Consumable insert                  | N/A                            | N/A | N/A             | N/A |
| Backing **                         | N/A                            | N/A | N/A             | N/A |
| Single / multiple pass per side    | N/A                            | N/A | N/A             | N/A |

**Fillet Welds:** Qualified to make fillet welds of any size on all base materials thickness and pipe diameters of any size.  
 \*\* Welds with backing include fillets and doubles-welded groove welds.  
**Notes:**

**Guided Bend Test (QW-160)**

| Figure Number and Type | Result       | Figure Number And Type | Result       |
|------------------------|--------------|------------------------|--------------|
| QW-462.2 Side Bend     | Satisfactory | QW-462.2 Side Bend     | Satisfactory |
| QW-462.2 Side Bend     | Satisfactory | QW-462.2 Side Bend     | Satisfactory |
| None                   |              | None                   |              |

Visual examination results: Visual exam satisfactory per QW-302.4 and QW-194  
 Radiographic test results: None  
 Welding test conducted by: Cisper Welding, Inc.  
 Mechanical/Radiographic tests conducted by: Cisper Welding, Inc. Lab test no: \_\_\_\_\_

We certify that the statements in this record are correct and that the test coupons were prepared, welded, and tested in accordance with the requirements of Section IX of the ASME Code.

Certified By: *Cameron Munro* Date: 6/19/2017  
 Cameron Munro QA/QC Cisper Welding Inc.

Approved for Shell Project T.16051  
 Geoff Rogers of SPLC  
 1<sup>st</sup> August 2017

**CISPER WELDING, INC.**

15681 East 590 Rd.

Inola, Oklahoma 74036

Phone (918) 543-7755

E-Mail: CisperWelding.com

**Welder or Welding Operator Performance Qualification (WPQ)**

**Welder's Name:** Justin McDaniel **Stamp:** S **Date:** 1/8/2018  
**Test WPS No.:** CWI-325-1

Welding process(es) type(s) used: GMAW/Semiautomatic FCAW/Semiautomatic  
 Type of joint welded: Pipe Groove Weld Joint Type(s) qualified: Groove and fillet welds  
 Base material(s) welded: SA106B to SA-106B

**Welder Variables (QW-350)**

| P-No. to P-No.                   | Actual Values Used |                   | Range Qualified            |                   |
|----------------------------------|--------------------|-------------------|----------------------------|-------------------|
|                                  | P-No.1 to P-No. 1  |                   | P-1 thru P-11, P-34 & P-4X |                   |
| Base metal thickness (in)        | 0.906              |                   | Max to be Welded           |                   |
| Pipe diameter (in)               | 8" Nom             |                   | 2.875" minimum/Unlimited   |                   |
|                                  | <b>GMAW/Semi.</b>  | <b>FCAW/Semi.</b> | <b>GMAW/Semi.</b>          | <b>FCAW/Semi.</b> |
| Backing **                       | No backing used    | Backing used      | With or without backing    | With backing only |
| A W S Classification             | ER70S-6            | E71T-1            |                            |                   |
| Filler metal specification (SFA) | 5.18               | 5.2               | 5.xx                       | 5.xx              |
| Filler metal F-No.               | 6                  | 6                 | F-No. 6                    | F-No. 6           |
| Filler metal product form        | N/A                | N/A               | N/A                        | N/A               |
| Consumable insert                | N/A                | N/A               | N/A                        | N/A               |
| Weld deposit thickness (in)      | 0.125              | 0.781             | 0.1375" maximum            | 8.0" maximum      |
| Welding position                 | 6G                 | 6G                | All                        | All               |
| Weld progression                 | N/A                | N/A               | N/A                        | N/A               |
| Backing gas                      | No backing used    | N/A               | With/Without backing gas   | N/A               |

**Machine Welding Variables (QW-360)**

|                                 | Actual Values Used             |     | Range Qualified |     |
|---------------------------------|--------------------------------|-----|-----------------|-----|
|                                 | Direct / remote visual control | N/A | N/A             | N/A |
| Automatic voltage control       | N/A                            | N/A | N/A             | N/A |
| Automatic joint tracking        | N/A                            | N/A | N/A             | N/A |
| Welding position                | N/A                            | N/A | N/A             | N/A |
| Consumable insert               | N/A                            | N/A | N/A             | N/A |
| Backing **                      | N/A                            | N/A | N/A             | N/A |
| Single / multiple pass per side | N/A                            | N/A | N/A             | N/A |

**Fillet Welds:** Qualified to make fillet welds of any size on all base materials thickness and pipe diameters of any size.  
 \*\* Welds with backing include fillets and doubles-welded groove welds.  
**Notes:**

**Guided Bend Test (QW-160)**

| Figure Number and Type | Result       | Figure Number And Type | Result       |
|------------------------|--------------|------------------------|--------------|
| QW-462.2 Side Bend     | Satisfactory | QW-462.2 Side Bend     | Satisfactory |
| QW-462.2 Side Bend     | Satisfactory | QW-462.2 Side Bend     | Satisfactory |
| None                   |              | None                   |              |

Visual examination results: Visual exam satisfactory per QW-302.4 and QW-194  
 Radiographic test results: None  
 Welding test conducted by: Cisper Welding, Inc.  
 Mechanical/Radiographic tests conducted by: Cisper Welding, inc. Lab test no: \_\_\_\_\_

We certify that the statements in this record are correct and that the test coupons were prepared, welded, and tested in accordance with the requirements of Section IX of the ASME Code.

Certified By: *Cameron Munro*  
 Cameron Munro QA/QC Cisper Welding Inc.

1/8/2018  
 Date

**CISPER WELDING, INC.**

15681 East 590

Inola, Oklahoma 74036

Phone (918) 543-2321

**Welder or Welding Operator Performance Qualification (WPQ)**

**Welder's Name:** Justin McDaniel **Stamp:** S **Date:** 1/8/2018  
**Test WPS No.:** CWI-241-1

Welding process(es) type(s) used: GTAW/ Manual  
 Type of joint welded: Pipe Groove Weld Joint Type(s) qualified: Groove and fillet welds  
 Base material(s) welded: SA 106-B to SA 106-B

| Welder Variables (QW-350)          |      | Actual Values Used  | Range Qualified             |
|------------------------------------|------|---------------------|-----------------------------|
| P-No. to P-No.                     |      | P-No.1 to P-No. 1   | P-1 thru P-11, P-34 & P-4X  |
| Base metal thickness               | (in) | 0.218               | Max. to be welded           |
| Pipe diameter                      | (in) | 2.375               | 1.0" minimum/unlimited      |
|                                    |      | <b>GTAW/Manual</b>  | <b>GTAW/Manual</b>          |
| Backing **                         |      | No backing used     | With or without backing     |
| A W S Classification               |      | ER-70S-6            |                             |
| Filler metal specification (SFA)   |      | 5.18                | 5.xx                        |
| Filler metal F-No.                 |      | 6                   | F-No. 6                     |
| Filler metal product form          |      | Bare (Solid)        | Bare / metal cored          |
| Consumable insert                  |      | No insert used      | Without insert only         |
| Weld deposit thickness (in)        |      | 0.218               | 0.4360" maximum             |
| Welding position                   |      | 6G - 45 degree pipe | All Positions               |
| Weld progression                   |      | Vertical up         | Vertical up (n4)            |
| Backing gas                        |      | No backing gas used | With or Without backing gas |
| GTAW welding current/ polarity     |      | DCEN (straight)     | DCEN (straight)             |
| Machine Welding Variables (QW-360) |      | Actual Values Used  | Range Qualified             |
| Direct / remote visual control     |      | N/A                 | N/A                         |
| Automatic voltage control          |      | N/A                 | N/A                         |
| Automatic joint tracking           |      | N/A                 | N/A                         |
| Welding position                   |      | N/A                 | N/A                         |
| Consumable insert                  |      | N/A                 | N/A                         |
| Backing **                         |      | N/A                 | N/A                         |
| Single / multiple pass per side    |      | N/A                 | N/A                         |

**Fillet Welds:** Qualified to make fillet welds of any size on all base materials thickness and pipe diameters of any size.  
 \*\* Welds with backing include fillets and doubles-welded groove welds.  
**Notes:**

**Guided Bend Test (QW-160)**

| Figure Number and Type | Result       | Figure Number And Type | Result       |
|------------------------|--------------|------------------------|--------------|
| QW-462.3 Face Bend     | Satisfactory | QW-462.3 Root Bend     | Satisfactory |
| QW-462.3 Face Bend     | Satisfactory | QW-462.3 Root Bend     | Satisfactory |
| None                   |              | None                   |              |

Visual examination results: Visual exam satisfactory per QW-302.4 and QW-194  
 Radiographic test results: None  
 Welding test conducted by: Cisper Welding, Inc.  
 Mechanical/Radiographic tests conducted by: Cisper Welding, inc. Lab test no: \_\_\_\_\_

We certify that the statements in this record are correct and that the test coupons were prepared, welded, and tested in accordance with the requirements of Section IX of the ASME Code.

Certified By: Cameron Munro 1/8/2018  
 Cameron Munro - Cisper Welding - QA/QC Manager Date

**CISPER WELDING, INC.**

15681 East 590 Rd.

Inola, Oklahoma 74036

Phone (918) 543-7755

E-Mail: CisperWelding.com

**Welder or Welding Operator Performance Qualification (WPQ)**

Welder's Name: Jimmie Nibarger Stamp: O Date: 5/14/2018  
 Test WPS No.: CWI-325-1

Welding process(es) type(s) used: GMAW/Semiautomatic FCAW/Semiautomatic  
 Type of joint welded: Pipe Groove Weld Joint Type(s) qualified: Groove and fillet welds  
 Base material(s) welded: SA106B to SA-106B

**Welder Variables (QW-350)**

| P-No. to P-No.                   | Actual Values Used |                   | Range Qualified            |                   |
|----------------------------------|--------------------|-------------------|----------------------------|-------------------|
|                                  | P-No.1 to P-No. 1  |                   | P-1 thru P-11, P-34 & P-4X |                   |
| Base metal thickness (in)        | 0.906              |                   | Max to be Welded           |                   |
| Pipe diameter (in)               | 8" Nom             |                   | 2.875" minimum/Unlimited   |                   |
| Backing **                       | <b>GMAW/Semi.</b>  | <b>FCAW/Semi.</b> | <b>GMAW/Semi.</b>          | <b>FCAW/Semi.</b> |
|                                  | No backing used    | Backing used      | With or without backing    | With backing only |
| A W S Classification             | ER70S-6            | E71T-1            |                            |                   |
| Filler metal specification (SFA) | 5.18               | 5.2               | 5.xx                       | 5.xx              |
| Filler metal F-No.               | 6                  | 6                 | F-No. 6                    | F-No. 6           |
| Filler metal product form        | N/A                | N/A               | N/A                        | N/A               |
| Consumable insert                | N/A                | N/A               | N/A                        | N/A               |
| Weld deposit thickness (in)      | 0.125              | 0.781             | 0.1375" maximum            | 8.0" maximum      |
| Welding position                 | 6G                 | 6G                | All                        | All               |
| Weld progression                 | N/A                | N/A               | N/A                        | N/A               |
| Backing gas                      | No backing used    | N/A               | With/Without backing gas   | N/A               |

**Machine Welding Variables (QW-360)**

|                                 | Actual Values Used             |     | Range Qualified |     |
|---------------------------------|--------------------------------|-----|-----------------|-----|
|                                 | Direct / remote visual control | N/A | N/A             | N/A |
| Automatic voltage control       | N/A                            | N/A | N/A             | N/A |
| Automatic joint tracking        | N/A                            | N/A | N/A             | N/A |
| Welding position                | N/A                            | N/A | N/A             | N/A |
| Consumable insert               | N/A                            | N/A | N/A             | N/A |
| Backing **                      | N/A                            | N/A | N/A             | N/A |
| Single / multiple pass per side | N/A                            | N/A | N/A             | N/A |

**Fillet Welds:** Qualified to make fillet welds of any size on all base materials thickness and pipe diameters of any size.

\*\* Welds with backing include fillets and doubles-welded groove welds.

Notes:

**Guided Bend Test (QW-160)**

| Figure Number and Type | Result       | Figure Number And Type | Result       |
|------------------------|--------------|------------------------|--------------|
| QW-462.2 Side Bend     | Satisfactory | QW-462.2 Side Bend     | Satisfactory |
| QW-462.2 Side Bend     | Satisfactory | QW-462.2 Side Bend     | Satisfactory |
| None                   |              | None                   |              |

Visual examination results: Visual exam satisfactory per QW-302.4 and QW-194  
 Radiographic test results: None  
 Welding test conducted by: Cisper Welding, Inc.  
 Mechanical/Radiographic tests conducted by: Cisper Welding, Inc. Lab test no: \_\_\_\_\_

We certify that the statements in this record are correct and that the test coupons were prepared, welded, and tested in accordance with the requirements of Section IX of the ASME Code.

Certified By: *Cameron Munro*  
 Cameron Munro QA/QC Cisper Welding Inc.

5/14/2018  
 Date

**CISPER WELDING, INC.**

15681 East 590

Inola, Oklahoma 74036

Phone (918) 543-2321

**Welder or Welding Operator Performance Qualification (WPQ)**

**Welder's Name:** Felipe Romero **Stamp:** CC **Date:** 3/6/2017  
**Test WPS No.:** CWI-320-1

Welding process(es) type(s) used: GTAW/ Manual  
 Type of joint welded: Pipe Groove Weld Joint Type(s) qualified: Groove and fillet welds  
 Base material(s) welded: SA 106-B to SA 106-B

| Welder Variables (QW-350)          |      | Actual Values Used  | Range Qualified             |
|------------------------------------|------|---------------------|-----------------------------|
| P-No. to P-No.                     |      | P-No.1 to P-No. 1   | P-1 thru P-11, P-34 & P-4X  |
| Base metal thickness               | (in) | 0.218               | Max. to be welded           |
| Pipe diameter                      | (in) | 2.375               | 1.0" minimum/unlimited      |
|                                    |      | <b>GTAW/Manual</b>  | <b>GTAW/Manual</b>          |
| Backing **                         |      | No backing used     | With or without backing     |
| A W S Classification               |      | ER-70S-6            |                             |
| Filler metal specification (SFA)   |      | 5.18                | 5.xx                        |
| Filler metal F-No.                 |      | 6                   | F-No. 6                     |
| Filler metal product form          |      | Bare (Solid)        | Bare / metal cored          |
| Consumable insert                  |      | No insert used      | Without insert only         |
| Weld deposit thickness (in)        |      | 0.218               | 0.4360" maximum             |
| Welding position                   |      | 6G - 45 degree pipe | All Positions               |
| Weld progression                   |      | Vertical up         | Vertical up (n4)            |
| Backing gas                        |      | No backing gas used | With or Without backing gas |
| GTAW welding current/ polarity     |      | DCEN (straight)     | DCEN (straight)             |
| Machine Welding Variables (QW-360) |      | Actual Values Used  | Range Qualified             |
| Direct / remote visual control     |      | N/A                 | N/A                         |
| Automatic voltage control          |      | N/A                 | N/A                         |
| Automatic joint tracking           |      | N/A                 | N/A                         |
| Welding position                   |      | N/A                 | N/A                         |
| Consumable insert                  |      | N/A                 | N/A                         |
| Backing **                         |      | N/A                 | N/A                         |
| Single / multiple pass per side    |      | N/A                 | N/A                         |

**Fillet Welds:** Qualified to make fillet welds of any size on all base materials thickness and pipe diameters of any size.  
 \*\* Welds with backing include fillets and doubles-welded groove welds.  
**Notes:**

**Guided Bend Test (QW-160)**

| Figure Number and Type | Result       | Figure Number And Type | Result       |
|------------------------|--------------|------------------------|--------------|
| QW-462.3 Face Bend     | Satisfactory | QW-462.3 Root Bend     | Satisfactory |
| QW-462.3 Face Bend     | Satisfactory | QW-462.3 Root Bend     | Satisfactory |
| None                   |              | None                   |              |

Visual examination results: Visual exam satisfactory per QW-302.4 and QW-194  
 Radiographic test results: None  
 Welding test conducted by: Cisper Welding, Inc.  
 Mechanical/Radiographic tests conducted by: Cisper Welding, Inc. Lab test no: N/A

We certify that the statements in this record are correct and that the test coupons were prepared, welded, and tested in accordance with the requirements of Section IX of the ASME Code.

Certified By: *Cameron Munro*  
 Cameron Munro - Cisper Welding - QA/QC Manager

3/6/2017  
 Date

**CISPER WELDING, INC.**

15681 East 590 Rd.  
Inola, Oklahoma 74036  
Phone (918) 543-7755

E-Mail: CisperWelding.com

**Welder or Welding Operator Performance Qualification (WPQ)**

**Welder's Name:** Clay Mindemann **Stamp:** CM **Date:** 1/25/2017  
**Test WPS No.:** CWI-325-1

Welding process(es) type(s) used: GMAW/Semiautomatic FCAW/Semiautomatic  
Type of joint welded: Pipe Groove Weld Joint Type(s) qualified: Groove and fillet welds  
Base material(s) welded: SA106B to SA-106B

**Welder Variables (QW-350)**

| P-No. to P-No.                   | Actual Values Used |                   | Range Qualified            |                   |
|----------------------------------|--------------------|-------------------|----------------------------|-------------------|
|                                  | P-No.1 to P-No. 1  |                   | P-1 thru P-11, P-34 & P-4X |                   |
| Base metal thickness (in)        | 0.906              |                   | Max to be Welded           |                   |
| Pipe diameter (in)               | 8" Nom             |                   | 2.875" minimum/Unlimited   |                   |
|                                  | <b>GMAW/Semi.</b>  | <b>FCAW/Semi.</b> | <b>GMAW/Semi.</b>          | <b>FCAW/Semi.</b> |
| Backing **                       | No backing used    | Backing used      | With or without backing    | With backing only |
| A W S Classification             | ER70S-6            | E71T-1            |                            |                   |
| Filler metal specification (SFA) | 5.18               | 5.2               | 5.xx                       | 5.xx              |
| Filler metal F-No.               | 6                  | 6                 | F-No. 6                    | F-No. 6           |
| Filler metal product form        | N/A                | N/A               | N/A                        | N/A               |
| Consumable insert                | N/A                | N/A               | N/A                        | N/A               |
| Weld deposit thickness (in)      | 0.125              | 0.781             | 0.1375" maximum            | 8.0" maximum      |
| Welding position                 | 6G                 | 6G                | All                        | All               |
| Weld progression                 | N/A                | N/A               | N/A                        | N/A               |
| Backing gas                      | No backing used    | N/A               | With/Without backing gas   | N/A               |

**Machine Welding Variables (QW-360)**

|                                 | Actual Values Used             |     | Range Qualified |     |
|---------------------------------|--------------------------------|-----|-----------------|-----|
|                                 | Direct / remote visual control | N/A | N/A             | N/A |
| Automatic voltage control       | N/A                            | N/A | N/A             | N/A |
| Automatic joint tracking        | N/A                            | N/A | N/A             | N/A |
| Welding position                | N/A                            | N/A | N/A             | N/A |
| Consumable insert               | N/A                            | N/A | N/A             | N/A |
| Backing **                      | N/A                            | N/A | N/A             | N/A |
| Single / multiple pass per side | N/A                            | N/A | N/A             | N/A |

**Fillet Welds:** Qualified to make fillet welds of any size on all base materials thickness and pipe diameters of any size.  
\*\* Welds with backing include fillets and doubles-welded groove welds.  
**Notes:**

**Guided Bend Test (QW-160)**

| Figure Number and Type | Result       | Figure Number And Type | Result       |
|------------------------|--------------|------------------------|--------------|
| QW-462.2 Side Bend     | Satisfactory | QW-462.2 Side Bend     | Satisfactory |
| QW-462.2 Side Bend     | Satisfactory | QW-462.2 Side Bend     | Satisfactory |
| None                   |              | None                   |              |

Visual examination results: Visual exam satisfactory per QW-302.4 and QW-194  
Radiographic test results: None  
Welding test conducted by: Cisper Welding, Inc.  
Mechanical/Radiographic tests conducted by: Cisper Welding, inc. Lab test no: \_\_\_\_\_

We certify that the statements in this record are correct and that the test coupons were prepared, welded, and tested in accordance with the requirements of Section IX of the ASME Code.

Certified By: *Cameron Munro* 1/25/2017  
Cameron Munro QA/QC Cisper Welding Inc. Date

**CISPER WELDING, INC.**

15681 East 590

Inola, Oklahoma 74036

Phone (918) 543-2321

**Welder or Welding Operator Performance Qualification (WPQ)**

Welder's Name: Clay Mindemann Stamp: CM Date: 3/25/2017  
 Test WPS No.: CWI-320-1

Welding process(es) type(s) used: GTAW/ Manual  
 Type of joint welded: Pipe Groove Weld Joint Type(s) qualified: Groove and fillet welds  
 Base material(s) welded: SA 106-B to SA 106-B

| Welder Variables (QW-350)          |      | Actual Values Used  | Range Qualified             |
|------------------------------------|------|---------------------|-----------------------------|
| P-No. to P-No.                     |      | P-No.1 to P-No. 1   | P-1 thru P-11, P-34 & P-4X  |
| Base metal thickness               | (in) | 0.218               | Max. to be welded           |
| Pipe diameter                      | (in) | 2.375               | 1.0" minimum/unlimited      |
|                                    |      | <b>GTAW/Manual</b>  | <b>GTAW/Manual</b>          |
| Backing **                         |      | No backing used     | With or without backing     |
| A W S Classification               |      | ER-70S-6            |                             |
| Filler metal specification (SFA)   |      | 5.18                | 5.xx                        |
| Filler metal F-No.                 |      | 6                   | F-No. 6                     |
| Filler metal product form          |      | Bare (Solid)        | Bare / metal cored          |
| Consumable insert                  |      | No insert used      | Without insert only         |
| Weld deposit thickness (in)        |      | 0.218               | 0.4360" maximum             |
| Welding position                   |      | 6G - 45 degree pipe | All Positions               |
| Weld progression                   |      | Vertical up         | Vertical up (n4)            |
| Backing gas                        |      | No backing gas used | With or Without backing gas |
| GTAW welding current/ polarity     |      | DCEN (straight)     | DCEN (straight)             |
| Machine Welding Variables (QW-360) |      | Actual Values Used  | Range Qualified             |
| Direct / remote visual control     |      | N/A                 | N/A                         |
| Automatic voltage control          |      | N/A                 | N/A                         |
| Automatic joint tracking           |      | N/A                 | N/A                         |
| Welding position                   |      | N/A                 | N/A                         |
| Consumable insert                  |      | N/A                 | N/A                         |
| Backing **                         |      | N/A                 | N/A                         |
| Single / multiple pass per side    |      | N/A                 | N/A                         |

**Fillet Welds:** Qualified to make fillet welds of any size on all base materials thickness and pipe diameters of any size.  
 \*\* Welds with backing include fillets and doubles-welded groove welds.  
**Notes:**

**Guided Bend Test (QW-160)**

| Figure Number and Type | Result       | Figure Number And Type | Result       |
|------------------------|--------------|------------------------|--------------|
| QW-462.3 Face Bend     | Satisfactory | QW-462.3 Root Bend     | Satisfactory |
| QW-462.3 Face Bend     | Satisfactory | QW-462.3 Root Bend     | Satisfactory |
| None                   |              | None                   |              |

Visual examination results: Visual exam satisfactory per QW-302.4 and QW-194  
 Radiographic test results: None  
 Welding test conducted by: Cisper Welding, Inc.  
 Mechanical/Radiographic tests conducted by: Cisper Welding, inc. Lab test no: \_\_\_\_\_

We certify that the statements in this record are correct and that the test coupons were prepared, welded, and tested in accordance with the requirements of Section IX of the ASME Code.

Certified By: Cameron Munro Date: 3/25/2017  
 Cameron Munro - Cisper Welding - QA/QC Manager

**CISPER WELDING, INC.**

15681 East 590 Rd.

Inola, Oklahoma 74036

Phone (918) 543-7755

E-Mail: CisperWelding.com

**Welder or Welding Operator Performance Qualification (WPQ)**

**Welder's Name:** Jeremy Ross **Stamp:** JR **Date:** 1/3/2017  
**Test WPS No.:** CWI-325-1

Welding process(es) type(s) used: GMAW/Semiautomatic FCAW/Semiautomatic  
 Type of joint welded: Pipe Groove Weld Joint Type(s) qualified: Groove and fillet welds  
 Base material(s) welded: SA106B to SA-106B

**Welder Variables (QW-350)**

| P-No. to P-No.                   | Actual Values Used |                   | Range Qualified            |                   |
|----------------------------------|--------------------|-------------------|----------------------------|-------------------|
|                                  | P-No.1 to P-No. 1  |                   | P-1 thru P-11, P-34 & P-4X |                   |
| Base metal thickness (in)        | 0.906              |                   | Max to be Welded           |                   |
| Pipe diameter (in)               | 8" Nom             |                   | 2.875" minimum/Unlimited   |                   |
|                                  | <b>GMAW/Semi.</b>  | <b>FCAW/Semi.</b> | <b>GMAW/Semi.</b>          | <b>FCAW/Semi.</b> |
| Backing **                       | No backing used    | Backing used      | With or without backing    | With backing only |
| A W S Classification             | ER70S-6            | E71T-1            |                            |                   |
| Filler metal specification (SFA) | 5.18               | 5.2               | 5.xx                       | 5.xx              |
| Filler metal F-No.               | 6                  | 6                 | F-No. 6                    | F-No. 6           |
| Filler metal product form        | N/A                | N/A               | N/A                        | N/A               |
| Consumable insert                | N/A                | N/A               | N/A                        | N/A               |
| Weld deposit thickness (in)      | 0.125              | 0.781             | 0.1375" maximum            | 8.0" maximum      |
| Welding position                 | 6G                 | 6G                | All                        | All               |
| Weld progression                 | N/A                | N/A               | N/A                        | N/A               |
| Backing gas                      | No backing used    | N/A               | With/Without backing gas   | N/A               |

**Machine Welding Variables (QW-360)**

|                                 | Actual Values Used             |     | Range Qualified |     |
|---------------------------------|--------------------------------|-----|-----------------|-----|
|                                 | Direct / remote visual control | N/A | N/A             | N/A |
| Automatic voltage control       | N/A                            | N/A | N/A             | N/A |
| Automatic joint tracking        | N/A                            | N/A | N/A             | N/A |
| Welding position                | N/A                            | N/A | N/A             | N/A |
| Consumable insert               | N/A                            | N/A | N/A             | N/A |
| Backing **                      | N/A                            | N/A | N/A             | N/A |
| Single / multiple pass per side | N/A                            | N/A | N/A             | N/A |

**Fillet Welds:** Qualified to make fillet welds of any size on all base materials thickness and pipe diameters of any size.  
 \*\* Welds with backing include fillets and doubles-welded groove welds.  
**Notes:**

**Guided Bend Test (QW-160)**

| Figure Number and Type | Result       | Figure Number And Type | Result       |
|------------------------|--------------|------------------------|--------------|
| QW-462.2 Side Bend     | Satisfactory | QW-462.2 Side Bend     | Satisfactory |
| QW-462.2 Side Bend     | Satisfactory | QW-462.2 Side Bend     | Satisfactory |
| None                   |              | None                   |              |

Visual examination results: Visual exam satisfactory per QW-302.4 and QW-194  
 Radiographic test results: None  
 Welding test conducted by: Cisper Welding, Inc.  
 Mechanical/Radiographic tests conducted by: Cisper Welding, inc. Lab test no: \_\_\_\_\_

We certify that the statements in this record are correct and that the test coupons were prepared, welded, and tested in accordance with the requirements of Section IX of the ASME Code.

Certified By: *Cameron Munro*  
 Cameron Munro QA/QC Cisper Welding Inc.

1/3/2017  
 Date

**CISPER WELDING, INC.**

P.O. Box 946

Locust Grove, Oklahoma 74352

Phone (918) 543-2321

**Welder or Welding Operator Performance Qualification (WPQ)**

**Welder's Name:** Jeremy Ross **Stamp:** JR **Date:** 3/4/2017  
**Test WPS No.:** CWI-321-1

Welding process(es) type(s) used: GTAW/Manual FCAW/Semiautomatic  
 Type of joint welded: Plate Groove Weld Joint Type(s) qualified: Groove and fillet welds  
 Base material(s) welded: SA516-70 to 516-70

**Welder Variables (QW-350)**

|                                  | Actual Values Used |                    | Range Qualified            |                    |
|----------------------------------|--------------------|--------------------|----------------------------|--------------------|
|                                  | P-No.1 to P-No. 1  |                    | P-1 thru P-11, P-34 & P-4X |                    |
| Base metal thickness (in)        | 1.5                |                    | Max to be welded           |                    |
| Pipe diameter (in)               | N/A                |                    | 2.875" minimum/Unlimited   |                    |
|                                  | GTAW/Manual        | FCAW/Semiautomatic | GTAW/Manual                | FCAW/Semiautomatic |
| Backing **                       | No backing used    | Backing used       | With or without backing    | With backing only  |
| A W S Classification             | ER70S-2            | E71T-1             |                            |                    |
| Filler metal specification (SFA) | 5.18               | 5.2                | 5.xx                       | 5.xx               |
| Filler metal F-No.               | 6                  | 6                  | F-No. 6                    | F-No. 6            |
| Filler metal product form        | N/A                | N/A                | N/A                        | N/A                |
| Consumable insert                | N/A                | N/A                | N/A                        | N/A                |
| Weld deposit thickness (in)      | 0.125              | 1.375              | 0.2500" maximum            | 2.75" maximum      |
| Welding position                 | 1G Flat            | 1G Flat            | Flat Only                  | Flat Only          |
| Weld progression                 | N/A                | N/A                | N/A                        | N/A                |
| Backing gas                      | No backing used    | N/A                | With/Without backing gas   | N/A                |
| Transfer Mode                    | N/A                | Spray Arc          | N/A                        | Spray Arc          |

**Machine Welding Variables (QW-360)**

|                                 | Actual Values Used |     | Range Qualified |     |
|---------------------------------|--------------------|-----|-----------------|-----|
| Direct / remote visual control  | N/A                | N/A | N/A             | N/A |
| Automatic voltage control       | N/A                | N/A | N/A             | N/A |
| Automatic joint tracking        | N/A                | N/A | N/A             | N/A |
| Welding position                | N/A                | N/A | N/A             | N/A |
| Consumable insert               | N/A                | N/A | N/A             | N/A |
| Backing **                      | N/A                | N/A | N/A             | N/A |
| Single / multiple pass per side | N/A                | N/A | N/A             | N/A |

**Fillet Welds:** Qualified to make fillet welds of any size on all base materials thickness and pipe diameters of any size.  
 \*\* Welds with backing include fillets and doubles-welded groove welds.  
**Notes:**

**Guided Bend Test (QW-160)**

| Figure Number and Type | Result       | Figure Number And Type | Result       |
|------------------------|--------------|------------------------|--------------|
| QW-462.2 Side Bend     | Satisfactory | QW-462.2 Side Bend     | Satisfactory |
| QW-462.2 Side Bend     | Satisfactory | QW-462.2 Side Bend     | Satisfactory |
| None                   |              | None                   |              |

Visual examination results: Visual exam satisfactory per QW-302.4 and QW-194  
 Radiographic test results: None  
 Welding test conducted by: Cisper Welding, Inc.  
 Mechanical/Radiographic tests conducted by: Cisper Welding, inc. Lab test no: CWI-321-1

We certify that the statements in this record are correct and that the test coupons were prepared, welded, and tested in accordance with the requirements of Section IX of the ASME Code.

Certified By: *Cameron Munro*  
 Cameron Munro - Cisper Welding - QA/QC Manager

3/4/2017  
 Date

**CISPER WELDING, INC.**

15681 East 590  
Inola, Oklahoma 74036  
Phone (918) 543-2321

**Welder or Welding Operator Performance Qualification (WPQ)**

**Welder's Name:** Jeremy Ross **Stamp:** JR **Date:** 3/3/2017  
**Test WPS No.:** CWI-320-1

Welding process(es) type(s) used: GTAW/ Manual  
Type of joint welded: Pipe Groove Weld Joint Type(s) qualified: Groove and fillet welds  
Base material(s) welded: SA 106-B to SA 106-B

| Welder Variables (QW-350)          |      | Actual Values Used  | Range Qualified             |
|------------------------------------|------|---------------------|-----------------------------|
| P-No. to P-No.                     |      | P-No.1 to P-No. 1   | P-1 thru P-11, P-34 & P-4X  |
| Base metal thickness               | (in) | 0.218               | Max. to be welded           |
| Pipe diameter                      | (in) | 2.375               | 1.0" minimum/unlimited      |
|                                    |      | <b>GTAW/Manual</b>  | <b>GTAW/Manual</b>          |
| Backing **                         |      | No backing used     | With or without backing     |
| A W S Classification               |      | ER-70S-6            |                             |
| Filler metal specification (SFA)   |      | 5.18                | 5.xx                        |
| Filler metal F-No.                 |      | 6                   | F-No. 6                     |
| Filler metal product form          |      | Bare (Solid)        | Bare / metal cored          |
| Consumable insert                  |      | No insert used      | Without insert only         |
| Weld deposit thickness (in)        |      | 0.218               | 0.4360" maximum             |
| Welding position                   |      | 6G - 45 degree pipe | All Positions               |
| Weld progression                   |      | Vertical up         | Vertical up (n4)            |
| Backing gas                        |      | No backing gas used | With or Without backing gas |
| GTAW welding current/ polarity     |      | DCEN (straight)     | DCEN (straight)             |
| Machine Welding Variables (QW-360) |      | Actual Values Used  | Range Qualified             |
| Direct / remote visual control     |      | N/A                 | N/A                         |
| Automatic voltage control          |      | N/A                 | N/A                         |
| Automatic joint tracking           |      | N/A                 | N/A                         |
| Welding position                   |      | N/A                 | N/A                         |
| Consumable insert                  |      | N/A                 | N/A                         |
| Backing **                         |      | N/A                 | N/A                         |
| Single / multiple pass per side    |      | N/A                 | N/A                         |

**Fillet Welds:** Qualified to make fillet welds of any size on all base materials thickness and pipe diameters of any size.  
\*\* Welds with backing include fillets and doubles-welded groove welds.  
**Notes:**

**Guided Bend Test (QW-160)**

| Figure Number and Type | Result       | Figure Number And Type | Result       |
|------------------------|--------------|------------------------|--------------|
| QW-462.3 Face Bend     | Satisfactory | QW-462.3 Root Bend     | Satisfactory |
| QW-462.3 Face Bend     | Satisfactory | QW-462.3 Root Bend     | Satisfactory |
| None                   |              | None                   |              |

Visual examination results: Visual exam satisfactory per QW-302.4 and QW-194  
Radiographic test results: None  
Welding test conducted by: Cisper Welding, Inc.  
Mechanical/Radiographic tests conducted by: Cisper Welding, inc. Lab test no: \_\_\_\_\_

We certify that the statements in this record are correct and that the test coupons were prepared, welded, and tested in accordance with the requirements of Section IX of the ASME Code.

Certified By: *Cameron Munro*  
Cameron Munro - Cisper Welding - QA/QC Manager




3/3/2017  
Date

J-488 SK2

SPOOLS

WELD MAPS

HEAT MAPS

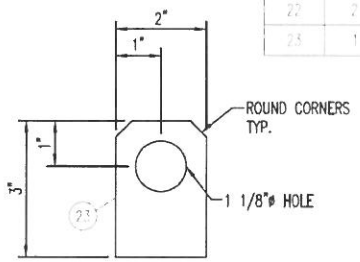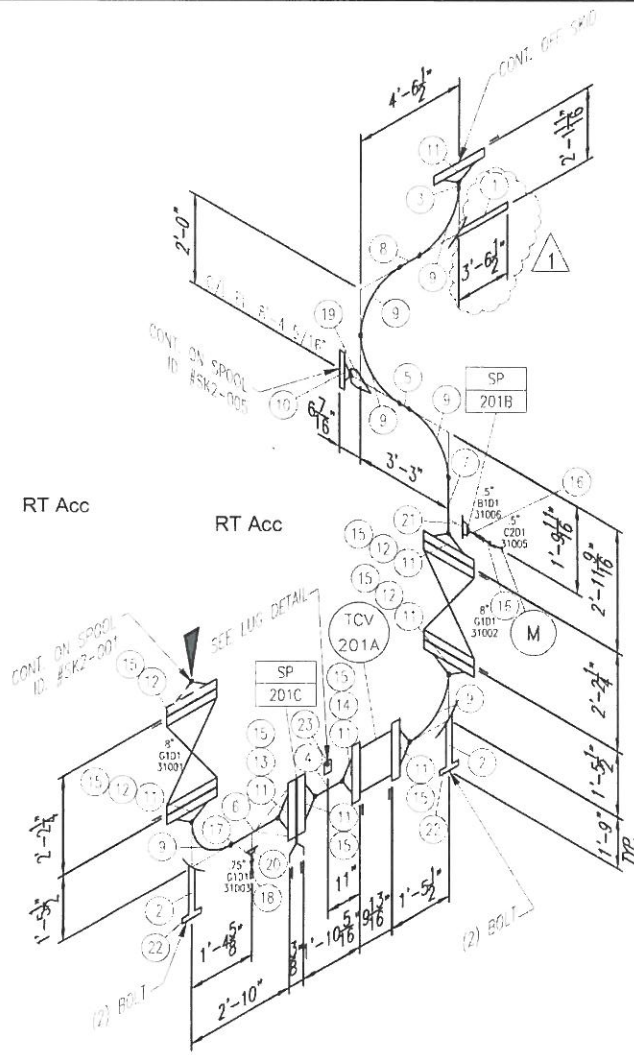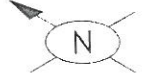

LIFTING LUG DETAIL

BILL OF MATERIAL

| MARK | QTY | SIZE      | DESCRIPTION   | LENGTH     |
|------|-----|-----------|---|------------|
| 1    | 1   | 4"        | PIPE STD SMLS, A-106-B  | 3'-6 1/2"  |
| 2    | 1   | 4"        | PIPE STD SMLS, A-106-B  | 2'-8 1/2"  |
| 3    | 1   | 8"        | PIPE, XH SMLS, A-106-B  | 8 3/16"    |
| 4    | 1   | 8"        | PIPE, XH SMLS, A-106-B  | 11 5/16"   |
| 5    | 1   | 4"        | PIPE, XH SMLS, A-106-B  | 1'-3"      |
| 6    | 1   | 8"        | PIPE, XH SMLS, A-106-B  | 1'-4 1/2"  |
| 7    | 1   | 8"        | PIPE, XH SMLS, A-106-B  | 1'-6 1/16" |
| 8    | 1   | 8"        | PIPE, XH SMLS, A-106-B  | 2'-8 1/2"  |
| 9    | 6   | 8"        | ELL, 90 LR, XH, A-234-WPB   |            |
| 10   | 1   | 2"        | FLG, 600LB XH, A-105  |            |
| 11   | 8   | 8"        | FLG, 600LB XH, A-105  |            |
| 12   | 4   | 1 1/8"    | (12) STUD BOLTS, A-193-B7 w/ TWO HEAVY HEX NUTS, A-194-2H                                   | 7 3/4"     |
| 13   | 1   | 1 1/8"    | (12) STUD BOLTS, A-193-B7 w/ TWO HEAVY HEX NUTS, A-194-2H                                   | 8 1/4"     |
| 14   | 1   | 1 1/8"    | (12) STUD BOLTS, A-193-B7 w/ TWO HEAVY HEX NUTS, A-194-2H                                   | 11'-5 1/2" |
| 15   | 8   | 8"        | GASKET, 1/8" THK, 600LB RF, SPIRALWOUND, 304SS WINDING, FLEXITE SUPER FILLER, CS GUIDE RING |            |
| 16   | 2   | 1/2"      | NIPPLE, S/160 SMLS, A-106-B THE   | 3"         |
| 17   | 1   | 3/4"      | NIPPLE, S/160 SMLS, A-106-B PCE-106   | 3"         |
| 18   | 1   | 3/4"      | PLUG, SOLID STEEL, ROUND HEAD, A-105  |            |
| 19   | 1   | 8"x3"     | EDL, RW, XH, A-105  |            |
| 20   | 1   | 8"x3/4"   | SOL, 3000LB FS, A-105   |            |
| 21   | 1   | 8"x1 1/2" | TOL, 3000LB FS, A-105   |            |
| 22   | 2   |           | BASE PLATE, 1/2" THK x 6" x 6" (SA-36 MATERIAL)   |            |
| 23   | 1   |           | LIFTING LUG, 1/2" THK x 2" x 3" w/ 1 1/8" HOLE (SA-36 MATERIAL)                             |            |

J-488  
08/22/18  
REV

Aug 22, 2018 -- 7:51am Z:\400 - Drafting\001-PROJECTS\488 SC6 RSV\SC6R\DRAWINGS\400-Piping\SPOOLS\IFC\SK2\


|                |            |                |                |     |  |          |     |     |
|----------------|------------|----------------|----------------|-----|--|----------|-----|-----|
| DESIGN PRESS.  | 1100 Psig  | FAB. LOCATION  | SHOP           |     |  |          |     |     |
| DESIGN TEMP.   | 150 °F     | SPOOL LOCATION | SKID #2        |     |  |          |     |     |
| OPER. PRESS.   | 885 Psia   |                |                |     |  |          |     |     |
| OPER. TEMP.    | 76 °F      | CORR. ALLOW.   | .0625"         | 1   | REVISED ITEM 1 TO REACH STRUCTURAL SUPPORT | 8/21/18  | COB | WD  |
| STRESS RELIEVE | NO         | INSULATION     | NONE           | 0   | ISSUE FOR CONSTRUCTION                     | 04/25/11 | PL0 | LH  |
| RADIOGRAPHY    | 15% NORMAL | PAINT          | TRCo SYSTEM #3 | NO. | REVISION                                   | DATE     | BY  | APR |

**CONFIDENTIAL STATEMENT**  
THIS DRAWING IS THE PROPERTY OF THE THOMAS RUSSELL Co. AND IS NOT TO BE USED FOR ANY PURPOSE OTHER THAN THAT FOR WHICH IT IS SPECIFICALLY FURNISHED.


**FABRICATION NOTES:**  
ALL VALVES ARE RAGGED FACE UNLESS NOTED.  
ALL FITTING MAKE-UP & CUT LENGTHS FOR BW PIPE DO NOT INCLUDE WELD CAPS.  
SHOP TO MAKE ADJUSTMENTS FOR WELD CAPS.  
ALL PIPE SEAMLESS UNLESS NOTED OTHERWISE.  
ALL COUPLING TO BE SHOULDER ON.

**Thomas Russell Co.**  
7050 S. Yale, Suite 210  
Tulsa, Oklahoma 74136  
PH: 918-481-5682

|                  |              |
|------------------|--------------|
| LINE No.         | 150-D1-CS-8" |
| ASSEMBLY DRAWING | 488-402      |
| FIELD DRAWING    | 488-231      |
| DRAWN BY         | DV           |
| DATE DRAWN       | 03/21/11     |
| JOB No.          | 488          |
| SPOOL I.D. No.   | SK2-002      |
| REV.             | 1            |

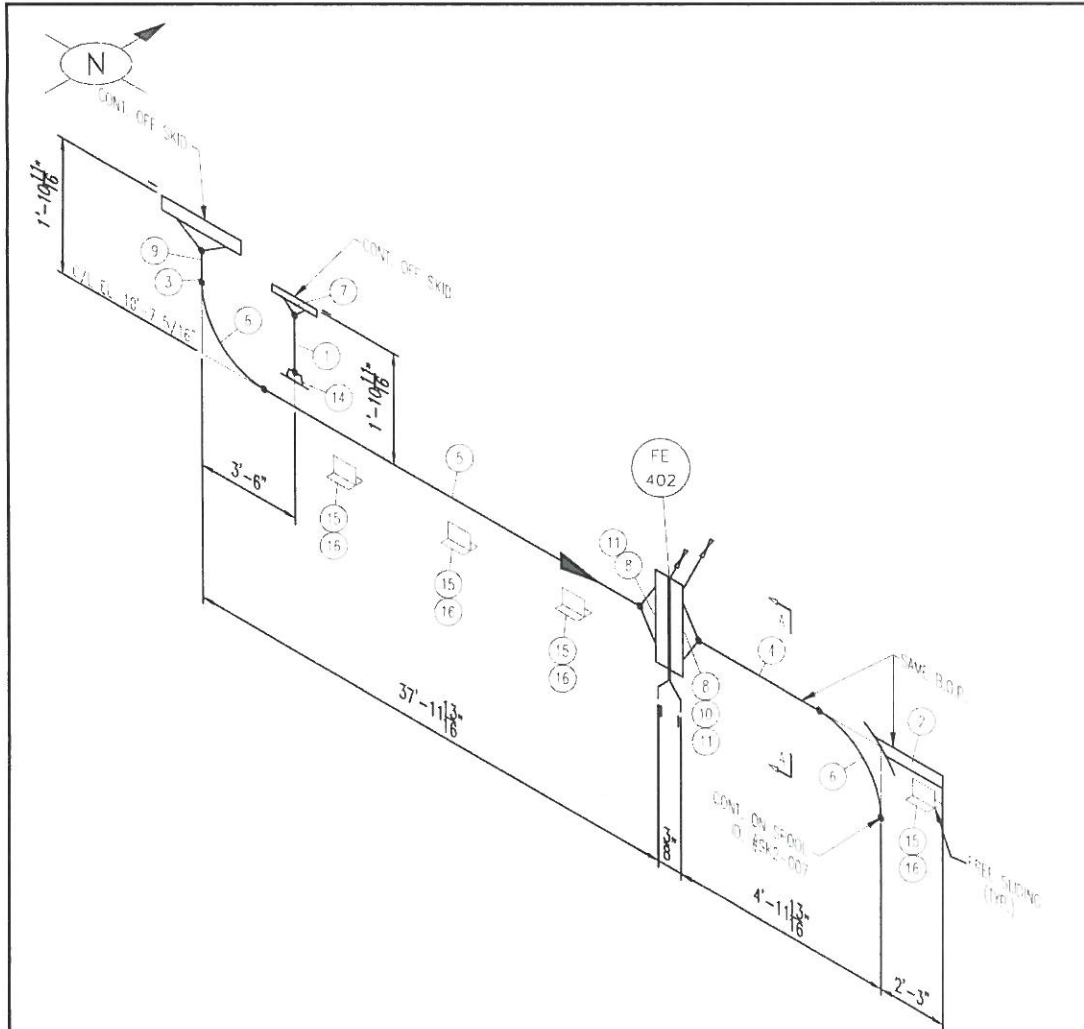

| BILL OF MATERIAL |     |        |   |         |             |
|------------------|-----|--------|---|---------|-------------|
| MARK             | QTY | SIZE   | DESCRIPTION   |         | LENGTH      |
| 1                | 1   | 2"     | PIPE, KH SMLS, A-333-B  | 1144852 | 1'-1 3/4"   |
| 2                | 1   | 2"     | PIPE, STD SMLS, A-333-B   |         | 3'-3"       |
| 3                | 1   | 8"     | PIPE, KH SMLS, A-333-B  | X02753  | 5 1/16"     |
| 4                | 1   | 8"     | PIPE, KH SMLS, A-333-B  | X02753  | 3'-6 5/16"  |
| 5                | 1   | 8"     | PIPE, KH SMLS, A-333-B  | 01531   | 36'-6 5/16" |
| 6                | 2   | 8"     | ELL, 90 LR KH, A-120-WPL8   |         |             |
| 7                | 1   | 2"     | FLG, RWN 600LB KH, A-350-LF2  |         |             |
| 8                | 2   | 8"     | FLG, RWN 600LB ORIFICE KH, A-350-LF2, w/ 1/2" NPT TAP                                       |         |             |
| 9                | 1   | 8"     | FLG, RWN 600LB KH, A-350-LF2  |         |             |
| 10               | 1   | 1 1/8" | (12) STUD BOLTS, A-193-B7 w/ TWO HEAVY HEX NUTS, A-194-2H                                   |         | 8 1/4"      |
| 11               | 2   | 8"     | GASKET, 1/8" THK, 600LB RF, SPIRALWOUND, 304SS WINDING, FLEKITE SUPER FILLER, CS GUIDE RING |         |             |
| 12               | 1   | 1/2"   | NIPPLE, S/160 SMLS, A-333-B TRF   |         | 1"          |
| 13               | 1   | 1/2"   | NIPPLE, S/160 SMLS, A-333-B TRF   |         | 6"          |
| 14               | 1   | 8x2"   | WGL, KH, A-350-LF2  |         |             |
| 15               | 4   |        | PLATE, 1/4" THK, w/ 3/4" x 6" (SA-516-70 MATERIAL)  |         |             |
| 16               | 4   |        | PLATE, 1/4" THK, w/ 6" x 6" (SA-516-70 MATERIAL)  |         |             |

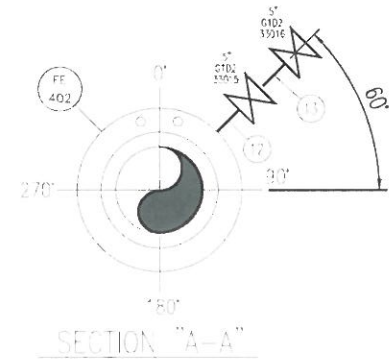

J-488  
04/11/18  
IFC

\*\*\* = JOB #

Apr 10, 2018 - 4:12pm C:\Users\j235418\appdata\local\temp\AcPublish\_236140\


|                |            |                |                |     |                        |          |     |     |
|----------------|------------|----------------|----------------|-----|------------------------|----------|-----|-----|
| DESIGN PRESS.  | 1100 Psig  | FAB. LOCATION  | SHOP           |     |                        |          |     |     |
| DESIGN TEMP.   | 150 °F     | SPOOL LOCATION | SKID #2        |     |                        |          |     |     |
| OPER. PRESS.   | 865 Psia   |                |                |     |                        |          |     |     |
| OPER. TEMP.    | 0 °F       | CORR. ALLOW.   | .0625"         |     |                        |          |     |     |
| STRESS RELIEVE | NO         | INSULATION     | 1.5°C          | 0   | ISSUE FOR CONSTRUCTION | 04/25/11 | PLD | LH  |
| RADIOGRAPHY    | 15% NORMAL | PAINT          | TRCO SYSTEM #3 | NO. | REVISION               | DATE     | BY  | APR |

**CONFIDENTIAL STATEMENT**  
THIS DRAWING IS THE PROPERTY OF THE THOMAS RUSSELL CO. AND IS NOT TO BE USED FOR ANY PURPOSE OTHER THAN THAT FOR WHICH IT IS SPECIFICALLY FURNISHED.


**FABRICATION NOTES:**  
ALL VALUES ARE WELDED FACE UNLESS NOTED.  
ALL FITTING MAKE-UP & CUT LENGTHS FOR BWP PIPE DO NOT INCLUDE WELD CAPS.  
SHOP TO MAKE ADJUSTMENTS FOR WELD CAPS.  
ALL PIPE SEAMLESS UNLESS NOTED OTHERWISE.  
ALL COUPLING TO BE SHOULDER ON.

**Thomas Russell Co.**  
7050 S. Yale, Suite 210  
Tulsa, Oklahoma 74136  
PH: 918-481-5682

|                  |                    |
|------------------|--------------------|
| LINE No.         | 158-D1-LT-8" 1.5°C |
| ASSEMBLY DRAWING | SC6-402            |
| PIED DRAWING     | ***-233 & 234      |
| DRAWN BY         | DV                 |
| DATE DRAWN       | 03/21/11           |
| JOB No.          | SC6                |
| SPOOL ID. No.    | SK2-006            |
| REV.             | 0                  |

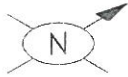

DD-30455 D1-LT  
 WT. = 1550 WT = 0F  
 D.A. = 9" CA = 0625"  
 INSUL. = 2" INSUL. = 1.5"  
 PAINT = NONE PAINT = TRCO SYSTEM #3

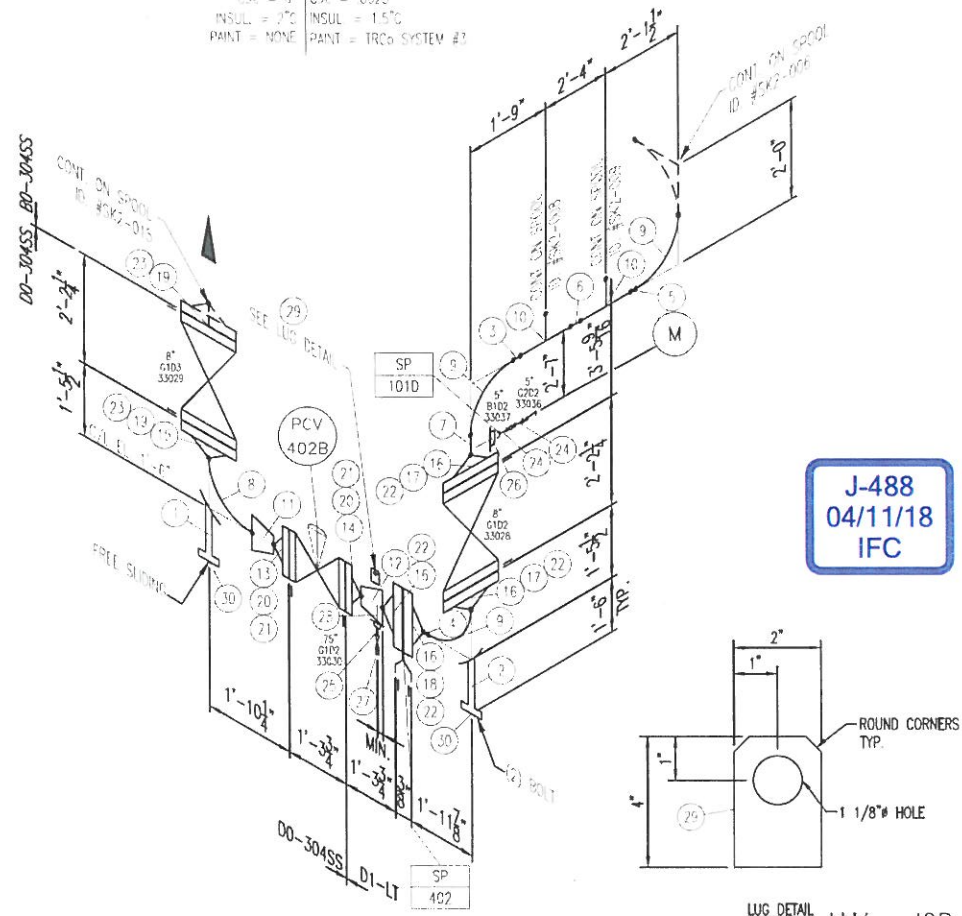

BILL OF MATERIAL

| MARK | QTY | SIZE      | DESCRIPTION   | LENGTH     |
|------|-----|-----------|---|------------|
| 1    | 1   | 4"        | PIPE, S/10S EFW, A-312-TP304/304L   | 2'-5 1/2"  |
| 2    | 1   | 4"        | PIPE, STD SMLS, A-333-F   | 2'-5 1/2"  |
| 3    | 1   | 6"        | PIPE, KH SMLS, A-333-F <b>01531</b>   | 2"         |
| 4    | 1   | 6"        | PIPE, KH SMLS, A-333-F  | 6 3/8"     |
| 5    | 1   | 6"        | PIPE, KH SMLS, A-333-F  | 6 1/2"     |
| 6    | 1   | 6"        | PIPE, KH SMLS, A-333-F  | 1'-9"      |
| 7    | 1   | 6"        | PIPE, KH SMLS, A-333-F  | 2'-0 1/16" |
| 8    | 1   | 8"        | ELL, 90 LR S/80S, A-403-WP307/304L  |            |
| 9    | 3   | 9"        | ELL, 90 LR KH, A-420-WPL6   |            |
| 10   | 2   | 8"x6"     | TEE, REDUCING KH, A-420-WPL6  |            |
| 11   | 1   | 8"x4"     | REDUCER, CONC S/80S x S/40S, A-403-WP304/304L   |            |
| 12   | 1   | 8"x4"     | REDUCER, CONC KH, A-420-WPL6  |            |
| 13   | 1   | 6"        | FLG, FFWN 600LR S/10S, A-182-F304/304L  |            |
| 14   | 1   | 4"        | FLG, FFWN 600LR KH, A-350-LF2   |            |
| 15   | 1   | 6"        | FLG, FFWN 600LR S/80S, A-182-F304/304L  |            |
| 16   | 4   | 6"        | FLG, FFWN 600LR KH, A-350-LF2   |            |
| 17   | 2   | 1 1/8"    | (12) STUD BOLTS, A-193-B7 w/ TWO HEAVY HEX NUTS, A-194-2H                                   | 7 3/4"     |
| 18   | 1   | 1 1/8"    | (12) STUD BOLTS, A-193-B7 w/ TWO HEAVY HEX NUTS, A-194-2H                                   | 8 1/4"     |
| 19   | 2   | 1 1/8"    | (12) STUD BOLTS, A-320-L7 w/ TWO HEAVY HEX NUTS, A-194-7                                    | 7 3/4"     |
| 20   | 2   | 7/8"      | (8) STUD BOLTS, A-320-L7 w/ TWO HEAVY HEX NUTS, A-194-7                                     | 6"         |
| 21   | 2   | 4"        | GASKET, 1/8" THK, 600LR RE, SPIRALWOUND, 304SS WINDING, GRAPHITE FILLER, 304 SS GUIDE RING  |            |
| 22   | 4   | 6"        | GASKET, 1/8" THK, 600LR RE, SPIRALWOUND, 304SS WINDING, FLEXITE SUPER FILLER, SS GUIDE RING |            |
| 23   | 2   | 6"        | GASKET, 1/8" THK, 600LR RE, SPIRALWOUND, 304SS WINDING, GRAPHITE FILLER, 304 SS GUIDE RING  |            |
| 24   | 2   | 1/2"      | NIPPLE, S/160 SMLS, A-333-F TFE   | 3"         |
| 25   | 1   | 3/4"      | NIPPLE, S/160 SMLS, A-333-F POE-TCE   | 3"         |
| 26   | 1   | 2"x1 1/2" | TOOL, 3000LR FS, A-350-LF2  |            |
| 27   | 1   | 1/4"      | PLUG, SOLID STEEL, ROUND HEAD, A-350-LF2  |            |
| 28   | 1   | 8"x3/4"   | SOL, 3000LR FS, A-350-LF2   |            |
| 29   | 1   |           | LIFTING LUG, 1/2" THK x 2" x 4" w/ 1 1/8" HOLE (A-516-70 MATL.)                             |            |
| 30   | 2   |           | BASE PLATE, 1/2" THK x 6" x 6" (SA-36 MATERIAL)   |            |

Apr 10, 2018 - 4:12pm C:\Users\h235418\appdata\local\temp\AcPublish\_236140\

|                |            |                |         |     |                        |          |        |
|----------------|------------|----------------|---------|-----|------------------------|----------|--------|
| DESIGN PRESS.  | 1100 Psig  | FAB. LOCATION  | SHOP    |     |                        |          |        |
| DESIGN TEMP.   | 150 °F     | SPOOL LOCATION | SKID #2 |     |                        |          |        |
| OPER. PRESS.   | 865 Psia   |                |         |     |                        |          |        |
| OPER. TEMP.    | NOTED °F   | CORR. ALLOW.   | NOTED   |     |                        |          |        |
| STRESS RELIEVE | NO         | INSULATION     | NOTED   | 0   | ISSUE FOR CONSTRUCTION | 04/25/11 | PLO LH |
| RADIOGRAPHY    | 15% NORMAL | PAINT          | NOTED   | NO. | REVISION               | DATE     | BY APR |



**CONFIDENTIAL STATEMENT**  
 THIS DRAWING IS THE PROPERTY OF THE THOMAS RUSSELL CO. AND IS NOT TO BE USED FOR ANY PURPOSE OTHER THAN THAT FOR WHICH IT IS SPECIFICALLY FURNISHED.

**FABRICATION NOTES:**  
 ALL VALUES ARE FINISH FACE UNLESS NOTED.  
 ALL FITTING MAKE-UP & CUT LENGTHS FOR RW PIPE DO NOT INCLUDE WELD CAPS.  
 SHOP TO MAKE ADJUSTMENTS FOR WELD CAPS.  
 ALL PIPE SEAMLESS UNLESS NOTED OTHERWISE.  
 ALL COUPLING TO BE SHOULDER ON.

**Thomas Russell Co.**

7050 S. Yale, Suite 210  
 Tulsa, Oklahoma 74136  
 PH: 918-481-5682

|                  |                    |                |          |
|------------------|--------------------|----------------|----------|
| LINE No.         | 164-D1-LT-8" 1.5"C |                |          |
| ASSEMBLY DRAWING | SC6-402            |                |          |
| PRED DRAWING     | ***-233            |                |          |
| DRAWN BY         | DV                 | DATE DRAWN     | 03/21/11 |
| JOB No.          | SC6                | SPOOL LID. No. | SK2-007  |
| REV.             | 0                  |                |          |

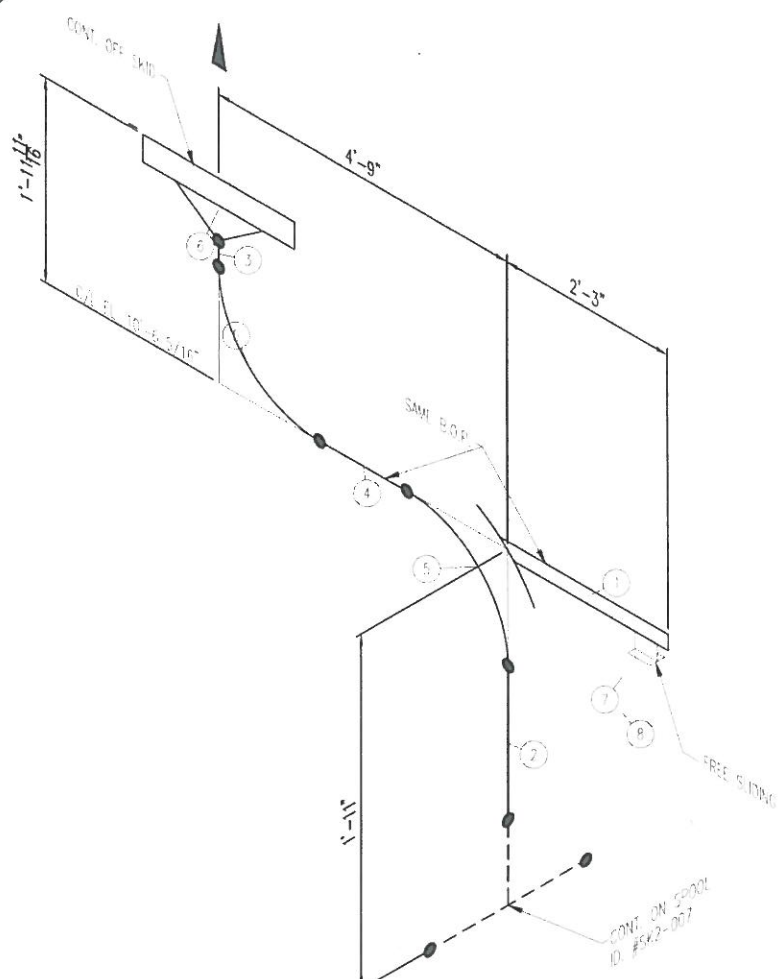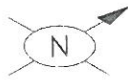

**BILL OF MATERIAL**

| MARK | QTY | SIZE | DESCRIPTION  | LENGTH    |
|------|-----|------|--|-----------|
| 1    | 1   | 3"   | PIPE, STD SMLS, A-333-B                              | 3'-0"     |
| 2    | 1   | 6"   | PIPE, KH SMLS, A-333-B <b>1162655</b>                | 7'-3/8"   |
| 3    | 1   | 6"   | PIPE, KH SMLS, A-333-B <b>1162655</b>                | 3'-13/16" |
| 4    | 1   | 6"   | PIPE, KH SMLS, A-333-B <b>1162655</b>                | 3'-3"     |
| 5    | 2   | 6"   | ELL, 90 LR, KH, A-420-WPL6                           |           |
| 6    | 1   | 6"   | FLG, BFWN 600LB KH, A-350-LF2                        |           |
| 7    | 1   |      | PLATE, 1/4" THK. x 2'-3/4" x 6" (SA-516-70 MATERIAL) |           |
| 8    | 1   |      | PLATE, 1/4" THK. x 6" x 6" (SA-516-70 MATERIAL)      |           |

**J-488**  
**04/11/18**  
**IFC**

\*\*\* = JOB #

Apr 10, 2018 - 4:12pm C:\Users\h235418\appdata\local\temp\AcPublish\_236140\


|                |            |                |                |     |                        |          |     |     |
|----------------|------------|----------------|----------------|-----|------------------------|----------|-----|-----|
| DESIGN PRESS.  | 1100 Psig  | FAB. LOCATION  | SHOP           |     |                        |          |     |     |
| DESIGN TEMP.   | 150 °F     | SPOOL LOCATION | SKID #2        |     |                        |          |     |     |
| OPER. PRESS.   | 865 Psig   |                |                |     |                        |          |     |     |
| OPER. TEMP.    | 0 °F       | CORR. ALLOW.   | .0625"         |     |                        |          |     |     |
| STRESS RELIEVE | NO         | INSULATION     | 1.5°C          | 0   | ISSUE FOR CONSTRUCTION | 04/25/11 | PLO | LH  |
| RADIOGRAPHY    | 15% NORMAL | PAINT          | TRCO SYSTEM #3 | NO. | REVISION               | DATE     | BY  | APR |

**CONFIDENTIAL STATEMENT**  
 THIS DRAWING IS THE PROPERTY OF THE THOMAS RUSSELL CO. AND IS NOT TO BE USED FOR ANY PURPOSE OTHER THAN THAT FOR WHICH IT IS SPECIFICALLY FURNISHED.

**FABRICATION NOTES:**  
 ALL VALUES ARE THREE FACE UNLESS NOTED.  
 ALL FITTING MAKE-UP & CUT LENGTHS FOR BWP PIPE DO NOT INCLUDE WELD CAPS.  
 SHOP TO MAKE ADJUSTMENTS FOR WELD CAPS.  
 ALL PIPE SEAMLESS UNLESS NOTED OTHERWISE.  
 ALL COUPLING TO BE SHOULDER ON.


**Thomas Russell Co.**  
 7050 S. Yale, Suite 210  
 Tulsa, Oklahoma 74136  
 PH: 918-481-5682

|                  |                    |      |  |
|------------------|--------------------|------|--|
| LINE No.         | 162-D1-LT-6" 1.5°C |      |  |
| ASSEMBLY DRAWING | SC6-402            |      |  |
| FIELD DRAWING    | ***-233            |      |  |
| DRAWN BY         | DATE DRAWN         |      |  |
| DV               | 03/21/11           |      |  |
| JOB No.          | SPOOL ID. No.      | REV. |  |
| SC6              | SK2-008            | 0    |  |

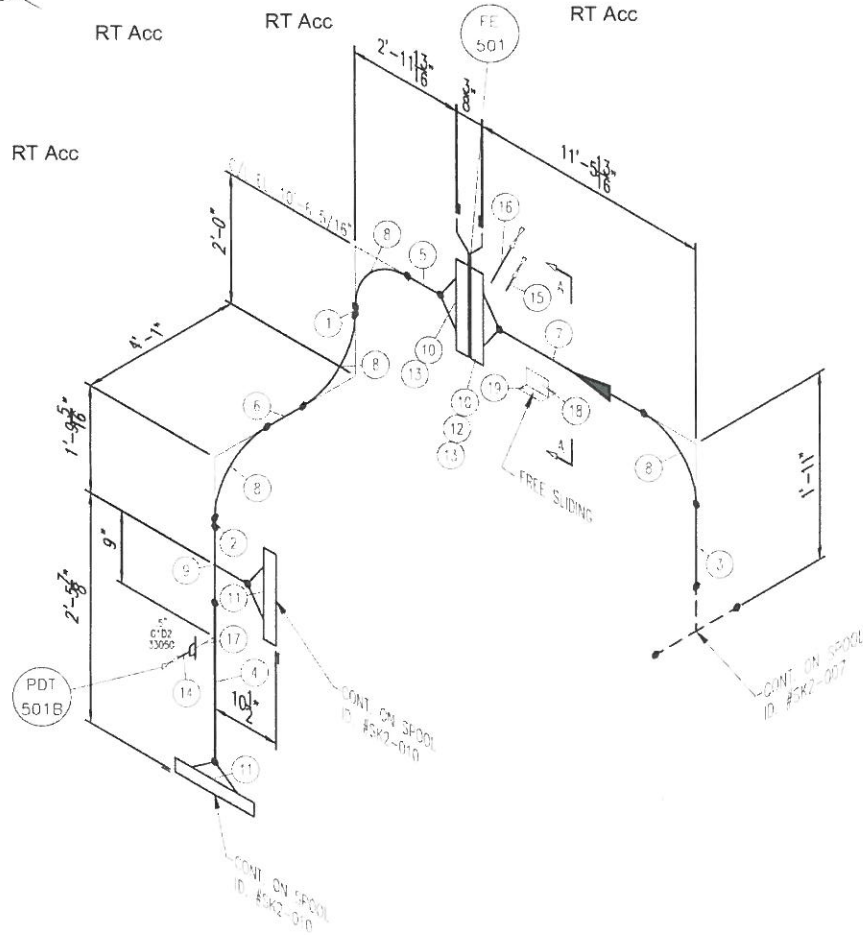

| BILL OF MATERIAL |     |         |   |         |              |
|------------------|-----|---------|---|---------|--------------|
| MATY             | QTY | SIZE    | DESCRIPTION   | LENGTH  |              |
| 1                | 1   | 6"      | PIPE, KH SMLS, A-333-6  | 1162655 | 6"           |
| 2                | 1   | 6"      | PIPE, KH SMLS, A-333-6  |         | 6'-1 1/4"    |
| 3                | 1   | 6"      | PIPE, KH SMLS, A-333-6  |         | 7 3/8"       |
| 4                | 1   | 6"      | PIPE, KH SMLS, A-333-6  |         | 1'-7 3/8"    |
| 5                | 1   | 6"      | PIPE, KH SMLS, A-333-6  |         | 1'-9 15/16"  |
| 6                | 1   | 6"      | PIPE, KH SMLS, A-333-6  |         | 7'-1"        |
| 7                | 1   | 6"      | PIPE, KH SMLS, A-333-6  |         | 10'-3 15/16" |
| 8                | 4   | 6"      | ELL, 90 LR KH, A-420-WPL6   |         |              |
| 9                | 1   | 6"      | TEE, STR, KH, A-420-WPL6  |         |              |
| 10               | 2   | 6"      | FLG, FEWN RODLB BRIDGE KH, A-350-LF2, w/ 1/2" NPT TAPS                                      |         |              |
| 11               | 2   | 6"      | FLG, FEWN RODLB KH, A-350-LF2   |         |              |
| 12               | 1   | 1"      | (12) STUD BOLTS, A-193-R7 w/ TWO HEAVY HEX NUTS, A-194-ZH                                   |         | 7 1/4"       |
| 13               | 2   | 6"      | CASKET, 1/8" THK, RODLB RE, SPIRALWOUND, 304SS WINDING, FLEKITE SUPER FILLER, CS GUIDE RING |         |              |
| 14               | 1   | 1/2"    | NIPPLE, S/160 SMLS, A-333-6 PDE-TOE   |         | 3"           |
| 15               | 1   | 1/2"    | NIPPLE, S/160 SMLS, A-333-6 TPE   |         | 3"           |
| 16               | 1   | 1/2"    | NIPPLE, S/160 SMLS, A-333-6 TPE   |         | 6"           |
| 17               | 1   | 6"x1/2" | SOL, 3000LB FS, A-350-LF2   |         |              |
| 18               | 1   |         | PLATE, 1/4" THK, x 2 3/4" x 6" (SA-516-70 MATERIAL)   |         |              |
| 19               | 1   |         | PLATE, 1/4" THK, x 6" x 6" (SA-516-70 MATERIAL)   |         |              |

J-488  
04/11/18  
IFC

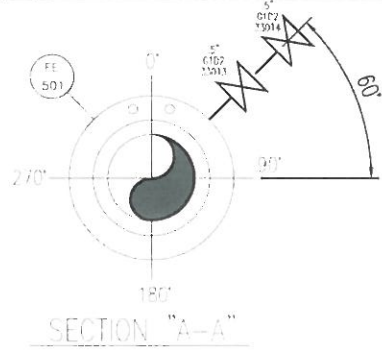

\*\*\* = JOB #

Apr 10, 2018 - 4:12pm C:\Users\h235418\appdata\local\temp\AcPublish\_236140\


|                |            |                |                |     |                        |          |        |
|----------------|------------|----------------|----------------|-----|------------------------|----------|--------|
| DESIGN PRESS.  | 1100 Psig  | FAB. LOCATION  | SHOP           |     |                        |          |        |
| DESIGN TEMP.   | 150 °F     | SPOOL LOCATION | SKID #2        |     |                        |          |        |
| OPER. PRESS.   | 865 Psia   |                |                |     |                        |          |        |
| OPER. TEMP.    | 0 °F       | CORR. ALLOW.   | .0625"         |     |                        |          |        |
| STRESS RELIEVE | NO         | INSULATION     | 1.5°C          | 0   | ISSUE FOR CONSTRUCTION | 04/25/11 | PLO LH |
| RADIOGRAPHY    | 15% NORMAL | PAINT          | TRCO SYSTEM #3 | NO. | REVISION               | DATE     | BY APR |

**CONFIDENTIAL STATEMENT**  
THIS DRAWING IS THE PROPERTY OF THE THOMAS RUSSELL CO. AND IS NOT TO BE USED FOR ANY PURPOSE OTHER THAN THAT FOR WHICH IT IS SPECIALLY FURNISHED.

**FABRICATION NOTES:**  
ALL VALVES ARE RISED FACE UNLESS NOTED.  
ALL FITTING MAKE-UP & CUT LENGTHS FOR BWP PIPE DO NOT INCLUDE WELD GAPS.  
SHOP TO MAKE ADJUSTMENTS FOR WELD GAPS.  
ALL PIPE SEAMLESS UNLESS NOTED OTHERWISE.  
ALL COUPLING TO BE SHOULDER ON.

**Thomas Russell Co.**  
7050 S. Yale, Suite 210  
Tulsa, Oklahoma 74136  
PH: 918-481-5882

|                  |                    |                        |
|------------------|--------------------|------------------------|
| LINE No.         | 159-D1-LT-6" 1.5°C |                        |
| ASSEMBLY DRAWING | SC6-402            |                        |
| PIED DRAWING     | ***-233            |                        |
| DRAWN BY         | DV                 | DATE DRAWN 03/21/11    |
| JOB No.          | SC6                | SPOOL LID. No. SK2-009 |
| REV.             |                    | 0                      |

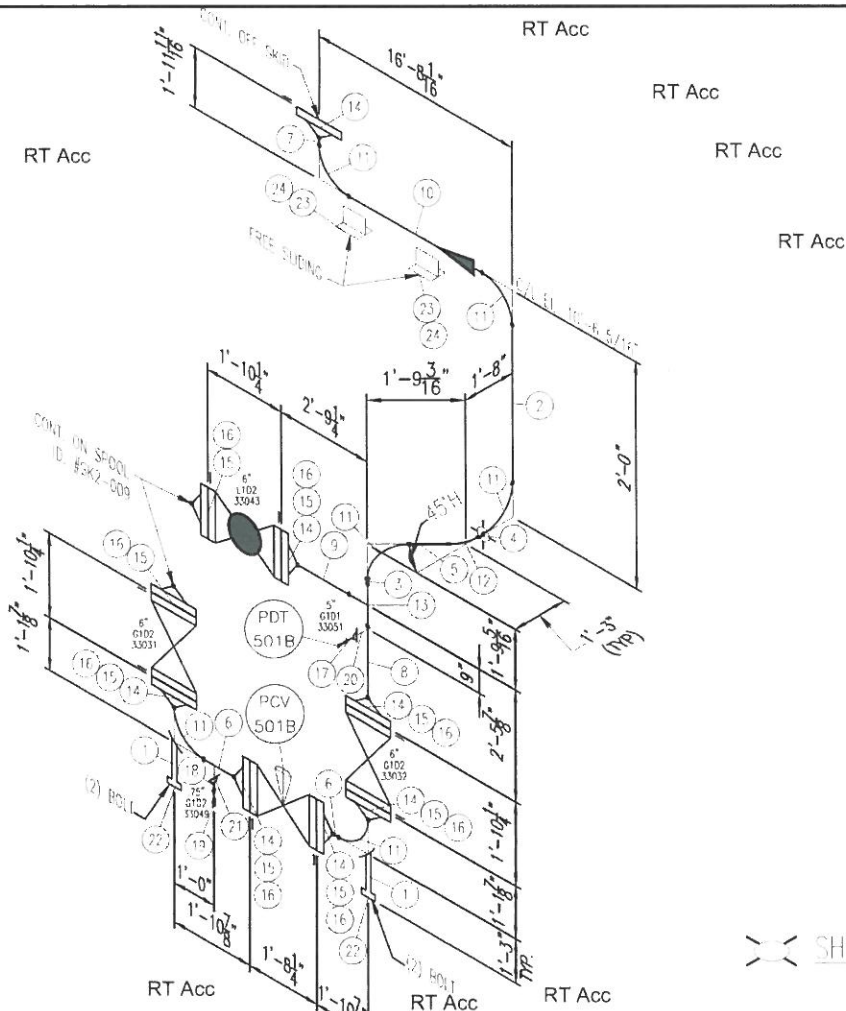

SHOP WELD

BILL OF MATERIAL

| MARK | QTY | SIZE    | DESCRIPTION   | LENGTH      |
|------|-----|---------|---|-------------|
| 1    | 2   | 3"      | PIPE, STD SMLS, A-337-B   | 1'-11 1/2"  |
| 2    | 1   | 6"      | PIPE, XH SMLS, A-337-B <b>1162655</b>   | 6"          |
| 3    | 1   | 6"      | PIPE, XH SMLS, A-337-B  | 6 11/16"    |
| 4    | 1   | 6"      | PIPE, XH SMLS, A-337-B  | 7 1/4"      |
| 5    | 1   | 6"      | PIPE, XH SMLS, A-337-B  | 8 1/16"     |
| 6    | 2   | 6"      | PIPE, XH SMLS, A-337-B  | 3"          |
| 7    | 1   | 6"      | PIPE, XH SMLS, A-337-B  | 9 13/16"    |
| 8    | 1   | 6"      | PIPE, XH SMLS, A-337-B  | 1'-1 3/8"   |
| 9    | 1   | 6"      | PIPE, XH SMLS, A-337-B  | 1'-10 3/4"  |
| 10   | 1   | 6"      | PIPE, XH SMLS, A-337-B  | 15'-2 1/16" |
| 11   | 6   | 6"      | ELL, 90 LR XH, A-420-WPL6   |             |
| 12   | 1   | 6"      | ELL, 45 LR XH, A-420-WPL6   |             |
| 13   | 1   | 6"      | TEE, STR, XH, A-420-WPL6  |             |
| 14   | 2   | 6"      | FLG, RWLN BOOBL XH, A-350-LF2   |             |
| 15   | 8   | 1"      | {12} STD BOLTS, A-194-B7 w/ TWO HEAVY HEX NUTS, A-194-2H                                    | 7"          |
| 16   | 8   | 6"      | GASKET, 1/8" THK, BOOBL RE, SPIRALWOUND, 34SS, WINDING, FLEXITE SUPER FILLER, CS GUIDE RING |             |
| 17   | 1   | 1/2"    | NIPPLE, S/160 SMLS, A-337-B, POE-TOE  | 3"          |
| 18   | 1   | 3/4"    | NIPPLE, S/160 SMLS, A-337-B, POE-TOE  | 3"          |
| 19   | 1   | 3/4"    | PLUG, SOLID STEEL, ROUND HEAD, A-350-LF2  |             |
| 20   | 1   | 6"x1/2" | SOL, 300DLR FS, A-350-LF2   |             |
| 21   | 1   | 6"x3/4" | SOL, 300DLR FS, A-350-LF2   |             |
| 22   | 2   |         | BASE PLATE, 1/2" THK, x 6" x 6" (SA-516 MATERIAL)   |             |
| 23   | 2   |         | PLATE, 1/4" THK, x 2 3/4" x 6" (SA-516-70 MATERIAL)   |             |
| 24   | 2   |         | PLATE, 1/4" THK, x 6" x 6" (SA-516-70 MATERIAL)   |             |

J-488  
04/11/18  
IFC

\*\*\* = JOB #

Apr 10, 2018 - 4:12pm Z:\400 - Drafting\001-PROJECTS\488 SC6 RSV\SC6R\DRAWINGS\400-Piping\SPHOOLS\FIC\SK2\


|                |            |                |                |     |                        |          |        |
|----------------|------------|----------------|----------------|-----|------------------------|----------|--------|
| DESIGN PRESS.  | 1100 Psig  | FAB. LOCATION  | SHOP           |     |                        |          |        |
| DESIGN TEMP.   | 150 °F     | SPOOL LOCATION | SKID #2        |     |                        |          |        |
| OPER. PRESS.   | 865 Psia   |                |                |     |                        |          |        |
| OPER. TEMP.    | 0 °F       | CORR. ALLOW.   | .0625"         |     |                        |          |        |
| STRESS RELIEVE | NO         | INSULATION     | 1.5°C          | 0   | ISSUE FOR CONSTRUCTION | 04/25/11 | PLO LH |
| RADIOGRAPHY    | 15% NORMAL | PAINT          | TRCO SYSTEM #3 | NO. | REVISION               | DATE     | BY     |

**CONFIDENTIAL STATEMENT**  
THIS DRAWING IS THE PROPERTY OF THE THOMAS RUSSELL CO. AND IS NOT TO BE USED FOR ANY PURPOSE OTHER THAN THAT FOR WHICH IT IS SPECIFICALLY FURNISHED.

**FABRICATION NOTES:**  
ALL VALUES ARE TABS FACE UNLESS NOTED.  
ALL FITTING MAKE-UP & CUT LENGTHS FOR BWP PIPE DO NOT INCLUDE WELD GAPS.  
SHOP TO MAKE ADJUSTMENTS FOR WELD GAPS.  
ALL PIPE SEAMLESS UNLESS NOTED OTHERWISE.  
ALL COUPLING TO BE SHOULDER ON.

**Thomas Russell Co.**  
7050 S. Yale, Suite 210  
Tulsa, Oklahoma 74136  
PH: 918-481-5682

|                  |                    |
|------------------|--------------------|
| LINE No.         | 159-D1-LT-6" 1.5°C |
| ASSEMBLY DRAWING | SC6-402            |
| PICED DRAWING    | ***-233            |
| DRAWN BY         | DV                 |
| DATE DRAWN       | 03/21/11           |
| JOB No.          | SC6                |
| SPOOL ID. No.    | SK2-010            |
| REV.             | 0                  |

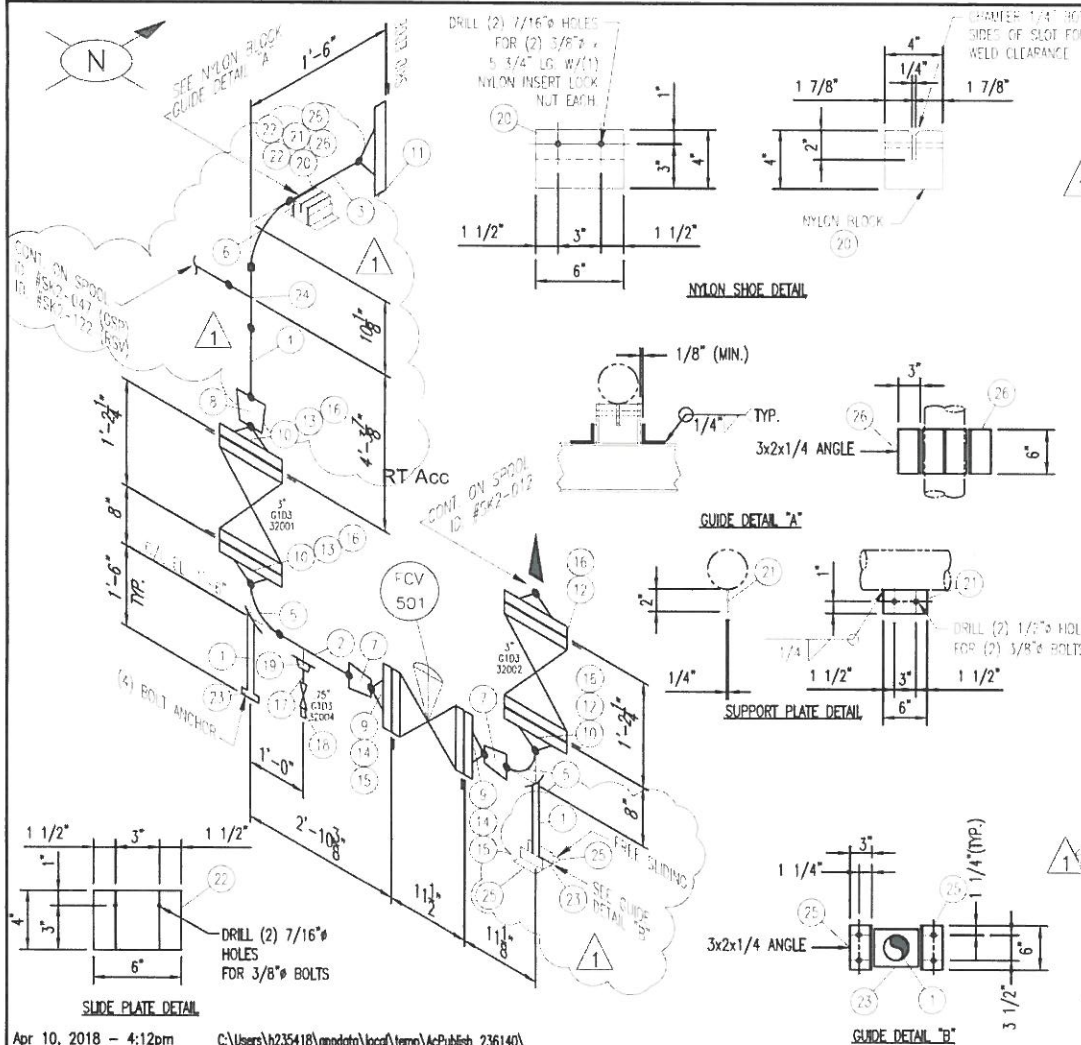

| BILL OF MATERIAL |     |         |   |              |            |
|------------------|-----|---------|---|--------------|------------|
| MARK             | QTY | SIZE    | DESCRIPTION   |              | LENGTH     |
| 1                | 2   | 2"      | PIPE, S/405 EFW, A-312-TP304/304L   |              | 1'-10"     |
| 2                | 1   | 3"      | PIPE, S/405 (FW), A-312-TP304/304L  | 475B-2483451 | 1'-11 1/8" |
| 3                | 1   | 4"      | PIPE, S/405 (FW), A-312-TP304/304L  | 049N         | 7 3/4"     |
| 4                | 1   | 4"      | PIPE, S/405 EFW, A-312-TP304/304L   | 049N         | 3'-4 1/4"  |
| 5                | 2   | 3"      | ELL, 90 LR S/405, A-403-WP304/304L  |              |            |
| 6                | 1   | 4"      | ELL, 90 LR S/405, A-403-WP304/304L  |              |            |
| 7                | 2   | 3'-2"   | REDUCER, CONC S/405, A-403-WP304/304L   |              |            |
| 8                | 1   | 4'-3"   | REDUCER, CONC S/405, A-403-WP304/304L   |              |            |
| 9                | 2   | 2"      | FLG, PFWN RODLH S/405, A-182-F304/304L  |              |            |
| 10               | 2   | 3"      | FLG, PFWN RODLH S/405, A-182-F304/304L  |              |            |
| 11               | 1   | 4"      | FLG, PFWN RODLH S/405, A-182-F304/304L  |              |            |
| 12               | 2   | 3/4"    | (B) STD BOLTS, A-193-BB w/ TWO HEAVY HEX NUTS, A-194-BB                                   |              | 5 1/4"     |
| 13               | 2   | 3/4"    | (B) STD BOLTS, A-193-BB w/ TWO HEAVY HEX NUTS, A-194-BB                                   |              | 5 1/4"     |
| 14               | 2   | 5/8"    | (B) STD BOLTS, A-193-BB w/ TWO HEAVY HEX NUTS, A-194-BB                                   |              | 4 1/2"     |
| 15               | 2   | 2"      | GASKET, 1/8" THK, 600L RE, SPIRALWOUND, 304SS WINDING, GRAPHITE FILLER, 304 SS GUIDE RING |              |            |
| 16               | 4   | 3"      | GASKET, 1/8" THK, 600L RE, SPIRALWOUND, 304SS WINDING, GRAPHITE FILLER, 304 SS GUIDE RING |              |            |
| 17               | 1   | 3/4"    | INFLUE, S/405 EFW, A-312-TP304/304L PGE-TPE   |              | 3"         |
| 18               | 1   | 3/4"    | PLUG, SOLID STEEL, ROUND HEAD, A-182-F304/304L  |              |            |
| 19               | 1   | 2"x3/4" | SOL, 3000LB FS, A-182-F304/304L   |              |            |
| 20               | 1   |         | NYLON BLOCK, 4" x 4" x 4" LG  |              |            |
| 21               | 1   |         | PLATE, 1/4" THK x 2" x 6" LG A-240-304SS (PER DETAIL)                                     |              |            |
| 22               | 2   |         | PLATE, 1/4" THK x 4" x 6" LG A-240-304SS (PER DETAIL)                                     |              |            |
| 23               | 2   |         | BASE PLATE, 1/2" THK x 5" x 5" (A-36 MATERIAL)  |              |            |
| 24               | 1   | 4'-2"   | TEE, RED S/405, A-403-WP304/304L  |              |            |
| 25               | 2   |         | ANGLE 3" x 2" x 1/4" x 6' LG A-36 (DRILL PER DETAIL)                                      |              |            |
| 26               | 2   |         | ANGLE 3" x 2" x 1/4" x 6' LG A-36   |              |            |

J-488  
04/11/18  
IFC

\*\*\* = JOB #

Apr 10, 2018 - 4:12pm C:\Users\h235418\appdata\local\temp\AcPublish\_236140\



| DESIGN         | PRESS.     | 1100 Psig | FAB. LOCATION  | SHOP    |     |                        |          |     |     |
|----------------|------------|-----------|----------------|---------|-----|------------------------|----------|-----|-----|
| DESIGN         | TEMP.      | 150 °F    | SPOOL LOCATION | SKID #2 |     |                        |          |     |     |
| OPER.          | PRESS.     | 860 Psia  |                |         |     |                        |          |     |     |
| OPER.          | TEMP.      | -102 °F   | CORR. ALLOW.   | 0"      | 1   | REVISED AS NOTED       | 10/03/13 | MSD | KK  |
| STRESS RELIEVE | NO         |           | INSULATION     | 2.5 °C  | 0   | ISSUE FOR CONSTRUCTION | 04/25/11 | PLO | LH  |
| RADIOGRAPHY    | 15% NORMAL |           | PAINT          | NONE    | NO. | REVISION               | DATE     | BY  | APR |

**CONFIDENTIAL STATEMENT**  
THIS DRAWING IS THE PROPERTY OF THE THOMAS RUSSELL CO. AND IS NOT TO BE USED FOR ANY PURPOSE OTHER THAN THAT FOR WHICH IT IS SPECIFICALLY FURNISHED.

**FABRICATION NOTES:**  
ALL VALUES ARE TYPED FACE UNLESS NOTED.  
ALL ITEMS HAVE-UP & CUT LENGTHS FOR BWP PIPE DO NOT INCLUDE WELD GAPS.  
SHOP TO MAKE ADJUSTMENTS FOR WELD GAPS.  
ALL PIPE SEAMLESS UNLESS NOTED OTHERWISE.  
ALL COUPLING TO BE SHOULDER ON.

**Thomas Russell Co.**  
7050 S. Yale, Suite 210  
Tulsa, Oklahoma 74136  
PH: 918-481-5662

|                  |                       |                        |
|------------------|-----------------------|------------------------|
| LINE No.         | 160-00-304SS-4" 2.5°C |                        |
| ASSEMBLY DRAWING | SC6-402               |                        |
| PIED DRAWING     | ***-232               |                        |
| DRAWN BY         | DV                    | DATE DRAWN 03/21/11    |
| JOB No.          | SC6                   | SPOOL LID. No. SK2-011 |
| REV.             |                       | 1                      |

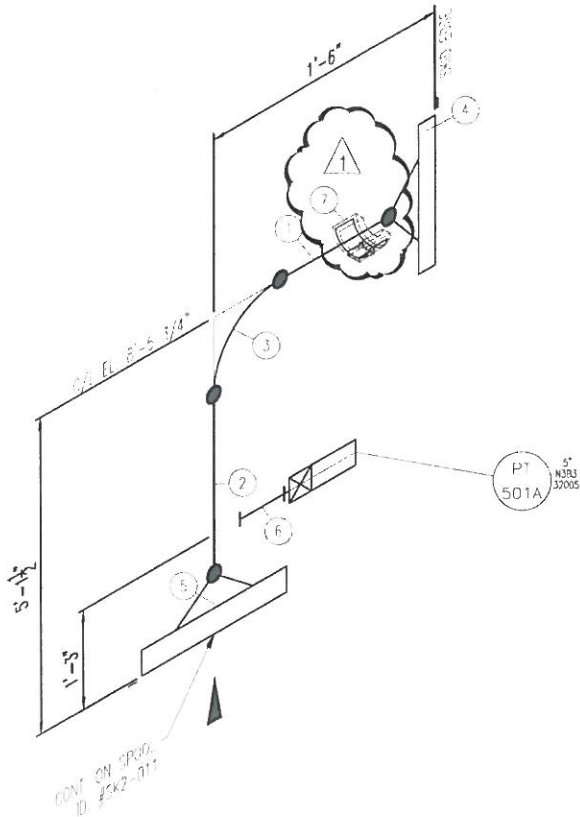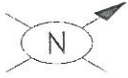

BILL OF MATERIAL

| MARK | QTY | SIZE | DESCRIPTION                                    | LENGTH     |
|------|-----|------|--|------------|
| 1    | 1   | 3"   | PIPE, 5/10S EFW, A-312-TR304/304L 232R         | 10' 3/8"   |
| 2    | 1   | 3"   | PIPE, 5/10S EFW, A-312-TR304/304L 232R         | 4'-5' 1/2" |
| 3    | 1   | 3"   | ELL, 90 DEG, 5/10S, A-401-WP304/304L           |            |
| 4    | 1   | 3"   | FLG, REWN, 300LB 5/10S, A-182-F304/304L        |            |
| 5    | 1   | 3"   | FLG, REWN, 600LB 5/10S, A-182-F304/304L        |            |
| 6    | 1   | 1/2" | CPLG, TRF x 3" LG., 3000LB FS, A-182-F304/304L |            |
| 7    | 1   | 3"   | TYPE 3 SUPPORT PER ENG-1404, 2.5" INSUL.       |            |



J-488  
04/11/18  
IFC

\*\*\* = JOB #

Apr 10, 2018 - 4:12pm C:\Users\h235418\appdata\local\temp\AcPublish\_236140\


|                |            |                |         |     |                        |          |     |     |
|----------------|------------|----------------|---------|-----|------------------------|----------|-----|-----|
| DESIGN PRESS.  | 400 Psig   | FAB. LOCATION  | SHOP    |     |                        |          |     |     |
| DESIGN TEMP.   | 150°F      | SPOOL LOCATION | SKID #2 |     |                        |          |     |     |
| OPER. PRESS.   | 220 Psia   |                |         |     |                        |          |     |     |
| OPER. TEMP.    | -160°F     | CORR. ALLOW.   | 0"      | 1   | ADDED ITEM #7          | 05/26/11 | PLO | LH  |
| STRESS RELIEVE | NO         | INSULATION     | 2.5°C   | 0   | ISSUE FOR CONSTRUCTION | 04/25/11 | PLO | LH  |
| RADIOGRAPHY    | 15% NORMAL | PAINT          | NONE    | NO. | REVISION               | DATE     | BY  | APR |

**CONFIDENTIAL STATEMENT**  
THIS DRAWING IS THE PROPERTY OF THE THOMAS RUSSELL Co. AND IS NOT TO BE USED FOR ANY PURPOSE OTHER THAN THAT FOR WHICH IT IS SPECIFICALLY FURNISHED.


**FABRICATION NOTES:**  
ALL WELDS ARE RASSED FACE UNLESS NOTED.  
ALL FITTING MAKE-UP & CUT LENGTHS FOR BW PIPE DO NOT INCLUDE WELD GAPS.  
SHOP TO MAKE ADJUSTMENTS FOR WELD GAPS.  
ALL PIPE SEAMLESS UNLESS NOTED OTHERWISE.  
ALL COUPLING TO BE SHOULDER ON.

**Thomas Russell Co.**  
7050 S. Yale, Suite 210  
Tulsa, Oklahoma 74136  
PH: 918-481-5682

|                  |                       |                |          |
|------------------|-----------------------|----------------|----------|
| LINE No.         | 161-B0-304SS-3" 2.5°C |                |          |
| ASSEMBLY DRAWING | SC6-402               |                |          |
| PICED DRAWING    | ***-232               |                |          |
| DRAWN BY         | DV                    | DATE DRAWN     | 03/21/11 |
| JOB No.          | SC6                   | SPOOL I.D. No. | SK2-012  |
| REV.             |                       |                | 1        |

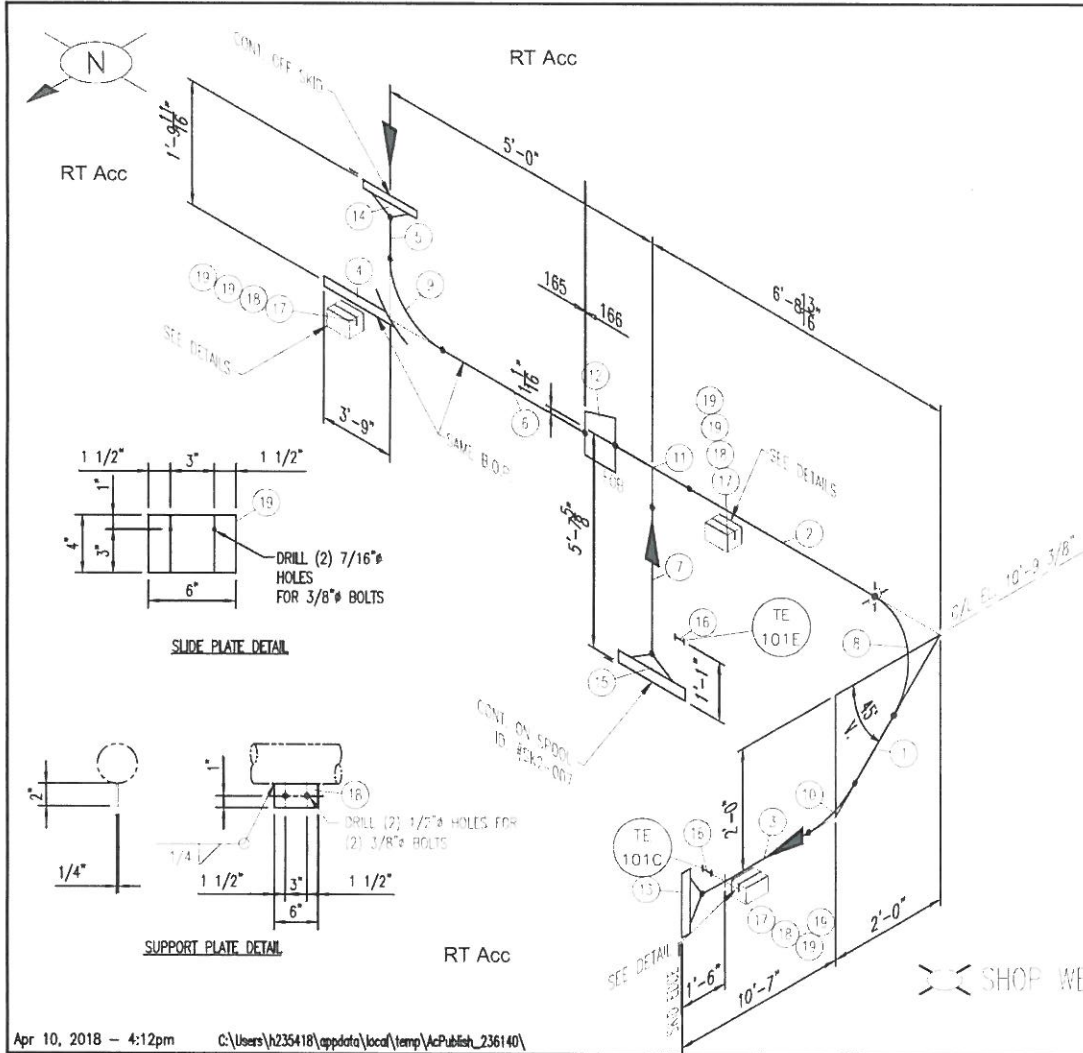

| BILL OF MATERIAL |     |        |   |                |  |             |
|------------------|-----|--------|---|----------------|--|-------------|
| MARK             | QTY | SIZE   | DESCRIPTION   |                |  | LENGTH      |
| 1                | 1   | 10"    | PIPE, S/40S EFW, A-312-TP304/304L                     | 119E           |  | 1'-0 11/16" |
| 2                | 1   | 10"    | PIPE, S/40S EFW, A-312-TP304/304L                     | 119E           |  | 4'-8 5/16"  |
| 3                | 1   | 10"    | PIPE, S/40S EFW, A-312-TP304/304L                     | 119E           |  | 4'-8 1/8"   |
| 4                | 1   | 4"     | PIPE, S/10S EFW, A-312-TP304/304L                     |                |  | 4'-0"       |
| 5                | 1   | 8"     | PIPE, S/40S EFW, A-312-TP304/304L                     | 516113-2404716 |  | 5'-5/16"    |
| 6                | 1   | 8"     | PIPE, S/40S EFW, A-312-TP304/304L                     |                |  | 2'-8 1/2"   |
| 7                | 1   | 8"     | PIPE, S/40S EFW, A-312-TP304/304L                     |                |  | 4'-6 1/8"   |
| 8                | 1   | 10"    | ELL, 90 LR S/40S, A-403-WP304/304L                    |                |  |             |
| 9                | 1   | 8"     | ELL, 90 LR S/40S, A-403-WP304/304L                    |                |  |             |
| 10               | 1   | 10"    | ELL, 45 LR S/40S, A-403-WP304/304L                    |                |  |             |
| 11               | 1   | 10"x8" | TEE, RED S/40S, A-403-WP304/304L                      |                |  |             |
| 12               | 1   | 10"x8" | REDUCER, EGG S/40S, A-403-WP304/304L                  |                |  |             |
| 14               | 1   | 8"     | FLG, RWWN 300LB S/40S, A-182-F304/304L                |                |  |             |
| 15               | 1   | 8"     | FLG, RWWN 300LB S/40S, A-182-F304/304L                |                |  |             |
| 16               | 2   | 3/4"   | ORLG, TOE x 3" LG, 3000LB FS, A-182-F404/304L         |                |  |             |
| 17               | 3   |        | NYLON BLOCK, 4" x 4" x 6" LG                          |                |  |             |
| 18               | 3   |        | PLATE, 1/4" THK x 2" x 6" LG A-240-304SS (PER DETAIL) |                |  |             |
| 19               | 6   |        | PLATE, 1/4" THK x 4" x 6" LG A-240-304SS (PER DETAIL) |                |  |             |

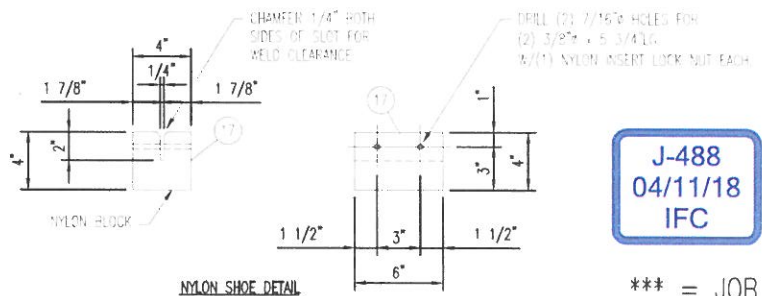

**J-488**  
**04/11/18**  
**IFC**

Apr 10, 2018 - 4:12pm C:\Users\A235418\appdata\local\temp\AcPublish\_236140\



|                |            |                |         |     |                        |          |     |     |
|----------------|------------|----------------|---------|-----|------------------------|----------|-----|-----|
| DESIGN PRESS.  | 400 Psig   | FAB. LOCATION  | SHOP    |     |                        |          |     |     |
| DESIGN TEMP.   | 150 °F     | SPOOL LOCATION | SKID #2 |     |                        |          |     |     |
| OPER. PRESS.   | 220 Psia   |                |         |     |                        |          |     |     |
| OPER. TEMP.    | -83 °F     | CORR. ALLOW.   | 0"      |     |                        |          |     |     |
| STRESS RELIEVE | NO         | INSULATION     | 2.5°C   | 0   | ISSUE FOR CONSTRUCTION | 04/25/11 | PL0 | LH  |
| RADIOGRAPHY    | 15% NORMAL | PAINT          | NONE    | NO. | REVISION               | DATE     | BY  | APR |

**CONFIDENTIAL STATEMENT**  
 THIS DRAWING IS THE PROPERTY OF THE THOMAS RUSSELL CO. AND IS NOT TO BE USED FOR ANY PURPOSE OTHER THAN THAT FOR WHICH IT IS SPECIFICALLY FURNISHED.

**FABRICATION NOTES:**  
 ALL VALUES ARE TOLERANCE UNLESS NOTED.  
 ALL WELDING MAKE-UP & CUT LENGTHS FOR THE PIPE DO NOT INCLUDE WELD GAPS.  
 SHOP TO MAKE ADJUSTMENTS FOR WELD GAPS.  
 ALL PIPE SEAMLESS UNLESS NOTED OTHERWISE.  
 ALL COUPLING TO BE SHOULDER ON.

**Thomas Russell Co.**  
 7050 S. Yale, Suite 210  
 Tulsa, Oklahoma 74136  
 PH: 918-481-5662

|                  |                        |                        |
|------------------|------------------------|------------------------|
| LINE No.         | 166-B0-304SS-10" 2.5°C |                        |
| ASSEMBLY DRAWING | SC6-402                |                        |
| PIED DRAWING     | ***-233                |                        |
| DRAWN BY         | DV                     | DATE DRAWN 03/21/11    |
| JOB No.          | SC6                    | SPOOL LID. No. SK2-015 |
| REV.             |                        | 0                      |

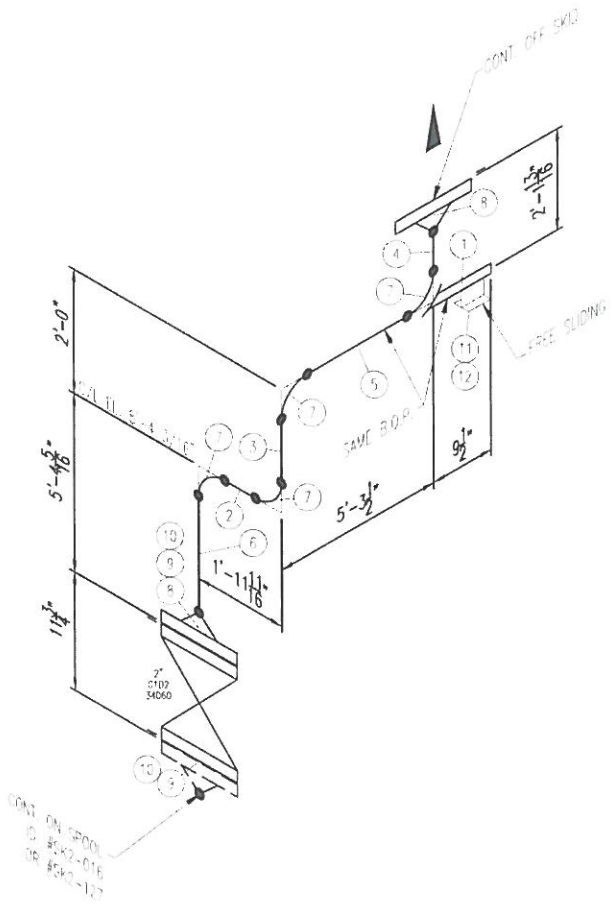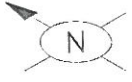

BILL OF MATERIAL

| MARK | QTY | SIZE   | DESCRIPTION  | LENGTH      |
|------|-----|--------|--|-------------|
| 1    | 1   | 1 1/2" | PIPE, KH, SMLS, A-333-E  | 1'-0 1/2"   |
| 2    | 1   | 2"     | PIPE, KH, SMLS, A-333-E BBE 1144852  | 1'-5 11/16" |
| 3    | 1   | 2"     | PIPE, KH, SMLS, A-333-E BBE  | 1'-6"       |
| 4    | 1   | 2"     | PIPE, KH, SMLS, A-333-E BBE  | 1'-7 11/16" |
| 5    | 1   | 2"     | PIPE, KH, SMLS, A-333-E BBE  | 4'-0 1/2"   |
| 6    | 1   | 2"     | PIPE, KH, SMLS, A-333-E BBE  | 4'-10 3/16" |
| 7    | 4   | 2"     | ELL. RD. 15° KH, A-420-WELG  |             |
| 8    | 2   | 2"     | FLG. REWN 60DLB KH, A-350-LF2  |             |
| 9    | 2   | 5/8"   | (8) STD. BOLTS, A-194-B7 w/ TWO HEAVY HEX NUTS, A-194-2H, ZINC PLATED  | 4'-1/2"     |
| 10   | 2   | 2"     | GASKET, 1/8" THK, 60DLB RE, SPIRALWOUND, BRASS WINDING, FLEXITE SUPER FILLER, US CHDGE RING (YELLOW W/PINK STRIPE) |             |
| 11   | 1   |        | PLATE, 1/4" THK x 2 3/4" x 6" LG A-516-70  |             |
| 12   | 1   |        | PLATE, 1/4" THK x 6" x 6" LG A-516-70  |             |

**J-488**  
 04/11/18  
 IFC

\*\*\* = JOB #

Apr 10, 2018 - 4:12pm C:\Users\j235418\appdata\local\temp\AcPublish\_236140\

|                |            |                |                            |     |                        |          |     |     |
|----------------|------------|----------------|----------------------------|-----|------------------------|----------|-----|-----|
| DESIGN PRESS.  | 1100 Psig  | FAB. LOCATION  | SHOP                       |     |                        |          |     |     |
| DESIGN TEMP.   | 150 °F     | SPOOL LOCATION | SKID #2                    |     |                        |          |     |     |
| OPER. PRESS.   | 863 Psia   |                |                            |     |                        |          |     |     |
| OPER. TEMP.    | -28 °F     | CORR. ALLOW.   | .0625"                     |     |                        |          |     |     |
| STRESS RELIEVE | NO         | INSULATION     | 1.5°C                      | 0   | ISSUE FOR CONSTRUCTION | 04/25/11 | PLO | LH  |
| RADIOGRAPHY    | 15% NORMAL | PAINT          | TRC <sub>o</sub> SYSTEM #3 | NO. | REVISION               | DATE     | BY  | APR |



**CONFIDENTIAL STATEMENT**  
 THIS DRAWING IS THE PROPERTY OF THE THOMAS RUSSELL CO. AND IS NOT TO BE USED FOR ANY PURPOSE OTHER THAN THAT FOR WHICH IT IS SPECIFICALLY FURNISHED.

**FABRICATION NOTES:**  
 ALL VALVES ARE INGED FACE UNLESS NOTED.  
 ALL FITTING MAKE-UP & CUT LENGTHS FOR BIV PIPE DO NOT INCLUDE WELD GAPS.  
 SHOP TO MAKE ADJUSTMENTS FOR WELD GAPS.  
 ALL PIPE SEAMLESS UNLESS NOTED OTHERWISE.  
 ALL COUPLING TO BE SKIDDED ON.

Thomas Russell Co.

7050 S. Yale, Suite 210  
Tulsa, Oklahoma 74136  
PH: 918-481-5882

|                  |                    |               |         |
|------------------|--------------------|---------------|---------|
| LINE No.         | 173-D1-LT-2" 1.5°C |               |         |
| ASSEMBLY DRAWING | SC6R-402           |               |         |
| FIELD DRAWING    | ***-234            |               |         |
| DRAWN BY         | COB                | DATE DRAWN    | 1/12/18 |
| JOB No.          | 488                | SPOOL LD. No. | SK2-017 |
| REV.             |                    |               | 1       |

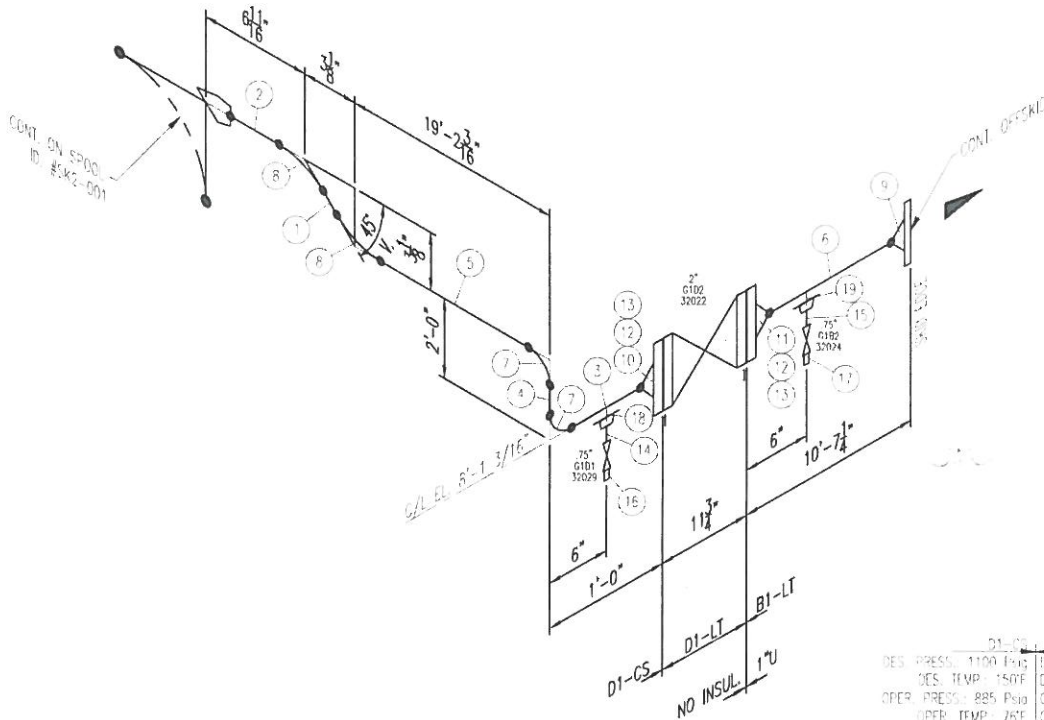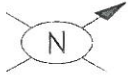

| BILL OF MATERIAL |     |         |   |         |              |  |
|------------------|-----|---------|---|---------|--------------|--|
| MARK             | QTY | SIZE    | DESCRIPTION   |         | LENGTH       |  |
| 1                | 1   | 2"      | PIPE, KH SMLS, A-106-B  | D04408  | 111/16"      |  |
| 2                | 1   | 2"      | PIPE, KH SMLS, A-106-B  |         | 3"           |  |
| 3                | 1   | 2"      | PIPE, KH SMLS, A-106-B  |         | 5 7/8"       |  |
| 4                | 1   | 2"      | PIPE, KH SMLS, A-106-B  |         | 1'-6"        |  |
| 5                | 1   | 2"      | PIPE, KH SMLS, A-106-B  |         | 18'-9 13/16" |  |
| 6                | 1   | 2"      | PIPE, KH SMLS, A-333-B  | 1144852 | 10'-1 3/8"   |  |
| 7                | 2   | 2"      | ELL, 90 LR KH, A-234-WPB  |         |              |  |
| 8                | 2   | 2"      | ELL, 45 LR KH, A-234-WPB  |         |              |  |
| 9                | 1   | 2"      | FLG, RFWN 300LB KH, A-350-LF2   |         |              |  |
| 10               | 1   | 2"      | FLG, RFWN 600LB KH, A-105   |         |              |  |
| 11               | 1   | 2"      | FLG, RFWN 600LB KH, A-350-LF2   |         |              |  |
| 12               | 2   | 5/8"    | (R) STUD BOLTS, A-193-B7 w/ TWO HEAVY HEX NUTS, A-104-2H                                    |         | 4 1/2"       |  |
| 13               | 2   | 2"      | CASKET, 1/8" THK, 600LB RF, SPIRALWOUND, 304SS WINDING, FLEXITE SUPER FILLER, CS GUIDE RING |         |              |  |
| 14               | 1   | 3/4"    | NIPPLE, S/160 SMLS, A-106-B PDE-TOE   |         | 3"           |  |
| 15               | 1   | 3/4"    | NIPPLE, KH SMLS, A-333-B PDE-TOE  |         | 3"           |  |
| 16               | 1   | 3/4"    | PLUG, SOLID STEEL, ROUND HEAD, A-105  |         |              |  |
| 17               | 1   | 3/4"    | PLUG, SOLID STEEL, ROUND HEAD, A-350-LF2  |         |              |  |
| 18               | 1   | 2"x3/4" | SOL, 3000LB FS, A-105   |         |              |  |
| 19               | 1   | 2"x3/4" | SOL, 3000LB FS, A-350-LF2   |         |              |  |

| D1-CS                  | D1-LT                  | B1-LT                  |
|------------------------|------------------------|------------------------|
| DES. PRESS.: 1100 Psig | DES. PRESS.: 1100 Psig | DES. PRESS.: 400 Psig  |
| DES. TEMP.: 150°F      | DES. TEMP.: 150°F      | DES. TEMP.: 200°F      |
| OPER. PRESS.: 885 Psig | OPER. PRESS.: 885 Psig | OPER. PRESS.: 220 Psig |
| OPER. TEMP.: 76°F      | OPER. TEMP.: 60°F      | OPER. TEMP.: 60°F      |

**J-488**  
**04/11/18**  
**IFC**

\*\*\* = JOB #

Apr 10, 2018 - 4:12pm C:\Users\h235418\appdata\local\temp\AcPublish\_236140\


|                |            |                |                |     |                        |          |        |
|----------------|------------|----------------|----------------|-----|------------------------|----------|--------|
| DESIGN PRESS.  | NOTED Psig | FAB. LOCATION  | SHOP           |     |                        |          |        |
| DESIGN TEMP.   | NOTED °F   | SPOOL LOCATION | SKID #2        |     |                        |          |        |
| OPER. PRESS.   | NOTED Psig |                |                |     |                        |          |        |
| OPER. TEMP.    | NOTED °F   | CORR. ALLOW.   | .0625"         |     |                        |          |        |
| STRESS RELIEVE | NO         | INSULATION     | NOTED          | 0   | ISSUE FOR CONSTRUCTION | 04/25/11 | PL0 LH |
| RADIOGRAPHY    | 15% NORMAL | PAINT          | TRCo SYSTEM #3 | NO. | REVISION               | DATE     | BY APR |

**CONFIDENTIAL STATEMENT**  
 THIS DRAWING IS THE PROPERTY OF THE THOMAS RUSSELL CO. AND IS NOT TO BE USED FOR ANY PURPOSE OTHER THAN THAT FOR WHICH IT IS SPECIFICALLY FURNISHED.

**FABRICATION NOTES:**  
 ALL VALUES ARE PRESSURE UNLESS NOTED.  
 ALL FITTING MAKE-UP & CUT LENGTHS FOR BW PIPE DO NOT INCLUDE WELD GAPS.  
 SHOP TO MAKE ADJUSTMENTS FOR WELD GAPS.  
 ALL PIPE SEAMLESS UNLESS NOTED OTHERWISE.  
 ALL COUPLERS TO BE SHIMMED ON.

**Thomas Russell Co.**  
 7050 S. Yale, Suite 210  
 Tulsa, Oklahoma 74136  
 PH: 918-481-5682

|                  |              |               |          |
|------------------|--------------|---------------|----------|
| LINE No.         | 110-D1-CS-2" |               |          |
| ASSEMBLY DRAWING | SC6-402      |               |          |
| FIELD DRAWING    | ***-221/232  |               |          |
| DRAWN BY         | DV           | DATE DRAWN    | 03/22/11 |
| JOB No.          | SC6          | SPOOL ID. No. | SK2-021  |
| REV.             | 0            |               |          |

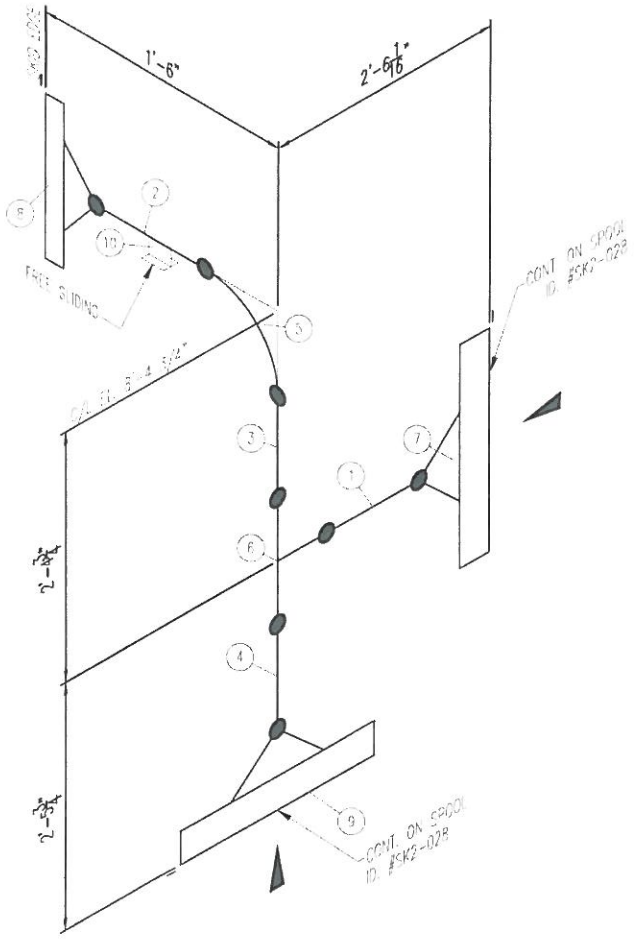

BILL OF MATERIAL

| MARK | QTY | SIZE  | DESCRIPTION                         | LENGTH      |
|------|-----|-------|-------------------------------------|-------------|
| 1    | 1   | 2"    | PIPE, KH, SMLS, A-106-B D04408      | 1'-10 3/4"  |
| 2    | 1   | 3"    | PIPE, STD, SMLS, A-106-B 1700766    | 10 3/8"     |
| 3    | 1   | 3"    | PIPE, STD, SMLS, A-106-B            | 1'-8 7/8"   |
| 4    | 1   | 3"    | PIPE, STD, SMLS, A-106-B            | 1'-10 1/16" |
| 5    | 1   | 3"    | ELL, 90 LR, STD, A-234-4PB          |             |
| 6    | 1   | 3"x2" | TEE, REDUCING STD-KH, A-234-4PB     |             |
| 7    | 1   | 2"    | FLG, BLWN 90DLR KH, A-105           |             |
| 8    | 1   | 3"    | FLG, BLWN 90DLR STD, A-105          |             |
| 9    | 1   | 3"    | FLG, BLWN 90DLR KH, A-105           |             |
| 10   | 1   |       | PIPE SHOE, 6" LG x 3" HI FROM W6x15 |             |

J-488  
04/11/18  
IFC

\*\*\* = JOB #

Apr 10, 2018 - 4:12pm C:\Users\h235418\appdata\local\temp\AcPublish\_236140\



|                |            |                |               |     |                        |          |     |     |
|----------------|------------|----------------|---------------|-----|------------------------|----------|-----|-----|
| DESIGN PRESS.  | 400 Psig   | FAB. LOCATION  | SHOP          |     |                        |          |     |     |
| DESIGN TEMP.   | 200 °F     | SPOOL LOCATION | SKID #2       |     |                        |          |     |     |
| OPER. PRESS.   | 195 Psia   |                |               |     |                        |          |     |     |
| OPER. TEMP.    | 23 °F      | CORR. ALLOW.   | .0625"        |     |                        |          |     |     |
| STRESS RELIEVE | NO         | INSULATION     | 1" C          | 0   | ISSUE FOR CONSTRUCTION | 04/25/11 | PLO | LH  |
| RADIOGRAPHY    | 15% NORMAL | PAINT          | TRC SYSTEM #3 | NO. | REVISION               | DATE     | BY  | APR |

**CONFIDENTIAL STATEMENT**  
THIS DRAWING IS THE PROPERTY OF THE THOMAS RUSSELL CO. AND IS NOT TO BE USED FOR ANY PURPOSE OTHER THAN THAT FOR WHICH IT IS SPECIFICALLY FURNISHED.



**FABRICATION NOTES:**  
ALL VALUES ARE TRISED FACE UNLESS NOTED.  
ALL FITTING MAKE-UP & CUT LENGTHS FOR BW PIPE DO NOT INCLUDE WELD GAPS.  
SHOP TO MAKE ADJUSTMENTS FOR WELD GAPS.  
ALL PIPE SEAMLESS UNLESS NOTED OTHERWISE.  
ALL COUPLING TO BE SHOULDED ON.

**Thomas Russell Co.**  
7050 S. Yale, Suite 210  
Tulsa, Oklahoma 74136  
PH: 918-481-5682

|                  |                   |                       |
|------------------|-------------------|-----------------------|
| LINE No.         | 237-B1-CS-3" 1" C |                       |
| ASSEMBLY DRAWING | SC6-402           |                       |
| PICD DRAWING     | ***-235           |                       |
| DRAWN BY         | DV                | DATE DRAWN 03/22/11   |
| JOB No.          | SC6               | SPOOL ID. No. SK2-029 |
| REV.             | 0                 |                       |

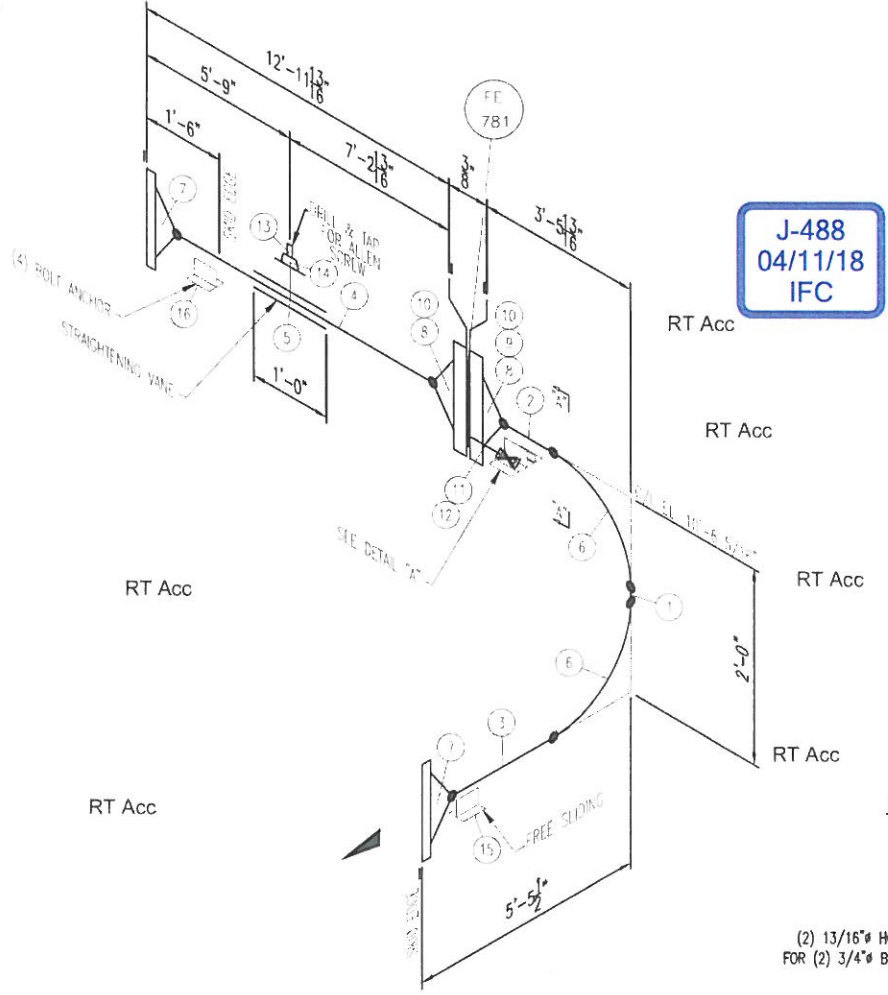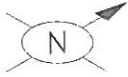

| BILL OF MATERIAL |     |      |   |          |            |
|------------------|-----|------|---|----------|------------|
| MARK             | QTY | SIZE | DESCRIPTION   | LENGTH   |            |
| 1                | 1   | 6"   | PIPE, STD SMLS, A-106-B   | 17607172 | 6"         |
| 2                | 1   | 6"   | PIPE, STD SMLS, A-106-B   |          | 2'-4 7/8"  |
| 3                | 1   | 6"   | PIPE, STD SMLS, A-106-B   |          | 4'-5"      |
| 4                | 1   | 6"   | PIPE, STD SMLS, A-106-B   |          | 12'-4 3/8" |
| 5                | 1   | 6"   | STRAIGHTENING VANE, #1100L LINE THPE, 6.065" LINE I.D.                                      |          | 1'-0"      |
| 6                | 2   | 6"   | FLG, 90 LR STD, A-234-WFB   |          |            |
| 7                | 2   | 6"   | FLG, RAWN 150LR STD, A-105  |          |            |
| 8                | 2   | 6"   | FLG, RAWN 300LR ORIFICE STD, A-105, w/ 1/2" NPT TAPS  |          |            |
| 9                | 1   | 3/4" | (12) STD BOLTS, A-193-B7 w/ TWO HEAVY HEX NUTS, A-194-2H                                    |          | 5 1/4"     |
| 10               | 2   | 6"   | GASKET, 1/8" THK, 300LR RF, SPIRALWOUND, 304SS WINDING, FLEXITE SUPER FILLER, CS GUIDE RING |          |            |
| 11               | 1   | 1/2" | NIPPLE, S/160 SMLS, A-106-B TBE   |          | 3"         |
| 12               | 1   | 1/2" | NIPPLE, S/160 SMLS, A-106-B TBE   |          | 6"         |
| 13               | 1   | 1/2" | PLUG, SOLID STEEL, ROUND HEAD, A-105  |          |            |
| 14               | 1   | 1/2" | PLUG, THRD, 300CLR FD, A-105  |          |            |
| 15               | 1   |      | PIPE SHOE, 6" LG x 3" HI FROM WAYS  |          |            |
| 16               | 2   |      | PIPE SHOE, 6" LG x 3" HI FROM WAYS  |          |            |
| 17               | 2   |      | ANGLE, 3" x 2" x 1/4" x 6" LG. (DRILL PER DETAIL)   |          |            |

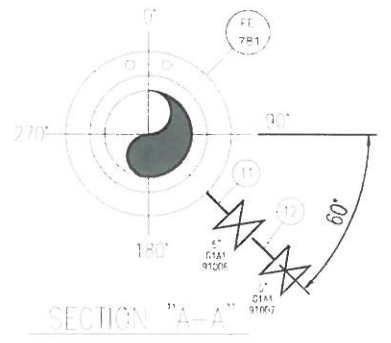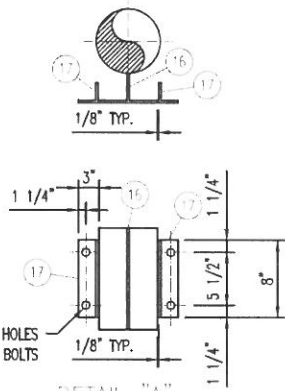

\*\*\* = JOB #

Apr 10, 2018 - 4:12pm Z:\400 - Drafting\001-PROJECTS\488 SC6 RSV\SC6R\DRAWINGS\400-Piping\SPOOLS\IFC\SK2


|                |            |                |                |     |                        |          |     |     |
|----------------|------------|----------------|----------------|-----|------------------------|----------|-----|-----|
| DESIGN PRESS.  | 150 Psig   | FAB. LOCATION  | SHOP           |     |                        |          |     |     |
| DESIGN TEMP.   | 400 °F     | SPOOL LOCATION | SKID #2        |     |                        |          |     |     |
| OPER. PRESS.   | 50 Psig    |                |                |     |                        |          |     |     |
| OPER. TEMP.    | 300 °F     | CORR. ALLOW.   | .0625"         |     |                        |          |     |     |
| STRESS RELIEVE | NO         | INSULATION     | 2"H            | 0   | ISSUE FOR CONSTRUCTION | 04/25/11 | PLD | LH  |
| RADIOGRAPHY    | 15% NORMAL | PAINT          | TRCo SYSTEM #2 | NO. | REVISION               | DATE     | BY  | APR |

**CONFIDENTIAL STATEMENT**  
 THIS DRAWING IS THE PROPERTY OF THE THOMAS RUSSELL CO. AND IS NOT TO BE USED FOR ANY PURPOSE OTHER THAN THAT FOR WHICH IT IS SPECIFICALLY FURNISHED.

**FABRICATION NOTES:**  
 ALL VALUES ARE TORQUE TO UNLESS NOTED.  
 ALL FITTING MAKE-UP & CUT LENGTHS FOR BY PIPE DO NOT INCLUDE WELD GAPS.  
 SHOP TO MAKE ADJUSTMENTS FOR WELD GAPS.  
 ALL PIPE SEAMLESS UNLESS NOTED OTHERWISE.  
 ALL COUPLING TO BE SHOULD OIL.

**Thomas Russell Co.**  
 7050 S. Yale, Suite 210  
 Tulsa, Oklahoma 74136  
 PH: 918-481-5882

|                  |                  |
|------------------|------------------|
| LINE No.         | 611-A1-CS-6" 2"H |
| ASSEMBLY DRAWING | SC6-402          |
| FIELD DRAWING    | ***-291          |
| DRAWN BY         | DV               |
| DATE DRAWN       | 03/22/11         |
| JOB No.          | SC6              |
| SPOOL I.D. No.   | SK2-032          |
| REV.             | 0                |

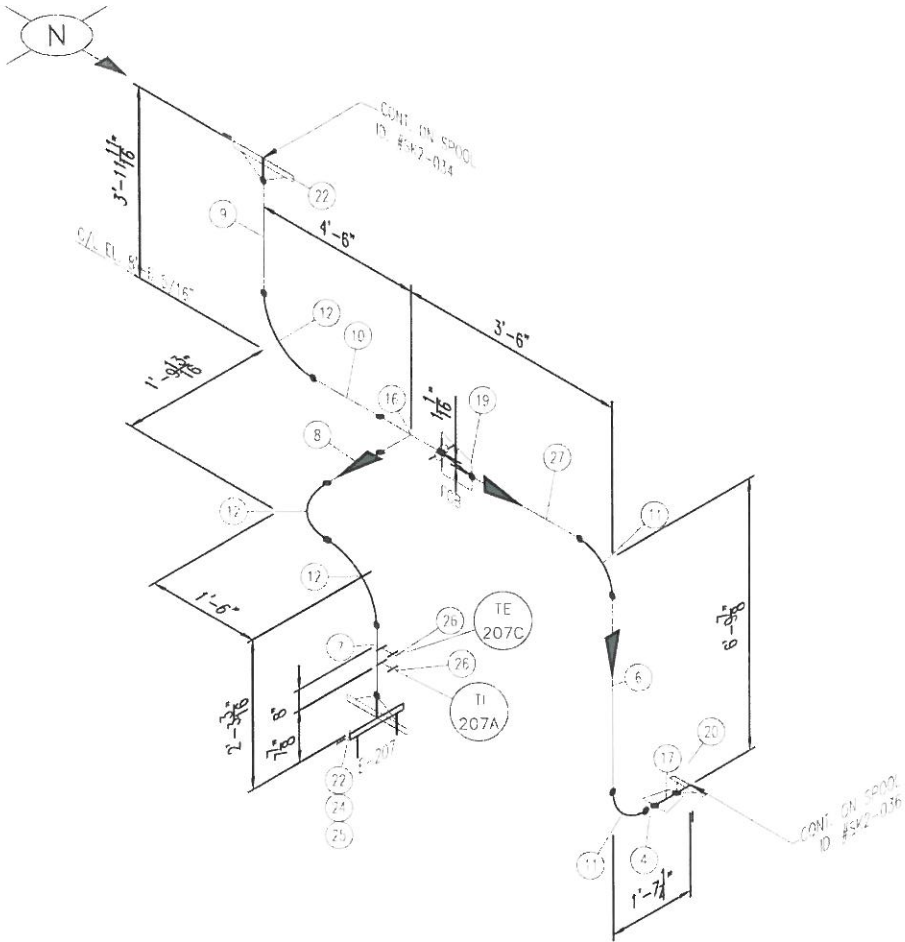

4

BILL OF MATERIAL

| MARK | QTY | SIZE  | DESCRIPTION   | LENGTH   |             |
|------|-----|-------|---|----------|-------------|
| 1    |     |       |   |          |             |
| 2    |     |       |   |          |             |
| 3    |     |       |   |          |             |
| 4    | 1   | 4"    | PIPE, STD SMLS, A-106-B   | 58130K   | 6 3/4"      |
| 5    |     |       |   |          |             |
| 6    | 1   | 4"    | PIPE, STD SMLS, A-106-B   | 58130K   | 5'-9 1/8"   |
| 7    | 1   | 6"    | PIPE, STD SMLS, A-106-B   | 17607172 | 1'-2 11/16" |
| 8    | 1   | 6"    | PIPE, STD SMLS, A-106-B   |          | 7 3/16"     |
| 9    | 1   | 6"    | PIPE, STD SMLS, A-106-B   |          | 2'-11 3/16" |
| 10   | 1   | 6"    | PIPE, STD SMLS, A-106-B   |          | 3'-3 3/8"   |
| 11   | 2   | 4"    | ELL. 90 LR STD, A-234-WPB   |          |             |
| 12   | 3   | 6"    | ELL. 90 LR STD, A-234-WPB   |          |             |
| 13   |     |       |   |          |             |
| 14   |     |       |   |          |             |
| 15   |     |       |   |          |             |
| 16   | 1   | 6"    | TEE, STR. STD, A-234-WPB  |          |             |
| 17   | 1   | 4"x2" | REDUCER, CONG. STD - KH, A-234-WPB  |          |             |
| 18   |     |       |   |          |             |
| 19   | 1   | 6"x4" | REDUCER, ECC STD, A-234-WPB   |          |             |
| 20   | 1   | 2"    | FLG. REWN 150LR XL, A-105   |          |             |
| 21   |     |       |   |          |             |
| 22   | 2   | 6"    | FLG. REWN 150LR STD, A-105  |          |             |
| 23   |     |       |   |          |             |
| 24   | 1   | 3/4"  | (8) STUD BOLTS, A-193-B7 w/ TWO HEAVY HEX NUTS, A-194-2H                                    |          | 4 3/4"      |
| 25   | 1   | 6"    | GASKET, 1/8" THK, 150LB. RF, SPIRALWOUND, 304SS WINDING, FLEXITE SUPER FILLER, CS SHIM RING |          |             |
| 26   | 2   | 5/4"  | ORLO, 10E x 2 1/2" LG, 3000LR FS, A-105   |          |             |
| 27   | 1   | 4"    | PIPE, STD SMLS, A-106-B   | 58130K   | 2'-0 1/8"   |

SHOP WELD

J-488  
04/11/18  
IFC

\*\*\* = JOB #

Apr 10, 2018 - 4:12pm C:\Users\h235418\appdata\local\temp\AcPublish\_236140\



| DESIGN PRESS.  | 150 Psig   | FAB. LOCATION  | SHOP           | 4   | REVISED & REMOVED ITEM #4 | 04/01/16 | CC  | LH  |
|----------------|------------|----------------|----------------|-----|---------------------------|----------|-----|-----|
| DESIGN TEMP.   | 400 °F     | SPOOL LOCATION | SKID #2        | 3   | REVISED & REMOVED PIPING  | 10/03/13 | MSD | KK  |
| OPER. PRESS.   | 50 Psig    |                |                | 2   | REVISED AS NOTED          | 2/9/12   | DV  | LH  |
| OPER. TEMP.    | 300 °F     | CORR. ALLOW.   | .0625"         | 1   | REVISED AS NOTED          | 12/27/11 | DV  | LH  |
| STRESS RELIEVE | NO         | INSULATION     | 2"H            | 0   | ISSUE FOR CONSTRUCTION    | 04/25/11 | PLO | LH  |
| RADIOGRAPHY    | 15% NORMAL | PAINT          | TRCo SYSTEM #2 | NO. | REVISION                  | DATE     | BY  | APR |

**CONFIDENTIAL STATEMENT**  
THIS DRAWING IS THE PROPERTY OF THE THOMAS RUSSELL CO. AND IS NOT TO BE USED FOR ANY PURPOSE OTHER THAN THAT FOR WHICH IT IS SPECIFICALLY FURNISHED.


**FABRICATION NOTES:**  
ALL VALUES ARE TOLERANCE UNLESS NOTED.  
ALL FITTING MAKE-UP & CUT LENGTHS FOR DWY PIPE DO NOT INCLUDE WELD GAPS.  
SHOP TO MAKE ADJUSTMENTS FOR WELD GAPS.  
ALL PIPE SEAMLESS UNLESS NOTED OTHERWISE.  
ALL COUPLING TO BE SOCKETED ON.

**Thomas Russell Co.**  
7050 S. Yale, Suite 210  
Tulsa, Oklahoma 74136  
PH.: 918-481-5682

|                  |                  |               |          |
|------------------|------------------|---------------|----------|
| LINE No.         | 611-A1-CS-6" 2"H |               |          |
| ASSEMBLY DRAWING | SC6-402          |               |          |
| PICED DRAWING    | ***-291          |               |          |
| DRAWN BY         | DV               | DATE DRAWN    | 03/22/11 |
| JOB No.          | SC6              | SPOOL ID. No. | SK2-033  |
| REV.             |                  |               | 4        |

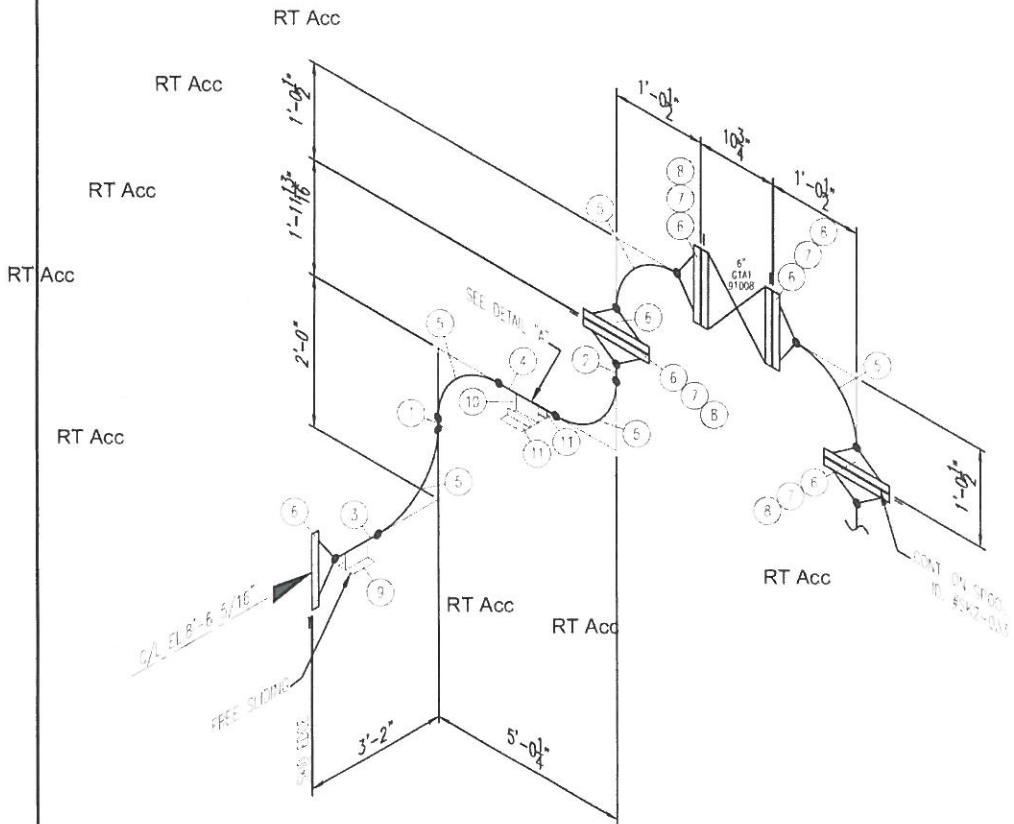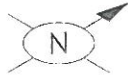

| BILL OF MATERIAL |     |      |   |           |  |
|------------------|-----|------|---|-----------|--|
| MARK             | QTY | SIZE | DESCRIPTION   | LENGTH    |  |
| 1                | 1   | 6"   | PIPE, STD SMLS, A-106-B 17702125  | 6"        |  |
| 2                | 1   | 6"   | PIPE, STD SMLS, A-106-B   | 11 3/16"  |  |
| 3                | 1   | 6"   | PIPE, STD SMLS, A-106-B   | 2'-1 1/2" |  |
| 4                | 1   | 6"   | PIPE, STD SMLS, A-106-B   | 2'-6 1/4" |  |
| 5                | 5   | 6"   | ELL, 90 LR STD, A-234-WPB   |           |  |
| 6                | 6   | 6"   | FLG, REWN 150LB STD, A-105  |           |  |
| 7                | 4   | 3/4" | (6) STUD BOLTS, A-193-B7 w/ TWO HEAVY HEX NUTS, A-194-DH                                    | 4 1/4"    |  |
| 8                | 4   | 6"   | GASKET, 1/8" THK, 150LB RE, SPIRALWOUND, 304SS WINDING, FLEXITE SUPER FILLER, CS GUIDE RING |           |  |
| 9                | 1   |      | PIPE SHOE, 6" LG x 3" HI FROM W6X15   |           |  |
| 10               | 1   |      | PIPE SHOE, 8" LG x 3" HI FROM W6X15   |           |  |
| 11               | 2   |      | ANGLE, 3" x 3" x 1/4" x 8" LG. (DRILL PER DETAIL "A")                                       |           |  |

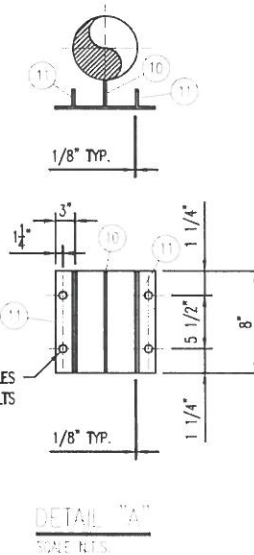

**J-488**  
**04/11/18**  
**IFC**

\*\*\* = JOB #

Apr 10, 2018 - 4:12pm Z:\400 - Drafting\001-PROJECTS\488 SC6 RSV\SC6P\DRAWINGS\400-Piping\SPOOLS\FC\SK2\


|                |            |                |                |     |                        |          |     |     |
|----------------|------------|----------------|----------------|-----|------------------------|----------|-----|-----|
| DESIGN PRESS.  | 150 Psig   | FAB. LOCATION  | SHOP           |     |                        |          |     |     |
| DESIGN TEMP.   | 400 °F     | SPOOL LOCATION | SKID #2        |     |                        |          |     |     |
| OPER. PRESS.   | 50 Psia    |                |                |     |                        |          |     |     |
| OPER. TEMP.    | 300 °F     | CORR. ALLOW.   | .0625"         |     |                        |          |     |     |
| STRESS RELIEVE | NO         | INSULATION     | 2"H            | 0   | ISSUE FOR CONSTRUCTION | 04/25/11 | PLO | LH  |
| RADIOGRAPHY    | 15% NORMAL | PAINT          | TRCo SYSTEM #2 | NO. | REVISION               | DATE     | BY  | APR |

**CONFIDENTIAL STATEMENT**  
 THIS DRAWING IS THE PROPERTY OF THE THOMAS RUSSELL CO. AND IS NOT TO BE USED FOR ANY PURPOSE OTHER THAN THAT FOR WHICH IT IS SPECIFICALLY FURNISHED.

**FABRICATION NOTES:**  
 ALL WELDS ARE RASPED FACE UNLESS NOTED.  
 ALL FITTING MAKE-UP & OUT LEGS ARE FOR BUY PIPE DO NOT INCLUDE WELD GAPS.  
 ALL PIPE SEAMLESS UNLESS NOTED OTHERWISE.  
 ALL COUPLING TO BE SHOPPED ON.

**Thomas Russell Co.**  
 7050 S. Yale, Suite 210  
 Tulsa, Oklahoma 74136  
 PH: 918-481-5682

|                  |                  |               |          |
|------------------|------------------|---------------|----------|
| LINE No.         | 611-A1-CS-6" 2"H |               |          |
| ASSEMBLY DRAWING | SC6-402          |               |          |
| PICED DRAWING    | ***-291          |               |          |
| DRAWN BY         | DV               | DATE DRAWN    | 03/22/11 |
| JOB No.          | SC6              | SPOOL ID. No. | SK2-034  |
| REV.             |                  |               | 0        |

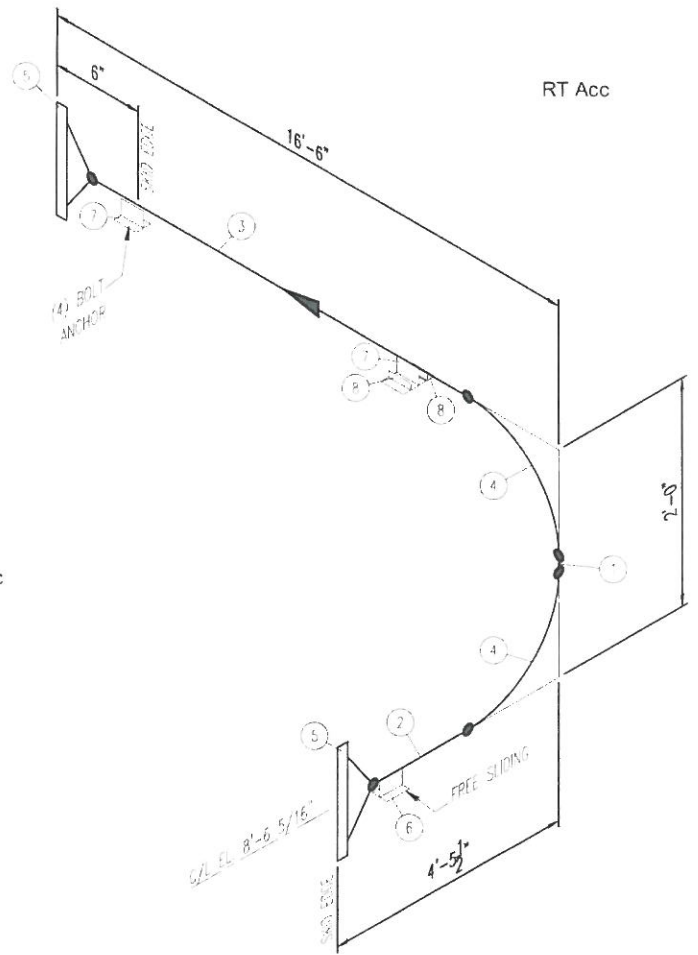

| BILL OF MATERIAL |     |      |  |          |            |
|------------------|-----|------|--|----------|------------|
| MARK             | QTY | SIZE | DESCRIPTION                                      | LENGTH   |            |
| 1                | 1   | 6"   | PIPE, STD SMLS, A-106-B                          | 17702125 | 6"         |
| 2                | 1   | 6"   | PIPE, STD SMLS, A-106-B                          |          | 3'-6"      |
| 3                | 1   | 6"   | PIPE, STD SMLS, A-106-B                          |          | 10'-5 1/2" |
| 4                | 2   | 6"   | ELL, 90 LR STD, A-234-WPB                        |          |            |
| 5                | 2   | 6"   | ELL, 45 RW 150LB STD, A-105                      |          |            |
| 6                | 1   |      | PIPE SHOUL, 6" LG x 3" HI FROM W&V'S             |          |            |
| 7                | 2   |      | PIPE SHOUL, 6" LG x 3" HI FROM W&V'S             |          |            |
| 8                | 2   |      | ANGLE, 3" x 2" x 1/4" x 8" LG (DRILL PER DETAIL) |          |            |



RT Acc

RT Acc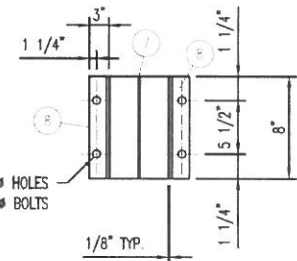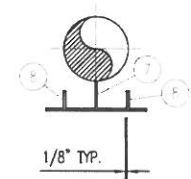

DETAIL "A"  
SCALE N.T.S.

J-488  
04/11/18  
IFC

\*\*\* = JOB #

Apr 10, 2018 - 4:12pm Z:\400 - Drafting\001-PROJECTS\488 SC6 RSA\SC6R\DRAWINGS\400-Piping\SPOOLS\FC\SK2\



|                |            |                |           |     |                        |          |     |     |
|----------------|------------|----------------|-----------|-----|------------------------|----------|-----|-----|
| DESIGN PRESS.  | 150 Psig   | FAB. LOCATION  | SHOP      |     |                        |          |     |     |
| DESIGN TEMP.   | 400 °F     | SPOOL LOCATION | SKID #2   |     |                        |          |     |     |
| OPER. PRESS.   | 40 Psig    |                |           |     |                        |          |     |     |
| OPER. TEMP.    | 200 °F     | CORR. ALLOW.   | .0625"    |     |                        |          |     |     |
| STRESS RELIEVE | NO         | INSULATION     | 2"H       | 0   | ISSUE FOR CONSTRUCTION | 04/25/11 | PLD | LH  |
| RADIOGRAPHY    | 15% NORMAL | PAINT          | SYSTEM #2 | NO. | REVISION               | DATE     | BY  | APR |

**CONFIDENTIAL STATEMENT**  
THIS DRAWING IS THE PROPERTY OF THE THOMAS RUSSELL CO. AND IS NOT TO BE USED FOR ANY PURPOSE OTHER THAN THAT FOR WHICH IT IS SPECIFICALLY FURNISHED.

**FABRICATION NOTES:**  
ALL VALUES ARE TOLERANCE UNLESS NOTED.  
ALL FITTING MAKE-UP & CUT LENGTHS FOR BWP PIPE DO NOT INCLUDE WELD GAPS.  
SHOP TO MAKE ADJUSTMENTS FOR WELD GAPS.  
ALL PIPE SEAMLESS UNLESS NOTED OTHERWISE.  
ALL COUPLING TO BE SHOULDED ON.

**Thomas Russell Co.**  
7050 S. Yale, Suite 210  
Tulsa, Oklahoma 74136  
PH: 918-481-5682

|                  |                  |                |          |
|------------------|------------------|----------------|----------|
| LINE No.         | 614-A1-CS-6" 2"H |                |          |
| ASSEMBLY DRAWING | SC6-402          |                |          |
| PICED DRAWING    | ***-291          |                |          |
| DRAWN BY         | DV               | DATE DRAWN     | 03/22/11 |
| JOB No.          | SC6              | SPOOL LID. No. | SK2-035  |
| REV.             | 0                |                |          |

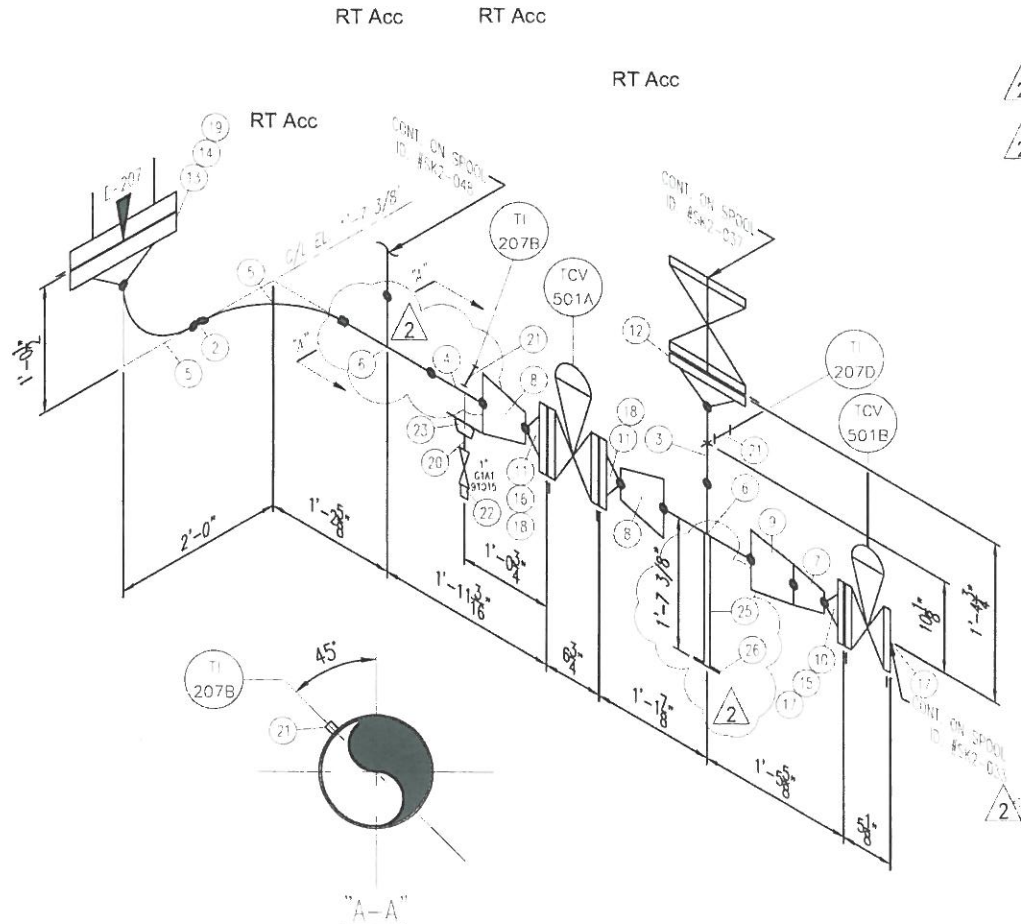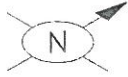

BILL OF MATERIAL

| MARK | QTY | SIZE  | DESCRIPTION   | LENGTH         |
|------|-----|-------|---|----------------|
| 1    |     |       |   |                |
| 2    | 1   | 6"    | PIPE, STD SMLS, A-106-B   | 17607172<br>6" |
| 3    | 1   | 6"    | PIPE, STD SMLS, A-106-B   | 7 5/8"         |
| 4    | 1   | 6"    | PIPE, STD SMLS, A-106-B   | 9 5/16"        |
| 5    | 2   | 6"    | ELL, 90 LR STD, A-234-WPB   |                |
| 6    | 2   | 6"    | TEE, STR STD, A-234-WPB   |                |
| 7    | 1   | 4"x2" | REDUCER, CONC STD - KH, A-234-WPB   |                |
| 8    | 2   | 6"x1" | REDUCER, CONC STD, A-234-WPB  |                |
| 9    | 1   | 6"x4" | REDUCER, CONC STD, A-234-WPB  |                |
| 10   | 1   | 2"    | FLG. REFW 150LB KH, A-105   |                |
| 11   | 2   | 1"    | FLG. REFW 150LB STD, A-105  |                |
| 12   | 1   | 6"    | FLG. REFW 150LB STD, A-105  |                |
| 13   | 1   | 6"    | FLG. REFW 150LB STD, A-105  |                |
| 14   | 1   | 3/4"  | (12) STD BOLTS, A-193-B7 w/ TWO HEAVY HEX NUTS, A-194-2H                                    | 4 3/4"         |
| 15   | 1   | 5/8"  | (4) STD BOLTS, A-193-B7 w/ TWO HEAVY HEX NUTS, A-194-2H                                     | 8 1/2"         |
| 16   | 1   | 5/8"  | (4) STD BOLTS, A-193-B7 w/ TWO HEAVY HEX NUTS, A-194-2H                                     | 10 1/2"        |
| 17   | 2   | 2"    | GASKET, 1/8" THK, 150LB RE, SPIRALWOUND, 304SS WINDING, FLEXITE SUPER FILLER, CS GUIDE RING |                |
| 18   | 2   | 2"    | GASKET, 1/8" THK, 150LB RE, SPIRALWOUND, 304SS WINDING, FLEXITE SUPER FILLER, CS GUIDE RING |                |
| 19   | 1   | 6"    | GASKET, 1/8" THK, 150LB RE, SPIRALWOUND, 304SS WINDING, FLEXITE SUPER FILLER, CS GUIDE RING |                |
| 20   | 1   | 1"    | NIPPLE, KH SMLS, A-106-B PDE-TOE  | 3"             |
| 21   | 2   | 3/4"  | GRG. TOE x 2 1/2" LG., 3000LB FS, A-105   |                |
| 22   | 1   | 1"    | PLUG, SOLID STEEL, ROUND HEAD, A-105  |                |
| 23   | 1   | 6"x1" | ISOL. SPOOLER FS, A-105   |                |
| 24   |     |       |   |                |
| 25   | 1   | 3"    | PIPE, STD SMLS, A-106-B   | 1'-6 7/8"      |
| 26   |     |       | BASE PLATE, 1/2" THK x 6" x 6" (SA-99 MATERIAL)   |                |

J-488  
04/11/18  
IFC

\*\*\* = JOB #

Apr 10, 2018 - 4:13pm C:\Users\h235418\appdata\local\temp\publish\_236140\



|                |            |                |                |     |                                      |          |     |     |
|----------------|------------|----------------|----------------|-----|--------------------------------------|----------|-----|-----|
| DESIGN PRESS.  | 150 Psig   | FAB. LOCATION  | SHOP           |     |                                      |          |     |     |
| DESIGN TEMP.   | 400 °F     | SPOOL LOCATION | SKID #2        |     |                                      |          |     |     |
| OPER. PRESS.   | 40 Psia    |                |                | 2   | REVISED TO ADD 6" TEE & PIPE SUPPORT | 10/03/13 | MSD | KK  |
| OPER. TEMP.    | 200 °F     | CORR. ALLOW.   | .0625"         | 1   | REVISED AS NOTED                     | 12/27/11 | DV  | LH  |
| STRESS RELIEVE | NO         | INSULATION     | 2"H            | 0   | ISSUE FOR CONSTRUCTION               | 04/25/11 | PLO | LH  |
| RADIOGRAPHY    | 15% NORMAL | PAINT          | TRCO SYSTEM #2 | NO. | REVISION                             | DATE     | BY  | APR |

**CONFIDENTIAL STATEMENT**  
THIS DRAWING IS THE PROPERTY OF THE THOMAS RUSSELL CO. AND IS NOT TO BE USED FOR ANY PURPOSE OTHER THAN THAT FOR WHICH IT IS SPECIFICALLY FURNISHED.


**FABRICATION NOTES:**  
ALL WELDS ARE WAGED FACE UNLESS NOTED.  
ALL FITTING MAKE-UP & CUT LENGTHS FOR DW PIPE DO NOT INCLUDE WELD GAPS.  
SHOP TO MAKE ADJUSTMENTS FOR WELD GAPS.  
ALL PIPE SEAMLESS UNLESS NOTED OTHERWISE.  
ALL COUPLING TO BE SHOULDER ON.

**Thomas Russell Co.**  
7050 S. Yale, Suite 210  
Tulsa, Oklahoma 74136  
PH: 918-481-5682

|                  |                  |               |          |
|------------------|------------------|---------------|----------|
| LINE No.         | 614-A1-CS-6" 2"H |               |          |
| ASSEMBLY DRAWING | SC6-402          |               |          |
| PRED DRAWING     | ***-291          |               |          |
| DRAWN BY         | DV               | DATE DRAWN    | 03/22/11 |
| JOB No.          | SC6              | SPOOL ID. No. | SK2-036  |
| REV.             |                  |               | 2        |

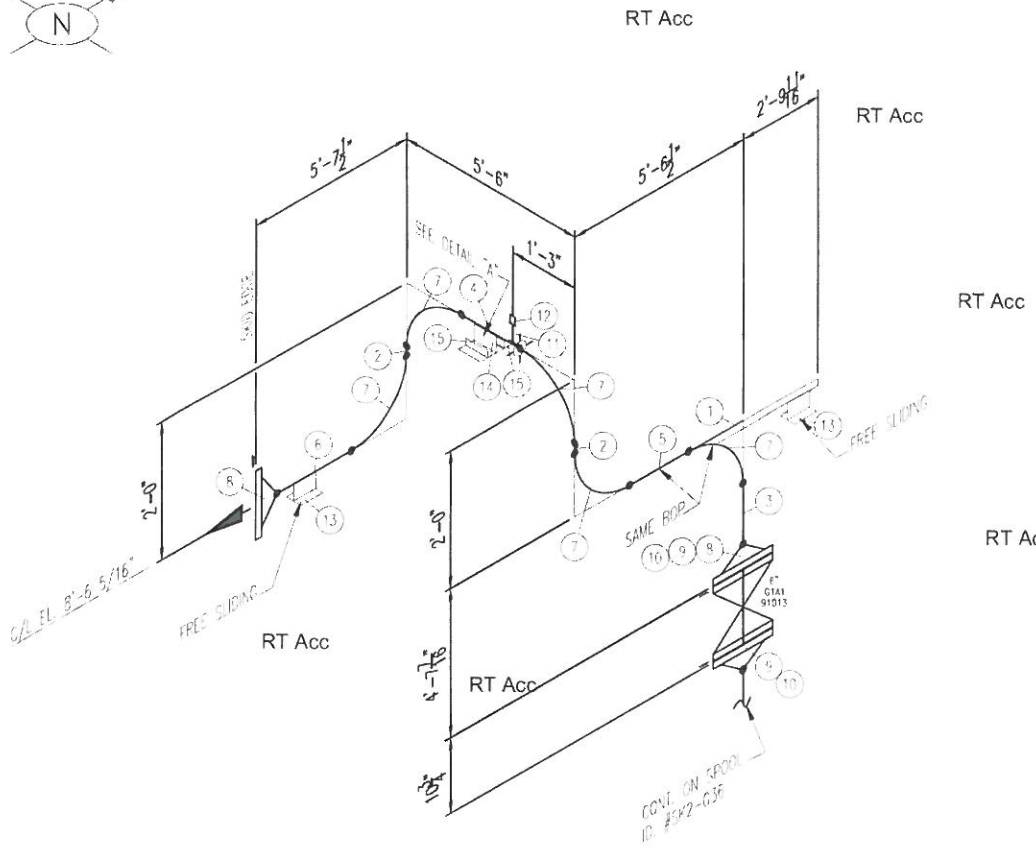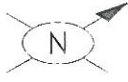

| BILL OF MATERIAL |     |      |   |          |             |
|------------------|-----|------|---|----------|-------------|
| MARK             | QTY | SIZE | DESCRIPTION   |          | LENGTH      |
| 1                | 1   | 6"   | PIPE, STD SMLS, A-106-B   |          | 3'-6 11/16" |
| 2                | 2   | 6"   | PIPE, STD SMLS, A-106-B   | 17702125 | 6"          |
| 3                | 1   | 6"   | PIPE, STD SMLS, A-106-B   | 17607172 | 2'-6 15/16" |
| 4                | 1   | 6"   | PIPE, STD SMLS, A-106-B   | 17702125 | 4'-0"       |
| 5                | 1   | 6"   | PIPE, STD SMLS, A-106-B   | 17702125 | 4'-0 1/2"   |
| 6                | 1   | 6"   | PIPE, STD SMLS, A-106-B   | 17702125 | 4'-0"       |
| 7                | 5   | 6"   | ELL, 90 LR STD, A-234-WFB   |          |             |
| 8                | 2   | 6"   | FLG, RFWN 150LR STD, A-105  |          |             |
| 9                | 2   | 3/4" | (R) STUD BOLTS, A-194-B7 w/ TWO HEAVY HEX NUTS, A-194-2H                                    |          | 4 1/4"      |
| 10               | 2   | 6"   | WASKET, 1/8" THK, 150LB RF, SPIRALWOUND, 304SS WINDING, FLEXITE SUPER FILLES, CS GUIDE RING |          |             |
| 11               | 1   | 1/2" | COILG, TOE x 2 1/2" LG, 3000LB FS, A-105  |          |             |
| 12               | 1   | 1/2" | FLDG, SOLID STEEL, ROUND HEAD, A-105  |          |             |
| 13               | 2   |      | PIPE SHOE, 6" LG x 3" HI FROM W6x15   |          |             |
| 14               | 1   |      | PIPE SHOE, 8" LG x 3" HI FROM W6x15   |          |             |
| 15               | 2   |      | ANGLE, 3" x 2" x 1/4" x 8" LG. (DRILL PER DETAIL)   |          |             |

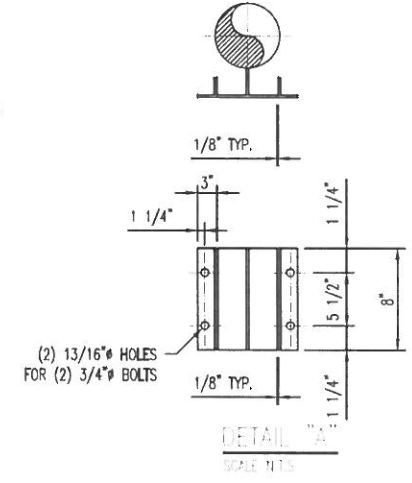

**J-488**  
**04/11/18**  
**IFC**

SHOP WELD

\*\*\* = JOB #

Apr 10, 2018 - 4:13pm C:\Users\h235418\appdata\local\temp\AcPublish\_236140\

|                |            |                |                |     |                        |          |        |
|----------------|------------|----------------|----------------|-----|------------------------|----------|--------|
| DESIGN PRESS.  | 150 Psig   | FAB. LOCATION  | SHOP           |     |                        |          |        |
| DESIGN TEMP.   | 400 °F     | SPOOL LOCATION | SKID #2        |     |                        |          |        |
| OPER. PRESS.   | 40 Psig    |                |                |     |                        |          |        |
| OPER. TEMP.    | 200 °F     | CORR. ALLOW.   | .0625"         |     |                        |          |        |
| STRESS RELIEVE | NO         | INSULATION     | 2"H            | 0   | ISSUE FOR CONSTRUCTION | 04/25/11 | PLD LH |
| RADIOGRAPHY    | 15% NORMAL | PAINT          | TRCo SYSTEM #2 | NO. | REVISION               | DATE     | BY APR |



**CONFIDENTIAL STATEMENT**  
 THIS DRAWING IS THE PROPERTY OF THE THOMAS RUSSELL Co. AND IS NOT TO BE USED FOR ANY PURPOSE OTHER THAN THAT FOR WHICH IT IS SPECIFICALLY FURNISHED.

**FABRICATION NOTES:**  
 ALL VALUES ARE RASSED FACE UNLESS NOTED.  
 ALL FITTING MAKE-UP & CUT LENGTHS FOR DW PIPE DO NOT INCLUDE WELD GAPS.  
 SHOP TO MAKE ADJUSTMENTS FOR WELD GAPS.  
 ALL PIPE SEAMLESS UNLESS NOTED OTHERWISE.  
 ALL COUPLING TO BE SHOULDER ON.

Thomas Russell Co.

7050 S. Yale, Suite 210  
 Tulsa, Oklahoma 74136  
 PH: 918-481-5682

|                  |                  |                |          |
|------------------|------------------|----------------|----------|
| LINE No.         | 614-A1-CS-6" 2"H |                |          |
| ASSEMBLY DRAWING | SC6-402          |                |          |
| PIED DRAWING     | ***-291          |                |          |
| DRAWN BY         | DV               | DATE DRAWN     | 03/22/11 |
| JOB No.          | SC6              | SPOOL LID. No. | SK2-037  |
| REV.             |                  |                | 0        |

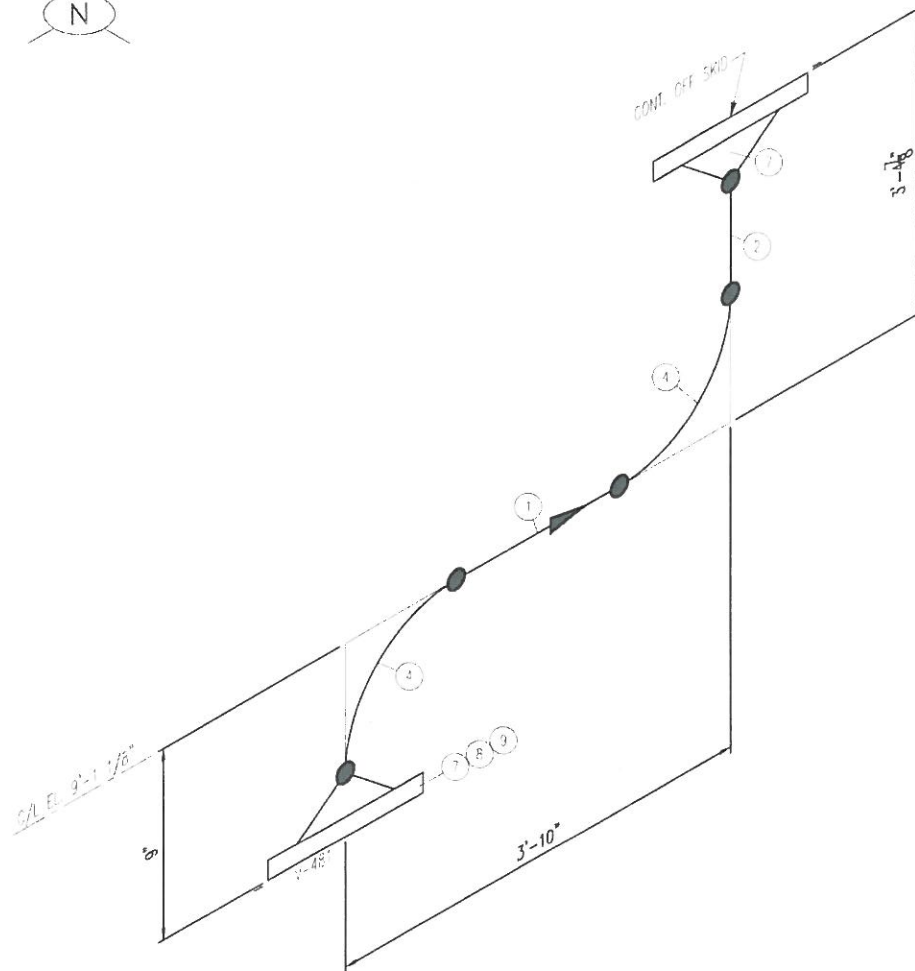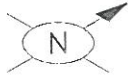

BILL OF MATERIAL

| MARK | QTY | SIZE  | DESCRIPTION  | LENGTH    |
|------|-----|-------|--|-----------|
| 1    | 1   | 4"    | PIPE, STD SMLS, A-106-B  | 2'-10"    |
| 2    | 1   | 4"    | PIPE, STD SMLS, A-106-B  | 2'-7 1/8" |
| 3    | 1   | 3"    | ELL, 90 LR STD, A-234-WPB  |           |
| 4    | 2   | 4"    | ELL, 90 LR STD, A-234-WPB  |           |
| 5    | 1   | 4"x1" | REDUCER, 45MC STD, A-234-WPB   |           |
| 6    | 1   | 4"    | FLG, RWLN 150LB STD, A-135   |           |
| 7    | 2   | 4"    | FLG, RWLN 150LB STD, A-135   |           |
| 8    | 1   | 5/8"  | (6) STUD BOLTS, A-193-B7 w/ TWO HEAVY HEX NUTS, A-194-2H                                   | 3 3/4"    |
| 9    | 1   | 4"    | GASKET 1/8" THK, 150LB RE, SPIRALWOUND, JOASG WINDING, FLEXITE SUPER FILLER, CS GUIDE RING |           |

J-488  
04/11/18  
IFC

\*\*\* = JOB #

Apr 10, 2018 - 4:13pm C:\Users\h235418\appdata\local\temp\AcPublish\_236140\


|                |            |                |                |     |                        |          |     |     |
|----------------|------------|----------------|----------------|-----|------------------------|----------|-----|-----|
| DESIGN PRESS.  | 150 Psig   | FAB. LOCATION  | SHOP           |     |                        |          |     |     |
| DESIGN TEMP.   | 150 °F     | SPOOL LOCATION | SKID #2        |     |                        |          |     |     |
| OPER. PRESS.   | 100 Psia   |                |                |     |                        |          |     |     |
| OPER. TEMP.    | 69 °F      | CORR. ALLOW.   | .0625"         | 1   | CHANGED FROM 3" TO 4"  | 07/29/11 | ROC | LH  |
| STRESS RELIEVE | NO         | INSULATION     | NONE           | 0   | ISSUE FOR CONSTRUCTION | 04/25/11 | PLO | LH  |
| RADIOGRAPHY    | 15% NORMAL | PAINT          | TRCo SYSTEM #3 | NO. | REVISION               | DATE     | BY  | APR |

**CONFIDENTIAL STATEMENT**  
THIS DRAWING IS THE PROPERTY OF THE THOMAS RUSSELL CO. AND IS NOT TO BE USED FOR ANY PURPOSE OTHER THAN THAT FOR WHICH IT IS SPECIFICALLY FURNISHED.

**FABRICATION NOTES:**  
ALL VALUES ARE TABER FACE UNLESS NOTED.  
ALL FITTING MAKE-UP & CUT LENGTHS FOR BIV PIPE DO NOT INCLUDE WELD GAPS.  
SHOP TO MAKE ADJUSTMENTS FOR WELD GAPS.  
ALL PIPE SEAMLESS UNLESS NOTED OTHERWISE.  
ALL COUPLING TO BE SHOULDER ON.

**Thomas Russell Co.**  
7050 S. Yale, Suite 210  
Tulsa, Oklahoma 74136  
PH: 918-481-5682

|                  |              |               |          |
|------------------|--------------|---------------|----------|
| LINE No.         | 703-A1-CS-4" |               |          |
| ASSEMBLY DRAWING | SC6-402      |               |          |
| PED DRAWING      | ***-296      |               |          |
| DRAWN BY         | DV           | DATE DRAWN    | 03/22/11 |
| JOB No.          | SC6          | SPOOL ID. No. | SK2-038  |
| REV.             |              |               | 1        |

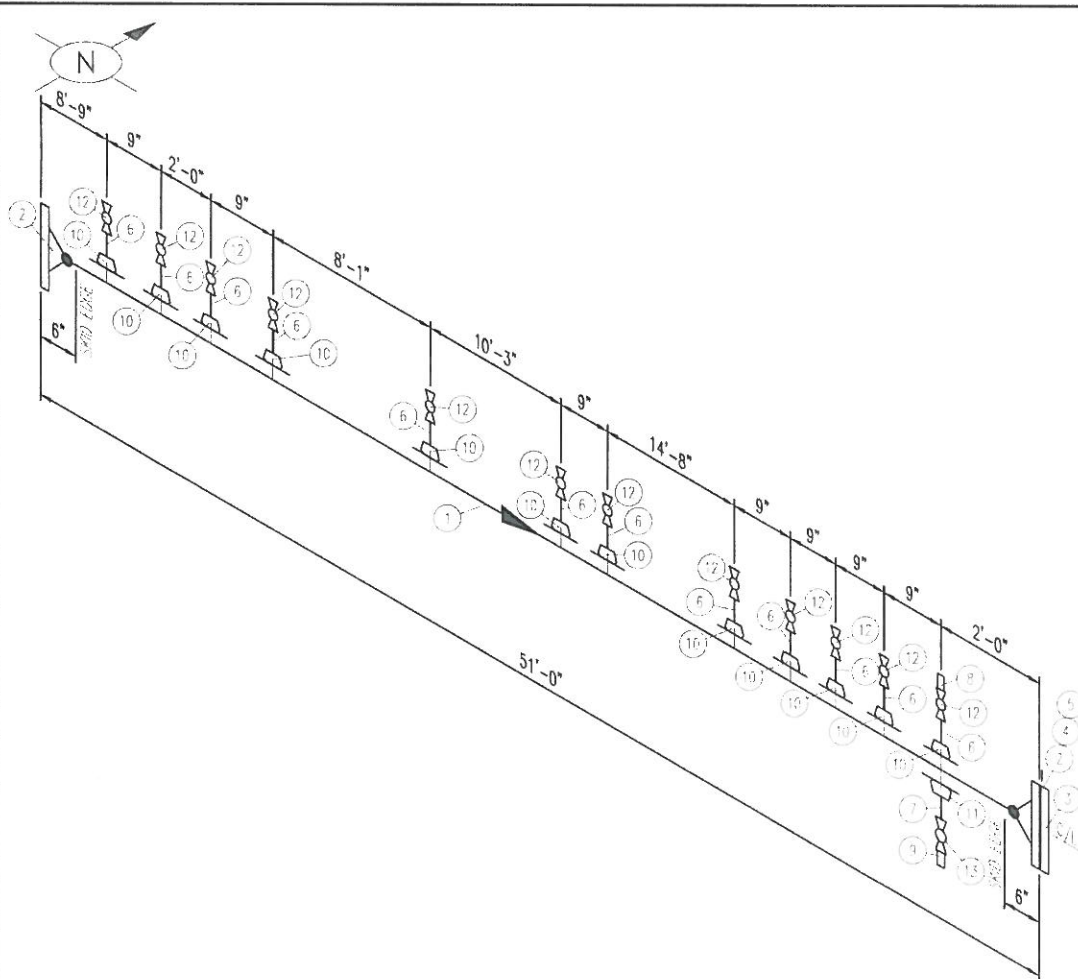

| BILL OF MATERIAL |     |         |  |        |         |
|------------------|-----|---------|--|--------|---------|
| MARK             | QTY | SIZE    | DESCRIPTION  |        | LENGTH  |
| 1                | 1   | 2"      | PIPE, KH SMLS, A-106-B   | D04408 | 50'-7"  |
| 2                | 2   | 2"      | FLG, BRWN 150LB KH, A-105  |        |         |
| 3                | 1   | 2"      | FLG, RE BRND 150LB, A-105  |        |         |
| 4                | 1   | 5/8"    | (4) STUD BOLTS, A-193-B7 w/ TWO HEAVY HEX NUTS, A-194-2H                                     |        | 3 1/2"  |
| 5                | 1   | 2"      | CRACKET, 1/8" THK, 150LB RE, SPIRALWOUND, 304SS WINDING, FLEXITE SUPER FILLER, CS GUIDE RING |        |         |
| 6                | 12  | 1/2"    | NIPPLE, S/160 SMLS, A-106-B TRF  |        | 3"      |
| 7                | 1   | 3/4"    | NIPPLE, KH SMLS, A-106-B TRF   |        | 5"      |
| 8                | 1   | 1/2"    | PLUG, SOLID STEEL, ROUND HEAD, A-105   |        |         |
| 9                | 1   | 1/4"    | PLUG, SOLID STEEL, ROUND HEAD, A-105   |        |         |
| 10               | 12  | 2"x1/2" | TGL, 3000LB FS, A-105  |        |         |
| 11               | 1   | 2"x3/4" | TGL, 3000LB FS, A-105  |        |         |
| 12               | 12  | 1/2"    | BALL VALVE, THRD, 2000 LB (APOLLO MODEL 76-103-01)   |        | 1 7/16" |
| 13               | 1   | 3/4"    | BALL VALVE, THRD, 2000 LB (APOLLO MODEL 76-104-01)   |        | 1 5/8"  |

**J-488**  
**04/11/18**  
**IFC**

\*\*\* = JOB #

Apr 10, 2018 - 4:13pm C:\Users\h235418\appdata\local\temp\AcPublish\_236140\


|                |            |                |                |     |                        |          |     |     |
|----------------|------------|----------------|----------------|-----|------------------------|----------|-----|-----|
| DESIGN PRESS.  | 150 Psig   | FAB. LOCATION  | SHOP           |     |                        |          |     |     |
| DESIGN TEMP.   | 150 °F     | SPOOL LOCATION | SKID #2        |     |                        |          |     |     |
| OPER. PRESS.   | 90 Psia    |                |                |     |                        |          |     |     |
| OPER. TEMP.    | AMBIENT °F | CORR. ALLOW.   | .0625"         |     |                        |          |     |     |
| STRESS RELIEVE | NO         | INSULATION     | NONE           | 0   | ISSUE FOR CONSTRUCTION | 04/25/11 | PLO | LH  |
| RADIOGRAPHY    | 15% NORMAL | PAINT          | TRCo SYSTEM #3 | NO. | REVISION               | DATE     | BY  | APR |

**CONFIDENTIAL STATEMENT**  
 THIS DRAWING IS THE PROPERTY OF THE THOMAS RUSSELL CO. AND IS NOT TO BE USED FOR ANY PURPOSE OTHER THAN THAT FOR WHICH IT IS SPECIFICALLY FURNISHED.

**FABRICATION NOTES:**  
 ALL VALVES ARE RASSED FACE UNLESS NOTED.  
 ALL FITTING MAKE-UP & OUT LEGS ARE FOR BW PIPE DO NOT INCLUDE WELD GAPS.  
 SHOP TO MAKE ADJUSTMENTS FOR WELD GAPS.  
 ALL PIPE SEAMLESS UNLESS NOTED OTHERWISE.  
 ALL COUPLING TO BE SHOULDER ON.

**Thomas Russell Co.**  
 7050 S. Yale, Suite 210  
 Tulsa, Oklahoma 74136  
 PH: 918-481-5662

|                  |                     |               |          |
|------------------|---------------------|---------------|----------|
| LINE No.         | 2" INSTRUMENT AIR   |               |          |
| ASSEMBLY DRAWING | SC6-402             |               |          |
| P&ID DRAWING     | ***-231-235/291/296 |               |          |
| DRAWN BY         | DV                  | DATE DRAWN    | 03/22/11 |
| JOB No.          | SC6                 | SPOOL ID. No. | SK2-041  |
| REV.             |                     |               | 0        |

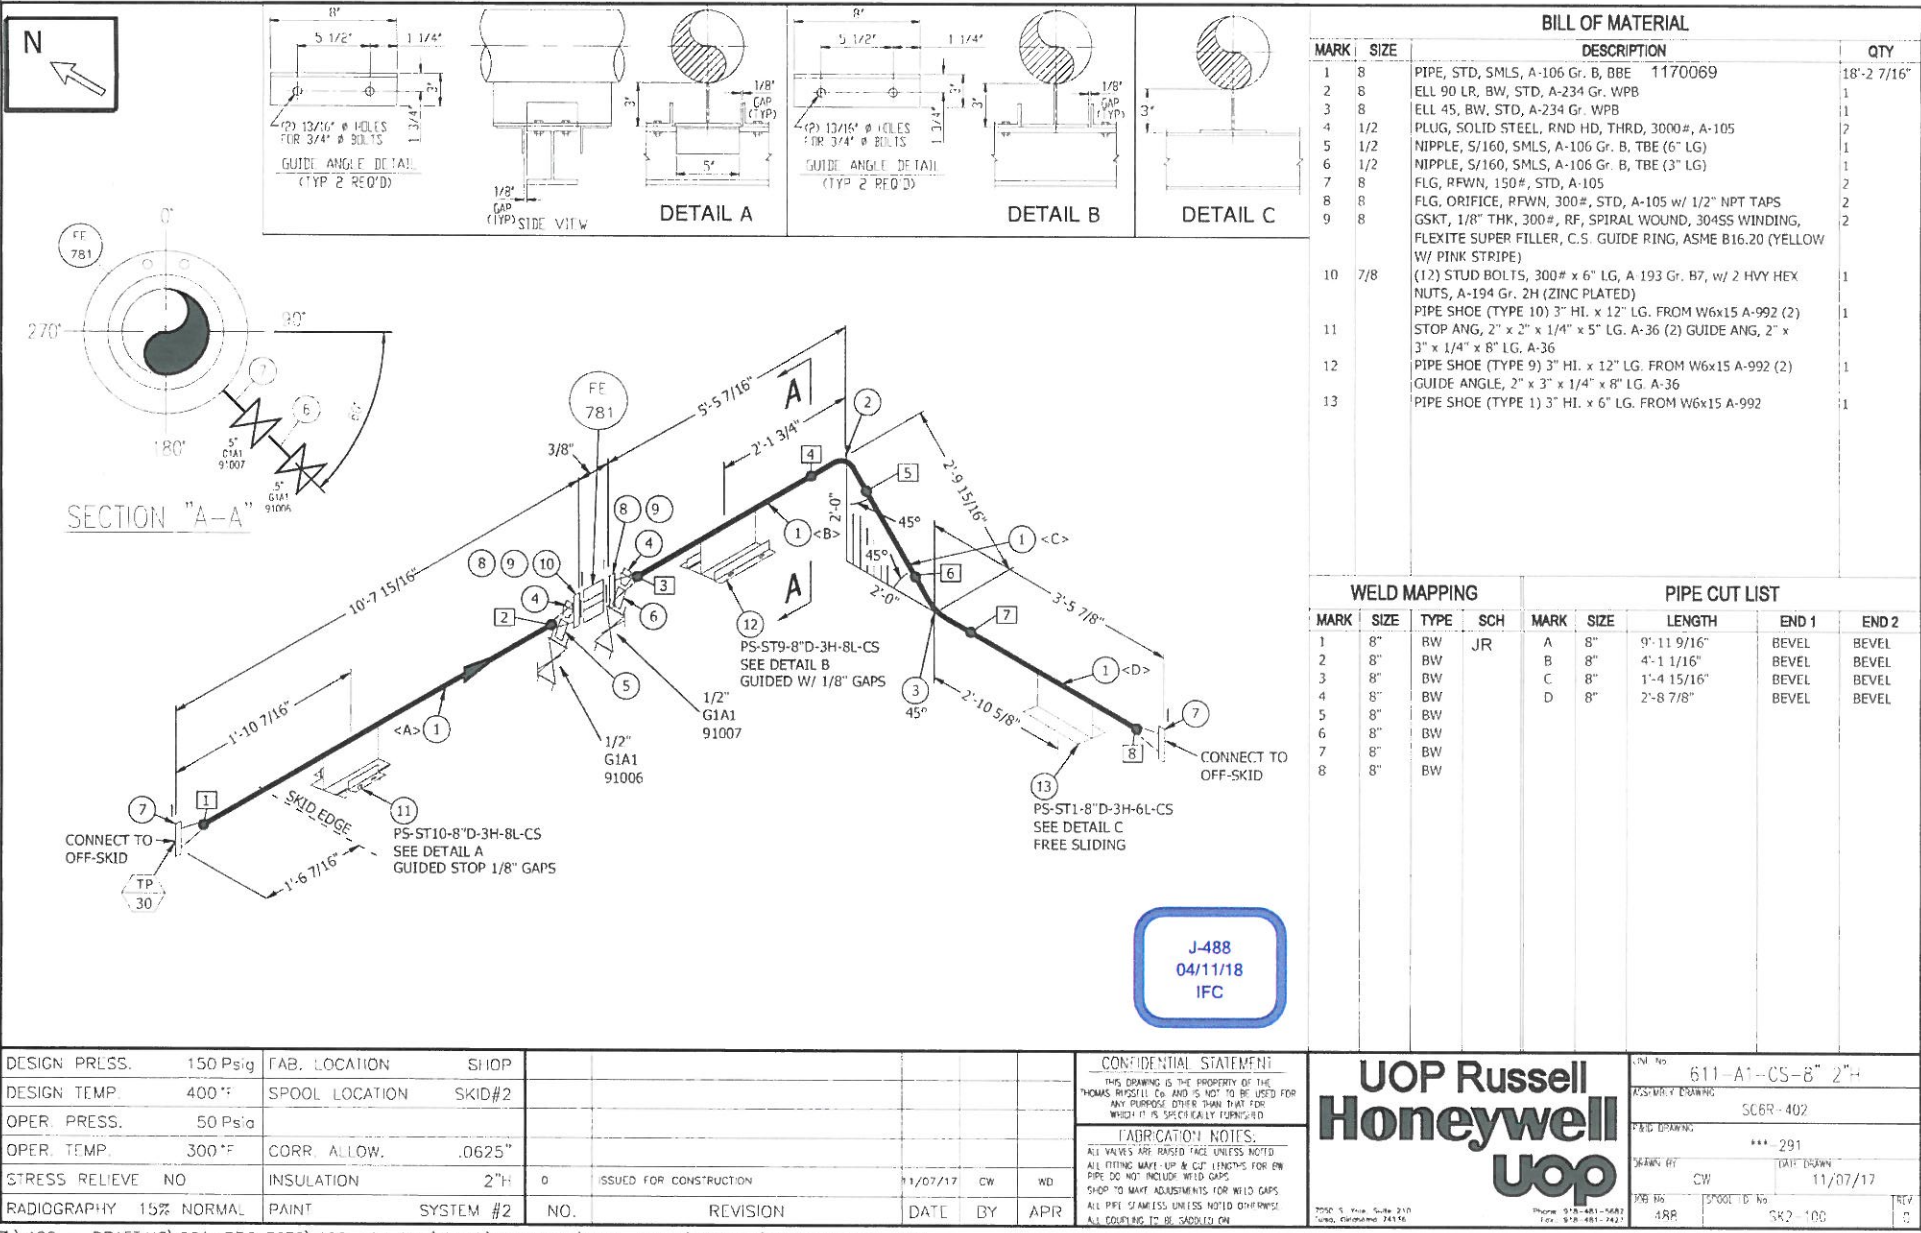

|                |            |                |           |
|----------------|------------|----------------|-----------|
| DESIGN PRESS.  | 150 Psig   | FAB. LOCATION  | SHOP      |
| DESIGN TEMP.   | 400 °F     | SPOOL LOCATION | SKID#2    |
| OPER. PRESS.   | 50 Psig    |                |           |
| OPER. TEMP.    | 300 °F     | CORR. ALLOW.   | .0625"    |
| STRESS RELIEVE | NO         | INSULATION     | 2" H      |
| RADIOGRAPHY    | 15% NORMAL | PAINT          | SYSTEM #2 |

**CONFIDENTIAL STATEMENT**  
 THIS DRAWING IS THE PROPERTY OF THE THOMAS RUSSELL CO. AND IS NOT TO BE USED FOR ANY PURPOSE OTHER THAN THAT FOR WHICH IT IS SPECIFICALLY ISSUED.




**FABRICATION NOTES:**  
 ALL VALVES ARE RAISED FACE UNLESS NOTED  
 ALL FITTING MAKE-UP & C.F. LENGTHS FOR BW PIPE DO NOT INCLUDE WELD GAPS  
 SHOP TO MAKE ADJUSTMENTS FOR WELD GAPS  
 ALL PIPE SEAMLESS UNLESS NOTED OTHERWISE  
 ALL EQUIPMENT TO BE SCHEDULE CW

**UOP Russell Honeywell**

UOP

Phone: 978-481-1487  
 Fax: 978-481-2421

|                  |                  |
|------------------|------------------|
| UNI No           | 611-A1-CS-8" 2"H |
| ASSEMBLY DRAWING | SC6R-402         |
| FIELD DRAWING    | ***-291          |
| DRAWN BY         | CW               |
| DATE DRAWN       | 11/07/17         |
| DWG No           | 488              |
| SPOOL ID No      | SK2-100          |
| REV              | 0                |

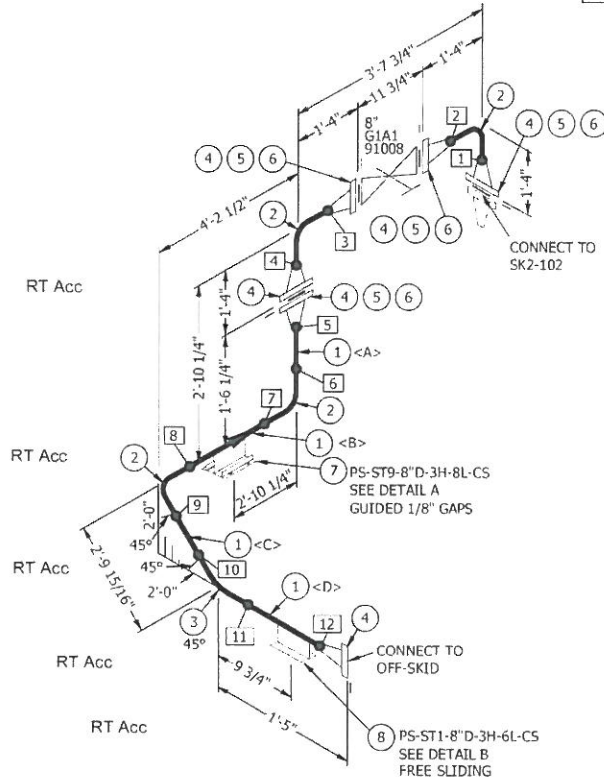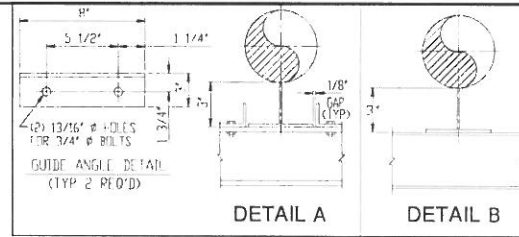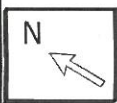

J-488  
04/11/18  
IFC

| BILL OF MATERIAL |      |  |         |            |
|------------------|------|--|---------|------------|
| MARK             | SIZE | DESCRIPTION  |         | QTY        |
| 1                | 8    | PIPE, STD, SMLS, A-106 Gr. B, BBE  | 1170278 | 4'-5 9/16" |
| 2                | 8    | ELL 90 LR, BW, STD, A-234 Gr. WPB  |         | 4          |
| 3                | 8    | ELL 45, BW, STD, A-234 Gr. WPB   |         | 1          |
| 4                | 8    | FLG, RFWN, 150#, STD, A-105  |         | 6          |
| 5                | 8    | GSKT, 1/8" THK, 150#, RF, SPIRAL WOUND, 304SS WINDING, FLEXITE SUPER FILLER, C.S. GUIDE RING, ASME B16.20 (YELLOW I/W PINK STRIPE) |         | 4          |
| 6                | 3/4  | (8) STUD BOLTS, 150# x 4 1/2" LG, A-193 Gr. B7, w/ 2 HVY HEX NUTS, A-194 Gr. 2H (ZINC PLATED)                                      |         | 4          |
| 7                | 8    | PIPE SHOE (TYPE 9) 3" HI. x 8" LG. FROM W6x15 A-992 (2)  |         | 1          |
| 8                | 8    | GUIDE ANGLE, 2" x 3" x 1/4" x 8" LG. A-36  |         | 1          |
|                  |      | PIPE SHOE (TYPE 1) 3" HI. x 6" LG. FROM W6x15 A-992  |         | 1          |

| WELD MAPPING |      |      |     | PIPE CUT LIST |      |             |       |       |
|--------------|------|------|-----|---------------|------|-------------|-------|-------|
| MARK         | SIZE | TYPE | SCH | MARK          | SIZE | LENGTH      | END 1 | END 2 |
| 1            | 8"   | BW   | O   | A             | 8"   | 2 1/8"      | BEVEL | BEVEL |
| 2            | 8"   | BW   | O   | B             | 8"   | 2'-2 1/2"   | BEVEL | BEVEL |
| 3            | 8"   | BW   | O   | C             | 8"   | 1'-4 15/16" | BEVEL | BEVEL |
| 4            | 8"   | BW   | O   | D             | 8"   | 8"          | BEVEL | BEVEL |
| 5            | 8"   | BW   | CC  |               |      |             |       |       |
| 6            | 8"   | BW   |     |               |      |             |       |       |
| 7            | 8"   | BW   |     |               |      |             |       |       |
| 8            | 8"   | BW   |     |               |      |             |       |       |
| 9            | 8"   | BW   |     |               |      |             |       |       |
| 10           | 8"   | BW   |     |               |      |             |       |       |
| 11           | 8"   | BW   |     |               |      |             |       |       |
| 12           | 8"   | BW   |     |               |      |             |       |       |

|                |            |                |           |
|----------------|------------|----------------|-----------|
| DESIGN PRESS   | 150 Psig   | FAB. LOCATION  | SHOP      |
| DESIGN TEMP    | 400 °F     | SPOOL LOCATION | SKID#2    |
| OPER. PRESS    | 50 Psig    |                |           |
| OPER. TEMP.    | 300 °F     | CORR. ALLOW.   | .0625"    |
| STRESS RELIEVE | NO         | INSULATION     | 2" H      |
| RADIOGRAPHY    | 15% NORMAL | PAINT          | SYSTEM #2 |
|                |            | NO.            |           |
|                |            | REVISION       |           |
|                |            | DATE           | 11/07/17  |
|                |            | BY             | CW        |
|                |            | APR            | WD        |




**CONFIDENTIAL STATEMENT**  
THIS DRAWING IS THE PROPERTY OF THE THOMAS RUSSELL CO AND IS NOT TO BE USED FOR ANY PURPOSE OTHER THAN THAT FOR WHICH IT IS SPECIFICALLY INTENDED.

**FABRICATION NOTES:**  
ALL VALVES ARE PASSED FACE UNLESS NOTED  
ALL FITTING MAKE-UP & CUT LENGTHS FOR BW PIPE DO NOT INCLUDE WELD GAPS  
SHOP TO MAKE ADJUSTMENTS FOR WELD GAPS  
ALL PIPE SEAMLESS UNLESS NOTED OTHERWISE  
ALL COUPLING TO BE SADDLED ON

**UOP Russell Honeywell**  
UOP

2700 S. Yale, Chicago, IL 60608  
Phone: 312-881-5887 Fax: 312-881-5821

|                  |                  |
|------------------|------------------|
| FIG. No.         | 611-A1-CS-8" 2"H |
| ASSEMBLY DRAWING | SC6R-402         |
| FIELD DRAWING    | *** 291          |
| DRAWN BY         | CW               |
| DATE DRAWN       | 11/07/17         |
| DWG No.          | 488              |
| SPOOL ID No.     | SK2-101          |
| REV              | 0                |

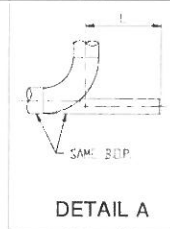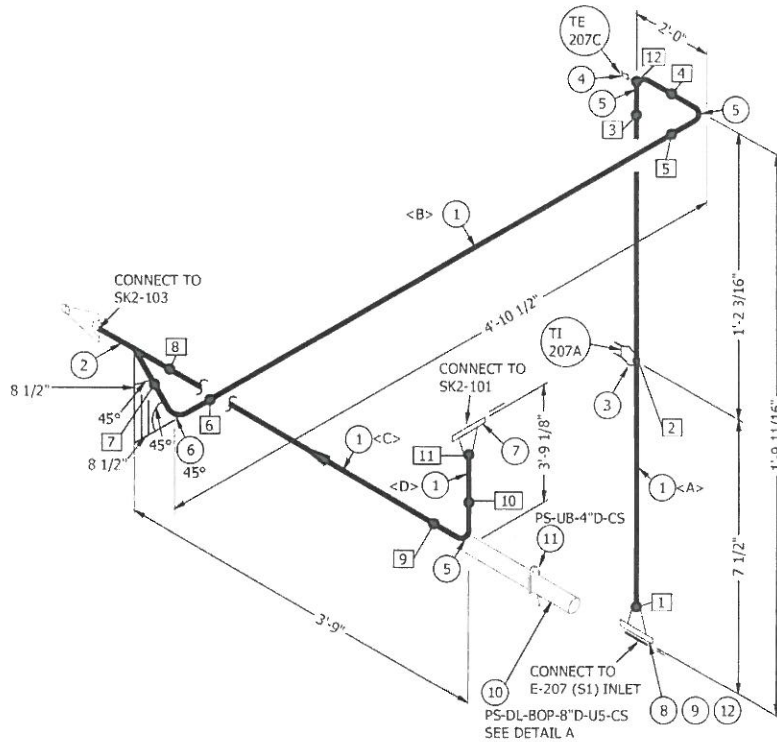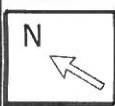

**J-488**  
**04/11/18**  
**IFC**

**BILL OF MATERIAL**

| MARK | SIZE  | DESCRIPTION   | QTY         |
|------|-------|---|-------------|
| 1    | 8     | PIPE, STD, SMLS, A-106 Gr. B, BBE 1170069   | 8'-5 15/16" |
| 2    | 8X8   | TEE, BW, STD, A-234 Gr. WPB   | 1           |
| 3    | 8X3/4 | CPLG, TOE, x 2 1/2" LG, 3000#, A-105  | 1           |
| 4    | 8X3/4 | E-O-L, THRD, 3000#, A-105   | 1           |
| 5    | 8     | ELL 90 LR, BW, STD, A-234 Gr. WPB   | 3           |
| 6    | 8     | ELL 45, BW, STD, A-234 Gr. WPB  | 1           |
| 7    | 8     | FLG, RFWN, 150#, STD, A-105   | 1           |
| 8    | 8     | GSKT, 1/8" THK, 300#, RF, SPIRAL WOUND, 304SS WINDING, FLEXITE SUPER FILLER, C.S. GUIDE RING, ASME B16.20 (YELLOW W/ PINK STRIPE) | 1           |
| 9    | 7/8   | (12) STUD BOLTS, 300#, A-193 Gr. B7, w/ 2 HVY HEX NUTS, A-194 Gr. 2H (ZINC PLATED) (5 3/4" LG)                                    | 1           |
| 10   |       | (1) PIPE, 4" STD, SMLS, x 4'-5 1/4" LG. A-106 Gr. B (1) END PL, 1/4" THK. x 4 3/8" O.D. A-36 (L=3'-5 1/4")                        | 1           |
| 11   |       | U-BOLT FOR 4" DIA PIPE W/ (4) HEX NUTS EA (CS ZINC PL)  | 1           |
| 12   | 8     | FLG, RFWN, 300#, STD, A-105   | 1           |

**WELD MAPPING**

| MARK | SIZE | TYPE | SCH |
|------|------|------|-----|
| 1    | 8"   | BW   | JR  |
| 2    | 3/4" | LET  |     |
| 3    | 8"   | BW   |     |
| 4    | 8"   | BW   |     |
| 5    | 8"   | BW   |     |
| 6    | 8"   | BW   |     |
| 7    | 8"   | BW   |     |
| 8    | 8"   | BW   |     |
| 9    | 8"   | BW   |     |
| 10   | 8"   | BW   |     |
| 11   | 8"   | BW   |     |
| 12   | 3/4" | LET  |     |

**PIPE CUT LIST**

| MARK | SIZE | LENGTH     | END 1 | END 2 |
|------|------|------------|-------|-------|
| 1    | 8"   | 5'-5 1/16" | BEVEL | BEVEL |
| 2    | 3/4" | 3'-5 1/2"  | BEVEL | BEVEL |
| 3    | 8"   | 2'-2"      | BEVEL | BEVEL |
| 4    | 8"   | 2'-5 1/8"  | BEVEL | BEVEL |



|                |            |                |           |
|----------------|------------|----------------|-----------|
| DESIGN PRESS.  | 150 Psig   | FAB. LOCATION  | SHOP      |
| DESIGN TEMP.   | 400 °F     | SPOOL LOCATION | SKID#2    |
| OPER. PRESS.   | 50 Psig    |                |           |
| OPER. TEMP.    | 300 °F     | CORR. ALLOW.   | 0625"     |
| STRESS RELIEVE | NO         | INSULATION     | 2"H       |
| RADIOGRAPHY    | 15% NORMAL | PAINT          | SYSTEM #2 |
|                |            | NO.            |           |
|                |            | REVISION       |           |
|                |            | DATE           |           |
|                |            | BY             |           |
|                |            | APR            |           |

**CONFIDENTIAL STATEMENT**  
 THIS DRAWING IS THE PROPERTY OF THE THOMAS RUSSELL CO. AND IS NOT TO BE USED FOR ANY PURPOSE OTHER THAN THAT FOR WHICH IT IS SPECIFICALLY INTENDED.


**FABRICATION NOTES:**  
 ALL VALVES ARE RAISED FACE UNLESS NOTED  
 ALL FITTING MAKE UP & CUT LENGTHS FOR BW PIPE DO NOT INCLUDE WELD GAPS  
 SHOP TO MAKE ADJUSTMENTS FOR WELD GAPS  
 ALL PIPE SEAMLESS UNLESS NOTED OTHERWISE  
 ALL COUPLING TO BE SADDLED ON

**UOP Russell**  
**Honeywell**  
**UOP**

|                  |                  |
|------------------|------------------|
| LINE NO.         | 611-A1-CS-8" 2"H |
| ESTIMATE DRAWING | SC6R-402         |
| PIPE DRAWING     | 888-291          |
| DRAWN BY         | CW               |
| CHECKED BY       | 11/13/17         |
| JOB NO.          | 488              |
| ISSUED NO.       | SC2-102          |
| REV              | 0                |

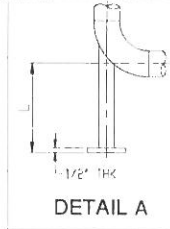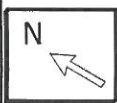

| BILL OF MATERIAL |      |   |     |        |
|------------------|------|---|-----|--------|
| MARK             | SIZE | DESCRIPTION   | QTY |        |
| 1                | 6    | PIPE, STD, SMLS, A-106 Gr. B, 17607172  | 7-7 | 13/16" |
| 2                | BX6  | RED ECC, BW, STD - STD, A-234 Gr. WPB   | 1   |        |
| 3                | 6X3  | RED CONC, BW, STD - STD, A-234 Gr. WPB  | 1   |        |
| 4                | 6    | ELL 90 LR, BW, STD, A-234 Gr. WPB   | 2   |        |
| 5                | 3    | FLG, RFWN, 150#, STD, A-105   | 1   |        |
| 6                | 3    | GSKT, 1/8" THK, 150#, RF, SPIRAL WOUND, 304SS WINDING, FLEXITE SUPER FILLER, C.S. GUIDE RING, ASME B16.20 (YELLOW W/ PINK STRIPE) | 2   |        |
| 7                | 5/8  | (4) STUD BOLTS, 150# x 10 1/2" LG, A-193 Gr. B7, w/ 2 HWY HEX NUTS, A-194 Gr. 2H (ZINC PLATED) (10 1/2" LG)                       | 2   |        |
| 8                |      | (1) PIPE, 3" STD, SMLS, x 2'-0" LG, A-106 Gr. B (1) BASE PL, 1/2" THK x 6" x 6" A-36 (L= 1'-3 1/2")                               | 1   |        |

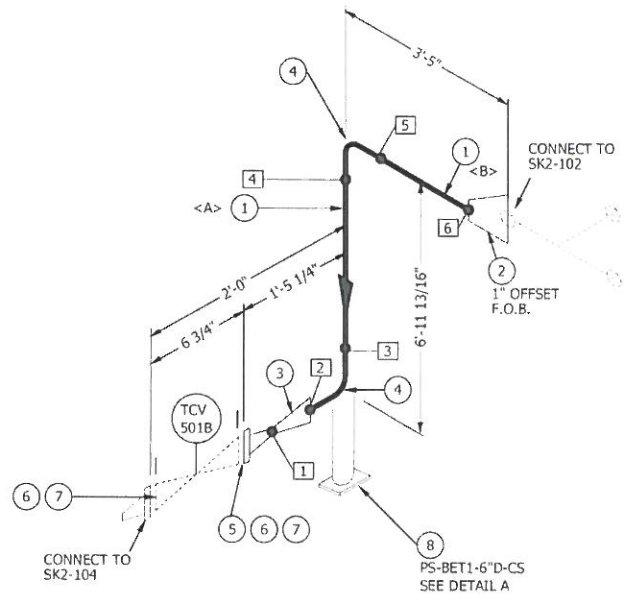

**J-488**  
 04/11/18  
 IFC

| WELD MAPPING |      |      |     | PIPE CUT LIST |      |             |       |       |
|--------------|------|------|-----|---------------|------|-------------|-------|-------|
| MARK         | SIZE | TYPE | SCH | MARK          | SIZE | LENGTH      | END 1 | END 2 |
| 1            | 3"   | BW   | JR  | A             | 6"   | 5'-5 13/16" | BEVEL | BEVEL |
| 2            | 6"   | BW   |     | B             | 6"   | 2'-2"       | BEVEL | BEVEL |
| 3            | 6"   | BW   |     |               |      |             |       |       |
| 4            | 6"   | BW   |     |               |      |             |       |       |
| 5            | 6"   | BW   |     |               |      |             |       |       |
| 6            | 6"   | BW   |     |               |      |             |       |       |

|                |            |                |           |     |                         |          |    |     |  |
|----------------|------------|----------------|-----------|-----|-------------------------|----------|----|-----|--|
| DESIGN PRESS.  | 150 Psig   | FAB. LOCATION  | SHOP      |     |                         |          |    |     |  |
| DESIGN TEMP.   | 400°F      | SPOOL LOCATION | SKID#2    |     |                         |          |    |     |  |
| OPER. PRESS.   | 50 Psig    |                |           |     |                         |          |    |     |  |
| OPER. TEMP.    | 300°F      | CORR. ALLOW.   | .0625"    |     |                         |          |    |     |  |
| STRESS RELIEVE | NO         | INSULATION     | 2" H      | 0   | ISSUED FOR CONSTRUCTION | 11/17/17 | CW | WD  |  |
| RADIOGRAPHY    | 15% NORMAL | PAINT          | SYSTEM #2 | NO. | REVISION                | DATE     | BY | APR |  |




**CONFIDENTIAL STATEMENT**  
 THIS DRAWING IS THE PROPERTY OF THE THOMAS RUSSELL CO AND IS NOT TO BE USED FOR ANY PURPOSE OTHER THAN THAT FOR WHICH IT IS SPECIFICALLY TURNED OVER.

**FABRICATION NOTES:**  
 ALL VALVES ARE RASHD FACE UNLESS NOTED  
 ALL FITTING MAKE-UP & CUT LENGTHS FOR BW PIPE DO NOT INCLUDE WELD GAPS  
 SHOP TO MAKE ADJUSTMENTS FOR WELD GAPS  
 ALL PIPE SEAMLESS UNLESS NOTED OTHERWISE  
 ALL CONNECTIONS TO BE SADDLED ON

**UOP Russell Honeywell**

7750 S. Yale, Suite 270  
 Denver, Colorado 80236  
 Phone: 303-481-5882  
 Fax: 303-481-7422

|                  |                  |
|------------------|------------------|
| LINE NO.         | 612-A1-CS-6" 2"H |
| ASSEMBLY DRAWING | SCBR-402         |
| FIELD DRAWING    | *** 291          |
| DRAWN BY         | CW               |
| DATE DRAWN       | 11/13/17         |
| JOB NO.          | 488              |
| SPOOL ID NO.     | SK2-103          |
| REV              | 0                |

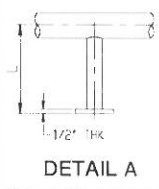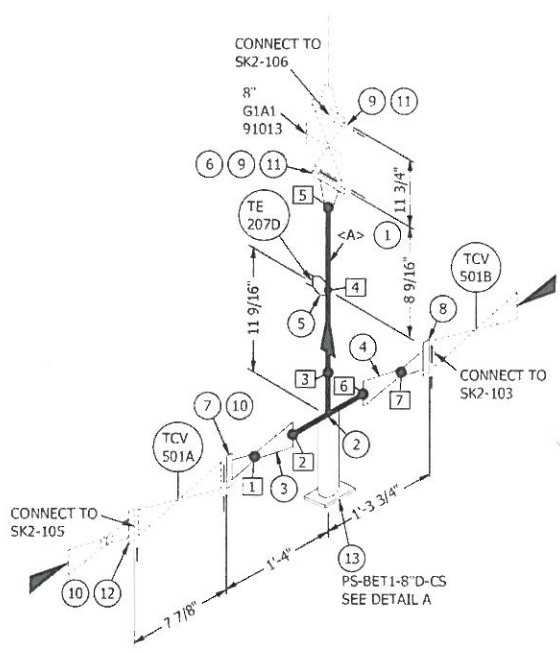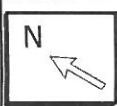

| BILL OF MATERIAL |       |   |         |           |
|------------------|-------|---|---------|-----------|
| MARK             | SIZE  | DESCRIPTION   |         | QTY       |
| 1                | 8     | PIPE, STD, SMLS, A-106 Gr. B, BBE   | 1170278 | 0'-9 1/8" |
| 2                | 8X8   | TEE, BW, STD, A-234 Gr. WPB   |         | 1         |
| 3                | 8X4   | RED CONC, BW, STD - STD, A-234 Gr. WPB  |         | 1         |
| 4                | 8X3   | RED CONC, BW, STD - STD, A-234 Gr. WPB  |         | 1         |
| 5                | 8X3/4 | CPLG. TOE, x 2 1/2" LG, 3000#, A-105  |         | 1         |
| 6                | 8     | FLG, RFWN, 150#, STD, A-105   |         | 1         |
| 7                | 4     | FLG, RFWN, 150#, STD, A-105   |         | 1         |
| 8                | 3     | FLG, RFWN, 150#, STD, A-105   |         | 1         |
| 9                | 8     | GSKT, 1/8" THK, 150#, RF, SPIRAL WOUND, 304SS WINDING, FLEXITE SUPER FILLER, C.S. GUIDE RING, ASME B16.20 (YELLOW W/ PINK STRIPE) |         | 2         |
| 10               | 4     | GSKT, 1/8" THK, 150#, RF, SPIRAL WOUND, 304SS WINDING, FLEXITE SUPER FILLER, C.S. GUIDE RING, ASME B16.20 (YELLOW W/ PINK STRIPE) |         | 2         |
| 11               | 3/4   | (8) STUD BOLTS, 150# x 4 1/2" LG, A-193 Gr. B7, w/ 2 HVY HEX NUTS, A-194 Gr. 2H (ZINC PLATED)                                     |         | 2         |
| 12               | 5/8   | (8) STUD BOLTS, 150# x 11 1/2" LG, A-193 Gr. B7, w/ 2 HVY HEX NUTS, A-194 Gr. 2H (ZINC PLATED)                                    |         | 1         |
| 13               |       | (1) PIPE, 4" STD, SMLS, x 1'-3" LG, A-106 Gr. B (1) BASE PL, 1/2" THK. x 6" x 6" A-36 (L=1'-3 1/2")                               |         | 1         |

| WELD MAPPING |      |      |     | PIPE CUT LIST |      |        |       |       |
|--------------|------|------|-----|---------------|------|--------|-------|-------|
| MARK         | SIZE | TYPE | SCH | MARK          | SIZE | LENGTH | END 1 | END 2 |
| 1            | 4"   | BW   | S   | A             | 8"   | 9 1/8" | BEVEL | BEVEL |
| 2            | 8"   | BW   |     |               |      |        |       |       |
| 3            | 8"   | BW   |     |               |      |        |       |       |
| 4            | 3/4" | LET  |     |               |      |        |       |       |
| 5            | 8"   | BW   |     |               |      |        |       |       |
| 6            | 8"   | BW   |     |               |      |        |       |       |
| 7            | 3"   | BW   |     |               |      |        |       |       |

**J-488**  
 04/11/18  
 IFC


|                |            |                |           |     |                         |        |     |     |  |
|----------------|------------|----------------|-----------|-----|-------------------------|--------|-----|-----|--|
| DESIGN PRESS.  | 150 Psig   | FAB. LOCATION  | SHOP      |     |                         |        |     |     |  |
| DESIGN TEMP.   | 400 °F     | SPOOL LOCATION | SKID#2    |     |                         |        |     |     |  |
| OPER. PRESS.   | 40 Psig    |                |           |     |                         |        |     |     |  |
| OPER. TEMP.    | 200 °F     | CORR. ALLOW.   | .0625"    |     |                         |        |     |     |  |
| STRESS RELIEVE | NO         | INSULATION     | 2"H       | 0   | ISSUED FOR CONSTRUCTION | 4/2/18 | COB | WC  |  |
| RADIOGRAPHY    | 15% NORMAL | PAINT          | SYSTEM #2 | NO. | REVISION                | DATE   | BY  | APR |  |

**CONFIDENTIAL STATEMENT**  
 THIS DRAWING IS THE PROPERTY OF THE THOMAS RUSSELL CO. AND IS NOT TO BE USED FOR ANY PURPOSE OTHER THAN THAT FOR WHICH IT IS SPECIFICALLY PREPARED.

**FABRICATION NOTES:**  
 ALL VALVES ARE RAISED FACE UNLESS NOTED  
 ALL FITTING MAKE-UP & CUT LENGTHS FOR BW PIPE DO NOT INCLUDE WELD GAPS  
 SHOP TO MAKE ADJUSTMENTS FOR WELD GAPS  
 ALL PIPE SEAMLESS UNLESS NOTED OTHERWISE  
 ALL COUPLING TO BE SADDLED ON

**UOP Russell**  
**Honeywell**  
**UOP**

|                  |                  |
|------------------|------------------|
| LINE NO.         | 614-A1-CS-8" 2"H |
| ASSEMBLY DRAWING | SC6R-402         |
| P&ID DRAWING     | ***-291          |
| DRAWN BY         | COB              |
| DATE DRAWN       | 4/2/18           |
| JOB NO.          | 488              |
| SPOOL ID NO.     | SK2-104          |
| REV              | 0                |

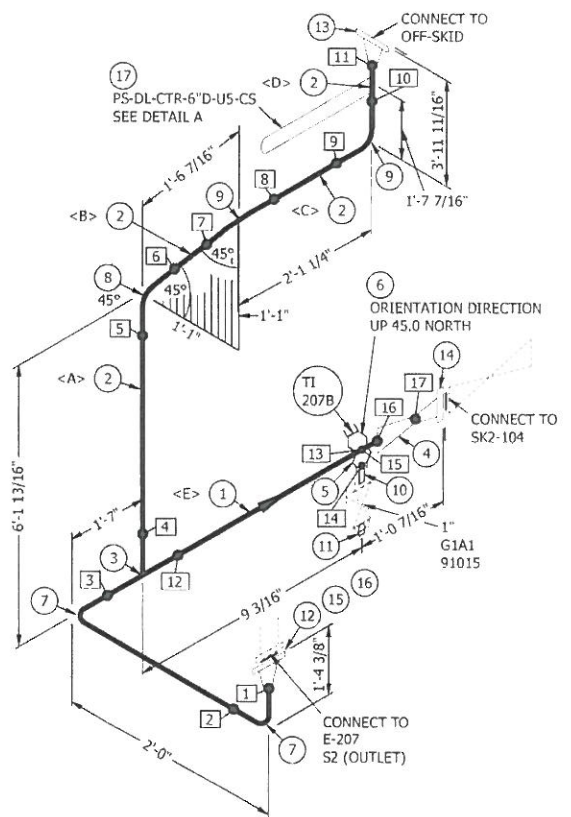

**BILL OF MATERIAL**

| MARK | SIZE  | DESCRIPTION   | QTY       |
|------|-------|---|-----------|
| 1    | 8     | PIPE, STD, SMLS, A-106 Gr. B, BBE 1170069   | 0'-5 5/8" |
| 2    | 6     | PIPE, STD, SMLS, A-106 Gr. B, BBE 17607172  | 9'-3 1/2" |
| 3    | 8x6   | TEE RED, BW, STD - STD, A-234 Gr. WPB   | 1         |
| 4    | 8x4   | RED CONC, BW, STD - STD, A-234 Gr. WPB  | 1         |
| 5    | 8X1   | S-O-L, SW, 3000#, A-105   | 1         |
| 6    | 8X3/4 | CPLG, TOE, x 2 1/2" LG, 3000#, A-105  | 1         |
| 7    | 8     | ELL 90 LR, BW, STD, A-234 Gr. WPB   | 2         |
| 8    | 6     | ELL 45, BW, STD, A-234 Gr. WPB  | 1         |
| 9    | 6     | ELL 90 LR, BW, STD, A-234 Gr. WPB   | 2         |
| 10   | 1     | NIPPLE, XH, SMLS, A-106 Gr. B, x 3" LG, POE-TOE   | 1         |
| 11   | 1     | PLUG, SOLID STEEL, RND HD, THRD, 3000#, A-105   | 1         |
| 12   | 8     | FLG, RFWN, 300#, STD, A-105   | 1         |
| 13   | 6     | FLG, RFWN, 150#, STD, A-105   | 1         |
| 14   | 4     | FLG, RFWN, 150#, STD, A-105   | 1         |
| 15   | 8     | GSKT, 1/8" THK, 300#, RF, SPIRAL WOUND, 304SS WINDING, FLEXITE SUPER FILLER, C.S. GUIDE RING, ASME B16.20 (YELLOW W/ PINK STRIPE) | 1         |
| 16   | 7/8   | (12) STUD BOLTS, 300# x 5 3/4" LG, A-193 Gr. B7, w/ 2 HVY HEX NUTS, A-194 Gr. 2H (ZINC PLATED)                                    | 1         |
| 17   | 6     | (1) PIPE, 3" STD, SMLS, x 2'-0" LG, A-106 Gr. B (1) END PL, 1/4" THK, x 3 3/8" O.D. A-36 (L=2'-0")                                | 1         |

**WELD MAPPING**

| MARK | SIZE | TYPE | SCH |
|------|------|------|-----|
| 1    | 8"   | BW   | JR  |
| 2    | 8"   | BW   |     |
| 3    | 8"   | BW   |     |
| 4    | 6"   | BW   | D   |
| 5    | 6"   | BW   | E   |
| 6    | 6"   | BW   |     |
| 7    | 6"   | BW   |     |
| 8    | 6"   | BW   |     |
| 9    | 6"   | BW   |     |
| 10   | 6"   | BW   |     |
| 11   | 6"   | BW   |     |
| 12   | 8"   | BW   | A   |
| 13   | 1"   | LET  | A   |
| 14   | 1"   | SW   | A   |
| 15   | 3/4" | LET  | A   |
| 16   | 8"   | BW   | A   |
| 17   | 4"   | BW   | A   |

**PIPE CUT LIST**


| MARK | SIZE | LENGTH      | END 1 | END 2 |
|------|------|-------------|-------|-------|
| 1    | 8"   | 5'-3 7/16"  | BEVEL | BEVEL |
| 2    | 8"   | 5 5/8"      | BEVEL | BEVEL |
| 3    | 8"   | 7 1/4"      | BEVEL | BEVEL |
| 4    | 6"   | 2'-11 3/16" | BEVEL | BEVEL |
| 5    | 6"   | 5 5/8"      | BEVEL | BEVEL |
| 6    | 6"   |             |       |       |
| 7    | 6"   |             |       |       |
| 8    | 6"   |             |       |       |
| 9    | 6"   |             |       |       |
| 10   | 6"   |             |       |       |
| 11   | 6"   |             |       |       |
| 12   | 8"   |             |       |       |
| 13   | 1"   |             |       |       |
| 14   | 1"   |             |       |       |
| 15   | 3/4" |             |       |       |
| 16   | 8"   |             |       |       |
| 17   | 4"   |             |       |       |

**J-488**  
 04/11/18  
 IFC



|                |            |                |           |     |                         |          |    |     |  |
|----------------|------------|----------------|-----------|-----|-------------------------|----------|----|-----|--|
| DESIGN PRESS.  | 150 Psig   | FAB. LOCATION  | SHOP      |     |                         |          |    |     |  |
| DESIGN TEMP.   | 400 °F     | SPOOL LOCATION | SKID#2    |     |                         |          |    |     |  |
| OPER. PRESS.   | 40 Psig    |                |           |     |                         |          |    |     |  |
| OPER. TEMP.    | 200 °F     | CORR. ALLOW.   | .0625"    |     |                         |          |    |     |  |
| STRESS RELIEVE | NO         | INSULATION     | 2"H       | 0   | ISSUED FOR CONSTRUCTION | 11/17/17 | CW | WC  |  |
| RADIOGRAPHY    | 15% NORMAL | PAINT          | SYSTEM #2 | NO. | REVISION                | DATE     | BY | APR |  |

**CONFIDENTIAL STATEMENT**  
 THIS DRAWING IS THE PROPERTY OF THE THOMAS RUSSELL CO. AND IS NOT TO BE USED FOR ANY PURPOSE OTHER THAN THAT FOR WHICH IT IS SPECIFICALLY SUBMITTED.


**FABRICATION NOTES:**  
 ALL VALVES ARE RANSE FACE UNLESS NOTED  
 ALL FITTINGS MARK UP TO CUT LENGTHS FOR BW PIPE DO NOT INCLUDE WELD CAPS  
 SHOW TO MAKE ADJUSTMENTS FOR WELD CAPS  
 ALL PIPE SEAMLESS UNLESS NOTED OTHERWISE  
 ALL COUPLING TO BE SADDLED ON

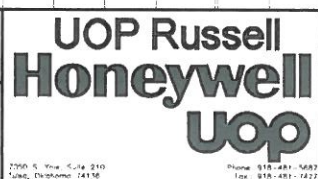

|                 |                  |
|-----------------|------------------|
| PIPI No         | 614-A1-CS-8" 2"H |
| ASSUMED DRAWING | SCGR-402         |
| PIPI DRAWING    | *** 291          |
| DRAWN BY        | CW               |
| DATE DRAWN      | 11/14/17         |
| SPR No          | 488              |
| SPOOL ID No     | SK2-105          |
| REV             | 0                |

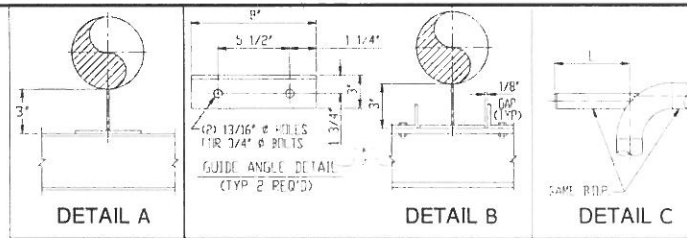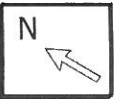

| BILL OF MATERIAL |       |  |            |
|------------------|-------|--|------------|
| MARK             | SIZE  | DESCRIPTION  | QTY        |
| 1                | 8     | PIPE, STD, SMLS, A-106 Gr. B, BBE 1170069                  | 15'-1 3/4" |
| 2                | 8X1/2 | CPLG, TOE, x 2 1/2" LG, 3000#, A-105                       | 1          |
| 3                | 8     | ELL 90 LR, BW, STD, A-234 Gr. WPB                          | 4          |
| 4                | 8     | ELL 45, BW, STD, A-234 Gr. WPB                             | 1          |
| 5                | 1/2   | PLUG, SOLID STEEL, RND HD, THRD, 3000#, A-105              | 1          |
| 6                | 8     | FLG, RFWN, 150#, STD, A-105                                | 2          |
| 7                | 8     | (1) PIPE, 4" STD, SMLS, x 3'-9 13/16" LG, A-106 Gr. B (11) | 1          |
| 8                | 8     | END PL, 1/4" THK x 4 3/8" O.D. A-36 (L=2'-9 13/16")        | 1          |
| 9                | 8     | PIPE SHOE (TYPE 9) 3" HI. x 8" LG. FROM W6x15 A-992 (2)    | 1          |
|                  |       | GUIDE ANGLE, 2" x 3" x 1/4" x 8" LG. A-36                  |            |
|                  |       | PIPE SHOE (TYPE 1) 3" HI. x 6" LG. FROM W6x15 A-992        | 2          |

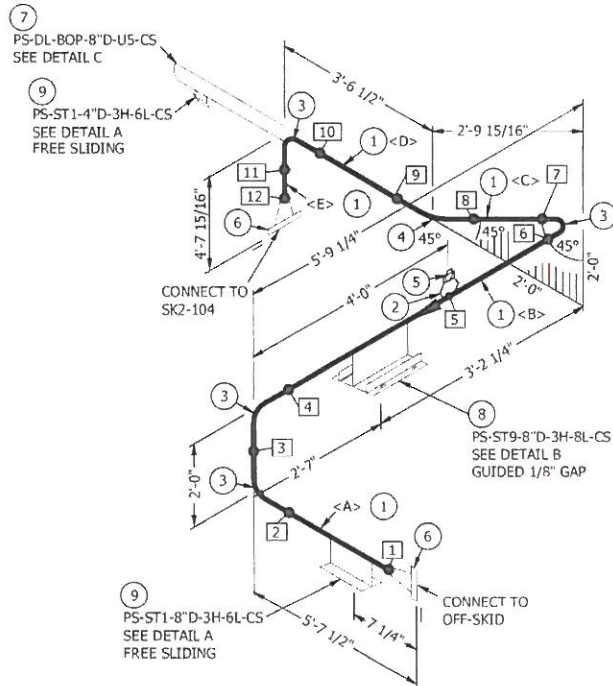

J-488  
 04/11/18  
 IFC

| WELD MAPPING |      |      |             | PIPE CUT LIST |      |             |       |       |
|--------------|------|------|-------------|---------------|------|-------------|-------|-------|
| MARK         | SIZE | TYPE | SCH         | MARK          | SIZE | LENGTH      | END 1 | END 2 |
| 1            | 8"   | BW   | S<br>S<br>T | A             | 8"   | 4'-3 1/2"   | BEVEL | BEVEL |
| 2            | 8"   | BW   |             | B             | 8"   | 3'-9 1/4"   | BEVEL | BEVEL |
| 3            | 8"   | BW   |             | C             | 8"   | 1'-4 15/16" | BEVEL | BEVEL |
| 4            | 8"   | BW   |             | D             | 8"   | 2'-1 1/2"   | BEVEL | BEVEL |
| 5            | 1/2" | LET  |             | E             | 8"   | 3'-3 15/16" | BEVEL | BEVEL |
| 6            | 8"   | BW   |             |               |      |             |       |       |
| 7            | 8"   | BW   |             |               |      |             |       |       |
| 8            | 8"   | BW   |             |               |      |             |       |       |
| 9            | 8"   | BW   |             |               |      |             |       |       |
| 10           | 8"   | BW   |             |               |      |             |       |       |
| 11           | 8"   | BW   |             |               |      |             |       |       |
| 12           | 8"   | BW   |             |               |      |             |       |       |

|                |            |                |           |     |                         |          |    |     |  |
|----------------|------------|----------------|-----------|-----|-------------------------|----------|----|-----|--|
| DESIGN PRESS.  | 150 Psig   | FAB. LOCATION  | SHOP      |     |                         |          |    |     |  |
| DESIGN TEMP.   | 400 °F     | SPOOL LOCATION | SKID#2    |     |                         |          |    |     |  |
| OPER. PRESS.   | 40 Psig    |                |           |     |                         |          |    |     |  |
| OPER. TEMP.    | 200 °F     | CORR. ALLOW.   | .0625"    |     |                         |          |    |     |  |
| STRESS RELIEVE | NO         | INSULATION     | 2"H       | C   | ISSUED FOR CONSTRUCTION | 11/17/17 | CW | WD  |  |
| RADIOGRAPHY    | 15% NORMAL | PAINT          | SYSTEM #2 | NO. | REVISION                | DATE     | BY | APR |  |



**CONFIDENTIAL STATEMENT**  
 THIS DRAWING IS THE PROPERTY OF THE THOMAS RUSSELL CO. AND IS NOT TO BE USED FOR ANY PURPOSE OTHER THAN THAT FOR WHICH IT IS SPECIFICALLY FURNISHED.

**FABRICATION NOTES:**  
 ALL VALVES ARE RASG FACE UNLESS NOTED.  
 ALL FITTING MARK-UP & CUT LENGTHS FOR BW PIPE DO NOT INCLUDE WELD GAPS.  
 SHOP TO MAKE ADJUSTMENTS FOR WELD GAPS.  
 ALL PIPE SEAMLESS UNLESS NOTED OTHERWISE.  
 ALL COUPLING TO BE SADDLED ON.


**UOP Russell Honeywell Uop**

2790 S. Yale, Suite 210 Tulsa, Oklahoma 74136 Phone: 918-481-5882 Fax: 918-481-7427

|                  |                  |
|------------------|------------------|
| LINE NO.         | 614-A1-CS-8" 2"H |
| ASSEMBLY DRAWING | SC6R-402         |
| FIELD DRAWING    | ***-291          |
| DESIGNED BY      | CW               |
| DATE DRAWN       | 11/14/17         |
| DWG. NO.         | 488              |
| SPOOL TO NO.     | 542-105          |
| REV.             | 0                |

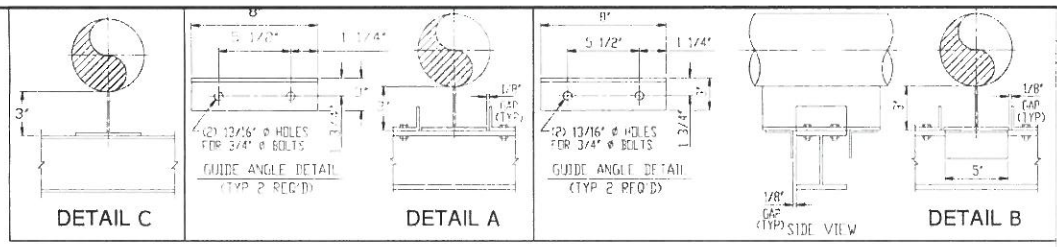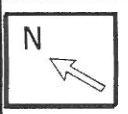

| BILL OF MATERIAL |      |  |             |
|------------------|------|--|-------------|
| MARK             | SIZE | DESCRIPTION  | QTY         |
| 1                | 8    | PIPE, STD, SMLS, A-106 Gr. B, BBE 1170069  | 18'-2 7/16" |
| 2                | 8    | ELL 45, BW, STD, A-234 Gr. WPB   | 1           |
| 3                | 8    | ELL 90 LR, BW, STD, A-234 Gr. WPB  | 1           |
| 4                | 8    | FLG, RFWN, 150#, STD, A-105  | 2           |
| 5                | 8    | PIPE SHOE (TYPE 1) 3" HI. x 6" LG. FROM W6x15 A-992                                | 1           |
| 6                | 8    | PIPE SHOE (TYPE 9) 3" HI. x 8" LG. FROM W6x15 A-992 (2)                            | 1           |
|                  |      | GUIDE ANGLE, 2" x 3" x 1/4" x 8" LG. A-36  |             |
| 7                | 8    | PIPE SHOE (TYPE 10) 3" HI. x 12" LG. FROM W6x15 A-992 (2)                          | 1           |
|                  |      | STOP ANG, 2" x 2" x 1/4" x 5" LG. A-36 (2) GUIDE ANG, 2" x 3" x 1/4" x 8" LG. A-36 |             |

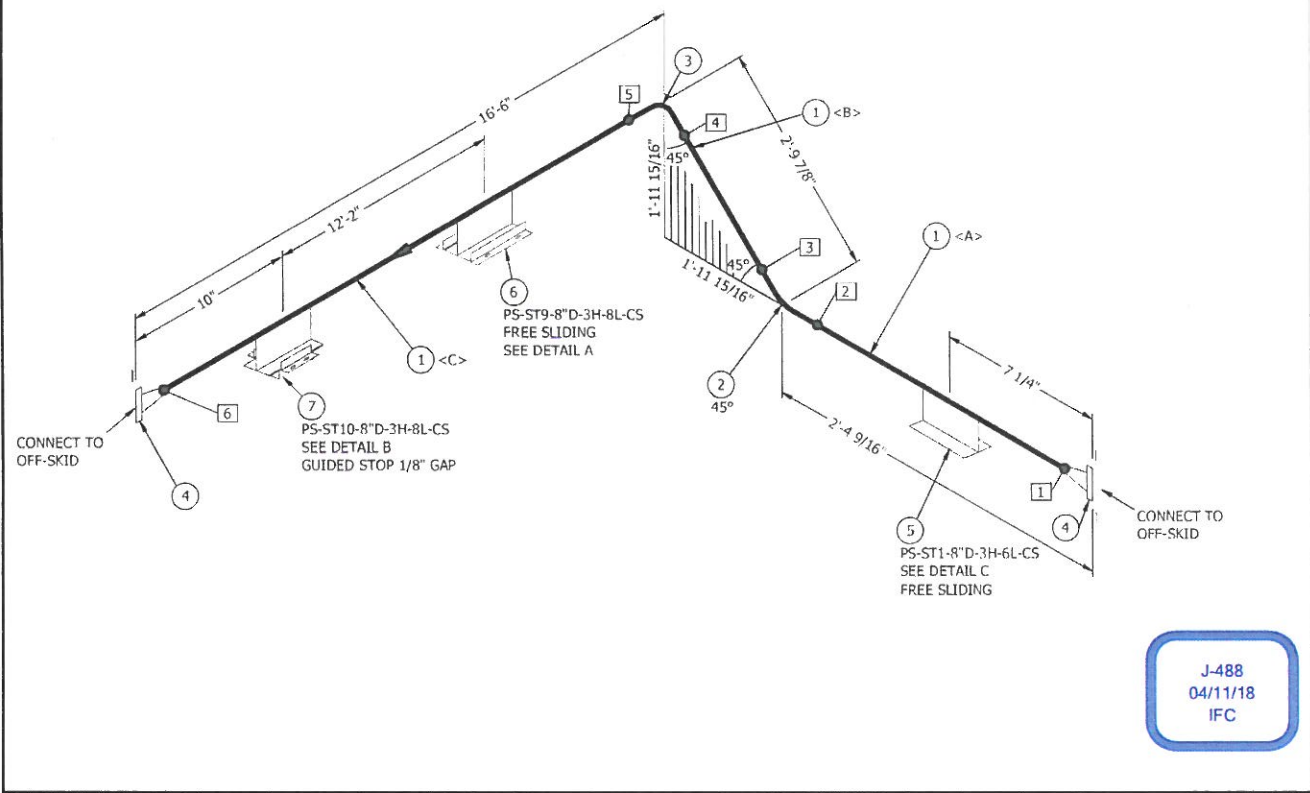


| WELD MAPPING |      |      |     | PIPE CUT LIST |      |            |       |       |
|--------------|------|------|-----|---------------|------|------------|-------|-------|
| MARK         | SIZE | TYPE | SCH | MARK          | SIZE | LENGTH     | END 1 | END 2 |
| 1            | 8"   | BW   | JR  | A             | 8"   | 1'-7 9/16" | BEVEL | BEVEL |
| 2            | 8"   | BW   |     | B             | 8"   | 1'-4 7/8"  | BEVEL | BEVEL |
| 3            | 8"   | BW   |     | C             | 8"   | 15'-2"     | BEVEL | BEVEL |
| 4            | 8"   | BW   |     |               |      |            |       |       |
| 5            | 8"   | BW   |     |               |      |            |       |       |
| 6            | 8"   | BW   |     |               |      |            |       |       |



|                |            |                |           |     |                         |          |    |     |  |
|----------------|------------|----------------|-----------|-----|-------------------------|----------|----|-----|--|
| DESIGN PRESS.  | 150 Psig   | FAB. LOCATION  | SHIP      |     |                         |          |    |     |  |
| DESIGN TEMP.   | 400 °f     | SPOOL LOCATION | SKID#2    |     |                         |          |    |     |  |
| OPER. PRESS.   | 40 Psig    |                |           |     |                         |          |    |     |  |
| OPER. TEMP.    | 200 °f     | CORR. ALLOW.   | .0625"    |     |                         |          |    |     |  |
| STRESS RELIEVE | NO         | INSULATION     | 2" H      | 0   | ISSUED FOR CONSTRUCTION | 01/17/17 | CW | WD  |  |
| RADIOGRAPHY    | 15% NORMAL | PAINT          | SYSTEM #2 | NO. | REVISION                | DATE     | BY | APR |  |

**CONFIDENTIAL STATEMENT**  
 THIS DRAWING IS THE PROPERTY OF THE THOMAS RUSSELL CO. AND IS NOT TO BE USED FOR ANY PURPOSE OTHER THAN THAT FOR WHICH IT IS SPECIFICALLY FURNISHED.


**FABRICATION NOTES:**  
 ALL VALVES ARE BARBED FACE UNLESS NOTED  
 ALL FITTINGS MARK, UP & CUT LENGTHS FOR BW PIPE DO NOT INCLUDE WELD GAPS  
 SHOP IC MAKE ADJUSTMENTS FOR WELD GAPS  
 ALL PIPE SEAMLESS UNLESS NOTED OTHERWISE!  
 ALL COUPLING TO BE SADDLED ON

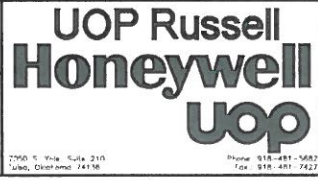

|                  |                   |
|------------------|-------------------|
| PIPE No          | 614-A1-CS-8" 2" H |
| ASSEMBLY DRAWING | SC6R-402          |
| FIELD DRAWING    | ***-291           |
| DRAWN BY         | CW                |
| DATE DRAWN       | 11/14/17          |
| JOB No           | 488               |
| SPOOL ID No      | SK2-107           |
| REV              | 0                 |

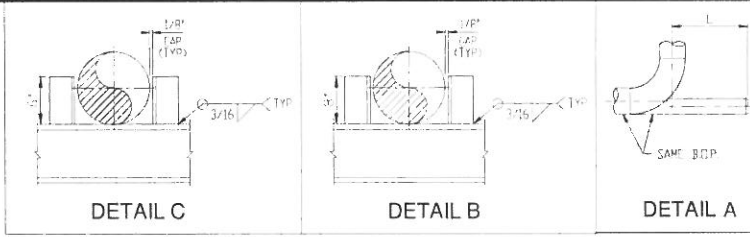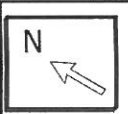

| BILL OF MATERIAL |        |  |            |
|------------------|--------|--|------------|
| MARK             | SIZE   | DESCRIPTION  | QTY        |
| 1                | 12     | PIPE, STD, SMLS, A-106 Gr. B, BBE 173201   | 28'-7 1/8" |
| 2                | 12X3/4 | S-O-L, SW, 3000#, A-105  | 1          |
| 3                | 12     | ELL 90 LR, BW, STD, A-234 Gr. WPB  | 2          |
| 4                | 3/4    | NIPPLE, X14, SMLS, A-106 Gr. B, x 3" LG, POE-TOE   | 1          |
| 5                | 3/4    | PLUG, SOLID STEEL, RND HD, THRD, 3000#, A-105  | 1          |
| 6                | 12     | FLG, RFWN, 300#, STD, A-105  | 2          |
| 7                | 12     | (1) PIPE, 8" STD, SMLS, x 3'-6" LG. A-106 Gr. B (1) END PL, 1/4" THK. x 8 1/2" O.D. A-36 (L=2'-0") | 1          |
| 8                | 12     | (1) PIPE, 8" STD, SMLS, x 6'-3" LG. A-106 Gr. B (1) END PL, 1/4" THK. x 8 1/2" O.D. A-36 (L=4'-9") | 1          |
| 9                |        | ANGLE, 3"x3"x1/4", A-36, 8" LG   | 2          |
| 10               |        | ANGLE, 2"x2"x1/4", A-36, 6" LG   | 2          |

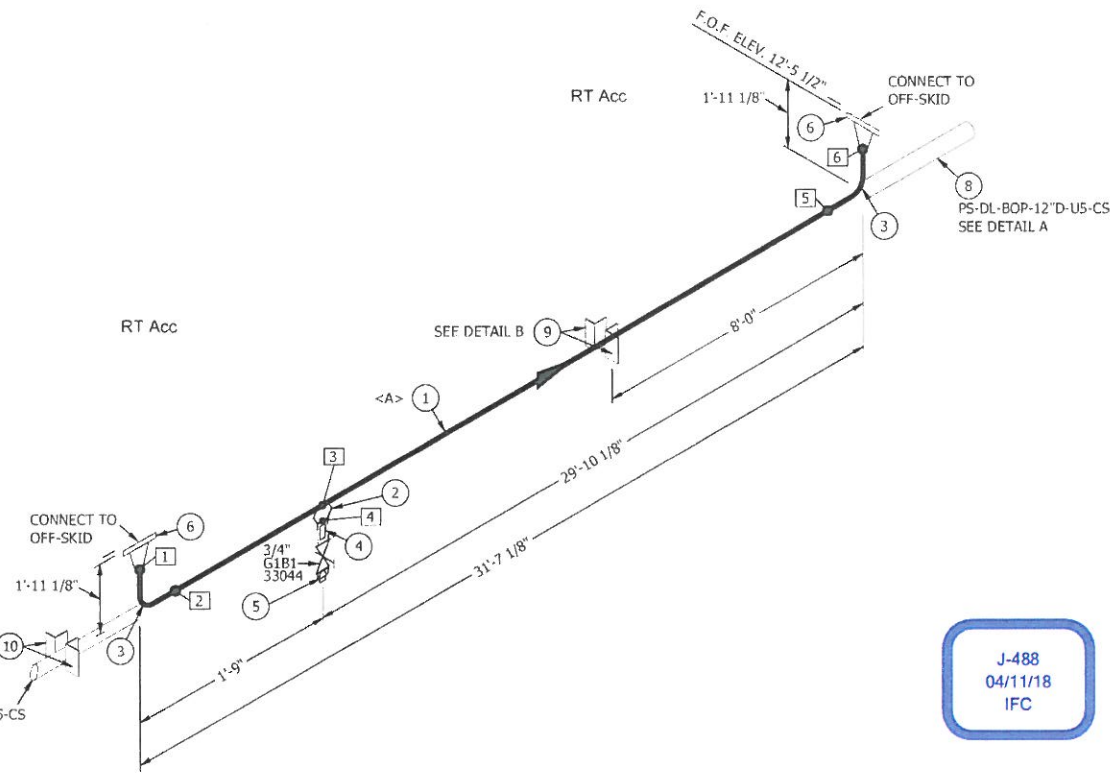

| WELD MAPPING |      |      |     | PIPE CUT LIST |      |            |       |       |
|--------------|------|------|-----|---------------|------|------------|-------|-------|
| MARK         | SIZE | TYPE | SCH | MARK          | SIZE | LENGTH     | END 1 | END 2 |
| 1            | 12"  | BW   | O   | A             | 12"  | 28'-7 1/8" | BEVEL | BEVEL |
| 2            | 12"  | BW   | O   |               |      |            |       |       |
| 3            | 3/4" | LET  | O   |               |      |            |       |       |
| 4            | 3/4" | SW   |     |               |      |            |       |       |
| 5            | 12"  | BW   | O   |               |      |            |       |       |
| 6            | 12"  | BW   | O   |               |      |            |       |       |

**J-488**  
 04/11/18  
 IFC



|                |            |                |           |     |                         |          |    |     |  |
|----------------|------------|----------------|-----------|-----|-------------------------|----------|----|-----|--|
| DESIGN PRESS   | 400 Psig   | FAB. LOCATION  | SHOP      |     |                         |          |    |     |  |
| DESIGN TEMP.   | 150 °F     | SPOOL LOCATION | SKID#2    |     |                         |          |    |     |  |
| OPER. PRESS.   | 210 Psid   |                |           |     |                         |          |    |     |  |
| OPER. TEMP.    | 88 °F      | CORR. ALLOW.   | 0.625"    |     |                         |          |    |     |  |
| STRESS RELIEVE | NO         | INSULATION     | NONE      | 0   | ISSUED FOR CONSTRUCTION | 11/17/17 | CW | WD  |  |
| RADIOGRAPHY    | 15% NORMAL | PAINT          | SYSTEM #3 | NO. | REVISION                | DATE     | BY | APR |  |

**CONFIDENTIAL STATEMENT**  
 THIS DRAWING IS THE PROPERTY OF THE HONEYWELL GROUP AND IS NOT TO BE USED FOR ANY PURPOSE OTHER THAN THAT FOR WHICH IT IS SPECIFICALLY INTENDED.

**FABRICATION NOTES:**  
 ALL VALVES ARE RAISED FACE UNLESS NOTED  
 ALL FITTING MAKE UP & CUT LENGTHS FOR BW PIPE DO NOT INCLUDE WELD CAPS  
 SHOP TO MAKE ADJUSTMENTS FOR WELD CAPS  
 ALL PIPE SEAMLESS UNLESS NOTED OTHERWISE  
 ALL COUPLING TO BE SADDLED ON

UOP Russell  
Honeywell  
UOP


|                  |               |
|------------------|---------------|
| REV. NO.         | 178-B1-CS-12" |
| ASSEMBLY DRAWING | SC6R-402      |
| FIELD DRAWING    | *** 233       |
| DRAWN BY         | CW            |
| DATE DRAWN       | 11/15/17      |
| JOB No.          | 488           |
| SPOOL TO NO.     | SKD-108       |
| REV.             | 0             |

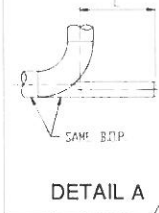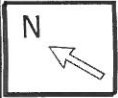

DETAIL A

**BILL OF MATERIAL**

| MARK | SIZE | DESCRIPTION   | QTY        |
|------|------|---|------------|
| 1    | 4    | PIPE, STD, SMLS, A-106 Gr. B, BBE 58130K  | 13'-6 5/8" |
| 2    | 4X2  | TEE RED, BW, STD -XH, A-234 Gr. W/PB  | 1          |
| 3    | 4    | ELL 90 LR, BW, STD, A-234 Gr. W/PB  | 3          |
| 4    | 4    | FLG, RFWN, 300#, STD, A-105   | 2          |
| 5    | 2    | FLG, RFWN, 300#, XH, A-105  | 1          |
| 6    | 2    | GSKT, 1/8" THK, 300#, RF, SPIRAL WOUND, 304SS WINDING, FLEXITE SUPER FILLER, C.S. GUIDE RING, ASME B16.20 (YELLOW W/ PINK STRIPE) | 2          |
| 7    | 5/8  | (8) STUD BOLTS, 300#, A-193 Gr. B7, w/ 2 HVY HEX NUTS, A-194 Gr. 2H, (ZINC PLATED) (3 3/4" LG)                                    | 2          |
| 8    |      | (1) PIPE, 3" STD, SMLS, x 2'-1 7/8" LG. A-106 Gr. B (1) END PL, 1/4" THK. x 3 3/8" O.D. A-36 (L=1'-7 7/8")                        | 1          |
| 9    |      | U-BOLT FOR 3" DIA PIPE W/ (4) HEX NUTS EA (CS ZINC PL)  | 1          |

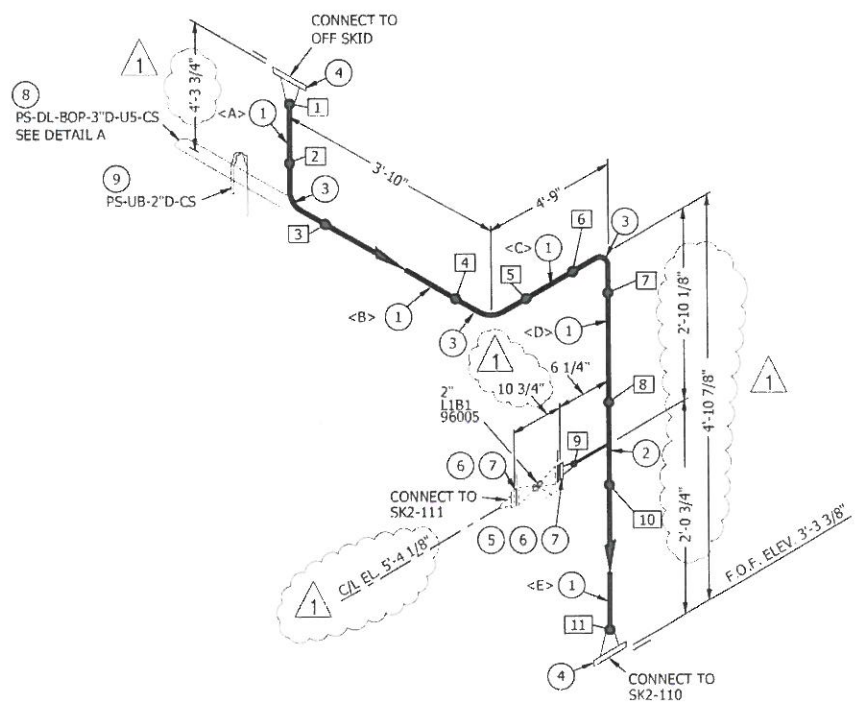

**WELD MAPPING**

| MARK | SIZE | TYPE | SCH |
|------|------|------|-----|
| 1    | 4"   | BW   | CM  |
| 2    | 4"   | BW   |     |
| 3    | 4"   | BW   |     |
| 4    | 4"   | BW   |     |
| 5    | 4"   | BW   |     |
| 6    | 4"   | BW   |     |
| 7    | 4"   | BW   |     |
| 8    | 4"   | BW   |     |
| 9    | 2"   | BW   |     |
| 10   | 4"   | BW   |     |
| 11   | 4"   | BW   |     |

**PIPE CUT LIST**

| MARK | SIZE | LENGTH    | END 1 | END 2 |
|------|------|-----------|-------|-------|
| 1    | 4"   | 3'-6 3/8" | BEVEL | BEVEL |
| 2    | 4"   | 2'-10"    | BEVEL | BEVEL |
| 3    | 4"   | 3'-9"     | BEVEL | BEVEL |
| 4    | 4"   | 2'-0"     | BEVEL | BEVEL |
| 5    | 4"   | 1'-5 1/4" | BEVEL | BEVEL |
| 6    | 4"   |           |       |       |
| 7    | 4"   |           |       |       |
| 8    | 4"   |           |       |       |
| 9    | 2"   |           |       |       |
| 10   | 4"   |           |       |       |
| 11   | 4"   |           |       |       |

J-488  
05/15/18  
REV

|                |            |                |           |     |                               |        |     |     |  |
|----------------|------------|----------------|-----------|-----|-------------------------------|--------|-----|-----|--|
| DESIGN PRESS.  | 400 Psig   | FAB. LOCATION  | SHOP      |     |                               |        |     |     |  |
| DESIGN TEMP.   | 150 °F     | SPOOL LOCATION | SKID#2    |     |                               |        |     |     |  |
| OPER. PRESS.   | 210 Psig   |                |           |     |                               |        |     |     |  |
| OPER. TEMP.    | 88 °F      | CORR. ALLOW.   | .0625"    | 1   | REVISED FOR VALVE SIZE CHANGE | 5/9/18 | COB | WC  |  |
| STRESS RELIEVE | NO         | INSULATION     | NONE      | 0   | ISSUE FOR CONSTRUCTION        | 5/9/18 | COB | WC  |  |
| RADIOGRAPHY    | 15% NORMAL | PAINT          | SYSTEM #3 | NO. | REVISION                      | DATE   | BY  | APR |  |



**CONFIDENTIAL STATEMENT**  
THIS DRAWING IS THE PROPERTY OF THE HONEYWELL COMPANY AND IS NOT TO BE USED FOR ANY PURPOSE OTHER THAN THAT FOR WHICH IT IS SPECIFICALLY FURNISHED.

**FABRICATION NOTES:**  
ALL VALVES ARE RAISED FACE UNLESS NOTED.  
ALL FITTING MAKE-UP & CUT LENGTHS FOR BW PIPE DO NOT INCLUDE WELD CAPS.  
SHOP TO MAKE ADJUSTMENTS FOR WELD CAPS.  
ALL PIPE STAINLESS UNLESS NOTED OTHERWISE.  
ALL COUPLING TO BE SADDLED ON.

**UOP Russell Honeywell**


7700 N. 17th Ave. Suite 210  
Tulsa, Oklahoma 74138  
Phone 918-481-5882  
Fax 918-481-2422

|                  |              |
|------------------|--------------|
| LINE NO.         | 700-B1-CS-4" |
| ASSEMBLY DRAWING | SC6R-402     |
| FIELD DRAWING    | 488-296      |
| DRAWN BY         | CW           |
| DATE DRAWN       | 5/9/18       |
| JOB NO.          | 488          |
| SPOOL ID NO.     | SK2-109      |
| REV              | 1            |

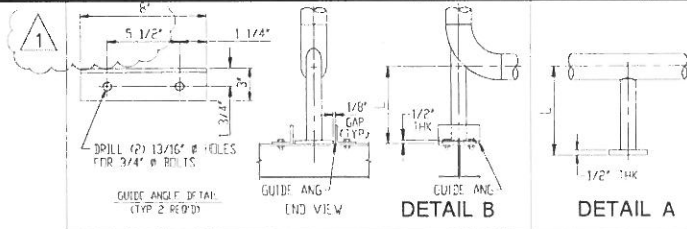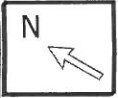

| BILL OF MATERIAL |       |  |           |
|------------------|-------|--|-----------|
| MARK             | SIZE  | DESCRIPTION  | QTY       |
| 1                | 4     | PIPE, STD, SMLS, A-106 Gr. B, BBE 58130K   | 1'-6 3/4" |
| 2                | 4X2   | RED CONC, BW, STD - XH, A-234 Gr. WPB  | 2         |
| 3                | 4X3/4 | S-O-L, SW, 3000#, A-105  | 1         |
| 4                | 4X1/2 | T-O-L, THRD, 3000#, A-105  | 2         |
| 5                | 4     | ELL 90 LR, BW, STD, A-234 Gr. WPB  | 2         |
| 6                | 3/4   | NIPPLE, XH, SMLS, A-106 Gr. B, x 3" LG, POE-TOE  | 1         |
| 7                | 3/4   | PLUG, SOLID STEEL, RND HD, THRD, 3000#, A-105  | 1         |
| 8                | 4     | FLG, RFWN, 300#, STD, A-105  | 2         |
| 9                | 2     | FLG, RFWN, 300#, XH, A-105   | 2         |
| 10               | 4     | GSKT, 1/8" THK, 300#, RF, SPIRAL WOUND, 304SS WINDING, FLEXITE SUPER FILLER, C.S. GUIDE RING, ASME B16.20 (YELLOW W/ PINK STRIPE)                      | 4         |
| 11               | 2     | GSKT, 1/8" THK, 300#, RF, SPIRAL WOUND, 304SS WINDING, FLEXITE SUPER FILLER, C.S. GUIDE RING, ASME B16.20 (YELLOW W/ PINK STRIPE)                      | 2         |
| 12               | 3/4   | (8) STUD BOLTS, 300# x 4 3/4" LG, A-193 Gr. B7, w/ 2 HVY HEX NUTS, A-194 Gr. 2H (ZINC PLATED)  | 4         |
| 13               | 5/8   | (8) STUD BOLTS, 300# x 3 3/4" LG, A-193 Gr. B7, w/ 2 HVY HEX NUTS, A-194 Gr. 2H (ZINC PLATED)  | 2         |
| 14               | 4     | (1) PIPE, 2" XH, SMLS, x 1'-11 3/16" LG, A-106 Gr. B (1) BASE PL, 1/2" THK, x 5" x 5" A-36 (L=1'-5 11/16")   | 1         |
| 15               | 4     | (1) PIPE, 2" XH, SMLS, x 1'-11 3/16" LG, A-106 Gr. B (1) BASE PL, 1/2" THK, x 5" x 5" A-36 (2) GUIDE ANG, 2" x 3" x 1/4" x 8" LG, A-36 (L=1'-5 11/16") | 1         |

| WELD MAPPING |      |      |     | PIPE CUT LIST |      |           |       |       |
|--------------|------|------|-----|---------------|------|-----------|-------|-------|
| MARK         | SIZE | TYPE | SCH | MARK          | SIZE | LENGTH    | END 1 | END 2 |
| 1            | 4"   | BW   | CC  | A             | 4"   | 1'-2 3/4" | BEVEL | BEVEL |
| 2            | 4"   | BW   |     | B             | 4"   | 4"        | BEVEL | BEVEL |
| 3            | 1/2" | LET  |     |               |      |           |       |       |
| 4            | 4"   | BW   |     |               |      |           |       |       |
| 5            | 2"   | BW   |     |               |      |           |       |       |
| 6            | 2"   | BW   |     |               |      |           |       |       |
| 7            | 4"   | BW   |     |               |      |           |       |       |
| 8            | 1/2" | LET  |     |               |      |           |       |       |
| 9            | 3/4" | LET  |     |               |      |           |       |       |
| 10           | 3/4" | SW   |     |               |      |           |       |       |
| 11           | 4"   | BW   | CC  |               |      |           |       |       |
| 12           | 4"   | BW   | CC  |               |      |           |       |       |

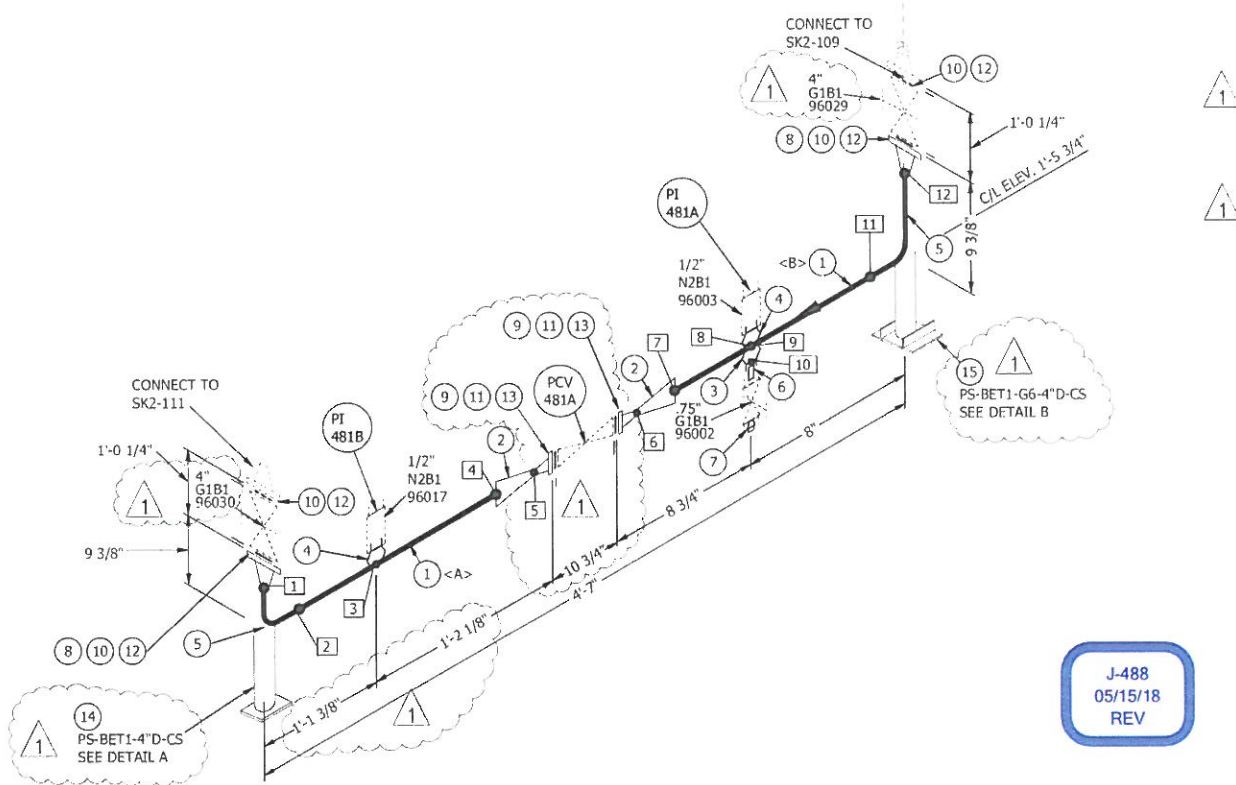


**J-488**  
 05/15/18  
 REV



|                |                      |                |           |     |                                       |         |     |     |  |
|----------------|----------------------|----------------|-----------|-----|---------------------------------------|---------|-----|-----|--|
| DESIGN PRESS.  | 400 P <sub>sig</sub> | FAB. LOCATION  | SHOP      |     |                                       |         |     |     |  |
| DESIGN TEMP    | 150 °F               | SPOOL LOCATION | SKID #2   |     |                                       |         |     |     |  |
| OPER. PRESS    | 210 P <sub>sig</sub> |                |           |     |                                       |         |     |     |  |
| OPER. TEMP     | 88 °F                | CORR. ALLOW.   | 062S"     | 1   | REVISED FOR CONTROL VALVE SIZE CHANGE | 5/15/18 | COB | WD  |  |
| STRESS RELIEVE | NO                   | INSULATION     | NONE      | 0   | ISSUE FOR CONSTRUCTION                | 5/9/18  | COB | WD  |  |
| RADIOGRAPHY    | 15% NORMAL           | PAINT          | SYSTEM #3 | NO. | REVISION                              | DATE    | BY  | APR |  |

**CONFIDENTIAL STATEMENT**  
 THIS DRAWING IS THE PROPERTY OF HILL THOMAS RUSSELL CO. AND IS NOT TO BE USED FOR ANY PURPOSE OTHER THAN THAT FOR WHICH IT IS SPECIFICALLY FURNISHED.

**FABRICATION NOTES:**  
 ALL VALVES ARE BARRID TATE VALVES NOTED  
 ALL FITTINGS MAKE UP & CUT LENGTHS FOR BW PIPE DO NOT INCLUDE WELD CAPS  
 SHOP TO MAKE ADJUSTMENTS FOR WELD CAPS  
 ALL PIPE SEAMLESS UNLESS NOTED OTHERWISE  
 ALL CORROSION TO BE SADDLED ON

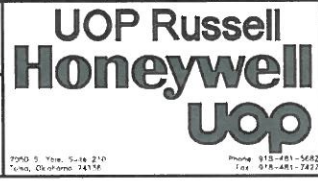

|                    |              |
|--------------------|--------------|
| DRW. NO.           | 700-B1-CS-4" |
| REGISTERED DRAWING | SC6R-402     |
| PROJECT DRAWING    | 488-296      |
| DRAWN BY           | COB          |
| CHECKED BY         | 5/9/18       |
| SCALE              | AS SHOWN     |
| DATE               | 5/9/18       |
| REV                | 1            |

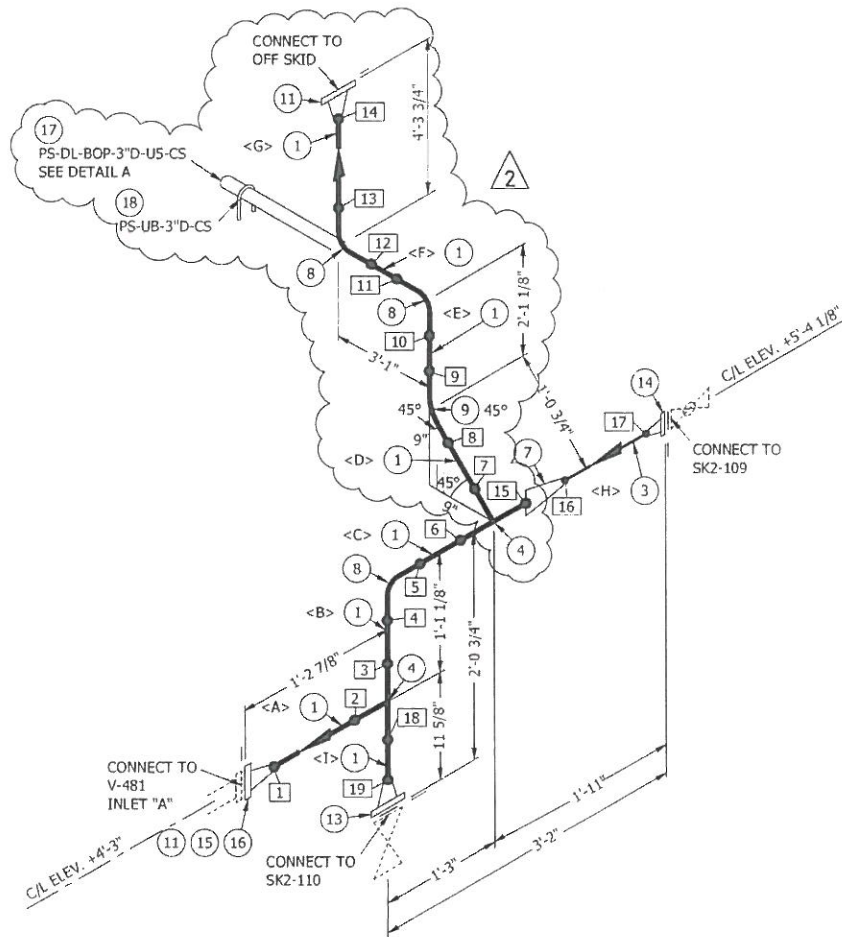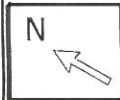

J-488  
06/10/18  
REV

**BILL OF MATERIAL**

| MARK | SIZE | DESCRIPTION   | QTY |
|------|------|---|-----|
| 1    | 4    | PIPE, STD, SMLS, A-106 Gr. B, BBE 58130K  | 2   |
| 3    | 2    | PIPE, XH, SMLS, A-106 Gr. B, BBE D04408   | 1   |
| 4    | 4X4  | TEE, BW, STD, A-234 Gr. WPB   | 2   |
| 7    | 4X2  | RED CONC, BW, STD - XH, A-234 Gr. WPB   | 1   |
| 8    | 4    | ELL 90 LR, BW, STD, A-234 Gr. WPB   | 3   |
| 9    | 4    | ELL 45, BW, STD, A-234 Gr. WPB  | 1   |
| 11   | 4    | FLG, RFWN, 150#, STD, A-105   | 2   |
| 13   | 4    | FLG, RFWN, 300#, STD, A-105   | 1   |
| 14   | 2    | FLG, RFWN, 300#, XH, A-105  | 1   |
| 15   | 4    | GSKT, 1/8" THK, 150#, RF, SPIRAL WOUND, 304SS WINDING, FLEXITE SUPER FILLER, C.S. GUIDE RING, ASME B16.20 (YELLOW W/ PINK STRIPE) | 1   |
| 16   | 5/8  | (8) STUD BOLTS, 150# x 3 3/4" LG, A-193 Gr. B7, w/ 2 HVY HEX NUTS, A-194 Gr. 2H (ZINC PLATED)                                     | 1   |
| 17   | 2    | (1) PIPE, 3" STD, SMLS, x 2'-1 7/8" LG, A-106 Gr. B (1) END PL, 1/4" THK. x 3 3/8" O.D. A-36 (L=1'-7 7/8")                        | 1   |
| 18   | 3    | U-BOLT FOR 3" DIA PIPE W/ (4) HEX NUTS EA (CS ZINC PL)  | 1   |

**WELD MAPPING**

| MARK | SIZE | TYPE | SCH |
|------|------|------|-----|
| 1    | 4"   | BW   | CC  |
| 2    | 4"   | BW   |     |
| 3    | 4"   | BW   |     |
| 16   | 2"   | BW   | CM  |
| 17   | 2"   | BW   |     |
| 18   | 4"   | BW   |     |
| 19   | 4"   | BW   |     |


**PIPE CUT LIST**

| MARK | SIZE | LENGTH    | END 1 | END 2 |
|------|------|-----------|-------|-------|
| 1    | 4"   | 7 3/4"    | BEVEL | BEVEL |
| 2    | 4"   | 3"        | BEVEL | BEVEL |
| 3    | 4"   | 4 7/8"    | BEVEL | BEVEL |
| 4    | 4"   | 6 1/8"    | BEVEL | BEVEL |
| 5    | 4"   | 1'-4 5/8" | BEVEL | BEVEL |
| 6    | 4"   | 2'-1"     | BEVEL | BEVEL |
| 7    | 4"   | 3'-6 3/4" | BEVEL | BEVEL |
| 8    | 4"   | 1'-0 1/8" | BEVEL | BEVEL |
| 9    | 4"   | 4 1/8"    | BEVEL | BEVEL |
| 10   | 4"   |           |       |       |
| 11   | 4"   |           |       |       |
| 12   | 4"   |           |       |       |
| 13   | 4"   |           |       |       |
| 14   | 4"   |           |       |       |
| 15   | 4"   |           |       |       |
| 16   | 2"   |           |       |       |
| 17   | 2"   |           |       |       |
| 18   | 4"   |           |       |       |
| 19   | 4"   |           |       |       |


|                |            |                |           |     |                                       |        |     |     |
|----------------|------------|----------------|-----------|-----|---------------------------------------|--------|-----|-----|
| DESIGN PRESS.  | 150 Psig   | FAB. LOCATION  | SHOP      |     |                                       |        |     |     |
| DESIGN TEMP.   | 150 °F     | SPOOL LOCATION | SKID #2   |     |                                       |        |     |     |
| OPER. PRESS.   | 100 Psia   |                |           | 2   | REVISED FOR SIZE CHANGE IN PSV-481    | 6/5/18 | COB | WD  |
| OPER. TEMP.    | 69 °F      | CORR. ALLOW.   | .0625"    | 1   | REVISED FOR CONTROL VALVE SIZE CHANGE | 5/9/18 | COB | WD  |
| STRESS RELIEVE | NO         | INSULATION     | NONE      | 0   | ISSUED FOR CONSTRUCTION               | 5/9/18 | COB | WD  |
| RADIOGRAPHY    | 15% NORMAL | PAINT          | SYSTEM #3 | NO. | REVISION                              | DATE   | BY  | APR |

**CONFIDENTIAL STATEMENT**  
THIS DRAWING IS THE PROPERTY OF THE THOMAS RUSSELL Co. and IS NOT TO BE USED FOR ANY PURPOSE OTHER THAN THAT FOR WHICH IT IS SPECIFICALLY FURNISHED.

**FABRICATION NOTES:**  
ALL VALVES ARE RAISED FACE UNLESS NOTED.  
ALL FITTING MAKE-UP & CUT LENGTHS FOR BW PIPE DO NOT INCLUDE WELD CAPS.  
SHOP TO MAKE ADJUSTMENTS FOR WELD CAPS.  
ALL PIPE SEAMLESS UNLESS NOTED OTHERWISE.  
ALL COUPLING TO BE SADDLED ON.

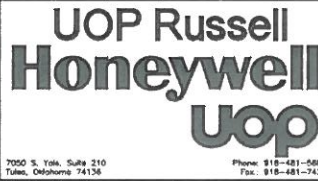

|                  |              |
|------------------|--------------|
| LINE No.         | 702-A1-CS-4" |
| ASSEMBLY DRAWING | SC6R-402     |
| PART DRAWING     | 488-296      |
| DRAWN BY         | CW           |
| DATE DRAWN       | 11/20/17     |
| JOB No.          | 488          |
| SPOOL I.D. No.   | SK2-111      |
| REV              | 2            |

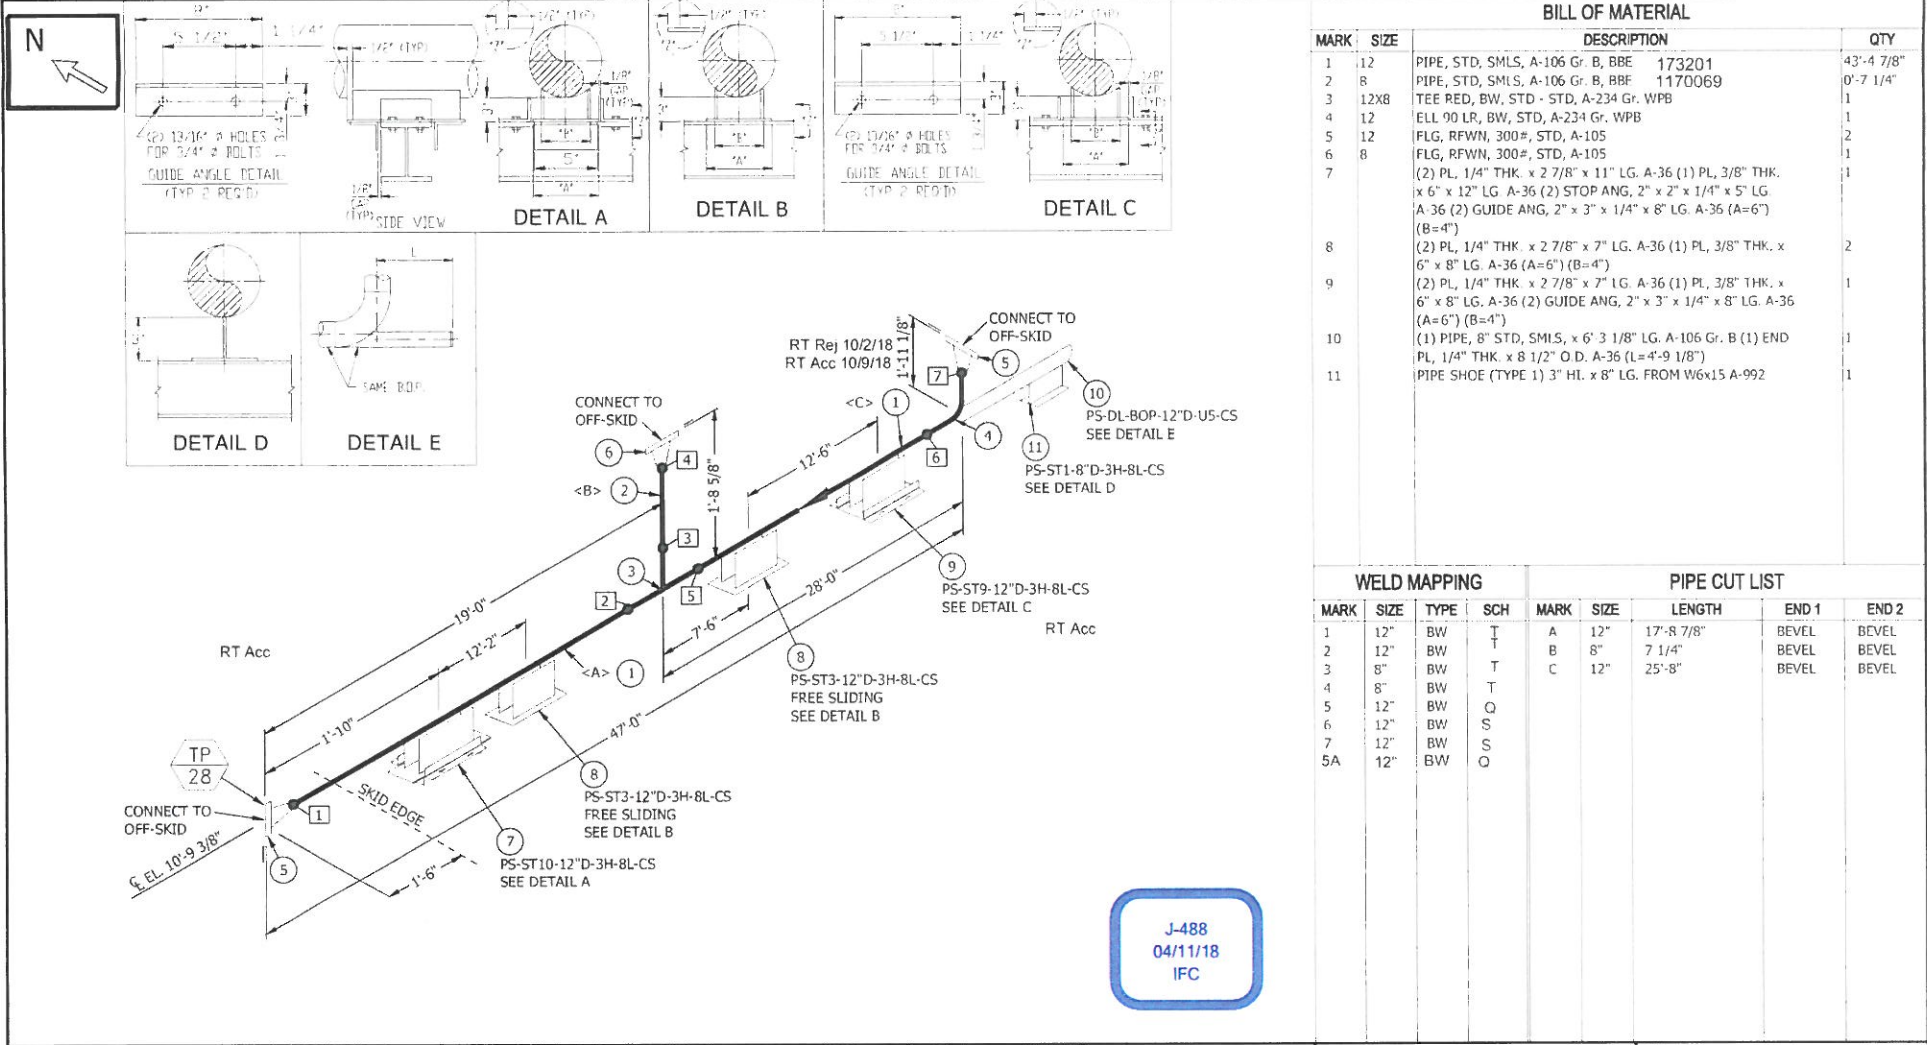

| BILL OF MATERIAL |      |  |         |            |
|------------------|------|--|---------|------------|
| MARK             | SIZE | DESCRIPTION  |         | QTY        |
| 1                | 12   | PIPE, STD, SMLS, A-106 Gr. B, BBE  | 173201  | 43'-4 7/8" |
| 2                | 8    | PIPE, STD, SMLS, A-106 Gr. B, BBE  | 1170069 | 0'-7 1/4"  |
| 3                | 12XB | TEE RED, BW, STD - STD, A-234 Gr. WPB  |         | 1          |
| 4                | 12   | ELL 90 LR, BW, STD, A-234 Gr. WPB  |         | 1          |
| 5                | 12   | FLG, RFWN, 300#, STD, A-105  |         | 2          |
| 6                | 8    | FLG, RFWN, 300#, STD, A-105  |         | 1          |
| 7                |      | (2) PL, 1/4" THK. x 2 7/8" x 11" LG. A-36 (1) PL, 3/8" THK. x 6" x 12" LG. A-36 (2) STOP ANG, 2" x 2" x 1/4" x 5" LG. A-36 (2) GUIDE ANG, 2" x 3" x 1/4" x 8" LG. A-36 (A=6") (B=4") |         | 1          |
| 8                |      | (2) PL, 1/4" THK. x 2 7/8" x 7" LG. A-36 (1) PL, 3/8" THK. x 6" x 8" LG. A-36 (A=6") (B=4")  |         | 2          |
| 9                |      | (2) PL, 1/4" THK. x 2 7/8" x 7" LG. A-36 (1) PL, 3/8" THK. x 6" x 8" LG. A-36 (2) GUIDE ANG, 2" x 3" x 1/4" x 8" LG. A-36 (A=6") (B=4")  |         | 1          |
| 10               |      | (1) PIPE, 8" STD, SMLS, x 6' 3 1/8" LG. A-106 Gr. B (1) END PL, 1/4" THK x 8 1/2" O.D. A-36 (L=4'-9 1/8")  |         | 1          |
| 11               |      | PIPE SHOE (TYPE 1) 3" HI. x 8" LG. FROM W6x15 A-992  |         | 1          |


| WELD MAPPING |      |      |     | PIPE CUT LIST |      |            |       |       |
|--------------|------|------|-----|---------------|------|------------|-------|-------|
| MARK         | SIZE | TYPE | SCH | MARK          | SIZE | LENGTH     | END 1 | END 2 |
| 1            | 12"  | BW   | T   | A             | 12"  | 17'-8 7/8" | BEVEL | BEVEL |
| 2            | 12"  | BW   | B   | B             | 8"   | 7 1/4"     | BEVEL | BEVEL |
| 3            | 8"   | BW   | T   | C             | 12"  | 25'-8"     | BEVEL | BEVEL |
| 4            | 8"   | BW   | T   |               |      |            |       |       |
| 5            | 12"  | BW   | Q   |               |      |            |       |       |
| 6            | 12"  | BW   | S   |               |      |            |       |       |
| 7            | 12"  | BW   | S   |               |      |            |       |       |
| 5A           | 12"  | BW   | O   |               |      |            |       |       |

J-488  
04/11/18  
IFC



|                |           |                |           |     |                          |      |    |     |  |
|----------------|-----------|----------------|-----------|-----|--------------------------|------|----|-----|--|
| DESIGN PRESS.  | 500 Psig  | FAB. LOCATION  | SHOP      |     |                          |      |    |     |  |
| DESIGN TEMP.   | 250 °F    | SPOOL LOCATION | SKID #2   |     |                          |      |    |     |  |
| OPER. PRESS.   | 246 Psig  |                |           |     |                          |      |    |     |  |
| OPER. TEMP.    | 117 °F    | CORR. ALLOW.   | .0625"    |     |                          |      |    |     |  |
| STRESS RELIEVE | NO        | INSULATION     | 1" B      | 0   | ISSUED FROM CONSTRUCTION |      |    |     |  |
| RADIOGRAPHY    | 15% NORMA | PAINT          | SYSTEM #3 | NO. | REVISION                 | DATE | BY | APR |  |

**CONFIDENTIAL STATEMENT**  
THIS DRAWING IS THE PROPERTY OF THE THOMAS RUSSELL CO. AND IS NOT TO BE USED FOR ANY PURPOSE OTHER THAN THAT FOR WHICH IT IS SPECIFICALLY SUBMITTED.

**FABRICATION NOTES:**  
ALL WELDS ARE RADIOGRAPHY UNLESS NOTED.  
ALL FITTINGS MAKE UP & CUT LENGTHS FOR PIPE DO NOT INCLUDE WELD CAPS.  
SHOP TO MAKE ADJUSTMENTS FOR WELD CAPS.  
ALL PIPE SEAMLESS UNLESS NOTED OTHERWISE.  
ALL DOUBTING TO BE SADDLED ON.

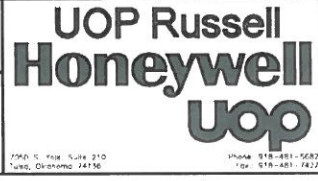

|              |                    |
|--------------|--------------------|
| LINE No.     | 180-B1-CS-12" 1" B |
| DESIGNED BY  | SC6R-402           |
| FAB. DRAWING | ***-233L           |
| DRAWN BY     | CW                 |
| DATE DRAWN   | 11/30/17           |
| SCALE        | AS SHOWN           |
| REVISION     | 488                |
| DATE         | 04/11/18           |
| BY           | IFC                |

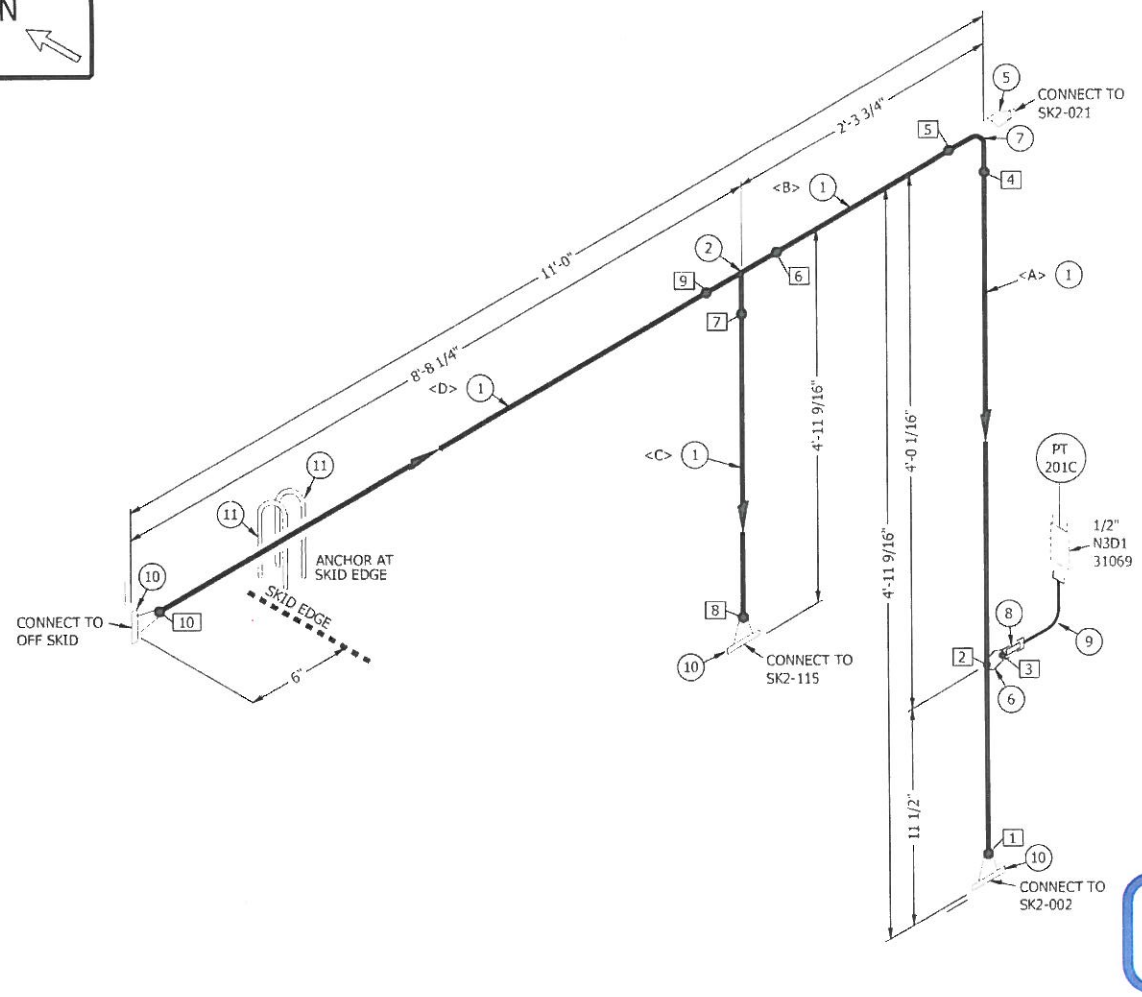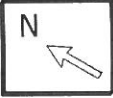

| BILL OF MATERIAL |       |  |  |            |
|------------------|-------|--|--|------------|
| MARK             | SIZE  | DESCRIPTION  |  | QTY        |
| 1                | 8     | PIPE, XH, SMLS, A-106 Gr. B, BBE 101966                    |  | 15'-9 5/8" |
| 2                | 8X8   | TEE, BW, XH, A-234 Gr. WPB                                 |  | 1          |
| 5                | 8X2   | E-O-L, BW, XH, A-105                                       |  | 1          |
| 6                | 8X1/2 | S-O-L, SW, 6000#, A-105                                    |  | 1          |
| 7                | 8     | ELL 90 LR, BW, XH, A-234 Gr. WPB                           |  | 1          |
| 8                | 1/2   | NIPPLE, S/160, SMLS, A-106 Gr. B, x 6" LG, POE-TOE (6" LG) |  | 1          |
| 9                | 1/2   | ELL 90, THRD, 3000#, A-105                                 |  | 1          |
| 10               | 8     | FLG, RFWN, 600#, XH, A-105                                 |  | 3          |
| 11               | 8     | U-BOLT FOR 8" DIA PIPE W/ (4) HEX NUTS EA (CS ZINC PL)     |  | 2          |

| WELD MAPPING |      |      |     | PIPE CUT LIST |      |             |       |       |
|--------------|------|------|-----|---------------|------|-------------|-------|-------|
| MARK         | SIZE | TYPE | SCH | MARK          | SIZE | LENGTH      | END 1 | END 2 |
| 1            | 8"   | BW   | CM  | A             | 8"   | 3'-6 1/16"  | BEVEL | BEVEL |
| 2            | 1/2" | LET  | CM  | B             | 8"   | 8 3/4"      | BEVEL | BEVEL |
| 3            | 1/2" | SW   |     | C             | 8"   | 3'-11 1/16" | BEVEL | BEVEL |
| 4            | 8"   | BW   | CM  | D             | 8"   | 7'-7 3/4"   | BEVEL | BEVEL |
| 5            | 8"   | BW   |     |               |      |             |       |       |
| 6            | 8"   | BW   |     |               |      |             |       |       |
| 7            | 8"   | BW   |     |               |      |             |       |       |
| 8            | 8"   | BW   |     |               |      |             |       |       |
| 9            | 8"   | BW   |     |               |      |             |       |       |
| 10           | 8"   | BW   |     |               |      |             |       |       |



|                |                       |                |           |     |                        |          |     |     |  |
|----------------|-----------------------|----------------|-----------|-----|------------------------|----------|-----|-----|--|
| DESIGN PRESS   | 1100 P <sub>sig</sub> | FAB. LOCATION  | SHOP      |     |                        |          |     |     |  |
| DESIGN TEMP    | 150 °F                | SPOOL LOCATION | SKID #2   |     |                        |          |     |     |  |
| OPER. PRESS.   | 820 P <sub>sig</sub>  |                |           |     |                        |          |     |     |  |
| OPER. TEMP     | 85 °F                 | CORR. ALLOW.   | 0.0625"   |     |                        |          |     |     |  |
| STRESS RELIEVE | NO                    | INSULATION     | NONE      | 0   | ISSUE FOR CONSTRUCTION | 12/13/17 | COB | WD  |  |
| RADIOGRAPHY    | 15% NORMAL            | PAINT          | SYSTEM #3 | NO. | REVISION               | DATE     | BY  | APR |  |

**CONFIDENTIAL STATEMENT**  
 THIS DRAWING IS THE PROPERTY OF THE THOMAS RUSSELL CO. AND IS NOT TO BE USED FOR ANY PURPOSE OTHER THAN THAT FOR WHICH IT IS SPECIFICALLY FURNISHED.

**FABRICATION NOTES:**  
 ALL VALVES ARE RASSED FACE UNLESS NOTED.  
 ALL FITTING MAKE UP & CUT LENGTHS FOR BW PIPE DO NOT INCLUDE WELD GAPS.  
 SHOP TO MAKE ADJUSTMENTS FOR WELD GAPS.  
 ALL PIPE SEAMLESS UNLESS NOTED OTHERWISE.  
 ALL CORROSION TO BE RADDLED ON.

**UOP Russell Honeywell**

|                  |                     |
|------------------|---------------------|
| SPN No           | 109-01-CS-8"        |
| ASSEMBLY DRAWING | SC6R-402            |
| P&ID DRAWING     | ***-271/231         |
| DRAWN BY         | COR                 |
| CHECKED BY       | DATE DRAWN 12/13/17 |
| DATE             | 4/8                 |
| ISSUED TO No     | SK2-113             |
| REV              | 0                   |

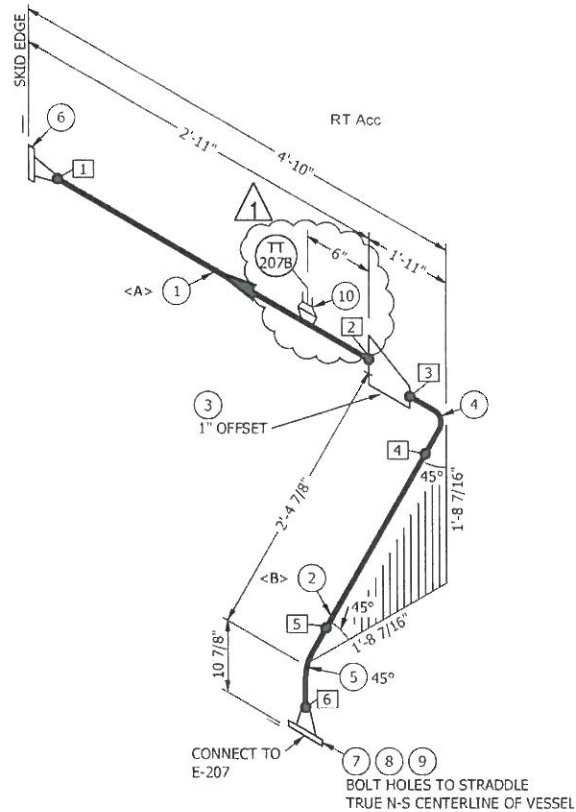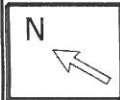

RT Acc

RT Acc

J-488  
05/01/18  
REV

**BILL OF MATERIAL**

| MARK | SIZE  | DESCRIPTION   | QTY       |
|------|-------|---|-----------|
| 1    | 12    | PIPE, STD, SMLS, A-333 Gr. 6, BBE 1133589   | 2'-5 7/8" |
| 2    | 10    | PIPE, STD, SMLS, A-333 Gr. 6, BBE T45432  | 0'-7 5/8" |
| 3    | 12X10 | RED ECC, BW, STD - STD, A-420 Gr. WPL6  | 1         |
| 4    | 10    | ELL 90 LR, BW, STD, A-420 Gr. WPL6  | 1         |
| 5    | 10    | ELL 45, BW, STD, A-420 Gr. WPL6   | 1         |
| 6    | 12    | FLG, RFWN, 300#, STD, A-350 Gr. LF2-1   | 1         |
| 7    | 10    | FLG, RFWN, 300#, STD, A-350 Gr. LF2-1   | 1         |
| 8    | 10    | GSKT, 1/8" THK, 300#, RF, SPIRAL WOUND, 304SS WINDING, FLEXITE SUPER FILLER, C.S. GUIDE RING, ASME B16.20 (YELLOW W/ PINK STRIPE) | 1         |
| 9    | 1     | (16) STUD BOLTS, 300# x 6 1/2" LG, A-193 Gr. B7, w/ 2 HVY HEX NUTS, A-194 Gr. 2H (ZINC PLATED)                                    | 1         |
| 10   | 3/4   | T.O.L., THRD, 3000#, A-350 Gr. LF2-1  | 1         |

**WELD MAPPING**

| MARK | SIZE | TYPE | SCH |
|------|------|------|-----|
| 1    | 12"  | BW   | CM  |
| 2    | 12"  | BW   |     |
| 3    | 10"  | BW   |     |
| 4    | 10"  | BW   |     |
| 5    | 10"  | BW   |     |
| 6    | 10"  | BW   |     |


**PIPE CUT LIST**

| MARK | SIZE | LENGTH    | END 1 | END 2 |
|------|------|-----------|-------|-------|
| 1    | 12"  | 2'-5 7/8" | BEVEL | BEVEL |
| 2    | 12"  | 7 5/8"    | BEVEL | BEVEL |

|                |            |                |           |     |                        |         |     |     |  |
|----------------|------------|----------------|-----------|-----|------------------------|---------|-----|-----|--|
| DESIGN PRESS.  | 400 Psig   | FAB. LOCATION  | SHOP      |     |                        |         |     |     |  |
| DESIGN TEMP.   | 200 °F     | SPOOL LOCATION | SKID #2   |     |                        |         |     |     |  |
| OPER. PRESS.   | 253 Psia   |                |           |     |                        |         |     |     |  |
| OPER. TEMP.    | 135 °F     | CORR. ALLOW.   | .0625"    | 1   | ADDED TT-207B          | 4/30/18 | COB | WD  |  |
| STRESS RELIEVE | NO         | INSULATION     | NONE      | 0   | ISSUE FOR CONSTRUCTION | 2-20-17 | COB | WD  |  |
| RADIOGRAPHY    | 15% NORMAL | PAINT          | SYSTEM #3 | NO. | REVISION               | DATE    | BY  | APR |  |

**CONFIDENTIAL STATEMENT**  
THIS DRAWING IS THE PROPERTY OF THE THOMAS RUSSELL CO. AND IS NOT TO BE USED FOR ANY PURPOSE OTHER THAN THAT FOR WHICH IT IS SPECIFICALLY FURNISHED.




**FABRICATION NOTES:**  
ALL VALVES ARE RAISED FACE UNLESS NOTED.  
ALL FITTING MAKE-UP & CUT LENGTHS FOR BW PIPE DO NOT INCLUDE WELD CAPS.  
SHOP TO MAKE ADJUSTMENTS FOR WELD CAPS.  
ALL PIPE SEAMLESS UNLESS NOTED OTHERWISE.  
ALL COUPLING TO BE SHOULDER ON.

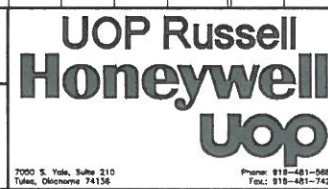

|                  |               |               |          |
|------------------|---------------|---------------|----------|
| LINE No.         | 207-B1-LT-12" |               |          |
| ASSEMBLY DRAWING | SC6R-402      |               |          |
| FIELD DRAWING    | ***-232       |               |          |
| DRAWN BY         | COB           | DATE DRAWN    | 12/12/17 |
| JOB No.          | 488           | SPOOL ID. No. | SK2-114  |
| REV.             |               |               | 1        |

7000 S. Yale, Suite 210  
Tulsa, Oklahoma 74136

Phone: 818-481-5882  
Fax: 818-481-7427

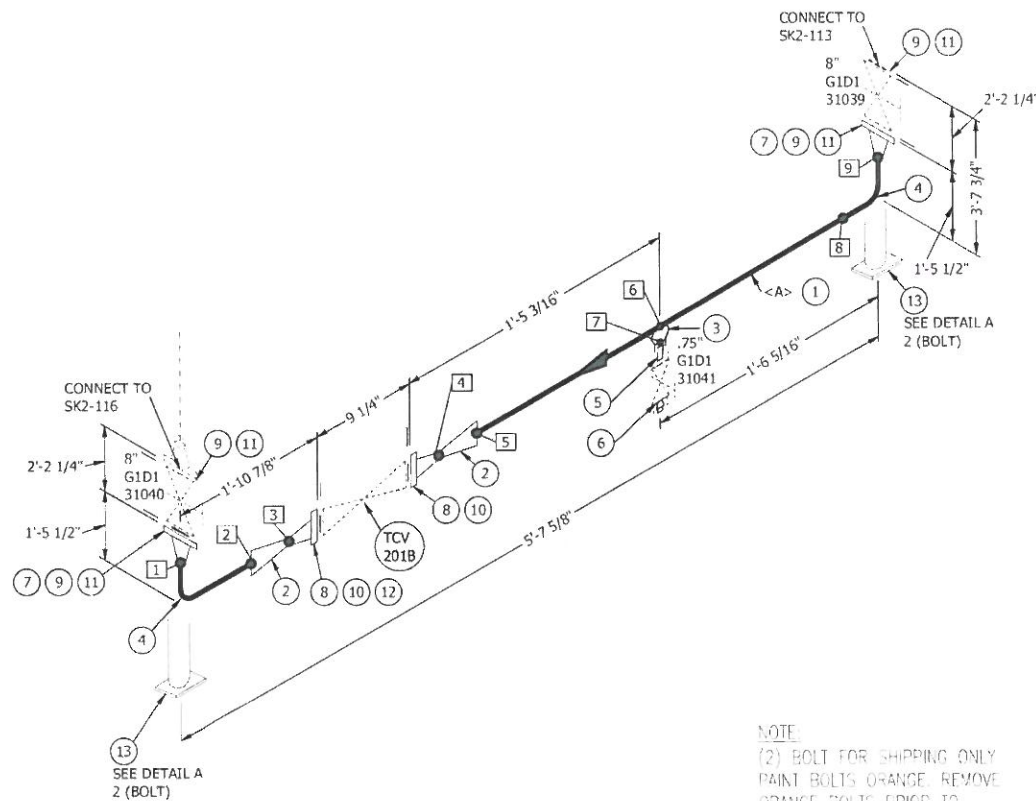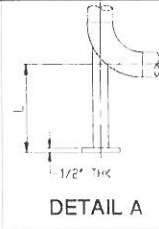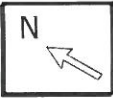

**NOTE**  
 (2) BOLT FOR SHIPPING ONLY  
 PAINT BOLTS ORANGE REMOVE  
 ORANGE BOLTS PRIOR TO  
 SERVICE.

**J-488**  
 04/11/18  
 IFC

**BILL OF MATERIAL**

| MARK | SIZE  | DESCRIPTION  | QTY       |
|------|-------|--|-----------|
| 1    | 8     | PIPE, XH, SMLS, A-106 Gr. B, BBE 1170306   | 1'-0 5/8" |
| 2    | 8X6   | RED CONC, BW, XH - XH, A-234 Gr. WPB   | 2         |
| 3    | 8X3/4 | S-O-L, SW, 6000#, A-105  | 1         |
| 4    | 8     | ELL 90 LR, BW, XH, A-234 Gr. WPB   | 2         |
| 5    | 3/4   | NIPPLE, S/160, SMLS, A-106 Gr. B, x 3" LG, POE-TOE   | 1         |
| 6    | 3/4   | PLUG, SOLID STEEL, RND HD, THRD, 3000#, A-105  | 1         |
| 7    | 8     | FLG, RFWN, 600#, XH, A-105   | 2         |
| 8    | 6     | FLG, RFWN, 600#, XH, A-105   | 2         |
| 9    | 8     | GSKT, 1/8" THK, 600#, RF, SPIRAL WOUND, 304SS WINDING, FLEXITTE SUPER FILLER, C.S. GUIDE RING, ASME B16.20 (YELLOW W/ PINK STRIPE) | 4         |
| 10   | 6     | GSKT, 1/8" THK, 600#, RF, SPIRAL WOUND, 304SS WINDING, FLEXITTE SUPER FILLER, C.S. GUIDE RING, ASME B16.20 (YELLOW W/ PINK STRIPE) | 2         |
| 11   | 1 1/8 | (12) STUD BOLTS, 600# x 7 3/4" LG, A-193 Gr. B7, w/ 2 HVY HEX NUTS, A-194 Gr. 2H (ZINC PLATED)                                     | 4         |
| 12   | 1     | (12) STUD BOLTS, 600# x 16 1/4" LG, A-193 Gr. B7, w/ 2 HVY HEX NUTS, A-194 Gr. 2H (ZINC PLATED)                                    | 1         |
| 13   | 8     | (1) PIPE, 4" STD, SMLS, x 2'-8 1/2" LG, A-106 Gr. B (1) BASE PL, 1/2" THK, x 6" x 6" A-36 (L=1'-9")                                | 2         |

**WELD MAPPING**

| MARK | SIZE | TYPE | SCH |
|------|------|------|-----|
| 1    | 8"   | BW   | CM  |
| 2    | 8"   | BW   |     |
| 3    | 6"   | BW   |     |
| 4    | 6"   | BW   |     |
| 5    | 8"   | BW   |     |
| 6    | 3/4" | LET  |     |
| 7    | 3/4" | SW   |     |
| 8    | 8"   | BW   |     |
| 9    | 8"   | BW   |     |

**PIPE CUT LIST**


| MARK | SIZE | LENGTH    | END 1 | END 2 |
|------|------|-----------|-------|-------|
| 1    | 8"   | 1'-0 5/8" | BEVEL | BEVEL |

|                |                       |                |           |     |                        |          |     |     |  |
|----------------|-----------------------|----------------|-----------|-----|------------------------|----------|-----|-----|--|
| DESIGN PRESS.  | 1100 P <sub>sig</sub> | FAB. LOCATION  | SHOP      |     |                        |          |     |     |  |
| DESIGN TEMP.   | 150 °F                | SPOOL LOCATION | SKID #2   |     |                        |          |     |     |  |
| OPER. PRESS.   | 820 P <sub>sig</sub>  |                |           |     |                        |          |     |     |  |
| OPER. TEMP.    | 85 °F                 | CORR. ALLOW.   | 0.0625"   |     |                        |          |     |     |  |
| STRESS RELIEVE | NO                    | INSULATION     | NONE      | 0   | ISSUE FOR CONSTRUCTION | 12/20/17 | COB | WC  |  |
| RADIOGRAPHY    | 15% NORMAL            | PAINT          | SYSTEM #3 | NO. | REVISION               | DATE     | BY  | APR |  |

**CONFIDENTIAL STATEMENT**  
 THIS DRAWING IS THE PROPERTY OF THE THOMAS RUSSELL Co. AND IS NOT TO BE USED FOR ANY PURPOSE OTHER THAN THAT FOR WHICH IT IS SPECIFICALLY SUBMITTED.  
**FABRICATION NOTES:**  
 ALL VALVES ARE RASG FACE UNLESS NOTED  
 ALL FITTING MAKE UP & CUT LENGTHS FOR BW PIPE DO NOT INCLUDE WELD CAPS  
 SHOP TO MAKE ADJUSTMENTS FOR WELD CAPS  
 ALL PIPE SEAMLESS UNLESS NOTED OTHERWISE  
 ALL COUPLING TO BE SADDLED ON

UOP Russell  
 Honeywell  
 Uop

|                    |              |
|--------------------|--------------|
| LINE No            | 151-D1-CS-8" |
| RESISTANCE DRAWING | SC6R-402     |
| PIANO DRAWING      | *** 231      |
| ISSUE No           | COR          |
| DATE DRAWING       | 12/13/17     |
| SPD No             | 483          |
| SPD ID No          | SK2-115      |
| REV                | 0            |

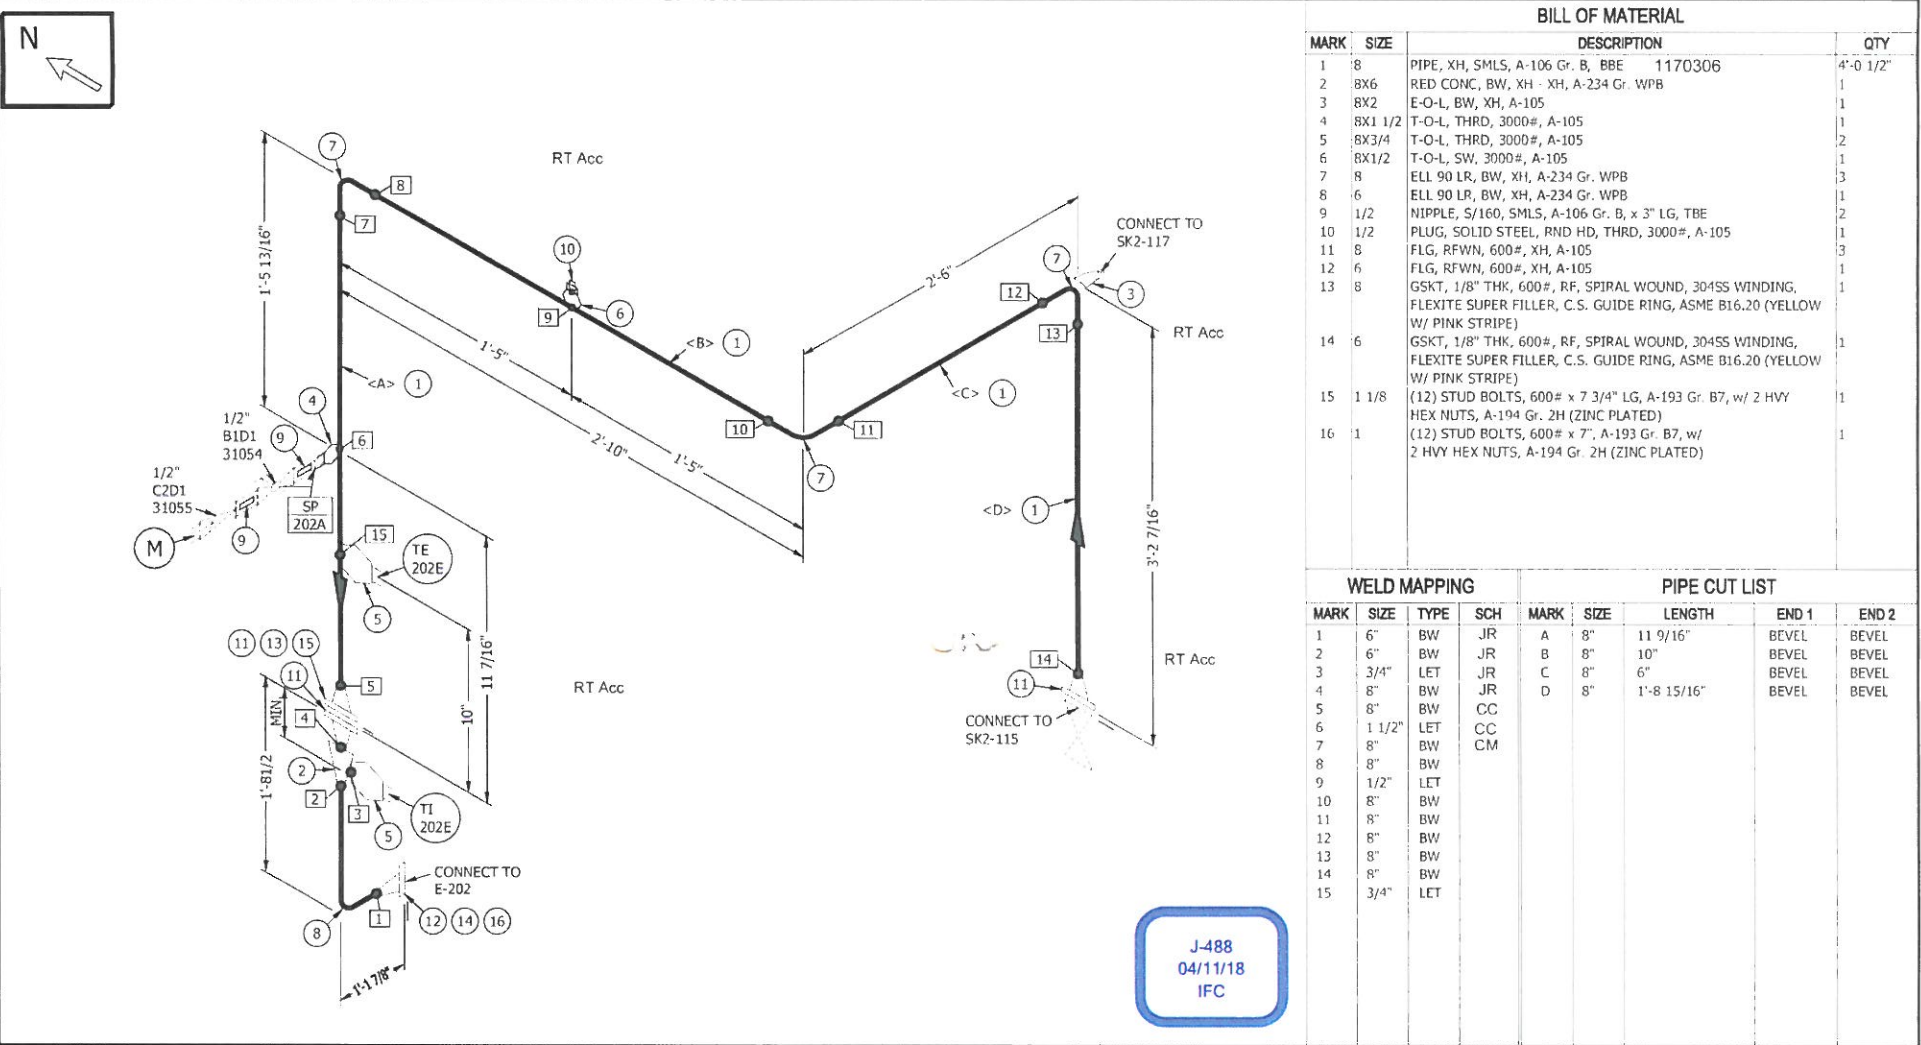

| BILL OF MATERIAL |         |   |         |           |
|------------------|---------|---|---------|-----------|
| MARK             | SIZE    | DESCRIPTION   |         | QTY       |
| 1                | 8       | PIPE, XH, SMLS, A-106 Gr. B, BBE  | 1170306 | 4'-0 1/2" |
| 2                | 8X6     | RED CONC, BW, XH - XH, A-234 Gr. WPB  |         | 1         |
| 3                | 8X2     | E-O-L, BW, XH, A-105  |         | 1         |
| 4                | 8X1 1/2 | T-O-L, THRD, 3000#, A-105   |         | 1         |
| 5                | 8X3/4   | T-O-L, THRD, 3000#, A-105   |         | 2         |
| 6                | 8X1/2   | T-O-L, SW, 3000#, A-105   |         | 1         |
| 7                | 8       | ELL 90 LR, BW, XH, A-234 Gr. WPB  |         | 3         |
| 8                | 6       | ELL 90 LR, BW, XH, A-234 Gr. WPB  |         | 1         |
| 9                | 1/2     | NIPPLE, S/160, SMLS, A-106 Gr. B, x 3" LG, TBE  |         | 2         |
| 10               | 1/2     | PLUG, SOLID STEEL, RND HD, THRD, 3000#, A-105   |         | 1         |
| 11               | 8       | FLG, RFWN, 600#, XH, A-105  |         | 3         |
| 12               | 6       | FLG, RFWN, 600#, XH, A-105  |         | 1         |
| 13               | 8       | GSKT, 1/8" THK, 600#, RF, SPIRAL WOUND, 304SS WINDING, FLEXITE SUPER FILLER, C.S. GUIDE RING, ASME B16.20 (YELLOW W/ PINK STRIPE) |         | 1         |
| 14               | 6       | GSKT, 1/8" THK, 600#, RF, SPIRAL WOUND, 304SS WINDING, FLEXITE SUPER FILLER, C.S. GUIDE RING, ASME B16.20 (YELLOW W/ PINK STRIPE) |         | 1         |
| 15               | 1 1/8   | (12) STUD BOLTS, 600# x 7 3/4" LG, A-193 Gr. B7, w/ 2 HVY HEX NUTS, A-194 Gr. 2H (ZINC PLATED)                                    |         | 1         |
| 16               | 1       | (12) STUD BOLTS, 600# x 7", A-193 Gr. B7, w/ 2 HVY HEX NUTS, A-194 Gr. 2H (ZINC PLATED)   |         | 1         |

| WELD MAPPING |        |      |     | PIPE CUT LIST |      |             |       |       |
|--------------|--------|------|-----|---------------|------|-------------|-------|-------|
| MARK         | SIZE   | TYPE | SCH | MARK          | SIZE | LENGTH      | END 1 | END 2 |
| 1            | 6"     | BW   | JR  | A             | 8"   | 11 9/16"    | BEVEL | BEVEL |
| 2            | 6"     | BW   | JR  | B             | 8"   | 10"         | BEVEL | BEVEL |
| 3            | 3/4"   | LET  | JR  | C             | 8"   | 6"          | BEVEL | BEVEL |
| 4            | 8"     | BW   | JR  | D             | 8"   | 1'-8 15/16" | BEVEL | BEVEL |
| 5            | 8"     | BW   | CC  |               |      |             |       |       |
| 6            | 1 1/2" | LET  | CC  |               |      |             |       |       |
| 7            | 8"     | BW   | CM  |               |      |             |       |       |
| 8            | 8"     | BW   |     |               |      |             |       |       |
| 9            | 1/2"   | LET  |     |               |      |             |       |       |
| 10           | 8"     | BW   |     |               |      |             |       |       |
| 11           | 8"     | BW   |     |               |      |             |       |       |
| 12           | 8"     | BW   |     |               |      |             |       |       |
| 13           | 8"     | BW   |     |               |      |             |       |       |
| 14           | 8"     | BW   |     |               |      |             |       |       |
| 15           | 3/4"   | LET  |     |               |      |             |       |       |

|                |            |                |           |
|----------------|------------|----------------|-----------|
| DESIGN PRESS.  | 1100 Psig  | FAB. LOCATION  | SHOP      |
| DESIGN TEMP.   | 150 °F     | SPOOL LOCATION | SKID #2   |
| OPER. PRESS.   | 820 Psig   |                |           |
| OPER. TEMP.    | 85 °F      | CORR. ALLOW.   | .0625"    |
| STRESS RELIEVE | NO         | INSULATION     | NONE      |
| RADIOGRAPHY    | 15% NORMAL | PAINT          | SYSTEM #3 |



**CONFIDENTIAL STATEMENT**  
 THIS DRAWING IS THE PROPERTY OF THE THOMAS RUSSELL CO. AND IS NOT TO BE USED FOR ANY PURPOSE OTHER THAN THAT FOR WHICH IT IS SPECIFICALLY FURNISHED.

**FABRICATION NOTES:**  
 ALL WELDS ARE RASPED FACE UNLESS NOTED  
 ALL FITTING MAKE-UP & CUT LENGTHS FOR BW PIPE DO NOT INCLUDE WELD GAPS  
 SHOP TO MAKE ADJUSTMENTS FOR WELD GAPS  
 ALL PIPE SEAMLESS UNLESS NOTED OTHERWISE  
 ALL COUPLING TO BE SADDLED ON


**UOP Russell Honeywell UOP**

250 S. York Suite 210  
 Tulsa, Oklahoma 74116  
 Phone 918-481-5822  
 Fax 918-481-1927

|                  |              |
|------------------|--------------|
| REV No           | 151-D1-CS-8" |
| ASSEMBLY DRAWING | SC6R-402     |
| PART DRAWING     | ***-231      |
| DRAWN BY         | COB          |
| DATE DRAWN       | 12/13/17     |
| 3rd No           | 488          |
| SPOOL ID No      | 342-115      |
| REV              | 0            |

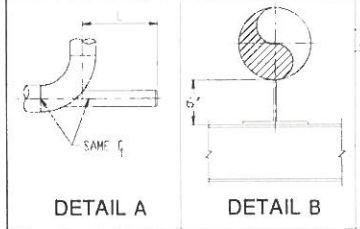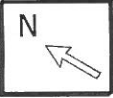

| BILL OF MATERIAL |      |   |            |
|------------------|------|---|------------|
| MARK             | SIZE | DESCRIPTION   | QTY        |
| 1                | 2    | PIPE, XH, SMLS, A-106 Gr. B, BBE D04408   | 17'-3 7/8" |
| 2                |      | ELL 90 LR, BW, XH, A-234 Gr. WPB  | 2          |
| 3                | 2    | FLG, RFWN, 600#, XH, A-105  | 1          |
| 4                |      | (1) PIPE, 1 1/2" XH SMLS, x 2'-5" LG. A-106-B (1) END PL. 1/4" THK x 1 3/4" O D. A-36 (L=2'-2") | 1          |
| 5                |      | PIPE SHOE (TYPE 1) 6" HI. x 6" LG. FROM W8x24 A-992   | 1          |

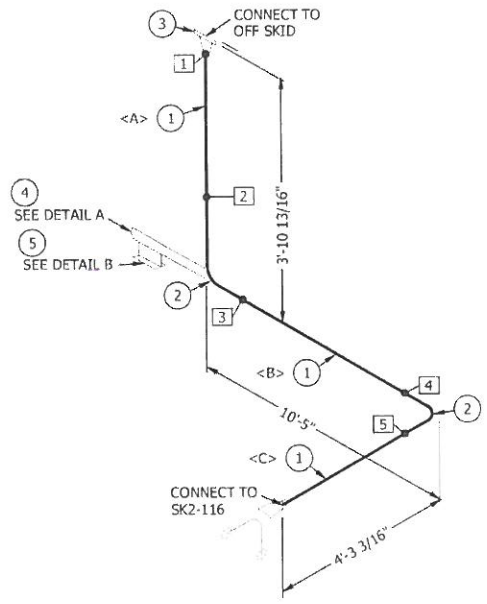

| WELD MAPPING |      |      |     | PIPE CUT LIST |      |             |       |       |
|--------------|------|------|-----|---------------|------|-------------|-------|-------|
| MARK         | SIZE | TYPE | SCH | MARK          | SIZE | LENGTH      | END 1 | END 2 |
| 1            | 2"   | BW   | CC  | A             | 2"   | 3'-4 11/16" | BEVEL | BEVEL |
| 2            | 2"   | BW   |     | B             | 2"   | 9'-11"      | BEVEL | BEVEL |
| 3            | 2"   | BW   |     | C             | 2"   | 4'-0 3/16"  | BEVEL | BEVEL |
| 4            | 2"   | BW   |     |               |      |             |       |       |
| 5            | 2"   | BW   |     |               |      |             |       |       |

**J-488**  
 04/11/18  
 IFC

|                |                       |                |           |     |                        |          |     |     |  |
|----------------|-----------------------|----------------|-----------|-----|------------------------|----------|-----|-----|--|
| DESIGN PRESS.  | 1100 P <sub>sig</sub> | FAB. LOCATION  | SHOP      |     |                        |          |     |     |  |
| DESIGN TEMP.   | 150°F                 | SPOOL LOCATION | SKID #2   |     |                        |          |     |     |  |
| OPER. PRESS.   | 820 P <sub>sig</sub>  |                |           |     |                        |          |     |     |  |
| OPER. TEMP.    | 85°F                  | CORR. ALLOW.   | 0.0625"   |     |                        |          |     |     |  |
| STRESS RELIEVE | NO                    | INSULATION     | NONE      | 0   | ISSUE FOR CONSTRUCTION | 12/20/17 | COB | WD  |  |
| RADIOGRAPHY    | 15% NORMAL            | PAINT          | SYSTEM #3 | NO. | REVISION               | DATE     | BY  | APR |  |


**CONFIDENTIAL STATEMENT**  
 THIS DRAWING IS THE PROPERTY OF THE THOMAS RUSSELL CO. AND IS NOT TO BE USED FOR ANY PURPOSE OTHER THAN THAT FOR WHICH IT IS SPECIFICALLY FURNISHED.

**FABRICATION NOTES:**  
 ALL VALVES ARE BRASS FACE UNLESS NOTED.  
 ALL FITTINGS MAKE-UP & CUT LENGTHS FOR BW PIPE DO NOT INCLUDE WELD GAPS.  
 SHOW TO MAKE ADJUSTMENTS FOR WELD GAPS.  
 ALL PIPE STAINLESS UNLESS NOTED OTHERWISE.  
 ALL COUPLING TO BE SADDLED ON.

UOP Russell  
Honeywell  
Uop

2300 S. Yale, Suite 210  
Tulsa, Oklahoma 74136  
Phone 918-481-5882  
Fax 918-481-7827

|                  |              |
|------------------|--------------|
| LINE No.         | 151-D1-CS-8" |
| ASSEMBLY DRAWING | SC6R-402     |
| FIELD DRAWING    | ***-231      |
| DESIGN BY        | COB          |
| DATE DRAWN       | 12/13/17     |
| JOB No.          | 488          |
| SPOOL ID No.     | 542-117      |
| PTS              | 0            |

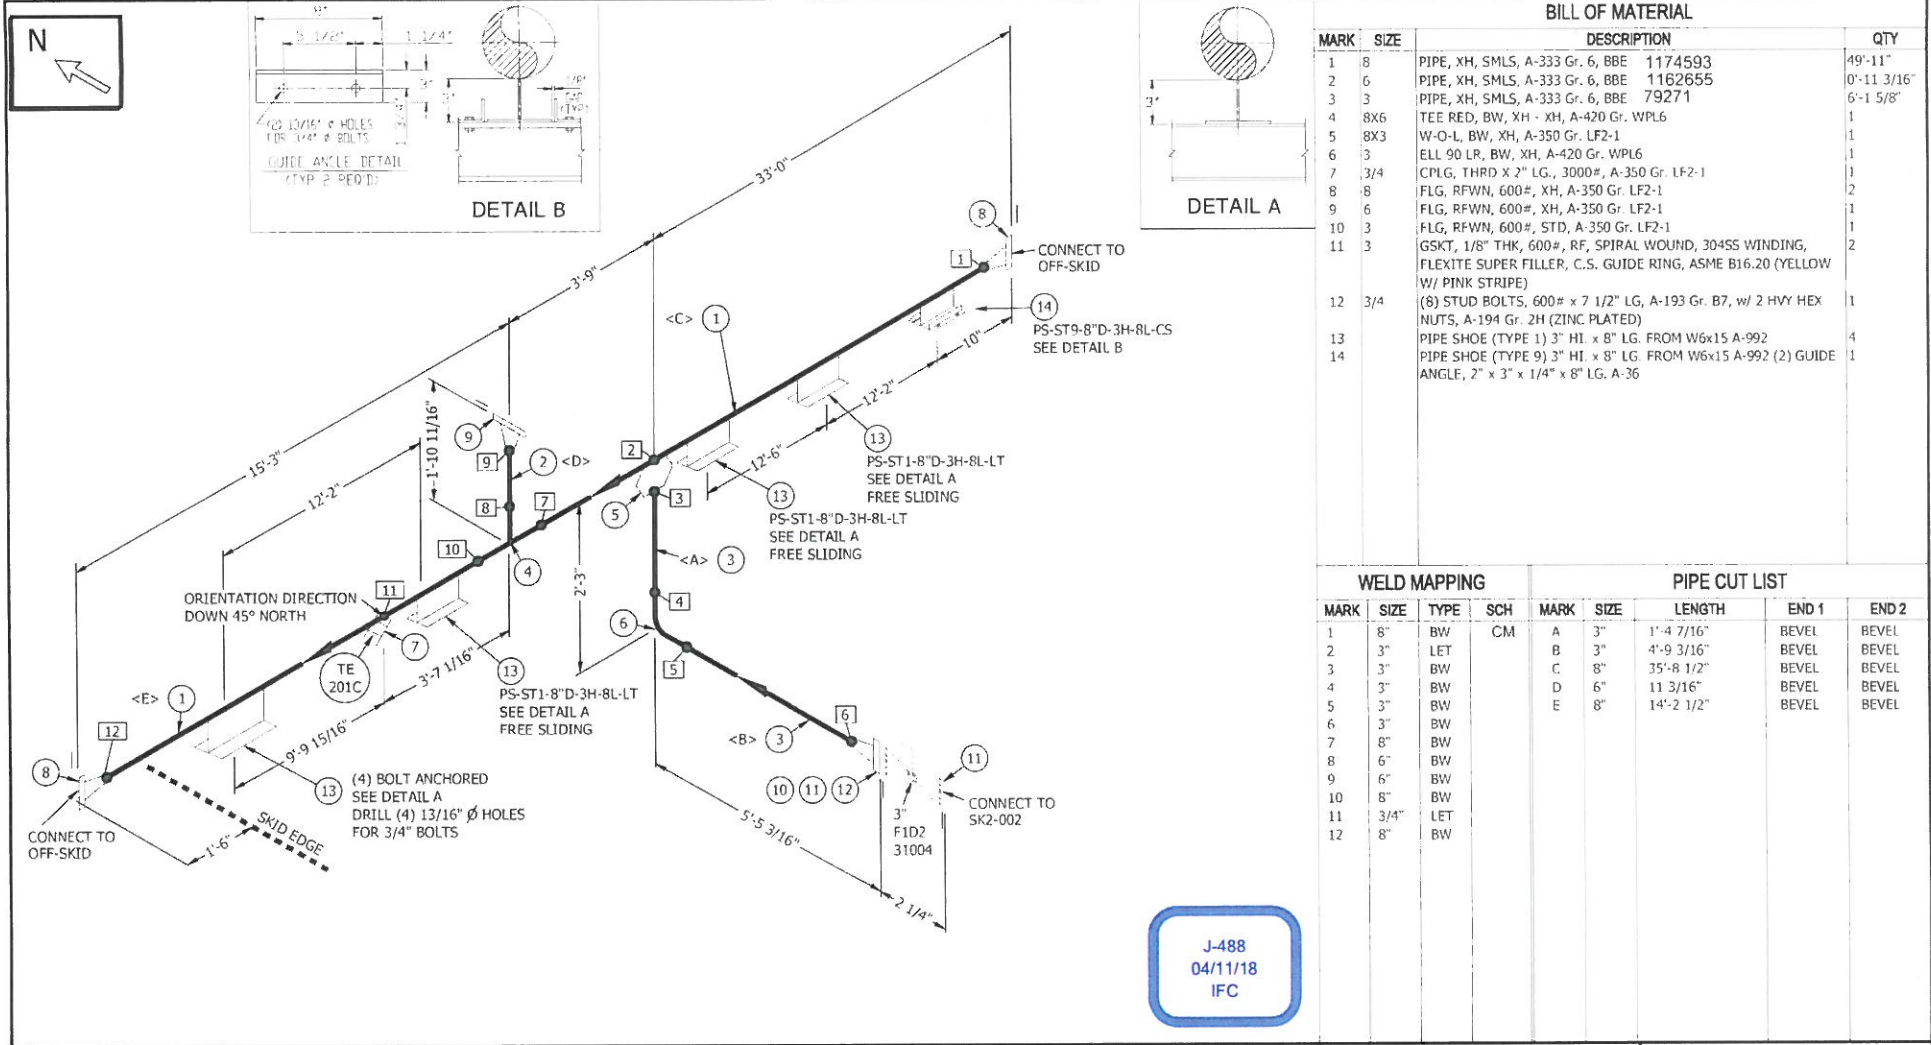

**BILL OF MATERIAL**

| MARK | SIZE | DESCRIPTION  | QTY         |
|------|------|--|-------------|
| 1    | 8    | PIPE, XH, SMLS, A-333 Gr. 6, BBE 1174593   | 49'-11"     |
| 2    | 6    | PIPE, XH, SMLS, A-333 Gr. 6, BBE 1162655   | 0'-11 3/16" |
| 3    | 3    | PIPE, XH, SMLS, A-333 Gr. 6, BBE 79271   | 6'-1 5/8"   |
| 4    | 8X6  | TEE RED, BW, XH - XH, A-420 Gr. WPL6   | 1           |
| 5    | 8X3  | W-O-L, BW, XH, A-350 Gr. LF2-1   | 1           |
| 6    | 3    | ELL 90 LR, BW, XH, A-420 Gr. WPL6  | 1           |
| 7    | 3/4  | CPLG, THRD X 2" LG., 3000#, A-350 Gr. LF2-1  | 1           |
| 8    | 8    | FLG, RFWN, 600#, XH, A-350 Gr. LF2-1   | 2           |
| 9    | 6    | FLG, RFWN, 600#, XH, A-350 Gr. LF2-1   | 1           |
| 10   | 3    | FLG, RFWN, 600#, STD, A-350 Gr. LF2-1  | 1           |
| 11   | 3    | GSKT, 1/8" THK, 600#, RF, SPIRAL WOUND, 304SS WINDING, FLEXITTE SUPER FILLER, C.S. GUIDE RING, ASME B16.20 (YELLOW W/ PINK STRIPE) | 2           |
| 12   | 3/4  | (8) STUD BOLTS, 600# x 7 1/2" LG, A-193 Gr. B7, w/ 2 HVY HEX NUTS, A-194 Gr. 2H (ZINC PLATED)                                      | 1           |
| 13   |      | PIPE SHOE (TYPE 1) 3" HI. x 8" LG. FROM W6x15 A-992  | 4           |
| 14   |      | PIPE SHOE (TYPE 9) 3" HI. x 8" LG. FROM W6x15 A-992 (2) GUIDE ANGLE, 2" x 3" x 1/4" x 8" LG. A-36                                  | 1           |

J-488  
 04/11/18  
 IFC

|                |            |                |           |     |                        |          |     |     |  |
|----------------|------------|----------------|-----------|-----|------------------------|----------|-----|-----|--|
| DESIGN PRESS   | 1100 Psig  | FAB. LOCATION  | SHOP      |     |                        |          |     |     |  |
| DESIGN TEMP.   | 150 °F     | SPOOL LOCATION | SKID #2   |     |                        |          |     |     |  |
| OPER. PRESS.   | 820 Psig   |                |           |     |                        |          |     |     |  |
| OPER. TEMP.    | 71 °F      | CORR. ALLOW.   | .0625"    |     |                        |          |     |     |  |
| STRESS RELIEVE | NO         | INSULATION     | 1.5" C    | 0   | ISSUE FOR CONSTRUCTION | 12-21-17 | COB | WD  |  |
| RADIOGRAPHY    | 15% NORMAL | PAINT          | SYSTEM #3 | NO. | REVISION               | DATE     | BY  | APR |  |



**CONFIDENTIAL STATEMENT**  
 THIS DRAWING IS THE PROPERTY OF THE HONEYWELL COMPANY AND IS NOT TO BE USED FOR ANY PURPOSE OTHER THAN THAT FOR WHICH IT IS SPECIFICALLY SUBMITTED.

**FABRICATION NOTES:**  
 ALL VALVES ARE BARGE FACE UNLESS NOTED.  
 ALL FITTING MAKE-UP & CUT LENGTHS FOR BW PIPE DO NOT INCLUDE WELD GAPS.  
 SHOP TO MAKE ADJUSTMENTS FOR WELD GAPS.  
 ALL PIPE SEAMLESS UNLESS NOTED OTHERWISE.  
 ALL COUPLING TO BE SADDLED ON.

**UOP Russell Honeywell**

2990 S. York, Suite 210  
 Tulsa, Oklahoma 74136  
 Phone 918-481-5882  
 Fax 918-481-7427

|                  |                     |
|------------------|---------------------|
| LINE No.         | 155-D1-LT-8" 1.5" C |
| ASSEMBLY DRAWING | SC6R-402            |
| FABO DRAWING     | ***-231             |
| DRAWN BY         | COB                 |
| DATE DRAWN       | 3-17-17             |
| JOB No.          | 488                 |
| SPOOL ID No.     | 542-118             |
| REV              | 0                   |

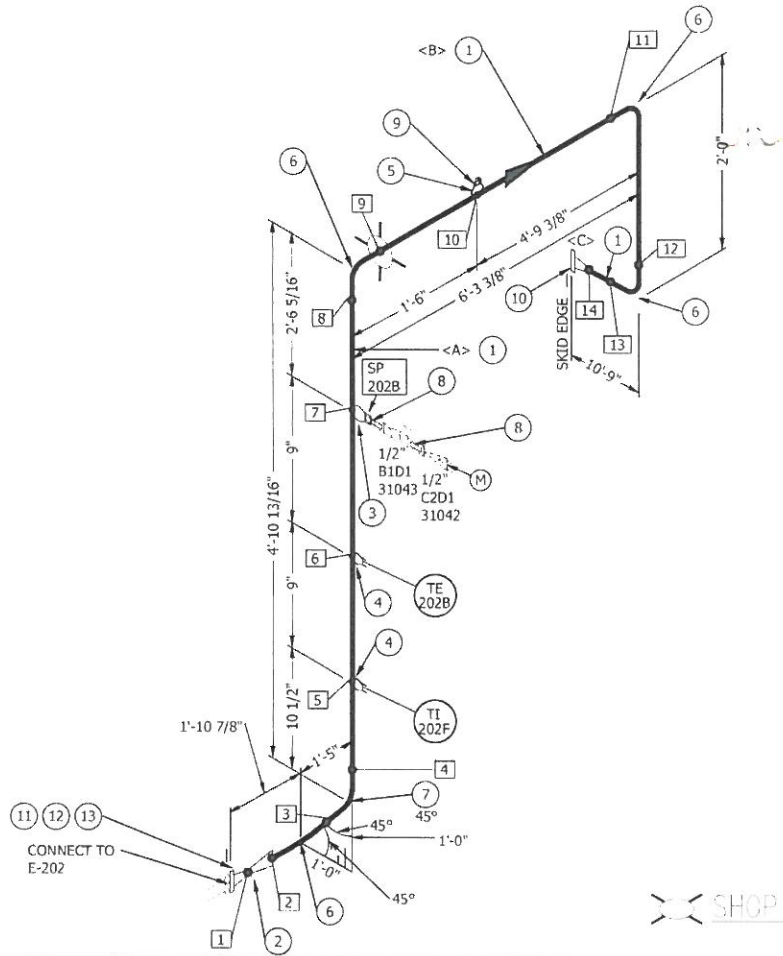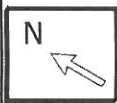

SHOP WELD

J-488  
04/11/18  
IFC

**BILL OF MATERIAL**

| MARK | SIZE    | DESCRIPTION   | QTY        |
|------|---------|---|------------|
| 1    | 8       | PIPE, XH, SMLS, A-106 Gr. B, BBE 101966   | 17'-0 3/4" |
| 2    | 8X6     | RED CONC, BW, XH - XH, A-234 Gr. WPR  | 1          |
| 3    | 8X1 1/2 | T-O-L, THRD, 3000#, A-105   | 1          |
| 4    | 8X3/4   | T-O-L, THRD, 3000#, A-105   | 2          |
| 5    | 8X1/2   | T-O-L, THRD, 3000#, A-105   | 1          |
| 6    | 8       | ELL 90 LR, BW, XH, A-234 Gr. WPB  | 4          |
| 7    | 8       | ELL 45, BW, XH, A-234 Gr. WPB   | 1          |
| 8    | 1/2     | NIPPLE, S/160, SMLS, A-106 Gr. B, x 3" LG, TBE (3" LG)  | 2          |
| 9    | 1/2     | PLUG, SOLID STEEL, RND HD, THRD, 3000#, A-105   | 1          |
| 10   | 8       | FLG, RFWN, 600#, XH, A-105  | 1          |
| 11   | 6       | FLG, RFWN, 600#, XH, A-105  | 1          |
| 12   | 6       | GSKT, 1/8" THK, 600#, RF, SPIRAL WOUND, 304SS WINDING, FLEXITE SUPER FILLER, C.S. GUIDE RING, ASME B16 20 (YELLOW W/ PINK STRIPE) | 1          |
| 13   | 1       | (12) STUD BOLTS, 600# x 7" LG, A-193 Gr. B7, w/ 2 HVY HEX NUTS, A-194 Gr. 2H (ZINC PLATED) (7" LG)                                | 1          |

**WELD MAPPING**

| MARK | SIZE   | TYPE | SCH |
|------|--------|------|-----|
| 1    | 6"     | BW   | JR  |
| 2    | 8"     | BW   |     |
| 3    | 8"     | BW   |     |
| 4    | 8"     | BW   |     |
| 5    | 3/4"   | LET  |     |
| 6    | 3/4"   | LET  |     |
| 7    | 1 1/2" | LET  |     |
| 8    | 8"     | BW   |     |
| 9    | 8"     | BW   |     |
| 10   | 1/2"   | LET  |     |
| 11   | 8"     | BW   |     |
| 12   | 8"     | BW   |     |
| 13   | 8"     | BW   |     |
| 14   | 8"     | BW   |     |

**PIPE CUT LIST**

| MARK | SIZE | LENGTH      | END 1 | END 2 |
|------|------|-------------|-------|-------|
| A    | 8"   | 3'-5 13/16" | BEVEL | BEVEL |
| B    | 8"   | 4'-3 3/8"   | BEVEL | BEVEL |
| C    | 8"   | 9'-3 9/16"  | BEVEL | BEVEL |

|                |            |                |           |
|----------------|------------|----------------|-----------|
| DESIGN PRESS.  | 1100 Psig  | FAB. LOCATION  | SHOP      |
| DESIGN TEMP    | 150 °F     | SPOOL LOCATION | SKID #2   |
| OPER. PRESS.   | 830 Psig   |                |           |
| OPER. TEMP.    | 109 °F     | CORR. ALLOW.   | 0.0625"   |
| STRESS RELIEVE | NO         | INSULATION     | NONE      |
| RADIOGRAPHY    | 15% NORMAL | PAINT          | SYSTEM #3 |

**CONFIDENTIAL STATEMENT**  
THIS DRAWING IS THE PROPERTY OF THE THOMAS RUSSELL CO AND IS NOT TO BE USED FOR ANY PURPOSE OTHER THAN THAT FOR WHICH IT IS SPECIFICALLY PREPARED.



**FABRICATION NOTES:**  
ALL VALVES ARE ROUGH TACK UNLESS NOTED  
ALL FITTING MAKE-UP & CUT LENGTHS FOR BW PIPE DO NOT INCLUDE WELD CAPS  
SHOP TO MAKE ADJUSTMENTS FOR WELD CAPS  
ALL PIPE SEAMLESS UNLESS NOTED OTHERWISE  
ALL EQUIPMENT TO BE PARALLELED ON.

**UOP Russell Honeywell Uop**

2020 S. Yale Avenue, Suite 210  
Tulsa, Oklahoma 74136

Phone: 918-481-5697  
Fax: 918-481-7427

|                  |              |
|------------------|--------------|
| REV. No.         | 153-D1-CS-8" |
| ASSEMBLY DRAWING | SC6R-402     |
| PLANT DRAWING    | ***-251      |
| DRAWN BY         | COB          |
| CHECKED BY       | 1/8/18       |
| JOB NO.          | 488          |
| SPOON ID No.     | SK2 121      |
| REV              | 0            |

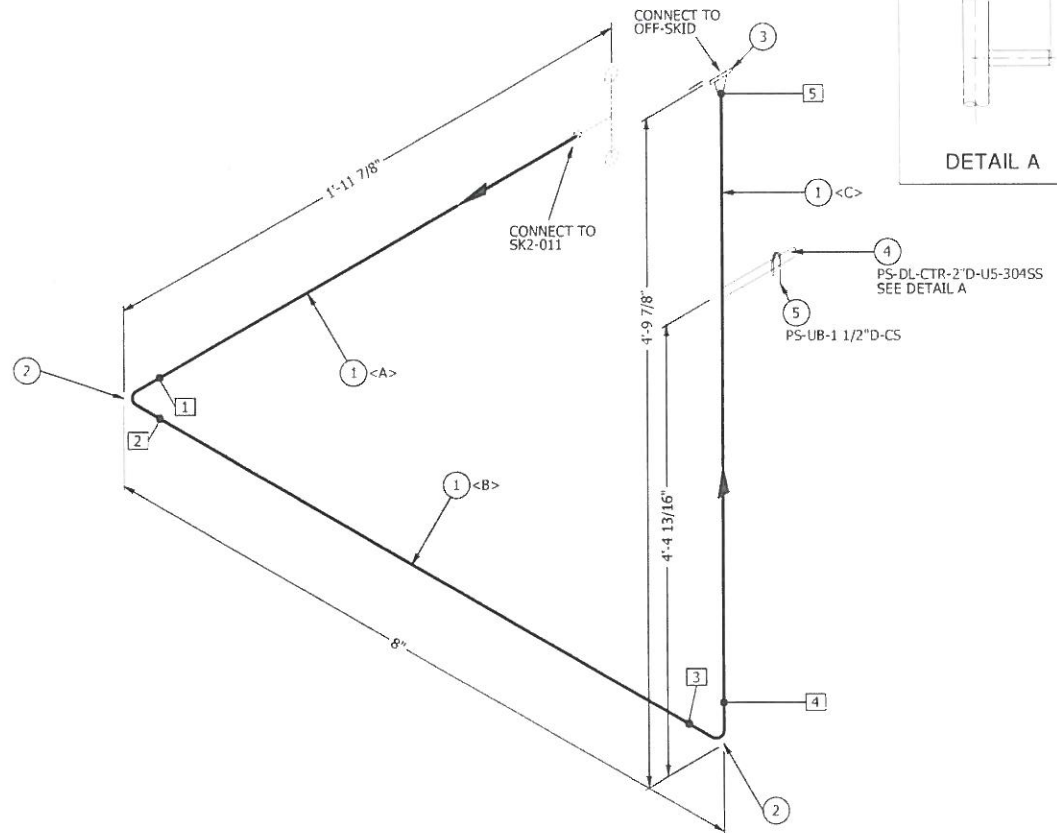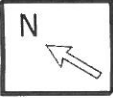

| BILL OF MATERIAL |       |  |          |            |
|------------------|-------|--|----------|------------|
| MARK             | SIZE  | DESCRIPTION  | QTY      |            |
| 1                | 2     | PIPE, S/40S, SMLS, A-312 Gr. TP-304/304L, BBE                  | OC513085 | 5'-11 1/8" |
| 2                | 2     | ELI 90 LR, BW, S/40S, A-403 Gr. WP-304/304L                    |          | 2          |
| 3                | 2     | FLG, PFWN, 600#, S/40S, A-182 Gr. F304/304L                    |          | 1          |
| 4                | 2     | (1) PIPE, 1 1/2" S/80S, SMLS OR WLD, x 1-7 1/8" LG. A-312 Gr.  |          | 1          |
| 5                | 1 1/2 | TP-304/304L (1) END PL, 1/4" THK. x 1 3/4" O.D. A-36 (L=2'-1") |          | 1          |
|                  |       | U-BOLT FOR 1 1/2" DIA PIPE W/ (4) HEX NUTS EA (CS ZINC PL)     |          |            |

| WELD MAPPING |      |      |     | PIPE CUT LIST |      |           |       |       |
|--------------|------|------|-----|---------------|------|-----------|-------|-------|
| MARK         | SIZE | TYPE | SCH | MARK          | SIZE | LENGTH    | END 1 | END 2 |
| 1            | 2"   | BW   | D   | A             | 2"   | 1'-5 3/8" | BEVEL | BEVEL |
| 2            | 2"   | BW   |     | B             | 2"   | 2"        | BEVEL | BEVEL |
| 3            | 2"   | BW   |     | C             | 2"   | 4'-3 3/4" | BEVEL | BEVEL |
| 4            | 2"   | BW   |     |               |      |           |       |       |
| 5            | 2"   | BW   |     |               |      |           |       |       |

J-488  
 04/11/18  
 IFC

|                |            |                |         |     |                        |          |    |     |  |
|----------------|------------|----------------|---------|-----|------------------------|----------|----|-----|--|
| DESIGN PRESS   | 1100 Psig  | FAB LOCATION   | SHOP    |     |                        |          |    |     |  |
| DESIGN TEMP    | 150°F      | SPOOL LOCATION | SKID #2 |     |                        |          |    |     |  |
| OPER. PRESS.   | 810 Psia   |                |         |     |                        |          |    |     |  |
| OPER. TEMP.    | -71°F      | CORR. ALLOW.   | NONE    |     |                        |          |    |     |  |
| STRESS RELIEVE | NO         | INSULATION     | 2.5°C   | 0   | ISSUE FOR CONSTRUCTION | 01/09/18 | CW | WC  |  |
| RADIOGRAPHY    | 15% NORMAL | PAINT          | NONE    | NO. | REVISION               | DATE     | BY | APR |  |

**CONFIDENTIAL STATEMENT**  
 THIS DRAWING IS THE PROPERTY OF THE THOMAS RUSSELL Co. AND IS NOT TO BE USED FOR ANY PURPOSE OTHER THAN THAT FOR WHICH IT IS SPECIFICALLY FURNISHED.


**FABRICATION NOTES:**  
 ALL VALVES ARE RASFD FACE UNLESS NOTED  
 ALL FITTING MARK-UP & CUT LENGTHS FOR BW PIPE DO NOT INCLUDE WELD CAPS  
 SHOP TO MAKE ADJUSTMENTS FOR WELD CAPS  
 ALL PIPE SEAMLESS UNLESS NOTED OTHERWISE  
 ALL CONNECTIONS TO BE SADDLED ON.

UOP Russell  
Honeywell


Uop

1200 S. Yale, Suite 310  
Tulsa, Oklahoma 74116  
Phone 918-481-5800  
Fax 918-481-7427

|                  |                       |
|------------------|-----------------------|
| LINE No.         | 160-00-304SS-4" 2.5°C |
| ASSEMBLY DRAWING |                       |
| SC6R-402         |                       |
| P&ID DRAWING     |                       |
| ***-231          |                       |
| DRAWN BY         | CW                    |
| DATE DRAWN       | 01/09/18              |
| 238 No.          | 498                   |
| PROCESS ID No.   | SK2-122               |
| REV              | 0                     |

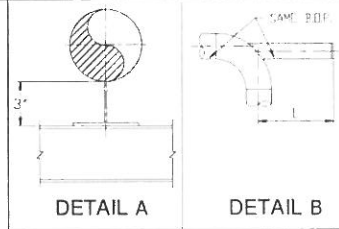

| BILL OF MATERIAL |      |   |              |
|------------------|------|---|--------------|
| MARK             | SIZE | DESCRIPTION   | QTY          |
| 1                | 6    | PIPE, XH, SMLS, A-333 Gr. 6, BBE 1162655  | 20'-11 5/16" |
| 2                | 6X6  | TEE, BW, XH, A-420 Gr. WPL6   | 1            |
| 3                | 6X4  | RED CONC, BW, XH - XH, A-420 Gr. WPL6   | 1            |
| 4                | 6    | ELL 90 LR, BW, XH, A-420 Gr. WPL6   | 3            |
| 5                | 4X2  | RED CONC, BW, XH - XH, A-420 Gr. WPL6   | 1            |
| 6                | 1/2  | PLUG, SOLID STEEL, RND HD, THRD, 3000#, A-350 Gr. LF2-1   | 2            |
| 7                | 1/2  | NIPPLE, S/160, SMLS, A-333 Gr. 6, x 3" LG, TBE (3.00000000 LG)  | 1            |
| 8                | 1/2  | NIPPLE, S/160, SMLS, A-333 Gr. 6, x 6" LG, TBE (6.00000000 LG)  | 1            |
| 9                | 6    | FLG, RFWN, 600#, XH, A-350 Gr. LF2-1  | 1            |
| 10               | 6    | FLG, ORIFICE, RFWN, 600#, XH, A-350 Gr. LF2-1 w/ 1/2" NPT TAPS  | 2            |
| 11               | 2    | FLG, RFWN, 600#, XH, A-350 Gr. LF2-1  | 1            |
| 12               | 6    | GSKT, 1/8" THK, 600#, RF, SPIRAL WOUND, 304SS WINDING, FLEXITE SUPER FILLER, C.S. GUIDE RING, ASME B16.20 (YELLOW W/ PINK STRIPE) | 2            |
| 13               | 1    | (12) STUD BOLTS, 600# x 7 1/4" LG, A-193 Gr. B7, w/ 2 HWY HEX NUTS, A-194 Gr. 2H (ZINC PLATED) (7.25000000 LG)                    | 1            |
| 14               | 6    | (1) PL, 1/4" THK. x 6" x 6" LG. A-516-70 (1) PL, 1/4" THK. x 2 3/4" x 6" LG. A-516-70   | 2            |
| 15               | 6    | (1) PIPE, 4" STD, SMLS, x 5'-11" LG. A-333 Gr. 6 (1) END PL, 1/4" THK. x 4 3/8" O.D. A-36 (L-5'-1')                               | 1            |
| 16               | 3    | (1) PL, 1/4" THK. x 6" x 8" LG. A-516-70 (1) PL, 1/4" THK. x 2 3/4" x 8" LG. A-516-70   | 1            |

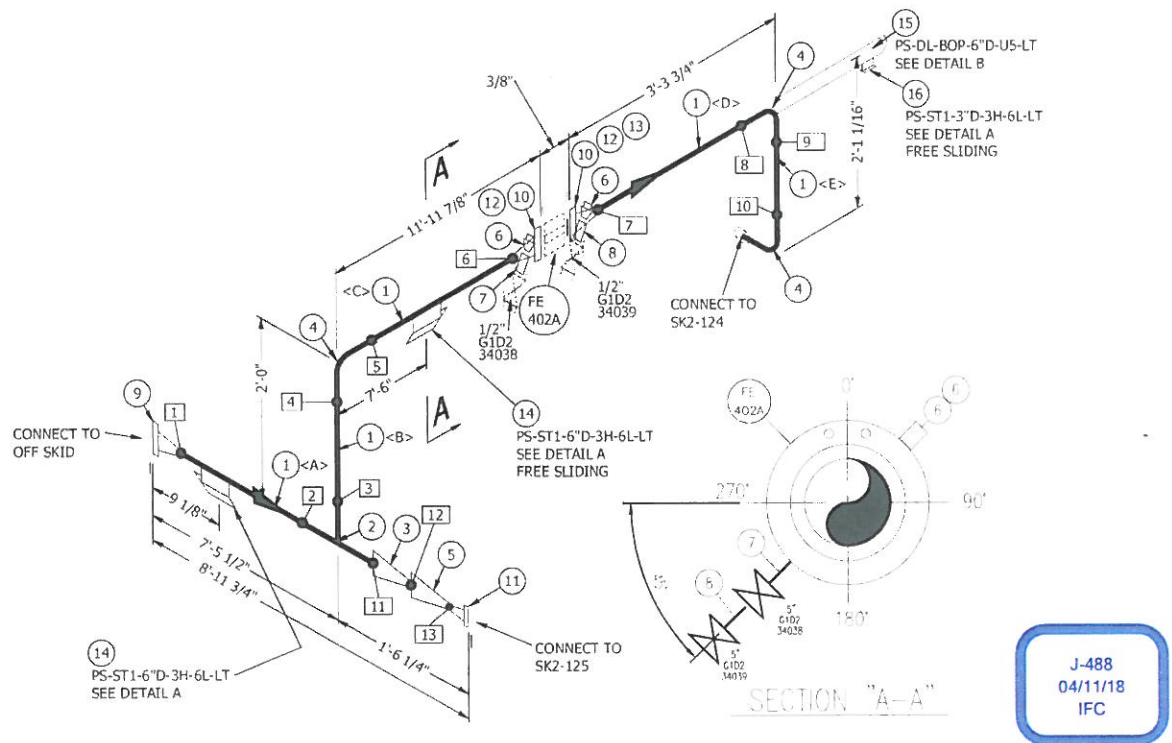


| WELD MAPPING |      |      |     | PIPE CUT LIST |      |           |       |       |
|--------------|------|------|-----|---------------|------|-----------|-------|-------|
| MARK         | SIZE | TYPE | SCH | MARK          | SIZE | LENGTH    | END 1 | END 2 |
| 1            | 6"   | BW   | CM  | A             | 6"   | 6'-7"     | BEVEL | BEVEL |
| 2            | 6"   | BW   |     | B             | 6"   | 9 3/8"    | BEVEL | BEVEL |
| 3            | 6"   | BW   |     | C             | 6"   | 10'-10"   | BEVEL | BEVEL |
| 4            | 6"   | BW   |     | D             | 6"   | 2'-1 7/8" | BEVEL | BEVEL |
| 5            | 6"   | BW   |     | E             | 6"   | 7 1/16"   | BEVEL | BEVEL |
| 6            | 6"   | BW   |     |               |      |           |       |       |
| 7            | 6"   | BW   |     |               |      |           |       |       |
| 8            | 6"   | BW   |     |               |      |           |       |       |
| 9            | 6"   | BW   |     |               |      |           |       |       |
| 10           | 6"   | BW   |     |               |      |           |       |       |
| 11           | 6"   | BW   |     |               |      |           |       |       |
| 12           | 4"   | BW   |     |               |      |           |       |       |
| 13           | 2"   | BW   |     |               |      |           |       |       |

**J-488**  
 04/11/18  
 IFC




|                |            |                |           |     |                        |          |    |     |  |
|----------------|------------|----------------|-----------|-----|------------------------|----------|----|-----|--|
| DESIGN PRESS.  | 1100 Psig  | FAB. LOCATION  | SHOP      |     |                        |          |    |     |  |
| DESIGN TEMP.   | 150°F      | SPOOL LOCATION | SKID #2   |     |                        |          |    |     |  |
| OPER. PRESS.   | 800 Psia   |                |           |     |                        |          |    |     |  |
| OPER. TEMP.    | -30°F      | CORR. ALLOW.   | 0.625"    |     |                        |          |    |     |  |
| STRESS RELIEVE | NO         | INSULATION     | 1.5°C     | 0   | ISSUE FOR CONSTRUCTION | 01/10/18 | CW | WD  |  |
| RADIOGRAPHY    | 15% NORMAL | PAINT          | SYSTEM #3 | NO. | REVISION               | DATE     | BY | APR |  |

**CONFIDENTIAL STATEMENT**  
 THIS DRAWING IS THE PROPERTY OF THE THOMAS RUSSELL Co. AND IS NOT TO BE USED FOR ANY PURPOSE OTHER THAN THAT FOR WHICH IT IS SPECIFICALLY FURNISHED.

**FABRICATION NOTES:**  
 ALL VALVES ARE BRASS FACE UNLESS NOTED.  
 ALL CUTTING MARKS, UO & CO. LENGTHS FOR END PIPE DO NOT INCLUDE WELD GAPS.  
 SHOP TO MAKE ADJUSTMENTS FOR WELD GAPS.  
 ALL PIPE SEAMLESS UNLESS NOTED OTHERWISE.  
 ALL EQUIPMENT TO BE SADDLED ON.

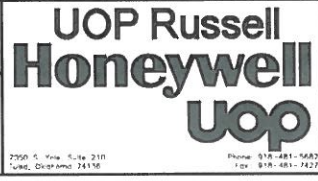

|                  |                    |
|------------------|--------------------|
| DRW. No.         | 170-D1-11-6" 1.5°C |
| ASSEMBLY DRAWING | SC6R-402           |
| FIELD DRAWING    | ***-234            |
| DRAWN BY         | CW                 |
| DATE DRAWN       | 01/10/18           |
| JOB No.          | 488                |
| SPOOL ID No.     | SK2-123            |
| REV              | 0                  |

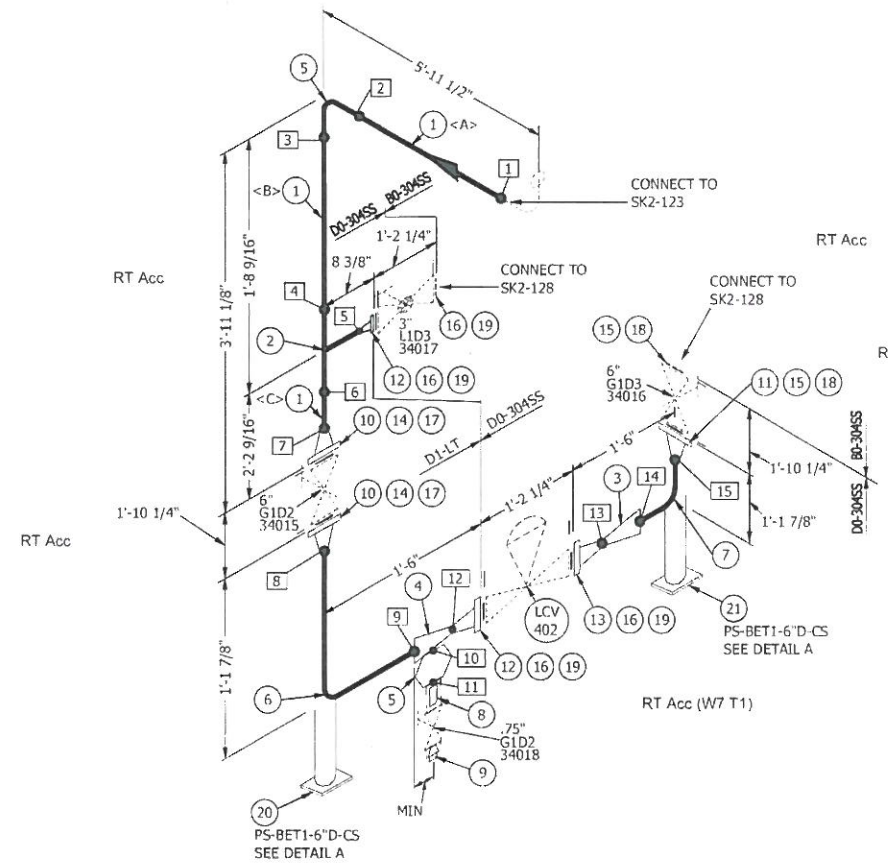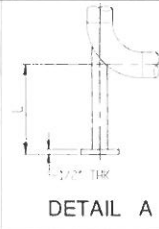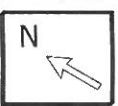

**J-488**  
 04/11/18  
 IFC

**BILL OF MATERIAL**

| MARK | SIZE  | DESCRIPTION   | QTY       |
|------|-------|---|-----------|
| 1    | 6     | PIPE, XH, SMLS, A-333 Gr. 6, BBE 1162655  | 6'-3 1/2" |
| 2    | 6X3   | TEE RED, BW, XH - XH, A-420 Gr. WPL6  | 1         |
| 3    | 6X3   | RED CONC, BW, XH - XH, A-420 Gr. WPL6   | 1         |
| 4    | 6X3   | RED CONC, BW, S/40S - S/40S, A-403 Gr. WP-304/304L  | 1         |
| 5    | 6X3/4 | S-O-L, SW, 3000#, A-350 Gr. LF2-1   | 1         |
| 6    | 6     | ELL 90 LR, BW, XH, A-420 Gr. WPL6   | 2         |
| 7    | 6     | ELL 90 LR, BW, S/40S, A-403 Gr. WP-304/304L   | 1         |
| 8    | 3/4   | NIPPLE, S/160, SMLS, A-333 Gr. 6, x 3" LG, (3" LG)  | 1         |
| 9    | 3/4   | PLUG, SOLID STEEL, RND HD, THRD, 3000#, A-350 Gr. LF2-1   | 1         |
| 10   | 6     | FLG, RFWN, 600#, XH, A-350 Gr. LF2-1  | 2         |
| 11   | 6     | FLG, RFWN, 600#, S/40S, A-182 Gr. F304/304L   | 1         |
| 12   | 3     | FLG, RFWN, 600#, XH, A-350 Gr. LF2-1  | 2         |
| 13   | 3     | FLG, RFWN, 600#, S/40S, A-182 Gr. F304/304L   | 1         |
| 14   | 6     | GSKT, 1/8" THK, 600#, RF, SPIRAL WOUND, 304SS WINDING, FLEXITE SUPER FILLER, C.S. GUIDE RING, ASME B16.20 (YELLOW W/ PINK STRIPE)     | 2         |
| 15   | 6     | GSKT, 1/8" THK, 600#, RF, SPIRAL WOUND, 304SS WINDING, FLEXIBLE GRAPHITE FILLER, C.S. GUIDE RING, ASME B16.20 (YELLOW W/ GREY STRIPE) | 2         |
| 16   | 3     | GSKT, 1/8" THK, 600#, RF, SPIRAL WOUND, 304SS WINDING, FLEXIBLE GRAPHITE FILLER, C.S. GUIDE RING, ASME B16.20 (YELLOW W/ GREY STRIPE) | 4         |
| 17   | 1     | (12) STUD BOLTS, 600# x 7" LG, A-193 Gr. B7, w/ 2 HVY HEX NUTS, A-194 Gr. 2H (ZINC PLATED)  | 2         |
| 18   | 1     | (12) STUD BOLTS, 600# x 7" LG, A-193 Gr. B8 Cl. 2, w/ 2 HVY HEX NUTS, A-194 Gr. 8 (ZINC PLATED)                                       | 2         |
| 19   | 3/4   | (8) STUD BOLTS, 600# x 5 1/4" LG, A-193 Gr. B8 Cl. 2, w/ 2 HVY HEX NUTS, A-194 Gr. 8 (ZINC PLATED)                                    | 4         |
| 20   | 6     | (1) PIPE, 3" STD, SMLS, x 2'-2 1/2" LG. A-333 Gr. 6 (1) BASE PL, 1/2" THK. x 6" x 6" A-36 (L=1'-6")                                   | 1         |
| 21   | 6     | (1) PIPE, 3" S/10S, SMLS OR WLD, x 2'-2 1/2" LG. A-312 Gr. TP-304/304L (1) BASE PL, 1/2" THK. x 6" x 6" A-36 (L=1'-6")                | 1         |

**WELD MAPPING**

| MARK | SIZE | TYPE | SCH |
|------|------|------|-----|
| 1    | 6"   | BW   | CC  |
| 2    | 6"   | BW   |     |
| 3    | 6"   | BW   |     |
| 4    | 6"   | BW   |     |
| 5    | 3"   | BW   |     |
| 6    | 6"   | BW   |     |
| 7    | 6"   | BW   |     |
| 8    | 6"   | BW   |     |
| 9    | 6"   | BW   |     |
| 10   | 3/4" | LET  |     |
| 11   | 3/4" | SW   |     |
| 12   | 3"   | BW   | S   |
| 13   | 3"   | BW   |     |
| 14   | 6"   | BW   |     |
| 15   | 6"   | BW   |     |


**PIPE CUT LIST**

| MARK | SIZE | LENGTH     | END 1 | END 2 |
|------|------|------------|-------|-------|
| 1    | 6"   | 4'-5 1/2"  | BEVEL | BEVEL |
| 2    | 6"   | 5 15/16"   | BEVEL | BEVEL |
| 3    | 6"   | 1'-4 1/16" | BEVEL | BEVEL |
| 4    | 6"   |            |       |       |
| 5    | 3"   |            |       |       |
| 6    | 6"   |            |       |       |
| 7    | 6"   |            |       |       |
| 8    | 6"   |            |       |       |
| 9    | 6"   |            |       |       |
| 10   | 3/4" |            |       |       |
| 11   | 3/4" |            |       |       |
| 12   | 3"   |            |       |       |
| 13   | 3"   |            |       |       |
| 14   | 6"   |            |       |       |
| 15   | 6"   |            |       |       |



|                |                        |                |           |     |                        |          |    |     |  |
|----------------|------------------------|----------------|-----------|-----|------------------------|----------|----|-----|--|
| DESIGN PRESS.  | 1100 P <sub>Si</sub> g | FAB. LOCATION  | SHOP      |     |                        |          |    |     |  |
| DESIGN TEMP.   | 150 °F                 | SPOOL LOCATION | SK'D #2   |     |                        |          |    |     |  |
| OPER. PRESS.   | 800 P <sub>Si</sub> d  |                |           |     |                        |          |    |     |  |
| OPER. TEMP.    | -30 °F                 | CORR. ALLOW.   | 0625"     |     |                        |          |    |     |  |
| STRESS RELIEVE | NO                     | INSULATION     | 1.5"C     | 0   | ISSUE FOR CONSTRUCTION | 01/10/18 | CW | WD  |  |
| RADIOGRAPHY    | 15% NORMAL             | PAINT          | SYSTEM #3 | NO. | REVISION               | DATE     | BY | APR |  |

**CONFIDENTIAL STATEMENT**  
 THIS DRAWING IS THE PROPERTY OF THE THOMAS RUSSELL CO AND IS NOT TO BE USED FOR ANY PURPOSE OTHER THAN THAT FOR WHICH IT IS SPECIFICALLY FURNISHED.

**FABRICATION NOTES:**  
 ALL VALVES ARE RATED FACE UNLESS NOTED.  
 ALL FITTING WAVE UP & CUT LENGTHS FOR END PIPE DO NOT INCLUDE WELD CAPS.  
 SHOP TO MAKE ADJUSTMENTS FOR WELD CAPS.  
 ALL PIPE SEAMLESS UNLESS NOTED OTHERWISE.  
 ALL COUPLING TO BE SADDLED ON.

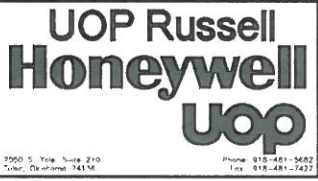

|                  |                    |
|------------------|--------------------|
| DRW. NO.         | 170-D1-11-6" 1.5"C |
| ASSEMBLY DRAWING | SC6R-402           |
| TITLE DRAWING    | ***-234            |
| DRAWN BY         | CW                 |
| DATE             | 01/10/18           |
| JOB NO.          | 488                |
| SPOOL ID NO.     | SK2-124            |
| REV              | 0                  |

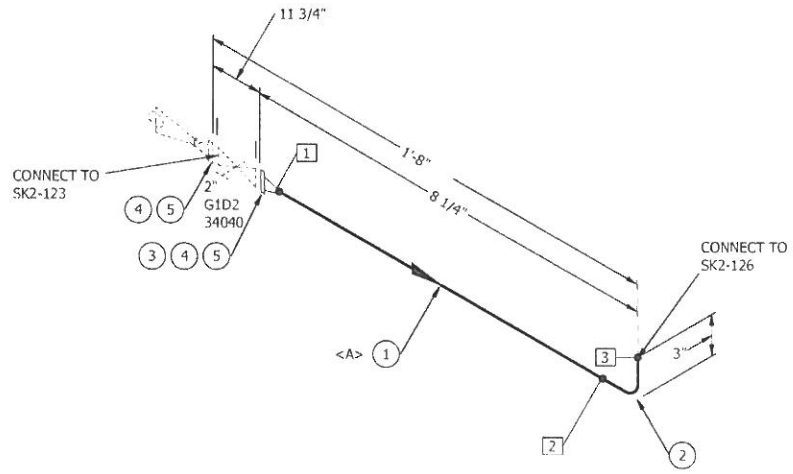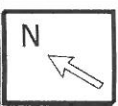

**J-488**  
 04/11/18  
 IFC

**BILL OF MATERIAL**

| MARK | SIZE | DESCRIPTION   | QTY       |
|------|------|---|-----------|
| 1    | 2    | PIPE, XH, SMLS, A-333 Gr. 6, BBE 1144852  | 0'-2 1/8" |
| 2    | 2    | ELI 90 LR, BW, XH, A-420 Gr. WPL6   | 1         |
| 3    | 2    | FLG, RFWN, 600#, STD, A-350 Gr. LF2-1   | 1         |
| 4    | 2    | GSKT, 1/8" THK, 600#, RF, SPIRAL WOUND, 304SS WINDING, FLEXITE SUPER FILLER, C.S. GUIDE RING, ASME B16.20 (YELLOW W/ PINK STRIPE) | 2         |
| 5    | 5/8  | (8) STUD BOLTS, 600# x 4 1/2" LG, A-193 Gr. B7, w/ 2 HVY HEX NUTS, A-194 Gr. 2H (ZINC PLATED) (4 1/2" LG)                         | 2         |

**WELD MAPPING**

| MARK | SIZE | TYPE | SCH |
|------|------|------|-----|
| 1    | 2"   | BW   | CC  |
| 2    | 2"   | BW   |     |
| 3    | 2"   | BW   |     |


**PIPE CUT LIST**

| MARK | SIZE | LENGTH | END 1 | END 2 |
|------|------|--------|-------|-------|
| 1    | 2"   | 2 1/8" | BEVEL | BEVEL |
| 2    | 2"   |        |       |       |
| 3    | 2"   |        |       |       |


|                |            |                |           |    |                        |         |     |     |  |
|----------------|------------|----------------|-----------|----|------------------------|---------|-----|-----|--|
| DESIGN PRESS.  | 1100 Psig  | FAB. LOCATION  | SHOP      |    |                        |         |     |     |  |
| DESIGN TEMP.   | 150 °F     | SPOOL LOCATION | SKID #2   |    |                        |         |     |     |  |
| OPER. PRESS.   | 863 Psig   |                |           |    |                        |         |     |     |  |
| OPER. TEMP.    | -28 °F     | CORR. ALLOW.   | 0.0625"   |    |                        |         |     |     |  |
| STRESS RELIEVE | NO         | INSULATION     | 1.5°C     | 0  | ISSUE FOR CONSTRUCTION | 1-11-18 | COB | WD  |  |
| RADIOGRAPHY    | 15% NORMAL | PAINT          | SYSTEM #3 | NO | REVISION               | DATE    | BY  | APR |  |

**CONFIDENTIAL STATEMENT**  
 THIS DRAWING IS THE PROPERTY OF THE THOMAS RUSSELL CO. AND IS NOT TO BE USED FOR ANY PURPOSE OTHER THAN THAT FOR WHICH IT IS SPECIFICALLY FURNISHED.

**FABRICATION NOTES:**  
 ALL VALVES ARE RAISED FACE UNLESS NOTED  
 ALL FITTING MAKE-UP & CUT LENGTHS FOR THE PIPE DO NOT INCLUDE WELD CAPS  
 SHOP TO MAKE ADJUSTMENTS FOR WELD CAPS  
 ALL PIPE SEAMLESS UNLESS NOTED OTHERWISE  
 ALL COUPLING TO BE SCHEDULED ON.

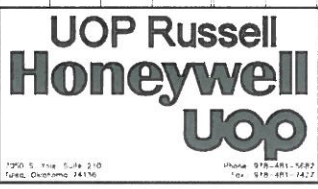

|                  |                    |
|------------------|--------------------|
| DRW. No.         | 172-D1-LT-2" 1.5°C |
| ASSEMBLY DRAWING | SC6R-402           |
| DATE DRAWING     | ***-2-14           |
| DESIGNED BY      | COB                |
| CHECKED BY       | 1/10/18            |
| DRW. No.         | 488                |
| SPOOL ID No.     | SK2-125            |
| REV              | 0                  |

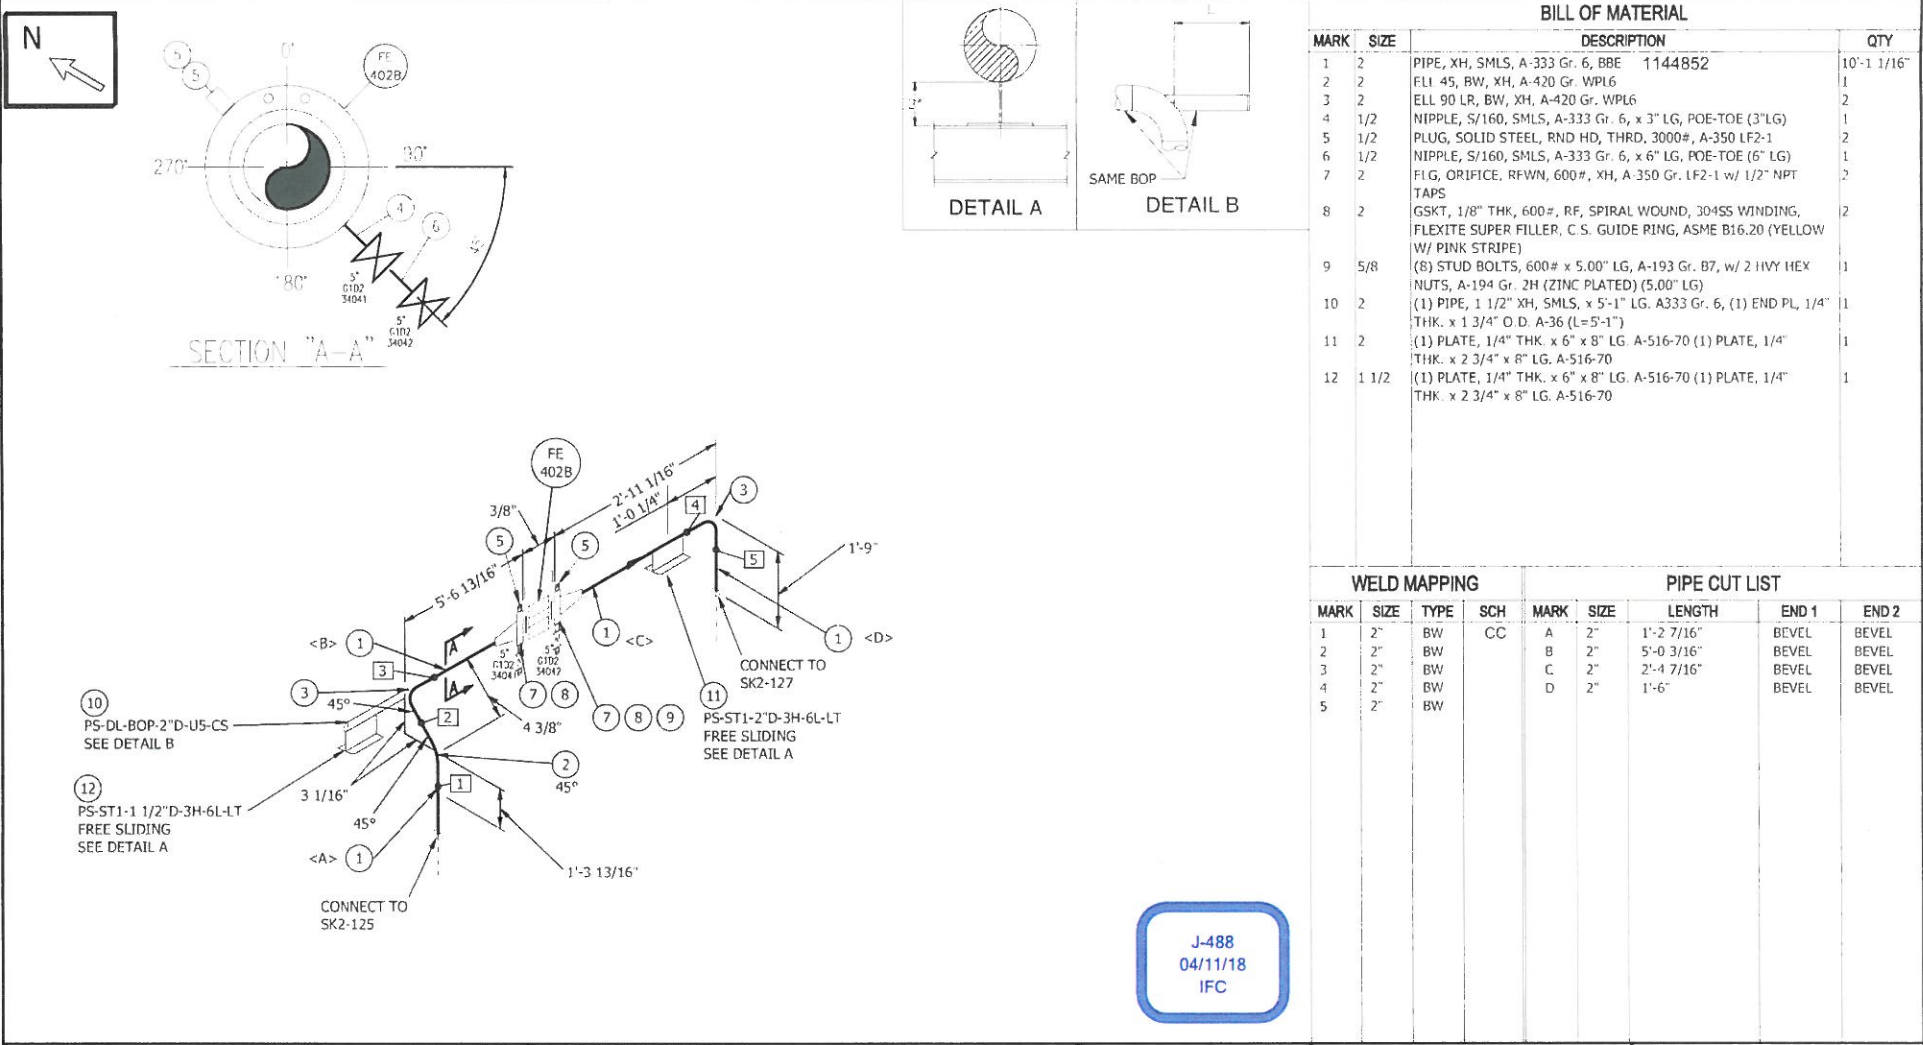

J-488  
04/11/18  
IFC

|                |            |                |           |     |          |      |    |     |  |
|----------------|------------|----------------|-----------|-----|----------|------|----|-----|--|
| DESIGN PRESS.  | 1100 Psig  | FAB. LOCATION  | SHOP      |     |          |      |    |     |  |
| DESIGN TLMP    | 150 °F     | SPOOL LOCATION | SKD #2    |     |          |      |    |     |  |
| OPER. PRESS.   | 865 Psig   |                |           |     |          |      |    |     |  |
| OPER. TEMP     | -28 °F     | CORR. ALLOW.   | 0.0625"   |     |          |      |    |     |  |
| STRESS RELIEVE | NO         | INSULATION     | 1.5" C    |     |          |      |    |     |  |
| RADIOGRAPHY    | 15% NORMAL | PAINT          | SYSTEM #3 | NO. | REVISION | DATE | BY | APR |  |

**CONFIDENTIAL STATEMENT**  
THIS DRAWING IS THE PROPERTY OF THE THOMAS RUSSELL Co. AND IS NOT TO BE USED FOR ANY PURPOSE OTHER THAN THAT FOR WHICH IT IS SPECIFICALLY FURNISHED.




**FABRICATION NOTES:**  
ALL VALVES ARE RASIED FACE UNLESS NOTED  
ALL FITTING MAKE-UP IS CUT LENGTHS FOR THE PIPE DO NOT INCLUDE WELD CAPS  
SHOP TO MAKE ADJUSTMENTS FOR WELD CAPS  
ALL PIPE SEAMLESS UNLESS NOTED OTHERWISE  
ALL EQUIPMENT TO BE SADDLED ON.

**UOP Russell Honeywell Uop**

7200 S. 70th, Suite 210  
Irwin, Oklahoma 74136

Phone: 918-481-5692  
Fax: 918-481-2422

|                  |                     |
|------------------|---------------------|
| LINE No          | 172-D1-1T-2" 1.5" C |
| ASSEMBLY DRAWING | SC6R-402            |
| PART DRAWING     | ***-2.54            |
| DRAWN BY         | COR                 |
| DATE DRAWN       | 1/10/18             |
| SCALE            | AS SHOWN            |
| REV              | 0                   |

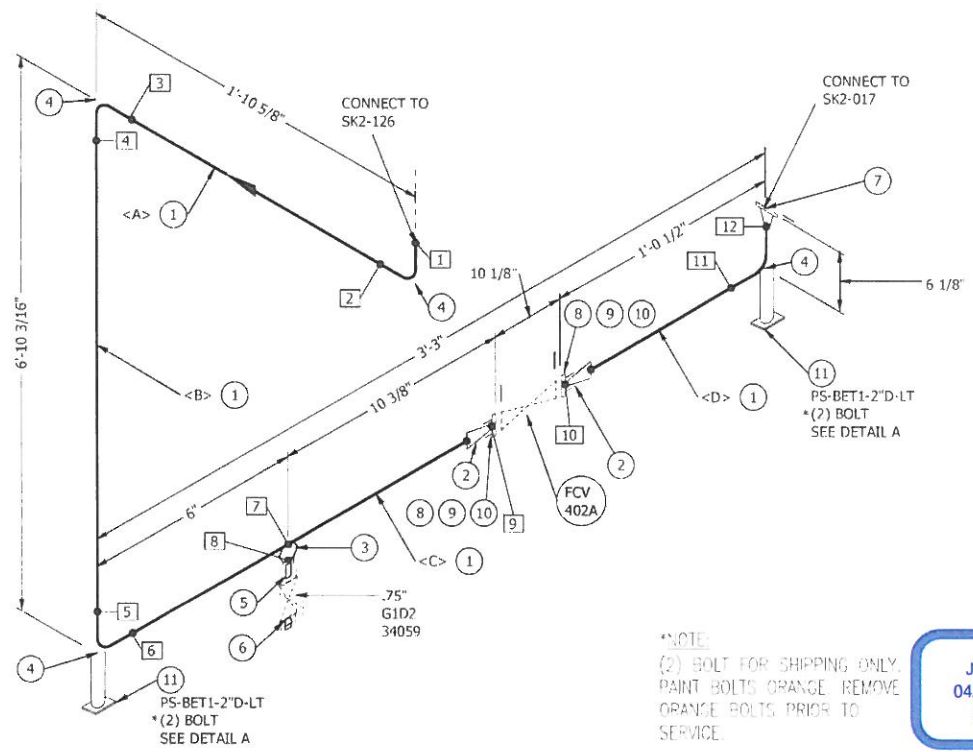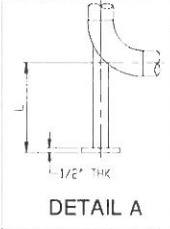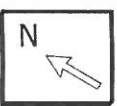

\*NOTE:  
 (2) BOLT FOR SHIPPING ONLY.  
 PAINT BOLTS ORANGE REMOVE  
 ORANGE BOLTS PRIOR TO  
 SERVICE.

J-488  
 04/11/18  
 IFC

**BILL OF MATERIAL**

| MARK | SIZE    | DESCRIPTION   | QTY         |
|------|---------|---|-------------|
| 1    | 2       | PIPE, XH, SMLS, A-333 Gr. 6, BBE 1144852  | 8'-4 15/16" |
| 2    | 2X1 1/2 | SWAGE CONC. XH - S/160, A-420 Gr. WPL6 BLE-PSE  | 2           |
| 3    | 2X3/4   | S-O-L, SW, 3000#, A-350 Gr. LF2-1   | 1           |
| 4    | 2       | ELL 90 LR, BW, XH, A-420 Gr. WPL6   | 4           |
| 5    | 3/4     | NIPPLE, S/160, SMLS, A-333 Gr. 6, x 3" LG, POE-TOE (3" LG)  | 1           |
| 6    | 3/4     | PLUG, SOLID STEEL, RND HD, THRD, 3000#, A-350 Gr. LF2-1   | 1           |
| 7    | 2       | FLG, RFSW, 600#, XH, A-350 Gr. LF2-1  | 1           |
| 8    | 1 1/2   | FLG, RFSW, 600#, S/160, A-350 Gr. LF2-1   | 2           |
| 9    | 1 1/2   | GSKT, 1/8" THK, 600#, RF, SPIRAL WOUND, 304SS WINDING, FLEXITE SUPER FILLER, C.S. GUIDE RING, ASME B16.20 (YELLOW W/ PINK STRIPE) | 2           |
| 10   | 3/4     | (4) STUD BOLTS, 600# x 4 1/2" LG, A-193 Gr. B7, w/ 2 HVY HEX NUTS, A-194 Gr. 2H (ZINC PLATED) (4 1/2" LG)                         | 2           |
| 11   | 2       | (1) PIPE, 1 1/2" XH SMLS x 1'-8 1/2" LG A-333 Gr. 6 (1) BASE PLATE, 1/2" THK. x 5" x 5" A-36 (L=1'-6")                            | 2           |

**WELD MAPPING**

| MARK | SIZE   | TYPE | SCH |
|------|--------|------|-----|
| 1    | 2"     | BW   | CM  |
| 2    | 2"     | BW   |     |
| 3    | 2"     | BW   |     |
| 4    | 2"     | BW   |     |
| 5    | 2"     | BW   |     |
| 6    | 2"     | BW   |     |
| 7    | 3/4"   | LET  |     |
| 8    | 3/4"   | SW   |     |
| 9    | 1 1/2" | SW   |     |
| 10   | 1 1/2" | SW   |     |
| 11   | 2"     | BW   |     |
| 12   | 2"     | BW   |     |


**PIPE CUT LIST**

| MARK | SIZE | LENGTH     | END 1 | END 2 |
|------|------|------------|-------|-------|
| 1    | 2"   | 1' 4 5/8"  | BEVEL | BEVEL |
| 2    | 2"   | 6'-4 3/16" | BEVEL | BEVEL |
| 3    | 2"   | 6"         | BEVEL | BEVEL |
| 4    | 2"   | 2 1/8"     | BEVEL | BEVEL |



|                |            |                |           |
|----------------|------------|----------------|-----------|
| DESIGN PRESS.  | 1100 Psig  | FAB. LOCATION  | SHOP      |
| DESIGN TEMP.   | 150°F      | SPOOL LOCATION | SKID #2   |
| OPER. PRESS.   | 863 Psig   |                |           |
| OPER. TEMP.    | -28°F      | CORR ALLOW.    | 0.0625"   |
| STRESS RELIEVE | NO         | INSULATION     | 1.5"C     |
| RADIOGRAPHY    | 15% NORMAL | PAINT          | SYSTEM #3 |

**CONFIDENTIAL STATEMENT**  
 THIS DRAWING IS THE PROPERTY OF THE THOMAS RUSSELL Co AND IS NOT TO BE USED FOR ANY PURPOSE OTHER THAN THAT FOR WHICH IT IS SPECIFICALLY FURNISHED.


**FABRICATION NOTES:**  
 ALL VALVES ARE RASSED FACE UNLESS NOTED  
 ALL FITTING MAKE UP & CUT LENGTHS FOR BW PIPE DO NOT INCLUDE WELD GAPS  
 SHOP TO MAKE ADJUSTMENTS FOR WELD GAPS  
 ALL PIPE SEAMLESS UNLESS NOTED OTHERWISE  
 ALL COUPLING TO BE SADDLED ON

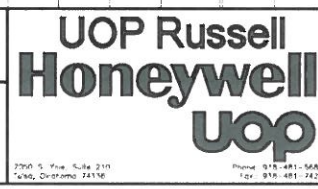

|                  |                    |
|------------------|--------------------|
| DRW No           | 172-D1-ET-2" 1.5"C |
| ASSEMBLY DRAWING | SC6R-402           |
| PIPED DRAWING    | ***-234            |
| DESIGN BY        | COB                |
| DATE DRAWN       | 1/10/18            |
| JOB No           | 488                |
| SPOOL ID No      | 542-127            |
| REV              | 0                  |

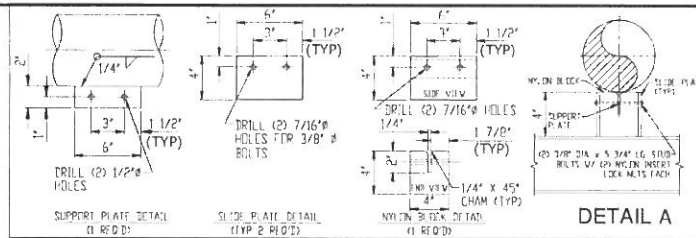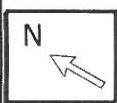

| BILL OF MATERIAL |      |  |            |
|------------------|------|--|------------|
| MARK             | SIZE | DESCRIPTION  | QTY        |
| 1                | 6    | PIPE, S/40S, SMLS OR WLD, A-312 Gr. TP-304/304L, BBE   | 2'-1 7/16" |
| 2                | 3    | PIPE, S/10S, SMLS, A-312 Gr. TP-304/304L, BBE  | 1'-7 1/4"  |
| 3                | 6X3  | TEE RED, BW, S/40S - S/10S, A-403 Gr. WP-304/304L  | 1          |
| 4                | 6    | ELL 90 LR, BW, S/40S, A-403 Gr. WP-304/304L  | 1          |
| 5                | 6    | ELL 45, BW, S/40S, A-403 Gr. WP-304/304L   | 1          |
| 6                | 6    | FLG, RFWN, 300#, S/40S, A-182 Gr. F304/304L  | 1          |
| 7                | 6    | FLG, RFWN, 600#, S/40S, A-182 Gr. F304/304L  | 1          |
| 8                | 3    | FLG, RFWN, 600#, S/10S, A-182 Gr. F304/304L  | 1          |
| 9                | 6    | (1) SUPT PL, 1/4" THK. x 2" x 6" LG. A-240-304SS (2) SLIDE PL, 1/4" THK. x 4" x 6" LG. A-240-304SS (1) NYLON BLK, 4" x 4" x 6" LG. | 1          |

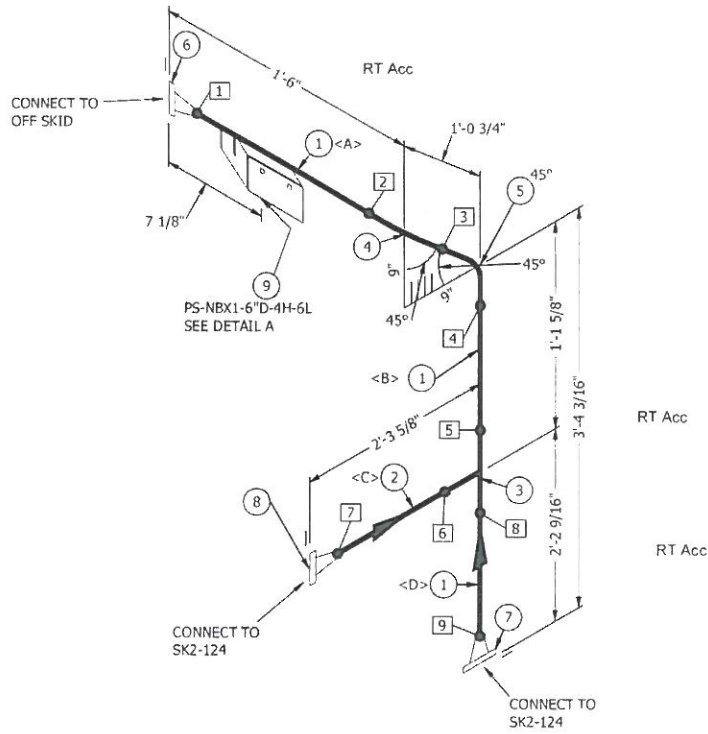

| WELD MAPPING |      |      |     | PIPE CUT LIST |      |            |       |       |
|--------------|------|------|-----|---------------|------|------------|-------|-------|
| MARK         | SIZE | TYPE | SCH | MARK          | SIZE | LENGTH     | END 1 | END 2 |
| 1            | 6"   | BW   | A   | A             | 6"   | 5 1/8"     | BEVEL | BEVEL |
| 2            | 6"   | BW   |     | B             | 6"   | 4 1/4"     | BEVEL | BEVEL |
| 3            | 6"   | BW   |     | C             | 3"   | 1'-7 1/4"  | BEVEL | BEVEL |
| 4            | 6"   | BW   |     | D             | 6"   | 1'-4 1/16" | BEVEL | BEVEL |
| 5            | 6"   | BW   |     |               |      |            |       |       |
| 6            | 3"   | BW   |     |               |      |            |       |       |
| 7            | 3"   | BW   |     |               |      |            |       |       |
| 8            | 6"   | BW   |     |               |      |            |       |       |
| 9            | 6"   | BW   |     |               |      |            |       |       |

**J-488**  
 04/11/18  
 IFC


|                |            |                |         |
|----------------|------------|----------------|---------|
| DESIGN PRESS.  | 400 Psig   | FAB. LOCATION  | SHOP    |
| DESIGN TEMP.   | 150 °F     | SPOOL LOCATION | SKID #2 |
| OPER. PRESS.   | 225 Psig   |                |         |
| OPER. TEMP.    | -81 °F     | CORR. ALLOW.   | NONE    |
| STRESS RELIEVE | NO         | INSULATION     | 2" C    |
| RADIOGRAPHY    | 15% NORMAL | PAIN           | NONE    |

**CONFIDENTIAL STATEMENT**  
 THIS DRAWING IS THE PROPERTY OF THE THOMAS RUSSELL CO. AND IS NOT TO BE USED FOR ANY PURPOSE OTHER THAN THAT FOR WHICH IT IS SPECIFICALLY TURNED OVER.

**FABRICATION NOTES:**  
 ALL VALVES ARE RASGD FACE UNLESS NOTED  
 ALL FITTING MAKE-UP & CUT LENGTHS FOR BW PIPE DO NOT INCLUDE WELD GAPS  
 SHOP TO MAKE ADJUSTMENTS FOR WELD GAPS  
 ALL PIPE STAINLESS UNLESS NOTED OTHERWISE  
 ALL EQUIPMENT TO BE SANDED ON

UOP Russell  
Honeywell  
UOP

|                  |                      |
|------------------|----------------------|
| Part No          | 171-B0-304SS-6" 2" C |
| Assembly Drawing | SC6R-402             |
| Part Drawing     | *** 232/234          |
| Drawn By         | CW                   |
| Date             | 01/10/18             |
| Job No           | 488                  |
| Spec ID No       | SK2-128              |

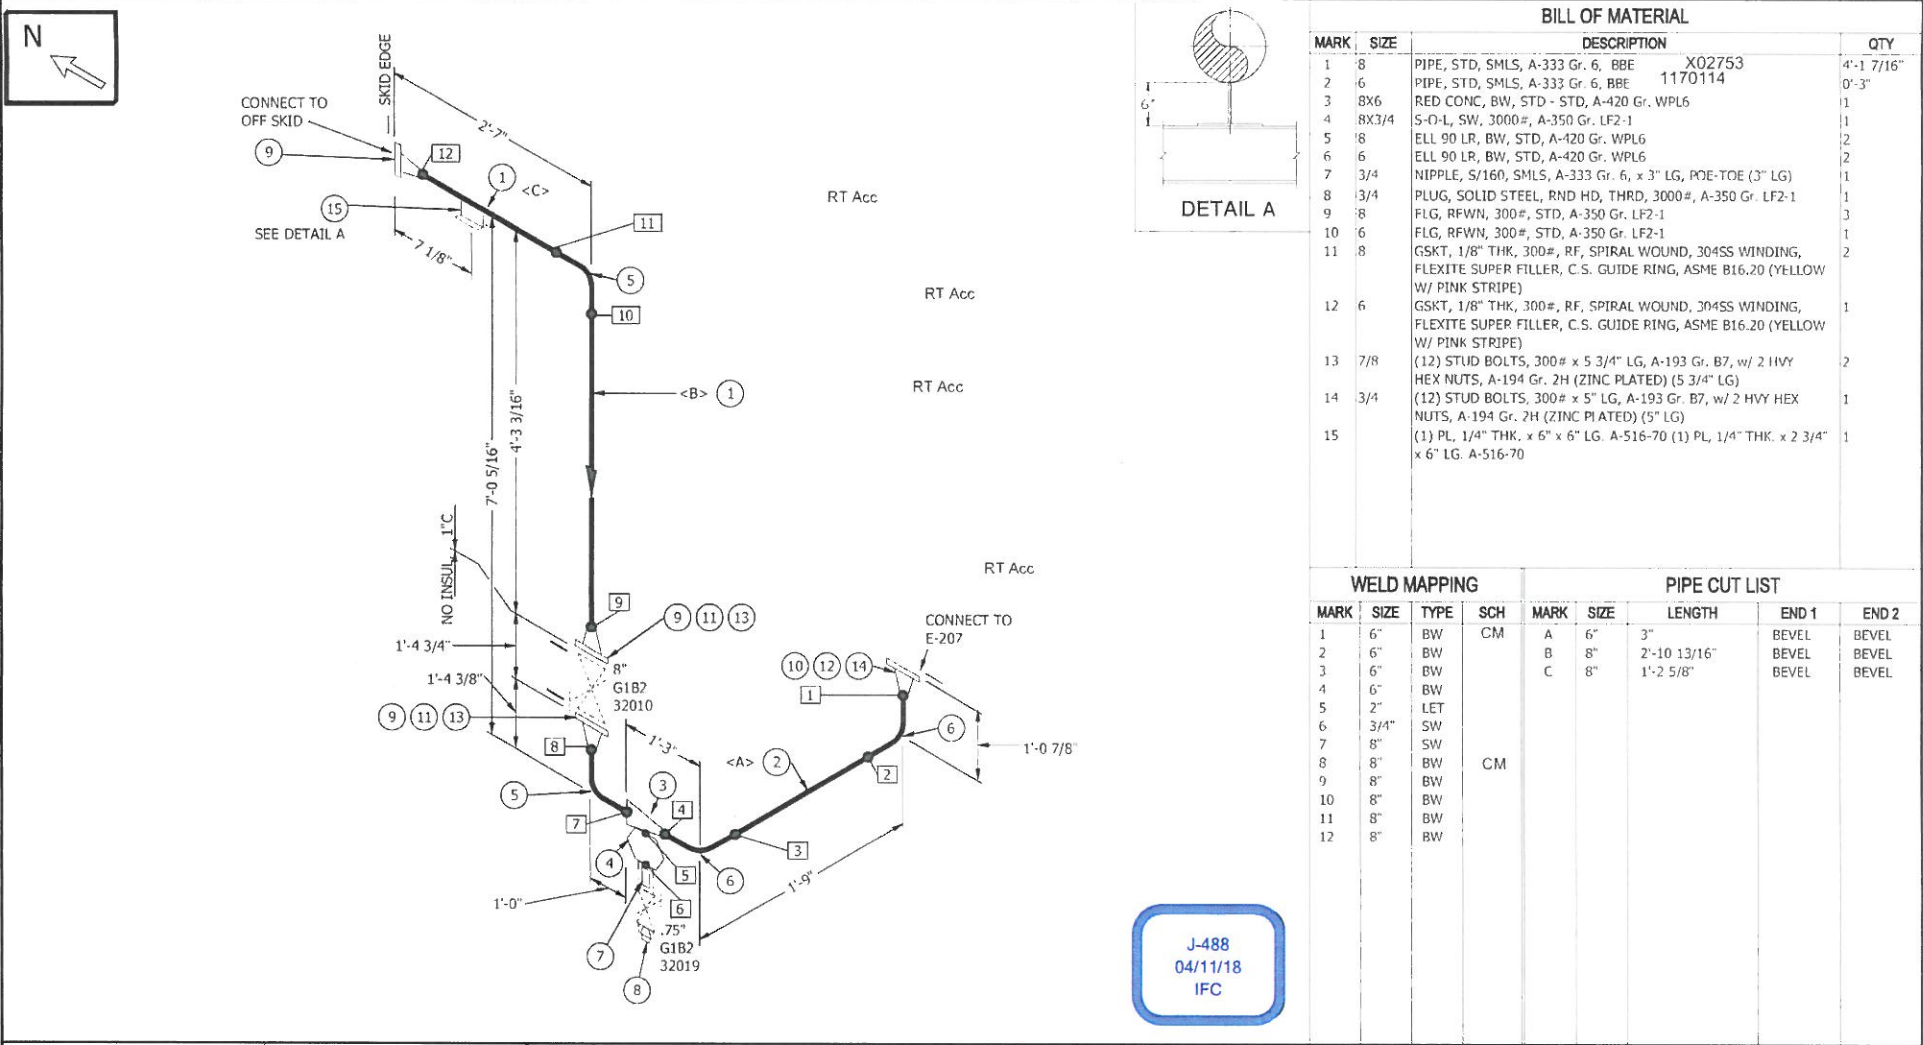

**BILL OF MATERIAL**

| MARK | SIZE  | DESCRIPTION   | QTY        |
|------|-------|---|------------|
| 1    | 8     | PIPE, STD, SMLS, A-333 Gr. 6, BBE X02753  | 4'-1 7/16" |
| 2    | 6     | PIPE, STD, SMLS, A-333 Gr. 6, BBE 1170114   | 0'-3"      |
| 3    | 8X6   | RED CONC, BW, STD - STD, A-420 Gr. WPL6   | 1          |
| 4    | 8X3/4 | S-O-L, SW, 3000#, A-350 Gr. LF2-1   | 1          |
| 5    | 8     | ELL 90 LR, BW, STD, A-420 Gr. WPL6  | 2          |
| 6    | 6     | ELL 90 LR, BW, STD, A-420 Gr. WPL6  | 2          |
| 7    | 3/4   | NIPPLE, S/160, SMLS, A-333 Gr. 6, x 3" LG, POE-TOE (3" LG)  | 1          |
| 8    | 3/4   | PLUG, SOLID STEEL, RND HD, THRD, 3000#, A-350 Gr. LF2-1   | 1          |
| 9    | 8     | FLG, RFWN, 300#, STD, A-350 Gr. LF2-1   | 3          |
| 10   | 6     | FLG, RFWN, 300#, STD, A-350 Gr. LF2-1   | 1          |
| 11   | 8     | GSKT, 1/8" THK, 300#, RF, SPIRAL WOUND, 304SS WINDING, FLEXITE SUPER FILLER, C.S. GUIDE RING, ASME B16.20 (YELLOW W/ PINK STRIPE) | 2          |
| 12   | 6     | GSKT, 1/8" THK, 300#, RF, SPIRAL WOUND, 304SS WINDING, FLEXITE SUPER FILLER, C.S. GUIDE RING, ASME B16.20 (YELLOW W/ PINK STRIPE) | 1          |
| 13   | 7/8   | (12) STUD BOLTS, 300# x 5 3/4" LG, A-193 Gr. B7, w/ 2 HVY HEX NUTS, A-194 Gr. 2H (ZINC PLATED) (5 3/4" LG)                        | 2          |
| 14   | 3/4   | (12) STUD BOLTS, 300# x 5" LG, A-193 Gr. B7, w/ 2 HVY HEX NUTS, A-194 Gr. 2H (ZINC PLATED) (5" LG)                                | 1          |
| 15   |       | (1) PL, 1/4" THK, x 6" x 6" LG. A-516-70 (1) PL, 1/4" THK, x 2 3/4" x 6" LG. A-516-70   | 1          |

**WELD MAPPING**

| MARK | SIZE | TYPE | SCH |
|------|------|------|-----|
| 1    | 6"   | BW   | CM  |
| 2    | 6"   | BW   |     |
| 3    | 6"   | BW   |     |
| 4    | 6"   | BW   |     |
| 5    | 2"   | LET  |     |
| 6    | 3/4" | SW   |     |
| 7    | 8"   | SW   |     |
| 8    | 8"   | BW   | CM  |
| 9    | 8"   | BW   |     |
| 10   | 8"   | BW   |     |
| 11   | 8"   | BW   |     |
| 12   | 8"   | BW   |     |

**PIPE CUT LIST**

| MARK | SIZE | LENGTH       | END 1 | END 2 |
|------|------|--------------|-------|-------|
| 1    | 6"   | 3"           | BEVEL | BEVEL |
| 2    | 6"   | 2'-10 13/16" | BEVEL | BEVEL |
| 3    | 6"   | 1'-2 5/8"    | BEVEL | BEVEL |

J-488  
04/11/18  
IFC



|                |            |                |           |     |                        |         |     |     |  |
|----------------|------------|----------------|-----------|-----|------------------------|---------|-----|-----|--|
| DESIGN PRESS.  | 400 Psig   | FAB LOCATION   | SHOP      |     |                        |         |     |     |  |
| DESIGN TEMP.   | 200 °F     | SPOOL LOCATION | SKID #2   |     |                        |         |     |     |  |
| OPER PRESS.    | 253 Psig   |                |           |     |                        |         |     |     |  |
| OPER. TEMP.    | 120 °F     | CORR. ALLOW.   | 0.0625"   |     |                        |         |     |     |  |
| STRESS RELIEVE | NO         | INSULATION     | NOTED     | 0   | ISSUE FOR CONSTRUCTION | 1/10/18 | COB | WD  |  |
| RADIOGRAPHY    | 15% NORMAL | PAINT          | SYSTEM #3 | NO. | REVISION               | DATE    | BY  | APR |  |

**CONFIDENTIAL STATEMENT**  
THIS DRAWING IS THE PROPERTY OF THE THOMAS RUSSELL CO. AND IS NOT TO BE USED FOR ANY PURPOSE OTHER THAN THAT FOR WHICH IT IS SPECIFICALLY FURNISHED.

**FABRICATION NOTES:**  
ALL VALVES ARE RATED FACE UNLESS NOTED  
ALL FITTING MAKE UP & CUT LENGTHS FOR PIPE DO NOT INCLUDE WELD GAPS  
SHOP TO MAKE ADJUSTMENTS FOR WELD GAPS  
ALL PIPE SEAMLESS UNLESS NOTED OTHERWISE  
ALL CRUISING TO BE SANDBLASTED ON

**UOP Russell Honeywell**  
Uop

|                  |              |
|------------------|--------------|
| LINE No          | 205-B1-11-8" |
| ASSEMBLY DRAWING | SCR#-402     |
| PART DRAWING     | ***-232      |
| DRAWN BY         | COB          |
| CHECKED BY       | WD           |
| DATE             | 1/10/18      |
| DATE             | 4/8          |
| SKID TO No       | 202-129      |
| REV              | 0            |

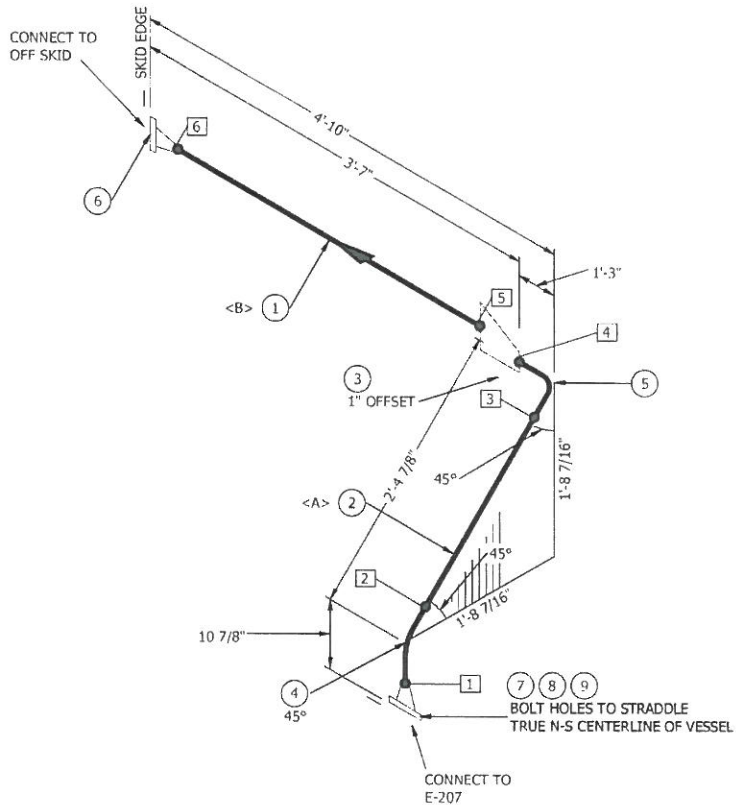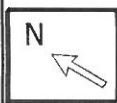

**J-488**  
 04/11/18  
 IFC

| BILL OF MATERIAL |       |   |         |           |
|------------------|-------|---|---------|-----------|
| MARK             | SIZE  | DESCRIPTION   | QTY     |           |
| 1                | 12    | PIPE, STD, SMLS, A-333 Gr. 6, BBE   | 1133589 | 2'-5 7/8" |
| 2                | 10    | PIPE, STD, SMLS, A-333 Gr. 6, BBE   | 78376K  | 0'-7 5/8" |
| 3                | 12X10 | RED ECC, BW, STD - STD, A-420 Gr. WPL6  |         | 1         |
| 4                | 10    | ELL 45, BW, STD, A-420 Gr. WPL6   |         | 1         |
| 5                | 10    | ELL 90 LR, BW, STD, A-420 Gr. WPL6  |         | 1         |
| 6                | 12    | FLG, RFWN, 300#, STD, A-350 Gr. LF2-1   |         | 1         |
| 7                | 10    | FLG, RFWN, 300#, STD, A-350 Gr. LF2-1   |         | 1         |
| 8                | 10    | GSKT, 1/8" THK, 300#, RF, SPIRAL WOUND, 304SS WINDING, FLEXITE SUPER FILLER, C.S. GUIDE RING, ASME B16.20 (YELLOW W/ PINK STRIPE) |         | 1         |
| 9                | 1     | (16) STUD BOLTS, 300# x 6 1/2" LG, A-193 Gr. B7, w/ 2 HWY HEX NUTS, A-194 Gr. 2H (ZINC PLATED) (6.50000000 LG)                    |         | 1         |

| WELD MAPPING |      |      |     | PIPE CUT LIST |      |           |       |       |
|--------------|------|------|-----|---------------|------|-----------|-------|-------|
| MARK         | SIZE | TYPE | SCH | MARK          | SIZE | LENGTH    | END 1 | END 2 |
| 1            | 10"  | BW   | CM  | A             | 10"  | 7 5/8"    | BEVEL | BEVEL |
| 2            | 10"  | BW   |     | B             | 12"  | 2'-5 7/8" | BEVEL | BEVEL |
| 3            | 10"  | BW   |     |               |      |           |       |       |
| 4            | 10"  | BW   |     |               |      |           |       |       |
| 5            | 12"  | BW   |     |               |      |           |       |       |
| 6            | 12"  | BW   |     |               |      |           |       |       |

|                |            |                |           |     |                        |         |     |     |  |
|----------------|------------|----------------|-----------|-----|------------------------|---------|-----|-----|--|
| DESIGN PRESS   | 400 Psig   | FAB. LOCATION  | SHOP      |     |                        |         |     |     |  |
| DESIGN TEMP    | 200 °F     | SPOOL LOCATION | SKID #2   |     |                        |         |     |     |  |
| OPER. PRESS    | 253 Psig   |                |           |     |                        |         |     |     |  |
| OPER. TEMP.    | 135 °F     | CORR. ALLOW.   | 0.0625"   |     |                        |         |     |     |  |
| STRESS RELIEVE | NO         | INSULATION     | NONE      | 0   | ISSUE FOR CONSTRUCTION | 1/12/18 | COB | WC  |  |
| RADIOGRAPHY    | 15% NORMAL | PAINT          | SYSTEM #3 | NO. | REVISION               | DATE    | BY  | APR |  |



**CONFIDENTIAL STATEMENT**  
 THIS DRAWING IS THE PROPERTY OF THE THOMAS RUSSELL CO. AND IS NOT TO BE USED FOR ANY PURPOSE OTHER THAN THAT FOR WHICH IT IS SPECIFICALLY FURNISHED.

**FABRICATION NOTES**  
 ALL VALVES ARE RAISED FACE UNLESS NOTED  
 ALL FITTING MAKE-UP & CUT LENGTHS FOR BW PIPE DO NOT INCLUDE WELD CAPS  
 SHOP TO MAKE ADJUSTMENTS FOR WELD CAPS  
 ALL PIPE SHAMLESS UNLESS NOTED OTHERWISE  
 ALL COUPLING TO BE SADDLED ON


**UOP Russell**  
**Honeywell**  
**UOP**

2250 N. 14th 14th 210  
 Tulsa, Oklahoma 74116  
 Phone: 918-481-4800  
 Fax: 918-481-2422

|                  |               |
|------------------|---------------|
| DRW. NO.         | 207-81-11-12" |
| ASSEMBLY DRAWING | SC6R-402      |
| PART DRAWING     | ***-232       |
| DATE DRAWN       | 1/10/18       |
| DATE CHECKED     |               |
| DATE APPROVED    |               |
| DRW. NO.         | 488           |
| SPRCK. ID. NO.   | 242-130       |
| REV.             | 0             |

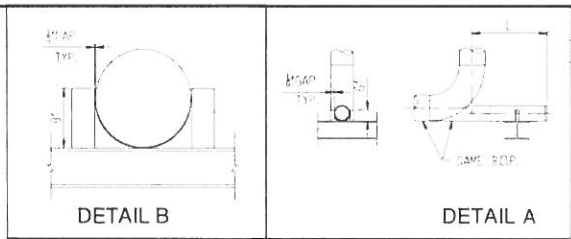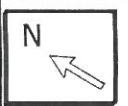

| BILL OF MATERIAL |        |   |            |
|------------------|--------|---|------------|
| MARK             | SIZE   | DESCRIPTION   | QTY        |
| 1                | 12     | PIPE, STD, SMLS, A-106 Gr. B, BBE 173201  | 28'-7 1/8" |
| 2                | 12X3/4 | S-O-L, SW, 3000#, A-105   | 1          |
| 3                | 12     | ELL 90 LR, BW, STD, A-234 Gr. WPB   | 2          |
| 4                | 3/4    | NIPPLE, XH, SMLS, A-106 Gr. B, x 3" LG, POE-TOE (3.00000000 LG)   | 1          |
| 5                | 3/4    | PLUG, SOLID STEEL, RND HD, THRD, 3000#, A-105   | 1          |
| 6                | 12     | FIG, RFWN, 300#, STD, A-105   | 2          |
| 7                | 12     | (1) PIPE, 8" STD, SMLS, x 3'-6" LG, A-106 Gr. B (1) END PL, 1/4" THK. x 8 1/2" O.D. A-36 (L=2'-0"), (2) L 2"x2"x1/4"x6" LG. | 1          |
| 8                | 12     | (1) PIPE, 8" STD, SMLS, x 6'-3" LG, A-106 Gr. B (1) END PL, 1/4" THK. x 8 1/2" O.D. A-36 (L=4'-9")                          | 1          |
| 9                |        | (2) L 3"x3"x1/4"x8" LG  | 1          |

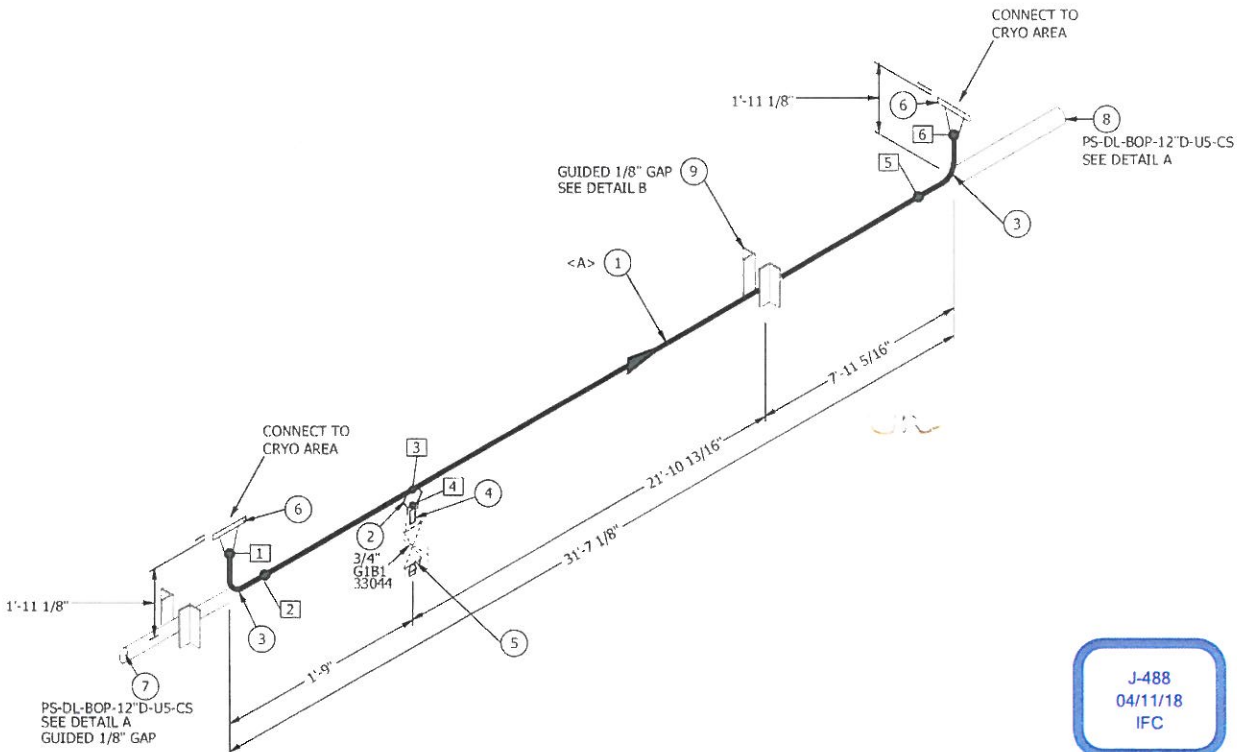

| WELD MAPPING |      |      |     | PIPE CUT LIST |      |            |       |       |
|--------------|------|------|-----|---------------|------|------------|-------|-------|
| MARK         | SIZE | TYPE | SCH | MARK          | SIZE | LENGTH     | END 1 | END 2 |
| 1            | 12"  | BW   | Q   | A             | 12"  | 28'-7 1/8" | BEVEL | BEVEL |
| 2            | 12"  | BW   |     |               |      |            |       |       |
| 3            | 3/4" | LET  |     |               |      |            |       |       |
| 4            | 3/4" | SW   |     |               |      |            |       |       |
| 5            | 12"  | BW   | Q   |               |      |            |       |       |
| 6            | 12"  | BW   | Q   |               |      |            |       |       |

**J-488**  
 04/11/18  
 IFC

|                |            |                |           |     |                        |          |    |     |  |
|----------------|------------|----------------|-----------|-----|------------------------|----------|----|-----|--|
| DESIGN PRESS.  | 400 Psig   | FAB. LOCATION  | SHOP      |     |                        |          |    |     |  |
| DESIGN TEMP.   | 150 °F     | SPOOL LOCATION | SKID #2   |     |                        |          |    |     |  |
| OPER. PRESS.   | 210 Psia   |                |           |     |                        |          |    |     |  |
| OPER. TEMP.    | 88 °F      | CORR. ALLOW.   | .0625"    |     |                        |          |    |     |  |
| STRESS RELIEVE | NO         | INSULATION     | NONE      | 0   | ISSUE FOR CONSTRUCTION | 01/10/18 | CW | WD  |  |
| RADIOGRAPHY    | 15% NORMAL | PAINT          | SYSTEM #3 | NO. | REVISION               | DATE     | BY | APR |  |



**CONFIDENTIAL STATEMENT**  
 THIS DRAWING IS THE PROPERTY OF THE THOMAS RUSSELL CO. AND IS NOT TO BE USED FOR ANY PURPOSE OTHER THAN THAT FOR WHICH IT IS SPECIFICALLY FURNISHED.

**FABRICATION NOTES:**  
 ALL VALVES ARE RASGID FACE UNLESS NOTED  
 ALL FITTINGS MAKE UP & COP LENGTHS FOR END PIPE DO NOT INCLUDE WELD GAPS  
 SHOP TO MAKE ADJUSTMENTS FOR WELD GAPS  
 ALL PIPE SEAMLESS UNLESS NOTED OTHERWISE  
 ALL COUPLING TO BE SADDLED ON


UOP Russell  
Honeywell  
Uop

2000 N. 17th, Suite 210  
Lombard, Illinois 60148  
Phone 815-481-5683  
Fax 815-481-7422

|                  |               |
|------------------|---------------|
| LINE No.         | 178-B1-CS-12" |
| ASSEMBLY DRAWING | SC6R-402      |
| PART DRAWING     | ***-2331      |
| ISSUED BY        | CW            |
| DATE DRAWN       | 01/10/18      |
| JOB No.          | 488           |
| SPOOL TO NO.     | SK2-131       |
| REV              | 0             |

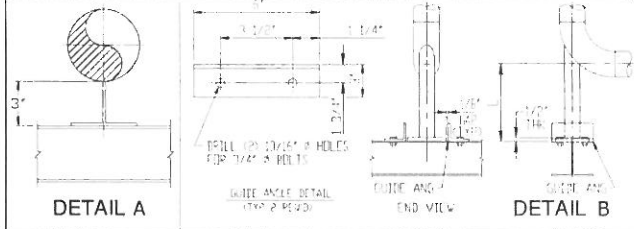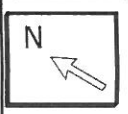

| BILL OF MATERIAL |      |   |             |
|------------------|------|---|-------------|
| MARK             | SIZE | DESCRIPTION   | QTY         |
| 1                | 6    | PIPE, XH, SMLS, A-106 Gr. B, BBE 4204171  | 28'-6 9/16" |
| 2                | 6X6  | TEE, BW, XH, A-234 Gr. WPB  | 1           |
| 3                | 6X3  | TEE RED, BW, XH - XH, A-234 Gr. WPB   | 1           |
| 4                | 6    | ELL 45, BW, XH, A-234 Gr. WPB   | 1           |
| 5                | 6    | ELL 90 LR, BW, XH, A-234 Gr. WPB  | 2           |
| 6                | 3/4  | CPLG, THRD X 1 1/2" LG., 3000#, A-105   | 1           |
| 7                | 6    | FIG, RTJWN, 900#, XH, A-105   | 3           |
| 8                |      | PIPE SHOE (TYPE 1) 3" HI. x 6" LG. FROM W6x15 A-992   | 1           |
| 9                |      | (1) PIPE, 3" STD, SMLS, x 2'-2 1/16" LG. A-106 Gr. B (1)<br>BASE PL, 1/2" THK x 6" x 6" A-36 (2) GUIDE ANG, 2" x 3" x 1/4" x 6" LG. A-36 (L=1'-5 9/16") | 1           |

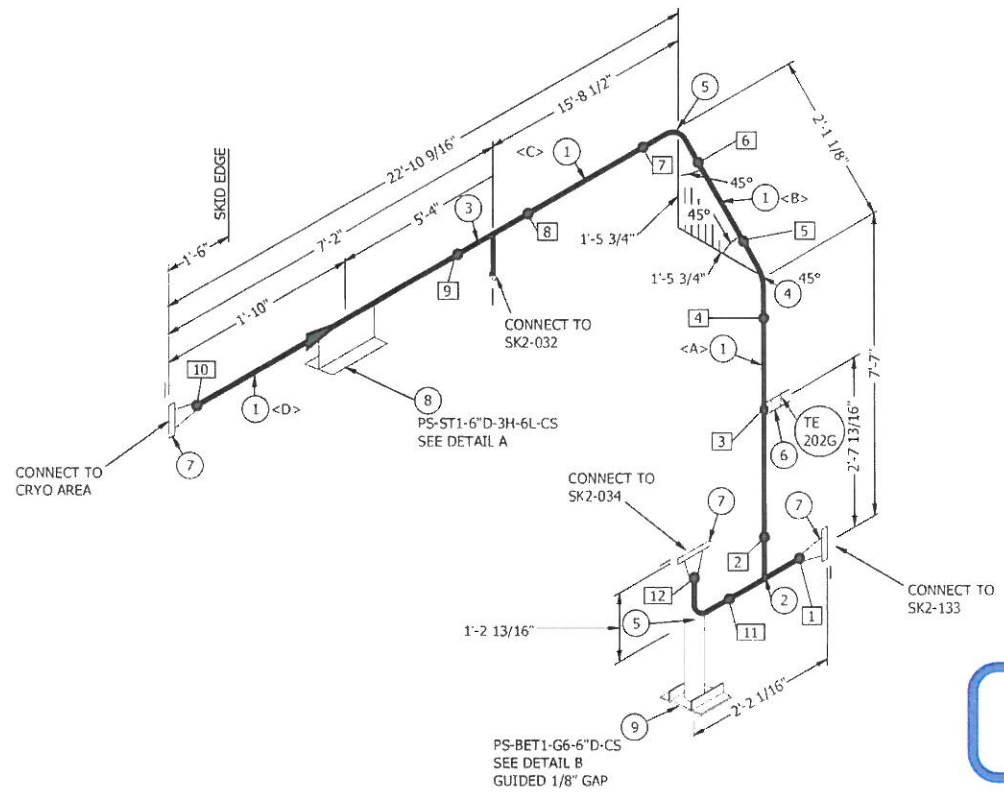


**J-488**  
**04/11/18**  
**IFC**

| WELD MAPPING |      |      |     | PIPE CUT LIST |      |             |       |       |
|--------------|------|------|-----|---------------|------|-------------|-------|-------|
| MARK         | SIZE | TYPE | SCH | MARK          | SIZE | LENGTH      | END 1 | END 2 |
| 1            | 6"   | BW   | JR  | A             | 6"   | 6'-9 11/16" | BEVEL | BEVEL |
| 2            | 6"   | BW   |     | B             | 6"   | 1'-0 3/8"   | BEVEL | BEVEL |
| 3            | 3/4" | LET  |     | C             | 6"   | 14'-5 7/8"  | BEVEL | BEVEL |
| 4            | 6"   | BW   |     | D             | 6"   | 6'-2 5/8"   | BEVEL | BEVEL |
| 5            | 6"   | BW   | CC  |               |      |             |       |       |
| 6            | 6"   | BW   |     |               |      |             |       |       |
| 7            | 6"   | BW   |     |               |      |             |       |       |
| 8            | 6"   | BW   |     |               |      |             |       |       |
| 9            | 6"   | BW   |     |               |      |             |       |       |
| 10           | 6"   | BW   |     |               |      |             |       |       |
| 11           | 6"   | BW   | JR  |               |      |             |       |       |
| 12           | 6"   | BW   | JR  |               |      |             |       |       |


|                |            |                |           |     |                        |          |    |     |  |
|----------------|------------|----------------|-----------|-----|------------------------|----------|----|-----|--|
| DESIGN PRESS.  | 1440 Psig  | FAB. LOCATION  | SHOP      |     |                        |          |    |     |  |
| DESIGN TEMP.   | 200 °F     | SPOOL LOCATION | SKID #2   |     |                        |          |    |     |  |
| OPER. PRESS.   | 1270 Psig  |                |           |     |                        |          |    |     |  |
| OPER. TEMP.    | 58 °F      | CORR. ALLOW.   | .0625"    |     |                        |          |    |     |  |
| STRESS RELIEVE | NO         | INSULATION     | 1" C      | 0   | ISSUE FOR CONSTRUCTION | 01/10/18 | CW | WC  |  |
| RADIOGRAPHY    | 15% NORMA. | PAINT          | SYSTEM #3 | NO. | REVISION               | DATE     | BY | APR |  |

**CONFIDENTIAL STATEMENT**  
 THIS DRAWING IS THE PROPERTY OF THE THOMAS RUSSELL CO. AND IS NOT TO BE USED FOR ANY PURPOSE OTHER THAN THAT FOR WHICH IT IS SPECIFICALLY FURNISHED.

**FABRICATION NOTES:**  
 ALL VALVES ARE RISED FACE UNLESS NOTED  
 ALL FITTING MAKE-UP & CUT LENGTHS FOR PIPE DO NOT INCLUDE WELD GAPS  
 SHOP TO MAKE ADJUSTMENTS FOR WELD GAPS  
 ALL PIPE SEAMLESS UNLESS NOTED OTHERWISE  
 ALL CONNECTIONS TO BE SADDLED ON

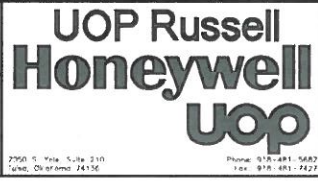

|                  |                   |
|------------------|-------------------|
| FIG. No.         | 215-E1-CS-6" 1" C |
| ASSEMBLY DRAWING | SC6R-402          |
| FIELD DRAWING    | ***-231/236       |
| DESIGNED BY      | CW                |
| DATE DRAWN       | 01/10/18          |
| JOB No.          | 488               |
| ISSUED TO No.    | 542-132           |
| REV.             | 0                 |

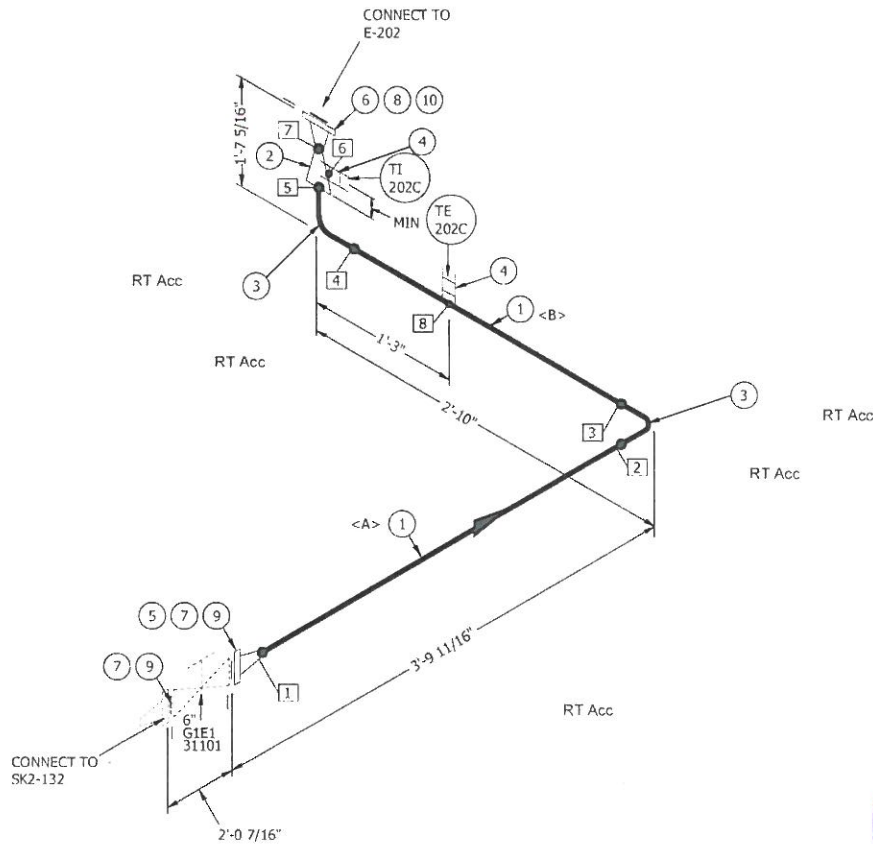

**J-488**  
 04/11/18  
 IFC

**BILL OF MATERIAL**

| MARK | SIZE  | DESCRIPTION  | QTY        |
|------|-------|--|------------|
| 1    | 6     | PIPE, XH, SMLS, A-106 Gr. B, BBE 4204171   | 3'-10 7/8" |
| 2    | 6X4   | RED CONC, BW, XH - XH, A-234 Gr. WPB   | 1          |
| 3    | 6     | ELL 90 LR, BW, XH, A-234 Gr. WPB   | 2          |
| 4    | 3/4   | CPLG, THRD X 1 1/2" LG., 3000#, A-105  | 2          |
| 5    | 6     | FLG, RTJWN, 900#, XH, A-105  | 1          |
| 6    | 4     | FLG, RTJWN, 900#, XH, A-105  | 1          |
| 7    | 6     | GSKT, 900# RTJ, SOFT IRON, OVAL RING R37, BRINELL HARDNESS 90 R45                          | 2          |
| 8    | 4     | GSKT, 900# RTJ, SOFT IRON, OVAL RING R37, BRINELL HARDNESS 90 R37                          | 1          |
| 9    | 1 1/8 | (12) STUD BOLTS, 900# x 8" LG, A-193 Gr. B7, w/ 2 HVY HEX NUTS, A-194 Gr. 2H (ZINC PLATED) | 2          |
| 10   | 1 1/8 | (8) STUD BOLTS, 900# x 7" LG, A-193 Gr. B7, w/ 2 HVY HEX NUTS, A-194 Gr. 2H (ZINC PLATED)  | 1          |

**WELD MAPPING**

| MARK | SIZE | TYPE | SCH |
|------|------|------|-----|
| 1    | 6"   | BW   | CM  |
| 2    | 6"   | BW   |     |
| 3    | 6"   | BW   |     |
| 4    | 6"   | BW   |     |
| 5    | 6"   | BW   |     |
| 6    | 3/4" | LET  |     |
| 7    | 4"   | BW   |     |
| 8    | 3/4" | LET  |     |

**PIPE CUT LIST**

| MARK | SIZE | LENGTH    | END 1 | END 2 |
|------|------|-----------|-------|-------|
| 1    | 6"   | 2'-6 7/8" | BEVEL | BEVEL |
| 2    | 6"   | 1'-4"     | BEVEL | BEVEL |


|                |            |                |           |     |                        |          |     |     |  |
|----------------|------------|----------------|-----------|-----|------------------------|----------|-----|-----|--|
| DESIGN PRESS.  | 1440 Psig  | FAB LOCATION   | SHOP      |     |                        |          |     |     |  |
| DESIGN TEMP.   | 200 °F     | SPOOL LOCATION | SKID #2   |     |                        |          |     |     |  |
| OPER. PRESS.   | 1270 Psig  |                |           |     |                        |          |     |     |  |
| OPER. TEMP.    | 58 °F      | CORR. ALLOW.   | .0625"    |     |                        |          |     |     |  |
| STRESS RELIEVE | NO         | INSULATION     | 1" C      | 0   | ISSUE FOR CONSTRUCTION | 04/22/18 | COB | WC  |  |
| RADIOGRAPHY    | 15% NORMAL | PAINT          | SYSTEM #3 | NO. | REVISION               | DATE     | BY  | APR |  |

**CONFIDENTIAL STATEMENT**  
 THIS DRAWING IS THE PROPERTY OF THE THOMAS RUSSELL CO. AND IS NOT TO BE USED FOR ANY PURPOSE OTHER THAN THAT FOR WHICH IT IS SPECIFICALLY FURNISHED.

**FABRICATION NOTES:**  
 ALL WELDS ARE RAISED FACE UNLESS NOTED.  
 ALL FITTING MAKE-UP & CUT LENGTHS FOR END PIPE DO NOT INCLUDE WELD CAPS.  
 SHOP IS MAKE ADJUSTMENTS FOR WELD CAPS.  
 ALL PIPE SEAMLESS UNLESS NOTED OTHERWISE.  
 ALL EQUIPMENT TO BE SUPPLIED ON.

UOP Russell  
Honeywell  
Uop

|                  |                   |
|------------------|-------------------|
| LINE No          | 215-E1-CS-6" 1" C |
| ASSEMBLY DRAWING | SC6R-402          |
| FIELD DRAWING    | ***-231/236       |
| DRAWN BY         | COB               |
| CHECKED BY       | 4/2/18            |
| JOB No           | 488               |
| SPOOL ID No      | SK2-133           |
| REV              | 0                 |

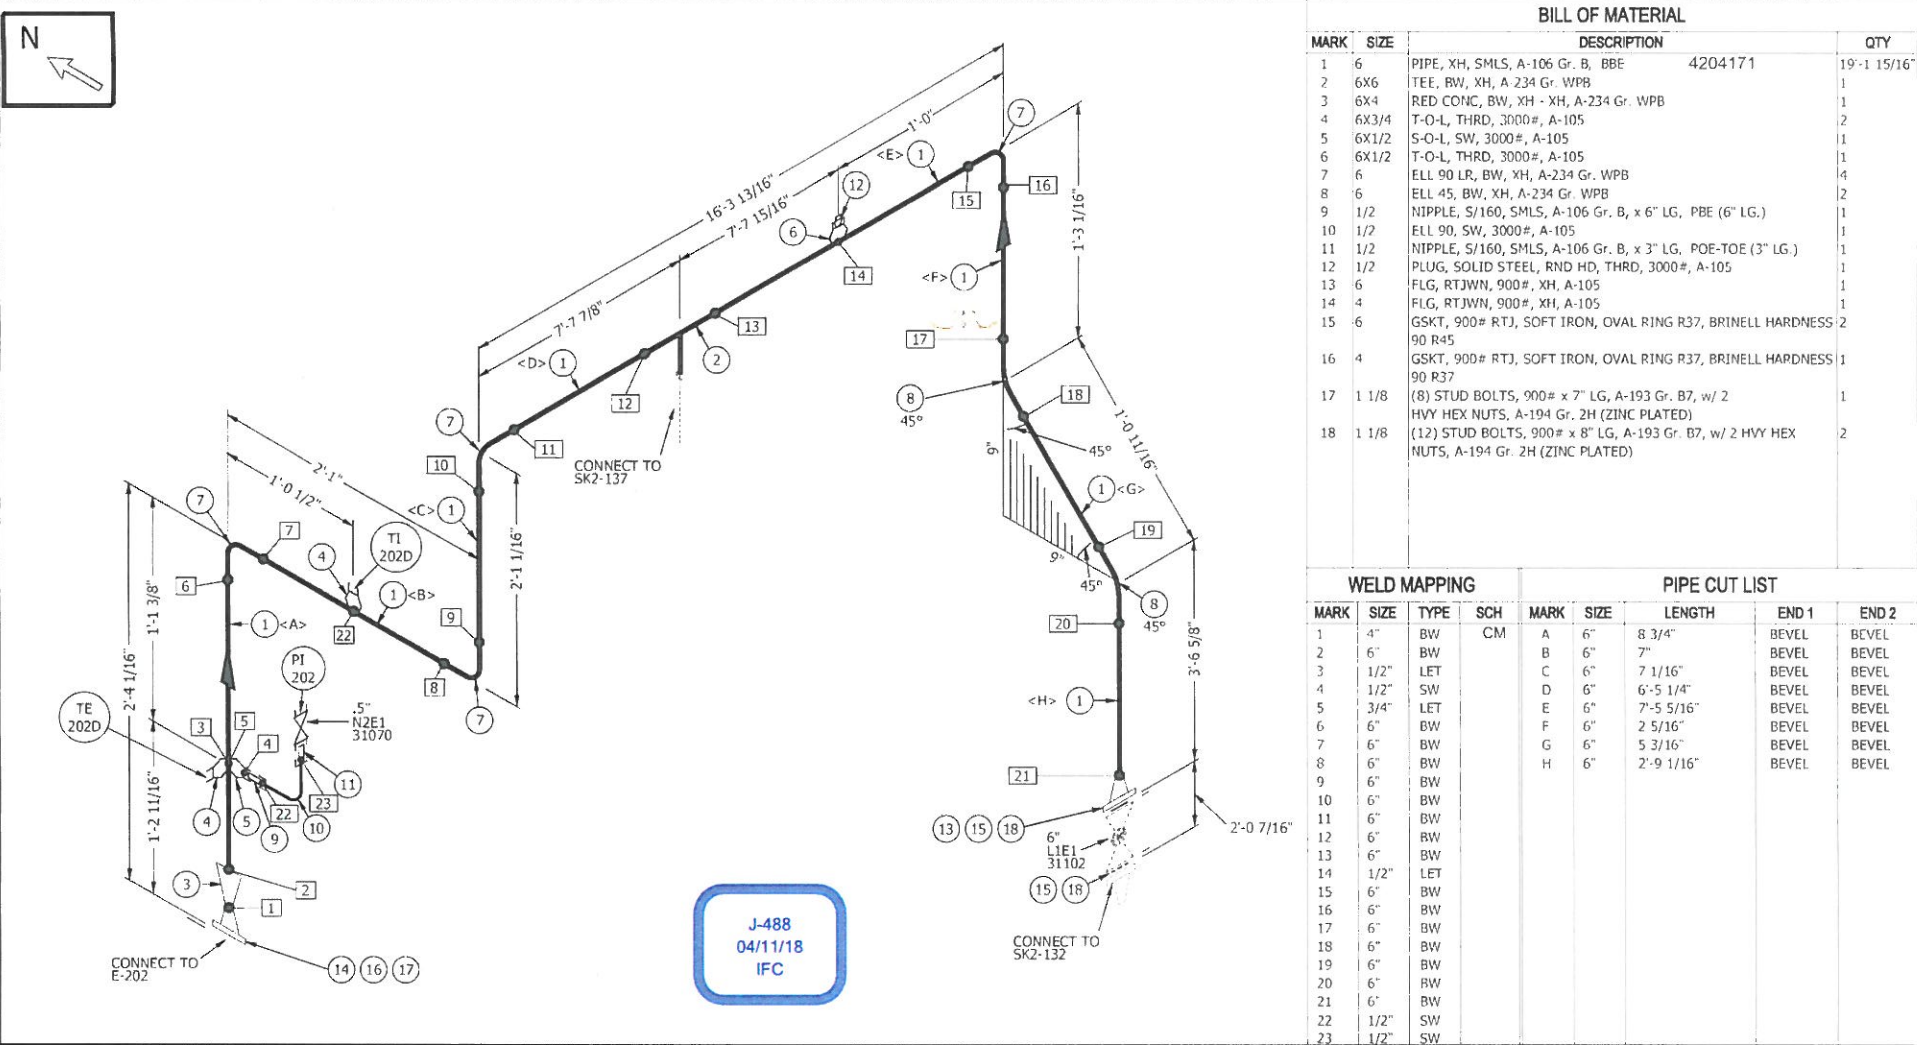

| BILL OF MATERIAL |       |  |              |
|------------------|-------|--|--------------|
| MARK             | SIZE  | DESCRIPTION  | QTY          |
| 1                | 6     | PIPE, XH, SMLS, A-106 Gr. B, BBE 4204171   | 19'-1 15/16" |
| 2                | 6X6   | TEE, BW, XH, A-234 Gr. WPB   | 1            |
| 3                | 6X4   | RED CONC, BW, XH - XH, A-234 Gr. WPB   | 1            |
| 4                | 6X3/4 | T-O-L, THRD, 3000#, A-105  | 2            |
| 5                | 6X1/2 | S-O-L, SW, 3000#, A-105  | 1            |
| 6                | 6X1/2 | T-O-L, THRD, 3000#, A-105  | 1            |
| 7                | 6     | ELL 90 LR, BW, XH, A-234 Gr. WPB   | 4            |
| 8                | 6     | ELL 45, BW, XH, A-234 Gr. WPB  | 2            |
| 9                | 1/2   | NIPPLE, S/160, SMLS, A-106 Gr. B, x 6" LG, PBE (6" LG.)                                    | 1            |
| 10               | 1/2   | ELL 90, SW, 3000#, A-105   | 1            |
| 11               | 1/2   | NIPPLE, S/160, SMLS, A-106 Gr. B, x 3" LG, POE-TOE (3" LG.)                                | 1            |
| 12               | 1/2   | PLUG, SOLID STEEL, RND HD, THRD, 3000#, A-105  | 1            |
| 13               | 6     | FLG, RTJWN, 900#, XH, A-105  | 1            |
| 14               | 4     | FLG, RTJWN, 900#, XH, A-105  | 1            |
| 15               | 6     | GSKT, 900# RTJ, SOFT IRON, OVAL RING R37, BRINELL HARDNESS 90 R45                          | 2            |
| 16               | 4     | GSKT, 900# RTJ, SOFT IRON, OVAL RING R37, BRINELL HARDNESS 90 R37                          | 1            |
| 17               | 1 1/8 | (8) STUD BOLTS, 900# x 7" LG, A-193 Gr. B7, w/ 2 HVY HEX NUTS, A-194 Gr. 2H (ZINC PLATED)  | 1            |
| 18               | 1 1/8 | (12) STUD BOLTS, 900# x 8" LG, A-193 Gr. B7, w/ 2 HVY HEX NUTS, A-194 Gr. 2H (ZINC PLATED) | 2            |

| WELD MAPPING |      |      |     | PIPE CUT LIST |      |            |       |       |
|--------------|------|------|-----|---------------|------|------------|-------|-------|
| MARK         | SIZE | TYPE | SCH | MARK          | SIZE | LENGTH     | END 1 | END 2 |
| 1            | 4"   | BW   | CM  | A             | 6"   | 8 3/4"     | BEVEL | BEVEL |
| 2            | 6"   | BW   |     | B             | 6"   | 7"         | BEVEL | BEVEL |
| 3            | 1/2" | LET  |     | C             | 6"   | 7 1/16"    | BEVEL | BEVEL |
| 4            | 1/2" | SW   |     | D             | 6"   | 6'-5 1/4"  | BEVEL | BEVEL |
| 5            | 3/4" | LET  |     | E             | 6"   | 7'-5 5/16" | BEVEL | BEVEL |
| 6            | 6"   | BW   |     | F             | 6"   | 2 5/16"    | BEVEL | BEVEL |
| 7            | 6"   | BW   |     | G             | 6"   | 5 3/16"    | BEVEL | BEVEL |
| 8            | 6"   | BW   |     | H             | 6"   | 2'-9 1/16" | BEVEL | BEVEL |
| 9            | 6"   | BW   |     |               |      |            |       |       |
| 10           | 6"   | BW   |     |               |      |            |       |       |
| 11           | 6"   | BW   |     |               |      |            |       |       |
| 12           | 6"   | BW   |     |               |      |            |       |       |
| 13           | 6"   | BW   |     |               |      |            |       |       |
| 14           | 1/2" | LET  |     |               |      |            |       |       |
| 15           | 6"   | BW   |     |               |      |            |       |       |
| 16           | 6"   | BW   |     |               |      |            |       |       |
| 17           | 6"   | BW   |     |               |      |            |       |       |
| 18           | 6"   | BW   |     |               |      |            |       |       |
| 19           | 6"   | BW   |     |               |      |            |       |       |
| 20           | 6"   | BW   |     |               |      |            |       |       |
| 21           | 6"   | BW   |     |               |      |            |       |       |
| 22           | 1/2" | SW   |     |               |      |            |       |       |
| 23           | 1/2" | SW   |     |               |      |            |       |       |

|                |            |                |           |     |                        |          |    |     |  |
|----------------|------------|----------------|-----------|-----|------------------------|----------|----|-----|--|
| DESIGN PRESS.  | 1440 Psig  | FAB. LOCATION  | SHOP      |     |                        |          |    |     |  |
| DESIGN TEMP.   | 200 °F     | SPOOL LOCATION | SK D #2   |     |                        |          |    |     |  |
| OPER. PRESS.   | 1265 Psig  |                |           |     |                        |          |    |     |  |
| OPER. TEMP.    | 72 °F      | CORR. ALLOW.   | .0625"    |     |                        |          |    |     |  |
| STRESS RELIEVE | NO         | INSULATION     | NONE      | 0   | ISSUE FOR CONSTRUCTION | 01/10/18 | CW | WC  |  |
| RADIOGRAPHY    | 15% NORMAL | PAINT          | SYSTEM #3 | NO. | REVISION               | DATE     | BY | APR |  |

**CONFIDENTIAL STATEMENT**  
 THIS DRAWING IS THE PROPERTY OF THE THOMAS RUSSELL CO. AND IS NOT TO BE USED FOR ANY PURPOSE OTHER THAN THAT FOR WHICH IT IS SPECIFICALLY FURNISHED.



**FABRICATION NOTES:**  
 ALL VALVES ARE RASSED FACE UNLESS NOTED  
 ALL FITTINGS MAKE UP & CUT LENGTHS FOR BW PIPE DO NOT INCLUDE WELD CAPS  
 SHOP TO MAKE ADJUSTMENTS FOR WELD CAPS  
 ALL PIPE SEAMLESS UNLESS NOTED OTHERWISE  
 ALL COUNTING TO BE SADDLED ON

**UOP Russell Honeywell**


2250 S. 11th, Suite 210  
 Tulsa, Oklahoma 74116  
 Phone 918-481-5892  
 Fax 918-481-7422

|             |              |
|-------------|--------------|
| LINE No.    | 216-E1-CS-6" |
| ISSUE NO.   | SC6R-402     |
| FAB DRAWING | *** 231      |
| DATE        | 01/10/18     |
| REV         | 0            |



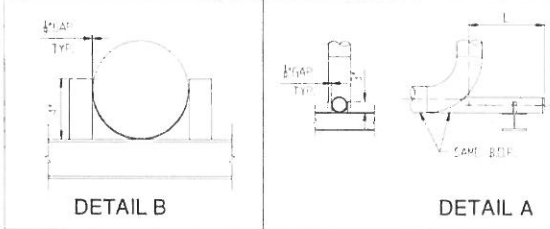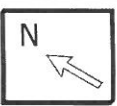

| BILL OF MATERIAL |       |  |         |             |
|------------------|-------|--|---------|-------------|
| MARK             | SIZE  | DESCRIPTION  |         | QTY         |
| 1                | 6     | PIPE, XH, SMLS, A-106 Gr. B, BBE   | 4204171 | 17'-3 1/16" |
| 2                | 2     | PIPE, XH, SMLS, A-106 Gr. B, BBE   |         | 1'-2"       |
| 3                | 6X3   | TEE RED, BW, XH - XH, A-234 Gr. WPB  |         | 1           |
| 4                | 6X3/4 | S-O-L, SW, 3000#, A-105  |         | 1           |
| 5                | 6X3/4 | T-O-L, THRD, 3000#, A-105  |         | 1           |
| 6                | 6     | ELL 90 LR, BW, XH, A-234 Gr. WPB   |         | 3           |
| 7                | 3X2   | RED CONC, BW, XH - XH, A-234 Gr. WPB   |         | 1           |
| 8                | 3/4   | NIPPLE, S/160, SMLS, A-106 Gr. B, x 3" LG, POE-TOE (3" LG)   |         | 1           |
| 9                | 3/4   | PLUG, SOLID STEEL, RND HD, THRD, 3000#, A-105  |         | 1           |
| 10               | 6     | FLG, RTJWN, 900#, XH, A-105  |         | 1           |
| 11               | 2     | FLG, RTJWN, 900#/1500#, XH, A-105  |         | 1           |
| 12               | 6     | (1) PIPE, 3" STD, SMLS, x 30" LG, A-106 Gr. B (1) END PL, 1/4" THK x 3 3/8" O.D. A-36 (L=18"), (2) ANGLE, 2" x 2" x 1/4" x 4" LG. A-36 |         | 1           |
| 13               | 4     | ANGLE, 2" x 2" x 1/4" x 4" LG. A-36  |         | 2           |

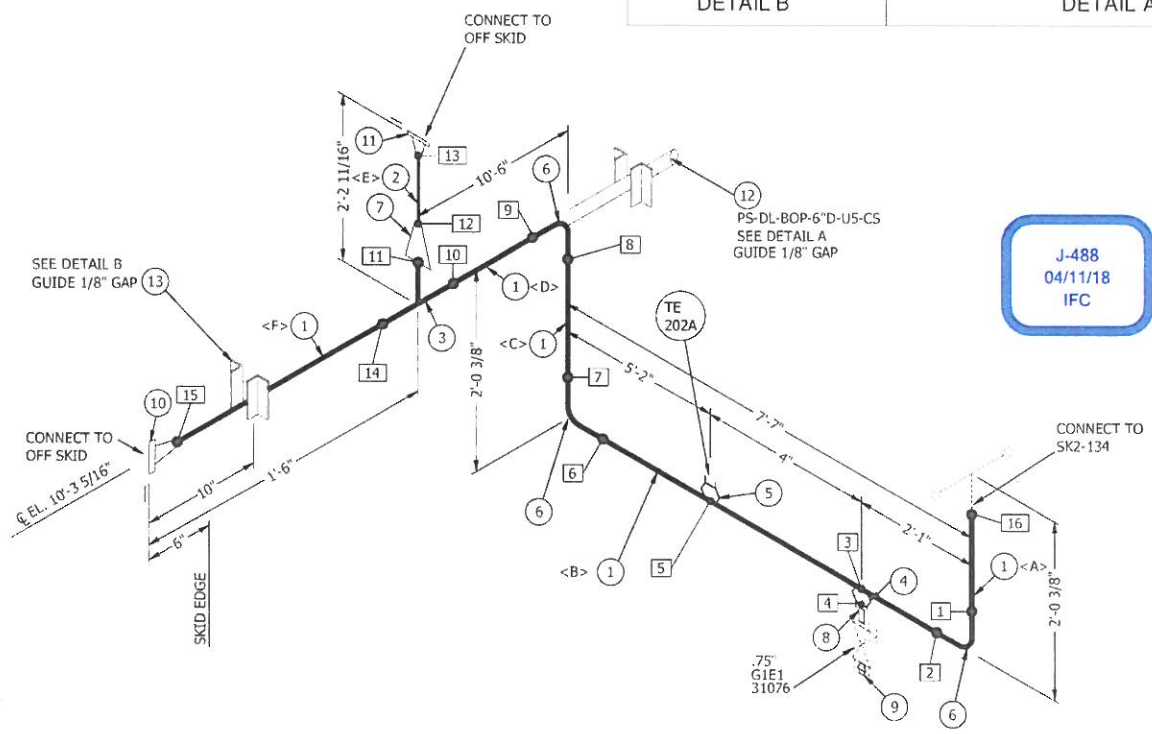


**J-488**  
 04/11/18  
 IFC

| WELD MAPPING |      |      |     | PIPE CUT LIST |      |           |       |       |
|--------------|------|------|-----|---------------|------|-----------|-------|-------|
| MARK         | SIZE | TYPE | SCH | MARK          | SIZE | LENGTH    | END 1 | END 2 |
| 1            | 6"   | BW   | CM  | A             | 6"   | 9 3/4"    | BEVEL | BEVEL |
| 2            | 6"   | BW   |     | B             | 6"   | 6'-1"     | BEVEL | BEVEL |
| 3            | 3/4" | LET  |     | C             | 6"   | 6 3/8"    | BEVEL | BEVEL |
| 4            | 3/4" | SW   |     | D             | 6"   | 9'-3 3/8" | BEVEL | BEVEL |
| 5            | 3/4" | LET  |     | E             | 2"   | 1'-2"     | BEVEL | BEVEL |
| 6            | 6"   | BW   |     | F             | 6"   | 6 9/16"   | BEVEL | BEVEL |
| 7            | 6"   | BW   |     |               |      |           |       |       |
| 8            | 6"   | BW   |     |               |      |           |       |       |
| 9            | 6"   | BW   |     |               |      |           |       |       |
| 10           | 6"   | BW   |     |               |      |           |       |       |
| 11           | 3"   | BW   |     |               |      |           |       |       |
| 12           | 2"   | BW   |     |               |      |           |       |       |
| 13           | 2"   | BW   |     |               |      |           |       |       |
| 14           | 6"   | BW   |     |               |      |           |       |       |
| 15           | 6"   | BW   |     |               |      |           |       |       |
| 16           | 6"   | BW   |     |               |      |           |       |       |




|                |            |                |           |    |  |  |  |  |  |
|----------------|------------|----------------|-----------|----|--|--|--|--|--|
| DESIGN PRESS.  | 1440 Psig  | FAB. LOCATION  | SHOP      |    |  |  |  |  |  |
| DESIGN TEMP.   | 200°F      | SPOOL LOCATION | SKID #2   |    |  |  |  |  |  |
| OPER. PRESS.   | 1265 Psig  |                |           |    |  |  |  |  |  |
| OPER. TEMP.    | 72°F       | CORR. ALLOW.   | .0625"    |    |  |  |  |  |  |
| STRESS RELIEVE | NO         | INSULATION     | NONE      |    |  |  |  |  |  |
| RADIOGRAPHY    | 15% NORMAL | PANT           | SYSTEM #3 | NO |  |  |  |  |  |

**CONFIDENTIAL STATEMENT**  
 THIS DRAWING IS THE PROPERTY OF THE THOMAS RUSSELL CO. AND IS NOT TO BE USED FOR ANY PURPOSE OTHER THAN THAT FOR WHICH IT IS SPECIFICALLY INTENDED.

**FABRICATION NOTES:**  
 ALL VALVES ARE RASSED FACE UNLESS NOTED  
 ALL FITTING MAKE-UP & CUT LENGTHS FOR RW PIPE DO NOT INCLUDE WELD GAPS  
 SHOP TO MAKE ADJUSTMENTS FOR WELD GAPS  
 ALL PIPE SEAMLESS UNLESS NOTED OTHERWISE  
 ALL CONNECTIONS TO BE SCHEDULED ON

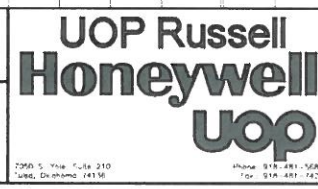

|                  |              |
|------------------|--------------|
| LINE No.         | 216-F1-CS-6" |
| ASSEMBLY DRAWING | SC6R-402     |
| PART DRAWING     | *** 231      |
| DRAWN BY         | CW           |
| CHECKED BY       |              |
| DATE DRAWN       | 01/10/18     |
| DWG No.          | 488          |
| SPEC. TO NO.     | 042-137      |
| REV              | 0            |

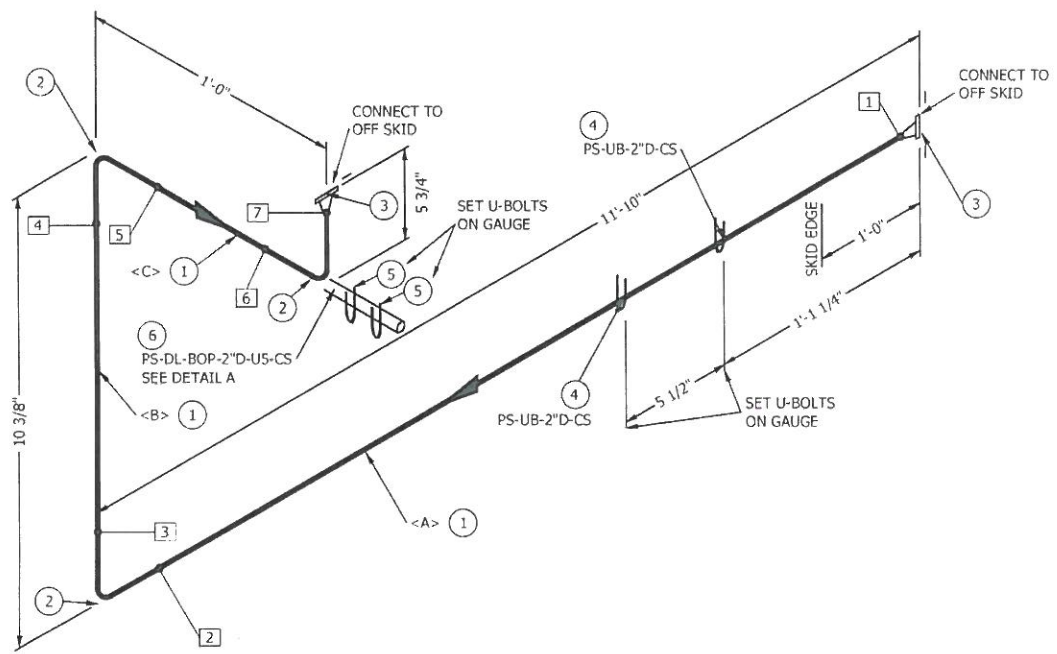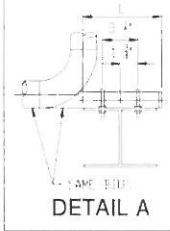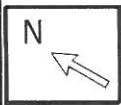

BILL OF MATERIAL

| MARK | SIZE  | DESCRIPTION  | QTY        | SAP No |
|------|-------|--|------------|--------|
| 1    | 2     | PIPE, XH, SMLS, A-106 Gr. B, BBE D04408                      | 12'-2 5/8" |        |
| 2    | 2     | ELL 90 LR, BW, XH, A-234 Gr. WPB                             | 3          |        |
| 3    | 2     | FLG, RPWN, 300#, XH, A-105                                   | 2          |        |
| 4    | 2     | U-BOLT FOR 2" DIA PIPE W/ (4) HEX NUTS EA (CS ZINC PL)       | 2          |        |
| 5    | 1 1/2 | U-BOLT FOR 1 1/2" DIA PIPE W/ (4) HEX NUTS EA (CS ZINC PL)   | 2          |        |
| 6    | 2     | (1) PIPE, 1 1/2" XH, SMLS, x 1'-1 11/16" LG. A-106 Gr. B (1) | 1          |        |
|      |       | END PL, 1/4" THK. x 1 3/4" O.D. A-36 (L=10 11/16")           |            |        |

WELD MAPPING

| MARK | SIZE | TYPE | WEL DEF |
|------|------|------|---------|
| 1    | 2"   | BW   | CC      |
| 2    | 2"   | BW   |         |
| 3    | 2"   | BW   |         |
| 4    | 2"   | BW   |         |
| 5    | 2"   | BW   |         |
| 6    | 2"   | BW   |         |
| 7    | 2"   | BW   |         |

PIPE CUT LIST


| MARK | SIZE | LENGTH     | END 1 | END 2 |
|------|------|------------|-------|-------|
| 1    | 2"   | 11'-4 1/4" | BEVEL | BEVEL |
| 2    | 2"   | 4 3/8"     | BEVEL | BEVEL |
| 3    | 2"   | 6"         | BEVEL | BEVEL |

J-488  
04/11/18  
IFC

|                |            |                |           |     |                        |        |     |     |  |
|----------------|------------|----------------|-----------|-----|------------------------|--------|-----|-----|--|
| DESIGN PRESS.  | 650 Psig   | FAB. LOCATION  | SHOP      |     |                        |        |     |     |  |
| DESIGN TEMP.   | 200°F      | SPOOL LOCATION | SKID #2   |     |                        |        |     |     |  |
| OPER. PRESS.   | 245 Psig   |                |           |     |                        |        |     |     |  |
| OPER. TEMP.    | 130°F      | CORR ALLOW.    | 0.625"    |     |                        |        |     |     |  |
| STRESS RELIEVE | NO         | INSULATION     | NONE      | 0   | ISSUE FOR CONSTRUCTION | 3/5/18 | COR | WD  |  |
| RADIOGRAPHY    | 15% NORMAL | PAINT          | SYSTEM #3 | NO. | REVISION               | DATE   | BY  | APR |  |

**CONFIDENTIAL STATEMENT**  
THIS DRAWING IS THE PROPERTY OF THE THOMAS RUSSELL CO. AND IS NOT TO BE USED FOR ANY PURPOSE OTHER THAN THAT FOR WHICH IT IS SPECIFICALLY PREPARED.

**FABRICATION NOTES:**  
ALL VALUES ARE BASED FACE UNLESS NOTED  
ALL FITTING MAKE-UP & CUT LENGTHS FOR PIPE DO NOT INCLUDE WELD CAPS  
SHOP TO MAKE ADJUSTMENTS FOR WELD CAPS  
ALL PIPE SEAMLESS UNLESS NOTED OTHERWISE  
ALL CONNECTIONS TO BE SCHEDULE 40

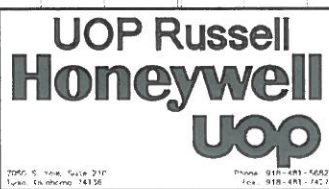

|                  |                 |
|------------------|-----------------|
| LINE No          | PSV-001 (B1-CS) |
| APPROVAL DRAWING | *** 450         |
| PAID DRAWING     | *** 2331        |
| DRAWN BY         | COR 3/5/18      |
| CHECKED BY       | SK2-138         |
| DATE             | 3/5/18          |
| REV              | 0               |

J-488 SK2

SPOOLS

PIPE MTRs





A02 Inspection certificate "3.1" (EN 10 204)


A03 Document No.: 32515/16

Page: 1/2

|               |  |   |   |  |       |   |      |   |           |       |       |  |       |  |  |  |  |  |
|---------------|--|---|---|--|-------|---|------|---|-----------|-------|-------|--|-------|--|--|--|--|--|
| A07           | Customer's Order (P.O.) No./Item No.:<br>165608-00/10098521  | A08                                     | Manufacturer's Works Order No.:<br>40277/0/16 |  |       |   |      |   |           |       |       |  |       |  |  |  |  |  |
| A11           | Supplier's Order No.:<br>3151002086  | A10                                     | Advice - Note No.:<br>8150008597, 8150007129  |  |       |   |      |   |           |       |       |  |       |  |  |  |  |  |
| B03, B12/B3   | Quantity delivered:<br><table border="1"> <tr> <td>pcs</td> <td>mtrs</td> <td>kgs</td> </tr> <tr> <td>bcls</td> <td>feet</td> <td>lbs</td> </tr> <tr> <td>835</td> <td>10301.837</td> <td>17076</td> </tr> </table>  | pcs                                     | mtrs  | kgs  | bcls  | feet  | lbs  | 835   | 10301.837 | 17076 | A09   | Customer / Consignee:<br><br>ArcelorMittal International America, LLC<br>1 S. Dearborn Street<br>60603-8688 CHICAGO<br>USA |       |  |  |  |  |  |
| pcs           | mtrs   | kgs                                     |   |  |       |   |      |   |           |       |       |  |       |  |  |  |  |  |
| bcls          | feet   | lbs                                     |   |  |       |   |      |   |           |       |       |  |       |  |  |  |  |  |
| 835           | 10301.837  | 17076                                   |   |  |       |   |      |   |           |       |       |  |       |  |  |  |  |  |
| B08-11        | Dimensions:<br>1.900 X 0.200"  |   |   |  |       |   |      |   |           |       |       |  |       |  |  |  |  |  |
| B02           | Steel designation:<br>Grade 6 Grade B  |   |   |  |       |   |      |   |           |       |       |  |       |  |  |  |  |  |
| B01, B03, B04 | Product, conditions and terms of delivery:<br>Seamless steel pipes acc. to ASME B36.10M-15 / ASTM A333/A333M-15 Grade 6 / ASME SA333/SA333M-15 Grade 6 / ASTM A53/A53M-12 Grade B / ASME SA53/SA53M-12 Grade B / ASTM A108/A108M-15 Grade B / ASTM SA108/SA108M-15 Grade B, NACE MR0175/ISO 15156-08 / NACE MR0103-12, with plain ends, protected with plastic caps, surface lacquered.<br>Normalized hot finished. Certified acc. to EN 10204/3.1-2004. |   |   |  |       |   |      |   |           |       |       |  |       |  |  |  |  |  |
| A04, B05      | Marking: Manufacturer's mark, mill inspector's stamp<br><br>ANTP OSTRAVA <span style="border: 1px solid black; border-radius: 50%; padding: 2px;">3</span>   |   |   |  |       |   |      |   |           |       |       |  |       |  |  |  |  |  |
| C71-82        | Heat chemical analysis (%)   |   |   |  |       |   |      |   |           |       |       |  | C70   | Steel made by basic oxygen process, fully killed, strand cast. |  |  |  |  |
| B07           | Heat No.:  | C                                       | MN  | SI   | P     | S   | CU   | NI  | CR        | MO    | V     | TI   | NB    | CEQ  |  |  |  |  |
|               | 78376K   | 0.18                                    | 1.17  | 0.231  | 0.014 | 0.008   | 0.06 | 0.03  | 0.04      | 0.007 | 0.001 | 0.001  | 0.004 | 0.39   |  |  |  |  |
| Z09           | <input checked="" type="checkbox"/>  | continues on page 2/2                   |   |  |       |   |      |   |           |       |       |  |       |  |  |  |  |  |
| B07, C04      | Test results:  | psi                                     |   | psi  |       | % (Z')  |      | HRB   |           |       |       |  |       |  |  |  |  |  |
|               | Heat No. / Specimen No. Requirements: Grade 6 / Grade B  | c11 Yield Point min. 35000 / min. 35000 |   | c12 Tensile Strength min. 60200 / min. 60000 |       | c13 Elongation min. 24 / min. 22                |      | c10-13 Impact test L-3,33-5 ft-lb / -60°F max. 99 |           |       |       |  |       |  |  |  |  |  |
|               |  | Longitudinal strip specimen 3/4"        |   |  |       |   |      | Ø min   |           |       |       |  |       |  |  |  |  |  |
|               | 78376K   | 45252 / 46847 / 45977 / 49313           |   | 70053 / 74114 / 72519 / 73099                |       | 32.0 / 28.7 / 27.7 / 30.2                       |      | 19 / 19 18 21 / 76.5                              |           |       |       |  |       |  |  |  |  |  |
| Z09           | <input checked="" type="checkbox"/>  | continues on page 2/2                   |   |  |       |   |      |   |           |       |       |  |       |  |  |  |  |  |
| D01           | Visual and dimensional inspection with satisfactory results  | X                                       |   | D01  |       | Hydraulic test - min. test pressure psi / sec   |      | 2500 / 5  |           |       |       |  |       |  |  |  |  |  |
| C50           | Flattening test - satisfactory   | X                                       |   | D02  |       | The pipes tested on tightness by NDT in acc. to |      |   |           |       |       |  |       |  |  |  |  |  |
| C51           | Expanding test - satisfactory  |   |   |  |       |   |      |   |           |       |       |  |       |  |  |  |  |  |
| C52           | Bending test - satisfactory  | X                                       |   |  |       |   |      |   |           |       |       |  |       |  |  |  |  |  |
| C63           | Ring expanding test - satisfactory   |   |   | D03  |       | Nondestructive Electromagnetic Testing          |      |   |           |       |       |  |       |  |  |  |  |  |
| C64           | Ring tensile test - satisfactory   |   |   |  |       |   |      |   |           |       |       |  |       |  |  |  |  |  |

PRESENTED DATA WAS CONVERTED FROM SI UNIT SYSTEM.

MISNA Order No.: 165608-00/10098521 Customer name: Vessel name: STAR ISMENE  
 Z01 All pipes conform to the above mentioned standards and ordering requirements and agreements.  
 Z02 Date of issue 3.11.2016/CE Tel.: +420 595683644

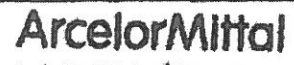

ArcelorMittal Tubular Products Ostrava a.s.  
 Vratimovská 689, 707 02 Ostrava 7  
 Czech Republic

Bc. Petr Pastucha  
 Work's Inspector  
 Z02 Validation

A01 ArcelorMittal Tubular Products Ostrava a.s.  
 A05 QA Department  
 Vratimovská 689  
 707 02 Ostrava-Kunčice  
 Czech Republic

EZ 2574/16/15P

Please purchase PDFStamp Command Line product to remove this watermark.  
<http://www.verypdf.com>



Inspection certificate "3.1" (EN 10 204)

Doc Document No: 32515/16

Page: 2/2

| c71-82 Heat chemical analysis (%) |          |      |      |       |       |       |      |      |      |       |       |       |       |      |
|-----------------------------------|----------|------|------|-------|-------|-------|------|------|------|-------|-------|-------|-------|------|
| b07                               | Heat No. | C    | Mn   | Si    | P     | S     | Cu   | Ni   | Cr   | Mo    | V     | Ti    | Nb    | Ceq  |
|                                   | 79975K   | 0.16 | 1.11 | 0.206 | 0.011 | 0.010 | 0.07 | 0.04 | 0.05 | 0.008 | 0.001 | 0.001 | 0.004 | 0.37 |

| b07<br>c04 | Test results:<br>Heat No. c03 Specimen No. | c11 Yield Point<br>psi   | c12 Tensile Strength<br>psi  | c13 Elongation<br>% (2")   | c40-43 Impact Test<br>min. |    |    | c30-32 Hardness |      |
|------------|--|--|--|--|----------------------------|----|----|-----------------|------|
|            |  |  |  |  | Ø                          |    |    |                 |      |
|            | 79875K                                     | 44672<br>45687<br>47717<br>45107<br>48702<br>48267<br>48267<br>47137<br>45252<br>44382 | 69908<br>69618<br>72374<br>68893<br>70778<br>68893<br>69183<br>70923<br>70778<br>70198 | 31.6<br>33.2<br>30.8<br>29.7<br>30.1<br>33.7<br>32.0<br>32.4<br>30.7<br>32.5 | 19                         | 18 | 18 | 21              | 72.4 |

z02 Date of issue 3.11.2016/CE

Tel.: +420 580883944

A01 ArcelorMittal Tubular Products Ostrava s.s.  
 A06 QA Department  
 Vrařimovská 689  
 707 02 Ostrava-Kunčice  
 Czech Republic

**ArcelorMittal**

ArcelorMittal Tubular Products Ostrava s.s.  
 Vrařimovská 689, 707 02 Ostrava 7  
 (Inspected)

**Bc. Petr Pastucha**

Work's Inspector  
 z02 Validation

E.L. 257476/15/P



A03 Document No.:  
A 2016/12/003005-JAN

Sheet : 1 / 5

ORIGINAL



A01, A05  
 Manufacturer: TRINECKÉ ŽELEZÁRNY, a.s. /Průmyslová 1000 /Staré Město /739 81 Třinec /Czech Republic  
 Production mill : VT - VÁLCOVNA TRUB / Vystavní 1132 / 706 02 Ostrava - Vítkovice / Czech Republic

| A07<br>Purchaser's order No.:   | A08<br>Works order No./ Contract No.: | A09<br>Consignee:   |  |
|---|---------------------------------------|---|--|
| 60094   | 9700245396<br>0041414435 / 176        |   |  |
| A10 Advice-Note No.:<br>16/12/001283/01 06.12.2016  |                                       |   |  |
| A02 Type of inspection document:<br>Inspection certificate 3.1, EN 10204:2004   |                                       |   |  |
| B01, B09-B11<br>Product, product dimensions, specification  | B08, B13<br>Quantity                  | B02.1<br>Steel designation  | B02.2<br>Product / Dimensional standard  |
| Seamless Steel Line Pipes Hot Rolled<br><br>10.750 in x 0.365 in  | 24 pcs<br>984.50 ft<br>18839 kgs      | X52N/PSL2<br>Gr.B<br>Gr.B<br>Gr.B<br>Gr.B<br>Gr.C<br>Gr.B<br>Gr.C<br>Gr.B | API SPEC 5L 45. EDITION<br>ASTM A106/A106M 11/2015<br>ASTM A53/A53M 03/2012<br>ASTM A333/A333M 03/2016<br>ASME SA106/SA106M 07/2015<br>ASME SA106/SA106M 07/2015<br>ASME SA53/SA53M 07/2015<br>ASTM A106/A106M 11/2015<br>ASME SA333/SA333M 07/2015<br><br>ASME B36.10 08/2015 |
| B04 Product delivery condition:<br>normalized   |                                       |   |  |
| B03 Supplementary requirements:<br>PED 2014/68/EU (No.: 07/202/0190/WZ/0812/16)<br>Manufacturer declares that is certified according to Article 4.3, Annex I of Directive 2014/68/EU by the notified body TÜV NORD reg. No 0045. Certificate is valid until September 2019.<br>Tolerance on Outside Diameter $\pm 0.75\%$<br>Bevelled ends $30^\circ \pm 5^\circ/0^\circ$ , root face 1,6mm $\pm 0,8$ mm, With monogram API |                                       |   |  |
| B14 Letter of credit:<br>MILL TEST CERTIFICATE<br>Description of Goods and/or Services:<br>PRIME NEWLY PRODUCED SEAMLESS STEEL LINE PIPE, ACCORDING TO ASTM/ASME A/SA53-B, A/SA 106-B/C, A/SA 333 GR.B, API5L X52N (PSL-2), CERTIFIED TO NACE MR0175, MR0103, PED 97/23/EC-SECT 4.3. EN 10204 3.1, MILL LACQUER COATED, BEVELED ENDS WITH PLASTIC CAPS.   |                                       |   |  |

Z02 Confirmed: Marta Uthová, Ing.,  
Head of Attestation, Releasing and External inspection VT, independent authorized agent

Z02  
Ostrava-Vitkovice,  
08.12.2016

tel.: 00420/59/560/2160

TRINECKÉ ŽELEZÁRNY, a.s.  
Průmyslová 1000, Staré Město, 739 81 Třinec, Czech Republic  
Tel: +420 59 560 2160

38813  
10/16

Z03 Independent authorized agent

Please purchase PDFStamp Command Line product to remove this watermark.  
<http://www.verypdf.com>



**TRINECKÉ ŽELEZÁŘNY**  
**MORAVIA STEEL**

A03 Document No.:  
A 2016/12/003005-JAN

Sheet : 2 / 5

A01, A05  
Manufacturer: TRINECKÉ ŽELEZÁŘNY, a.s. /Průmyslová 1000 /Staré Město /739 61 Třinec /Czech Republic  
Production mill : VT - VALCOVNA TRUB / Vystavní 1132 / 708 02 Ostrava - Vítkovice / Czech Republic

TOTAL QUANTITY: 10,300 FT/183 MT  
SHIPPING TERMS: CIF, LO HOUSTON, TX, USA.

| SIZE (IN) | WT (IN)   | QTY (FT)/MT | LENGTH (FT) |
|-----------|-----------|-------------|-------------|
| 6.000     | .280W S40 | 2,000/17    | 38-42       |
| 6.000     | .432W S80 | 1,200/16    | 38-42       |
| 8.000     | .322W S40 | 1,500/19    | 38-42       |
| 8.000     | .500W S80 | 1,000/20    | 38-42       |
| 10.000    | .365W     | 1,000/18    | 38-42       |
| 10.000    | .500 W    | 600/15      | 38-42       |
| 12.000    | .375W     | 1,000/22    | 38-42       |
| 12.000    | .500W     | 500/15      | 38-42       |
| 14.000    | .375W     | 1,000/25    | 38-42       |
| 14.000    | .500W     | 500/16      | 38-42       |

OD TOLERANCE: +/- 0.75 PERCENT.  
WT TOLERANCE: +15/-12.5 PERCENT

Requirements :

| B07.1 Heat No. | B07.2 Specimen No. | C10* Specimen shape       | C11 Yield Strength Rm,5 psi  | C12 Tensile Strength Rm psi       | C13 Elongation 2" % | C14 Reduction of area Z % |
|----------------|--------------------|---------------------------|------------------------------|-----------------------------------|---------------------|---------------------------|
|                |                    |                           | 52200-76900                  | 70000-110200                      | min 30              |                           |
|                |                    | C02 Specimen direction: L | C03 Test temperature(°F): 70 | C15 Test method: ASTM A370        |                     |                           |
| T45432         | 61688/P            | P                         | 54389                        | 75275                             | 44.2                | -                         |
| T45432         | 61689/P            | P                         | 57435                        | 78175                             | 42.8                | -                         |
| T47853         | 61678/P            | P                         | 55694                        | 78290                             | 41.8                | -                         |
| B07.1 Heat No. | B07.2 Specimen No. | C10* Specimen shape       | C11 Yield Strength Rm,5 psi  | C12 Tensile Strength Rm psi       | C13 Elongation A5 % | C14 Reduction of area Z % |
|                |                    |                           | 52200-76900                  | 70000-110200                      | min 14              |                           |
|                |                    | C02 Specimen direction: L | C03 Test temperature(°F): 70 | C15 Test method: ENISO 6892-1 B30 |                     |                           |
| T45432         | 61688/P            | P                         | 62221                        | 77305                             | 32.6                | -                         |
| T47853         | 61678/P            | P                         | 61641                        | 77595                             | 30.9                | -                         |

\* P - Flat specimen  
K - Round specimen

Z02 Confirmed: Marta Uhrová, Ing.  
Head of Attestation, Releasing and External Inspection VT, independent authorized agent



Z02  
Ostrava-Vitkovice :  
08.12.2016  
tel: 00420/59/560/2160

Z03 independent authorized agent

38873  
2016

Please purchase PDFStamp Command Line product to remove this watermark.  
http://www.verypdf.com



A01, A05  
 Manufacturer: TRINECKÉ ŽELEZÁŘNY, a.s. /Průmyslová 1000 /Staré Město /739 61 Třinec /Czech Republic  
 Production mill : VT - VALCOVNA TRUB / Vystavní 1132 / 706 02 Ostrava - Vítkovice / Czech Republic

| B07.1<br>Heat No.   | B07.2<br>Specimen No. | C40<br>Impact test<br>KV<br>ft.lb                                      |                   | C44<br>Lateral expandit<br>mm    |                     | C45<br>Shear fracture area<br>% |                     |
|---|-----------------------|--|-------------------|----------------------------------|---------------------|---------------------------------|---------------------|
|   |                       | C41<br>0.295in x 0.394in   |                   |                                  |                     |                                 |                     |
|   |                       | C02<br>Specimen direction: L   |                   | C03<br>Test temperature(°F): -50 |                     | C46<br>Test method: ASTM A370   |                     |
|   |                       | C42<br>Individual values   | C43<br>Mean value | C44.1<br>Individual values       | C44.2<br>Mean value | C45.1<br>Individual values      | C45.2<br>Mean value |
| T45432  | 61688/P               | -181   | -178              | 170                              | -178                |                                 |                     |
| T47853  | 61678/P               | 136  | 133               | 127                              |                     |                                 |                     |
| B07.1<br>Heat No.   | B07.2<br>Specimen No. | C40<br>Impact test<br>KV<br>ft.lb                                      |                   | C44<br>Lateral expandit<br>mm    |                     | C45<br>Shear fracture area<br>% |                     |
|   |                       | C41<br>0.295in x 0.394in   |                   |                                  |                     |                                 |                     |
|   |                       | C02<br>Specimen direction: T   |                   | C03<br>Test temperature(°F): 32  |                     | C46<br>Test method: ASTM A370   |                     |
|   |                       | C42<br>Individual values   | C43<br>Mean value | C44.1<br>Individual values       | C44.2<br>Mean value | C45.1<br>Individual values      | C45.2<br>Mean value |
| T45432  | 61688/P               | -181   | 143               | 143                              | -158                |                                 |                     |
| T47853  | 61678/P               | -211   | -195              | -186                             | -197                |                                 |                     |
| B07.1<br>Heat No.   | B07.2<br>Specimen No. | C40<br>Impact test<br>KV2<br>ft.lb                                     |                   | C44<br>Lateral expandit<br>mm    |                     | C45<br>Shear fracture area<br>% |                     |
|   |                       | C41<br>0.295in x 0.394in   |                   |                                  |                     |                                 |                     |
|   |                       | C02<br>Specimen direction: L   |                   | C03<br>Test temperature(°F): 68  |                     | C46<br>Test method: ISO 148-1   |                     |
|   |                       | C42<br>Individual values   | C43<br>Mean value | C44.1<br>Individual values       | C44.2<br>Mean value | C45.1<br>Individual values      | C45.2<br>Mean value |
| T45432  | 61688/P               | 141  | 142               | 150                              | 145                 |                                 |                     |
| T47853  | 61678/P               | 145  | 135               | 130                              | 136                 |                                 |                     |
| B07.1<br>Heat No.   | B07.2<br>Specimen No. | C30<br>Hardness<br>HBW<br>NACE MR0176-2009/NACE MR0103-2012<br>max 237 |                   |                                  |                     |                                 |                     |
|   |                       | C33<br>Test method: ISO 6506-1   |                   |                                  |                     |                                 |                     |
|   |                       | C31<br>Individual values   | C32<br>Mean value |                                  |                     |                                 |                     |
| T45432  | 61688/P               | 148  | 144               | 143                              | 144                 |                                 |                     |
| T47853  | 61678/P               | 148  | 148               | 137                              | 144                 |                                 |                     |
| C70 Steelmaking process:<br>Basic oxygen furnace<br>Vacuum degassed |                       |  |                   |                                  |                     |                                 |                     |

Z02 Confirmed. Maria Ukhová, Ing.,  
Head of Attestation, Releasing and External Inspection VT, Independent authorized agent

Z02

Ostrava-Vitkovice  
08.12.2016

tel: 00420/59/560/2180



TRINECKÉ ŽELEZÁŘNY, a.s.  
Průmyslová 1000, Staré Město  
739 61 Třinec, Czech Republic

*[Handwritten signature]*

Z03 Independent authorized agent

38873  
3016

Please purchase PDFStamp Command Line product to remove this watermark.  
<http://www.verypdf.com>



**TRINECKÉ ŽELEZÁŘNY**  
**MORAVIA STEEL**

A03 Document No.:  
A 2016/12/003005-JAN

Sheet : 4 / 5

A01, A03  
Manufacturer: TRINECKÉ ŽELEZÁŘNY, a.s. /Průmyslová 1000 /Staré Město /739 61 Třinec /Czech Republic  
Production mill: VT - VÁLCOVNA TRUB / Vystavní 1132 / 708 02 Ostrava - Vítkovice / Czech Republic

| C71-C92  |                    |      |      |       |       |       |      |      |       |       |       |       |       |        |                  |      |                   |                |
|--|--------------------|------|------|-------|-------|-------|------|------|-------|-------|-------|-------|-------|--------|------------------|------|-------------------|----------------|
| Heat chemical analysis in %:   |                    |      |      |       |       |       |      |      |       |       |       |       |       |        |                  |      | Ceq max.: 0.43    |                |
| B07.1 Heat No.   | C                  | Mn   | Si   | P     | S     | Cu    | Ni   | Cr   | Mo    | V     | Ti    | Al    | Nb    | B      | Ceq              |      |                   |                |
| T45432   | 0.17               | 1.15 | 0.20 | 0.012 | 0.003 | 0.05  | 0.02 | 0.18 | 0.005 | 0.037 | 0.001 | 0.029 | 0.001 | 0.0005 | 0.41             |      |                   |                |
| T47853   | 0.16               | 1.15 | 0.20 | 0.014 | 0.004 | 0.05  | 0.03 | 0.18 | 0.007 | 0.035 | 0.001 | 0.031 | 0.001 | 0.0005 | 0.40             |      |                   |                |
| Product chemical analysis in %:  |                    |      |      |       |       |       |      |      |       |       |       |       |       |        |                  |      | Ceq max.: 0.43    |                |
| B07.1 Heat No.   | B07.2 Specimen No. | C    | Mn   | Si    | P     | S     | Cu   | Ni   | Cr    | Mo    | V     | Ti    | Al    | Nb     | B                | Ceq  |                   |                |
| T45432   | 61688/P            | 0.17 | 1.14 | 0.20  | 0.011 | 0.002 | 0.05 | 0.02 | 0.19  | 0.006 | 0.037 | 0.001 | 0.029 | 0.001  | 0.0004           | 0.41 |                   |                |
| T45432   | 61689/P            | 0.17 | 1.14 | 0.20  | 0.010 | 0.001 | 0.05 | 0.02 | 0.19  | 0.006 | 0.038 | 0.001 | 0.029 | 0.001  | 0.0004           | 0.41 |                   |                |
| T47853   | 61678/P            | 0.17 | 1.15 | 0.19  | 0.014 | 0.003 | 0.04 | 0.02 | 0.18  | 0.008 | 0.037 | 0.001 | 0.030 | 0.001  | 0.0003           | 0.41 |                   |                |
| C60, D61, D62-D80, D51   |                    |      |      |       |       |       |      |      |       |       |       |       |       |        |                  |      |                   |                |
| Other requirements:  |                    |      |      |       |       |       |      |      |       |       |       |       |       |        |                  |      |                   |                |
| Visual and dimensional inspection  |                    |      |      |       |       |       |      |      |       |       |       |       |       |        |                  |      | - satisfactory    |                |
| Flattening test  |                    |      |      |       |       |       |      |      |       |       |       |       |       |        | ASTM A 530/A 998 |      | - satisfactory    |                |
| Hydrostatic test - test pressure   |                    |      |      |       |       |       |      |      |       |       |       |       |       |        | 2970 psi/5s      |      | - satisfactory    |                |
| Ultrasonic testing   |                    |      |      |       |       |       |      |      |       |       |       |       |       |        | 100% of pipes    |      | ASTM E213 5 % L+T | - satisfactory |
| Residual magnetism   |                    |      |      |       |       |       |      |      |       |       |       |       |       |        | API 5L           |      | - satisfactory    |                |
| B16 Supplementary information:   |                    |      |      |       |       |       |      |      |       |       |       |       |       |        |                  |      |                   |                |
| Heat No.: T45432 - 23 pcs, 945.16 ft, 18074 kgs  |                    |      |      |       |       |       |      |      |       |       |       |       |       |        |                  |      |                   |                |
| Heat No.: T47853 - 1 pcs, 39.34 ft, 765 kgs  |                    |      |      |       |       |       |      |      |       |       |       |       |       |        |                  |      |                   |                |
| 80 % of capacity of the Charpy Impact Machine was exceeded at the Impact Test Values (see values marked with "-").   |                    |      |      |       |       |       |      |      |       |       |       |       |       |        |                  |      |                   |                |
| MECHANICAL PROPERTIES (TENSILE AND YIELD STRENGTH IN PSI, IMPACT TEST AND ELONGATION VALUE SHALL BE SPECIFIED)   |                    |      |      |       |       |       |      |      |       |       |       |       |       |        |                  |      |                   |                |
| STATEMENT 'MATERIAL HAS NO CONTAMINATION BY MERCURY, NO LEAD, NO ASBESTOS, AND NO REPAIR BY WELDING.'  |                    |      |      |       |       |       |      |      |       |       |       |       |       |        |                  |      |                   |                |
| COUNTRY OF ORIGIN OF RAW MATERIAL - CZECH REPUBLIC.  |                    |      |      |       |       |       |      |      |       |       |       |       |       |        |                  |      |                   |                |
| COUNTRY OF ORIGIN OF ACTUAL MANUFACTURE AND COUNTRY OF MELT - CZECH REPUBLIC.  |                    |      |      |       |       |       |      |      |       |       |       |       |       |        |                  |      |                   |                |
| LATEST EDITION AND ADDENDA   |                    |      |      |       |       |       |      |      |       |       |       |       |       |        |                  |      |                   |                |
| STATEMENT 'MATERIAL FURNISHED ON THIS PURCHASE ORDER SHALL NOT HAVE COME IN DIRECT CONTACT WITH MERCURY, ANY OF ITS COMPOUNDS, OR ANY MERCURY-BEARING DEVICES DURING THE MANUFACTURING PROCESS, TESTS, OR INSPECTIONS. |                    |      |      |       |       |       |      |      |       |       |       |       |       |        |                  |      |                   |                |
| 'NO WELD REPAIR HAS BEEN PERFORMED ON TUBES' STATEMENT   |                    |      |      |       |       |       |      |      |       |       |       |       |       |        |                  |      |                   |                |

Z02 Confirmed: Maria Uthová, Ing.  
Head of Attestation, Releasing and External Inspection VT, Independent authorized agent



TRINECKÉ ŽELEZÁŘNY, a.s.  
Průmyslová 1000 Staré Město  
739 61 Třinec, Czech Republic

Z02

Ostrava-Vitkovice:  
08.12.2016

tel. 00420/59/6602160

Z03 Independent authorized agent

406  
38873

Please purchase PDFStamp Command Line product to remove this watermark.  
<http://www.verypdf.com>



**TŘINECKÉ ŽELEZÁŘNY**  
**MORAVIA STEEL**

A03 Document No.:  
A 2016/12/003005-JAN

Sheet : 5/ 5

A01, A05

Manufacturer: TŘINECKÉ ŽELEZÁŘNY, a.s. /Průmyslová 1000 /Staré Město /739 61 Třinec /Czech Republic  
Production mill : VT - VALCOVNA TRUB / Výstavní 1132 / 706 02 Ostrava - Vítkovice / Czech Republic

The Mass Activity value of Ionizing Radiation in the Heat Analysis doesn't exceed 100 Bq/kg.  
The hardness test values in HBW conform to the request max. 22 HRC (max. 237 HBW).  
Grain size 5 - 12 acc.to ASTM E112: guaranteed  
Width of gauge length of the tension test specimen at a room temperature - 1.5 in /ASTM A370/.  
Data mentioned in USC Units were converted from SI Units.  
Appendix: Heat treatment report.

Z01  
ALL PRODUCTS MEET REQUIREMENTS OF ABOVE MENTIONED STANDARDS AND REQUIREMENTS SPECIFIED  
IN ORDER. THE DECLARATION IS ISSUED UNDER THE SOLE RESPONSIBILITY OF THE SUPPLIER.

A04 Manufacturer's mark:



Z06  
Electronical version of this document is protected by the electronical signature according to Law No. 227/2009Coll.

Z02 Confirmed: Marta Uhrová, Ing.,  
Head of Attestation, Releasing and External inspection VT. Independent authorized agent

Z02

Ostrava-Vitkovice:  
06.12.2016


tel.: 00420759/560/2160




Z03 Independent authorized agent

38873  
Sofie

Please purchase PDFStamp Command Line product to remove this watermark.  
<http://www.verypdf.com>

|   |              |   |            |
|---|--------------|---|------------|
|  <b>TŘINECKÉ ŽELEZÁŘNY<br/>MORAVIA STEEL</b> |              | <b>HEAT TREATMENT REPORT</b><br>Appendix at<br>Inspection certificate 3.1<br>A 2016/12/003005-JAN |            |
| DIMENSION [inch]:   | 10.750x0.365 | SHOP ORDER No.:   | 9700245396 |
| HEAT No. :  |              | T45432<br>T47853  |            |
| MATERIAL SPECIFICATION AND GRADE :  |              | X52N<br>Gr.6<br>Gr.B<br>Gr.C  |            |
| TYPE OF HEAT TREATMENT :  |              | NORMALIZED  |            |
| MINIMUM TEMPERATURE:  |              | 1652°F  |            |
|   |              |   |            |


 TŘINECKÉ ŽELEZÁŘNY, a.s.  
 Moravia Steel, s.r.o.  
 Ostrava-Vítkovice  
 705 01, Czech Republic  
 151  
 .....  
 Independent authorized agent

38873  
 6046

Ostrava-Vítkovice: 08.12.2016

tel: 00420/59/560/2160

Please purchase PDFStamp Command Line product to remove this watermark.  
<http://www.verypdf.com>



INSPECTION CERTIFICATE  
EN 10204.3.1

No.:  
30025095

Sheet:  
1 / 6

Vallourec Soluções Tubulares do Brasil S.A.  
Distrito Industrial, s/n - Jeceaba - MG - 35498-000 - Brasil

Trading Company: Sumitomo Corporation  
NSSMC work order: JYYS11870000  
Buyer: Nippon Steel & Sumitomo Metal Corporation  
Buyer Order No.: 7P185226906  
Customer: SUMITOMO CORPORATION OF AMERICAS  
Customer Order No / Item: RCH-222327/6  
Inspection Company: Vallourec Soluções Tubulares do Brasil S.A.

Destination Country: USA  
Work Order: 31634/10  
Material Number: 702987

Size (O.D. X W.T.): 12.750 inch X 0.375 inch  
Grade: X42R # B # B  
Standard: API SPEC 5L, 12.2012, 45TH EDITION # PSL 2

In accordance also with the standards:

ASTM A106M - 15 / ASTM A 530 - 12 / ASME SA-106M - 15 / ASTM A 530M - 12 / ASME SA-530M - 15 / ASME SA-530M - 15

Description of products: HOT ROLLED CARBON STEEL SEAMLESS PIPE HEAT TREATMENT - AS ROLLED, BEVELLED ENDS 30 DEG. Heat Treatment : AS ROLLED , BEVELLED ENDS 30 DEG.

Tolerance (Pipe Ends): Outside Diameter:- 0.063 \* / + 0.063

Tolerances: Outside Diameter: - 0.75 % / + 0.75 %

Tolerances: Wall Thickness: - 12.5 % / + 15.0 %

Internal Surface Protection: UV-VARNISH

Open Ends Protector: POLYETHYLENE CAP WITH HOLE

Length: RANDOM: 42.0 FT / 44.0 FT

Acceptance Length: RANDOM, 10 %, 38.0 FT / 42.0 FT

Standard Marking:

UNIT STENCILED: VSB LOGO API SPEC 5L 0867 API MONOGRAM MONTH/YEAR ASTM/ASME A/SA-106 A/SA-53 12.750 0.375 BR/X42R PSL2 SMLS JYYS11870000 HEAT NUMBER PIPE TALLY NO LENGTH B S

STED 2110 PSL/INDE WEIGHT NSSMC LOGO

Shipping Marking:

SUMITOMO CORPORATION OF AMERICAS HOUSTON P.O. NO. RCH-222327 MADE IN BRAZIL

VS

INSPECTION CERTIFICATE  
EN 10204.3.1

No.:  
30025095

Sheet:  
2 / 6

Valourec Soluções Tubulares do Brasil S.A.  
Distrito Industrial, s/n - Jeceaba - MG - 35498-000 - Brasil

| Sheet No. | Pieces | Length(m) | Weight(kg) | Length(ft) | Weight(lbs) |
|-----------|--------|-----------|------------|------------|-------------|
| 173201    | 40     | 532,67    | 40007      | 1747,8     | 88200       |
| 173202    | 64     | 832,66    | 62948      | 2764,8     | 138779      |
| 173203    | 80     | 1064,89   | 79064      | 3509,2     | 174303      |
| 173204    | 103    | 1767,03   | 101781     | 4484,8     | 224392      |
| 173207    | 10     | 131,97    | 9818       | 432,9      | 21646       |
| TOTAL     | 297    | 3939,16   | 293618     | 12922,8    | 647320      |

The product is satisfactory in the following tests/inspections:

Dimensional # Visual # Flattening Test # Electromagnetic Test : API 5L L2(N5)/O L4(N12.5)/L1 # Maximum Residual Magnetism : 30 GAUSS # Hydrostatic Test : 2110.0 PSI 5 s #

CHEMICAL COMPOSITION (%) Process: Electric Arc Furnace (EAF), heats fully killed

CEQ: C+Mn/6+(Si+Mo+V)/5+(Ni+Cu)/15

CE1: Cr + Cu + Mo + V CE2: Nb + V

| Sheet No. | Pipe No. | Analysis | C    | Mn   | Si    | Ni    | Cr   | Mo   | Cu   | Nb   | B    | Ti   | Ceq  | CE1   | CE2  |      |      |      |
|-----------|----------|----------|------|------|-------|-------|------|------|------|------|------|------|------|-------|------|------|------|------|
| 1201      | Ladle    | Min.     |      | 0.29 | 0.10  |       |      |      |      |      |      |      |      |       |      |      |      |      |
|           |          | Max.     | 0.20 | 1.20 | 0.025 | 0.015 | 0.40 | 0.30 | 0.30 | 0.15 | 0.40 | 0.06 | 0.05 | 0.001 | 0.04 | 0.42 | 1.00 | 0.06 |
| 1202      | Check1   | Min.     |      | 0.29 | 0.10  |       |      |      |      |      |      |      |      |       |      |      |      |      |
|           |          | Max.     | 0.20 | 1.20 | 0.025 | 0.015 | 0.40 | 0.30 | 0.30 | 0.15 | 0.40 | 0.06 | 0.05 | 0.001 | 0.04 | 0.42 | 1.00 | 0.06 |
| 1203      | Ladle    | Min.     | 0.15 | 1.10 | 0.012 | 0.004 | 0.27 | 0.04 | 0.14 | 0.03 | 0.10 | 0.03 | 0.00 | 0.000 | 0.00 | 0.38 | 0.34 | 0.03 |
|           |          | Max.     | 0.15 | 1.09 | 0.011 | 0.004 | 0.27 | 0.04 | 0.14 | 0.03 | 0.09 | 0.03 | 0.00 | 0.000 | 0.00 | 0.38 | 0.33 | 0.03 |
| 1204      | Check1   | Min.     | 0.14 | 1.09 | 0.011 | 0.004 | 0.27 | 0.04 | 0.14 | 0.03 | 0.09 | 0.03 | 0.00 | 0.000 | 0.00 | 0.37 | 0.33 | 0.03 |
|           |          | Max.     | 0.14 | 1.11 | 0.012 | 0.005 | 0.28 | 0.04 | 0.13 | 0.03 | 0.09 | 0.03 | 0.00 | 0.000 | 0.00 | 0.37 | 0.32 | 0.03 |
| 1205      | Check1   | Min.     | 0.15 | 1.10 | 0.012 | 0.006 | 0.28 | 0.04 | 0.13 | 0.03 | 0.09 | 0.03 | 0.00 | 0.000 | 0.00 | 0.38 | 0.32 | 0.03 |
|           |          | Max.     | 0.16 | 1.12 | 0.010 | 0.005 | 0.28 | 0.04 | 0.13 | 0.03 | 0.08 | 0.03 | 0.00 | 0.000 | 0.00 | 0.39 | 0.31 | 0.03 |
| 1206      | Ladle    | Min.     | 0.15 | 1.10 | 0.011 | 0.004 | 0.27 | 0.04 | 0.13 | 0.04 | 0.08 | 0.03 | 0.00 | 0.000 | 0.00 | 0.38 | 0.32 | 0.03 |
|           |          | Max.     | 0.16 | 1.08 | 0.011 | 0.005 | 0.28 | 0.04 | 0.13 | 0.03 | 0.08 | 0.03 | 0.00 | 0.000 | 0.00 | 0.39 | 0.31 | 0.03 |



INSPECTION CERTIFICATE  
EN 10204.3.1

No.:  
38025095

Sheet:  
3 / 6

Vallourec Soluções Tubulares do Brasil S.A.  
Distrito Industrial, s/n - Jezebra - MG - 35498-000 - Brasil

| Required         | Analysis | Min.   | C    | Mn    | P     | S     | Si   | Ni   | Cr   | Mo   | Cu   | V    | Nb    | B     | Ti   | Ceq  | CE1  | CE2  |
|------------------|----------|--------|------|-------|-------|-------|------|------|------|------|------|------|-------|-------|------|------|------|------|
| Product Analysis | Min.     |        |      | 0.29  |       |       | 0.10 |      |      |      |      |      |       |       |      |      |      |      |
|                  | Max.     | 0.20   | 1.20 | 0.025 | 0.015 | 0.015 | 0.30 | 0.30 | 0.15 | 0.40 | 0.06 | 0.05 | 0.001 | 0.04  | 0.42 | 1.00 | 0.06 |      |
| Product Analysis | Min.     |        |      | 0.29  |       |       | 0.10 |      |      |      |      |      |       |       |      |      |      |      |
|                  | Max.     | 0.20   | 1.20 | 0.025 | 0.015 | 0.015 | 0.40 | 0.30 | 0.30 | 0.15 | 0.40 | 0.06 | 0.05  | 0.001 | 0.04 | 0.42 | 1.00 | 0.06 |
| Heat No.         | Pipe No. |        |      |       |       |       |      |      |      |      |      |      |       |       |      |      |      |      |
|                  | 403110   | Check1 | 0.16 | 1.11  | 0.011 | 0.004 | 0.28 | 0.05 | 0.13 | 0.04 | 0.08 | 0.04 | 0.00  | 0.000 | 0.00 | 0.40 | 0.34 | 0.04 |
| 73204            |          | Ladle  | 0.15 | 1.11  | 0.012 | 0.007 | 0.28 | 0.04 | 0.13 | 0.05 | 0.08 | 0.03 | 0.00  | 0.000 | 0.00 | 0.39 | 0.33 | 0.03 |
|                  | 501110   | Check1 | 0.16 | 1.12  | 0.009 | 0.003 | 0.27 | 0.05 | 0.13 | 0.04 | 0.08 | 0.03 | 0.00  | 0.000 | 0.00 | 0.40 | 0.33 | 0.03 |
|                  | 501120   | Check2 | 0.15 | 1.09  | 0.010 | 0.004 | 0.28 | 0.05 | 0.13 | 0.04 | 0.08 | 0.03 | 0.00  | 0.000 | 0.00 | 0.38 | 0.33 | 0.03 |
| 73207            |          | Ladle  | 0.15 | 1.10  | 0.017 | 0.006 | 0.28 | 0.05 | 0.14 | 0.04 | 0.10 | 0.03 | 0.00  | 0.000 | 0.00 | 0.39 | 0.36 | 0.03 |
|                  | 201110   | Check1 | 0.15 | 1.10  | 0.013 | 0.006 | 0.28 | 0.05 | 0.12 | 0.02 | 0.08 | 0.03 | 0.00  | 0.000 | 0.00 | 0.38 | 0.30 | 0.03 |
|                  | 501110   | Check2 | 0.15 | 1.09  | 0.015 | 0.005 | 0.28 | 0.05 | 0.14 | 0.03 | 0.09 | 0.03 | 0.00  | 0.000 | 0.00 | 0.38 | 0.34 | 0.03 |

.. Combined Elements



INSPECTION CERTIFICATE  
EN 10204.3.1

No.:  
30025095

Sheet:  
4 / 6

Vallourec Soluções Tubulares do Brasil S.A.  
Distrito Industrial, s/n - Jezebra - MG - 35498-000 - Brasil

**TENSILE TEST** Direction: Longitudinal Temperature: Room Temperature Gauge Length: 100mm YS Method: 0.50 %  
Type of specimen: STRIP 1.5" WIDTH Thickness: 0.375"

| Item No. | Pipe No. | Position of Sample | YS    |       | E     |      |
|----------|----------|--------------------|-------|-------|-------|------|
|          |          |                    | (Psi) |       | %     |      |
| Required |          |                    | Min.  | 42100 | 70000 | 28.0 |
|          |          |                    | Max.  | 71800 | 95000 |      |
| 3201     | 101110   | Bottom             |       | 59200 | 81200 | 39.0 |
| 3202     | 503120   | Bottom             |       | 57300 | 80100 | 39.0 |
| 3203     | 201110   | Bottom             |       | 61200 | 81900 | 38.0 |
| 3204     | 501120   | Top                |       | 57700 | 79600 | 39.0 |
| 3204     | 502250   | Bottom             |       | 58200 | 79500 | 39.0 |
| 3207     | 501110   | Top                |       | 62800 | 82200 | 40.0 |

YS: yield strength; TS: tensile strength; E: Elongation

**IMPACT TEST** Test Specimen: CHARPY 10X55X7.5 V NOTCH Direction: Transverse Temperature: 32°F Striking tup: 0.315"

| Item No. | Pipe No. | Position of Sample | AE     |        |        |        | SA  |     |     | LE     |        |        |  |
|----------|----------|--------------------|--------|--------|--------|--------|-----|-----|-----|--------|--------|--------|--|
|          |          |                    | (FtLb) | (FtLb) | (FtLb) | (FtLb) | (%) | (%) | (%) | (Mils) | (Mils) | (Mils) |  |
| Required |          |                    | Min.   | 11     | 11     | 11     | 15  |     |     |        |        |        |  |
|          |          |                    | Max.   |        |        |        |     |     |     |        |        |        |  |
| 201      | 101110   | Bottom             | 42     | 49     | 41     | 44.3   | 46  | 58  | 55  |        |        |        |  |
| 202      | 503120   | Bottom             | 46     | 38     | 35     | 39.1   | 48  | 46  | 44  |        |        |        |  |
| 203      | 201110   | Bottom             | 46     | 49     | 38     | 45.0   | 49  | 58  | 60  |        |        |        |  |
| 204      | 501120   | Top                | 49     | 68     | 56     | 57.5   | 62  | 76  | 68  |        |        |        |  |
| 204      | 502250   | Bottom             | 38     | 40     | 49     | 42.8   | 50  | 49  | 63  |        |        |        |  |
| 207      | 501110   | Top                | 46     | 50     | 44     | 46.5   | 61  | 62  | 56  |        |        |        |  |

SA: absorbed energy; LE: lateral expansion



INSPECTION CERTIFICATE  
EN 10204.3.1

No.:  
30025095

Sheet:  
5/6

Vallourec Soluções Tubulares do Brasil S.A.  
Distrito Industrial, s/n - Jeceaba - MG - 35498-000 - Brasil

HARDNESS HV10

| Test No. | Pipe No. | Position Sample | Individual | Average | Variation | MW    |       |       |       |       | IW    |       |       |       |       | AVG Variation Total |
|----------|----------|-----------------|------------|---------|-----------|-------|-------|-------|-------|-------|-------|-------|-------|-------|-------|---------------------|
|          |          |                 |            |         |           | 1     | 2     | 3     | 4     | AVG   | 1     | 2     | 3     | 4     | AVG   |                     |
| 73201    | 401110   | Top             | Q1         | 159.0   | 160.0     | 160.0 | 162.0 | 171.0 | 172.0 | 169.0 | 172.0 | 177.0 | 173.0 | 173.0 | 174.0 |                     |
| 73202    | 402110   | Top             | Q1         | 158.0   | 159.0     | 158.0 | 159.0 | 165.0 | 168.0 | 168.0 | 169.0 | 163.0 | 163.0 | 163.0 | 165.0 |                     |
| 73203    | 403110   | Top             | Q1         | 158.0   | 157.0     | 157.0 | 158.0 | 166.0 | 166.0 | 163.0 | 167.0 | 162.0 | 163.0 | 163.0 | 160.0 |                     |
| 73204    | 402250   | Top             | Q1         | 157.0   | 158.0     | 157.0 | 156.0 | 164.0 | 165.0 | 164.0 | 167.0 | 169.0 | 165.0 | 168.0 | 163.0 |                     |
| 73204    | 501110   | Bottom          | Q1         | 159.0   | 159.0     | 159.0 | 158.0 | 174.0 | 174.0 | 168.0 | 171.0 | 175.0 | 172.0 | 175.0 | 174.0 |                     |
| 73207    | 201110   | Bottom          | Q1         | 157.0   | 159.0     | 157.0 | 160.0 | 173.0 | 171.0 | 172.0 | 174.0 | 167.0 | 166.0 | 167.0 | 168.0 |                     |

IW - Outer Wall; MW - Middle Wall; IW - Inner Wall;

REMARKS

THE PRESENTED WAS CONVERTED FROM SI MEASUREMENT SYSTEM USED FOR THE ORIGINAL INSPECTION. Since October 1st of 2016, VSB changed the company name from Vallourec Sumitomo Tubos do Brasil Ltda. to Vallourec Soluções Tubulares do Brasil S.A. (Jeceaba Plant), and changed the company logo. Please note that products marked with the company logo maybe included in the orders shipped after October, depending on the actual date of production.

ACE MR0103-2012/MR0175/ISO15155-2/2009. SATISFACTORY

MANUFACTURED FROM FULLY KILLED CARBON STEEL

STM A 106-C AND ASME SA 106-C : GUARANTEED NO WELD REPAIR



INSPECTION CERTIFICATE  
EN 10204.3.1

No.:  
30025095

Sheet:  
6 / 6

Valsobec Soluções Tubulares do Brasil S.A.  
Distrito Industrial, s/n - Itacaba - MG - 35498-000 - Brasil

We hereby certify that this product has been manufactured and examined in accordance with all requirements of the standards and specifications and all the results are found to be satisfactory.

This testimonial and certificate respectively is recorded by a computer system and is valid without signature. Alterations or use for others products are regarded as falsification of documents and will be subject to criminal jurisdiction.

QUALITY CONTROL DEPARTMENT

FAX: +55 31 3411 465

Email: carlos.horta@vstubos.com

Carlos Eduardo Lima Horta  
Technical Responsible  
Date : 07.11.2017



**ІНТЕРПАЙП**  
НТЗ

ПАТ "ІНТЕРПАЙП НИЖНЬОДНІПРОВСЬКИЙ ТРУБОПРОКАТНИЙ ЗАВОД"  
Франків, м. Дніпропетровськ, вул. Стоякова, 21  
Тел. факс: +38 (0562) 34-90-99

Замовник  
Customer

Сертифікат № 4/534  
Certificate №  
INSPECTION CERTIFICATE ACC. TO EN 10204-2004/3.1

Контракт №  
Contract №

Заказ № 631360/101  
Customer order № 13-1360  
Customer order #: PO #10415

№ транспортного средства BT 6933 AT / BT 6341 XT  
№ vehicle

Лист 1 Листов 1  
Sheet Sheet

| Наименование и код товара<br>Description and code of goods    | ИД<br>Standard   | Термообработка<br>Heat treatment |
|---|--|----------------------------------|
| SEAMLESS STEEL HOT-ROLLED PIPE<br>FOR LOW-TEMPERATURE SERVICE | ASTM A106/A 106M-2011/<br>ASME SA106-2010/<br>ASTM A53/A 53M-2012/<br>ASME SA53-2010/<br>ASTM A333/A333M-2011/<br>ASME SA333/A333M-2010<br>"acc. to latest editions" | Normalized                       |

| Маркировка/<br>Marking |                                | INTERPIPE<br>НТЗ              |                            | ASTM A106/ASME SA106/ASTM A53/ASME SA53/ASTM A333/ASME SA333 B/C 6<br>dimensions pipe S NDE length pipe weight pipe Heat number Hot-Rolled 49.61 lb/ft pipe<br>number PO#10415 |  |                 |                                       |  |   |                         |                         |
|------------------------|--------------------------------|-------------------------------|----------------------------|--|--|-----------------|---------------------------------------|--|---|-------------------------|-------------------------|
| № п.п.<br>№            | Номер партии<br>Number of heat | Номер партии<br>Number of lot | Марка стали<br>Grade steel | Размер, дюйм (мм)<br>Dimensions, in. (mm)<br>Диаметр<br>O.D.   |  | Толщина<br>W.T. | Длина<br>фул (м)<br>Length<br>ft. (m) | Метраж<br>фул (м)<br>Metreage<br>ft. (m) | К-во труб.<br>шт<br>Q-ty of<br>pipes, pcs | Вес, фунт (кг)<br>Gross | Weight, lb. (kg)<br>Net |
| Actual weight          |                                |                               |                            |  |  |                 |                                       |  |   |                         |                         |

|    |         |   |       |         |        |  |               |         |   |         |         |
|----|---------|---|-------|---------|--------|--|---------------|---------|---|---------|---------|
| 1. | 1133589 | 1 | B/C 6 | 12.750" | 0.375" |  | 38.1-39.4     | 76.5    | 2 | 3968.3  | 3946.3  |
|    |         |   |       | NPS 12" | Sch 40 |  | (11.60-12.00) | (23.31) | 2 | (1.810) | (1.790) |

|             |                                | Показатели качества товара<br>Quantity characteristics of goods             |       |       |        |        |       |       |       |        |        |        |        |
|-------------|--------------------------------|---|-------|-------|--------|--------|-------|-------|-------|--------|--------|--------|--------|
|             |                                | Химический состав, массовая доля %<br>Chemical composition, mass fraction % |       |       |        |        |       |       |       |        |        |        |        |
| № п.п.<br>№ | Номер партии<br>Number of heat | C   | Si    | Mn    | S      | P      | Cr    | Ni    | Cu    | Mo     | V      | Al     | Nb     |
|             |                                | x 100   | x 100 | x 100 | x 1000 | x 1000 | x 100 | x 100 | x 100 | x 1000 | x 1000 | x 1000 | x 1000 |
| 1.          | 1133589 H                      | 18  | 29    | 80    | 4      | 12     | 5     | 11    | 22    | 10     | 5      | 45     | 10     |
|             | 1133589 P                      | 18  | 26    | 85    | 6      | 11     | 6     | 10    | 21    | 11     | 5      | 42     | 0      |
|             |                                | 18  | 24    | 82    | 4      | 9      | 6     | 9     | 19    | 10     | 5      | 41     | 0      |

Cr+Cu+Ni+Mo+V ≤ 1 %

Продолжение на обороте The continuation on the back

**INTERPIPE**  
НТЗ

PJSC "INTERPIPE NIZHNEDNEPROVSKY TUBE ROLLING PLANT"  
UKR. LINE, Dnepropetrovsk, 21, Stoikova Str.  
Tel./fax: +38 (0562) 34-90-99

| Тип образца<br>Type of specimen<br>Strip       |                                | Размеры образца<br>Dimensions of specimen                      |  |  | Ориентация образца<br>Orientation of specimen<br>Longitudinal |                           |                                 |
|--|--------------------------------|--|--|--|---|---------------------------|---------------------------------|
|  |                                | Ширина, width: 1 1/2" (38.1 mm)<br>Длина, length: 2" (50.8 mm) |  |  |   |                           |                                 |
| Механические свойства<br>Mechanical properties |                                |  |  |  |   |                           |                                 |
| № п.п.<br>p.<br>No                             | Номер партии<br>Number of heat | Номер партии<br>Number of lot                                  | Предел прочности,<br>PSI (MPa)<br>Tensile strength,<br>PSI (MPa) | Предел текучести,<br>PSI (MPa)<br>Yield strength,<br>PSI (MPa) | Удлинение,<br>%<br>Elongation,<br>%                           | Сплюсывание<br>Flattening | Испытание на изгиб<br>Bend test |

|    |         |   |                                  |                                  |              |            |     |
|----|---------|---|----------------------------------|----------------------------------|--------------|------------|-----|
| 1. | 1133589 | 1 | 80 931 (558.0)<br>81 217 (560.0) | 58 220 (401.4)<br>59 017 (406.9) | 38.6<br>37.6 | Ok.<br>Ok. | Ok. |
|----|---------|---|----------------------------------|----------------------------------|--------------|------------|-----|

| № п.п.<br>p.<br>No  | Номер партии<br>Number of heat | Номер партии<br>Number of lot | Размеры образца<br>Dimensions of specimen<br>mm | Мин. работа на разрыв, фунт-фут (Дж)<br>Min. Charpy Energy, Ft.-Lbs. (J) |                        |                           |                        | Температура<br>-55 °F / -48 °C<br>Temp<br>-55 °F / -48 °C |      |      |      |      |                           |
|---|--------------------------------|-------------------------------|---|--|------------------------|---------------------------|------------------------|---|------|------|------|------|---------------------------|
|   |                                |                               |   | поперечн.<br>Transverse  |                        | продольн.<br>Longitudinal |                        |   |      |      |      |      |                           |
|   |                                |                               |   | радиус<br>fil size   | нестанд.<br>Non-stand. | радиус<br>fil size        | нестанд.<br>Non-stand. |   |      |      |      |      |                           |
| 1.  | 1133589                        | 1                             | 10x7.5x55                                       | 69.5   | 66.6                   | 66.6                      | 67.6                   | (94.2)(90.3)(90.3)-(91.6)                                 | 63.7 | 65.1 | 65.1 | 64.6 | (86.3)(88.3)(88.3)-(87.6) |
| Гидравлическое испытание, PSI (MPa)<br>Hydraulic test pressure, PSI (MPa) |                                |                               |   | Время выдержки, сек<br>Duration, sec                                     |                        |                           |                        |   |      |      |      |      |                           |

Номера труб (пакетов):  
Number of pipes (packages):

1, 1133589 NI 51 56

Total: 2 pipes. 1 package.

Примечания:

- Note: 1. We hereby certify that the all the above pipes have been manufactured, sampled, tested and inspected in strict compliance with ASTM A106/A106M-2011/ASME SA106-2010/ASTM A53/A53M-2012/ASME SA53-2010/ASTM A333/A333M-2011/ASME SA333/A333M-2010 (acc. to latest editions) and have been found to meet the requirements and terms of the standard and contract.
2. Nondestructive ultrasonic test – without remarks.
  3. Pipes with plastic caps.
  4. Dispatch was effected according to physical weight.
  5. Certificate 4/4698 is invalid.

04.02.2014

Дата/ Date

Печать/Stamp

Подпись/Signature





ОБЩЕСТВО С ОГРАНИЧЕННОЙ ОТВЕТСТВЕННОСТЬЮ  
 "ИНТЕРПАЙП НИКО ТЬЮБ"  
 Украина, г. Никополь, пр. Трубников, 56  
 Тел./факс +38 (05662) 2-10-70

ИНСПЕКЦИОННЫЙ СЕРТИФИКАТ № 5380  
 INSPECTION CERTIFICATE № 5380  
 EN 10204:2004/ 3.1

Грузополучатель North American Interpipe, Inc.  
 Consignee 1800 West Loop South, Suite 1350, Houston, Texas 77027,  
 USA

Контракт № 14-1289  
 Contract № (07-14-21218)

Страна USA  
 Country  
 Дата 31.10.2014г.  
 Date

Лист 1  
 Sheet  
 Листов 1  
 Sheets

№ транспортного средства ВТ3649ВА/ВТ0088ХР  
 № vehicle

ТРЕБОВАНИЯ ASTM A106/A106M-2011/ ASME SA106-2010/ ASTM A333/A333M-2011/ ASME SA333-2010  
 REQUIREMENTS Трубы стальные бесшовные горячекатаные для трубопроводов  
 Наименование товара SEAMLESS STEEL HOT ROLLEED PIPES FOR PIPELINES  
 Description of goods

| №<br>поз.<br>item<br>№ | Марка<br>стали<br>Steel grade<br>хрточое<br>обозн.<br>brief<br>designation | Код<br>товара<br>code of<br>goods | Номер<br>пакет<br>bundle<br>number | Номера<br>плавов<br>Heats<br>numbers | Номера<br>партий<br>Lots<br>number | Размеры<br>Dimensions |              |                           |              |                 |             | Количество<br>Quantity |                   |           |                 |              |                 |              |
|------------------------|--|-----------------------------------|------------------------------------|--------------------------------------|------------------------------------|-----------------------|--------------|---------------------------|--------------|-----------------|-------------|------------------------|-------------------|-----------|-----------------|--------------|-----------------|--------------|
|                        |  |                                   |                                    |                                      |                                    | диаметр<br>diameter   |              | толщина<br>wall thickness |              | длина<br>length |             | шт<br>pcs.             | метраж<br>metrage |           | масса<br>weight |              |                 |              |
|                        |  |                                   |                                    |                                      |                                    | мм<br>mm              | дюйм<br>inch | мм<br>mm                  | дюйм<br>inch | мм<br>mm        | фут<br>ft   |                        | м<br>m            | фут<br>ft | кг<br>kg        |              | фунт<br>lb      |              |
|                        |  |                                   |                                    |                                      |                                    |                       |              |                           |              |                 |             |                        |                   |           | брутто<br>gross | нетто<br>net | брутто<br>gross | нетто<br>net |
| 1.                     | 6/B  | 29376900                          | 4                                  | 1144852                              | 7162                               | 60.3                  | 2.375        | 5.5                       | 0.218        | 11600-<br>12500 | 38,1'-41,0' | 37                     | 446,59            | 1465,17   | 3 370           | 3 360        | 7 430           | 7 408        |
| 2.                     | *  | *                                 | 5                                  | 1144852                              | 7162                               | 60.3                  | 2.375        | 5.5                       | 0.218        | *               | *           | 37                     | 446,59            | 1465,17   | 3 340           | 3 330        | 7 363           | 7 341        |
| 3.                     | *  | *                                 | 7                                  | 1144852                              | 7179                               | 60.3                  | 2.375        | 5.5                       | 0.218        | *               | *           | 18                     | 210,60            | 690,93    | 1 600           | 1 590        | 3 527           | 3 505        |
| 4.                     | 6/B  | 29376900                          | 8                                  | 1144852                              | 7179                               | 60.3                  | 2.375        | 5.5                       | 0.218        | 11600-<br>12500 | 38,1'-41,0' | 18                     | 210,60            | 690,93    | 1 600           | 1 590        | 3 527           | 3 505        |
| NPS 2" SCH 80          |  |                                   |                                    |                                      |                                    | TOTAL:                |              |                           |              |                 |             | 110                    | 1314,38           | 4312,20   | 9 910           | 9 870        | 21 847          | 21 759       |
| BUNDLES:               |  |                                   |                                    |                                      |                                    | TOTAL:                |              |                           |              |                 |             | 4                      |                   |           |                 |              |                 |              |



LIMITED LIABILITY COMPANY  
 "INTERPIPE NIKO TUBE"  
 UKRAINE, Nikopol, 56, Trubnikov ave. Tel./fax +38 (05662) 2-10-70

Please purchase PDFStamp Command Line product to remove this watermark.  
<http://www.verypdf.com>

Инспекционный сертификат № 5380  
 Inspection certificate № 5380  
 Показатели качества товара  
 Quality characteristics

Лист . Листов  
 Sheet 1 Sheets 1

| Номер<br>плавки<br>Number<br>of heats | ХИМИЧЕСКИЙ СОСТАВ %% - CHEMICAL COMPOSITION %% |            |            |            |            |            |            |             |             |            |            | З-Д<br>поставщик      |
|---------------------------------------|--|------------|------------|------------|------------|------------|------------|-------------|-------------|------------|------------|-----------------------|
|                                       | C<br>x100                                      | Si<br>x100 | Mn<br>x100 | S<br>x1000 | P<br>x1000 | Cr<br>x100 | Ni<br>x100 | Ti<br>x1000 | Mo<br>x1000 | Cu<br>x100 | V<br>x1000 |                       |
| 1144852                               | 18   | 27         | 84         | 3          | 12         | 6          | 12         | 19          | 12          | 21         | 5          | ТОВ "МЗ "Днепросталь" |

Анализ плавки согласно сертификата завода-изготовителя  
 Heat analysis acc.to the manufacturer certificate.

РЕЗУЛЬТАТЫ ИСПЫТАНИЙ - TEST RESULTS

| Номер<br>позиции<br>№ | Lots<br>numbers<br>Номер<br>партии | Механические свойства - Mechanical properties                     |  |   |  |                      | Механические испытания произведены на<br>продольных образцах<br>Mechanical test was performed on longitudinal<br>standart<br>Ширина образца,мм/дюйм-19,0/3/4"<br>Breadth of standart,mm/inch<br>Длина образца,мм/дюйм-50,0/2"<br>Length of standart,mm/inch |  |
|-----------------------|------------------------------------|---|--|---|--|----------------------|---|--|
|                       |                                    | Условный<br>предел<br>текучести<br>Conventional<br>yield strength | Предел<br>прочности<br>при растяжении<br>на разрыв<br>Tensile strength | Относительное<br>удлинение<br>Percent<br>elongation | Тест на ударную<br>вязкость Шарпи<br>test<br>t=-45°C |                      |   |  |
|                       |                                    | N/mm2<br>N/mm2<br>PSI   | N/mm2<br>N/mm2<br>PSI  | %   | Футфунт<br>lb/ft                                     | Дж<br>J              |   |  |
|                       |                                    | min 240/<br>35000   | min 415/<br>60000  | min 20.5  |  |                      |   |  |
| 1.                    | 7162                               | 376 / 55000   | 517 / 75000  | 38.0  | 52 56 63<br>63 58 58                                 | 70 78 85<br>85 79 79 |   |  |
| 2.                    | 7179                               | 371 / 54000   | 512 / 74000  | 35.0  | 56 58 58<br>63 56 58                                 | 76 79 79<br>85 76 79 |   |  |

Трубы испытаны согласно требованиям ASTM A106/A106M-2011 / ASME SA106-2013/ASTM A333/A333M-2011/ASME SA333-2010,  
 результаты удовлетворительные  
 Tubes test according to requirements ASTM A106/A106M-2011 / ASME SA106-2013/ASTM A333/A333M-2011/ASME SA333-2010,result satisfactory.

Герметичность: ГИДРОИСПЫТАНИЕ УДОВЛЕТВОРИТЕЛЬНО, ИСПЫТАТЕЛЬНОЕ ДАВЛЕНИЕ 17,2МПа/2500PSI  
 ВРЕМЯ ВЫДЕРЖКИ НЕ МЕНЕЕ 5 СЕКУНД.  
 Leak-proofness: HYDROSTATIC TEST SATISFACTORY MINIMUM HYDRO-PRESSURE 17,2MPa/2500PSI  
 DURATION NOT LESS THEN 5SEC.

Технологические свойства- Technological properties  
 Pipes are bending tested with satisfactory result.  
 Трубы прошли испытание на загиб с удовлетворительным результатом.  
 Pipes are beveled.  
 Трубы отгружены с фаской.

Состояние поставки (поверхность) Трубы без покрытия. Трубы отгружены с колпачками.  
 Delivery condition (surface) Pipes are beveled. Pipes have caps.

Visual inspection of external and internal surfaces was performed with satisfactory results  
 Визуальный контроль наружной и внутренней поверхности выполнен с удовлетворительными результатами

All products were sampled, tested and inspected in accordance with specification(s) and found to meet the requirement.  
 Material is free mercury contamination.  
 Material is certified to ASTM A106-08/ASME SA106  
 Weld repair is not permitted.  
 Все продукты были отобраны, испытаны и проверены в соответствии со спецификациями.  
 Материал не содержит радиоактивных элементов и ртути.  
 Материал сертифицирован по ASTM A106-08/ASME SA106  
 Ремонт сварки запрещен.

Примечание: Ваши предложения по улучшению продукции просим направлять на эл. адрес Vladimir.Lysenko@nsp.interpipe.biz, по факсу  
 +380566221070 или по телефону +380568839371. При переписке просим ссылаться на номер сертификата  
 Note: You are requested to submit your proposals concerning product quality improvement to the following e-mail address:  
 Vladimir.Lysenko@nsp.interpipe.biz, fax +380566221070 or phone +380566639371. Please, refer in your mails to the certificate number.

Дата  
 Date 31.10.2014r.

Подпись

Inspector

REVIEWED BY  
 I. KLOKOV  
 03.11.2014



39 T.Moroz

*T.Moroz*

273 Genl. Hertzog Rd,  
Peacehaven Vereeniging 1939  
P O Box 48 Vereeniging 1930  
South Africa

Telephone +27 (0)16 450 4220  
Fax +27 (0)16 423 4906



Licensed under  
API Spec 5L and 5CT  
5L - 0319  
5CT - 0419

ISO 9001: 2008  
DE-395997 QM

Test Certificate  
EH 10204:2004 TYPE 3.1



Customer: Lee Supply Co., LLC  
Order No: 4000023284  
Certificate Reference No: 040062154224  
Product: FULLY KILLED HOT FINISHED CARBON STEEL SEAMLESS TUBES  
Specification: ISO3183:2012/API 5L:2012 L245/L290/B/X42 PSL1 ASTM A53B.12 A106B/C.15 A530.12 ASME SA53B.15 SA106B/C.15 SA530.15  
Product Marking: ARCELORMITTAL SA ISO3183/Spec 5L-0319 MONOGRAM 05-17 ASTM/ASME A/SA106B/C A53B 3.500 0.216 40.000 L245/B L290/X42 PSL1 SMLS TESTED 3000 psi CAST NO: 1700766 PROD/O NO: T0342328410 MADE IN SOUTH AFRICA NDE

Customer Order/Contract No: SUS4 155457  
Material No: 1000038304  
Cast/Heat No: 1700766

Page 1 of 1

**General Information**

| Quantity | Mass           | Dimensions |           |             | Total Length  |
|----------|----------------|------------|-----------|-------------|---------------|
|          |                | Tube OD    | Thickness | Length      |               |
| 208      | 63,175.370(lb) | 3.500(" )  | 0.216(" ) | 40.000 (ft) | 8,320.000(ft) |

| Steel making process | Final Rolling Operation   |
|----------------------|---|
| Basic Oxygen Furnace | As Rolled   |
|                      | Final hot rolling finished above 1580°F and cooled in still air |

**Chemical Composition**

| Element(%)    | R22-(V + Nb + Ti) |        |        |        |        | R24-(Nb + V) |        |        |        |        |        |        |        |        |        | R22    |        |        | R24    |        |   |
|---------------|-------------------|--------|--------|--------|--------|--------------|--------|--------|--------|--------|--------|--------|--------|--------|--------|--------|--------|--------|--------|--------|---|
|               | C                 | Si     | Mn     | S      | P      | Cr           | Ni     | Mo     | Cu     | V      | Al     | Ti     | Sn     | Ca     | N      | B      | Nb     | CE     | R22    | R24    |   |
| Minimum       | -                 | -      |
| Maximum       | 0.200             | -      | 1.30   | 0.030  | 0.030  | 0.50         | 0.50   | 0.150  | 0.500  | -      | -      | -      | -      | -      | -      | -      | -      | 0.41   | 0.15   | 0.060  |   |
| Heat          | 0.178             | 0.26   | 0.88   | 0.008  | 0.015  | 0.02         | 0.01   | 0.001  | 0.005  | 0.003  | 0.032  | 0.001  | 0.001  | 0.0016 | 0.0068 | 0.0005 | 0.0005 | 0.33   | 0.00   | 0.004  |   |
| Product       | 0.1777            | 0.2630 | 0.8760 | 0.0077 | 0.0152 | 0.0250       | 0.0110 | 0.0010 | 0.0050 | 0.0034 | 0.0319 | 0.0010 | 0.0014 | 0.0016 | 0.0068 | 0.0005 | 0.0005 | 0.3306 | 0.0049 | 0.0039 |   |
| Product (ADD) | 0.1777            | 0.2630 | 0.8760 | 0.0077 | 0.0152 | 0.0250       | 0.0110 | 0.0010 | 0.0050 | 0.0034 | 0.0319 | 0.0010 | 0.0014 | 0.0016 | 0.0068 | 0.0005 | 0.0005 | 0.3306 | 0.0049 | 0.0039 |   |

**Mechanical Properties**

| Specification | UTS (Rm) |       | Yield (0.5%) |       | % EL<br>2 inch |
|---------------|----------|-------|--------------|-------|----------------|
|               | MPa      | psi   | MPa          | psi   |                |
| Limits        |          | 70000 |              | 42000 | 30.0           |
| Minimum       |          |       |              |       |                |
| Maximum       |          |       |              |       |                |
| (1) Actual    |          | 70343 |              | 43366 | 38.0           |
| (2) Actual    |          | 70923 |              | 42786 | 40.0           |
| (3) Actual    |          |       |              |       |                |
| (4) Actual    |          |       |              |       |                |

|                                    | UTS (Rm)            |     | Yield (0.5%) |     | % EL<br>2 inch |
|------------------------------------|---------------------|-----|--------------|-----|----------------|
|                                    | MPa                 | psi | MPa          | psi |                |
| (5) Actual                         |                     |     |              |     |                |
| (6) Actual                         |                     |     |              |     |                |
| (7) Actual                         |                     |     |              |     |                |
| Orientation & type of tensile test | Longitudinal, Strip |     |              |     |                |
| Width of tensile piece (inch)      | 0.75 Inch           |     |              |     |                |
| Orientation of impact test piece   |                     |     |              |     |                |

| OTHER TESTS |                                |
|-------------|--------------------------------|
| Category    | Result                         |
| Hydrostatic | 3000 psi for 5 Sec             |
| NDI: EMI    | PASS - ASTM E570 - 12.5% NOTCH |
| NDI: UT     | UT not required                |
| HV 22 lbs   | 150 153 154                    |

**Remarks:**

Material in accordance with NACE MR0175:2015/ISO15156-2:2015, MR0103:2015. Dimensions to ASME B36.10M-2015. The material conform to the hot yield strength requirements as per ASME, Sect II, Pt D, Table Y-1, 2015. All the material conform to the visual and dimensional requirements and is made to a suitable fine grain practice.

Quality Assurance Manager: PJ Venter

Date of Release: 2017.05.26

Certified by:

I hereby certify that the material was manufactured, tested and inspected to and fully comply with the requirements of referenced specifications. No changes, amendments or additions may be made to this document. Any changes which are effected shall invalidate this certificate.


Please purchase PDFStamp Command Line product to remove this watermark.  
<http://www.verypdf.com>



ArcelorMittal South Africa Limited  
 Tubular Products  
 273 Genl. Hertzog Rd,  
 Peacehaven Vereeniging 1939  
 P O Box 48 Vereeniging 1930  
 South Africa

**MATERIAL TEST CERTIFICATE  
 SEAMLESS TUBE**

Telephone +27 (0)16 450 4220  
 Fax +27 (0)16 423 4906

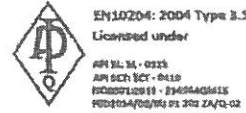

|   |   |
|---|---|
| Customer: Lee Supply Co., LLC   | Customer Order/Contract No: SUSO 156824 |
| Order No: 4000024274  | Material No: 1000042255                 |
| Certificate Reference No: 040062251290  | Cast/Heat No: 1707384                   |
| Product: FULLY KILLED HOT FINISHED CARBON STEEL SEAMLESS TUBES  | Page 1 of 1                             |
| Specification: ISO3183:2012/API 5L:12 L245/L290/B/X42 PSL1 ASTM A53B:12 A106B/C:15 A530:12 ASME SA53B:15 SA106B/C:15 SA530:15   |   |
| Product Marking: ARCELORMITTAL SA ISO3183/Spec 5L-0319 MONOGRAM 11-17 ASTM/ASME A/SA106B/C A53B 3.500 0.300 40.000 L245/B L290/X42 PSL1 SMLS TESTED 3000 psi CAST NO: 1707384 PROD/O NO: T0942427410 NDE MADE IN SOUTH AFRICA |   |

**General Information**

| Quantity | Mass           | Dimensions |           |             | Total Length  | Steel making process | Final Rolling Operation  |
|----------|----------------|------------|-----------|-------------|---------------|----------------------|--|
|          |                | Tube OD    | Thickness | Length      |               |                      |  |
| 114      | 46,829,275(lb) | 3.500(")   | 0.300(")  | 40,000 (ft) | 4,560,000(ft) | Basic Oxygen Furnace | As Rolled<br>Final hot rolling finished above 1580°F and cooled in still air |

**Chemical Composition**

| Element(%)    | R22-(V + Nb + Ti) |        |        |        |        |        |        | R24-(Nb + V) |        |        |        |        |        |        |        |        |        |        |      |        |        |   |
|---------------|-------------------|--------|--------|--------|--------|--------|--------|--------------|--------|--------|--------|--------|--------|--------|--------|--------|--------|--------|------|--------|--------|---|
|               | C                 | Si     | Mn     | S      | P      | Cr     | Ni     | Mo           | Cu     | V      | Al     | Ti     | Bn     | Ca     | N      | B      | Nb     | CE     | PCM  | R22    | R24    |   |
| Minimum       | -                 | -      |
| Maximum       | 0.280             | -      | 1.30   | 0.030  | 0.030  | 0.50   | 0.50   | 0.130        | 0.500  | -      | -      | -      | -      | -      | -      | -      | -      | 0.41   | -    | 0.15   | 0.060  |   |
| Heat          | 0.130             | 0.24   | 1.03   | 0.004  | 0.010  | 0.13   | 0.01   | 0.057        | 0.005  | 0.032  | 0.037  | 0.017  | 0.000  | 0.0016 | 0.0104 | 0.0003 | 0.0010 | 0.35   | 0.20 | 0.05   | 0.033  |   |
| Product       | 0.1300            | 0.2400 | 1.0300 | 0.0040 | 0.0100 | 0.1300 | 0.0130 | 0.0567       | 0.0050 | 0.0320 | 0.0370 | 0.0173 | 0.0001 | 0.0016 | 0.0104 | 0.0003 | 0.0010 | 0.3466 | -    | 0.0503 | 0.0330 |   |
| Product (ADD) | 0.1300            | 0.2400 | 1.0300 | 0.0040 | 0.0100 | 0.1300 | 0.0130 | 0.0567       | 0.0050 | 0.0320 | 0.0370 | 0.0173 | 0.0001 | 0.0016 | 0.0104 | 0.0003 | 0.0010 | 0.3466 | -    | 0.0503 | 0.0330 |   |

**Mechanical Properties**

| Specification | UTS (Rm) |       | Yield (0.5%) |       | % EL | UTS (Rm)                           |     | Yield (0.5%)        |     | % EL | OTHER TESTS |                                |
|---------------|----------|-------|--------------|-------|------|------------------------------------|-----|---------------------|-----|------|-------------|--------------------------------|
|               | MPa      | psi   | MPa          | psi   |      | MPa                                | psi | MPa                 | psi |      |             |                                |
| Minimum       | -        | 70000 | -            | 42000 | 30.0 | (6) Actual                         | -   | -                   | -   | -    | Category    | Result                         |
| Maximum       | -        | -     | -            | -     | -    | (6) Actual                         | -   | -                   | -   | -    | Flattening  | Passed                         |
| (1) Actual    | -        | 70923 | -            | 48877 | 39.6 | (7) Actual                         | -   | -                   | -   | -    | Hydrostatic | 3000 psi for 5 Sec             |
| (2) Actual    | -        | 71503 | -            | 49458 | 42.0 | Orientation & type of tensile test |     | Longitudinal, Strip |     | -    | NDI: EMI    | PASS - ASTM E570 - 12.5% NOTCH |
| (3) Actual    | -        | -     | -            | -     | -    | Width of tensile piece (inch)      |     | 0.75 inch           |     | -    | NDI: UT     | UT not required                |
| (4) Actual    | -        | -     | -            | -     | -    | Orientation of impact test piece   |     | -                   |     | -    | HV 22 lbs   | 153 153 153                    |

**Remarks:**

Material in accordance with NACE MR0175:15/ISO15156-2:15, MR0103:15. Dimensions to ASME B36.10M:15. End finish to ASME B16.25:15. Material conforms to the hot yield strength requirements as per ASME Sect II, Pt D, Table Y-1, 2015. Material conforms to the visual and dimensional requirements and is made to a suitable fine grain practice.

Quality Assurance Manager, Certification: R Van Vuuren

Date of Release: 2017.11.14

Certified by:

We hereby certify that the material was manufactured, tested and inspected to and fully comply with the requirements of referenced specifications. No changes, amendments or additions may be made to this document. Any changes which are effected shall invalidate this certificate.



**INSPECTION CERTIFICATE**

(BS EN 10204 3.1: 2004 - ISO 10474 3.1: 2013)

Number / Número:

845483

Page / Página:

1 / 8

Date / Día: March 30, 2017

Sidra S.A.I.C.  
Dr. Jorge A. Simón 250  
10200(MIA) Guapata  
Buenos Aires, Argentina  
(54) 3489 433100 int  
7413498 43305 fax

|   |  |   |  |   |  |  |  |
|---|--|---|--|---|--|--|--|
| Customer / Cliente:   |  | Customer's Order Item / Orden Cliente - Item:<br>214168-00007 |  | Customer's Reference / Ref. del Cliente:<br>N/A   |  | Manufacturer's Works Order N° / Confirmación de Venta:<br>51373/06 |  |
| Manufacturing Process / Proceso de Manufactura:<br>SEAMLESS HOT ROLLED  |  | Product Type / Tipo de Producto:<br>SMLS CARBON STEEL PIPE    |  | Surface / Superficie:<br>INT BARE / EXT VARNISHED |  |  |  |
| Standard or Specification / Normas o Especificaciones:<br>ASTM/ASME A/SA 333/106 +NACE MR0175/0103+TQ N°4 - 20013061 + PED 97/23/BC |  | Steel Grade / Grado de acero:<br>1/6/B                        |  | Ends / Extremos:<br>BEVELLED AT 30 DEG. ASTM      |  |  |  |
| Dimensions / Dimensiones:<br>3 1/2 X 0.300 INCH<br>88.90 X 7.62 MM  |  | Schedule / Cédula:<br>080                                     |  | Length / Longitud:<br>11.6/12.8 m                 |  | Quantity / Cantidad: 113 Pcs/pz<br>4541.63 FT<br>1384.29 MTS       |  |
|   |  |   |  | 47355 LB<br>21480 KG                              |  | Nominal Weight / Peso Nominal:<br>10.25 LB/FT<br>15.27 KG/M        |  |

**TENSILE TEST / ENSAYO DE TENSION**

| Heat N°<br>Colada N° | Sample N°<br>Muestra N° | Zone<br>Zona | Lot N°<br>Lote N° | Pipe N°<br>Tubo N° | Specimen condition<br>Condición de la probeta |    |              |     | Specimen dimensions<br>Dimensiones de la probeta |                 | Test temp.<br>Temp. ensayo | Y.S.<br>Req. |         | Elongation / Alargamiento |      |      |
|----------------------|-------------------------|--------------|-------------------|--------------------|---|----|--------------|-----|--|-----------------|----------------------------|--------------|---------|---------------------------|------|------|
|                      |                         |              |                   |                    | Ls  | Sc | Type<br>Tipo | Ori | Size<br>Tamaño                                   | Area<br>Sección |                            | Min: 35      | Min: 60 | Lo<br>2"                  | Min. | Obt. |
|                      |                         |              |                   |                    |   |    |              |     |  |                 |                            |              |         |                           |      |      |
| 42316                | 2783382                 | E1           | 62002             | 3                  | B   | AM | Ss           | L   | 0.755 ± 0.302                                    | 0.230           | RT                         | 46.7         | 66.6    | 50.8                      | 34.0 | 36.4 |
| 42316                | 2783383                 | E1           | 62002             | 5                  | B   | AM | Ss           | L   | 0.744 ± 0.289                                    | 0.225           | RT                         | 48.7         | 66.6    | 50.8                      | 34.0 | 35.6 |
| 79271                | 2783290                 | E1           | 62000             | 5                  | B   | AM | Ss           | L   | 0.754 ± 0.295                                    | 0.225           | RT                         | 46.5         | 66.7    | 50.8                      | 34.0 | 35.7 |
| 79271                | 2783291                 | E2           | 62000             | 45                 | B   | AM | Ss           | L   | 0.75 ± 0.31                                      | 0.235           | RT                         | 46.7         | 67.3    | 50.8                      | 34.0 | 36.7 |
| 79271                | 2783292                 | E2           | 62000             | 96                 | B   | AM | Ss           | L   | 0.754 ± 0.303                                    | 0.231           | RT                         | 46.0         | 66.0    | 50.8                      | 34.0 | 36.4 |
| 79271                | 2783293                 | E1           | 62000             | 25                 | B   | AM | Ss           | L   | 0.757 ± 0.304                                    | 0.232           | RT                         | 47.5         | 64.5    | 50.8                      | 34.0 | 35.8 |
| 79271                | 2783294                 | E1           | 62000             | 65                 | B   | AM | Ss           | L   | 0.75 ± 0.291                                     | 0.220           | RT                         | 46.3         | 64.4    | 50.8                      | 34.0 | 35.3 |
| 79271                | 2783294                 | E1           | 62001             | 103                | B   | AM | Ss           | L   | 0.75 ± 0.308                                     | 0.233           | RT                         | 46.3         | 66.3    | 50.8                      | 34.0 | 35.7 |
| 79271                | 2783294                 | E2           | 62001             | 105                | B   | AM | Ss           | L   | 0.752 ± 0.315                                    | 0.239           | RT                         | 46.0         | 64.4    | 50.8                      | 34.0 | 36.3 |

|  |  |   |  |
|--|--|---|--|
| AM: As manufactured / Según proceso de fabricación | Lo: Initial length / Longitud inicial            | Obt: Obtained / Obtenido                    | Sc: Specimen condition / Condición de la probeta |
| B: Body / Cuerpo                                   | Ls: Location of sample / Ubicación de la muestra | Ori: Orientation / Orientación              | Ss: Strip specimen / Muestra rectangular         |
| E1 / E2: Ends of Sampling / Extremos de Muestra    | Max: Maximum / Máximo                            | Req: Required / Requerido                   | U.T.S: Ultimate tensile strength / Resistencia   |
| L: Longitudinal / Longitudinal                     | Min: Minimum / Mínimo                            | RT: Room temperature / Temperatura ambiente | Y.S: Yield strength / Fluencia                   |

This certificate is issued by a computerized system and it is valid with electronic signature. On the original certificate the trade-mark green colored "Tenaris" is stamped. In case the owner of the original certificate would release a copy of it, he must attest its conformity to the original one taking upon himself the responsibility for any unlawful or not allowed use. Any alteration and/or falsification will be subjected to the law.

Este certificado se emite mediante sistema computarizado y es válido con firma electrónica. El certificado original posee impreso el logo "Tenaris" color verde. En caso de que el poseedor del certificado otorgue una copia, deberá garantizar la conformidad con el original haciéndose responsable por cualquier uso ilegal o indebido. Cualquier alteración y/o falsificación estará sujeta a la ley.





**INSPECTION CERTIFICATE**

(BS EN 10204 3.1: 2004 - ISO 10474 3.1: 2013)

Number / Número: **845483**  
Page / Página: **3 / 8**

Siderca S.A.I.C.  
Dr Jorge A. Simón 250  
BARRIO HACHA Campana  
Buenos Aires, Argentina  
(54) 3491 433100 int  
(54) 3491 433416 fax

|  |                               |  |   |  |
|--|-------------------------------|--|---|--|
| Customer / Cliente: <b>214168-00007</b>  |                               | Customer's Order Item / Orden Cliente - Item: <b>N/A</b>       | Customer's Reference / Ref. del Cliente: <b>N/A</b>                                     | Manufacturer's Works Order Nº / Confirmación de Venta: <b>51575/06</b> |
| Manufacturing Process / Proceso de Manufactura: <b>SEAMLESS HOT ROLLED</b>   |                               | Product Type / Tipo de Producto: <b>SMLS CARBON STEEL PIPE</b> |   | Surface / Superficie: <b>INT BARE/EXT VARNISHED</b>                    |
| Standard or Specification / Normas o Especificaciones: <b>ASTM/ASME A5A 333/106 +NACE MR0175/0103+TQ Nº4 - 20013061 + PED 97/23/EC</b> |                               | Steel Grade / Grado de acero: <b>1/6/B</b>                     | Ends / Extremos: <b>BEVELLED AT 30 DEG. ASTM</b>  |  |
| Dimensions / Dimensiones: <b>3 1/2 X 0.300 INCH<br/>88.90 X 7.62 MM</b>  | Schedule / Cédula: <b>080</b> | Length / Longitud: <b>11.6/12.8 m</b>                          | Quantity / Cantidad: <b>113 Pcs/ps<br/>4541.63 FT 47355 LB<br/>1384.29 MTS 21480 KG</b> | Nominal Weight / Peso Nominal: <b>10.25 LB/FT<br/>15.27 KG/M</b>       |

**SUPERFICIAL HARDNESS / DUREZA SUPERFICIAL**

| Heat Nº<br>Colada Nº | Sample Nº<br>Muestra Nº | Zone<br>Zona | Lot Nº<br>Lote Nº | Pipe Nº<br>Tubo Nº | Ls | External / Externa            |                            | Heat Nº<br>Colada Nº | Sample Nº<br>Muestra Nº | Zone<br>Zona | Lot Nº<br>Lote Nº | Pipe Nº<br>Tubo Nº | Ls | External / Externa            |                            |
|----------------------|-------------------------|--------------|-------------------|--------------------|----|-------------------------------|----------------------------|----------------------|-------------------------|--------------|-------------------|--------------------|----|-------------------------------|----------------------------|
|                      |                         |              |                   |                    |    | Scale / Escala: HBW/2.5/187.5 | Req. Min: -- Req. Max: 237 |                      |                         |              |                   |                    |    | Scale / Escala: HBW/2.5/187.5 | Req. Min: -- Req. Max: 237 |
| 42316                | 2783382                 | E1           | 62001             | 3                  | B  |                               | 132                        | 79271                | 2783292                 | E2           | 62000             | 96                 | B  |                               | 148                        |
| 42316                | 2783343                 | E1           | 62002             | 5                  | B  |                               | 140                        | 79271                | 2783358                 | E1           | 62001             | 103                | B  |                               | 153                        |
| 79271                | 2783291                 | E2           | 62000             | 45                 | B  |                               | 151                        | 79271                | 2783363                 | E2           | 62001             | 105                | B  |                               | 166                        |

B: Body / Cuerpo E1/E2: Ends of Sampling / Extremos de Muestra L: Location of sample / Ubicación de la muestra

**IMPACT TEST / ENSAYO DE IMPACTO**

| Type/Type: <b>Charpy V</b> |                         | Orientation/Orientación: <b>L</b> |                    |    |    | Unit / Unidad: <b>ft.lb</b>                  |               |  |                      |     |     |     |
|----------------------------|-------------------------|-----------------------------------|--------------------|----|----|--|---------------|--|----------------------|-----|-----|-----|
| Position/Posición:         |                         | Temp: <b>32</b>                   |                    |    |    | Ind.Min Req: <b>7</b> Req.Min.Avg: <b>10</b> |               |  |                      |     |     |     |
| Heat Nº<br>Colada Nº       | Sample Nº<br>Muestra Nº | Lot Nº<br>Lote Nº                 | Pipe Nº<br>Tubo Nº | Ls | Sc | T T<br>°F                                    | Size / Tamaño |  | Results / Resultados |     |     |     |
|                            |                         |                                   |                    |    |    |  | In            |  | 1                    | 2   | 3   | Avg |
| 42316                      | 2783382                 | 62002                             | 3                  | B  | AM | 32   | 0.39 ± 0.2    |  | 97                   | 106 | 89  | 97  |
| 79271                      | 2783292                 | 62000                             | 96                 | B  | AM | 32   | 0.39 ± 0.2    |  | 83                   | 83  | 99  | 88  |
| 79271                      | 2783358                 | 62001                             | 103                | B  | AM | 32   | 0.39 ± 0.2    |  | 91                   | 89  | 107 | 95  |

AM: As manufactured / Según proceso de fabricación Ind. Min. Req: Individual Minimum Required / Requerido Mínimo Individual L: Location of sample / Ubicación de la muestra Sc: Specimen condition / Condición de la probeta  
Avg: Average / Promedio Req. Min. Avg: Required minimum average / Promedio mínimo requerido T,T: Test temperature / Temperatura de ensayo  
B: Body / Cuerpo L: Longitudinal / Longitudinal mínimo requerido Temp: Temperature / Temperatura

This certificate is issued by a computerized system and it is valid with electronic signature. On the original certificate the trade-mark, green colored, "Tenaris" is stamped. In case the owner of the original certificate would release a copy of it, he must attest its conformity to the original one taking upon himself the responsibility for any unlawful or not allowed use. Any alteration and/or falsification will be subjected to the law.  
Este certificado se emite mediante sistema computarizado y es válido con firma electrónica. El certificado original posee impreso el logo Tenaris color verde. En caso de que el poseedor del certificado entregue una copia, deberá garantizar la conformidad con el original haciéndose responsable por cualquier uso ilegal o indebido. Cualquier alteración y/o falsificación estará sujeta a la ley.

Please purchase PDFStamp Command Line product to remove this watermark.  
<http://www.verypdf.com>



### INSPECTION CERTIFICATE

(BS EN 10204 3.1: 2004 - ISO 10474 3.1: 2013)

Number / Número: **845483**  
 Page / Página: **4 / 8**  
 Date / Día: **March 30, 2017**

Gilbert S. A. S.  
 Dr. Jorge A. Spina 260  
 (B2004MHA) Casapalca  
 Buenos Aires, Argentina  
 (54) 2400 430100 int  
 (54) 2400 430105 fax

|  |  |   |                                  |  |                           |  |                                |  |
|--|--|---|----------------------------------|--|---------------------------|--|--------------------------------|--|
| Customer / Cliente   |  | Customer's Order Item / Orden Cliente - Item: |                                  | Customer's Reference / Ref. del Cliente: |                           | Manufacturer's Works Order N° / Confirmación de Venta: |                                |  |
|  |  | 214168-00007                                  |                                  | N/A                                      |                           | 51575/06   |                                |  |
| Manufacturing Process / Proceso de Manufactura:                              |  |   | Product Type / Tipo de Producto: |  |                           | Surface / Superficie:                                  |                                |  |
| SEAMLESS HOT ROLLED  |  |   | SMLS CARBON STEEL PIPE           |  |                           | INT BARE/EXT VARNISHED                                 |                                |  |
| Standard or Specification / Normas o Especificaciones:                       |  |   |                                  | Steel Grade / Grado de acero:            |                           | Ends / Extremos:                                       |                                |  |
| ASTM/ASME A/S.A. 333/106 +NACE MR0175/01034+TQ N°4 - 20013061 + PED 97/23/EC |  |   |                                  | 1/6/B                                    |                           | BEVELLED AT 30 DEG. ASTM                               |                                |  |
| Dimensions / Dimensiones:  |  | Schedule / Cédula:                            | Length / Longitud:               |  | Quantity / Cantidad:      |  | Nominal Weight / Peso Nominal: |  |
| 3 1/2 X 0.300 INCH<br>88.90 X 7.62 MM  |  | D80   | 11.6/12.8 m                      |  | 4541.63 FT<br>1384.29 MTS |  | 47355 LB<br>21400 KG           |  |
|  |  |   |                                  |  |                           | 10.25 LB/FT  |                                |  |
|  |  |   |                                  |  |                           | 15.27 KG/M   |                                |  |

### IMPACT TEST / ENSAYO DE IMPACTO

|                     |            |                            |         |    |    |                                   |               |  |                      |     |    |      |
|---------------------|------------|----------------------------|---------|----|----|-----------------------------------|---------------|--|----------------------|-----|----|------|
| Type/Tipo: Charpy V |            | Orientation/Orientación: L |         |    |    | Unit / Unidad: Ft.Lb              |               |  |                      |     |    |      |
| Position/Posición:  |            | Temp: -65.2                |         |    |    | Ind. Min. Req: 5 Req. Min. Avg: 7 |               |  |                      |     |    |      |
| Heat N°             | Sample N°  | Lot N°                     | Pipe N° | Ls | Sc | T.T                               | Size / Tamaño |  | Results / Resultados |     |    |      |
| Colada N°           | Muestra N° | Lote N°                    | Tubo N° |    |    | °F                                | In            |  | 1                    | 2   | 3  | Avg. |
| 42316               | 2783382    | 62002                      | 3       | B  | AM | -65.2                             | 0.39 x 0.2    |  | 91                   | 83  | 83 | 86   |
| 79271               | 2783292    | 62000                      | 96      | B  | AM | -65.2                             | 0.39 x 0.2    |  | 78                   | 83  | 79 | 80   |
| 79271               | 2783358    | 62001                      | 103     | B  | AM | -65.2                             | 0.39 x 0.2    |  | 106                  | 111 | 80 | 99   |

|  |  |  |  |
|--|--|--|--|
| AM: As manufactured / Según proceso de fabricación | Ind. Min. Req: Individual Minimum Required / | Ls: Location of sample / Ubicación de la muestra   | Sc: Specimen condition / Condición de la probeta |
| Avg: Average / Promedio                            | Requerido Mínimo Individual                  | Req. Min. Avg: Required minimum average / Promedio | T.T: Test temperature / Temperatura de ensayo    |
| B: Body / Cuerpo                                   | L: Longitudinal / Longitudinal               | mínimo requerido                                   | Temp: Temperature / Temperatura                  |

|                     |            |---------------------|------------|----------------------------|---------|----|----|-----------------------------------|---------------|--|----------------------|---------------------------------------|----|------|----------------------|--|-----|------|------|------|------|------|
| Type/Tipo: Charpy V |            | Orientation/Orientación: L |         |    |    | Unit / Unidad: Ft.Lb              |               |  |                      | Shear area / Área de corte %          |    |      |                      | Lateral Expansion/Expansión Lateral mils |     |      |      |      |      |      |
| Position/Posición:  |            | Temp: -59.8                |         |    |    | Ind. Min. Req: 5 Req. Min. Avg: 7 |               |  |                      | Ind. Min. Req: --- Req. Min. Avg: --- |    |      |                      | Ind. Min. Req: --- Req. Min. Avg: ---    |     |      |      |      |      |      |
| Heat N°             | Sample N°  | Lot N°                     | Pipe N° | Ls | Sc | T.T                               | Size / Tamaño |  | Results / Resultados |                                       |    |      | Results / Resultados |  |     |      |      |      |      |      |
| Colada N°           | Muestra N° | Lote N°                    | Tubo N° |    |    | °F                                | In            |  | 1                    | 2                                     | 3  | Avg. | 1                    | 2  | 3   | Avg. |      |      |      |      |
| 42316               | 2783382    | 62002                      | 3       | B  | AM | -59.8                             | 0.39 x 0.2    |  | 80                   | 63                                    | 93 | 78   | 100                  | 100                                      | 100 | 100  | 59.0 | 76.0 | 80.0 | 71.7 |
| 79271               | 2783292    | 62000                      | 96      | B  | AM | -59.8                             | 0.39 x 0.2    |  | 107                  | 106                                   | 85 | 103  | 100                  | 100                                      | 100 | 100  | 71.0 | 71.0 | 82.0 | 74.7 |
| 79271               | 2783358    | 62001                      | 103     | B  | AM | -59.8                             | 0.39 x 0.2    |  | 88                   | 90                                    | 80 | 86   | 100                  | 100                                      | 100 | 100  | 81.0 | 84.0 | 64.0 | 76.3 |

|  |  |  |   |
|--|--|--|---|
| AM: As manufactured / Según proceso de fabricación | Requerido Mínimo Individual                  | Ls: Location of sample / Ubicación de la muestra   | T.T: Test temperature / Temperatura de ensayo |
| Avg: Average / Promedio                            | Ind. Min. Req: Individual Minimum Required / | Req. Min. Avg: Required minimum average / Promedio | Temp: Temperature / Temperatura               |
| B: Body / Cuerpo                                   | Requerido Mínimo Individual                  | mínimo requerido                                   |   |
| Ind. Min. Req: Individual Minimum Required /       | L: Longitudinal / Longitudinal               | Sc: Specimen condition / Condición de la probeta   |   |

This certificate is issued by a computerized system and it is valid with electronic signature. On the original certificate the trade-mark green colored "Tenaris" is stamped. In case the owner of the original certificate would release a copy of it, he must attest its conformity to the original one taking upon himself the responsibility for any unlawful or not allowed use. Any alteration and/or falsification will be subjected to the law.

Este certificado se emite mediante sistema computarizado y es válido con firma electrónica. El certificado original posee impreso el logo "Tenaris" color verde. En caso de que el poseedor del certificado entregue una copia, deberá garantizar la conformidad con el original haciéndose responsable por cualquier uso ilegal o indebido. Cualquier alteración y/o falsificación estará sujeta a la ley.

Please purchase PDFStamp Command Line product to remove this watermark.  
<http://www.verypdf.com>



**INSPECTION CERTIFICATE**

(BS EN 10204 3.1: 2004 - ISO 10474 3.1: 2013)

Number / Número: **845483**  
 Page / Página: **5 / 8**

Bidnos B A.L.C.  
 Dr. Jorge A. Serio CEO  
 (B2B04/HA) Olimpia  
 Olavarría Avda. Argentina  
 (54) 3499 433100 int  
 (54) 3499 433005 fax

Date / Día: **March 30, 2017**

|   |                           |   |  |  |   |  |  |
|---|---------------------------|---|--|--|---|--|--|
| Customer / Cliente:   |                           | Customer's Order Item / Orden Cliente - Item:<br>214168-00007 |  | Customer's Reference / Ref. del Cliente:<br>N/A  |   | Manufacturer's Works Order N° / Confirmación de Venta:<br>51575/06 |  |
| Manufacturing Process / Proceso de Manufactura:<br>SEAMLESS HOT ROLLED  |                           | Product Type / Tipo de Producto:<br>SMLS CARBON STEEL PIPE    |  | Surface / Superficie:<br>INT BARE /EXT VARNISHED |   |  |  |
| Standard or Specification / Normas o Especificaciones:<br>ASTM/ASME A/SA 333/106 +NACE MR0175/0103+TQ N°4 - 20013061 + FED 97/23/EC |                           | Steel Grade / Grado de acero:<br>1/4/B                        |  | Ends / Extremos:<br>BEVELLED AT 30 DEG. ASTM     |   |  |  |
| Dimensions / Dimensiones:<br>3 1/2 X 0.300 INCH<br>88.90 X 7.62 MM  | Schedule / Cédula:<br>080 | Length / Longitud:<br>11.6/12.8 m                             | Quantity / Cantidad: 113 Pcs/pz<br>4541.63 FT      47355 LB<br>1384.29 MTS      21480 KG |  | Nominal Weight / Peso Nominal:<br>10.21 LB/FT<br>15.27 KG/M |  |  |

**FLATTENING TEST / ENSAYO DE APLASTAMIENTO**

| Standard / Norma:         |                   |                         |    |                     | Standard / Norma:         |                   |                         |    |                     | Standard / Norma:         |                   |                         |    |                     |
|---------------------------|-------------------|-------------------------|----|---------------------|---------------------------|-------------------|-------------------------|----|---------------------|---------------------------|-------------------|-------------------------|----|---------------------|
| Heat N°<br>Calefacción N° | Lot N°<br>Lote N° | Sample N°<br>Muestra N° | LS | Result<br>Resultado | Heat N°<br>Calefacción N° | Lot N°<br>Lote N° | Sample N°<br>Muestra N° | LS | Result<br>Resultado | Heat N°<br>Calefacción N° | Lot N°<br>Lote N° | Sample N°<br>Muestra N° | LS | Result<br>Resultado |
| 42316                     | 62002             | 2783382                 | B  | Good / Bueno        | 79271                     | 62000             | 2783291                 | B  | Good / Bueno        | 79271                     | 62000             | 2783294                 | B  | Good / Bueno        |
| 42316                     | 62001             | 2783363                 | B  | Good / Bueno        | 79271                     | 62000             | 2783292                 | B  | Good / Bueno        | 79271                     | 62001             | 2783358                 | B  | Good / Bueno        |
| 79271                     | 62000             | 2783290                 | B  | Good / Bueno        | 79271                     | 62000             | 2783293                 | B  | Good / Bueno        | 79271                     | 62001             | 2783363                 | B  | Good / Bueno        |

B. Body / Cuerpo      LS: Location of sample / Ubicación de la muestra

**HYDROSTATIC TEST / PRUEBA HIDRAULICA**

| Pressure / Presión |               | Time / Tiempo      |  | Results / Resultado          |
|--------------------|---------------|--------------------|--|------------------------------|
| Unit / Unidad.     | Value / Valor | Seconds / Segundos |  |                              |
| psi                | 2,500         | 5                  |  | Satisfactory / Satisfactorio |

This certificate is issued by a computerized system and it is valid with electronic signature. On the original certificate the track-mark green colored "Tenaris" is stamped. In case the owner of the original certificate would release a copy of it, he must attest its conformity to the original one taking upon himself the responsibility for any unlawful or not allowed use. Any alteration under fabrication will be subjected to the law.

Este certificado se emite mediante sistema computarizado y es válido con firma electrónica. El certificado original posee impreso el logo "Tenaris" en color verde. En caso de que el poseedor del certificado entregue una copia, deberá garantizar la conformidad con el original haciéndose responsable por cualquier uso ilegal o indebido. Cualquier alteración y/o falsificación estará sujeta a la ley.



**INSPECTION CERTIFICATE**

(BS EN 10204 3.1: 2004 - ISO 10474 3.1: 2013)

Number / Número: 845483 Page / Página: 6 / 8

Date / Día: March 30, 2017

SIMONSA S.A.I.C.  
 Or Jorge A. Simons 250  
 (B280)MHA) Carapana  
 Buenos Aires, Argentina  
 (54) 2400 432100 ext  
 (54) 4400 433625 fax

|   |                    |   |   |  |
|---|--------------------|---|---|--|
| Customer / Cliente  |                    | Customer's Order Item / Orden Cliente - Item: | Customer's Reference / Ref. del Cliente:    | Manufacturer's Works Order N° / Confirmación de Venta: |
| 214168-00007  |                    | N/A   | 51575/06                                    |  |
| Manufacturing Process / Proceso de Manufactura:                           |                    | Product Type / Tipo de Producto:              | Surface / Superficie:                       |  |
| SEAMLESS HOT ROLLED   |                    | SMLS CARBON STEEL PIPE                        | BNT BARE /EXT VARNISHED                     |  |
| Standard or Specification / Normas o Especificaciones:                    |                    | Steel Grade / Grado de acero:                 | Ends / Extremos:                            |  |
| ASTM/ASME A/SA 333/106 +NACE MR0175/0103+TQ N°4 - 20013061 + PED 97/23/EC |                    | 1/6/B   | BRVELLED AT 30 DRG. ASTM                    |  |
| Dimensions / Dimensiones:   | Schedule / Cédula: | Length / Longitud                             | Quantity / Cantidad: 113 Pcs/pz             | Nominal Weight / Peso Nominal:                         |
| 3 1/2 X 0.300 INCH<br>88.90 X 7.62 MM                                     | 080                | 11.6/12.8 m                                   | 4541.63 FT 47355 LB<br>1384.29 MTS 21480 KG | 10.25 LB/FT<br>15.27 KG/M                              |

**HEAT TREATMENT / TRATAMIENTO TERMICO**

|   |                           |                        |                                  |
|---|---------------------------|------------------------|----------------------------------|
| Heat treatment / Tratamiento térmico: Pipe / Tubo                                       |                           |                        |                                  |
| Quench media of heat treatment process / Medio de enfriamiento del tratamiento térmico: |                           |                        |                                  |
| Temperature Scale / Escala de Temperatura: Celsius                                      |                           |                        |                                  |
| Type / Tipo   | Temperature / Temperatura | Tolerance / Tolerancia | Permanence / Permanencia (Mins.) |
| Normalized / Normalizado  | 850                       | -20 30                 | 24                               |

**SPECIAL REQUIREMENTS / REQUERIMIENTOS ESPECIALES\***

|                                       |   |
|---------------------------------------|---|
| Condition / Condición                 | Description / Descripción   |
| End protectors / Protector de extremo | NON LIFTABLE CLOSED PLASTIC PROTECTOR FOR FLAT / BEVELLED PIPE. SUPPLIER METALCENTRO. |

**SUPPLEMENTARY INFORMATION / INFORMACIÓN SUPLEMENTARIA**

Supplementary Information / Información Suplementaria

|   |   |
|---|---|
| "MELTED AND MANUFACTURED BY TENARIS SIDERCA - ARGENTINA"  | "FUNDIDO Y FABRICADO POR TENARIS SIDERCA - ARGENTINA"   |
| "ACERAGE PROCESS"   | "PROCESO DE ACERACIÓN"  |
| STEEL MAKING PROCESS: E.A.P./E. AND CONTINUOUS CASTING - FULL ALUMINIUM KILLED AND FINE GRAIN PRACTICE                | FABRICACIÓN DE ACERO: FUNDICIÓN POR ARCO ELÉCTRICO Y COLADO CONTINUO - ACERO CALMADO AL ALUMINIO Y PRACTICA DE GRAÑO FINO   |
| THE LP PRACTICE INCLUDES ARGON RINSE AND A FINAL INJECTION OF CALCIUM SILICIDE WIRE FOR MICROINCLUSION SHAPE CONTROL. | -LA PRACTICA DE AFINO EN EL HORNO - CUCHARA INCLUYE AGITACION POR ARGON Y UNA INYECCIÓN FINAL DE UNA VARILLA DE SILICIURO DE CALCIO PARA OBTENER UNA FORMA GLOBULAR DE EVENTUALES MICROINCLUSIONES. |
| MATERIAL FREE FROM MERCURY CONTAMINATION.   | MATERIAL LIBRE DE CONTAMINACIÓN DE MERCURIO.  |

This certificate is issued by a computerized system and it is valid with electronic signature. On the original certificate the trade-mark green colored "Tenaris" is stamped. In case the owner of the original certificate would release a copy of it, he must attest its conformity to the original one taking upon himself the responsibility for any unlawful or not allowed use. Any alteration and/or falsification will be subjected to the law.

Este certificado es emitido mediante sistema computarizado y es válido con firma electrónica. El certificado original posee impreso el logo "Tenaris" color verde. En caso de que el poseedor del certificado entregara una copia, deberá garantizar la conformidad con el original haciéndose responsable por cualquier uso ilegal o indebido. Cualquier alteración y/o falsificación estará sujeta a la ley.



**INSPECTION CERTIFICATE**

(BS EN 10204 3.1: 2004 - ISO 10474 3.1: 2013)

Number / Número:

845483

Page / Página:

7 / 8

Date / Día: March 30, 2017

Sitios: S.A.T.C.  
 Dr. Jorge A. Simón 200  
 (B260449A) Casapara  
 Buenos Aires, Argentina  
 (54) 3419 433100 int.  
 (54) 3419 835425 fax

|   |                    |   |  |  |
|---|--------------------|---|--|--|
| Customer / Cliente:   |                    | Customer's Order Item / Orden Cliente - Item: | Customer's Reference / Ref. del Cliente: | Manufacturer's Works Order Nº / Confirmación de Venta: |
|   |                    | 214168-00007                                  | N/A                                      | 51575/06   |
| Manufacturing Process / Proceso de Manufactura:                           |                    | Product Type / Tipo de Producto:              |  | Surface / Superficie:                                  |
| SEAMLESS HOT ROLLED   |                    | SMLS CARBON STEEL PIPE                        |  | INT BARE /EXT VARNISHED                                |
| Standard or Specification / Normas o Especificaciones:                    |                    |   | Steel Grade / Grado de acero:            | Ends / Extremos:                                       |
| ASTM/ASME A/SA 333/106 +NACE MR0175/0103+TQ N°4 - 20013061 + PED 97/23/EC |                    |   | 1/6/B                                    | BEVELLED AT 30 DEG, ASTM                               |
| Dimensions / Dimensiones:   | Schedule / Cédula: | Length / Longitud:                            | Quantity / Cantidad: 113 Pcs/pz          | Nominal Weight / Peso Nominal:                         |
| 3 1/2 X 0.300 INCH<br>88.50 X 7.62 MM                                     | 680                | 11.6/12.8 m                                   | 4541.63 FT<br>1384.29 MTS                | 47355 LB<br>21480 KG                                   |

**SUPPLEMENTARY INFORMATION / INFORMACIÓN SUPLEMENTARIA**

Supplementary Information  
 Información Suplementaria

|  |   |
|--|---|
| <p>*ROLLING PROCESS*</p> <p>-MANUFACTURING PROCESS: SEAMLESS HOT ROLLED</p> <p>*CONTROLS*</p> <p>-VISUAL AND DIMENSIONAL INSPECTION: SATISFACTORY.</p> <p>*MATERIAL CONDITIONS*</p> <p>-NOT REPAIRED BY WELDING.</p> <p>*STANDARDS*</p> <p>-EDICIÓN DE LA NORMA: ASTM A 106/A106M - 2015</p> <p>-EDICIÓN DE REGULACIÓN: ASTM A 333/A333M-16</p> <p>-EDICIÓN REGULACIÓN: ASME SA 106/ 2013</p> <p>-EDICIÓN REGULACIÓN: ASME SA 333/ 2013</p> <p>-EDICIÓN DE REGULACIÓN: NACE MR-01-03 EDICION 2012.</p> <p>-EDICIÓN DE REGULACIÓN: NACE MR 01-75 -2013 - ISO 15156-2 : 2009</p> | <p>*PROCESO DE LAMINACIÓN*</p> <p>-FABRICACIÓN DE TUBO: LAMINADO EN CALIENTE Y SIN COSTURA.</p> <p>*CONTROLES*</p> <p>-CONTROL VISUAL Y DIMENSIONAL: SATISFACTARIO.</p> <p>*CONDICIONES DEL MATERIAL*</p> <p>-NO REPARADO POR SOLDADURA.</p> <p>*NORMAS*</p> <p>-EDICION DE LA NORMA: ASTM A106/A 106M - 2015</p> <p>-EDICION DEL ANORMA ASTM A 333/A333M - 16</p> <p>-EDICIÓN DE LA NORMA: ASME SA 106/ 2013</p> <p>-EDICIÓN DE LA NORMA: ASME SA 333/ 2013</p> <p>-EDICIÓN DE LA NORMA: NACE MR-01-03 EDICION 2013</p> <p>-EDICIÓN DE LA NORMA: NACE MR 01-75 : 2013 - ISO 15156-2 : 2009</p> |
|--|---|

|  |
|--|
| <p>Additional Information<br/>                 Información Adicional</p> <p>NON DESTRUCTIVE TEST: SATISFACTORY.<br/>                 INSPECTION METHODS: E.M.I. LONG. (EXT.) NOT CH3N.<br/>                 STATEMENT SHOWING THAT MATERIAL IS FULLY KILLED AND MADE TO FINE GRAIN PRACTICE.</p> |
|--|

|   |
|---|
| <p>Additional Information<br/>                 Información Adicional</p> <p>CHARTY IMPACT TEST. VALUE OF ABSORBED ENERGY IN FOOTPOUNDS.<br/>                 MATERIAL COMPLIES WITH ALL REQUIREMENTS OF THE ORDER.<br/>                 SEE ATTACHED CERTIFICATE OF APPROVAL.</p> |
|---|

This certificate is issued by a computerized system and it is valid with electronic signature. On the original certificate the trade-mark green colored "Tenaris" is stamped. In case the owner of the original certificate would release a copy of it, he must attest its conformity to the original one taking upon himself the responsibility for any unlawful or not allowed use. Any alteration and/or falsification will be subjected to the law.

Este certificado se emite mediante sistema computarizado y es válido con firma electrónica. El certificado original posee Ingreso el logo "Tenaris" color verde. En caso de que el poseedor del certificado entregue una copia, deberá garantizar la conformidad con el original haciéndose responsable por cualquier uso ilegal o indebido. Cualquier alteración y/o falsificación estará sujeta a la ley.

Please purchase PDFStamp Command Line product to remove this watermark.  
<http://www.verypdf.com>



**INSPECTION CERTIFICATE**

(BS EN 10204 3.1: 2004 - ISO 10474 3.1: 2013)

Number / Número: Page / Página:

845483 8 / 8

Date / Día: March 30, 2017

Sistema S.A.I.C.  
Dr. Jorge A. Serrín 260  
(B2904MNA) Campaña  
Buenos Aires, Argentina  
(04) 3429 432100 ext  
(54) 3429 432100 ext


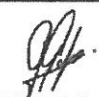
|   |  |   |  |  |  |   |  |
|---|--|---|--|--|--|---|--|
| Customer / Cliente:   |  | Customer's Order Item / Orden Cliente - Item: |  | Customer's Reference / Ref. del Cliente: |  | Manufacturer's Works Order N° / Confirmación de Venta:      |  |
|   |  | 214168-00007                                  |  | N/A                                      |  | 51575/06  |  |
| Manufacturing Process / Proceso de Manufactura:                           |  | Product Type / Tipo de Producto:              |  |  |  | Surface / Superficie:                                       |  |
| SEAMLESS HOT ROLLED   |  | SMLS CARBON STEEL PIPE                        |  |  |  | INT BARE /EXT VARNISHED                                     |  |
| Standard or Specification / Normas o Especificaciones:                    |  |   |  | Steel Grade / Grado de acero:            |  | Ends / Extremos:  |  |
| ASTM/ASME A/SA 333/106 +NACE MR0175/0103+TQ N°4 - 20013061 + PED 97/23/EC |  |   |  | 1/6/B                                    |  | REVELLED AT 30 DEG. ASTM                                    |  |
| Dimensions / Dimensiones:   |  | Schedule / Cédula:                            |  | Length / Longitud:                       |  | Quantity / Cantidad: 113 Pcs/pzs                            |  |
| 3 1/2 X 0.300 INCH<br>88.90 X 7.62 MM                                     |  | 080   |  | 11.6/12.8 m                              |  | 4541.63 FT 47355 LB<br>1384.29 MTS 21480 KG                 |  |
|   |  |   |  |  |  | Nominal Weight / Peso Nominal:<br>10.25 LB/FT<br>15.27 KG/M |  |

**MARKING / MARCACION**

|   |  |  |  |
|---|--|--|--|
| Marking / Marcación   |  | Marking / Marcación  |  |
| @ = Monogram / Monogram SIDERCA<br>NNNNN = Número de tubo / Mtr of pipe<br>LLL = Length / length<br>PPP = Peso / Weight |  | @ = Monogram / Monogram API<br>MM.YY = Mes / Año Month / Year<br>Y/T = Año / Trimestre Year / Quarter<br>HNDXXXX = Calada / Heat |  |
| Stenciling (Pipe) / Estarcido (Tubo)  |  | Stenciling (Pipe) / Estarcido (Tubo)   |  |
| TENARIS SD ASTM/ASME A/SA 333/106 UNB 3 HP L1-40F 3 XS SCH 80 NDB/ 250PIS PO 214168 HNDXXXX                             |  | NNNNN LLLL MADE IN ARGENTINA   |  |

This is to certify that the product described here has been manufactured, sampled, tested, and inspected in accordance with purchaser order requirements. This certificate is not a declaration of origin nor may it be used as a declaration of origin.

Por el presente certificamos que el material aquí descrito ha sido fabricado, muestreado, ensayado e inspeccionado de acuerdo a los requisitos de su orden de compra. Este certificado no es, ni puede ser usado, como una declaración de origen.


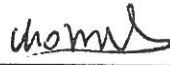

|   |  |   |  |
|---|--|---|--|
| CUSTOMER - THIRD PARTY  |  | TENARIS QUALITY DEPARTMENT SIGNATURE  |  |
| INSPECTION COMPANY<br>COMPAÑÍA DE INSPECCIÓN<br><br>Company Name: N/A<br>Employee Name: N/A |  | <br>QUALITY CERTIFICATION DEPT.<br>DEPTO. DE CERTIFICACIÓN DE CALIDAD<br>GONZALEZ Esteban                        |  |
|   |  | <br>CHIEF OF QUALITY CERTIFICATION DEPT.<br>RESPONSABLE DEL DEPTO. DE CERTIFICACIÓN DE CALIDAD<br>GAJO Gabriel |  |

This certificate is issued by a computerized system and it is valid with electronic signature. On the original certificate the trade-mark green colored "Tenaris" is stamped. In case the owner of the original certificate would release a copy of it, he must attest to conformity to the original one taking upon himself the responsibility for any unlawful or not allowed use. Any alteration and/or falsification will be subjected to the law.

Este certificado se emite mediante sistema computarizado y es válido con firma electrónica. El certificado original posee impreso el logo "Tenaris" color verde. En caso de que el poseedor del certificado emita una copia, deberá garantizar la conformidad con el original haciéndose responsable por cualquier uso ilegal o indebido. Cualquier alteración y/o falsificación estará sujeta a la ley.

Please purchase PDFStamp Command Line product to remove this watermark.  
<http://www.verypdf.com>

AMJ-QFM-QMO-LBT-088 Rev 0

|   |                 |   |               |  |                    |   |        |  |        |   |        |  |        |        |        |        |        |         |  |
|---|-----------------|---|---------------|--|--------------------|---|--------|--|--------|---|--------|--|--------|--------|--------|--------|--------|---------|--|
| <b>A01 ArcelorMittal Tubular Products Jubail</b><br>Crossroads 305 & 308 P.O. Box 10090<br>Jubail 2 Industrial City 51961<br>Kingdom of Saudi Arabia  |                 | <b>MILL TEST CERTIFICATE</b><br>A02 EN 10204-3.1                    |               | <b>A03 MTC No. 99001155 -10</b><br>A11 Certificate date: 12 10 2017              |                    |  |        |  |        |   |        |  |        |        |        |        |        |         |  |
| <b>A06.1 Customer:</b> ArcelorMittal International<br>1 S. Dearborn Street<br>60603 Chicago, IL   |                 | <b>A07 Packing List No:</b> 0099001155                              |               | <b>A10 Customer PO/ Date :</b> 10103550 / 19 July 2017                           |                    |   |        |  |        |   |        |  |        |        |        |        |        |         |  |
| <b>A06.2 Recipient:</b>   |                 | <b>A08.1 S.O. Number:</b> 0030000382 Items: 20                      |               | <b>A08.2 Invoice no:</b> 0175000285  |                    |   |        |  |        |   |        |  |        |        |        |        |        |         |  |
|   |                 | <b>A12. Total No Pipes:</b> 22                                      |               | <b>A13. Total Length:</b> 839.56 Ft  |                    | <b>A14. Total Weight:</b> 9207 Lb   |        |  |        |   |        |  |        |        |        |        |        |         |  |
| <b>B01, B09 - B11 Product :</b> Seamless Line Pipe,   |                 |   |               |  |                    |   |        |  |        |   |        |  |        |        |        |        |        |         |  |
| <b>B03.6 Product specification:</b> ASTM A106 Gr B/C -15 / ASME SA106 Gr B/C -15 / API 5L Gr B/X42 PSL 1 - 45th Edition 2012  |                 |   |               |  |                    |   |        |  |        |   |        |  |        |        |        |        |        |         |  |
| <b>B03.1 NPS/ Inch SIZE:</b> 4 x 0.237"   |                 | <b>B03.2 SIZE in mm:</b> 114.3 OD x 6.02 WT                         |               | <b>B03.3 Length:</b> 37' - 42' DFL   |                    | <b>B03.4 Part No.:</b>  |        |  |        |   |        |  |        |        |        |        |        |         |  |
| <b>B07.0 Heat no. 58130K</b>  |                 | <b>B07.1 Quality Lot Number:</b> QL0005793                          |               | <b>B07.2.1 Steel Supplier :</b> AM OSTRAVA AS                                    |                    | <b>B07.2.2 Number of pipes:</b> 22  |        |  |        |   |        |  |        |        |        |        |        |         |  |
|   |                 |   |               | <b>B07.3 Total length:</b> 839.56 Ft   |                    | <b>B07.4 Weight:</b> 9207 Lb  |        |  |        |   |        |  |        |        |        |        |        |         |  |
| <b>B03.4a Item No.:</b> 20  |                 |   |               |  |                    |   |        |  |        |   |        |  |        |        |        |        |        |         |  |
| <b>B03.5 End Condition:</b> BE - Bevel Ends, 30.0 deg   |                 |   |               |  |                    |   |        |  |        |   |        |  |        |        |        |        |        |         |  |
| <b>C70 Chemical composition %</b>   |                 |   |               |  |                    |   |        |  |        |   |        |  |        |        |        |        |        |         |  |
|   | C               | Mn  | Si            | S  | P                  | Cr  | Ni     | Mo   | Al     | Cu  | Nb     | V  | B      | Ti     | Ca     | CE (W) | Nb+V   | Nb+V+Ti |  |
| Min   |                 | 0.2900  | 0.1000        | 0.0300   | 0.0300             | 0.4000  | 0.4000 | 0.1500   |        | 0.4000  |        | 0.0800   | 0.0010 |        |        |        | 0.0600 | 0.1500  |  |
| Max   | 0.2800          | 1.3500  |               |  |                    |   |        |  |        |   |        |  |        |        |        |        |        |         |  |
| Heat : 58130K   | 0.1800          | 1.3000  | 0.1900        | 0.0020   | 0.0110             | 0.0600  | 0.0300 | 0.0020   | 0.0270 | 0.0500  | 0.0020 | 0.0010   | 0.0001 | 0.0010 | 0.0020 | 0.4100 | 0.0030 | 0.0040  |  |
| Pipe Id : EDW/F002  | 0.19            | 1.29  | 0.20          | 0.001  | 0.011              | 0.049   | 0.028  | 0.005  | 0.028  | 0.047   | 0.0011 | 0.0040   | 0.0001 | 0.0004 | 0.0021 | 0.42   | 0.005  | 0.006   |  |
| Pipe Id : EDW/F003  | 0.19            | 1.28  | 0.20          | 0.001  | 0.010              | 0.048   | 0.028  | 0.004  | 0.028  | 0.047   | 0.0010 | 0.0040   | 0.0001 | 0.0003 | 0.0018 | 0.41   | 0.005  | 0.006   |  |
| <b>Mechanical properties</b>  |                 |   |               |  |                    |   |        |  |        |   |        |  |        |        |        |        |        |         |  |
| M01 Heat no.  | M02 Quality Lot | Pipe Id   | Specimen Type | Orientation T/L  | Specimen Width/Dia | YS 0.5%EUL  | UTS    | %E 50.8 mm   |        |   |        |  |        |        |        |        |        |         |  |
|   |                 |   |               |  | [INCH]             | [PSI]   | [PSI]  | [%]  |        |   |        |  |        |        |        |        |        |         |  |
| 58130K  | QL0005793       | EDW/F002  | Strip         | L  | 1.00               | 52143   | 78958  | 35.93  |        |   |        |  |        |        |        |        |        |         |  |
| <b>G01 NDT test :</b> Full body UT as per ASTM E213 & End MPT as per ASTM E709, Ultrasonic Long Ext - 12.5 %, Ultrasonic Tran Ext - 12.5 %, Ultrasonic Tran Int - 12.5, End MPI- Both Ends ,Wall thickness Scan- 100 %.                                 |                 |   |               |  |                    |   |        |  |        |   |        |  |        |        |        |        |        |         |  |
| <b>G02.0 Hydro test:</b> STD, 2,660 PSI, 5 second - SATISFACTORY  |                 |   |               |  |                    |   |        | <b>G02.1 Color Code :</b> NA   |        |   |        |  |        |        |        |        |        |         |  |
| <b>R01 End MPT</b> carried out by Fluorescent Technique (Ends 350 mm)<br>Pipe supplied with Transparent Lacquer Coating   |                 |   |               | <b>B12 Mn 1.35 %</b> Max is permitted as per ASTM A106 Table 1 / API 5L Table 4. |                    |   |        | <b>B13 Steel Melting Practice</b> -EAF-LRF-VD-CC, Al & Si Killed, Fine grain Practice                              |        |   |        |  |        |        |        |        |        |         |  |
| <b>L01 Marking on pipe :</b> ArcelorMittal Jubail API Spec 5L 1026 API MONO MO-YR ASTM/ASME A/SA 106 GR B/C 4.500 0.237 (4 NPS SCH 40) B/X42 PSL1 SMLS PIPE :XXXXX 2660 PSI H:XXXXXX Lr:XXXX FT Wt:XXXX Lb PO:23.241 AMI PO: 10103550 ITEM# 20, COO:KSA |                 |   |               |  |                    |   |        |  |        |   |        |  |        |        |        |        |        |         |  |
| <b>Z01 We here with certify that the material is tested and complies to the product specification and customer requirement</b>  |                 |   |               |  |                    |   |        | <b>Z2.5.1 Prepared By</b><br> |        | <b>Z2.5.2 Approved By</b><br>for Md Tabanul Sumra |        |  |        |        |        |        |        |         |  |
| <b>Z02.3 Quality management system.</b><br>ISO 9001, ISO 17025, API Q1<br>ISO 18001, ISO 14001  |                 | <b>Z02.4 API LICENSE NUMBER</b><br>API 5L - 1026,<br>API 5CT - 1675 |               | <b>Z02.5: End Squareness</b> ≤1.80MM<br>Residual Magnetism ≤ 30.0 Gs             |                    |   |        |  |        |   |        |  |        |        |        |        |        |         |  |
| <b>Z02.6 L-Longitudinal, T-Transverso, YS-Yield Strength, UTS-Tensile Strength, Rc-Rectangular, Rd-Round, Fts-Full Screen; Hrd-Hardness, %E-Elongation, B-Body, U-Upset End, J-Joules, SA-Shear Area , MO-YR -Month-Year</b>                            |                 |   |               |  |                    |   |        |  |        |   |        |  |        |        |        |        |        |         |  |

Please purchase PDFStamp Command Line product to remove this watermark.  
<http://www.verypdf.com>





BOLY PIPE CO., LTD.

MILL TEST CERTIFICATES

Address: 7/342 M.6, T.Mayyapongon A.Pluakdaeng,

Rayong, 21140,Thailand

Phone Number:+66-33-010-907,+66-33-010-909



EN10204/3.1

BL/OR12-02

PAGE1 OF1

|               |          |---------------|----------|---|----|-------------------|----|--------------|----|--------------------|----|-------------------------------|---|---------------|----|----------------------------|-----|--------------------|-----------------------|---|------|---------------|--------|---------------------|----------|----------|--------|------------|----|----|--|
| CUSTOMER      |          |   |    |                   |    |              |    |                    |    |                               |   |               |    |                            |     | PRODUCT            |                       | PRIME NEWLY PRODUCED SEAMLESS LINE PIPE |      |               |        |                     |          |          |        |            |    |    |  |
| PURCHASER     |          |   |    |                   |    |              |    |                    |    |                               |   |               |    |                            |     | PO.NO              |                       | BWS17BPT026                             |      |               |        |                     |          |          |        |            |    |    |  |
| Standard      |          | ASTM A53-GRADE B 2012/ASME SA53-GRADE B 2015,ASTM A106-GRADE B 2015/ASME SA106-GRADE B 2015 ASTM A106-GRADE C 2015/ASME SA106-GRADE C 2015<br>API 5L B0X42 PSL-1 45 <sup>th</sup> ASTM A530-2012 NACE MR-017519015156   |    |                   |    |              |    |                    |    |                               |   |               |    |                            |     | INVOICE.NO:        |                       | BWS17BPT026-1A                          |      | API Cert. NO. |        | 5L-0956             |          |          |        |            |    |    |  |
| Grade         |          | B/CX42  |    |                   |    |              |    |                    |    |                               |   |               |    |                            |     | L/C NO.:           |                       |   |      | DATE          |        | 2017/10/12          |          |          |        |            |    |    |  |
| Size(OD*WT)   |          | 6.625*0.280"  |    |                   |    | Length range |    |                    |    | 40'(-Q/+Z')                   |   |               |    | Total Length (FT)          |     | 17853.84           |                       | Total Bundles                           |      | 66            |        | Order Quantity (MT) |          | 150.000  |        |            |    |    |  |
| Total Joints  |          | 437   |    | Total Weight (MT) |    | 155.148      |    | Delivery Condition |    | CHAMFER                       |   | Making Method |    | Hot Finished, Seamless     |     |                    |                       |   |      |               |        |                     |          |          |        |            |    |    |  |
| No.           | Heat No. | Chemical Composition (%)  |    |                   |    |              |    |                    |    |                               |   |               |    |                            |     | Batch No.          | Mechanical Properties |   |      | Impact Test   |        |                     | Hardness | Quantity | Length | Weight     |    |    |  |
|               |          | 1=X10,2=X100,3=X1000,4=X10000,5=X100000   |    |                   |    |              |    |                    |    |                               |   |               |    |                            |     |                    | (Temperature)         |   |      | HB            | Bundle | Jts                 |          |          |        |            | FT | MT |  |
|               |          | C   | SI | Mn                | P  | S            | Cr | Ni                 | Cu | Mo                            | V | Ti            | Nb | Al                         |     | R <sub>t</sub> 0.5 | R <sub>m</sub>        | A <sub>10%</sub>                        | Size | 1             | 2      | 3                   | AVG      | (AVG)    |        |            |    |    |  |
|               |          | min   |    |                   |    |              |    |                    |    |                               |   |               |    |                            |     | min                |                       |   |      |               |        |                     |          |          |        |            |    |    |  |
|               |          | max   |    |                   |    |              |    |                    |    |                               |   |               |    |                            | max | Ksi                |                       |   |      |               |        |                     |          |          |        |            |    |    |  |
| 1             | 17607172 | H   | 18 | 24                | 95 | 18           | 9  | 36                 | 2  | 2                             | 8 | 22            | 8  | 4                          | 33  |                    |                       |   |      |               |        |                     |          |          |        |            |    |    |  |
|               |          | P   | 18 | 24                | 95 | 19           | 8  | .35                | 2  | 2                             | 8 | 22            | 8  | 3                          | 32  |                    |                       |   |      |               |        |                     |          |          |        |            |    |    |  |
|               |          | P   | 17 | 24                | 97 | 19           | 9  | .35                | 2  | 2                             | 6 | 23            | 8  | 4                          | 35  |                    |                       |   |      |               |        |                     |          |          |        |            |    |    |  |
| 2             | 17607173 | H   | 18 | 25                | 95 | 19           | 8  | 34                 | 3  | 2                             | 6 | 25            | 5  | 4                          | 30  |                    |                       |   |      |               |        |                     |          |          |        |            |    |    |  |
|               |          | P   | 18 | 24                | 94 | 19           | 8  | 34                 | 3  | 2                             | 7 | 23            | 5  | 4                          | 32  |                    |                       |   |      |               |        |                     |          |          |        |            |    |    |  |
|               |          | P   | 18 | 24                | 95 | 19           | 7  | 34                 | 3  | 2                             | 7 | 25            | 5  | 5                          | 30  |                    |                       |   |      |               |        |                     |          |          |        |            |    |    |  |
| 3             | 17607177 | H   | 19 | 22                | 97 | 19           | 7  | 35                 | 3  | 3                             | 8 | 21            | 4  | 3                          | 32  |                    |                       |   |      |               |        |                     |          |          |        |            |    |    |  |
|               |          | P   | 18 | 22                | 97 | 19           | 8  | .35                | .3 | 3                             | 8 | 20            | 4  | 3                          | 31  |                    |                       |   |      |               |        |                     |          |          |        |            |    |    |  |
|               |          | P   | 18 | 22                | 97 | 18           | 7  | 35                 | 3  | 3                             | 7 | 20            | 4  | 3                          | 32  |                    |                       |   |      |               |        |                     |          |          |        |            |    |    |  |
| E.M.I         |          | ASTM E570 L4  |    |                   |    | U.T          |    | /                  |    | M.P.I                         |   | ASTM E709     |    | Coating                    |     | PASS               |                       | Visual                                  |      | PASS          |        | Pipe ends           |          | PASS     |        | Drift Test |    | /  |  |
|               |          | PASS  |    |                   |    |              |    |                    |    |                               |   | PASS          |    |                            |     |                    |                       |   |      |               |        | Land(1.6±0.8)mm     |          |          |        |            |    |    |  |
| Expansion     |          | Residual Magnesium Measurement  |    |                   |    | Flattening   |    | Bending            |    | Hydrostatic Test (2870PSI@6s) |   |               |    | Chamfer Inspection (30+5)* |     | Heat Treatment     |                       | O.D Size                                |      | I.D Size      |        | W.T.Measure         |          |          |        |            |    |    |  |
|               |          | PASS  |    |                   |    | PASS         |    | /                  |    | PASS                          |   |               |    | PASS                       |     | /                  |                       | PASS                                    |      | PASS          |        | PASS                |          |          |        |            |    |    |  |
| NOTES         |          | G.L=Gauge Length *1 Process C= Electric Furnace & Continuous Casting *2 Chemical Composition H=Heat(tadie)Analysis *3 Sampling Position P=Pipe Body *4 Size 2= StripTX25mm  |    |                   | INSPECTORS TO |          | WE HEREBY CERTIFY THAT THE MATERIAL HEREIN DESCRIBED HAS BEEN MANUFACTURED, SAMPLED, TESTED AND INSPECTED IN ACCORDANCE WITH THE REQUIREMENT  |    |                   |               |          | THE ABOVE SPECIFICATIONS AND PURCHASE ORDER.WE HEREBY CERTIFY THAT THE MATERIAL ARE MERCURY FREE / NO WELD REPAIR FINE GRAIN PRACTICE.MEETS H PER ANS/NACE MRD175/ISO 15156:2009.MEETS HARDNESS FOR NACE MR-0103.THIS MILL TEST CERTIFICATE IS ISSUED BY BOLY PIPE CO.,LTD AS THE MANUFACTURER.<br>COUNTRY OF MELT FOR BILLET:CHINA |    |                   |               |          
Please purchase PDFStamp Command Line product to remove this watermark.  
<http://www.verypdf.com>

No:http://www.verypdf.com/ Your Order 2345908-2-1 Your Order 18-2221DN Packing List 99924-1 (4/12/2018) Image 1/2989 (4/12/2018)

**ІНТЕРПАЙП**  
НТЗ

ПАТ "ІНТЕРПАЙП НИЖНЬОДНІПРОВСЬКИЙ ТРУБОПРОКАТНИЙ ЗАВОД"  
Україна, м. Дніпропетровськ, вул. Столетова, 21  
Тел.: +38 (0562) 35-92-50. Факс: +38 (0562) 35-83-89

ИНСПЕКЦИОННЫЙ СЕРТИФИКАТ № 141/5  
INSPECTION CERTIFICATE № EN 10204-20043.1

Группопачатель North American Interpipe, Inc. 1800 West Loop South, Suite 1350,  
BUYER Houston, Texas 77027

Контракт №  
Contract No

Страна USA  
Country

PO#

Транспортное средство № 60434826 /70/  
vehicle

№ заказа 771497/101  
Order # COC16/1497

Дата 20.01.2017.  
Date

Лист 2 / 2 Стр 3 / 4  
Sheet Page

| Наименование и код товара<br>Description and code of goods |                              | Требования НД<br>Standard requirements   |                            |                                 |  | Класс поставки<br>Class of delivery |   | Термообработка<br>Heat treatment |                                  |              |                                  |       |             |
|--|------------------------------|--|----------------------------|---------------------------------|--|-------------------------------------|---|----------------------------------|----------------------------------|--------------|----------------------------------|-------|-------------|
| Seamless steel hot-rolled pipes for pipelines              |                              | ASTM A106/A106M-2016 / ASME SA106/<br>SA106M-2016 / ASTM A53/A53M-2012 / ASME<br>SA53/SA53M-2016 / ASTM A333/A333M-2016 /<br>ASME SA333/SA333M-2016 / NACE MR0176-2015 /<br>NACE MR0103-2012 |                            |                                 |  |                                     |   | Нормализация<br>Normalized       |                                  |              |                                  |       |             |
| № лот<br>Lot No  | Номера пакетов<br>Package No | Номер трубы<br>Pipe No   | Марка стали<br>Steel Grade | Номер партии<br>Numbers of lots | Размеры<br>Dimensions                    |                                     |   |                                  | Количество<br>Quantity           |              |                                  |       |             |
|  |                              |  |                            |                                 | Краткое обозначение<br>Brief Designation | диаметр<br>Диаметр<br>Inch          | толщина стенок<br>или флокса<br>Добль<br>Inch | длина<br>length<br>Фут<br>Foot   | метраж<br>metrage<br>Фут<br>Foot | шт<br>pieces | Фактический вес<br>Actual weight |       | Фут<br>Foot |
| Фут<br>Foot  | Лб<br>Lb                     | Фут<br>Foot  | Лб<br>Lb                   |                                 |  |                                     |   |                                  |                                  |              |                                  |       |             |
| 1  | 1/20                         | 1-9  | 6/8/C                      | 1170114                         | 84                                       | 6.825                               | 0.280   | 39.37                            | 40.35                            | 357.38       | 9                                | 7.220 | 7.187       |
| 2  | 2/20                         | 10-20  | 6/8/C                      | 1170114                         | 84                                       | 6.825                               | 0.280   | 39.37                            | 40.35                            | 356.89       | 9                                | 7.231 | 7.178       |
| 3  | 3/20                         | 21-30  | 6/8/C                      | 1170114                         | 84                                       | 6.825                               | 0.280   | 39.37                            | 40.35                            | 358.40       | 9                                | 7.258 | 7.225       |
| 4  | 4/20                         | 32-34 36-42  | 6/8/C                      | 1170114                         | 84                                       | 6.825                               | 0.280   | 39.37                            | 40.35                            | 358.83       | 9                                | 7.258 | 7.225       |
| 5  | 5/20                         | 43, 44, 47-62, 64  | 6/8/C                      | 1170114                         | 84                                       | 6.825                               | 0.280   | 39.37                            | 40.35                            | 358.46       | 9                                | 7.275 | 7.242       |
| 6  | 6/20                         | 55-58, 61-63, 65   | 6/8/C                      | 1170114                         | 84                                       | 6.825                               | 0.280   | 39.37                            | 40.35                            | 357.51       | 9                                | 7.263 | 7.220       |
| 7  | 7/20                         | 66-71 73, 75, 77-79  | 6/8/C                      | 1170114                         | 84                                       | 6.825                               | 0.280   | 39.37                            | 40.35                            | 357.15       | 9                                | 7.248 | 7.198       |
| 8  | 8/20                         | 83-97  | 6/8/C                      | 1170114                         | 84                                       | 6.825                               | 0.280   | 39.37                            | 40.35                            | 358.88       | 9                                | 7.216 | 7.185       |
| 9  | 10/20                        | 99-104, 106, 108, 109  | 6/8/C                      | 1170114                         | 84                                       | 6.825                               | 0.280   | 39.37                            | 40.35                            | 356.59       | 9                                | 7.216 | 7.183       |
| 10   | 11/20                        | 110, 112-119, 120  | 6/8/C                      | 1170114                         | 84                                       | 6.825                               | 0.280   | 39.37                            | 40.35                            | 357.09       | 9                                | 7.271 | 7.216       |
| 11   | 12/20                        | 121-128, 130   | 6/8/C                      | 1170114                         | 84                                       | 6.825                               | 0.280   | 39.37                            | 40.35                            | 357.22       | 9                                | 7.203 | 7.169       |
| 12   | 13/20                        | 131, 132, 134, 137, 138-143  | 6/8/C                      | 1170114                         | 84                                       | 6.825                               | 0.280   | 39.37                            | 40.35                            | 356.92       | 9                                | 7.222 | 7.169       |
| 13   | 14/20                        | 146, 148-151   | 6/8/C                      | 1170114                         | 84                                       | 6.825                               | 0.280   | 39.37                            | 40.35                            | 356.92       | 5                                | 4.015 | 3.982       |
| 14   | 15/20                        | 152, 154, 156, 157, 158, 161-164   | 6/8/C                      | 1170114                         | 84                                       | 6.825                               | 0.280   | 39.37                            | 40.35                            | 357.15       | 8                                | 7.208 | 7.176       |
| 15   | 16/20                        | 165-168, 171-174   | 6/8/C                      | 1170114                         | 84                                       | 6.825                               | 0.280   | 39.37                            | 40.35                            | 357.15       | 8                                | 7.205 | 7.172       |
| 16   | 17/20                        | 170, 175-177   | 6/8/C                      | 1170114                         | 84                                       | 6.825                               | 0.280   | 39.37                            | 40.35                            | 358.83       | 4                                | 3.210 | 3.177       |
| 17   | 18/20                        | 178-185, 187   | 6/8/C                      | 1170114                         | 84                                       | 6.825                               | 0.280   | 39.37                            | 40.35                            | 357.32       | 9                                | 7.196 | 7.163       |
| 18   | 19/20                        | 186-188  | 6/8/C                      | 1170114                         | 84                                       | 6.825                               | 0.280   | 39.37                            | 40.35                            | 358.07       | 9                                | 7.267 | 7.174       |
| 19   | 20/20                        | 187-199  | 6/8/C                      | 1170114                         | 84                                       | 6.825                               | 0.280   | 39.37                            | 40.35                            | 119.29       | 3                                | 2.418 | 2.385       |

NPS 6 Sch 40

TOTAL 6195.50  
BUNDLES 19 156 126.334 124.644

**INTERPIPE**  
NTRP

PJSC "INTERPIPE NIZHNEPNEPROSKY TUBE ROLLING PLANT" 077969  
UKRAINE, Dnepropetrovsk, 21, Stoletova str.  
Tel.: +38 (0562) 35-92-50. Fax: +38 (0562) 35-83-89

Химический состав по сертификату данных на заготовку и результаты контрольных измерений  
Heat analysis acc. to the billet manufacturer certificate & results of control analysis of pipes

| № п/п<br>№ п/п<br>№ п/п | Лаборатория<br>Laboratory | Химический состав в %<br>Chemical composition % |            |            |            |            |            |            |           |             |             | Д  | V  | Nb | B | CEQ | Земля изготовитель<br>заводов<br>Manufacturer of pipes |
|-------------------------|---------------------------|---|------------|------------|------------|------------|------------|------------|-----------|-------------|-------------|----|----|----|---|-----|--|
|                         |                           | C<br>x100                                       | Mn<br>x100 | Si<br>x100 | P<br>x1000 | S<br>x1000 | Cr<br>x100 | Mo<br>x100 | W<br>x100 | Ni<br>x1000 | Al<br>x1000 |    |    |    |   |     |  |
|                         |                           | 20  | 100        | -          | 20         | 20         | 30         | 40         | 40        | 120         | 40          | 80 | 20 | 1  |   |     |  |
| 1170114                 | ОлегрSteel*               | 21  | 87         | 22         | 3          | 16         | 11         | 9          | 17        | 9           | 1           | 3  | 2  |    |   |     | MPE OlegrSteel LLC                                     |
| 1 1170114               | НТР**                     | 22  | 92         | 22         | 4          | 17         | 11         | 9          | 17        | 10          | 5           | 3  | 1  |    |   |     |  |
| 2 1170114               | НТР**                     | 22  | 82         | 22         | 4          | 17         | 11         | 9          | 17        | 10          | 5           | 5  | 1  |    |   |     | MPE OlegrSteel LLC                                     |

\*Анализ проведен согласно сертификату заготовочного материала  
Steel analysis is in accordance with the manufacturer's certificate  
Сталь произведена в итальянской структуре / Steel has been fully made and made to the steel grades  
Земельность изготовитель / Manufacturer been produced by the EAF with complete casting process  
Способ литья - сталь произведена на заводе ООО МЗ Днепропетр в электропечи с последующей обработкой Украины. 49051 Днепропетрск ул. Виноградная 4 Укр. Адрес +380562 371 50 40  
Method of melting - steel is produced by "MPE OLEGRSTEEL", LLC in Electric Arc Furnace with further treatment Ukraine. 49051 Dnepropetrovsk ul. Vynohradna 4 Ukr. Address +380562 371 50 40

Результаты испытаний - Test results

| № п/п<br>Item No | Номера литейной заготовки<br>Numbers of heat | Новая литейная заготовка<br>New casting<br>of lot | Испытание на растяжение / Tensile test |                                    |  | Механические свойства / Mechanical Properties |   |   | Прочие виды свойств / Other mechanical properties                  |                                      |               | Размер образцов<br>Specimens size, mm |               |      |        |
|------------------|--|---|--|------------------------------------|--|---|---|---|--|--------------------------------------|---------------|---------------------------------------|---------------|------|--------|
|                  |  |   | Предел прочности<br>Tensile strength   | Предел текучести<br>Yield strength | Относительное удлинение<br>Relative elongation | Средняя толщина<br>Average thickness          | Ширина образца<br>Width of specimen<br>mm | Длина образца<br>Length of specimen<br>mm | Твердость<br>Hardness<br>Acc to HRC<br>ISO 15-2013<br>HRC 150-2012 | Ударный импульс KV<br>Impact Test KV |               |                                       |               |      |        |
|                  |  |   |  |                                    |  |   |   |   |  | 30 °F<br>0 °F                        | 30 °F<br>0 °F |                                       | 30 °F<br>0 °F |      |        |
| 5-18             | 1170114                                      | 84  | 76370<br>76370                         | 49748<br>50615                     | 33.00<br>28.00                                 | Продольный<br>Longitudinal                    | 1   | 2.0                                       | 78.0 78.0 78.0   | <12                                  | 33.8          | 35.4                                  | 35.4          | 34.8 | 5 x 10 |

Прочие виды контроля - Other types of tests

| Вид испытаний<br>Type of test  | Параметры / Criteria   | Результаты / Results<br>HRC 6, max 42 |
|--|--|---------------------------------------|
| Испытание на ударное воздействие<br>Impact test  | NPS 6 max 40 100% / 2030 PSI / 5 sec   | Удовлетворительно<br>Acceptable       |
| Неразрушающий контроль<br>Non-destructive test<br>100%   | Продольная трещина 12.5% на средней поверхности<br>Longitudinal notch with depth 12.5% NDT on external surface | Удовлетворительно<br>Acceptable       |
| Сопоставление<br>Flattening  | По стандарту<br>As per Standard  | Удовлетворительно<br>Acceptable       |
| Визуальный контроль<br>внутренней и наружной поверхности<br>Visual inspection of internal and external surface | По стандарту<br>As per Standard  | Удовлетворительно<br>Acceptable       |
| Измерение геометрических параметров труб<br>Measurement of geometric parameters                                | По стандарту<br>As per Standard  | Удовлетворительно<br>Acceptable       |

\* Неразрушающий контроль труб изготовлен / Non-destructive test etc etc  
Состояние поставки - Delivery condition  
Трубы произведены методом горячей деформации и нормализованы в диапазоне температур 845°C - 846°C, выжаты на воздухе и соответствуют требованиям ASTM A182/A182M-2015 / ASME SA182/A182M-2015 / ASTM A333/A333M-2015 / ASME SA333/A333M-2015 / NACE MR0175-2015 / NACE MR0101-2012. Трубы не содержат свищей и руть.  
Pipes produced by Hot Forming process and followed by normalizing at the temperature 845 deg C 846 deg C cooled in air. Pipes are settled to the requirements of ASTM A182/A182M-2015 / ASME SA182/A182M-2015 / ASTM A333/A333M-2015 / ASME SA333/A333M-2015 / NACE MR0175-2015 / NACE MR0101-2012. Pipes are free from defects and rust.  
Pipes are settled to the requirements of ASTM A182/A182M-2015 / ASME SA182/A182M-2015 / ASTM A333/A333M-2015 / ASME SA333/A333M-2015 / NACE MR0175-2015 / NACE MR0101-2012. Pipes are free from defects and rust.  
Country of origin: Ukraine.

| Термообработка<br>Heat treatment | Нормализация<br>Normalizing  |
|----------------------------------|--|
| Покрытие<br>Coating              | Трубы покрыты черным лаком (IE 01-9002/2 вид 15)<br>Pipes are coated with black varnish (IE 01-9002/2 code 15)   |
| Концы<br>Ends                    | Трубы с фаской. Без обработки концов (фаска/BE) Трубы отгружены с пластиковыми колпачками<br>Pipes with bevelled ends. End-treatment BE (bevelled Ends) Pipes shipment with plastic caps |

Этот сертификат действителен только для перечисленных продуктов. Использование или некорректное использование данного сертификата строго запрещено. Нарушение может рассматриваться как подделка документов и подлежит уголовному преследованию.  
This certificate is only for the listed products. Modification or unauthorized use of the certificate is strictly prohibited. Violations can be considered as forgery and is subject to prosecution. You are requested to submit your proposals concerning product quality improvement to the following e-mail address:  
info@interpipe.biz, fax: +37148857412 or phone: +37148126622  
Специалист N.M.Ткаченко phone +380 662 288333.

Дата / Date: 20.01.2017  
Специалист / Specialist: М.М.Ткаченко / M.M.Tkachenko  
Подпись / Signature:





BOLY PIPE CO., LTD.

MILL TEST CERTIFICATES

Address: 7/342 M.6, T.Mapyangpon A Plaakdaeng,

Rayong, 21140, Thailand

Phone Number: +66-33-010-907, +66-33-010-909



EN10204/3.1

BLQR12-02

PAGE 1 OF 1

|               |          |---------------|----------|---|----|-------------------|----|---|----|--------------------|---------------|--------------------|----|----------------|----|----------|-----|------------------------|-----------------------|-------------|-----|-----------------|--------|------|----------|-----------|--------|--------|
| CUSTOMER      |          |   |    | PRODUCT           |    | PRIME NEWLY PRODUCED SEAMLESS LINE PIPE |    |                    | PURCHASER     |          |   |    | PO NO             |    | BWS17BPT025                             |    |                    | Standard      |          | ASTM A53-GRADE B 2012/ASME SA53-GRADE B 2015, ASTM A106-GRADE B 2015/ASME SA106-GRADE B 2015 ASTM A106-GRADE C 2015/ASME SA106-GRADE C 2015   |    | INVOICE NO:       |    | BWS17BPT025-1A                          |    |                    | API Cert. NO. |                    |    | 5L-0856        |    |          |     |                        |                       |             |     |                 |        |      |          |           |        |        |
| Grade         |          | B+C/X42   |    | U/C NO.:          |    |   |    |                    | DATE          |                    |    | 2017/10/30     |    |          |     |                        |                       |             |     |                 |        |      |          |           |        |        |
| Size(OD*WT)   |          | 6.625*0.432"  |    | Length range      |    | 40'(-0/+2')                             |    | Total Length (FT)  |               | 10056.16           |    | Total Bundles  |    | 61       |     | Order Quantity (MT)    |                       | 125,000     |     |                 |        |      |          |           |        |        |
| Total Joints  |          | 254   |    | Total Weight (MT) |    | 131.852                                 |    | Delivery Condition |               | CHAMFER            |    | Making Method  |    |          |     | Hot Finished, Seamless |                       |             |     |                 |        |      |          |           |        |        |
| No.           | Heat No. | Chemical Composition (%)  |    |                   |    |   |    |                    |               |                    |    |                |    |          |     | Batch No.              | Mechanical Properties |             |     | Impact Test     |        |      | Hardness | Quantity  | Length | Weight |
|               |          | 1=X10,2=X100,3=X1000,4=X10000,5=X100000   |    |                   |    |   |    |                    |               |                    |    |                |    |          |     |                        | Rt0.5 Rm A1%          |             |     | (Temperature)   |        |      |          |           |        |        |
|               |          | C   | Si | Mn                | P  | S                                       | Cr | Ni                 | Cu            | Mo                 | V  | Ti             | Nb | Al       |     | 1                      | 2                     | 3           | AVG | HB              | Bundle | Jls  | FT       | MT        |        |        |
| min           |          |   |    |                   |    |   |    |                    |               |                    |    |                |    |          | min |                        |                       |             |     |                 |        |      |          |           |        |        |
| max           |          | 28  |    | 108               | 30 | 30                                      | 40 | 40                 | 40            | 150                | 80 |                |    |          | max |                        |                       |             |     |                 |        |      |          |           |        |        |
| 1             | 4204171  | H   | 21 | 28                | 97 | 14                                      | 5  | 33                 | 2             | 1                  | 19 | 18             | 1  | 3        | 13  |                        |                       |             |     |                 |        |      |          |           |        |        |
|               |          | P   | 20 | 25                | 98 | 13                                      | 4  | 32                 | 2             | 1                  | 18 | 19             | 1  | 2        | 12  |                        |                       |             |     |                 |        |      |          |           |        |        |
|               |          | P   | 20 | 28                | 96 | 14                                      | 4  | 33                 | 2             | 1                  | 18 | 19             | 1  | 2        | 13  |                        |                       |             |     |                 |        |      |          |           |        |        |
| 2             | 4204423  | H   | 19 | 25                | 97 | 13                                      | 3  | 31                 | 1             | 1                  | 15 | 16             | 1  | 2        | 15  |                        |                       |             |     |                 |        |      |          |           |        |        |
|               |          | P   | 20 | 24                | 98 | 12                                      | 3  | 33                 | 1             | 1                  | 14 | 18             | 1  | 2        | 13  |                        |                       |             |     |                 |        |      |          |           |        |        |
|               |          | P   | 19 | 24                | 98 | 12                                      | 4  | 32                 | 1             | 1                  | 14 | 18             | 1  | 1        | 16  |                        |                       |             |     |                 |        |      |          |           |        |        |
| 2             | 4204624  | H   | 20 | 26                | 99 | 15                                      | 5  | 30                 | 1             | 1                  | 15 | 16             | 1  | 2        | 14  |                        |                       |             |     |                 |        |      |          |           |        |        |
|               |          | P   | 20 | 24                | 98 | 15                                      | 5  | 31                 | 1             | 1                  | 15 | 17             | 1  | 1        | 15  |                        |                       |             |     |                 |        |      |          |           |        |        |
|               |          | P   | 21 | 24                | 98 | 15                                      | 4  | 32                 | 1             | 1                  | 15 | 18             | 1  | 1        | 12  |                        |                       |             |     |                 |        |      |          |           |        |        |
| E.M.I         |          | ASTM E570 L4  |    | U.T               |    | /                                       |    | M.P.I              |               | ASTM E709          |    | Coating        |    | PASS     |     | Visual                 |                       | PASS        |     | Pipe ends       |        | PASS |          | Dirr Test |        |        |
|               |          | PASS  |    |                   |    |   |    |                    |               | PASS               |    |                |    |          |     |                        |                       |             |     | Lang(1.6±0.8)mm |        | PASS |          |           |        |        |
| Expansion     |          | Residual Magnetism Measurement  |    | Flattening        |    | Bending                                 |    | Hydrostatic Test   |               | Chamfer Inspection |    | Heat Treatment |    | O.D Size |     | I.D Size               |                       | W.T.Measure |     |                 |        |      |          |           |        |        |
|               |          | PASS  |    | PASS              |    | /                                       |    | PASS               |               | PASS               |    | /              |    | PASS     |     | PASS                   |                       | PASS        |     |                 |        |      |          |           |        |        |
| NOTES         |          | G.L.=Gauge Length *1 Process C= Electric Furnace & Continuous Casting *2 Chemical Composition H=Heat(jadle)Analysis *3 Sampling Position P=Pipe Body *4 Size 2= Skip TX26mm   |    |                   | INSPECTORS TO |          | WE HEREBY CERTIFY THAT THE MATERIAL HEREIN DESCRIBED HAS BEEN MANUFACTURED SAMPLED, TESTED AND INSPECTED IN ACCORDANCE WITH THE REQUIREMENT   |    |                   |               |          | THE ABOVE SPECIFICATIONS AND PURCHASE ORDER, WE HEREBY CERTIFY THAT THE MATERIAL ARE MERCURY FREE / NO WELD REPAIR FINE GRAIN PRACTICE, MEETS PER ANSUNACE MR0175/ISO 15156:2009, MEETS HARDNESS FOR NACE MR-0103, THIS MILL TEST CERTIFICATE IS ISSUED BY BOLY PIPE CO., LTD AS THE MANUFACTURER COUNTRY OF MELT FOR BILLET: CHINA |    |                   |               |          | G.A Signature   |    |                   
Please purchase PDFStamp Command Line product to remove this watermark. http://www.verypdf.com

**ІНТЕРПАЙП**  
НТЗ

ПАТ "ІНТЕРПАЙП НИЖНЬОДНІПРОВСЬКИЙ ТРУБОПРОКАТНИЙ ЗАВОД"  
Україна, м. Дніпропетровськ, вул. Столетова, 21  
Тел./факс +38(0562) 34-90-99

Заказчик  
Customer  
**North American Interpipe, Inc.**  
1800 West Loop South, Suite 1350,  
Houston, Texas 77027, USA

Сертифікат № 1532/5  
Certificate №  
INSPECTION CERTIFICATE ACC. TO EN 10204-2004/3.1

Контракт №  
Contract №

Заказ № 760908/102  
Customer order № СОС16/0908  
PO # 163591-00

№ транспортного средства 67870014 /69/  
№ vehicle

Лист/ Sheet 2 Стр/Page 3  
Листов/ Sheets 2 Страниц/ Pages 4

| Наименование и код товара<br>Description and code of goods |                                      |                                     |                                  |                                  | НД<br>Standard  |                              |                                  | Термообработка<br>Heat treatment           |                 |              |
|--|--------------------------------------|-------------------------------------|----------------------------------|----------------------------------|---|------------------------------|----------------------------------|--|-----------------|--------------|
| SEAMLESS STEEL HOT-ROLLED PIPES<br>FOR PIPELINES           |                                      |                                     |                                  |                                  | ASTM A106/A106M-2015/<br>ASME SA106/SA106M-2015/<br>ASTM A333/A333M-2016/<br>ASME SA333/SA333M-2015/<br>NACE MR0175-2015/<br>NACE MR0103-2012 |                              |                                  | Without heat treatment                     |                 |              |
|  |                                      |                                     |                                  |                                  |   |                              |                                  |  |                 | 6/B/C        |
| №<br>п.п.<br>р.<br>№                                       | Номер<br>плавки<br>Number<br>of heat | Номер<br>партии<br>Number<br>of lot | Марка<br>стали<br>Grade<br>steel | Размеры, дюйм<br>Dimensions, in. |   | Длина<br>фут<br>Length<br>ft | Метраж,<br>фут<br>Metreage<br>ft | К-во труб,<br>шт<br>Q-ty of<br>pipes, pcs. | Вес, фунт       |              |
|  |                                      |                                     |                                  | Диаметр<br>O.D.                  | Тол. ст.<br>W. T.   |                              |                                  |  | Брутто<br>Gross | Нетто<br>Net |
| 1.   | 1162655                              | 2337                                | "                                | 6.625                            | 0.432   | 39.70-40.03                  | 278.58                           | 7  | 8077.7          | 8011.6       |
| 2.   | 1162745                              | 2361                                | "                                | 4.500                            | 0.531   | 38.06-38.39                  | 878.58                           | 23   | 20315.6         | 20183.4      |
| Total:   |                                      |                                     |                                  |                                  |   |                              | 1157.16                          | 30   | 28393.4         | 28195.0      |

| Показатели качества товара<br>Quality characteristics of goods |                                      |   |          |          |           |           |          |          |          |           |           |           |
|--|--------------------------------------|---|----------|----------|-----------|-----------|----------|----------|----------|-----------|-----------|-----------|
| №<br>п.п.<br>р.<br>№   | Номер<br>плавки<br>Number<br>of heat | Химический состав, массовая доля %<br>Chemical composition, mass fraction % |          |          |           |           |          |          |          |           |           |           |
|  |                                      | C   | Si       | Mn       | S         | P         | Cr       | Ni       | Cu       | Mo        | V         | Al        |
|  |                                      | x<br>100  | x<br>100 | x<br>100 | x<br>1000 | x<br>1000 | x<br>100 | x<br>100 | x<br>100 | x<br>1000 | x<br>1000 | x<br>1000 |
| 1.   | 1162655 H                            | 24  | 22       | 87       | 3         | 12        | 8        | 9        | 15       | 8         | 2         | 35        |
|  | 1162655 P                            | 23  | 21       | 92       | 7         | 11        | 7        | 9        | 14       | 10        | 5         | 8         |
|  |                                      | 22  | 21       | 92       | 7         | 9         | 7        | 9        | 14       | 10        | 5         | 8         |
| 2.   | 1162745 H                            | 25  | 26       | 87       | 4         | 10        | 7        | 11       | 18       | 10        | 3         | 32        |
|  | 1162745 P                            | 26  | 25       | 89       | 6         | 8         | 7        | 11       | 20       | 13        | 5         | 37        |
|  |                                      | 25  | 25       | 89       | 6         | 8         | 7        | 11       | 20       | 12        | 5         | 36        |

Cr+Cu+Ni+Mo+V ≤ 1 %

Продолжение на обороте The continuation on the back

**INTERPIPE**  
NTRP

PJSC "INTERPIPE NIZHNE DNEPROVSKY TUBE ROLLING PLANT" 011423  
UKRAINE, Dnepropetrovsk, 21, Stoletova str.  
Tel./fax +38(0562) 34-90-99

Please purchase PDFStamp Command Line product to remove this watermark.  
<http://www.verypdf.com>

| Тип образца<br>Type of specimen | Размеры образца<br>Dimensions of specimen | Ориентация образца<br>Orientation of specimen |
|---------------------------------|---|---|
| Strip                           | Ширина, width: 1"<br>Длина, length: 2"    | Longitudinal                                  |

Механические свойства Mechanical properties

| № п.п.<br>p.<br>No | Номер плавки<br>Number of heat | Номер партии<br>Number of lot | Предел прочности,<br>PSI<br>Tensile strength,<br>PSI | Предел текучести,<br>PSI<br>Yield strength,<br>PSI | Удлинение,<br>%<br>Elongation,<br>% | Твердость по Роквеллу,<br>Hardness, |      | Сплюсывание<br>Flattening | Испытание на изгиб<br>Bend test |
|--------------------|--------------------------------|-------------------------------|--|--|-------------------------------------|-------------------------------------|------|---------------------------|---------------------------------|
|                    |                                |                               |  |  |                                     | HRC                                 | HRB  |                           |                                 |
| 1.                 | 1162655                        | 2337                          | 77326<br>70907                                       | 47165<br>43654                                     | 31.26<br>33.20                      | < 22                                | 77.5 | О.К.                      |                                 |
| 2.                 | 1162745                        | 2361                          | 81094<br>81606                                       | 48992<br>49201                                     | 33.75<br>32.56                      | < 22                                | 73.7 | О.К.                      |                                 |

| № п.п.<br>p.<br>No | Номер плавки<br>Number of heat | Номер партии<br>Number of lot | Размеры образца<br>Dimensions of specimen<br>mm | Мин. Работа разрушения, футо-фунт<br>Min. Charpy Energy, Ft.-Lbs. |                          |                            |                          | Испытательн.<br>Температура<br>(-50)°F<br>Test<br>Temperature<br>(-50)°F | Площадь сдвига<br>Shear area<br>% |
|--------------------|--------------------------------|-------------------------------|---|---|--------------------------|----------------------------|--------------------------|--|-----------------------------------|
|                    |                                |                               |   | поперечный<br>Transverse  |                          | продольный<br>Longitudinal |                          |  |                                   |
|                    |                                |                               |   | полномер.<br>Full size  | нестандар.<br>Non-stand. | полномер.<br>Full size     | нестандар.<br>Non-stand. |  |                                   |
| 1.                 | 1162655                        | 2337                          | 7.5x10  | Actual results<br>41.5 46.0 42.0 - 43.2                           |                          |                            |                          | 20<br>50   |                                   |
| 2.                 | 1162745                        | 2361                          | 10x10   | 42.9 42.0 47.6 - 44.2   |                          |                            |                          |  |                                   |

| Гидроиспытательное давление, PSI<br>Hydrostatic test pressure, PSI | Время выдержки, сек<br>Duration, sec |
|--|--------------------------------------|
| 2800   | min. 5                               |

Номера труб (пакетов):  
Number of pipes (packages):

6.625 x 0.432 1162655 - 8/10 42-44, 9/10 45-48.

4.500 x 0.531 1162745 - 1/5 1-7, 2/5 8-11; 14-16, 3/5 17-22, 4/5 13; 23-24.

Total: 6 packages.

Примечания:

- Note: 1. We hereby certify that above material has been manufactured, sampled, tested and inspected in accordance with ASTM A106/A106M-2015/ASME SA106/SA106M-2015/ASTM A333/A333M-2016/ASME SA333/SA333M-2015/ NACE MR 0175-2015/NACE MR 0103-2012 and has been found to meet requirements and terms of contract.
2. Nondestructive ultrasonic test - without remarks.
  3. Pipes with plastic caps.
  4. Pipes will be delivered with beveled ends.
  5. Pipes are varnished with black lacquer "UE 01-9502/2" code 15.
  6. Material have not been repaired by welding.
  7. Dispatch was effected according to physical weight.
  8. The presented data were converted from the applied measuring system (SI), used in the initial control.
  9. Method of melting - steel is produced by "MP "DNEPROSTEEL" LLC in Electric Arc Furnace with further treatment. Ukraine, 49051, Dnipropetrovsk, 4, Vinokurova Str. Tel./fax +38(056) 371 50 40
  10. Specialist T.V.Polozhevetc phone +380 562 358535.

Заводський  
інженер Т.В. Полізеветс



T.V.Polozhevetc

29.09.2016.  
Дата/ Date

Печать/Stamp

Подпись/Signature

NIK464 / 1170069 / 8.0A106STDF / 8 STD A106B SMLS PIPE

**ИНТЕРПАЙП**  
НИКО ТЬУБ

ОБЩЕСТВО С ОГРАНИЧЕННОЙ ОТВЕТСТВЕННОСТЬЮ  
"ИНТЕРПАЙП НИКО ТЬУБ"  
Украина, г. Никополь, пр. Трубиников, 56  
Тел./факс +38 (0566) 639-379

ИНСПЕКЦИОННЫЙ СЕРТИФИКАТ № 0861/6  
INSPECTION CERTIFICATE № 0861/6  
EN 16004-2004/2.1

Город/страна/адрес: North American Interpipe, Inc. 1400 West Loop South, Suite 1350  
BUYER: Houston, Texas 77027, USA

Контракт №: COC16/1487  
Сторона #:

Страна/страны: USA

Заказной номер: M005710  
Production order #  
Номер заказа клиента  
Customer's ref: IP20173

Транспортное средство №: AP688800AP2767X0  
Vehicle №:

Лист 1 / Всего 1  
Sheet / Sheets

Дата: 31.01.2017г.  
Date:

| Наименование и код товара<br>Description and code of goods  |                          | Наименование стандартов<br>Specifications   |  |                            |                                       |                       |                    |                       | Класс<br>Class of delivery | Тип резьбы<br>Thread type                    |                               |   |
|---|--------------------------|---|--|----------------------------|---------------------------------------|-----------------------|--------------------|-----------------------|----------------------------|--|-------------------------------|---|
| Трубы стальные бесшовные горячекатаные для трубопроводов<br>Seamless steel hot-rolled pipes for pipelines |                          | ASTM A106/A 106M-2015/ ASME SA106/A106M-2015/ ASTM A53/A53M-2015/ ASME SA53/A53M-2015/ NACE MR0175-2015/ NACE MR0103-2012 |  |                            |                                       |                       |                    |                       |                            |  |                               |   |
| №<br>No.  | Номер партии<br>Bundle # | Номер трубы<br>Pipe #   | Марка стали<br>Литера<br>обозначения<br>Steel<br>Designation | Номер<br>алюмин.<br>Heat # | Номер<br>серии<br>Inspection<br>Lot # | Размеры<br>Dimensions |                    |                       | Вес<br>Weight              | Фактический вес<br>Actual weight             |                               |   |
|   |                          |   |  |                            |                                       | OD<br>дюйм<br>inch    | WT<br>дюйм<br>inch | Length<br>футов<br>ft |                            | Теоретический<br>Theoretical<br>фунтов<br>lb | Масса<br>Mass<br>фунтов<br>lb | Масса нетто<br>Net weight<br>фунтов<br>lb |
| 1   | 17-38-02451              |   | B/ B/ C  | 1170278                    | 312                                   | 8.625                 | 0.322              | 38.1                  | 189.8                      | 5  | 5 587                         | 5 650                                     |
| 2   | 17-38-02450              |   | B/ B/ C  | 1170278                    | 312                                   | 8.625                 | 0.322              | 38.1                  | 189.9                      | 5  | 5 699                         | 5 848                                     |
| 3   | 17-38-02504              |   | B/ B/ C  | 1170278                    | 312                                   | 8.625                 | 0.322              | 38.1                  | 189.8                      | 5  | 5 600                         | 5 680                                     |
| 4   | 17-38-02548              |   | B/ B/ C  | 1170278                    | 312                                   | 8.625                 | 0.322              | 38.1                  | 151.8                      | 4  | 4 378                         | 4 385                                     |
| 5   | 17-38-02505              |   | B/ B/ C  | 1170278                    | 312                                   | 8.625                 | 0.322              | 38.1                  | 189.8                      | 5  | 5 680                         | 5 678                                     |
| 6   | 17-38-02592              |   | B/ B/ C  | 1170278                    | 312                                   | 8.625                 | 0.322              | 38.1                  | 151.9                      | 4  | 4 408                         | 4 398                                     |
| 7   | 17-38-01418              |   | B/ B/ C  | 1170069                    | 117                                   | 8.625                 | 0.322              | 38.1                  | 189.4                      | 5  | 5 634                         | 5 523                                     |
| 8   | 17-38-01419              |   | B/ B/ C  | 1170069                    | 117                                   | 8.625                 | 0.322              | 38.1                  | 189.5                      | 6  | 6 823                         | 6 612                                     |
| 9   | 17-38-01421              |   | B/ B/ C  | 1170069                    | 117                                   | 8.625                 | 0.322              | 38.1                  | 113.8                      | 3  | 3 373                         | 3 382                                     |
| NPS 8   |                          | Sch 40 STD  |  | TOTAL/ИТОГО                |                                       | 1696.7                |                    | 41                    | 48 627                     | 48 428                                       |                               |   |



LIMITED LIABILITY COMPANY "ИНТЕРПАЙП"  
"INTERPIPE NIKO TUBE"  
UKRAINE, Nikopol, 56, Trubnikoviy pr. TEL/fax: +38 (0566) 639-379



Please purchase PDFStamp Command Line product to remove this watermark.  
http://www.verypdf.com

Химический состав по сертификатам дается на заготовку в результате контроля химического состава металла труб  
Heat analysis acc. to the heat manufacturer certificate & results of chemical analysis of pipes

| Номер партии / Heat # | Лаборатория / Laboratory  | Химический состав в % / Chemical composition % |         |         |         |         |         |         |         |          |         |          |         |                   | Источники металла / Steel supplier |   |
|-----------------------|---------------------------|--|---------|---------|---------|---------|---------|---------|---------|----------|---------|----------|---------|-------------------|------------------------------------|---|
|                       |                           | C x100   | Mn x100 | Si x100 | S x1000 | P x1000 | Cr x100 | Ni x100 | Cu x100 | Mo x1000 | V x1000 | Nb x1000 | CE x100 |                   |                                    |   |
| max                   |                           | 30   | 100     | -       | -       | -       | -       | -       | -       | -        | -       | -        | -       | -                 | -                                  | - |
| 1170069               | ДнепроСталь / ДНЕПРОСТАЛЬ | 22   | 89.5    | 25      | 8       | 10      | 7.3     | 9.2     | 14.7    | 0        | 3       | 2        | 40.2    | "ДНЕПРОСТАЛЬ" ООО |                                    |   |
|                       | НИКОУБЕ                   | 23   | 89      | 25      | 10      | 11      | 7       | 10      | 15      | 10       | 1       | 1        | 41.1    | "ДНЕПРОСТАЛЬ" ООО |                                    |   |
|                       | НИКОУБЕ                   | 23   | 90      | 25      | 8       | 10      | 7       | 10      | 15      | 10       | 2       | 2        | 41.3    | "ДНЕПРОСТАЛЬ" ООО |                                    |   |
| 1170278               | ДнепроСталь / ДНЕПРОСТАЛЬ | 22.5   | 85.7    | 24.7    | 6       | 12      | 10.5    | 10.6    | 16.5    | 11       | 3       | 2        | 41      | "ДНЕПРОСТАЛЬ" ООО |                                    |   |
|                       | НИКОУБЕ                   | 24   | 88      | 25      | 7       | 12      | 10      | 10      | 16      | 11       | 1       | 2        | 42.8    | "ДНЕПРОСТАЛЬ" ООО |                                    |   |
|                       | НИКОУБЕ                   | 23   | 88      | 20      | 6       | 12      | 10      | 10      | 16      | 11       | 1       | 1        | 41.6    | "ДНЕПРОСТАЛЬ" ООО |                                    |   |

Анализ химического состава сертификата заготовки изготовитель не выдал, в соответствии с сертификатом. \*control analysis of pipes\* - контрольный анализ от труб.  
Сталь произведена методом прокатки в водородной печи с последующей нормализацией. Сталь имеет следующие характеристики: Сталь имеет следующие характеристики: Сталь имеет следующие характеристики.  
Address of the manufacturer: Ukraine, 40051, Dnipropetrovsk, ul. Vynohorivsk, 4 / Steel has been produced by the EAF with continuous casting process. Steel is fully killed and made to fine grain practice. Alternatively killed steel. The address of steel supplier: Ukraine, 40051, Dnipropetrovsk, 4 Vynohorivsk str. При расчете углеродного эквивалента использована формула: When calculating the carbon equivalent the following formula was used:  $CE=C+Mn/6+Cr+Mo+V/5+(Nb+Cu)/15$

Размеры и свойства труб - Test results for pipes

| Номер партии / Heat # | Номер партии / Lot # | Механические свойства / Mechanical Properties |                                   |                                  |   |  |  |                                 |                                     |                                |                                       |                                |                                     |                                |
|-----------------------|----------------------|---|-----------------------------------|----------------------------------|---|--|--|---------------------------------|-------------------------------------|--------------------------------|---------------------------------------|--------------------------------|-------------------------------------|--------------------------------|
|                       |                      | Испытание на растяжение / Tensile test        |                                   |                                  |   |  |  | Испытание на удар / Impact test |                                     |                                | Испытание на усталость / Fatigue test |                                |                                     |                                |
|                       |                      | Предел прочности / Tensile strength           | Предел текучести / Yield strength | Отношение удлинения / Elongation | Относительное сужение / Reduction of area | Средняя длина образца / Average length of specimen | Диаметр номинальный / Nominal diameter | Твердость / Hardness            | Средняя толщина / Average thickness | Средняя длина / Average length | Средняя толщина / Average thickness   | Средняя длина / Average length | Средняя толщина / Average thickness | Средняя длина / Average length |
| PSI                   | PSI                  | %   | %                                 | inches                           | inches                                    | HRB  | mm                                     | mm                              | mm                                  | mm                             | mm                                    | mm                             | mm                                  |                                |
| 70000                 | 40000                | 27.0  | -                                 |                                  |   | 100  |  | 22                              |                                     |                                |                                       |                                |                                     |                                |
| 1170069               | 117                  | 74500   | 48500                             | 38.5                             | -   | 1300   | 1370                                   | 83                              | <22                                 | L KV -60°F                     | 30 25 10 av 29                        | 5 5 5                          | 0 30 av 293                         |                                |
|                       |                      | 81000   | 53000                             | 37.0                             | -   | 1300   | 1370                                   | 85                              | <22                                 | L KV -60°F                     |                                       |                                |                                     |                                |
| 1170278               | 312                  | 77500   | 60500                             | 34.0                             | -   | 1300   | 1370                                   | 81                              | <22                                 | L KV -60°F                     | 27 21 27 av 25                        | 10 5 10                        | 0 30 av 293                         |                                |
|                       |                      | 79000   | 62500                             | 34.0                             | -   | 1300   | 1370                                   | 83                              | <22                                 | L KV -60°F                     |                                       |                                |                                     |                                |

\* L - Продольный образец / Longitudinal specimen; - поперечный образец / Transverse specimen  
\*\* Результаты испытаний ударных образцов приведены на поперечных / Non-fulfilling specimens results consist to fulfill (10x10mm)

Прочие виды контроля / Other tests

| Вид испытаний / Type of test  | Параметры / Criteria   | Результаты контроля / Test       |
|---|--|----------------------------------|
| Состояние поверхности / Finishing test  | По стандарту / As per Standard   | Удовлетворительно / Satisfactory |
| Испытание гидравлическим давлением / Hydraulic test                                   | 100% / 12.4 MPa / 1800 PSI / 10 sec - 210,1x3,18 (625x0 322)   | Удовлетворительно / Satisfactory |
| Недеструктивный контроль толщины трубы / Non-destructive inspection of wall thickness | Метод контроля / Method: Ультразвуковой контроль / UT inspection<br>Продольная риска 12,5% на наружной и внутренней поверхностях / Longitudinal notch with depth 12,5% on external and internal surfaces | Удовлетворительно / Satisfactory |
| Контроль концов труб / End inspection   | Неконтролируемые концы труб обрезаны / Non-inspected ends are cutted   | Удовлетворительно / Satisfactory |
| Визуальный контроль / Visual inspection   | По стандарту / As per Standard   | Удовлетворительно / Satisfactory |
| Контроль геометрических параметров / Dimensional inspection                           | По стандарту / As per Standard   | Удовлетворительно / Satisfactory |

Состояние поставки / Delivery condition

|  |  |
|--|--|
| Общие условия / General condition                  | Трубы изготовлены и испытаны в соответствии с требованиями ASTM A106/A106M-2015 / ASME SA106/SA106M-2015 / ASTM A53/A53M-2012 / ASME SA53/SA53M-2015 / ASTM A333/A333M-2015 / ASME SA333/SA333M-2015 / NACE MR0175-2015 / NACE MR0103-2012 в заводском состоянии / Pipes were produced and inspected according to requirements of ASTM A106/A106M-2015 / ASME SA106/SA106M-2015 / ASTM A53/A53M-2012 / ASME SA53/SA53M-2015 / ASTM A333/A333M-2015 / ASME SA333/SA333M-2015 / NACE MR0175-2015 / NACE MR0103-2012 and order's requirements |
| Состояние поставки / Delivery condition            | Трубы произведены путем горячей деформации и нормализованы при температуре 845...848°C, охлаждение на воздухе / Pipes produced by Hot Forming followed by normalizing at the temperature 845 deg C to 845 deg C cooled at air  |
| Покрытие / Coating                                 | Трубы покрыты черным лаком / Pipes are coated with black varnish   |
| Фаска (если требуется) / Beveled ends if required  | Стандартная фаска / Bevel as per standard  |
| Защита концов / Protection of pipe ends            | Концы труб оснащены пластиковыми колпачками / The ends of pipes are equipped by plastic caps   |
| Дополнительная информация / Additional information | Масса фактическая / Actual weight. Ремонт сваркой запрещен. / No weld repair<br>Объем партии не более чем 100 труб / Quantity of pipes in the inspection lot is not more than 100 pieces<br>Трубы не содержат ртути и свинца. Material is free of mercury and lead   |

Страна происхождения / Origin


Ваше предложение по покупке продукции приемлемо, мы готовы / Please send your proposals for buying the product by e-mail or fax or by phone  
Ваше предложение по покупке продукции приемлемо, мы готовы / Please send your proposals for buying the product by e-mail or fax or by phone  
Ваше предложение по покупке продукции приемлемо, мы готовы / Please send your proposals for buying the product by e-mail or fax or by phone  
Ваше предложение по покупке продукции приемлемо, мы готовы / Please send your proposals for buying the product by e-mail or fax or by phone

Дата / Date

31.01.2017

Подпись инспектора / Signature of I-4 Part Inspector

Подпись ОТК / Signature OCT

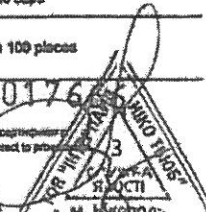

NIK465 / 1170278 / 8.0A106STDF / 8 STD A106B SMLS PIPE

**ИНТЕРПАЙП**  
НИКО ТЬЮБ

ОБЩЕСТВО С ОГРАНИЧЕННОЙ ОТВЕТСТВЕННОСТЬЮ  
"ИНТЕРПАЙП НИКО ТЬЮБ"  
Украина, г. Никополь, пр. Трубинов, 56  
Тел./факс +38 (0566) 639-379

ИНСПЕКЦИОННЫЙ СЕРТИФИКАТ № 0561/5  
INSPECTION CERTIFICATE № 0561/5  
EN 16204-2004/2.1

Группа компаний BUYER North American Interpipe, Inc. 1800 West Loop South, Suite 1350  
Houston, Texas 77027, USA

Контракт № COC18/1487  
Contract #

Страна Country USA

Заказный номер M005810  
Production order #  
Номер заказа клиента  
Customer's ref #P20173

Транспортное средство № Vehicle № AP888606AP2787X0

Лист 1 Sheet 1  
Листов 1 Sheets

Дата Date 31.01.2017г.

| Наименование и код товара<br>Description and code of goods  |                          | Наименование спецификации<br>Specifications   |                      |                        |                       |                       |               |              | Класс<br>Class of delivery   | Тип резьбы<br>Thread type        |                     |                  |
|---|--------------------------|---|----------------------|------------------------|-----------------------|-----------------------|---------------|--------------|------------------------------|----------------------------------|---------------------|------------------|
| Трубы стальные бесшовные горячекатаные для трубопроводов<br>Seamless steel hot-rolled pipes for pipelines |                          | ASTM A106/A106M-2015/ASME SA106/SA106M-2015/ASTM A53/A53M-2015/ASME SA53/SA53M-2015/ASTM A83/A83M-2015/ASME SA83/SA83M-2015/ASTM A133/A133M-2015/ASME SA133/SA133M-2015/ASTM A178/A178M-2015/ASME SA178/SA178M-2015 |                      |                        |                       |                       |               |              |                              |                                  |                     |                  |
| № п/п<br>No.  | Номер пакета<br>Bundle # | Номер трубы<br>Pipe #   | Марка стали<br>Grade | Номер заказа<br>Heat # | Номер партии<br>Lot # | Размеры<br>Dimensions |               |              |                              | Фактический вес<br>Actual weight |                     |                  |
|   |                          |   |                      |                        |                       | OD<br>дюйм<br>inch    | WT<br>lb/inch | Length<br>ft | Weight<br>Tubal weight<br>lb | шт<br>pieces                     | факт<br>gross<br>lb | нет<br>net<br>lb |
| 1   | 17-38-02451              |   | B/B/C                | 1170278                | 312                   | 8.625                 | 0.322         | 38.1         | 189.8                        | 5                                | 5 567               | 5 650            |
| 2   | 17-38-02450              |   | B/B/C                | 1170278                | 312                   | 8.625                 | 0.322         | 38.1         | 189.9                        | 5                                | 5 599               | 5 645            |
| 3   | 17-38-02504              |   | B/B/C                | 1170278                | 312                   | 8.625                 | 0.322         | 38.1         | 189.8                        | 5                                | 5 600               | 5 650            |
| 4   | 17-38-02549              |   | B/B/C                | 1170278                | 312                   | 8.625                 | 0.322         | 38.1         | 151.8                        | 4                                | 4 378               | 4 385            |
| 5   | 17-38-02505              |   | B/B/C                | 1170278                | 312                   | 8.625                 | 0.322         | 38.1         | 189.8                        | 5                                | 5 668               | 5 678            |
| 6   | 17-38-02592              |   | B/B/C                | 1170278                | 312                   | 8.625                 | 0.322         | 38.1         | 151.8                        | 4                                | 4 409               | 4 398            |
| 7   | 17-38-01418              |   | B/B/C                | 1170069                | 117                   | 8.625                 | 0.322         | 38.1         | 189.4                        | 5                                | 5 534               | 5 523            |
| 8   | 17-38-01419              |   | B/B/C                | 1170069                | 117                   | 8.625                 | 0.322         | 38.1         | 189.5                        | 5                                | 5 623               | 5 612            |
| 9   | 17-38-01421              |   | B/B/C                | 1170069                | 117                   | 8.625                 | 0.322         | 38.1         | 115.8                        | 3                                | 3 373               | 3 382            |
| NPS 8   |                          | Sch 40 STD  |                      | TOTAL WEIGHT           |                       | 1684.7                |               | 41           | 48 627                       | 48 425                           |                     |                  |



LIMITED LIABILITY COMPANY "ИНТЕРПАЙП"  
"INTERPIPE NIKO TUBE"  
UKRAINE, Nikopol, 56, Trubynovyye  
Tel./fax +38 (0566) 639-379



Please purchase PDFStamp Command Line product to remove this watermark.  
<http://www.verypdf.com>

o (<http://www.verypdf.com>)

# NIK465 / 1170278 / 8.0A106STDF / 8 STD A106B SMLS PIPE

ІНСПЕКЦІЙНИЙ СЕРТИФІКАТ № 055415  
INSPECTION CERTIFICATE № 055415

Лист 1 / Sheet 1  
Листов 1 / Sheets 1

Хімічний склад по поверхневим даним на загальному в результаті контролю хімічного складу металу труб  
Heat analysis acc. to the heat manufacturer certificate in results of chemical analysis of pipes

| Номер<br>наказу<br>Heat #<br>min | Лабораторія<br>Laboratory | Хімічний склад в %<br>Chemical composition % |            |             |            |            |            |            |             |             |            |             |            |                         | Завод<br>виробник сталі<br>Steel supplier |
|----------------------------------|---------------------------|--|------------|-------------|------------|------------|------------|------------|-------------|-------------|------------|-------------|------------|-------------------------|---|
|                                  |                           | C<br>x100                                    | Mn<br>x100 | Si<br>x1000 | S<br>x1000 | P<br>x1000 | Cr<br>x100 | Ni<br>x100 | Cu<br>x1000 | Mo<br>x1000 | V<br>x1000 | Nb<br>x1000 | CE<br>x100 |                         |   |
|                                  |                           | 30   | 150        | -           | 25         | -          | -          | -          | -           | -           | -          | -           | -          | -                       |   |
| 1170068                          | Дніпростал                | 22   | 89.5       | 23          | 8          | 10         | 7.3        | 9.2        | 14.7        | 9           | 3          | 2           | 40.2       | "MPDNEPROSTEEL" LLC     |   |
|                                  | NIKOTUBE*                 | 23   | 89         | 25          | 10         | 11         | 7          | 10         | 15          | 10          | 1          | 1           | 41.1       | ООО"МЗ"Дніпропетровськ" |   |
|                                  | NIKOTUBE*                 | 23   | 90         | 26          | 8          | 10         | 7          | 10         | 15          | 10          | 2          | 2           | 41.3       |                         |   |
| 1170278                          | Дніпростал                | 22.6   | 85.7       | 24.7        | 6          | 12         | 10.5       | 10.6       | 16.5        | 11          | 3          | 2           | 41         | "MPDNEPROSTEEL" LLC     |   |
|                                  | NIKOTUBE*                 | 24   | 88         | 25          | 7          | 12         | 10         | 10         | 16          | 11          | 1          | 2           | 42.8       | ООО"МЗ"Дніпропетровськ" |   |
|                                  | NIKOTUBE*                 | 23   | 88         | 28          | 5          | 12         | 10         | 10         | 16          | 11          | 1          | 1           | 41.8       |                         |   |

Аналіз плавки складом поверхневих даних загальної металургійної продукції в результаті контролю хімічного складу металу труб  
Steel production analysis of the general metalurgical product in results of chemical analysis of pipes - control analysis of pipes

Сталь вироблена методом кислотно-основного розплаву з послідовною нормалізацією в вакуумній камері. Сталь високоякісна розплавлена в металургійній сталеварні. Адреса заводу металургійної сталі: Україна, 49051, г.Дніпропетровськ, ул.Вікторівська, 4/ Steel has been produced by the EAF with continuous casting process. Steel is fully killed and made to fine grain practice. Refining plant steel: The address of steel supplier: Ukraine, 49051, Dnipropetrovsk, 4 Viktorivska str. При розрахунку еквівалентного вмісту вуглецю використано формулу/When calculating the carbon equivalent the following formula was used:  $CE=C+Mn/6+(Cr+Mo+V)/5+(Ni+Cu)/16$

Результати випробувань труб - Test results for pipes

| Номер<br>наказу<br>Heat #<br>min | Номер<br>випробу<br>Loop # | Механічні властивості<br>Mechanical Properties |                                       |                                   |  |  |  |  |                                      |  |                                  |  | Випробування на удар Абрайт тест<br>Impact test |          |                                 |                                 |   |
|----------------------------------|----------------------------|--|---------------------------------------|-----------------------------------|--|--|--|--|--------------------------------------|--|----------------------------------|--|---|----------|---------------------------------|---------------------------------|---|
|                                  |                            | Випробування на розтягнення<br>Tensile test    |                                       |                                   |  |  |  | Випробування на удар Абрайт тест<br>Impact test    |                                      |  |                                  |  | Середній вміст<br>Average                       |          | Відсоток вуглецю<br>Steel grade | Розмір зразка<br>Specimens size |   |
|                                  |                            | Прочність<br>Tensile strength                  | Прочність на розтяг<br>Yield strength | Остаточне удовження<br>Elongation | Остаточне стиснення<br>Reduction of area | Ориєнтація зразка<br>Specimens orientation | Відстань між отворами<br>Width of grip section | Діаметр заготовки<br>Diameter of original specimen | Діаметр зразка<br>Length of specimen | Твердість Ночес<br>Середня величина<br>Average | Орієнтація зразка<br>Orientation | Тип удару, тип металу<br>Type of test, temperature | Нормалізація                                    | Фут/Футт |                                 |                                 | % |
|                                  |                            | PSI  | PSI                                   | %                                 | %  | дюйм<br>inch                               | дюйм<br>inch                                   | дюйм<br>inch                                       | HRB                                  | HRC  |                                  | min  |   |          |                                 |                                 |   |
|                                  |                            | 70000  | 40000                                 | 27.0                              | -  |  |  |  | 100                                  | 22   |                                  |  |   |          |                                 |                                 |   |
| 1170068                          | 117                        | 74500  | 48500                                 | 38.5                              | -  | L 1.500                                    | 1.970  | 1.970  | 83                                   | 22   | L KV-60°F                        |  | 30 28 30 av 28                                  | 5 5 5    | 8 394x3 263                     |                                 |   |
|                                  |                            | 81000  | 53000                                 | 37.0                              | -  | L 1.500                                    | 1.970  | 1.970  | 85                                   | 22   | L KV-60°F                        |  |   |          |                                 |                                 |   |
| 1170278                          | 312                        | 77900  | 50600                                 | 34.0                              | -  | L 1.500                                    | 1.970  | 1.970  | 81                                   | 22   | L KV-60°F                        |  | 27 21 27 av 25                                  | 10 9 10  | 8 394x3 263                     |                                 |   |
|                                  |                            | 79900  | 52900                                 | 34.0                              | -  | L 1.500                                    | 1.970  | 1.970  | 83                                   | 22   | L KV-60°F                        |  |   |          |                                 |                                 |   |

\* L - Продовольчий зразок / Longitudinal specimen, \* - Поперечний зразок / Transverse specimen

\*\* Результати випробувань ударних зразків перераховані на нормалізацію/Non-killed specimen results convert to killed (10x10mm)

Прочі випробування / Other tests

| Вид випробування / Type of test  | Параметри / Criteria  | Результати випробування / Test |
|--|---|--------------------------------|
| Сохлоустійкість / Flaking test   | По стандарту / As per Standard  | Удовільняє / Satisfactory      |
| Випробування на гидравлічне тиснення / Hydrostatic test                            | 100% / 12.4 MPa / 1800 PSI / 10 sec - 210,1x3,10(8 626x3 322)   | Удовільняє / Satisfactory      |
| Неразрушувальний контроль товщи труби / Non-destructive inspection all length body | Метод контролю / Method: Ультразвуковий контроль / UT inspection<br>Продольна риска 12,5% на зовнішній і внутрішній поверхностях / Longitudinal notch with depth 12,5% on external and internal surface | Удовільняє / Satisfactory      |
| Контроль кінців труб / SEA inspection  | Неконтрольовані кінці труб обрізані / Non-inspected ends are cutted   | Удовільняє / Satisfactory      |
| Візуальний контроль / Visual inspection  | По стандарту / As per Standard  | Удовільняє / Satisfactory      |
| Контроль розмірних параметрів / Dimensional inspection                             | По стандарту / As per Standard  | Удовільняє / Satisfactory      |

Системні умови / Delivery conditions


|  |   |
|--|---|
| Общие условия / General condition                  | Трубы изготовлены и испытаны в соответствии с требованиями ASTM A106/A106M-2015/ ASME SA106/SA106M-2015/ ASTM A53/A53M-2012/ ASME SA53/SA53M-2015/ ASTM A333/A333M-2015/ ASME SA333/SA333M-2015/ NACE MR0170-2015/ NACE MR0103-2012 и заказа / Pipes were produced and inspected according to requirements of ASTM A106/A106M-2015/ ASME SA106/SA106M-2015/ ASTM A53/A53M-2012/ ASME SA53/SA53M-2015/ ASTM A333/A333M-2015/ ASME SA333/SA333M-2015/ NACE MR0170-2015/ NACE MR0103-2012 and order's requirements |
| Системні умови / Delivery condition                | Труби вироблені шляхом гарячої деформції і нормалізовані при температурі 845...846°C, охолоджені на повітрі / Pipes produced by Hot Forming followed by normalizing at the temperature 845 deg C to 845 deg C cooled at air   |
| Покриття / Coating                                 | Труби покриті чорним лаком / Pipes are coated with black varnish  |
| Фаска (акти трубостриг) / Beveled ends if required | Стандартна фаска / Bevel as per standard  |
| Захист кінців / Protection of pipe ends            | Кінці труб оснащені пластикними ковпачками / The ends of pipes are equipped by plastic caps   |
| Додаткова інформація / Additional information      | Маса фактична / Actual weight, Ремонт сварки заборонено. / No weld repair<br>Объем партии не более чем 100 труб / Quantity of pipes in the inspection lot is not more than 100 pieces<br>Трубы не содержат ртути и свинца. Material is free of mercury and lead   |

Страна происхождения Украины. Выше проведено по украинскому производству процесс нормализации на стандарт / Release and Your reference for inspecting this product by e-mail or fax or by phone: +38(0)662932278

Цей інспекційний сертифікат стосується тільки цієї продукції. Інспекція в інших місцях не проводиться. Відхилення можуть бути зазначені в звіті, який додається до цього інспекційного сертифікату. This inspection certificate is only for this product. Inspection in other places is strictly prohibited. Violations can be indicated in the report which is added to this inspection certificate.

Дата: 31.01.2017  
Date: 10.02.2017

Підписи СТО  
Signatures OGD

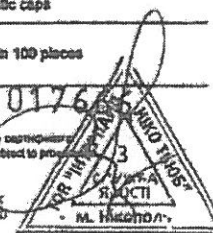



Vallourec Tubos do Brasil S.A.  
Barreiro Plant - Av. Olimo Meireles, 65  
ZIP 30640-010 - Belo Horizonte - MG - Brazil



ISO 9001  
ISO 14001  
ISO/TS 16949  
OHSAS 18001  
ISO 50001  
BUREAU VERITAS  
Certification



Inspection Certificate

(According to DIN EN 10204.3.1)

Nº: 0030035505

Sheet 1 / 4

Customer: VALLOUREC USA CORPORATION

Country: USA

Material Number: 271282

Work Order: 391164/100

Customer Order: 21005447

Inspection: Vallourec Tubos do Brasil S.A.

PRODUCT: SEAMLESS STEEL PIPE, HOT FINISHED, BEVELED ENDS 30 DEG., NORMALIZED

DIMENSIONS: 10.3/4" X 0.365" SCHEDULE: 040 GRADE: GR X52N # GR 6 # GR 1

STANDARD: API SPEC 5L, 12.2012, 45TH EDITION - PSL 2

IN ACCORDANCE ALSO TO THE STANDARDS: ASTM A 335 - 13 ASTM A 999 - 14 # ASME SA-333 - 13

SURFACE PROTECTION: EXTERNAL: LACQUER PIPE ENDS PROTECTOR: PLASTIC CAP

TOLERANCES: OUTSIDE DIAMETER (PIPE BODY): -0.031 " / + 0.081 " WALL THICKNESS: -0.046 " / + 0.055 "

LENGTH: RANDOM 40.0 FT - 44.0 FT

STANDARD MARKING: Paint stenciled in the pipe body: 391164/100 MANUFACTURER SPEC 5L-0150.4 API MONOGRAM MONTH/YEAR ASTM/ASME A/SA 333 10.3/4 X 0.365 X52N /6/1 PSL2 SMLS HEAT

NUMBER LENGTH S SCH 040 LT -50F - "NACE MR 0175/NACE MR 0103"

SHIPPING MARKING: MADE IN BRAZIL ----- J - RCH-206118-BGR \* VALLOUREC ORDER 21006447 \* HOUSTON

TOLERANCES(PIPE ENDS): OUTSIDE DIAMETER: -0.031 " / + 0.054 "

| Heat   | Pieces |
|--------|--------|
| 137316 | 45     |
| 137384 | 18     |
| Total  | 63     |

THE PRODUCT IS SATISFACTORY IN THE FOLLOWING TESTS / INSPECTIONS: DIMENSIONAL # VISUAL # FLATTENING TEST # ENDS INSPECTION : MPI(WBT) # HYDROSTATIC TEST: 20500.0 KPA 5 S # RESIDUAL MAGNETISM: MAX 30 GAUSS # ELETROMAGNETIC TEST : API 5L-N12.5, LONG, OUT/INS #

Chemical Composition (%)

Process: Basic Oxygen Furnace, heats fully killed

Ceq: C+ Mn/6+ (Cr+ Mo+ V)/5  
+ (Ni+ Cu)/15

PCM: COMPLETE

|                 |              | C     | Mn    | P     | S     | Si    | Ni    | Cr    | Mo    | Al    | Cu    | V     | Nb    | B      | Ti    | Ca     | Ceq   | Pcm  |
|-----------------|--------------|-------|-------|-------|-------|-------|-------|-------|-------|-------|-------|-------|-------|--------|-------|--------|-------|------|
| Heat Analays    | Min          |       | 0.290 |       |       | 0.100 |       |       |       |       |       |       |       |        |       |        |       |      |
|                 | Max          | 0.220 | 1.350 | 0.020 | 0.010 | 0.350 | 0.300 | 0.300 | 0.120 | 0.040 | 0.400 | 0.080 | 0.020 | 0.0005 | 0.040 | 0.0060 | 0.430 | 0.25 |
| Product Analays | Min          |       | 0.290 |       |       | 0.100 |       |       |       |       |       |       |       |        |       |        |       |      |
|                 | Max          | 0.220 | 1.350 | 0.020 | 0.010 | 0.350 | 0.300 | 0.300 | 0.120 | 0.040 | 0.400 | 0.080 | 0.020 | 0.0005 | 0.040 | 0.0060 | 0.430 | 0.25 |
| Heat            | Control-Lot  |       |       |       |       |       |       |       |       |       |       |       |       |        |       |        |       |      |
| 137316          | 030002599973 | 0.11  | 1.35  | 0.010 | 0.002 | 0.30  | 0.01  | 0.14  | 0.09  | 0.028 | 0.010 | 0.054 | 0.016 | 0.0004 | 0.002 | 0.0016 | 0.393 | 0.21 |
|                 | Check 1      | 0.12  | 1.35  | 0.010 | 0.002 | 0.28  | 0.01  | 0.15  | 0.10  | 0.030 | 0.008 | 0.053 | 0.014 | 0.0003 | 0.002 | 0.0013 | 0.409 | 0.20 |
|                 | Check 2      | 0.12  | 1.35  | 0.011 | 0.002 | 0.28  | 0.01  | 0.15  | 0.10  | 0.029 | 0.007 | 0.053 | 0.013 | 0.0003 | 0.002 | 0.0013 | 0.410 | 0.21 |
| 137384          | 050002600037 | 0.11  | 1.31  | 0.012 | 0.001 | 0.28  | 0.01  | 0.14  | 0.10  | 0.029 | 0.010 | 0.052 | 0.015 | 0.0003 | 0.002 | 0.0018 | 0.388 | 0.21 |
|                 | Check 1      | 0.12  | 1.33  | 0.013 | 0.002 | 0.28  | 0.01  | 0.15  | 0.10  | 0.029 | 0.008 | 0.051 | 0.015 | 0.0003 | 0.002 | 0.0015 | 0.402 | 0.19 |

Please purchase PDFStamp Command Line product to remove this watermark.  
<http://www.verypdf.com>



ISO 9001  
ISO 14001  
AS 1275 (SRM)  
DNV AS 1801  
ISO 9001  
BUREAU VERITAS  
Certified



**Inspection Certificate**

(According to DIN EN 10204.3.1)

N°: 0030035505

Sheet 2 / 4

**Chemical Composition (%)**

Process: Basic Oxygen Furnace, heats fully killed

Ceq: C+ Mn/5+ (Cr+ Mo+ V)/5  
+ (Ni+ Cu)/15

PCM: COMPLETE

|                  | C           | Mn    | P     | S     | Si    | Ni    | Cr    | Mo    | Al    | Cu    | V     | Nb    | B     | Ti     | Ca    | Ceq    | Pcm   |      |
|------------------|-------------|-------|-------|-------|-------|-------|-------|-------|-------|-------|-------|-------|-------|--------|-------|--------|-------|------|
| Heat Analysis    | Min         |       |       |       | 0.290 |       |       |       | 0.100 |       |       |       |       |        |       |        |       |      |
|                  | Max         | 0.220 | 1.350 | 0.020 | 0.010 | 0.350 | 0.300 | 0.300 | 0.120 | 0.040 | 0.400 | 0.080 | 0.020 | 0.0005 | 0.040 | 0.0060 | 0.430 | 0.25 |
| Product Analysis | Min         |       |       |       | 0.290 |       |       |       | 0.100 |       |       |       |       |        |       |        |       |      |
|                  | Max         | 0.220 | 1.350 | 0.020 | 0.010 | 0.350 | 0.300 | 0.300 | 0.120 | 0.040 | 0.400 | 0.080 | 0.020 | 0.0005 | 0.040 | 0.0060 | 0.430 | 0.25 |
| Heat             | Control Lot |       |       |       |       |       |       |       |       |       |       |       |       |        |       |        |       |      |
|                  | Check 2     | 0.12  | 1.32  | 0.013 | 0.001 | 0.28  | 0.01  | 0.15  | 0.10  | 0.031 | 0.007 | 0.051 | 0.013 | 0.0003 | 0.002 | 0.0018 | 0.401 | 0.20 |

Ceq: Carbon Equivalent; PCM: Parameter for crack measu

**Tensile Test**

Specimen Direction: Longitudinal

Temperature: Room Temperature

Gage Length: L0= 2"

Method: Elong.Total Under Load 0,50 %

Type of Specimen

Area

YS

TS

E

(Sqm)

(PSI)

(PSI)

(%)

Required: Min

Max

52200

66700

35

76900

110200

Heat Control Lot

137316 030002599973

STRIP WIDTH 38,1 MM

0.6

57435

78610

40

137384 030002600037

STRIP WIDTH 38,1 MM

0.7

57440

78620

39

STRIP WIDTH 38,1 MM

0.5

56564

78755

38

STRIP WIDTH 38,1 MM

0.7

56570

78767

40

YS-Yield Strength; TS-Tensile Strength; E-Elongation;

**Hardness Test**

Scale: HV10

Required: Min

Max 250,0


Heat Control Lot

137316 030002599973

150,0 151,0

137384 030002600037

165,0 167,0

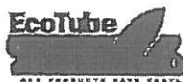

ISO 9001  
ISO 14001  
ISO/IEC 17025  
CNAS 18001  
ISO 50001  
BUREAU VERITAS  
Certificat



|  |              |
|--|--------------|
| <b>Inspection Certificate</b><br>(According to DIN EN 10204.3.1) |              |
| N°: 0030035505   | Sheet: 3 / 4 |

**Impact Test**

Test Specimen: CHARPY 10X55X7.5 V Direction: Longitudinal Temperature: -49°F Striking tip: 0.315"  
NOTCH

|                     | AE1<br>(FtIb) | AE2<br>(FtIb) | AE3<br>(FtIb) | AE4<br>(FtIb) | AE5<br>(FtIb) | AE Avg<br>(FtIb) |
|---------------------|---------------|---------------|---------------|---------------|---------------|------------------|
| Required: Min       | 13            | 13            | 13            |               |               | 15               |
| Max                 |               |               |               |               |               |                  |
| Heat Control Lot    |               |               |               |               |               |                  |
| 137316 030002599973 | 189           | 196           | 207           |               |               | 197              |
| 137384 030002600037 | 193           | 198           | 205           |               |               | 199              |

AE - Absorbed Energy:

**Impact Test**

Test Specimen: CHARPY 10X55X7.5 V Direction: Transverse Temperature: 52°F Striking tip: 0.315"  
NOTCH

|                     | AE1<br>(FtIb) | AE2<br>(FtIb) | AE3<br>(FtIb) | AE4<br>(FtIb) | AE5<br>(FtIb) | AE Avg<br>(FtIb) |
|---------------------|---------------|---------------|---------------|---------------|---------------|------------------|
| Required: Min       | 11            | 11            | 11            |               |               | 15               |
| Max                 |               |               |               |               |               |                  |
| Heat Control Lot    |               |               |               |               |               |                  |
| 137316 030002599973 | 205           | 200           | 204           |               |               | 204              |
| 137384 030002600037 | 199           | 198           | 199           |               |               | 199              |

AE - Absorbed Energy:

**Grain Size Test**

Method: ASTM E-112

|                     | Min |
|---------------------|-----|
| Required:           | 5   |
| Heat Control Lot    |     |
| 137316 030002599973 | 8   |
| 137384 030002600037 | 8   |

**Remarks:**

MATERIAL IN ACCORDANCE WITH NACE MR 0175  
PAR. 3.2/ISO 15156-2, ANNEX A.2.1.2/NACE MR0103 PAR.2.1. ALL LATEST EDITIONS



ISO 9001  
ISO 14001  
ISO/TC 15948  
DIN EN 10204  
BUREAU VERITAS  
Certification



|  |             |
|--|-------------|
| <b>Inspection Certificate</b><br>(According to DIN EN 10204.3.1) |             |
| Nº: 0030035505   | Sheet 4 / 4 |

**MATERIAL:-**

- NO WELD REPAIR - FREE OF MERCURY
- FINE GRAIN PRACTICE
- FULLY KILLED STEEL
- STEEL MELT COUNTRY OF ORIGIN - BRAZIL
- MATERIAL IN ACCORDANCE TO PED

The data presented were converted from SI measurement system, used for the original inspection.

We hereby certify that this product has been manufactured and examined in accordance with all requirements of the standards and specifications and all the results are found to be satisfactory. This testimonial and certificate respectively is recorded by a computer system and is valid without signature. Alteration or use for others products are regarded as falsification of documents and will be subject to criminal jurisdiction.

QUALITY CONTROL DEPARTMENT

FAX: (55-31) 3328-2817

e-mail: [gustavo.pinheiro@vallourec.com](mailto:gustavo.pinheiro@vallourec.com)

DATE

05.24.2016

DR. GUSTAVO ALVES PINHEIRO - CREA/MG-109170/D  
TECHNICAL RESPONSIBLE

ECO TUBES: The tubes from Vallourec do Brasil S.A. are manufactured with steel which uses charcoal as a source of energy in its production. This coal comes from more than 100,000 ha. of forest planted by Vallourec Florestal Ltda.. With the acquisition of 48.2 ton(s) of steel tubes from Vallourec do Brasil S.A., your company contributed to the reduction of the greenhouse effect, avoiding the accumulation of 86.8 ton(s) of Carbon Dioxide CO2 in the atmosphere.

Please purchase PDFStamp Command Line product to remove this watermark.  
<http://www.verypdf.com>

**ИНТЕРПАЙП**  
НИКО ТЬЮБ

ОБЩЕСТВО С ОГРАНИЧЕННОЙ ОТВЕТСТВЕННОСТЬЮ  
"ИНТЕРПАЙП НИКО ТЬЮБ"  
Украина, г. Никополь, пр. Трубников, 56  
Тел./факс +38 (0566) 639-379

ИНСПЕКЦИОННЫЙ СЕРТИФИКАТ № 018925  
INSPECTION CERTIFICATE № 018925  
EN 10204-2004/2.1

Продавец/Supplier: North American InstePipe, Inc. 1200 West Loop South, Suite 1300,  
BUYER: Houston, Texas 77027, USA

Контракт № CQC16/1487  
Contract #

Заказной номер N008910

Production order #

Номер заказа клиента

Customer's ref #PAULSEN PIPE

P20173

Страна/Country: USA

Транзитное  
средство №  
Vehicle №: AE1776AX/AE8230XP

Дата/Date: 16.01.2017.

Лист 1 / Sheet 1  
Листов 1 / Sheets

| Наименование и код товара<br>Description and code of goods   |                          |                       | Наименование стандарта<br>Specifications   |                        |                                     |                               |   |                              | Класс поставки<br>Class of delivery |   | Тип резьбы<br>Thread type         |                                  |  |
|--|--------------------------|-----------------------|--|------------------------|-------------------------------------|-------------------------------|---|------------------------------|-------------------------------------|---|-----------------------------------|----------------------------------|--|
| Трубы стальные бесшовные горячекатаные для трубопровода<br>Seamless steel hot-rolled pipes for pipelines |                          |                       | ASTM A106/A106M-2016/ ASME SA106/SA106M-2015/ ASTM A53/A53M-2012/ ASME SA53/SA53M-2016/ ASTM A333/A333M-2016/ ASME SA333/SA333M-2016/ NACE MR0175-2016/ NACE MR0103-2012 |                        |                                     |                               |   |                              |                                     |   |                                   |                                  |  |
| № п/п<br>No  | Номер пакета<br>Bundle # | Номера труб<br>Pipe # | Марка стали<br>Grade<br>категория<br>Brief designation   | Номер плавки<br>Heat # | Номер партии<br>Inspection<br>Lot # | Размеры<br>Dimensions         |   |                              | шт<br>pcs                           | Фактический вес<br>Actual weight            |                                   |                                  |  |
|  |                          |                       |  |                        |                                     | диаметр<br>OD<br>дюйм<br>Inch | толщина<br>стенки<br>WT<br>дюйм<br>Inch | длина<br>length<br>фут<br>ft |                                     | общая<br>длина<br>Total length<br>фут<br>ft | брутто вес<br>gross<br>фунт<br>lb | нетто вес<br>netto<br>фунт<br>lb |  |
| 1.   | 17-38-00703              |                       | B/B/C  | 1163935                | 51                                  | 12.750                        | 0.375                                   | 38.1                         | 37.9                                | 1   | 1 920                             | 1 918                            |  |
| 2.   | 17-38-00698              |                       | B/B/C  | 1163935                | 61                                  | 12.750                        | 0.375                                   | 38.1                         | 113.5                               | 3   | 5 941                             | 5 930                            |  |
| 3.   | 17-38-00699              |                       | B/B/C  | 1163935                | 61                                  | 12.750                        | 0.375                                   | 38.1                         | 113.7                               | 3   | 5 953                             | 5 942                            |  |
| 4.   | 17-38-00700              |                       | B/B/C  | 1163935                | 51                                  | 12.750                        | 0.375                                   | 38.1                         | 113.7                               | 3   | 5 953                             | 5 942                            |  |
| 5.   | 17-38-00702              |                       | B/B/C  | 1163935                | 51                                  | 12.750                        | 0.375                                   | 38.1                         | 37.9                                | 1   | 1 898                             | 1 896                            |  |
| 6.   | 17-38-00701              |                       | B/B/C  | 1163935                | 51                                  | 12.750                        | 0.375                                   | 38.1                         | 113.7                               | 3   | 5 776                             | 5 765                            |  |
| 7.   | 17-38-00697              |                       | B/B/C  | 1163935                | 51                                  | 12.750                        | 0.375                                   | 38.1                         | 113.6                               | 3   | 5 766                             | 5 754                            |  |
| 8.   | 17-38-00698              |                       | B/B/C  | 1163935                | 51                                  | 12.750                        | 0.375                                   | 38.1                         | 113.7                               | 3   | 5 787                             | 5 778                            |  |
| 9.   | 17-38-00670              |                       | B/B/C  | 1163935                | 61                                  | 12.750                        | 0.375                                   | 38.1                         | 113.8                               | 3   | 5 853                             | 5 842                            |  |
| NPS 12   |                          |                       | Sch STD  |                        | TOTAL/ИТОГО                         |                               |   | 571.5                        |                                     | 23  |                                   | 44 846                           |  |

**INTERPIPE**  
NIKO TUBE

LIMITED LIABILITY COMPANY  
"INTERPIPE NIKO TUBE"  
UKRAINE, Nikopol, 56, Trubnikov ave. Tel./fax +38 (0566) 639-379



Please purchase PDFStamp Command Line product to remove this watermark.  
<http://www.verypdf.com>

ИНСПЕКЦИОННЫЙ СЕРТИФИКАТ № 0198/Б  
INSPECTION CERTIFICATE № 0198/Б

Лист 1  
Sheet

Листов 1  
Sheets

Химический состав по сертификатным данным на заготовку к результатам контроля химического состава металла труб  
Heat analysis acc. to the billet manufacturer certificate & results of chemical analysis of pipes

| Номер плавки<br>Heat # | Лаборатория<br>Laboratory | Химический состав в %<br>Chemical composition % |            |            |            |            |            |            |            |             |            | Завод<br>изготовитель заготовки<br>Steel supplier |
|------------------------|---------------------------|---|------------|------------|------------|------------|------------|------------|------------|-------------|------------|---|
|                        |                           | C<br>x100                                       | Mn<br>x100 | Si<br>x100 | S<br>x1000 | P<br>x1000 | Cr<br>x100 | Ni<br>x100 | Cu<br>x100 | Mo<br>x1000 | V<br>x1000 |   |
| тип                    |                           | 30  | 27         | 10         | -          | -          | -          | -          | -          | -           | -          |   |
| max                    |                           | 30  | 27         | 10         | -          | -          | -          | -          | -          | -           | -          |   |
| 1163935                | DneproSteel               | 17.2  | 87.3       | 26.5       | 5          | 8          | 5.8        | 8.3        | 13.6       | 8           | 3          | "MP DNEPROSTEEL" LLC<br>ООО "МЗ Днепросталь"      |
|                        | NIKOTUBE*                 | 18  | 87         | 27         | 5          | 8          | 5          | 8          | 13         | 8           | 2          |   |
|                        | NIKOTUBE*                 | 18  | 87         | 27         | 5          | 8          | 5          | 8          | 13         | 8           | 2          |   |

Анализ плавки согласно сертификата завода-изготовителя/Heat analysis acc to the manufacturer certificate. \*control analysis of pipes\*\* - контрольный анализ от труб.

Сталь произведена методом плавления в электродуговой печи с последующей непрерывной разливкой. Сталь полностью раскислена и мелкозерниста. Сталь раскислена алюминием. Адрес завода изготовителя заготовки. Украина, 49051, г. Днепропетровск, ул.Винокурова, 4/ Steel has been produced by the EAF with continuous casting process. Steel is fully killed and made to fine grain practice. Aluminium killed steel. The address of steel supplier: Ukraine, 49051, Dnipropetrovsk, 4 Vinokurova str.

Результаты испытаний труб - Test results for pipes

| Номер плавки<br>Heat# | Номер партии<br>Lot# | Механические свойства<br>Mechanical Properties |  |                                       |                                |   |  |                           |  |   |                                     | Испытания на удар / Char test |  |               |                             |
|-----------------------|----------------------|--|--|---------------------------------------|--------------------------------|---|--|---------------------------|--|---|-------------------------------------|-------------------------------|--|---------------|-----------------------------|
|                       |                      | Испытание на растяжение<br>Tensile test        |  |                                       |                                |   | Твердость<br>Среднее значение<br>Average | Ориентация<br>Orientation | Испытания на удар / Char test                        |   |                                     |                               |  |               |                             |
|                       |                      | Предел прочности<br>Tensile strength           | Предел текучести R0.5<br>Yield strength R0.5 | Относительное удлинение<br>Elongation | Отношение отвоз<br>Ratio отвоз | Ориентация образца<br>Specimens orientation |  |                           | Ширина полосового образца<br>Width of strip specimen | Диаметр цилиндрического образца<br>Diameter of cylindrical specimen | Длина образца<br>Length of specimen |                               | Тип надреза, темп. надреза<br>Notch, temperature | Норматив/Norm | Среднее значение<br>Average |
|                       |                      | PSI  | PSI  | %                                     |                                | дюйм/<br>inch                               | дюйм/<br>inch                            | дюйм/<br>inch             | HRB  | HRC   |                                     | min                           | Дж/У   | %             | дюйм/<br>inch               |
|                       |                      | min<br>70000                                   | 40000  | -                                     | -                              |   |  |                           | -  | -   |                                     |                               |  |               |                             |
|                       |                      | max  |  |                                       |                                |   |  |                           | 100  | 22  |                                     |                               |  |               |                             |
| 1163935               | 51                   | 71000<br>72000                                 | 48700<br>49700                               | 42.0<br>40.0                          |                                | L 1.500<br>L 1.500                          |  | 1.970<br>1.970            | 78<br>78   | <22<br><22  | L KV -50°F                          |                               | 160 159 143 av. 154                              | 100 100       | 0.394x0.295                 |

L - Продольный образец / Longitudinal specimen; l - поперечный образец / transverse specimen

\*\* Результаты испытаний уменьшенных образцов пересчитаны на полноразмерные/Non-fullsize specimens results convert to fullsize (10x10mm)

Прочие виды контроля / Other tests

| Вид испытания / Type of test  | Параметры / Criteria  | Результаты контроля / Test results |
|---|---|------------------------------------|
| Сплюснение / Flattening test  | По стандарту / As per Standard**  | Удовлетворительно / Satisfactory   |
| Испытание гидравлическим давлением / Hydrostatic test                             | 100% / 4,7 MPa / 1400 PSI / 10 sec  | Удовлетворительно / Satisfactory   |
| Недеструктивный контроль тела трубы / Non-destructive inspection full length body | Метод контроля / Method: Ультразвуковой контроль / UT inspection<br>Продольная риска 12,5% на наружной и внутренней поверхности/ Longitudinal notch with depth 12.5% on external and internal surface |                                    |
| Контроль концов труб / SEA Inspection   | Неконтролируемые концы труб обрезаны / Non-inspected ends are cutted  |                                    |
| Визуальный контроль / Visual inspection   | По стандарту / As per Standard**  | Удовлетворительно / Satisfactory   |
| Контроль геометрических параметров / Dimensional inspection                       | По стандарту / As per Standard**  | Удовлетворительно / Satisfactory   |

Состояние поставки / Delivery condition

|  |   |
|--|---|
| Общие условия / General condition                  | Трубы изготовлены и испытаны в соответствии с требованиями ASTM A106/A106M-2015 / ASME SA106/SA106M-2015 / ASTM A333/A333M-2012 / ASME SA53/SA53M-2015 / ASTM A333/A333M-2016 / ASME SA333/SA333M-2015 / NACE MR0175-2015 / NACE MR0103-2012 и заказа / Pipes were produced and inspected according to requirements of ASTM A106/A106M-2015 / ASME SA106/SA106M-2015 / ASTM A53/A53M-2012 / ASME SA53/SA53M-2015 / ASTM A333/A333M-2016 / ASME SA333/SA333M-2015 / NACE MR0175-2015 / NACE MR0103-2012 and order's requirements |
| Состояние поставки / Delivery condition            | Трубы произведены путем горячей деформации и нормализованы при температуре 845...945°C, охлаждение на воздухе / Pipes produced by Hot Forming followed by normalizing at the temperature 845 deg C to 945 deg C cooled at air   |
| Покрытие / Coating                                 | Трубы покрыты черным лаком / Pipes are coated with black varnish  |
| Фаска (если требуется) / Beveled ends if required  | Стандартная фаска / Bevel as per standard   |
| Защита концов / Protection of pipe ends            | Концы труб оснащены пластиковыми колпачками / The ends of pipes are equipped by plastic caps  |
| Дополнительная информация / Additional Information | Масса фактическая / Actual weight.<br>Ремонт сваркой запрещен. / No weld repair.<br>Объем партии не более чем 100 труб/ Quantity of pipes in the inspection lot is not more than 100 pieces<br>Трубы не содержат ртути и свинца. /Material is free of mercury and lead  |

\* страна происхождения - Украина

Виды предложения по улучшению продукции просим направлять на эл адрес / Please send Your proposals for improving the product by e-mail on

Сергей Пискачев skp@interpro.be phone +38(0)56(0)339379

e-mail info@interpro.biz Phone 17133330333 Fax 17133330330

Этот инспекционный сертификат относится только к перечисленной в нем продукции. Недопустимо внесение изменений или другое использование сертификата.  
This inspection certificate is only for the listed products. Modification or unauthorized use of the certificate is strictly prohibited. Variations can be considered as invalid. Inspection Certificate was drawn up and checked by the Certificate Inspector CHUMACHENKO V.D.


Дата: 16.01.2017

Date:

REVIEWED BY  
I. KLOKOV  
16.01.2017

Подпись инспектора 3-й стороны:  
Signature of 3-rd Part Inspector:

Подпись ОТК  
Signatures OCO

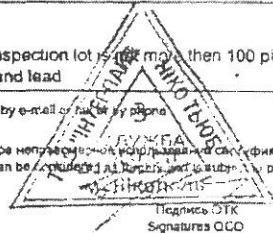



UNITED STATES STEEL CORPORATION

TUBULAR PRODUCTS  
CERTIFIED TEST REPORT

(IN ACCORDANCE WITH ISO 10474/EN10204/DIN50049 "type 3.1")

DATE: 02/17/16  
TIME: 08:39:36  
SERIAL NO: F0099536  
EBS NO: 2001423156 1

|   |              |                          |            |
|---|--------------|--------------------------|------------|
| MILL ORDER/ITEM NO<br>DR93682 01  | SHIPPERS NO. | P.O. NUMBER<br>154876-00 | VEHICLE LO |
| SOLD TO ADDRESS   |              | MAIL TO ADDRESS          |            |
| VENDOR<br>UNITED STATES STEEL CORP<br>FAIRFIELD TUBULAR OPERATIONS<br>5700 VALLEY ROAD<br>P.O. BOX 599<br>FAIRFIELD, AL 35064 |              |                          |            |

SPECIFICATION AND GRADE

SMLS STANDARD PIPE ASTM A106-14 GRADE B, ASTM A333-13 GRADE 1/6, ASME SA106-2013 GRADE B, ASME SA333-2013 GRADE 1/ 6 TEXAS PIPE & SUPPLY SPEC US-333F REV 1 DTD 5/22/14 AND TECH COM 131402601 DTD 6/12/14 REG MILL COAT PE BEV 30 DEGREE APPLICABLE REQUIREMENTS OF NACE MR0103-2012 ED AND NACE MR0175/ISO 15156-2 2009 ED

| MATERIAL COND: NORMALIZED    |                        |            |                | O.D.: 8.625 (219.075) In (mm) |          |       |          | WALL: 0.322 ( 8.178) In (mm) |      |                  |      |                     |      |               |            |
|------------------------------|------------------------|------------|----------------|-------------------------------|----------|-------|----------|------------------------------|------|------------------|------|---------------------|------|---------------|------------|
| PRODUCT IDENTIFICATION       | TEST TYPE/ ORIENTATION | TEST COND. | GAUGE WIDTH IN | YIELD                         |          | EXT % | TENSILE  |                              | Y/T  | ELONG % (IN 2" ) |      | HARDNESS SCALE: HRB |      | MIN HYDRO PSI | DWELL(SEC) |
|                              |                        |            |                | MIN: PSI                      | MAX: PSI |       | MIN: PSI | MAX: PSI                     |      | MIN:             | MAX: | MIN:                | MAX: |               |            |
| X02753                       | STRIP/L/B              | NR         | 1.5            | 35,000                        | 58,000   | .50   | 60,000   | 71,500                       | 0.69 | 35.0             | 75.5 | 1570                | 5    |               |            |
| X02753                       | STRIP/L/B              | NR         | 1.5            | 49,200                        | 50,000   | .50   | 71,500   | 71,500                       | 0.70 | 48.0             | 46.3 | 1570                | 5    |               |            |
| ** END OF DATA THIS SHEET ** |                        |            |                |                               |          |       |          |                              |      |                  |      |                     |      |               |            |

| LEGEND:                      |      | L - LONGITUDINAL<br>U - UPSET | T - TRANSVERSE<br>NM - NORMALIZED |     |     |    | QT - QUENCH & TEMPERED<br>SR - STRESS RELIEVED |    |    |    | AR - AIR ROLLED<br>TR - THERMOMECHANICAL ROLLED |   |    |      | B - BODY<br>W - WELD |     |    |       |
|------------------------------|------|-------------------------------|-----------------------------------|-----|-----|----|--|----|----|----|---|---|----|------|----------------------|-----|----|-------|
| PRODUCT IDENTIFICATION       | TYPE | C                             | MIN                               | P   | S   | SI | CU   | NI | CR | MO | AL  | N | V  | B    | TI                   | CB  | CO | C.E.* |
|                              |      |                               |                                   |     |     |    |  |    |    |    |   |   |    |      |                      |     |    |       |
| X02753                       | HEAT | 16                            | 100                               | 007 | 005 | 22 | 01   | 00 | 03 | 02 | 031   |   | 00 | 0003 | 002                  | 001 |    |       |
| X02753                       | PROD | 17                            | 99                                | 007 | 005 | 23 | 01   | 00 | 04 | 02 | 032   |   | 00 | 0003 | 002                  | 001 |    |       |
| X02753                       | PROD | 18                            | 100                               | 008 | 005 | 23 | 01   | 00 | 04 | 02 | 033   |   | 00 | 0003 | 002                  | 001 |    |       |
| ** END OF DATA THIS SHEET ** |      |                               |                                   |     |     |    |  |    |    |    |   |   |    |      |                      |     |    |       |

\*C.E. IS BASED ON THE FOLLOWING EQUATION(S):

DECIMAL POSITIONS FOR ELEMENTS ARE INDICATED BY THE LEFT MARGIN, VERTICAL DOTTED LINE OR DECIMAL POINT. ELEMENTS REPORTED IN MASS FRACTION (%)  
00000000 TYJ03B24 8677395101 0-0-0 PAGE 1 OF 2

Please purchase PDFStamp Command Line product to remove this watermark.  
<http://www.verypdf.com>

no (http://www.verypdf.com)



UNITED STATES STEEL CORPORATION

TUBULAR PRODUCTS  
 CERTIFIED TEST REPORT  
 (IN ACCORDANCE WITH ISO 10474/EN10204/DIN50049 "type 3.1")

DATE: 02/17/16  
 TIME: 08:39:36  
 SERIAL NO: F0099536  
 EBS NO: 2001423156 1

|  |  |--|--|------------------|------|--------------------------------------|---------------------|------|-----------|-------------------------------------|------|------------|---|--------------------------|----|-----|---------|-----|-----|-----|--|--|--|
| MILL ORDER/ITEM NO<br><b>DR93682 01</b>  |  | SHIPPERS NO.     |      | P.O. NUMBER<br><b>154876-00</b>      |                     |      |           |                                     |      |            |   |                          |    |     |         |     |     |     |  |  |  |
| MATERIAL COND: <b>NORMALIZED</b>   |  |                  |      | O.D.: <b>8.625 (219.075)</b> in (mm) |                     |      |           | WALL: <b>0.322 ( 8.178)</b> in (mm) |      |            |   |                          |    |     |         |     |     |     |  |  |  |
| PRODUCT IDENTIFICATION   |  | FLAT             | BEND | GRAIN SIZE                           | MIN COLLAPSE        | DIR  | TEST LOC. | TEMP                                | SIZE | TEST COND. | CHARPY V-NOTCH IMPACT TESTING<br>FT-LBS |                          |    |     | % SHEAR |     |     |     |  |  |  |
|  |  |                  |      |                                      |                     |      |           | DEG F                               |      |            | 1                                       | 2                        | 3  | AVG | 1       | 2   | 3   | AVG |  |  |  |
| X02753<br>X02753   |  | OK<br>OK         |      |                                      |                     | L    | B         | - 60                                | 2/3  | N          | 78                                      | 56                       | 82 | 72  | 100     | 100 | 100 | 100 |  |  |  |
| ** END OF DATA THIS SHEET **   |  |                  | LEGEND   |  | L - LONGITUDINAL |      |                                      | T - TRANSVERSE      |      |           | B - BODY                            |      | W - WELD   |   | HAZ - HEAT AFFECTED ZONE |    |     |         |     |     |     |  |  |  |
| TESTING / INSPECTION INFORMATION   |  |                  | TEST / INSPECTION  |  |                  |      | YES                                  | RESULTS / COMMENTS  |      |           |                                     |      |            |   |                          |    |     |         |     |     |     |  |  |  |
| FULL LENGTH VISUAL   |  |                  |      | X                                    |                     |      |           |                                     |      |            |   |                          |    |     |         |     |     |     |  |  |  |
| FULL LENGTH EMI  |  |                  |      | X                                    | OD                  | OD/D | X         | L                                   | LT   | X          | 10.0/10.0% NOTCH                        |                          |    |     |         |     |     |     |  |  |  |
| FULL LENGTH MPI  |  |                  | FULL LENGTH UT   |  |                  |      |                                      | ID                  | OD/D | L         | LT                                  |      |            |   |                          |    |     |         |     |     |     |  |  |  |
| END AREA INSPECTION (PLAIN END)  |  |                  |      | X                                    | MPI                 | X    | UT        |                                     |      |            |   |                          |    |     |         |     |     |     |  |  |  |
| SPECIAL END AREA (SEA) INSP  |  |                  |      |                                      | MPI                 | UT   |           |                                     |      |            |   |                          |    |     |         |     |     |     |  |  |  |
| FULL LENGTH DRIFT  |  |                  |      |                                      | DRIFT MANDREL SIZE: |      |           |                                     |      |            |   |                          |    |     |         |     |     |     |  |  |  |
| ADDITIONAL NOTES/COMMENTS  |  |                  | ALL MELTING AND MANUFACTURING TOOK PLACE IN THE USA.<br>MANUFACTURED IN AN ISO 9001 CERTIFIED FACILITY - CERTIFICATE #30727.<br>NO REPAIRS BY WELDING. NO MERCURY OR MERCURY COMPOUNDS ARE ADDED TO THE STEEL AND ALL MERCURY<br>** END OF DATA ** |  |                  
THIS IS TO CERTIFY THAT THE PRODUCT DESCRIBED HEREIN WAS MANUFACTURED, SAMPLED, TESTED AND/OR INSPECTED IN ACCORDANCE WITH THE SPECIFICATION AND FULFILLS THE REQUIREMENTS IN SUCH RESPECTS.

PREPARED BY THE OFFICE OF: **MICHAEL HENRY - MANAGER, Q A**

DATE 02/17/16

00000000

TYJ03B24

8677395101

0-0-0

PAGE

2 OF

2

\*\*

Please purchase PDFStamp Command Line product to remove this watermark.  
<http://www.verypdf.com>



UNITED STATES STEEL CORPORATION

TUBULAR PRODUCTS  
 ADDITIONAL COMMENTS SHEET

DATE: 02/17/16  
 TIME: 08:39:39  
 PAGE: 1 OF 1

|                                  |              |                          |      |   |
|----------------------------------|--------------|--------------------------|------|---|
| MILL ORDER/ITEM NO<br>DR93682 01 | SHIPPERS NO. | P.O. NUMBER<br>154876-00 | HEAT | SERIAL NUMBER: F0099536   |
| SOLD TO ADDRESS                  |              | MAIL TO ADDRESS          |      | VENDOR<br>UNITED STATES STEEL CORP<br>FAIRFIELD TUBULAR OPERATIONS<br>P.O. BOX 599<br>FAIRFIELD ALABAMA 35064 |

HEAT X02753 - MELTED AT: FAIRFIELD WORKS, FAIRFIELD, AL 35064  
 END OF DATA

**VS**

Valeo Tubos e Equipamentos S.A.  
Rua Industrial s/n - Distrito Industrial  
Jacobs - MG  
35498-000 - Brazil

Trading Company: Sumitomo Corporation  
NSSMC work No.: JYYS03910000  
Buyer: Nippon Steel & Sumitomo Metal Corporation  
Buyer Order No.: 3P18S274206  
Customer: SUMITOMO CORPORATION OF AMERICA  
Customer Order No / Item: 30457 / 8

Inspection Company: Valeo Tubos e Sumitomo Tubos do Brasil Ltda.

Size (O.D. X W.T.): 8.625 inch X 0.500 inch  
Grade: X42 # B # B  
Standard: API SPEC 5L, 10.2012, 45TH EDITION # PSL 1

In accordance also to the standards:

ASTM A106 - 11 / ASME SA-106 - 10, ADDENDA 2011 / ASTM A 53 - 12 / ASTM A 530 - 10 / ASME SA-53 - 10, ADDENDA 2011  
Description of Product: SEAMLESS STEEL PIPE Heat Treatment: AS ROLLED, BEVELED ENDS 30 DEG.  
External Surface Protection: UV-VARNISH  
Tolerances: Outside Diameter: - 0.75 % / + 0.75 %  
Length: RANDOM: 40.0 FT / 42.0 FT

Pipes Ends Protector: POLYETHYLENE CAP WITH HOLE  
Wall Thickness: - 12.5 % / + 15.0 %

Acceptance Length: RANDOM, 10 %, 38.0 FT / 40.0 FT

Standard Marking:  
PAINT STENCILED: VSB LOGO API SPEC. 5L 8867 API MONOGRAM MONTH/YEAR ASTM/ASME A/SA-106 A/SA-53 8.625 0.500 B742 PSL 1 B#B JYYS039 10000 HEAT NUMBER PIPE TALLY  
NO LENGTH B & TESTED 2070 POUNDS WEIGHT NSSMC LOGO

Shipping Marking:  
SUMITOMO CORPORATION OF AMERICA HOUSTON P O. NO. 30457 MADE IN BRAZIL

| Heat No. | Min. allowed tempering temperature (°F) | Pieces | Length(m) | Weight(kgf) | Length(ft) | Weight(lbf) |
|----------|---|--------|-----------|-------------|------------|-------------|
| 103189   | N/A                                     | 145    | 1837.83   | 117817      | 6028.7     | 259061      |
| 103200   | N/A                                     | 149    | 1890.48   | 121614      | 8202.1     | 288114      |
| 103968   | N/A                                     | 84     | 1026.32   | 63912       | 3364       | 145313      |
| 103967   | N/A                                     | 134    | 1697.84   | 109055      | 5570.7     | 240449      |
| 103968   | N/A                                     | 149    | 1888.10   | 121324      | 8198.4     | 287472      |
| 103969   | N/A                                     | 128    | 1626.50   | 104659      | 5337.6     | 230739      |
| 103970   | N/A                                     | 88     | 1103.68   | 71035       | 3620.2     | 156610      |
| Total    |   | 874    | 11088.55  | 711526      | 36319.7    | 1586658     |

The product is satisfactory in the following tests/inspections:

Dimensional # Visual # Flattening Test # Flux Leakage Electromagn. Test : API 5L LONG.NS EXT # Maximum Residual Magnetism : 30 GAUSS # Hydrostatic Test : 2870.0 PSI 5 s #

CHEMICAL COMPOSITION (%) Process: Electric Arc Furnace (EAF), heats fully killed

Req: C+Mn/S+(Cr+Mo+V)/S +(Ni+Cu)/S

CE1: C + Cu + Mo + Ni + V

CE2: Nb + V

CE3: Nb + V + Ti

**VS**

VASARREZ & BASTOS  
 INGENHARIA DE METALURGIA  
 Rua Industrial s/n - Distrito Industrial  
 Jacoaba - MG  
 35488-000 - Brazil

**INSPECTION CERTIFICATE**  
 EN 10204.3.1

No.: 30018887

Sheet: 2 / 3

|           |                  |        | C    | Mn   | P     | S     | Si   | NI   | Cr   | Mo   | Cu   | V    | Nb    | TI    | Coq   | CEI  | CEZ  | CEA  |      |
|-----------|------------------|--------|------|------|-------|-------|------|------|------|------|------|------|-------|-------|-------|------|------|------|------|
| Required: | Ladle analysis   | Min.   |      | 0.29 |       |       | 0.10 |      |      |      |      |      |       |       |       |      |      |      |      |
|           |                  | Max.   | 0.23 | 1.20 | 0.030 | 0.030 |      | 0.40 | 0.40 | 0.15 | 0.40 | 0.05 |       | 0.001 | 0.43  | 1.00 | 0.05 | 0.15 |      |
|           | Product analysis | Min.   |      | 0.29 |       |       | 0.10 |      |      |      |      |      |       |       |       |      |      |      |      |
|           |                  | Max.   | 0.23 | 1.20 | 0.030 | 0.030 |      | 0.40 | 0.40 | 0.15 | 0.40 | 0.05 |       | 0.001 | 0.43  | 1.00 | 0.05 | 0.15 |      |
| Heat No.  | Pipe No.         |        |      |      |       |       |      |      |      |      |      |      |       |       |       |      |      |      |      |
| 103199    | 201120           | Ladle  | 0.18 | 1.04 | 0.011 | 0.004 | 0.27 | 0.02 | 0.05 | 0.00 | 0.05 | 0.02 | 0.000 | 0.000 | 0.002 | 0.37 | 0.14 | 0.02 | 0.02 |
|           | 301120           | check1 | 0.19 | 1.05 | 0.011 | 0.003 | 0.25 | 0.02 | 0.06 | 0.00 | 0.05 | 0.02 | 0.000 | 0.001 | 0.002 | 0.38 | 0.14 | 0.02 | 0.02 |
| 103200    | 308110           | Ladle  | 0.19 | 1.04 | 0.012 | 0.004 | 0.25 | 0.03 | 0.06 | 0.01 | 0.06 | 0.02 | 0.000 | 0.000 | 0.002 | 0.39 | 0.17 | 0.03 | 0.03 |
|           | 406120           | check1 | 0.20 | 1.04 | 0.011 | 0.004 | 0.25 | 0.03 | 0.05 | 0.01 | 0.06 | 0.02 | 0.000 | 0.001 | 0.002 | 0.40 | 0.17 | 0.02 | 0.02 |
| 103966    | 104210           | Ladle  | 0.18 | 1.03 | 0.012 | 0.002 | 0.23 | 0.03 | 0.10 | 0.01 | 0.03 | 0.02 | 0.000 | 0.001 | 0.002 | 0.38 | 0.19 | 0.02 | 0.02 |
|           | 502210           | check2 | 0.19 | 1.04 | 0.011 | 0.002 | 0.23 | 0.03 | 0.10 | 0.01 | 0.03 | 0.02 | 0.000 | 0.001 | 0.002 | 0.39 | 0.19 | 0.02 | 0.02 |
| 103967    | 104110           | Ladle  | 0.18 | 1.05 | 0.012 | 0.001 | 0.23 | 0.03 | 0.10 | 0.01 | 0.03 | 0.02 | 0.000 | 0.001 | 0.002 | 0.40 | 0.19 | 0.02 | 0.02 |
|           | 405120           | check1 | 0.18 | 1.04 | 0.013 | 0.002 | 0.24 | 0.02 | 0.08 | 0.01 | 0.03 | 0.02 | 0.000 | 0.001 | 0.002 | 0.38 | 0.18 | 0.02 | 0.02 |
| 103968    | 101120           | Ladle  | 0.18 | 1.03 | 0.015 | 0.003 | 0.24 | 0.03 | 0.09 | 0.02 | 0.04 | 0.02 | 0.000 | 0.001 | 0.002 | 0.39 | 0.20 | 0.02 | 0.02 |
|           | 106120           | check2 | 0.18 | 1.05 | 0.012 | 0.002 | 0.23 | 0.02 | 0.08 | 0.01 | 0.03 | 0.02 | 0.000 | 0.001 | 0.002 | 0.38 | 0.18 | 0.02 | 0.02 |
| 103969    | 106120           | Ladle  | 0.18 | 1.03 | 0.013 | 0.003 | 0.24 | 0.03 | 0.09 | 0.02 | 0.04 | 0.02 | 0.000 | 0.001 | 0.002 | 0.39 | 0.20 | 0.02 | 0.02 |
|           | 405110           | check1 | 0.19 | 1.06 | 0.016 | 0.003 | 0.24 | 0.03 | 0.09 | 0.02 | 0.04 | 0.02 | 0.000 | 0.001 | 0.002 | 0.40 | 0.20 | 0.02 | 0.02 |
| 103970    | 303120           | Ladle  | 0.19 | 1.02 | 0.013 | 0.003 | 0.23 | 0.03 | 0.08 | 0.01 | 0.05 | 0.03 | 0.000 | 0.001 | 0.002 | 0.40 | 0.20 | 0.03 | 0.03 |
|           | 401130           | check2 | 0.19 | 1.05 | 0.013 | 0.003 | 0.23 | 0.03 | 0.08 | 0.01 | 0.05 | 0.03 | 0.000 | 0.001 | 0.002 | 0.40 | 0.20 | 0.03 | 0.03 |
|           |                  | check1 | 0.19 | 1.05 | 0.012 | 0.003 | 0.23 | 0.03 | 0.08 | 0.01 | 0.05 | 0.03 | 0.000 | 0.001 | 0.002 | 0.39 | 0.20 | 0.03 | 0.03 |

CE: Combined Elements ; Ceq: Carbon Equivalent

**TENSILE TEST** S.Direction: Longitudinal

Temperature: Room Temperature  
 Type of specimen: STRIP 1.5" WIDTH  
 Gauge Length: LD=2"  
 Thickness: 0.850"  
 YS method: 0.50 %

| Required | Heat No. | Pipe no. | Position of Sample | YS TS E RA YS/TS |       |       |      |  |
|----------|----------|----------|--------------------|------------------|-------|-------|------|--|
|          |          |          |                    | (Psi)            | (Psi) | %     | %    |  |
|          |          |          |                    | Min.             | 42100 | 60200 | 30.0 |  |
|          |          |          |                    | Max.             |       |       |      |  |
|          | 103199   | 201120   | Top                |                  | 52200 | 78500 | 40.0 |  |
|          | 103200   | 308110   | Bottom             |                  | 53800 | 82200 | 40.0 |  |
|          | 103966   | 502210   | Bottom             |                  | 51100 | 79000 | 40.0 |  |
|          | 103967   | 405120   | Bottom             |                  | 48700 | 76000 | 41.0 |  |
|          | 103968   | 106120   | Bottom             |                  | 49900 | 77300 | 41.0 |  |
|          | 103969   | 405110   | Bottom             |                  | 52400 | 79800 | 40.0 |  |
|          | 103970   | 206120   | Bottom             |                  | 51200 | 78800 | 40.0 |  |

VS

VSB - VLS - VLS - VLS - VLS  
Rua Industrial s/n - Distrito Industrial  
Jacareá - MG  
35458-000 - Brasil

INSPECTION CERTIFICATE  
EN 10204.3.1

No.:  
30018887

Sheet: 3 / 3

YS-yield strength; FS-tensile strength; E-elongation

**REMARKS**

THE DATA PRESENTED WAS CONVERTED FROM SI MEASUREMENT SYSTEM USED FOR THE ORIGINAL INSPECTION

§ NACE MR0103-2012/MR0175/ISO15156-2/2009: SATISFACTORY & MANUFACTURED FROM FULLY KILLED CARBON STEEL

We hereby certify that this product has been manufactured and examined in accordance with all requirements of the standards and specifications and all the results are found to be satisfactory.

This testimonial and certificate respectively is recorded by a computer system and is valid without signature. Alteration or use for other products are regarded as falsification of documents and will be subject to criminal jurisdiction.

QUALITY CONTROL DEPARTMENT

FAK: +55 31 2141 5365  
e-mail: carlos.horta@vstbros.com

Carlos Eduardo Lima Horta  
Technical Responsible

Date  
12.12.2013

Ruam Felipe Vieira 1320  
Carlos Horta  
D/ Gerente  
Qualidade - TQM  
VSB



**ИНТЕРПАЙП**  
НИКО ТЬЮБ

ОБЩЕСТВО С ОГРАНИЧЕННОЙ ОТВЕТСТВЕННОСТЬЮ  
"ИНТЕРПАЙП НИКО ТЬЮБ"  
Украина, г. Никополь, пр. Трубников, 56  
Тел./факс +38 (05662) 2-10-70

ИНСПЕКЦИОННЫЙ СЕРТИФИКАТ № 1792/Б  
INSPECTION CERTIFICATE № 1792/Б  
EN 10204-2004/3.1 / ISO 10474-2013

Грузополучатель BUYER North American Interpipe, Inc. 1800 West Loop South, Suite 1350, Houston, Texas 77027, USA.

Контракт № СОС16/1679  
Contract #

Страна Country USA

Заводской заказ №008260  
Production order #

Транспортное средство № Vehicle № 65468124

Номер заказа клиента Customer's ref #PO#10P23015

Дата Date 11.04.2017г.

Лист 1 Sheet Листов 1 Sheets

| Наименование и код товара<br>Description and code of goods  |                         | Наименования стандартов<br>Specifications  |  |                       |                                 |                           |                                 | Класс поставки<br>Class of delivery | Тип резьбы<br>Thread type |                                     |                          |                       |
|---|-------------------------|--|--|-----------------------|---------------------------------|---------------------------|---------------------------------|-------------------------------------|---------------------------|-------------------------------------|--------------------------|-----------------------|
| Трубы стальные бесшовные горячекатаные для нефтегазопроводов<br>Seamless steel hot-rolled pipes for oil and gas pipelines |                         | API Spec 5L - 2012/ ASTM A106/A106M-2015/ ASME SA106/SA106M-2015 / ASTM A53/A53M-2012/ ASME SA53/SA53M-2015 / NACE MR0175-2015/ NACE MR0103-2012 |  |                       |                                 |                           |                                 | PSL1                                |                           |                                     |                          |                       |
| № поз. / Item No  | Номер пакета / Bundle # | Номер трубы / Pipe #   | Марка стали / Grade кратко обозначение / Brief Designation | Номер плавки / Heat # | Номер партии / Inspection Lot # | Размеры / Dimensions      |                                 |                                     | шт / piece                | Фактический вес / Actual weight     |                          |                       |
|   |                         |  |  |                       |                                 | диаметр / OD дюйм / inch  | толщина стенки / WT дюйм / inch | Длина / length фут / ft             |                           | общая длина / Total length фут / ft | брутто / gross фунт / lb | нетто / net фунт / lb |
| 1.  | 17-38-04547             |  | B/ X42<br>NPS 8  | 1170306<br>Sch 80 XS  | 472                             | 8.625                     | 0.500                           | 38.0-40.0                           | 114.8                     | 3                                   | 5 016                    | 5 004                 |
|   |                         |  |  |                       |                                 | <b>TOTAL/ИТОГО</b>        |                                 |                                     | 114.8                     | 3                                   | 5 016                    | 5 004                 |
|   |                         |  |  |                       |                                 | <b>BUNDLES/ПАКЕТОВ 1</b>  |                                 |                                     |                           |                                     |                          |                       |
| 2.  | 17-38-07458             |  | B/ X42   | 1171091               | 909                             | 8.625                     | 0.500                           | 20.0-21.0                           | 145.7                     | 7                                   | 6 528                    | 6 504                 |
| 3.  | 17-38-07457             |  | B/ X42   | 1171091               | 909                             | 8.625                     | 0.500                           | 20.0-21.0                           | 145.9                     | 7                                   | 6 548                    | 6 526                 |
| 4.  | 17-38-07454             |  | B/ X42   | 1171091               | 909                             | 8.625                     | 0.500                           | 20.0-21.0                           | 145.8                     | 7                                   | 6 526                    | 6 504                 |
| 5.  | 17-38-07456             |  | B/ X42   | 1171091               | 909                             | 8.625                     | 0.500                           | 20.0-21.0                           | 145.8                     | 7                                   | 6 526                    | 6 504                 |
| 6.  | 17-38-07451             |  | B/ X42   | 1171086               | 913                             | 8.625                     | 0.500                           | 20.0-21.0                           | 146.0                     | 7                                   | 6 515                    | 6 493                 |
| 7.  | 17-38-07455             |  | B/ X42   | 1171091               | 909                             | 8.625                     | 0.500                           | 20.0-21.0                           | 145.8                     | 7                                   | 6 515                    | 6 493                 |
| 8.  | 17-38-07435             |  | B/ X42   | 1171091               | 909                             | 8.625                     | 0.500                           | 20.0-21.0                           | 146.3                     | 7                                   | 6 515                    | 6 493                 |
| 9.  | 17-38-07487             |  | B/ X42   | 1171091               | 909                             | 8.625                     | 0.500                           | 20.0-21.0                           | 145.9                     | 7                                   | 6 504                    | 6 482                 |
| 10.   | 17-38-07486             |  | B/ X42   | 1171091               | 909                             | 8.625                     | 0.500                           | 20.0-21.0                           | 145.9                     | 7                                   | 6 482                    | 6 460                 |
| 11.   | 17-38-07469             |  | B/ X42   | 1171091               | 909                             | 8.625                     | 0.500                           | 20.0-21.0                           | 146.0                     | 7                                   | 6 537                    | 6 515                 |
| 12.   | 17-38-07470             |  | B/ X42<br>NPS 8  | 1171091<br>Sch 80 XS  | 909                             | 8.625                     | 0.500                           | 20.0-21.0                           | 146.4                     | 7                                   | 6 548                    | 6 526                 |
|   |                         |  |  |                       |                                 | <b>TOTAL/ИТОГО</b>        |                                 |                                     | 1605.5                    | 77                                  | 71 742                   | 71 500                |
|   |                         |  |  |                       |                                 | <b>BUNDLES/ПАКЕТОВ 11</b> |                                 |                                     |                           |                                     |                          |                       |
|   |                         |  |  |                       |                                 | <b>TOTAL/ИТОГО</b>        |                                 |                                     | 1720.3                    | 80                                  | 76 758                   | 76 504                |
|   |                         |  |  |                       |                                 | <b>BUNDLES/ПАКЕТОВ 12</b> |                                 |                                     |                           |                                     |                          |                       |



**INTERPIPE**  
НИКО ТЬЮБ

LIMITED LIABILITY COMPANY  
"INTERPIPE NIKO TUBE"  
UKRAINE, Nikopol, 56, Trubnikov ave. Tel./fax +38 (05662) 2-10-70

Please purchase PDFStamp Command Line product to remove this watermark.  
<http://www.verypdf.com>

ИНСПЕКЦИОННЫЙ СЕРТИФИКАТ № 1792/Б  
INSPECTION CERTIFICATE № 1792/Б

Лист 1  
Sheet

Листов 2  
Sheets

Химический состав по сертификатам данным на заготовку и результаты контроля химического состава металла труб  
Heat analysis acc. to the billet manufacturer certificate & results of chemical analysis of pipes

| Номер плавки<br>Heat # | Лаборатория<br>Laboratory | Химический состав в %<br>Chemical composition % |         |         |         |         |         |         |          |          |          |         |          |          | Завод изготовитель заготовки<br>Steel supplier |   |   |
|------------------------|---------------------------|---|---------|---------|---------|---------|---------|---------|----------|----------|----------|---------|----------|----------|--|---|---|
|                        |                           | C x100  | Mn x100 | Si x100 | S x1000 | P x1000 | Cr x100 | Ni x100 | Cu x1000 | Mo x1000 | Ti x1000 | V x1000 | Nb x1000 | Al x1000 |  | CE x100                                     |   |
|                        | min                       | -   | 29      | 10      | -       | -       | -       | -       | -        | -        | -        | -       | -        | -        | -  | -   | - |
|                        | max                       | 28  | 106     | -       | 30      | 30      | 40      | 40      | 40       | 150      | -        | 80      | -        | -        | -  | -   | - |
| 1170306                | DneprSteel NIKOTUBE*      | 17.7  | 51.8    | 25.1    | 5       | 9       | 11.5    | 10.6    | 16.6     | 10       | 2        | 2       | 2        | 37       | 30.7   | "MP"DNEPROSTEEL"LLC<br>ООО"МЗ"Днепропеталь" |   |
|                        | NIKOTUBE*                 | 18  | 52      | 27      | 5       | 8       | 12      | 10      | 17       | 10       | 3        | 1       | 1        | 39       | 31.3   |   |   |
| 1171086                | DneprSteel NIKOTUBE*      | 18  | 53      | 27      | 5       | 9       | 12      | 10      | 17       | 10       | 3        | 1       | 1        | 39       | 31.3   |   |   |
|                        | NIKOTUBE*                 | 20  | 87      | 24      | 2       | 11      | 10      | 10      | 16       | 10       | 1        | 2       | 2        | 25       | 38.5   | "MP"DNEPROSTEEL"LLC<br>ООО"МЗ"Днепропеталь" |   |
| 1171091                | DneprSteel NIKOTUBE*      | 21  | 87      | 26      | 3       | 10      | 10      | 10      | 17       | 13       | 3        | 1       | 1        | 27       | 39.6   |   |   |
|                        | NIKOTUBE*                 | 21  | 86      | 26      | 3       | 10      | 10      | 10      | 17       | 13       | 3        | 1       | 1        | 27       | 39.4   |   |   |
| 1171091                | DneprSteel NIKOTUBE*      | 18  | 48      | 27      | 4       | 9       | 12      | 11      | 18       | 10       | 1        | 1       | 2        | 37       | 30.6   | "MP"DNEPROSTEEL"LLC<br>ООО"МЗ"Днепропеталь" |   |
|                        | NIKOTUBE*                 | 19  | 49      | 30      | 6       | 9       | 13      | 11      | 17       | 12       | 3        | 1       | 1        | 42       | 31.9   |   |   |
|                        | min                       | 19  | 49      | 29      | 6       | 9       | 12      | 11      | 18       | 12       | 3        | 1       | 1        | 41       | 31.8   |   |   |

Анализ плавки согласно сертификата завода-изготовителя/Heat analysis acc.to the manufacturer certificate.\*-control analysis of pipes/ \*-контрольный анализ от труб.

Сталь произведена методом плавления в электродуговой печи с последующей непрерывной разливкой. Сталь полностью раскисленная и мелкозернистая. Сталь раскисленная алюминием. Адрес завода изготовителя заготовки: Украина, 49051, г.Днепропетровск, ул.Винокурова, 4/  
Steel has been produced by the EAF with continuous casting process. Steel is fully killed and made to fine grain practice. Aluminium killed steel. The address of steel supplier: Ukraine, 49051, Dnipropetrovsk, 4 Vinokurova str.

При расчете углеродного эквивалента использована формула: /When calculating the carbon equivalent the following formula was used:  
CE=C+Mn/5+(Cr+Mo+V)/5+(Ni+Cu)/15

Результаты испытаний труб - Test results for pipes

| Номер плавки<br>Heat# | Номер партии<br>Lot# | Механические свойства<br>Mechanical Properties |  |                                       |                                 |   |  |   |                                     |                       |                             | Тип надреза, темп. ратура<br>Type of notch, temperature | Норматив/Norm | Ср.значение<br>Average | Площадь сдвига,<br>Shear area | Размер образцов **<br>Specimens size ** |
|-----------------------|----------------------|--|--|---------------------------------------|---------------------------------|---|--|---|-------------------------------------|-----------------------|-----------------------------|---|---------------|------------------------|-------------------------------|---|
|                       |                      | Испытание на растяжение<br>Tensile test        |  |                                       |                                 |   | Испытание на удар /Impact test                       |   |                                     |                       |                             |   |               |                        |                               |   |
|                       |                      | Предел прочности<br>Tensile strength           | Предел текучести R0.5<br>Yield strength R0.5 | Относительное удлинение<br>Elongation | Отношение отов<br>Ratio of otop | Ориентация образцов<br>Specimens orientation* | Ширина полосового образца<br>Width of strip specimen | Диаметр цилиндрического образца<br>Diameter of cylindrical specimen | Длина образца<br>Length of specimen | Твердость<br>Hardness | Среднее значение<br>Average |   |               |                        |                               |   |
|                       |                      | PSI  | PSI  | %                                     | -                               |   | дюйм/<br>inch  | дюйм/<br>inch   | дюйм<br>inch                        | HRB                   | HRC                         |   | min           |                        | %                             | дюйм/<br>inch                           |
|                       | min                  | 60200  | 42100  | 30.0                                  | -                               |   |  |   | 100                                 | -                     | -                           |   |               |                        |                               |   |
|                       | max                  | -  | -  | -                                     | -                               |   |  |   | -                                   | -                     | -                           |   |               |                        |                               |   |
| 1170306               | 472                  | 67500  | 44400  | 40.0                                  |                                 | L   | 1.500  | 1.970   | 78 80 78 av.79                      | <22                   |                             |   |               |                        |                               |   |
| 1171086               | 913                  | 76000  | 47500  | 35.5                                  |                                 | L   | 1.500  | 1.970   | 80 78 79 av.79                      | <22                   |                             |   |               |                        |                               |   |
| 1171091               | 909                  | 68500  | 45600  | 37.0                                  |                                 | L   | 1.500  | 1.970   | 84 83 83 av.83                      | <22                   |                             |   |               |                        |                               |   |
|                       |                      |  |  |                                       |                                 |   |  |   | 83 83 83 av.83                      | <22                   |                             |   |               |                        |                               |   |
|                       |                      |  |  |                                       |                                 |   |  |   | 78 79 77 av.78                      | <22                   |                             |   |               |                        |                               |   |
|                       |                      |  |  |                                       |                                 |   |  |   | 77 77 78 av.77                      | <22                   |                             |   |               |                        |                               |   |

\* L - Продольный образец / Longitudinal specimen; T - поперечный образец / transverse specimen

\*\* Результаты испытаний уменьшенных образцов пересчитаны на полноразмерные/Non-fullsize specimens results convert to fullsize (10x10mm)

Прочие виды контроля / Other tests

| Вид испытания / Type of test                                | Параметры / Criteria                  | Результаты контроля / Test results |
|---|---------------------------------------|------------------------------------|
| Сплюсывание / Flatten'ng test                               | По стандарту / As per Standard**      | Удовлетворительно / Satisfactory   |
| Испытание гидравлическим давлением / Hydrostatic test       | 100% / 20,5 MPa / 2970 PSI / 10 sec * | Удовлетворительно / Satisfactory   |
| Визуальный контроль / Visual inspection                     | По стандарту / As per Standard**      | Удовлетворительно / Satisfactory   |
| Контроль геометрических параметров / Dimensional inspection | По стандарту / As per Standard**      | Удовлетворительно / Satisfactory   |



**ИНТЕРПАЙП**  
НИКО ТЬЮБ

ОБЩЕСТВО С ОГРАНИЧЕННОЙ ОТВЕТСТВЕННОСТЬЮ  
"ИНТЕРПАЙП НИКО ТЬЮБ"  
Украина, г. Никополь, пр. Трубников, 56  
Тел./факс +38 (05662) 2-10-70

ИНСПЕКЦИОННЫЙ СЕРТИФИКАТ № 1792/Б  
INSPECTION CERTIFICATE № 1792/B

Лист 2  
Sheet

Листов 2  
Sheets

Состояние поставки / Delivery condition

|  |   |
|--|---|
| Общие условия / General condition                  | Трубы изготовлены и испытаны в соответствии с требованиями API Spec 5L - 2012/ ASTM A106/A106M-2015/ ASME SA106/SA106M-2015 / ASTM A53/A53M-2012/ ASME SA53/SA53M-2015 / NACE MR0175-2015/ NACE MR0103-2012 и заказа / Pipes were produced and inspected according to requirements of API Spec 5L - 2012/ ASTM A106/A106M-2015/ ASME SA106/SA106M-2015 / ASTM A53/A53M-2012/ ASME SA53/SA53M-2015 / NACE MR0175-2015/ NACE MR0103-2012 and order's requirements |
| Состояние поставки / Delivery condition            | Трубы произведены путем горячей деформации и нормализованы при температуре 845 deg C to 945 deg C cooled at air/Трубы произведены путем горячей деформации и нормализованы при температуре 845...945°С, охлаждены на воздухе  |
| Покрытие / Coating                                 | Трубы покрыты черным лаком / Pipes are coated with black varnish  |
| Фаска (если требуется) / Beveled ends if required  | Стандартная фаска / Bevel as per standard   |
| Защита концов / Protection of pipe ends            | Концы труб оснащены пластиковыми колпачками / The ends of pipes are equipped by plastic caps  |
| Дополнительная информация / Additional information | Масса фактическая/ Actual weight.<br>Ремонт сваркой запрещен. / No weld repair.<br>Объем партии не более чем 200 труб/ Quantity of pipes in the inspection lot is not more than 200 pieces.<br>Сумма концентрации Nb, V, Ti менее 0,150% / The sum of concentration Nb, V, Ti less 0,150%.  |

Страна происхождения: Украина.

Country of origin: Ukraine.

Ваши предложения по улучшению продукции просим направлять на эл.адрес / Please send Your proposals for improving the product by e-mail or fax or by phone

Сергей Филюков@nsp.interpipe.biz fax +38(0566)639379 phone +38(0566)639649

с-май: info@rus.interpipe.biz Phone: 17133330333 Fax: 17133330330

Этот инспекционный сертификат относится только к перечисленной в нем продукции. Недопустимо внесение изменений или другое неправомерное использование сертификата. This inspection certificate is only for the listed products. Modification or unauthorized use of the certificate is strictly prohibited. Violations can be considered as forgery and is subject to prosecution.

Инспекционный сертификат сформирован и проверен контролером сертифицированным МОРЗОЗ Н.А.


Inspection Certificate was drawn up and checked by the Certificate Inspector MOROZ N.A.

Дата 1: 04.2017

Date:

Подпись инспектора 3-й стороны:  
Signature of 3-rd Part Inspector:

Подпись ОТК:  
Signatures QCD:

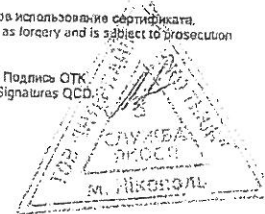

**INTERPIPE**  
NIKO TUBE

LIMITED LIABILITY COMPANY  
"INTERPIPE NIKO TUBE"

UKRAINE, Nikopol, 56, Trubnikov ave. Tel./fax +38 (05662) 2-10-70

Please purchase PDFStamp Command Line product to remove this watermark.  
<http://www.verypdf.com>

Please purchase PDFStamp Command Line product to remove this watermark.  
<http://www.verypdf.com>



**ИНТЕРПАЙП**  
НИКО ТЬЮБ

ОБЩЕСТВО С ОГРАНИЧЕННОЙ ОТВЕТСТВЕННОСТЬЮ

"ИНТЕРПАЙП НИКО ТЬЮБ"

Украина, г. Никополь, пр. Трубников, 56

Тел./факс +38 (05662) 2-10-70

ИНСПЕКЦИОННЫЙ СЕРТИФИКАТ № 6565/Б  
INSPECTION CERTIFICATE № 6565/Б  
EN 10204-2004/3.1

Грузополучатель BUYER North American Interpipe, Inc. 1800 West Loop South, Suite 1350, Houston, Texas 77027, USA

Контракт № COC17/1154  
Contract #

Страна Country USA

Заводской заказ №008108  
Production order #  
Номер заказа клиента  
Customer's ref #P20398

Транспортное средство № Vehicle № ВН8083НО/ВН8828ХК

Лист 1 Листов 1  
Sheet Sheets

Дата Date 25.11.2017г.

| Наименование и код товара<br>Description and code of goods  |                      |                   |  | Наименование стандартов<br>Specifications  |                              |                               |                                      | Класс поставки<br>Class of delivery | Тип резьбы<br>Thread type             |             |                                  |                            |
|---|----------------------|-------------------|--|--|------------------------------|-------------------------------|--------------------------------------|-------------------------------------|---------------------------------------|-------------|----------------------------------|----------------------------|
| Трубы стальные бесшовные горячекатаные для трубопроводов<br>Seamless steel hot-rolled pipes for pipelines |                      |                   |  | ASTM A106/A106M-2015/ ASME SA106/SA106M-2015/ ASTM A53/A53M-2012/ ASME SA53/SA53M-2015/ ASTM A333/A333M-2016/ ASME SA333/SA333M-2015/ NACE MR0175-2015/ NACE MR0103-2012 |                              |                               |                                      |                                     |                                       |             |                                  |                            |
| № поз.<br>Item No   | № пакета<br>Bundle # | № труба<br>Pipe # | Марка стали<br>Grade<br>краткое обозначение<br>Brief Designation | № плавки<br>Heat #   | № партии<br>Inspection Lot # | Размеры<br>Dimensions         |                                      |                                     | общая длина<br>Total length<br>фут ft | шт<br>piece | Фактический вес<br>Actual weight |                            |
|   |                      |                   |  |  |                              | диаметр<br>OD<br>дюйм<br>inch | толщина стенки<br>WT<br>дюйм<br>inch | длина<br>length<br>фут<br>ft        |                                       |             | брутто<br>gross<br>фунт<br>lb    | нетто<br>net<br>фунт<br>lb |
| 1.  | 17-38-27415          |                   | 6/ В/ С  | 1174593  | 3457                         | 8.625                         | 0.500                                | 38.2                                | 152.4                                 | 4           | 6 812                            | 6 801                      |
| 2.  | 17-38-27416          |                   | 6/ В/ С  | 1174593  | 3457                         | 8.625                         | 0.500                                | 38.2                                | 152.8                                 | 4           | 6 834                            | 6 823                      |
| 3.  | 17-38-27417          |                   | 6/ В/ С  | 1174593  | 3457                         | 8.625                         | 0.500                                | 38.2                                | 37.8                                  | 1           | 1 700                            | 1 698                      |
| 4.  | 17-38-27414          |                   | 6/ В/ С  | 1174593  | 3457                         | 8.625                         | 0.500                                | 38.2                                | 152.4                                 | 4           | 6 812                            | 6 801                      |
| 5.  | 17-38-27413          |                   | 6/ В/ С  | 1174593  | 3457                         | 8.625                         | 0.500                                | 38.2                                | 152.3                                 | 4           | 6 878                            | 6 867                      |
| 6.  | 17-38-27419          |                   | 6/ В/ С  | 1174593  | 3457                         | 8.625                         | 0.500                                | 38.2                                | 152.5                                 | 4           | 6 812                            | 6 801                      |
| 7.  | 17-38-27420          |                   | 6/ В/ С  | 1174593  | 3457                         | 8.625                         | 0.500                                | 38.2                                | 152.0                                 | 4           | 6 834                            | 6 823                      |
| 8.  | 17-38-27450          |                   | 6/ В/ С  | 1174593  | 3457                         | 8.625                         | 0.500                                | 38.2                                | 38.0                                  | 1           | 1 700                            | 1 698                      |
|   |                      | NPS 8             |  | Sch 80 XS  |                              | TOTAL/ИТОГО                   |                                      |                                     | 990.2                                 | 26          | 44 382                           | 44 312                     |
| BUNDLES/ПАКЕТОВ 8   |                      |                   |  |  |                              |                               |                                      |                                     |                                       |             |                                  |                            |



**INTERPIPE**  
NIKO TUBE

LIMITED LIABILITY COMPANY

"INTERPIPE NIKO TUBE"

UKRAINE, Nikopol, 56, Trubnikov ave. Tel./fax +38 (05662) 2-10-70

Please purchase PDFStamp Command Line product to remove this watermark.  
<http://www.verypdf.com>

Химический состав по сертификатным данным на заготовку и результаты контроля химического состава металла труб  
Heat analysis acc. to the billet manufacturer certificate & results of chemical analysis of pipes

| Номер плавки Heat# | Лаборатория Laboratory | Химический состав в % Chemical composition % |         |         |         |         |         |         |         |          |          |         |          |          | Завод изготовитель заготовки Steel supplier |   |                      |
|--------------------|------------------------|--|---------|---------|---------|---------|---------|---------|---------|----------|----------|---------|----------|----------|---|---|----------------------|
|                    |                        | C x100                                       | Mn x100 | Si x100 | S x1000 | P x1000 | Cr x100 | Ni x100 | Cu x100 | Mo x1000 | Ti x1000 | V x1000 | Nb x1000 | Al x1000 |   |   |                      |
| min                |                        | -  | 29      | 10      | -       | -       | -       | -       | -       | -        | -        | -       | -        | -        | -   | - | -                    |
| max                |                        | 30   | 106     | -       | 25      | 25      | 30      | 40      | 40      | 120      | -        | 80      | 20       | -        | -   | - |                      |
| 1174593            | DneproSteel            | 22   | 97      | 28      | 5       | 10      | 7       | 10      | 15      | 11       | 20       | 3       | 3        | 41       |   |   | "MP"DNEPROSTEEL" LLC |
|                    | NIKOTUBE*              | 23   | 92      | 26      | 2       | 11      | 9       | 9       | 15      | 9        | 16       | 1       | 1        | 38       |   |   | ООО"МЗ"Днепросталь"  |
|                    | NIKOTUBE*              | 23   | 92      | 26      | 2       | 11      | 9       | 9       | 15      | 9        | 15       | 1       | 1        | 37       |   |   |                      |

Анализ плавки согласно сертификата завода-изготовителя/Heat analysis acc.to the manufacturer certificate. \*control analysis of pipes/контрольный анализ от труб.  
Сталь произведена методом плавления в электродуговой печи с последующей непрерывной разливкой. Сталь полностью раскисленная и мелкозернистая. Сталь раскисленная алюминием. Адрес завода изготовителя заготовки: Украина, 49051, г.Днепропетровск, ул.Винокурова, 4/ Steel has been produced by the EAF with continuous casting process. Steel is fully killed and made to fine grain practice. Aluminium killed steel. The address of steel supplier: Ukraine,49051, Dnipropetrovsk, 4 Vinokurova str.

Результаты испытаний труб - Test results for pipes

| Номер плавки Heat# | Номер партии Lot# | Механические свойства Mechanical Properties |                                 |                                    |                            |   |  |  |                                  |   |                         |   | Испытание на удар /Impact test |                      |                            |
|--------------------|-------------------|---|---------------------------------|------------------------------------|----------------------------|---|--|--|----------------------------------|---|-------------------------|---|--------------------------------|----------------------|----------------------------|
|                    |                   | Испытание на растяжение Tensile test        |                                 |                                    |                            |   |  |  | Испытание на удар /Impact test   |   |                         |   | Испытание на удар /Impact test |                      |                            |
|                    |                   | Предел прочности Tensile strength           | Предел текучести Yield strength | Относительное удлинение Elongation | Отношениеsigma Ratio sigma | Ориентация образца Specimens orientation* | Ширина поперечного образца Width of strip specimen | Диаметр цилиндрического образца Diameter of cylindrical specimen | Длина образца Length of specimen | Твердость Hardness Среднее значение Average | Ориентация Orientation* | Тип надреза, температура Type of notch, temperature | Норматив Norm                  | Ср. значение Average | Площадь сдвига, Shear area |
| min                |                   | 70000                                       | 40000                           | 29.0                               | -                          |   | дюйм/ inch   | дюйм/ inch   | дюйм/ inch                       | HRB   | HRC                     | min   | фут/фунт f/lb                  | %                    | дюйм/ inch                 |
| max                |                   | -   | -                               | -                                  | -                          |   |  |  | 100                              | 22  |                         |   |                                |                      |                            |
| 1174593            | 3457              | 78300<br>78300                              | 49500<br>49500                  | 38.0<br>39.5                       |                            | L<br>L                                    | 1.500<br>1.500                                     | 1.970<br>1.970   | 80 79 79 av.79<br>80 80 79 av.80 | <22<br><22                                  | L KV -49°F              | 13  | 15 15 16 av. 15                | 5 5 5                | 0.394x0.394                |

\* L - продольный образец / Longitudinal specimen; T - поперечный образец / Transverse specimen  
\*\* Результаты испытаний уменьшенных образцов пересчитаны на полноразмерные / Non-fullsize specimens results convert to fullsize (10x10mm)

Прочие виды контроля / Other tests

| Вид испытания / Type of test                                | Параметры / Criteria                  | Результаты контроля / Test results |
|---|---------------------------------------|------------------------------------|
| Сплюсчивание / Flattening test                              | По стандарту / As per Standard**      | Удовлетворительно / Satisfactory   |
| Испытание гидравлическим давлением / Hydrostatic test       | 100% / 19.3 MPa / 2800 PSI / 10 sec** | Удовлетворительно / Satisfactory   |
| Визуальный контроль / Visual inspection                     | По стандарту / As per Standard**      | Удовлетворительно / Satisfactory   |
| Контроль геометрических параметров / Dimensional inspection | По стандарту / As per Standard**      | Удовлетворительно / Satisfactory   |

Состояние поставки / Delivery condition

|  |   |
|--|---|
| Общие условия / General condition                  | Трубы изготовлены и испытаны в соответствии с требованиями ASTM A106/A106M-2015/ ASME SA106/SA106M-2015/ ASTM A53/A53M-2012/ ASME SA53/SA53M-2015/ ASTM A333/A333M-2016/ ASME SA333/SA333M-2015/ NACE MR0175-2015/ NACE MR0103-2012 и заказа / Pipes were produced and inspected according to requirements of ASTM A106/A106M-2015/ ASME SA106/SA106M-2015/ ASTM A53/A53M-2012/ ASME SA53/SA53M-2015/ ASTM A333/A333M-2016/ ASME SA333/SA333M-2015/ NACE MR0175-2015/ NACE MR0103-2012 and order's requirements |
| Состояние поставки / Delivery condition            | Pipes produced by Hot Forming followed by normalizing at the temperature 845 deg C to 845 deg C cooled at air/Трубы произведены путем горячей деформации и нормализованы при температуре 845...945°С, охлаждены на воздухе  |
| Покрытие / Coating                                 | Трубы покрыты черным лаком / Pipes are coated with black varnish  |
| Фаска (если требуется) / Bevelled ends if required | Стандартная фаска / Bevel as per standard   |
| Защита конца / Protection of pipe ends             | Концы труб оснащены пластиковыми колпачками / The ends of pipes are equipped by plastic caps  |
| Дополнительная информация / Additional information | Масса фактическая / Actual weight. Ремонт сваркой запрещен. / No weld repair.<br>Объем партии не более чем 200 труб / Quantity of pipes in the inspection lot is not more than 200 pieces.<br>Трубы не содержат ртути и свинца. / Material is free of mercury and lead.<br>Страна производства заготовки - Украина. / Country of melt - Ukraine.  |


Страна происхождения: Украина. Country of origin: Ukraine  
Ваши предложения по улучшению продукции просим направлять на эл.адрес / Please send Your proposals for improving the product by e-mail or fax or by phone  
Sergey.Fichakov@nsp.interpipe.biz fax +38(0568)639379 phone +38(0568)638649  
e-mail: info@us.interpipe.biz Phone: 17133330333 Fax: 17133330330

Этот инспекционный сертификат относится только к перечисленной в нем продукции. Недопустимо внесение изменений или другое неправомерное использование сертификата.  
This inspection certificate is only for the listed products. Modification or unauthorized use of the certificate is strictly prohibited. Violations can be considered as forgery and is subject to prosecution.  
Инспекционный сертификат сформирован и проверен контролером сертификатом ВИТКО Л.В.  
Inspection Certificate was drawn up and checked by the Certificate Inspector ВИТКО Л.В.

Дата: 25.11.2017  
Date:

Подпись инспектора 3-й стороны  
Signature of 3-rd Part Inspector:

Подпись ОТК  
Signatures QCD

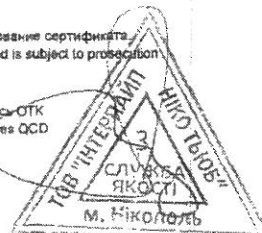

|   |               |   |                   |        |          |          |   |                   |                    |                 |
|---|---------------|---|-------------------|--------|----------|----------|---|-------------------|--------------------|-----------------|
| <b>TEST CERTIFICATE ACC TO EN: 10204: 3.1</b>   |               | <b>Format No. QFB-QU-14/R-01</b>          |                   |        |          |          |   |                   |                    |                 |
| Customer : ISMT E   |               | Test Certificate No. : EP328451           | Date: 17-NOV-2017 |        |          |          |   |                   |                    |                 |
| Consignee :   |               | W.O. No. : HFHP158457                     |                   |        |          |          |   |                   |                    |                 |
|   |               | Invoice No. : EAP1754824                  | Date: 17-NOV-2017 |        |          |          |   |                   |                    |                 |
|   |               | Prè Shipment Invoice No. : PCMP562636     |                   |        |          |          |   |                   |                    |                 |
| P.O.No : 001925-2773  |               | Date: 02-AUG-2017                         |                   |        |          |          |   |                   |                    |                 |
| Customer Item: SR.NO.7 07-2773-8" X .500" X DRL A106 GR. B SMLS (IMP) 43.43#  |               |   |                   |        |          |          |   |                   |                    |                 |
| Specification : ASTM A53/A53M-12/A106/A106M-15 Grade B/ASTM A333/333M-15 Grade 1 & 6 /ASME BPVC SA-53/SA53M/SA-106/SA-106M Grade B/ASME BPVC SA-333/SA 333M Grade 1 & 6 SECTION II,PART A Edition 2015 & NACE MR 0175/MR 0103 |               |   |                   |        |          |          |   |                   |                    |                 |
| <b>Product : HOT FINISHED NORMALISED SEAMLESS STEEL PIPE</b>  |               |   |                   |        |          |          |   |                   |                    |                 |
| Ends : BEVELLED ENDS  |               | Bearing No. / Part No.: NA                |                   |        |          |          |   |                   |                    |                 |
| Heat Number : 01531   |               | Steel Grade : BS 3059                     |                   |        |          |          |   |                   |                    |                 |
| Steel Supplier: SLRM  |               | Batch Number : BPH467                     |                   |        |          |          |   |                   |                    |                 |
| Manufacturing Route : BF-EOF-LRF-VD-CCM-EMS   |               |   |                   |        |          |          |   |                   |                    |                 |
| <b>Dimensions</b>   |               | <b>Tolerance</b>                          |                   |        |          |          |   |                   |                    |                 |
|   | MM            | Inch                                      | +Ve -Ve JOM       |        |          |          |   |                   |                    |                 |
| OD :  | 219.100       | 8.626                                     | 1.600 -0.790 MM   |        |          |          |   |                   |                    |                 |
| ID :  | 193.700       | 7.626                                     | 0.000 0.000 MM    |        |          |          |   |                   |                    |                 |
| WT :  | 12.700        | 0.500                                     | 10.000 -10.000 P  |        |          |          |   |                   |                    |                 |
| <b>Quantity</b>   |               | <b>Quantity</b>                           |                   |        |          |          |   |                   |                    |                 |
|   | <b>Number</b> | <b>Meter / Feet</b>                       | <b>Weight</b>     |        |          |          |   |                   |                    |                 |
|   | 18            | 225.150 / 738.717                         | 14.590 Ton        |        |          |          |   |                   |                    |                 |
| Length: D/12192.000-12801.600 MM. D40.002 -42.002 Feet  |               |   |                   |        |          |          |   |                   |                    |                 |
| <b>Chemical Analysis :</b>  |               | <b>Mechanical Properties : ASTM A 370</b> |                   |        |          |          |   |                   |                    |                 |
| Elements  | UOM           | Min                                       | Max               | Mill   | Product1 | Product2 | YS (ReH)<br>MPa<br>0.2%                                   | U.T.S.(Rm)<br>MPa | % E (A)<br>50.00MM | Hardness<br>BHN |
| C   | %             |   | 0.3000            | 0.1400 | 0.1400   | 0.1350   |   |                   |                    |                 |
| Si  | %             | 0.1000                                    |                   | 0.2500 | 0.2500   | 0.2400   |   |                   |                    |                 |
| S   | %             |   | 0.0250            | 0.0060 | 0.0060   | 0.0050   |   |                   |                    |                 |
| P   | %             |   | 0.0250            | 0.0140 | 0.0130   | 0.0140   |   |                   |                    |                 |
| Mn  | %             | 0.2900                                    | 1.3500            | 1.1200 | 1.1100   | 1.1200   |   |                   |                    |                 |
| Ni  | %             |   | 0.4000            | 0.0130 | 0.0110   | 0.0120   |   |                   |                    |                 |
| Cr  | %             |   | 0.3000            | 0.0310 | 0.0300   | 0.0310   |   |                   |                    |                 |
| Mo  | %             |   | 0.1200            | 0.0070 | 0.0070   | 0.0060   |   |                   |                    |                 |
| Cu  | %             |   | 0.4000            | 0.0140 | 0.0140   | 0.0130   |   |                   |                    |                 |
| Sn  | %             |   |                   | 0.0007 | 0.0007   | 0.0006   |   |                   |                    |                 |
| Al  | %             |   |                   | 0.0340 | 0.0340   | 0.0330   |   |                   |                    |                 |
| Ti  | %             |   |                   | 0.0015 | 0.0015   | 0.0014   |   |                   |                    |                 |
| V   | %             |   | 0.0800            | 0.0040 | 0.0040   | 0.0030   |   |                   |                    |                 |
| As  | %             |   |                   | 0.0017 | 0.0017   | 0.0016   |   |                   |                    |                 |
| Ca  | %             |   |                   | 0.0007 | 0.0006   | 0.0007   |   |                   |                    |                 |
| Nb  | %             |   | 0.0200            | 0.0004 | 0.0004   | 0.0003   |   |                   |                    |                 |
| CE  | %             |   |                   | 0.3369 | 0.3349   | 0.3313   |   |                   |                    |                 |
| <b>Impact Properties : ASTM E 23</b>  |               |   |                   |        |          |          | <b>Sample Orientation : Longitudinal</b>                  |                   |                    |                 |
| <b>Test Type : Charpy V Notch</b>   |               |   |                   |        |          |          | <b>Insile Specimen Type : Strip Gauge Width(mm) 19.05</b> |                   |                    |                 |
| Specimen Orientation  | Temp (°C)     | Size (mm)                                 | Value (Joules)    |        |          | Avg      | Reqd.   |                   |                    |                 |
|   |               |   | 1.                | 2.     | 3.       | Min      | Avg   |                   |                    |                 |
| Longitudinal  | -45           | 55x10x10                                  | 92                | 92     | 110      | 98       | 14  | 18                |                    |                 |
| <b>Flattening Test (As Per Specn.)</b>  |               | : Ok                                      |                   |        |          |          |   |                   |                    |                 |
| <b>Leakage Flux (As Per ASTM E570)</b>  |               | : Ok                                      |                   |        |          |          |   |                   |                    |                 |
| <b>Hydraulic Test (As Per Specn.)</b>   |               | : Ok 2500 PSI                             |                   |        |          |          |   |                   |                    |                 |
| <b>Remarks :</b>  |               |   |                   |        |          |          |   |                   |                    |                 |
| NO WELD REPAIR PERFORMED. MATERIAL FREE FROM RADIOACTIVE CONTAMINATION  |               |   |                   |        |          |          |   |                   |                    |                 |

ISMT Tube Plant B

B-13, MIDC, Baramati - 413 133, Maharashtra, India.  
Phone : +91 2112 243861 - 65 | Fax : +91 2112 243873


www.ismt.com

ISMT Tube Plant B, Baramati



Page 1 of 2

**ISM T LIMITED**  
Solutions You Can Trust
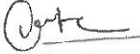
|  |                                       |                                  |  |
|--|---------------------------------------|----------------------------------|--|
| <b>TEST CERTIFICATE ACC TO EN: 10204: 3.1</b>  |                                       | <b>Format No. QFB-QU-14/R-01</b> |  |
| Customer : ISMT E A/C  | Test Certificate No. : EP328451       | Date: 17-NOV-2017                |  |
| Consignee :  | W.O. No. : HFHP158457                 |                                  |  |
|  | Invoice No. : EAP1754824              | Date: 17-NOV-2017                |  |
|  | Pre Shipment Invoice No. : PCMP562636 |                                  |  |
| We hereby Certify that the material described above conforms to specifications & Purchase Order  |                                       |                                  |  |
| <br>A.B. DEOKATE<br>JUNIOR SUPERVISOR<br>Authorized signatory |                                       |                                  |  |



**ISM T Tube Plant B**  
 B-13, MIDC, Baramati - 413 133, Maharashtra, India.  
 Phone : +91 2112 243861 - 65 | Fax : +91 2112 243873

[www.ismt.com](http://www.ismt.com)





390 Bristol Metals Rd.  
Bristol, TN 37620

# MILL TEST REPORT

RM ID NUMBER  
431379  
SALES ORDER / RLS  
20174883602  
CERT ID / REV  
23540

SOLD TO:  
INDUSTRIAL PIPING SPEC  
PO BOX 581270  
TULSA, OK 74158-1270

|  |        |               |                   |                  |  |
|--|--------|---------------|-------------------|------------------|--|
| CUSTOMER P.O.<br>TP547985  |        | CUSTOMER PART |                   | HEAT NO.<br>119E |  |
| DESCRIPTION: 3301000040304312120<br>10" WELDED PIPE SCHED 40S TP304/TP304L (UNS#S30400/S30403) A312 X-RAY DOUBLE RANDOM LENGTH |        |               |                   |                  |  |
| CERTIFICATION REQUIREMENTS   |        |               |                   |                  |  |
| ENGINEERING<br>ASTM A312-17 ASME SA312-15  |        |               |                   |                  |  |
| HYDRO PRESSURE<br>1000 PSI   |        |               |                   |                  |  |
| HEAT TREAT<br>Annealed at 1900 - 2000 Deg F. and water quenched to below 800 Deg. F. in less than 3 minutes.                   |        |               |                   |                  |  |
| <u>Chemical</u>  |        |               | <u>Mechanical</u> |                  |  |
| Test   | Result | Test          | Result            |                  |  |
| Carbon   | .0199  | 431379        |                   |                  |  |
| Manganese  | 1.73   | Elongation    | 52                |                  |  |
| Phosphorus   | .0285  | Hardness RB   | 87.               |                  |  |
| Sulfur   | .0114  | Tensile       | 90360             |                  |  |
| Silicon  | .263   | Yield         | 50000             |                  |  |
| Nickel   | 8.0645 |               |                   |                  |  |
| Chromium   | 18.065 | X-Ray         | Pass              |                  |  |
| Molybdenum   | .3225  | Tension       | Pass              |                  |  |
| Nitrogen   | .0752  | TG Face Bend  | Pass              |                  |  |
| Country of Origin  | USA    |               |                   |                  |  |

This report shall not be altered or reproduced, except in full, without the prior written approval of Bristol Metals LLC. This test report represents the actual attributes of the items furnished and all items were manufactured, sampled, inspected, and tested in full compliance with applicable specifications and your purchase order.  
 Certification is in accordance with EN10204:2004 type 3.1.  
 Chemical content is % by weight. Mechanical test results are in English units (inches and pounds).  
 No weld repairs have been performed on the base material.  
 Hardness in accordance with NACE MR0175/ISO 15156-3:2009 and MR0103-2012 and material is free of cold work to enhance mechanical properties.  
 Pipe is Pickled and Passivated in accordance with ASTM A380.  
 Bristol Metals has a Quality Management System in place that is in compliance with ISO 9001:2008.  
 In compliance with Pressure Equipment Directive (PED) 2014/68/EU as Category 1 material unless otherwise stated.  
 Bristol Metals does not add mercury or radioactive materials during any manufacturing process.  
 NAFTA country of origin: USA. Pipe/Tube Manufactured in the USA. Raw Material Melt Source: USA  
 FAR BAA - Complies, DFARS BAA - Complies, FAR TAA - Complies.  
 Pipe/Tube has been double welded using an EFW process.  
**QF-576**

Date Printed: 08/28/2017

Quality Assurance Manager



390 Bristol Metals Rd.  
Bristol, TN 37620

# MILL TEST REPORT

RM ID NUMBER  
4249541  
SALES ORDER / RLS  
201808584903  
CERT ID / REV  
34576

SOLD TO:  
INDUSTRIAL PIPING SPEC  
PO BOX 581270  
TULSA, OK 74158-1270

|  |        |               |                   |                    |  |
|--|--------|---------------|-------------------|--------------------|--|
| CUSTOMER P.O.<br>TP570939  |        | CUSTOMER PART |                   | HEAT NO.<br>518687 |  |
| DESCRIPTION: 3300200010304312020<br>2" WELDED PIPE SCHED 10S TP304L (UNS# S30400/S30403) A312 DOUBLE RANDOM LENGTH |        |               |                   |                    |  |
| CERTIFICATION REQUIREMENTS   |        |               |                   |                    |  |
| ENGINEERING<br>ASTM A312-17 ASME SA312-17  |        |               |                   |                    |  |
| HYDRO PRESSURE<br>1400 PSI   |        |               |                   |                    |  |
| HEAT TREAT<br>Annealed at 1900 Min. Deg F. and water quenched to below 800 Deg. F. in less than 3 minutes.         |        |               |                   |                    |  |
| <u>Chemical</u>  |        |               | <u>Mechanical</u> |                    |  |
| Test   | Result | Test          | Result            |                    |  |
| Carbon   | .025   | 4249541       | Elongation        | 54                 |  |
| Manganese  | 1.74   |               | Hardness RB       | 83                 |  |
| Phosphorus   | .027   |               | Tensile           | 96301              |  |
| Sulfur   | .012   |               | Yield             | 46265              |  |
| Silicon  | .52    |               |                   |                    |  |
| Nickel   | 8.04   |               | Tension           | Pass               |  |
| Chromium   | 18.19  |               | Flattening        | Pass               |  |
| Molybdenum   | .26    |               |                   |                    |  |
| Nitrogen   | .073   |               |                   |                    |  |
| Country of Origin  | USA    |               |                   |                    |  |

This report shall not be altered or reproduced, except in full, without the prior written approval of Bristol Metals LLC. This test report represents the actual attributes of the items furnished and all items were manufactured, sampled, inspected, and tested in full compliance with applicable specifications and your purchase order.  
 Certification is in accordance with EN10204:2004 type 3.1.  
 Chemical content is % by weight. Mechanical test results are in English units (inches and pounds).  
 No weld repairs have been performed on the base material.  
 Hardness in accordance with NACE MR0175/ISO 15156-3:2009 and MR0103-2012 and material is free of cold work to enhance mechanical properties.  
 Pipe is Pickled and Passivated in accordance with ASTM A380.  
 Bristol Metals has a Quality Management System in place that is in compliance with ISO 9001:2008.  
 In compliance with Pressure Equipment Directive (PED) 2014/68/EU as Category 1 material unless otherwise stated.  
 Bristol Metals does not add mercury or radioactive materials during any manufacturing process.  
 NAFTA country of origin: USA. Pipe/Tube Manufactured in the USA. Raw Material Melt: USA  
 FAR BAA - Complies, DFARS BAA -Complies, FAR TAA - Complies. This product is in full compliance with the American Iron and Steel requirement of P.L. 113-76 and as mandated in EPA's State Revolving Funds Program  
 Pipe/Tube has been double welded using an EPW process.  
 QF-576

Date Printed: 02/22/2018

Quality Assurance Manager



# MATERIAL TEST REPORT

**Sold To: 2425000**  
**INDUSTRIAL PIPING SPECIALISTS/TULSA**  
**606 N. 145TH EAST AVE.**  
**TULSA OK 74116**

**Ship To: 2425000**  
**INDUSTRIAL PIPING SPECIALISTS/TULSA**  
**606 N. 145TH EAST AVE.**  
**TULSA OK 74116**

**Purchase Order:** tp538110  
**Sales Order:** 216359  
**Material:** M063237515400 A/SA312 T304L 2.000" Sch. 40  
**Delivery / File Nbr:** 80371051

**Description:** ASTM A312-17 ASME SA312-15  
 WELDED STAINLESS STEEL PIPE, TP304/TP304L

**Test:** REVERSE BEND TEST PASSED. FLATTENING TEST PASSED. REVERSE FLATTENING TEST PASSED. FLARE TEST PASSED. NDT ELECTRIC TESTED TO ASTM A999, TEST METHOD E426 USING A DRILL-HOLE REF. STD. HYDRO TEST NOT PERFORMED. .75" WIDTH STRIP 2" GAUGE LGTH. HYDRO TEST NOT PERFORMED. .75" WIDTH STRIP 2" GAUGE LGTH

**Heat Number:** OC513085  
 %

|                   |     |        |
|-------------------|-----|--------|
| <b>CARBON</b>     | LDL | 0.023  |
| <b>MANGANESE</b>  | LDL | 1.280  |
| <b>PHOSPHORUS</b> | LDL | 0.029  |
| <b>SULFUR</b>     | LDL | 0.001  |
| <b>SILICON</b>    | LDL | 0.380  |
| <b>NICKEL</b>     | LDL | 8.040  |
| <b>CHROMIUM</b>   | LDL | 18.140 |

|                       |                 |
|-----------------------|-----------------|
| <b>Ultimate (PSI)</b> | 89,008 / 89,884 |
| <b>Yield (PSI)</b>    | 44,070 / 44,710 |
| <b>Elongation (%)</b> | 64 / 66         |
| <b>Hardness (RB)</b>  | 82 / 82         |

We hereby certify that the above figures are correct as contained in the records of the company and that each batch has been manufactured, sampled, tested and inspected in accordance with the applicable specification stated above. This Document conforms to the requirements of Specification EN 10204 Inspection Document Type 3.1. Webco does not use mercury in testing or production of its stainless steel products. According to our records and to the best of Webco's knowledge, understanding and belief, this product was not contaminated during manufacture in our facilities. This document was prepared by means of electronic processing and is valid without signature.

**Date: 06/01/2017**  
**Tucker Melvin**  
 KST Quality Manager  
 tmelvin@webcoindustries  
 18256 West HWY 66  
 Kellyville OK 74039




390 Bristol Metals Rd.  
Bristol, TN 37620

# MILL TEST REPORT

RM ID NUMBER  
721361  
SALES ORDER / RLS  
20174883602  
CERT ID / REV  
23541

SOLD TO:  
INDUSTRIAL PIPING SPEC  
PO BOX 581270  
TULSA, OK 74158-1270

|  |  |               |   |                  |        |
|--|--|---------------|---|------------------|--------|
| CUSTOMER P.O.<br>TP547985  |  | CUSTOMER PART |   | HEAT NO.<br>232R |        |
| DESCRIPTION: 3300300010304312020<br>3" WELDED PIPE SCHED 10S TP304/TP304L (UNS# S30400/S30403) A312 DOUBLE RANDOM LENGTH   |  |               |   |                  |        |
| <b>CERTIFICATION REQUIREMENTS</b>  |  |               |   |                  |        |
| <u>ENGINEERING</u><br>ASTM A312-17 ASME SA312-15   |  |               |   |                  |        |
| HYDRO PRESSURE<br>1000 PSI   |  |               |   |                  |        |
| <u>HEAT TREAT</u><br>Annealed at 1900 - 2000 Deg F. and water quenched to below 800 Deg. F. in less than 3 minutes.  |  |               |   |                  |        |
| <u>Chemical</u>  |  |               | <u>Mechanical</u>   |                  |        |
| Test   |  | Result        | Test  |                  | Result |
| Carbon   |  | .0168         | 721361  |                  |        |
| Manganese  |  | 1.783         | Elongation  |                  | 54     |
| Phosphorus   |  | .0255         | Hardness RB   |                  | 86     |
| Sulfur   |  | .0118         | Tensile   |                  | 90850  |
| Silicon  |  | .2725         | Yield   |                  | 45320  |
| Nickel   |  | 8.0785        |   |                  |        |
| Chromium   |  | 18.194        | Tension   | Pass             |        |
| Molybdenum   |  | .288          | TG Face Bend  | Pass             |        |
| Nitrogen   |  | .0828         |   |                  |        |
| Country of Origin  |  | USA           |   |                  |        |
| <p>This report shall not be altered or reproduced, except in full, without the prior written approval of Bristol Metals LLC. This test report represents the actual attributes of the items furnished and all items were manufactured, sampled, inspected, and tested in full compliance with applicable specifications and your purchase order.<br/>                     Certification is in accordance with EN10204:2004 type 3.1.<br/>                     Chemical content is % by weight. Mechanical test results are in English units (inches and pounds).<br/>                     No weld repairs have been performed on the base material.<br/>                     Hardness in accordance with NACE MR0175/ISO 15156-3:2009 and MR0103-2012 and material is free of cold work to enhance mechanical properties.<br/>                     Pipe is Pickled and Passivated in accordance with ASTM A380.<br/>                     Bristol Metals has a Quality Management System in place that is in compliance with ISO 9001:2008.<br/>                     In compliance with Pressure Equipment Directive (PED) 2014/68/EU as Category 1 material unless otherwise stated.<br/>                     Bristol Metals does not add mercury or radioactive materials during any manufacturing process.<br/>                     NAFTA country of origin: USA. Pipe/Tube Manufactured in the USA. Raw Material Melt Source: USA<br/>                     FAR BAA - Complies, DFARS BAA -Complies, FAR TAA - Complies.<br/>                     Pipe/Tube has been double welded using an EFW process.<br/>                     QF-576</p> |  |               |   |                  |        |
|  |  |               | Date Printed: 08/28/2017<br><br><br>Quality Assurance Manager |                  |        |




390 Bristol Metals Rd.  
Bristol, TN 37620

# MILL TEST REPORT

RM ID NUMBER  
2483451  
SALES ORDER / RLS  
201707407607  
CERT ID / REV  
33589

SOLD TO:  
INDUSTRIAL PIPING SPEC  
PO BOX 581270  
TULSA, OK 74158-1270

|   |        |                      |                   |   |        |
|---|--------|----------------------|-------------------|---|--------|
| <b>CUSTOMER P.O.</b><br>TP563562  |        | <b>CUSTOMER PART</b> |                   | <b>HEAT NO.</b><br>475B   |        |
| DESCRIPTION: 3300300040304312020<br>3" WELDED PIPE SCHED 40S TP304/TP304L (UNS# S30400/S30403) A312 DOUBLE RANDOM LENGTH  |        |                      |                   |   |        |
| <b>CERTIFICATION REQUIREMENTS</b>   |        |                      |                   |   |        |
| <b>ENGINEERING</b>  |        |                      |                   |   |        |
| ASTM A312-17 ASME SA312-17  |        |                      |                   |   |        |
| HYDRO PRESSURE<br>1900 PSI  |        |                      |                   |   |        |
| <b>HEAT TREAT</b><br>Annealed at 1900 Min. Deg F. and water quenched to below 800 Deg. F. in less than 3 minutes.   |        |                      |                   |   |        |
| <b>Chemical</b>   |        |                      | <b>Mechanical</b> |   |        |
| Test  | Result | Test                 | Result            | Test  | Result |
| Carbon  | .0144  | 2483451              |                   | Elongation  | 51     |
| Manganese   | 1.773  |                      |                   | Hardness RB   | 85     |
| Phosphorus  | .0315  |                      |                   | Tensile   | 90310  |
| Sulfur  | .0118  |                      |                   | Yield   | 46110  |
| Silicon   | .2475  |                      |                   |   |        |
| Nickel  | 8.0955 |                      |                   |   |        |
| Chromium  | 18.213 |                      |                   | Tension   | Pass   |
| Molybdenum  | .3205  |                      |                   | TG Face Bend  | Pass   |
| Nitrogen  | .0815  |                      |                   |   |        |
| Country of Origin   | USA    |                      |                   |   |        |
| <p>This report shall not be altered or reproduced, except in full, without the prior written approval of Bristol Metals LLC. This test report represents the actual attributes of the items furnished and all items were manufactured, sampled, inspected, and tested in full compliance with applicable specifications and your purchase order.</p> <p>Certification is in accordance with EN10204:2004 type 3.1.</p> <p>Chemical content is % by weight. Mechanical test results are in English units (inches and pounds).</p> <p>No weld repairs have been performed on the base material.</p> <p>Hardness in accordance with NACE MR0175/ISO 15156-3:2009 and MR0103-2012 and material is free of cold work to enhance mechanical properties.</p> <p>Pipe is Pickled and Passivated in accordance with ASTM A380.</p> <p>Bristol Metals has a Quality Management System in place that is in compliance with ISO 9001:2008.</p> <p>In compliance with Pressure Equipment Directive (PED) 2014/68/EU as Category 1 material unless otherwise stated.</p> <p>Bristol Metals does not add mercury or radioactive materials during any manufacturing process.</p> <p>NAFTA country of origin: USA. Pipe/Tube Manufactured in the USA. Raw Material Melt: USA</p> <p>FAR BAA - Complies, DFARS BAA -Complies, FAR TAA - Complies. This product is in full compliance with the American Iron and Steel requirement of P.L. 113-76 and as mandated in EPA's State Revolving Funds Program</p> <p>Pipe/Tube has been double welded using an EFW process.</p> <p>QF-576</p> |        |                      |                   |   |        |
|   |        |                      |                   | Date Printed: 02/06/2018  |        |
|   |        |                      |                   | <br>Quality Assurance Manager |        |




390 Bristol Metals Rd.  
Bristol, TN 37620

# MILL TEST REPORT

RM ID NUMBER  
895212  
SALES ORDER / RLS  
20173409602  
CERT ID / REV  
23537

SOLD TO:  
INDUSTRIAL PIPING SPEC  
PO BOX 581270  
TULSA, OK 74158-1270

|  |         |               |   |                  |  |
|--|---------|---------------|---|------------------|--|
| CUSTOMER P.O.<br>TP538674  |         | CUSTOMER PART |   | HEAT NO.<br>282N |  |
| DESCRIPTION: 3300400010304312020<br>4" WELDED PIPE SCHED 10S TP304/TP304L (UNS# S30400/S30403) A312 DOUBLE RANDOM LENGTH   |         |               |   |                  |  |
| <b>CERTIFICATION REQUIREMENTS</b>  |         |               |   |                  |  |
| <u>ENGINEERING</u><br>ASTM A312-17 ASME SA312-15   |         |               |   |                  |  |
| HYDRO PRESSURE<br>800 PSI  |         |               |   |                  |  |
| <u>HEAT TREAT</u><br>Annealed at 1900 - 2000 Deg F. and water quenched to below 800 Deg. F. in less than 3 minutes.  |         |               |   |                  |  |
| <u>Chemical</u>  |         |               | <u>Mechanical</u>   |                  |  |
| Test   | Result  | Test          | Result  |                  |  |
| Carbon   | .0187   | 895212        |   |                  |  |
| Manganese  | 1.768   | Elongation    |   | 50               |  |
| Phosphorus   | .028    | Hardness RB   |   | 84.              |  |
| Sulfur   | .0121   | Tensile       |   | 91020            |  |
| Silicon  | .2385   | Yield         |   | 45880            |  |
| Nickel   | 8.013   |               |   |                  |  |
| Chromium   | 18.1355 |               |   |                  |  |
| Molybdenum   | .28     | Tension       | Pass  |                  |  |
| Nitrogen   | .0832   | TG Face Bend  | Pass  |                  |  |
| Country of Origin  | USA     |               |   |                  |  |
| <p>This report shall not be altered or reproduced, except in full, without the prior written approval of Bristol Metals LLC. This test report represents the actual attributes of the items furnished and all items were manufactured, sampled, inspected, and tested in full compliance with applicable specifications and your purchase order.</p> <p>Certification is in accordance with EN10204:2004 type 3.1.</p> <p>Chemical content is % by weight. Mechanical test results are in English units (inches and pounds).</p> <p>No weld repairs have been performed on the base material.</p> <p>Hardness in accordance with NACE MR0175/ISO 15156-3:2009 and MR0103-2012 and material is free of cold work to enhance mechanical properties.</p> <p>Pipe is Pickled and Passivated in accordance with ASTM A380.</p> <p>Bristol Metals has a Quality Management System in place that is in compliance with ISO 9001:2008.</p> <p>In compliance with Pressure Equipment Directive (PED) 2014/68/EU as Category 1 material unless otherwise stated.</p> <p>Bristol Metals does not add mercury or radioactive materials during any manufacturing process.</p> <p>NAFTA country of origin: USA. Pipe/Tube Manufactured in the USA. Raw Material Melt Source: USA</p> <p>FAR BAA - Complies, DFARS BAA -Complies, FAR TAA - Complies.</p> <p>Pipe/Tube has been double welded using an EFW process.</p> <p>QF-576</p> |         |               |   |                  |  |
|  |         |               | <p>Date Printed: 08/28/2017</p> <br>Quality Assurance Manager |                  |  |




390 Bristol Metals Rd.  
Bristol, TN 37620

# MILL TEST REPORT

RM ID NUMBER  
2167994  
SALES ORDER / RLS  
20174215705  
CERT ID / REV  
25436

SOLD TO:  
INDUSTRIAL PIPING SPEC  
PO BOX 581270  
TULSA, OK 74158-1270

|  |        |                      |   |                           |        |
|--|--------|----------------------|---|---------------------------|--------|
| <b>CUSTOMER P.O.</b><br>TP543925   |        | <b>CUSTOMER PART</b> |   | <b>HEAT NO.</b><br>516135 |        |
| DESCRIPTION: 3300600040304312120<br>6" WELDED PIPE SCHED 40S TP304/TP304L (UNS# S30400/S30403) A312 X-RAY DOUBLE RANDOM LENGTH   |        |                      |   |                           |        |
| <b>CERTIFICATION REQUIREMENTS</b>  |        |                      |   |                           |        |
| <b>ENGINEERING</b><br>ASTM A312-17 ASME SA312-15   |        |                      |   |                           |        |
| HYDRO PRESSURE<br>1300 PSI   |        |                      |   |                           |        |
| <b>HEAT TREAT</b><br>Annealed at 1900 - 2000 Deg F. and water quenched to below 800 Deg. F. in less than 3 minutes.  |        |                      |   |                           |        |
| <u>Chemical</u>  |        |                      | <u>Mechanical</u>   |                           |        |
| Test   | Result | Test                 | Result  | Test                      | Result |
| Carbon   | .028   | 2167994              |   |                           |        |
| Manganese  | 1.78   | Elongation           |   |                           | 54     |
| Phosphorus   | .028   | Hardness RB          |   |                           | 82     |
| Sulfur   | .0113  | Tensile              |   |                           | 92095  |
| Silicon  | .57    | Yield                |   |                           | 45685  |
| Nickel   | 8.04   |                      |   |                           |        |
| Chromium   | 18.15  | X-Ray                | Pass  |                           |        |
| Molybdenum   | .31    | Tension              | Pass  |                           |        |
| Nitrogen   | .073   | TG Face Bend         | Pass  |                           |        |
| Country of Origin  | USA    |                      |   |                           |        |
| <p>This report shall not be altered or reproduced, except in full, without the prior written approval of Bristol Metals LLC. This test report represents the actual attributes of the items furnished and all items were manufactured, sampled, inspected, and tested in full compliance with applicable specifications and your purchase order.</p> <p>Certification is in accordance with EN10204:2004 type 3.1.</p> <p>Chemical content is % by weight. Mechanical test results are in English units (inches and pounds).</p> <p>No weld repairs have been performed on the base material.</p> <p>Hardness in accordance with NACE MR0175/ISO 15156-3:2009 and MR0103-2012 and material is free of cold work to enhance mechanical properties.</p> <p>Pipe is Pickled and Passivated in accordance with ASTM A380.</p> <p>Bristol Metals has a Quality Management System in place that is in compliance with ISO 9001:2008.</p> <p>In compliance with Pressure Equipment Directive (PED) 2014/68/EU as Category I material unless otherwise stated.</p> <p>Bristol Metals does not add mercury or radioactive materials during any manufacturing process.</p> <p>NAFTA country of origin: USA. Pipe/Tube Manufactured in the USA. Raw Material Melt Source: USA</p> <p>FAR BAA - Complies, DFARS BAA -Complies, FAR TAA - Complies.</p> <p>Pipe/Tube has been double welded using an EFW process.</p> <p>QF-576</p> |        |                      |   |                           |        |
|  |        |                      | Date Printed: 09/25/2017<br><br><br>Quality Assurance Manager |                           |        |



390 Bristol Metals Rd.  
Bristol, TN 37620

# MILL TEST REPORT


RM ID NUMBER  
245540  
SALES ORDER / RLS  
20160065804  
CERT ID / REV  
7942

SOLD TO:  
INDUSTRIAL PIPING SPEC - SHIP TO  
606 N. 145TH EAST AVE  
TULSA, OK 74116

|  |               |                      |                   |                         |               |
|--|---------------|----------------------|-------------------|-------------------------|---------------|
| <u>CUSTOMER P.O.</u><br>TP505911   |               | <u>CUSTOMER PART</u> |                   | <u>HEAT NO.</u><br>049N |               |
| DESCRIPTION: 3300400040304312020<br>4" WELDED PIPE SCHED 40S TP304/TP304L (UNS# S30400/S30403) A312 DOUBLE RANDOM LENGTH |               |                      |                   |                         |               |
| <b>CERTIFICATION REQUIREMENTS</b>  |               |                      |                   |                         |               |
| <u>ENGINEERING</u><br>ASTM A312-16 ASME SA312-15   |               |                      |                   |                         |               |
| <u>HYDRO PRESSURE</u><br>1600 PSI  |               |                      |                   |                         |               |
| <u>HEAT TREAT</u><br>Annealed at 1900 - 2000 Deg F. and water quenched to below 800 Deg. F. in less than 3 minutes.      |               |                      |                   |                         |               |
| <u>Chemical</u>  |               |                      | <u>Mechanical</u> |                         |               |
| <u>Test</u>  | <u>Result</u> | <u>Test</u>          | <u>Result</u>     | <u>Test</u>             | <u>Result</u> |
| Carbon   | .0206         | Tensile              | 90350             |                         |               |
| Manganese  | 1.724         | Yield                | 46090             |                         |               |
| Phosphorus   | .0275         | Elongation           | 51.14             |                         |               |
| Sulfur   | .0128         | Hardness RB          | 85                |                         |               |
| Silicon  | .2375         |                      |                   |                         |               |
| Nickel   | 8.027         | Tension              | Pass              |                         |               |
| Chromium   | 18.1575       | TG Face Bend         | Pass              |                         |               |
| Molybdenum   | .3425         |                      |                   |                         |               |
| Nitrogen   | .0816         |                      |                   |                         |               |
| Country of Origin  | USA           |                      |                   |                         |               |

This report shall not be altered or reproduced, except in full, without the prior written approval of Bristol Metals LLC. This test report represents the actual attributes of the items furnished and all items were manufactured, sampled, inspected, and tested in full compliance with applicable specifications and your purchase order.  
 Certification is in accordance with EN10204:2004 type 3.1.  
 Chemical content is % by weight. Mechanical test results are in English units (inches and pounds).  
 No weld repairs have been performed on the base material.  
 Hardness in accordance with NACE MR0175/ISO 15156-3:2009 and MR0103-2012 and material is free of cold work to enhance mechanical properties.  
 Pipe is Pickled and Passivated in accordance with ASTM A380.  
 Bristol Metals has a Quality Management System in place that is in compliance with ISO 9001:2008.  
 In compliance with Pressure Equipment Directive (PED) 97/23/EC as Category 1 material unless otherwise stated.  
 Bristol Metals does not add mercury or radioactive materials during any manufacturing process.  
 NAFTA country of origin: USA. Pipe/Tube Manufactured in the USA. Raw Material Melt Source: USA  
 FAR BAA - Complies, DFARS BAA -Complies, FAR TAA - Complies.  
 Pipe/Tube has been double welded using an EFW process.

QF-576

Date Printed: 11/10/2016  
  
  
 Quality Assurance Manager

**J-447**

**SK2 Assy**  
**Spools**

**ISTI**  
**Weld Procedures**



ISTI Plant Services  
 17207 East 21st Street  
 Tulsa, OK 74134

Welding Procedure Specification (WPS)

WPS No.: 1001 Date: 1/24/2007 Rev.: 5 Date: 1/5/2017 Page: 1 of 2

By: [Signature] Date Signed: 1/5/2017

Supporting PQR's: PI-P1-1001 Rev.2 (1/5/17)

Welding Process(es) / Type(s): GTAW / Manual

**Joints (QW-402)**

Joint Design: Groove and fillet welds

| Joint Type      | Backing              | Root Opening | Groove Angle | Root Face | Groove Radius |
|-----------------|----------------------|--------------|--------------|-----------|---------------|
| Single-V groove | No backing           | 3/16" max    | 50 deg min   | 1/8" max  | -             |
| Single bevel    | No backing           | 3/16" max    | 45 deg min   | 1/8" max  | -             |
| Single-V groove | Gouged & back welded | 1/4" max     | 50 deg min   | 3/16" max | -             |
| Double bevel    | Gouged & back welded | 1/4" max     | 45 deg min   | 3/16" max | -             |
| Double-V groove | Gouged & back welded | 1/4" max     | 45 deg min   | 3/16" max | -             |
| Square groove   | T-joint              | 1/32" max    | -            | -         | -             |
| Square groove   | No backing           | 3/32" max    | -            | -         | -             |

Fillet Welds: All fillet sizes on all base metal thicknesses and all diameters.

Retainers: None

SEE ENGINEERING DRAWINGS FOR MISALIGNMENT TOLERANCES. INTERNAL MISALIGNMENT TO BE 1/4" OF WALL THICKNESS, NOT TO EXCEED 1/8" MAX.

WELD JOINT DESCRIPTIONS SHOWN ARE NOT INCLUSIVE OF ALL THOSE FOUND ON A JOB. WELD JOINT DESIGN REFERENCE IN AN ENGINEERING SPECIFICATION OR A DESIGN DRAWING SHALL TAKE PRECEDENCE OVER WELD JOINTS SHOWN IN THIS WPS.

**Base Metals (QW-403)**

P-No.: 1 Group No.: 1, 2 Thickness Range (in.): 0.1875 to 1.5000  
 to P-No.: 1 Group No.: 1, 2

**Filler Metals (QW-404)**

Spec. No. (SFA): 5.18

AWS No. (Class): ER70S-6

Filler Metal Use: Filler Metal Used

F No.: 6 A No.: 1 (Conforms to QW-422)

Weld Metal Thickness Range: 1.5000 in. maximum

Flux Type: N/A

Flux Trade Name: N/A

Consumable Insert: None

Other: \_\_\_\_\_

Flux: None

Product Form: Bare (Solid)

Strip Thickness or Width (in.): N/A

**ISTI Plant Services**  
**Welding Procedure Specification (WPS)**

WPS No.: 1001 Date: 1/24/2007 Rev.: 5 Date: 1/5/2017 Page: 2 of 2

|   |   |
|---|---|
| <b>Positions (QW-405)</b><br>Position of Joint: <u>All Positions</u><br>Weld Progression: <u>Vertical up</u>  | <b>Postweld Heat Treatment (QW-407)</b><br>Type: <u>No PWHT will be performed</u><br>Temperature Range: <u>None</u> °F<br>Time Range: <u>None</u> |
| <b>Preheat (QW-406)</b><br>Preheat Temp. Min.: <u>75</u> °F<br>Interpass Temp. Max.: <u>450</u> °F<br>Preheat Maintenance: <u>None</u><br>When Base Metal Preheat is < 50°F, preheat to 150°F minimum   | <b>Gas (QW-408)</b><br>Gas Composition / Flow Rate<br>Shielding: <u>100% Argon / 23-30 CFH</u><br>Trailing: <u>None</u><br>Backing: <u>None</u>   |
| <b>Electrical Characteristics (QW-409)</b><br>Current Type / Polarity: <u>DCEN (straight)</u><br>Pulsed Current: <u>None</u><br>Tungsten Electrode Type and Size: <u>EWTh-2 / 3/32</u><br>Mode of Metal Transfer for GMAW(FCAW): <u>N/A</u><br>Max. Heat Input (J/in): <u>None</u><br>Energy/Power: <u>CC</u>   |   |
| <b>Technique (QW-410)</b><br>Thermal Processes: <u>-</u><br>String or Weave Bead: <u>Stringer and weave bead</u><br>Orifice or Gas Cup Size: <u>#5 to #10</u><br>Initial and Interpass Cleaning: <u>With wire brush clean 1 inch (25 mm) on both sides of weld joint</u><br>Method of Back Gouging: <u>When required, grind until all defects are removed.</u><br>Oscillation: <u>N/A</u><br>Contact Tube to Work Distance: <u>N/A</u><br>Single or Multiple Passes (per side): <u>Multipass</u><br>Single or Multiple Electrodes: <u>N/A</u><br>Peening: <u>None</u><br>No Autogenous Welding is permitted.<br>GTAW Bead Width limited to 4.5x the rod diameter. |   |

**Process Welding Parameters**

| Weld Layer(s) and/or Pass(es) | Process | Filler Metal |                | Current         |                | Voltage Range | Travel Speed Range (in/min) |
|-------------------------------|---------|--------------|----------------|-----------------|----------------|---------------|-----------------------------|
|                               |         | Class        | Diameter (in.) | Type / Polarity | Amperage Range |               |                             |
| Any                           | GTAW    | ER70S-6      | 1/16           | DCEN (straight) | 70-150         | 17-22         | Var.                        |
| Any                           | GTAW    | ER70S-6      | 3/32           | DCEN (straight) | 80-180         | 18-23         | Var.                        |
| Any                           | GTAW    | ER70S-6      | 1/8            | DCEN (straight) | 130-275        | 20-25         | Var.                        |
| Any                           | GTAW    | ER70S-6      | 3/16           | DCEN (straight) | 200-375        | 21-27         | Var.                        |

**Notes**

- \*Rev. 1: Corrected Preheat to match PQR and added Hardness Results to PQR.
- \*\*Rev. 2: Added Preheat temperature for 1-1/4" to 1-1/2" thickness and verify chemical analysis for ER70S-6.
- \*\*\*Rev. 3: Method of confirming ER70S-6 chemical analysis & misalignment limitations (A-No. Verification confirmed by OEM documentation.)
- \*\*\*\*Rev. 4: Added "No Autogenous Welding is permitted" comment, and "GTAW bead width is limited to 4.5x the rod diameter" comment.
- \*\*\*\*\*Rev. 5: Added NACE MRO175 Vickers Hardness to PQR.



ISTI Plant Services  
17207 East 21st Street  
Tulsa, OK 74134

Procedure Qualification Record (PQR)

PQR No.: P1-P1-1001 Rev.2 (1/5/17) WPS No.: 1001 Rev. 5 Date: 1/24/2007 Page: 1 of 2  
Welding Process(es) / Type(s): GTAW / Manual

**Joints (QW-402)**  
Weld Type: Groove weld  
Single-V groove  
Backing: Open butt, no back weld  
Root Opening: 5/32 in. Root Face: 0 in.  
Groove Angle: 60 °

**Base Metals (QW-403)**  
Material Spec., Type or Grade:  
SA-516, Grade 70 to SA-516, Grade 70  
P-No.: 1 Group No.: 2 to P-No.: 1 Group No.: 2  
Thickness of Test Coupon (in.): 0.750

**Postweld Heat Treatment (QW-407)**  
Type: No PWHT performed  
Temperature: None °F  
Time: None hr

**Filler Metals (QW-404)**  
SFA Specification: 5.18  
AWS Classification: ER70S-6  
Filler Metal Use: Filler Metal Used  
Filler Metal F-No: 6  
Weld Metal Analysis A-No: 1 (Conforms to QW-422)  
Size of Filler Metal (in.): 3/32  
Weld Deposit 't' (in.): 0.750  
Filler Metal Product Form: Bare (Solid)  
Consumable Insert: None  
Flux: None

**Gas (QW-408)**  
Gas Composition / Flow Rate  
Shielding: 100% Argon / 25 CFH  
Trailing: None  
Backing: None

**Positions (QW-405)**  
Position of Joint: 1G - Flat  
Weld Progression: N/A

**Electrical Characteristics (QW-409)**  
Current / Polarity: DCEN (straight)  
Amps: 142  
Volts: 15  
Tungsten Type / Size: EWTh-2 / 3/32  
Heat Input: N/R  
Pulsed Current: None

**Preheat (QW-406)**  
Preheat Temp.: 75 °F  
Interpass Temp.: 450 °F  
Preheat Maintenance: None

**Technique (QW-410)**  
Travel Speed (in/min): 3  
Thermal Processes: (1)No  
String/Weave Bead: Stringer and weave bead  
Oscillation: N/A  
Mult./Single Pass (per side): Multipass  
Mult./Single Electrode: N/A  
Nozzle/Gas Cup Size: 6

(1) \*Rev. 1 (2/22/2010): Added Brinell Hardness to PQR.  
\*\*Rev. 2 (1/5/2017): Added NACE MRO175 Vickers Hardness to PQR - Lab #M170003 Welder: Mando Tang.  
\*\*SEE LAB REPORT FOR ACTUAL HARDNESS READING LOCATIONS.

ISTI Plant Services  
Procedure Qualification Record (PQR)

PQR No.: P1-P1-1001 Rev.2 (1/5/17)

Page: 2 of 2

**Tensile Test (QW-150)**

| Specimen No. | Width (in.) | Thickness (in.) | Area (in <sup>2</sup> ) | Ultimate Total Load (lb) | Ultimate Stress (PSI) | Failure Type and Location |
|--------------|-------------|-----------------|-------------------------|--------------------------|-----------------------|---------------------------|
| 1            | 0.755       | 0.753           | 0.5685                  | 41250                    | 72359                 | Ductile - BM              |
| 2            | 0.757       | 0.752           | 0.5693                  | 42050                    | 73863                 | Ductile - BM              |

**Guided Bend Test (QW-160)**

| Figure Number and Type | Result | Figure Number and Type | Result |
|------------------------|--------|------------------------|--------|
| QW-462.2 Side bend     | Passed | QW-462.2 Side bend     | Passed |
| QW-462.2 Side bend     | Passed | QW-462.2 Side bend     | Passed |
| None                   |        | None                   |        |

**Hardness Test - Brinell/Vickers hardness**

| Location                       | Readings |       |       |       |       |       |       |       |       |
|--------------------------------|----------|-------|-------|-------|-------|-------|-------|-------|-------|
|                                | 1        | 2     | 3     | 4     | 5     | 6     | 7     | 8     | 9     |
| SA-516, Grade 70 BM (Brinell)  | 165      | 163   | 159   | 159   | 158   | 167   |       |       |       |
| SA-516, Grade 70 HAZ (Brinell) | 174      | 175   | 176   | 168   | 169   | 171   |       |       |       |
| Weld metal (Brinell)           | 189      | 191   | 186   |       |       |       |       |       |       |
| SA-516, Grade 70 BM (Vickers)  | 163.8    | 161.2 | 162.4 | 173.2 |       |       |       |       |       |
| SA-516, Grade 70 HAZ (Vickers) | 180.9    | 189.3 | 256.3 | 225.2 | 227.9 | 209.9 | 233.6 | 232.4 | 188.7 |
| SA-516, Grade 70 HAZ (Vickers) | 197.8    |       |       |       |       |       |       |       |       |
| Weld metal (Vickers)           | 193.6    | 181.1 | 247.9 | 234.5 | 181.1 |       |       |       |       |

Visual Examination: Acceptable

Jimmy Dick 102124579

Andres Garcia 102126206

Mando Tang M170003


Welder's Name: J. Dick-4579 A. Garcia-6206 M. Tang-0003 ID: \_\_\_\_\_ Stamp: \_\_\_\_\_

Welding of coupon was witnessed

by: ISTI Plant Services

Tests Conducted By: Tulsa Gamma Ray, Inc. Test ID.: See Above

We certify that the statements in this record are correct and that the test welds were prepared, welded, and tested in accordance with the requirements of Section IX of the ASME Code.

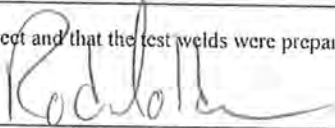Approved By:  Date: 1/5/2017



**TULSA GAMMA RAY, INC.**  
INSPECTION DIVISION  
1127 S. Lewis Avenue Tulsa, OK 74104-3900  
Phone 918-585-3228 Fax 918-584-5598

**TEST REPORT**

PQR# P1-P1-1001  
WPS# 1001  
Lab No. 102124579  
Material SA516-70  
Thickness 0.750"

Date 1-24-07

**TENSILE TEST (QW-150)**

| SPECIMEN NO. | WIDTH | THICKNESS | AREA   | ULTIMATE TOATL LOAD (LB) | ULTIMATE UNIT STRESS (PSI) | TYPE OF FAILURE & LOCATION |
|--------------|-------|-----------|--------|--------------------------|----------------------------|----------------------------|
| 1            | 0.755 | 0.753     | 0.5685 | 41250                    | 72559                      | Ductile-Base               |
| 2            | 0.757 | 0.752     | 0.5693 | 42050                    | 73863                      | Ductile-Base               |


**GUIDED BEND TESTS (QW-160)**

| TYPE AND FIGURE NO. | RESULTS                               |
|---------------------|---------------------------------------|
| 1 SIDE BEND         | NO DEFECT GREATER THAN 1/8". "PASSED" |
| 2 SIDE BEND         | NO DEFECT GREATER THAN 1/8". "PASSED" |
| 3 SIDE BEND         | NO DEFECT GREATER THAN 1/8". "PASSED" |
| 4 SIDE BEND         | NO DEFECT GREATER THAN 1/8". "PASSED" |

Welder Jimmy Dick

ISTI PLANT SERVICES

Client

  
Submitted by John Phillips

# TULSA GAMMA RAY, INC.

1127 S Lewis Ave Tulsa, OK 74104  
918.585.3228

## MECHANICAL TEST REPORT

Welder Qualification     Weld Procedure Evaluation  
**Organization** ISTI PLANT SERVICES    **LAB #** 102126206  
**Base Metal Type** SA516-70    **PWHT** N.A.  
**Coupon Thickness** 0.500"    **PQR#** P1-P1-1001  
**WPS No.** 1001    **Filler** ER70S-6  
**Weld Process** GTAW    **Position** 1G  
**Welder's Name** ANDRES GARCIA

| BENDS           |           |                  |
|-----------------|-----------|------------------|
| Specimen Number | Bend Type | Results/Comments |
| 1               | N/A       | N/A              |
| 2               | N/A       | N/A              |
| 3               | N/A       | N/A              |
| 4               | N/A       | N/A              |


| TENSILE TESTS   |               |                       |                     |                      |                |
|-----------------|---------------|-----------------------|---------------------|----------------------|----------------|
| Specimen Number | Specimen Size | Specimen Area sq. in. | Load at Failure PSI | Ultimate Tensile PSI | Break Location |
| 1               | N/A           | N/A                   | N/A                 | N/A                  | N/A            |
| 2               | N/A           | N/A                   | N/A                 | N/A                  | N/A            |
| 3               | N/A           | N/A                   | N/A                 | N/A                  | N/A            |
| 4               | N/A           | N/A                   | N/A                 | N/A                  | N/A            |

| HARDNESS IN BHN |     |     |                    |     |     |            |     |     |
|-----------------|-----|-----|--------------------|-----|-----|------------|-----|-----|
| Material 1      |     |     | Heat Affected Zone |     |     | Weld Metal |     |     |
| 1               | 2   | 3   | 1                  | 2   | 3   | 1          | 2   | 3   |
| 165             | 163 | 159 | 174                | 175 | 176 | 189        | 191 | 186 |
| Material 2      |     |     | Heat Affected Zone |     |     |            |     |     |
| 1               | 2   | 3   | 1                  | 2   | 3   |            |     |     |
| 159             | 158 | 167 | 168                | 169 | 171 |            |     |     |

| CHARPY V-NOTCH IMPACT TESTING |               |               |         |                |                   |               |
|-------------------------------|---------------|---------------|---------|----------------|-------------------|---------------|
| Specimen Number               | Specimen Type | Specimen Size | Temp. F | Value Ft./Lbs. | Lateral Expansion | Percent Shear |
| N/A                           | N/A           | N/A           | N/A     | N/A            | N/A               | N/A           |
| N/A                           | N/A           | N/A           | N/A     | N/A            | N/A               | N/A           |
| N/A                           | N/A           | N/A           | N/A     | N/A            | N/A               | N/A           |
| N/A                           | N/A           | N/A           | N/A     | N/A            | N/A               | N/A           |

Other Tests Performed: NONE

Heat Treatment per ASME Sec. VIII Div. I UCS-56, Impacts per UG-84.  
All test performed in accordance to methods specified in ASME SA-370 & ASME Sec. IX.

Signature JOHN PHILLIPS 

Date 2-22-10



American Piping Inspection, Metallurgical Lab  
 18501 E. Admiral Pl. Catoosa, Oklahoma 74015  
 Office: (918) 266-4130

Form: MR-8  
 Established: 10/2/16  
 Revision: 0  
 Date: 10/2/16


Mechanical/Lab Test Report

Organization: ISTI Plant Services Lab Number: M170003 Rev. 0  
 Base Material: 1 SA-106 GRB to 2 SA-106 GRB Heat Number: N/A  
 Coupon Dimension: 6.625" O.D. x 0.562" Pos. IGR Welder Name/ID: Mando Tang ID. N/A  
 WPS/PQR #: 1001 Process(es): GTAW  
 Filler Metal: ER70S-6 PWHT: N/A

Vickers Hardness (HV10)

| Indention Number | Location | Hardness Value | Indention Number | Location | Hardness Value | Indention Number | Location | Hardness Value |
|------------------|----------|----------------|------------------|----------|----------------|------------------|----------|----------------|
| 1                | BM       | 163.8          | 11               | HAZ      | 209.9          | N/A              |          |                |
| 2                | HAZ      | 180.9          | 12               | WM       | 247.9          | N/A              |          |                |
| 3                | HAZ      | 189.3          | 13               | WM       | 234.5          | N/A              |          |                |
| 4                | WM       | 193.6          | 14               | HAZ      | 233.6          | N/A              |          |                |
| 5                | WM       | 181.1          | 15               | HAZ      | 232.4          | N/A              |          |                |
| 6                | HAZ      | 256.3          | 16               | BM       | 173.2          | N/A              |          |                |
| 7                | HAZ      | 225.2          | 17               | HAZ      | 188.7          | N/A              |          |                |
| 8                | BM       | 161.2          | 18               | WM       | 181.1          | N/A              |          |                |
| 9                | BM       | 162.4          | 19               | HAZ      | 197.8          | N/A              |          |                |
| 10               | HAZ      | 227.9          | N/A              |          |                | N/A              |          |                |
| Average BM:      |          | 165.15         | Average HAZ:     |          | 214.2          | Average WM:      |          | 207.64         |

For Reference Only

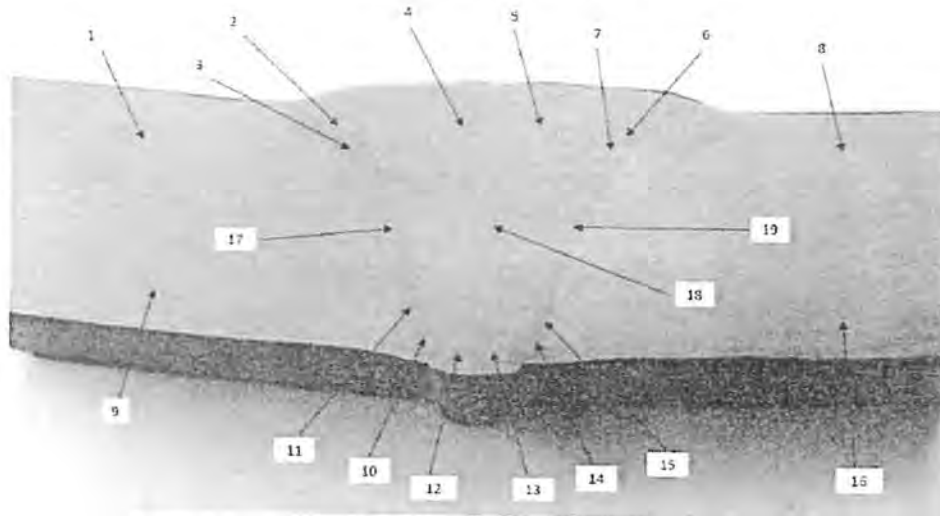

Comments

[Empty box for comments]

Other Tests: N/A

All testing performed in accordance with the methods specified in NACE MRO175

Approved by: Eric Darge

Date: 1/5/2017

Signature:

Title: Certified Associate Welding Inspector

\*Test results relate only to the items tested. This document shall not be reproduced, except in full, without the written approval of American Piping Inspection, Inc. Metallurgical Laboratory.



ISTI Plant Services  
17207 East 21st Street  
Tulsa, OK 74134

Welding Procedure Specification (WPS)

WPS No.: 1003 Date: 11/15/2006 Rev.: 4 Date: 1/5/2017 Page: 1 of 2  
By: [Signature] Date Signed: 1/5/2017

Supporting PQR's: P1-P1-1003 Rev.4 (1/5/2017)

Welding Process(es) / Type(s): (1) GTAW / Manual (2) FCAW / Semiautomatic

**Joints (QW-402)**  
Joint Design: Groove and fillet welds

| Joint Type      | Backing              | Root Opening | Groove Angle | Root Face | Groove Radius |
|-----------------|----------------------|--------------|--------------|-----------|---------------|
| Single-V groove | No backing           | 3/16" max    | 50 deg min   | 1/8" max  | -             |
| Single bevel    | No backing           | 3/16" max    | 45 deg min   | 1/8" max  | -             |
| Single-V groove | Gouged & back welded | 1/4" max     | 50 deg min   | 3/16" max | -             |
| Double bevel    | Gouged & back welded | 1/4" max     | 45 deg min   | 3/16" max | -             |
| Double-V groove | Gouged & back welded | 1/4" max     | 45 deg min   | 3/16" max | -             |
| Square groove   | T-joint              | 1/32" max    | -            | -         | -             |
| Square groove   | No backing           | 3/32" max    | -            | -         | -             |

Fillet Welds: All fillet sizes on all base metal thicknesses and all diameters.

Retainers: None

Groove weld joint details to be approved by Company Representative.

WELD JOINT DESCRIPTIONS SHOWN ARE NOT INCLUSIVE OF ALL THOSE FOUND ON A JOB. WELD JOINT DESIGN REFERENCE IN AN ENGINEERING SPECIFICATION OR A DESIGN DRAWING SHALL TAKE PRECEDENCE OVER WELD JOINTS SHOWN IN THIS WPS.

**Base Metals (QW-403)**

P-No.: 1 Group No.: 1 or 2 Thickness Range (in.): 0.1875 to 8.0000  
to P-No.: 1 Group No.: 1 or 2

- \*Rev. 1 (10/15/2009): Added SI Materials designation to supporting PQR line per customer request.
- \*\*Rev. 2 (9/18/2015): Clarified weld progression, added maximum Hardness Note, and updated to latest Prowrite format.
- \*\*\*Rev. 3 (4/11/2016): clarified GTAW Chemistry verification, Tube to Work Contact Distance, grinding if needed between passes, added preheat ranges, group 2 designation & groove weld joint detail approval by Company Representative statement.
- \*\*\*\*Rev. 4 (1/5/17): Added NACE MRO175 Vickers Hardness to PQR.

**Filler Metals (QW-404)**

Spec. No. (SFA): (1) 5.18 (2) 5.20

AWS No. (Class): (1) ER70S-6 (2) E71T-12M

Filler Metal Use: (1) Filler Metal Used

F No.: (1 & 2) 6 A No.: (1 & 2) (verify chemistry)

Weld Metal Thickness Range: (1) 0.2500 in. maximum (2) 8.0000 in. maximum No Pass Greater Than 1/2" Allowed

Flux Type: N/A

Flux Trade Name: N/A

Consumable Insert: (1) No consumable insert used

Other: \_\_\_\_\_

Flux: (1) No flux used

Product Form: (1) Bare (Solid) (2) Flux cored

Supplemental Filler Metal: (2) None

Strip Thickness or Width (in.): N/A

**ISTI Plant Services**  
**Welding Procedure Specification (WPS)**

WPS No.: 1003 Date: 11/15/2006 Rev.: 4 Date: 1/5/2017 Page: 2 of 2

|   |  |
|---|--|
| <b>Positions (QW-405)</b><br>Position of Joint: <u>(1 &amp; 2) All Positions</u><br>Weld Progression: <u>(1 &amp; 2) Vertical up</u>  | <b>Postweld Heat Treatment (QW-407)</b><br>Type: <u>No PWHT will be performed</u><br>Temperature Range: <u>None</u> °F<br>Time Range: <u>None</u>  |
| <b>Preheat (QW-406)</b><br>Preheat Temp. Min.: <u>70</u> °F<br>Interpass Temp. Max.: <u>400</u> °F<br>Preheat Maintenance: <u>None</u><br><u>70°F &lt; 1.00", 175°F &gt; 1.00"</u>  | <b>Gas (QW-408)</b><br>Gas Composition / Flow Rate<br>Shielding: <u>(1) 100% Argon / 23-30 CFH</u><br><u>(2) 75% Argon, 25% CO2 / 23-30 CFH</u><br>Trailing: <u>(1 &amp; 2) None</u><br>Backing: <u>(1 &amp; 2) None</u> |
| <b>Electrical Characteristics (QW-409)</b><br>Current Type / Polarity: <u>(1) DCEN (straight) (2) DCEP (reverse)</u><br>Pulsed Current: <u>(1) No pulsed current used</u><br>Tungsten Electrode Type and Size: <u>(1) EWTh-2 / 3/32 (2) N/A</u><br>Mode of Metal Transfer for GMAW(FCAW): <u>(1) N/A (2) Globular arc</u><br>Max. Heat Input (J/in): <u>(1 &amp; 2) None</u>  |  |
| <b>Technique (QW-410)</b><br>Thermal Processes: <u>(1 &amp; 2) -</u><br>String or Weave Bead: <u>(1 &amp; 2) Stringer and weave bead</u><br>Orifice or Gas Cup Size: <u>(1) #5 to #10 (2) 3/8" to 5/8"</u><br>Initial and Interpass Cleaning: <u>Grind or wire brush clean 1 inch 925mm) on both sides of weld joint</u><br>Method of Back Gouging: <u>When required, grind until all defects are removed.</u><br>Oscillation: <u>N/A</u><br>Contact Tube to Work Distance: <u>(2) 5/8" - 7/8"</u><br>Single or Multiple Passes (per side): <u>(1) Multipass (2) -</u><br>Single or Multiple Electrodes: <u>N/A</u><br>Peening: <u>(1 &amp; 2) None</u> |  |
| (1) ER70S-6 chemistry to be verified by Typical MTR from filler metal manufacturer.   |  |

**Process Welding Parameters**

| Weld Layer(s) and/or Pass(es) | Process | Filler Metal |                | Current         |                | Voltage Range | Travel Speed Range (in/min) |
|-------------------------------|---------|--------------|----------------|-----------------|----------------|---------------|-----------------------------|
|                               |         | Class        | Diameter (in.) | Type / Polarity | Amperage Range |               |                             |
| Any                           | GTAW    | ER70S-6      | 1/16           | DCEN (straight) | 70-150         | n/r           | Var.                        |
| Any                           | GTAW    | ER70S-6      | 3/32           | DCEN (straight) | 80-180         | n/r           | Var.                        |
| Any                           | GTAW    | ER70S-6      | 1/8            | DCEN (straight) | 130-275        | n/r           | Var.                        |
| Any                           | GTAW    | ER70S-6      | 3/16           | DCEN (straight) | 200-375        | n/r           | Var.                        |
| Any                           | FCAW    | E71T-12M     | 0.035          | DCEP (reverse)  | 120-200        | 19-24         | Var.                        |
| Any                           | FCAW    | E71T-12M     | 0.045          | DCEP (reverse)  | 150-225        | 22-26         | Var.                        |
| Any                           | FCAW    | E71T-12M     | 1/16           | DCEP (reverse)  | 175-275        | 25-28         | Var.                        |
| Any                           | FCAW    | E71T-12M     | 5/64           | DCEP (reverse)  | 200-400        | 26-32         | Var.                        |
| Any                           | FCAW    | E71T-12M     | 3/32           | DCEP (reverse)  | 300-500        | 26-34         | Var.                        |



ISTI Plant Services  
17207 East 21st Street  
Tulsa, OK 74134

Procedure Qualification Record (PQR)

PQR No.: PI-PI-1003 Rev.4 (1/5/2017) WPS No.: 1003 Date: 11/15/2006 Page: 1 of 2

Welding Process(es) / Type(s): (1) GTAW / Manual (2) FCAW / Semiautomatic

|  |  |
|--|--|
| <b>Joints (QW-402)</b><br>Weld Type: <u>Groove weld</u><br><u>Single-V groove</u><br>Backing: <u>Open butt, no back weld</u><br>Root Opening: <u>1/8</u> in. Root Face: <u>-</u> in.<br>Groove Angle: <u>60</u> °  |  |
| <b>Base Metals (QW-403)</b><br>Material Spec., Type or Grade:<br><u>SA-516, Grade 70</u> to <u>SA-516, Grade 70</u><br>P-No.: <u>1</u> Group No.: <u>2</u> to P-No.: <u>1</u> Group No.: <u>2</u><br>Thickness of Test Coupon (in.): <u>1.500</u>  | <b>Postweld Heat Treatment (QW-407)</b><br>Type: <u>No PWHT performed</u><br>Temperature: <u>None</u> °F<br>Time: <u>None</u> hr   |
| <b>Filler Metals (QW-404)</b><br>SFA Specification: <u>(1) 5.18 (2) 5.20</u><br>AWS Classification: <u>(1) ER70S-6 (2) E71T-12M</u><br>Filler Metal Use: <u>(1) Filler Metal Used</u><br>Filler Metal F-No: <u>(1 &amp; 2) 6</u><br>Weld Metal Analysis A-No: <u>(1 &amp; 2) (verify chemistry)</u><br>Size of Filler Metal (in.): <u>(1) 3/32 (2) 0.045</u><br>Weld Deposit 't' (in.): <u>(1) 0.125 (2) 1.375</u><br>Pass Greater Than 1/8": <u>(2) No</u><br>Filler Metal Product Form: <u>(1) Bare (Solid) (2) Flux cored</u><br>Supplemental Filler Metal: <u>(2) None</u><br>Consumable Insert: <u>(1) None</u> | <b>Gas (QW-408)</b><br>Gas Composition / Flow Rate<br>Shielding: <u>(1) 100% Argon / 25 CFH</u><br><u>(2) 75% Argon, 25% CO2 / 25 CFH</u><br>Trailing: <u>(1 &amp; 2) None</u><br>Backing: <u>(1 &amp; 2) None</u>   |
| <b>Positions (QW-405)</b><br>Position of Joint: <u>(1 &amp; 2) 1G - Flat</u><br>Weld Progression: <u>(1 &amp; 2) N/A</u>   | <b>Electrical Characteristics (QW-409)</b><br>Current / Polarity: <u>(1) DCEN (straight) (2) DCEP (reverse)</u><br>Amps: <u>(1) 140 (2) 160</u><br>Volts: <u>(1) 15 (2) 26</u><br>Tungsten Type / Size: <u>(1) EWTh-2 / 3/32 (2) N/A</u><br>Transfer Mode: <u>(2) Globular arc</u><br>Wire Feed Speed (in/min): <u>(2) 300</u><br>Heat Input: <u>(1 &amp; 2) N/R</u>   |
| <b>Preheat (QW-406)</b><br>Preheat Temp.: <u>32</u> °F<br>Interpass Temp.: <u>500</u> °F<br>Preheat Maintenance: <u>None</u>   | <b>Technique (QW-410)</b><br>Travel Speed (in/min): <u>(1) 3 (2) 4</u><br>Thermal Processes: <u>(1 &amp; 2) No</u><br>String/Weave Bead: <u>(1 &amp; 2) Stringer and weave bead</u><br>Oscillation: <u>(1 &amp; 2) N/A</u><br>Mult./Single Pass (per side): <u>(1 &amp; 2) Multipass</u><br>Mult./Single Electrode: <u>(1 &amp; 2) N/A</u><br>Nozzle/Gas Cup Size: <u>(2) .625</u><br>Contact Tube to Work Dist.: <u>(2) 3/4</u> |
| (1) *Rev. 1 (4/3/08): Added Brinell Hardness<br>**Rev. 2 (10/15/09): Added SI Material<br>***Rev. 3 (9/18/15): Updated to latest Prowrite Format.<br><br>(2) ****Rev. 4 (1/7/2017): Added NACE MRO175 Vickers Hardness to PQR - Lab #M170005 Welder: Arturo Vallejo.<br>****SEE LAB REPORT FOR ACTUAL HARDNESS READING LOCATIONS   |  |

ISTI Plant Services  
 Procedure Qualification Record (PQR)

PQR No.: P1-P1-1003 Rev.4 (1/5/2017)

Page: 2 of 2

**Tensile Test (QW-150)**

| Specimen No. | Width (in.) | Thickness (in.) | Area (in <sup>2</sup> ) | Ultimate Total Load (lb) | Ultimate Stress (PSI) | Failure Type and Location |
|--------------|-------------|-----------------|-------------------------|--------------------------|-----------------------|---------------------------|
| 1            | 0.758       | 1.521           | 1.15                    | 84350                    | 73300                 | Ductile - BM              |
| 2            | 0.753       | 1.527           | 1.15                    | 83850                    | 72900                 | Ductile - BM              |

**Guided Bend Test (QW-160)**

| Figure Number and Type | Result | Figure Number and Type | Result           |
|------------------------|--------|------------------------|------------------|
| QW-462.2 Side bend     | Passed | QW-462.2 Side bend     | Passed           |
| QW-462.2 Side bend     | Passed | QW-462.2 Side bend     | No defects noted |
| None                   |        | None                   |                  |

**Hardness Test - Brinell/Vickers hardness**

| Location                       | Readings |       |       |       |       |       |       |       |       |
|--------------------------------|----------|-------|-------|-------|-------|-------|-------|-------|-------|
|                                | 1        | 2     | 3     | 4     | 5     | 6     | 7     | 8     | 9     |
| SA-516, Grade 70 BM (Brinell)  | 264      | 266   | 258   | 267   | 263   | 269   |       |       |       |
| SA-516, Grade 70 HAZ (Brinell) | 275      | 273   | 270   | 276   | 275   | 281   |       |       |       |
| Weld metal (Brinell)           | 281      | 281   | 289   |       |       |       |       |       |       |
| SA-106, Grade B BM (Vickers)   | 159.7    | 167.5 | 175.6 | 169   |       |       |       |       |       |
| SA-106, Grade B HAZ (Vickers)  | 197.4    | 199.1 | 233.6 | 223.6 | 178.1 | 176.1 | 194.6 | 186.6 | 172.9 |
| SA-106, Grade B HAZ (Vickers)  | 174      |       |       |       |       |       |       |       |       |
| Weld metal (Vickers)           | 194.3    | 188.7 | 184.6 | 189.9 | 172.7 |       |       |       |       |

Visual Examination: Acceptable

Welders/Lab Numbers

Jimmy Dick Lab# 102124377

Erik Medrando Lab# 102126341

Arturo Vallejo Lab# W170005


Welder's Name: J. Dick -4377 E. Medrando-6341 A. Vallejo-7005 ID: \_\_\_\_\_ Stamp: \_\_\_\_\_

Welding of coupon was witnessed

by: ISTI Plant Services

Tests Conducted By: Tulsa Gamma Ray Test ID.: See Above

We certify that the statements in this record are correct and that the test welds were prepared, welded, and tested in accordance with the requirements of Section IX of the ASME Code.

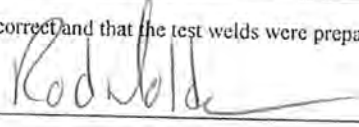Approved By:  1/5/2017  
Date



**TULSA GAMMA RAY, INC.**  
INSPECTION DIVISION  
1127 S. Lewis Avenue Tulsa, OK 74104-3900  
Phone 918-585-3228 Fax 918-584-5598

**TEST REPORT**

PQR# P1-P1-1003  
WPS# 1003  
Lab No. 102124377  
Material SA516-70  
Thickness 1.500"

Date 11-15-06

**TENSILE TEST (QW-150)**

| SPECIMEN NO. | WIDTH  | THICKNESS | AREA | ULTIMATE TENSILE LOAD (LB) | ULTIMATE UNIT STRESS (PSI) | TYPE OF FAILURE & LOCATION |
|--------------|--------|-----------|------|----------------------------|----------------------------|----------------------------|
| 1            | 0.758" | 1.521"    | 1.15 | 84,350                     | 73,300                     | Ductile-Base               |
| 2            | 0.753" | 1.527"    | 1.15 | 83,850                     | 72,900                     | Ductile-Base               |


**GUIDED BEND TESTS (QW-160)**

| TYPE AND FIGURE NO.   | RESULTS                               |
|-----------------------|---------------------------------------|
| #1 SIDE BEND QW-462.2 | NO DEFECT GREATER THAN 1/8". "PASSED" |
| #2 SIDE BEND QW-462.2 | NO DEFECT GREATER THAN 1/8". "PASSED" |
| #3 SIDE BEND QW-462.2 | NO DEFECT GREATER THAN 1/8". "PASSED" |
| #4 SIDE BEND QW-462.2 | NO DEFECT GREATER THAN 1/8". "PASSED" |

Welder Jimmy Dick

ISTI PLANT SERVICES

Client \_\_\_\_\_

  
Submitted by John Phillips \_\_\_\_\_

All test performed in accordance to methods specified in ASTM A370 & ASME Sec. IX

# TULSA GAMMA RAY, INC.

1127 S Lewis Ave Tulsa, OK 74104  
918.585.3228

## MECHANICAL TEST REPORT

Welder Qualification     Weld Procedure Evaluation  
**Organization** ISTI PLANT SERVICES    **LAB #** 102126341  
**Base Metal Type** SA106B    **PWHT** N.A.  
**Coupon Thickness** 6" Sch 120 (6.625" x 0.562")    **PQR#** P1-P1-1003  
**WPS No.** 1003    **Filler** ER70S-6/E71T-12M  
**Weld Process** GTAW/FCAW    **Position** 6G  
**Welder's Name** Erik Medrando

| Specimen Number | Bend Type | BENDS            |     |
|-----------------|-----------|------------------|-----|
|                 |           | Results/Comments |     |
| 1               | N/A       |                  | N/A |
| 2               | N/A       |                  | N/A |
| 3               | N/A       |                  | N/A |
| 4               | N/A       |                  | N/A |


| Specimen Number | Specimen Size | TENSILE TESTS         |                     |                      |     | Break Location |
|-----------------|---------------|-----------------------|---------------------|----------------------|-----|----------------|
|                 |               | Specimen Area sq. in. | Load at Failure PSI | Ultimate Tensile PSI |     |                |
| 1               | N/A           | N/A                   | N/A                 | N/A                  | N/A |                |
| 2               | N/A           | N/A                   | N/A                 | N/A                  | N/A |                |
| 3               | N/A           | N/A                   | N/A                 | N/A                  | N/A |                |
| 4               | N/A           | N/A                   | N/A                 | N/A                  | N/A |                |

| HARDNESS IN BHN |     |     |                    |     |     |            |     |     |
|-----------------|-----|-----|--------------------|-----|-----|------------|-----|-----|
| Material 1      |     |     | Heat Affected Zone |     |     | Weld Metal |     |     |
| 1               | 2   | 3   | 1                  | 2   | 3   | 1          | 2   | 3   |
| 264             | 266 | 258 | 275                | 273 | 270 | 281        | 281 | 289 |
| Material 2      |     |     | Heat Affected Zone |     |     |            |     |     |
| 1               | 2   | 3   | 1                  | 2   | 3   |            |     |     |
| 267             | 263 | 269 | 276                | 275 | 281 |            |     |     |

| CHARPY V-NOTCH IMPACT TESTING |               |               |         |                |                   |               |  |
|-------------------------------|---------------|---------------|---------|----------------|-------------------|---------------|--|
| Specimen Number               | Specimen Type | Specimen Size | Temp. F | Value Ft./Lbs. | Lateral Expansion | Percent Shear |  |
| NONE                          | N/A           | N/A           | N/A     | N/A            | N/A               | N/A           |  |
| N/A                           | N/A           | N/A           | N/A     | N/A            | N/A               | N/A           |  |
| N/A                           | N/A           | N/A           | N/A     | N/A            | N/A               | N/A           |  |
| N/A                           | N/A           | N/A           | N/A     | N/A            | N/A               | N/A           |  |

Other Tests Performed: NONE

Heat Treatment per ASME Sec. VIII Div. 1 UCS-56, Impacts per UG-84.  
All test performed in accordance to methods specified in ASME SA-370 & ASME Sec. IX.

Signature JOHN PHILLIPS 

Date 4-3-08



American Piping Inspection, Metallurgical Lab  
 18501 E. Admiral Pl. Catoosa, Oklahoma 74015  
 Office: (918) 266-4130

Form: MR-8  
 Established: 10/2/16  
 Revision: 0  
 Date: 10/2/16


Mechanical/Lab Test Report

Organization: ISTI Plant Services Lab Number: M170005 Rev. 0  
 Base Material: 1 SA-106 GRB to 2 SA-106 GRB Heat Number: N/A  
 Coupon Dimension: 6.625" O.D. x 0.562" Pos. IGR Welder Name/ID: Arturo Vallejo ID: N/A  
 WPS/PQR #: 1003 Process(es): GTAW/FCAW  
 Filler Metal: ER70S-G/E71T-12M PWHT: N/A

Vickers Hardness (HV10)

| Indention Number | Location | Hardness Value | Indention Number | Location | Hardness Value | Indention Number | Location | Hardness Value |
|------------------|----------|----------------|------------------|----------|----------------|------------------|----------|----------------|
| 1                | BM       | 159.7          | 11               | HAZ      | 176.1          | N/A              |          |                |
| 2                | HAZ      | 197.4          | 12               | WM       | 184.6          | N/A              |          |                |
| 3                | HAZ      | 199.1          | 13               | WM       | 189.9          | N/A              |          |                |
| 4                | WM       | 194.3          | 14               | HAZ      | 194.6          | N/A              |          |                |
| 5                | WM       | 188.7          | 15               | HAZ      | 186.6          | N/A              |          |                |
| 6                | HAZ      | 233.6          | 16               | BM       | 169            | N/A              |          |                |
| 7                | HAZ      | 223.6          | 17               | HAZ      | 172.9          | N/A              |          |                |
| 8                | BM       | 167.5          | 18               | WM       | 172.7          | N/A              |          |                |
| 9                | BM       | 175.6          | 19               | HAZ      | 174            | N/A              |          |                |
| 10               | HAZ      | 178.1          | N/A              |          |                | N/A              |          |                |
| Average BM:      |          | 167.95         | Average HAZ:     |          | 193.6          | Average WM:      |          | 186.04         |

For Reference Only

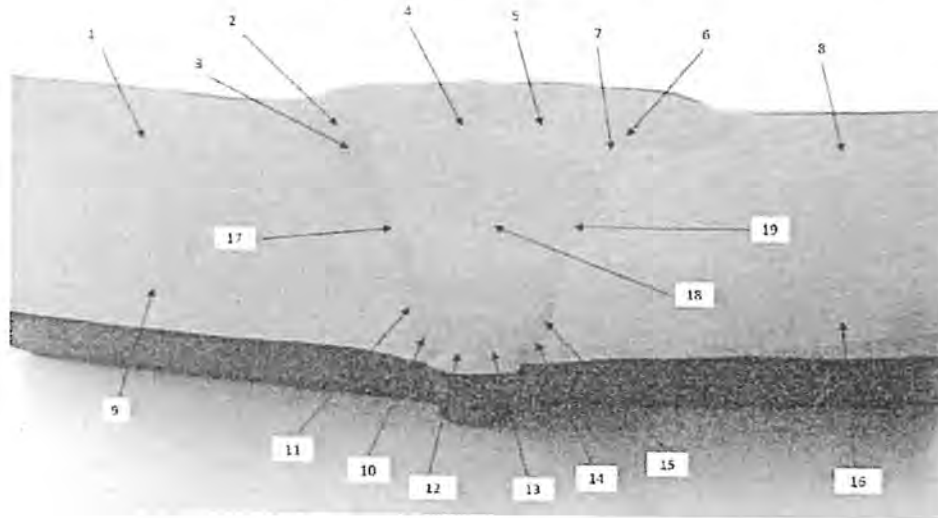

Comments

[Empty box for comments]

Other Tests: N/A

All testing performed in accordance with the methods specified in NACE MRO175

Approved by: Eric Darge

Date: 1/5/2017

Signature:

Title: Certified Associate Welding Inspector

\*Test results relate only to the items tested. This document shall not be reproduced, except in full, without the written approval of American Piping Inspection, Inc. Metallurgical Laboratory.



ISTI Plant Services  
17207 East 21st Street  
Tusla, Ok 74134

Welding Procedure Specification (WPS)

WPS No.: 1004 Date: 10/16/2006 Rev.: 4 Date: 1/5/2017 Page: 1 of 2  
By: [Signature] Date Signed: 1/5/2017

Supporting PQR's: P1-P1-1004 Rev. 4 (1/5/2017)

Welding Process(es) / Type(s): (1) GMAW / Semiautomatic (2) FCAW / Semiautomatic

| Joint Type      | Backing              | Root Opening | Groove Angle | Root Face | Groove Radius |
|-----------------|----------------------|--------------|--------------|-----------|---------------|
| Single-V groove | No backing           | 3/16" max    | 50 deg min   | 1/8" max  | -             |
| Single bevel    | No backing           | 3/16" max    | 45 deg min   | 1/8" max  | -             |
| Single-V groove | Gouged & back welded | 1/4" max     | 50 deg min   | 3/16" max | -             |
| Double bevel    | Gouged & back welded | 1/4" max     | 45 deg min   | 3/16" max | -             |
| Double-V groove | Gouged & back welded | 1/4" max     | 45 deg min   | 3/16" max | -             |
| Square groove   | T-joint              | 1/32" max    | -            | -         | -             |
| Square groove   | No backing           | 3/32" max    | -            | -         | -             |

Fillet Welds: All fillet sizes on all base metal thicknesses and all diameters.

Retainers: None

All groove weld joint details must be approved by Company Representative.

WELD JOINT DESCRIPTIONS SHOWN ARE NOT INCLUSIVE OF ALL THOSE FOUND ON A JOB. WELD JOINT DESIGN REFERENCE IN AN ENGINEERING SPECIFICATION OR A DESIGN DRAWING SHALL TAKE PRECEDENCE OVER WELD JOINTS SHOWN IN THIS WPS.

Base Metals (QW-403)

P-No.: 1 Group No.: 1 or 2 Thickness Range (in.): 0.1875 to 8.0000  
to P-No.: 1 Group No.: 1 or 2

\*Rev. 1 (7/5/2007): Deleted SA516-70 Material Spec

\*\*Rev. 2 (9/10/2015): Updated to latest Prowrite Format

\*\*\*Rev. 3 (4/11/2016): Updated contact to work distances, corrected GMAW mode of transfer to reflect actual Volts & Amps used, added Group 2 designation of P Number & added groove weld joint detail approval by Company Representative statement.

\*\*\*\*Rev. 4 (1/5/2017): Added NACE MRO175 Vickers Hardness to PQR.

Filler Metals (QW-404)

Spec. No. (SFA): (1) 5.18 (2) 5.20

AWS No. (Class): (1) ER70S-6 (2) E71T-12M

F No.: (1 & 2) 6 A No.: (1 & 2) (verify chemistry)

Weld Metal Thickness Range: (1) 0.2500 in. maximum No Pass Greater Than 1/2" Allowed  
(2) 8.0000 in. maximum No Pass Greater Than 1/2" Allowed

Flux Type: N/A

Flux Trade Name: N/A

Consumable Insert: N/A

Other: \_\_\_\_\_

Product Form: (1) Bare (Solid) (2) Flux cored

Supplemental Filler Metal: (1 & 2) None

Strip Thickness or Width (in.): N/A

ISTI Plant Services  
Welding Procedure Specification (WPS)

WPS No.: 1004. Date: 10/16/2006 Rev.: 4 Date: 1/5/2017 Page: 2 of 2

|   |  |
|---|--|
| <b>Positions (QW-405)</b><br>Position of Joint: <u>(1 &amp; 2) All Positions</u><br>Weld Progression: <u>(1 &amp; 2) Vertical up</u>  | <b>Postweld Heat Treatment (QW-407)</b><br>Type: <u>                    </u> No PWHT will be performed<br>Temperature Range: <u>                    </u> None °F<br>Time Range: <u>                    </u> None |
| <b>Preheat (QW-406)</b><br>Preheat Temp. Min.: <u>                    </u> 70 °F<br>Interpass Temp. Max.: <u>                    </u> 400 °F<br>Preheat Maintenance: <u>                    </u> None   | <b>Gas (QW-408)</b><br>Gas Composition / Flow Rate<br>Shielding: <u>(1 &amp; 2) 75% Argon, 25% CO2 / 32-42 CFH</u><br>Trailing: <u>(1 &amp; 2) None</u><br>Backing: <u>(1 &amp; 2) None</u>                      |
| <b>Electrical Characteristics (QW-409)</b><br>Current Type / Polarity: <u>(1 &amp; 2) DCEP (reverse)</u><br>Tungsten Electrode Type and Size: <u>(1 &amp; 2) N/A</u><br>Mode of Metal Transfer for GMAW(FCAW): <u>(1 &amp; 2) Globular arc</u><br>Max. Heat Input (J/in): <u>(1 &amp; 2) None</u>   |  |
| <b>Technique (QW-410)</b><br>Thermal Processes: <u>(1 &amp; 2) -</u><br>String or Weave Bead: <u>(1 &amp; 2) Stringer and weave bead</u><br>Orifice or Gas Cup Size: <u>(1 &amp; 2) 3/8" to 5/8"</u><br>Initial and Interpass Cleaning: <u>Grind or wire brush clean 1 inch (25 mm) on both sides of weld joint</u><br>Method of Back Gouging: <u>When required, grind until all defects are removed.</u><br>Oscillation: <u>N/A</u><br>Contact Tube to Work Distance: <u>(1) 1/2 to 3/4" (2) 5/8" to 7/8"</u><br>Single or Multiple Passes (per side): <u>(1) Multipass (2) -</u><br>Single or Multiple Electrodes: <u>N/A</u><br>Peening: <u>(1 &amp; 2) None</u> |  |

Process Welding Parameters

| Weld Layer(s) and/or Pass(es) | Process | Filler Metal |                | Current         |                | Voltage Range | Travel Speed Range (in/min) |
|-------------------------------|---------|--------------|----------------|-----------------|----------------|---------------|-----------------------------|
|                               |         | Class        | Diameter (in.) | Type / Polarity | Amperage Range |               |                             |
| Any                           | GMAW    | ER70S-6      | 0.035          | DCEP (reverse)  | 100-175        | 23-26         | Var.                        |
| Any                           | GMAW    | ER70S-6      | 0.045          | DCEP (reverse)  | 150-250        | 23-27         | Var.                        |
| Any                           | GMAW    | ER70S-6      | 1/16           | DCEP (reverse)  | 200-300        | 24-28         | Var.                        |
| Any                           | FCAW    | E71T-12M     | 0.035          | DCEP (reverse)  | 120-200        | 19-24         | Var.                        |
| Any                           | FCAW    | E71T-12M     | 0.045          | DCEP (reverse)  | 150-225        | 22-26         | Var.                        |
| Any                           | FCAW    | E71T-12M     | 1/16           | DCEP (reverse)  | 175-275        | 25-28         | Var.                        |
| Any                           | FCAW    | E71T-12M     | 5/64           | DCEP (reverse)  | 200-400        | 26-32         | Var.                        |
| Any                           | FCAW    | E71T-12M     | 3/32           | DCEP (reverse)  | 300-500        | 26-34         | Var.                        |



ISTI Plant Services  
17207 East 21st Street  
Tulsa, OK 74134

Procedure Qualification Record (PQR)

PQR No.: PI-PI-1004 Rev. 4 (1/5/2017) WPS No.: 1004 Date: 1/5/2017 Page: 1 of 2

Welding Process(es) / Type(s): (1) GMAW / Semiautomatic (2) FCAW / Semiautomatic

|   |   |
|---|---|
| <b>Joints (QW-402)</b><br>Weld Type: <u>Groove weld</u><br><u>Single-V groove</u><br>Backing: <u>Open butt, no back weld</u><br>Root Opening: <u>1/8</u> in. Root Face: <u>-</u> in.<br>Groove Angle: <u>60</u> °   |   |
| <b>Base Metals (QW-403)</b><br>Material Spec., Type or Grade:<br><u>SA-516, Grade 70</u> to <u>SA-516, Grade 70</u><br>P-No.: <u>1</u> Group No.: <u>2</u> to P-No.: <u>1</u> Group No.: <u>2</u><br>Thickness of Test Coupon (in.): <u>1.500</u>   | <b>Postweld Heat Treatment (QW-407)</b><br>Type: <u>No PWHT performed</u><br>Temperature: <u>None</u> °F<br>Time: <u>None</u> hr  |
| <b>Filler Metals (QW-404)</b><br>SFA Specification: <u>(1) 5.18 (2) 5.20</u><br>AWS Classification: <u>(1) ER70S-6 (2) E71T-12M</u><br>Filler Metal F-No: <u>(1 &amp; 2) 6</u><br>Weld Metal Analysis A-No: <u>(1 &amp; 2) (verify chemistry)</u><br>Size of Filler Metal (in.): <u>(1 &amp; 2) 0.035</u><br>Weld Deposit 't' (in.): <u>(1) 0.125 (2) 1.375</u><br>Pass Greater Than 1/2": <u>(1 &amp; 2) No</u><br>Filler Metal Product Form: <u>(1) Bare (Solid) (2) Flux cored</u><br>Supplemental Filler Metal: <u>(1 &amp; 2) None</u> | <b>Gas (QW-408)</b><br>Gas Composition / Flow Rate<br>Shielding: <u>(1 &amp; 2) 75% Argon, 25% CO2 / 35 CFH</u><br>Trailing: <u>(1 &amp; 2) None</u><br>Backing: <u>(1 &amp; 2) None</u>  |
| <b>Positions (QW-405)</b><br>Position of Joint: <u>(1 &amp; 2) 1G - Flat</u><br>Weld Progression: <u>(1 &amp; 2) N/A</u>  | <b>Electrical Characteristics (QW-409)</b><br>Current / Polarity: <u>(1 &amp; 2) DCEP (reverse)</u><br>Amps: <u>(1) 110 (2) 160</u><br>Volts: <u>(1) 20 (2) 26</u><br>Tungsten Type / Size: <u>(1 &amp; 2) N/A</u><br>Transfer Mode: <u>(1 &amp; 2) Globular arc</u><br>Heat Input: <u>(1 &amp; 2) N/R</u>  |
| <b>Preheat (QW-406)</b><br>Preheat Temp.: <u>70</u> °F<br>Interpass Temp.: <u>400</u> °F<br>Preheat Maintenance: <u>None</u>  | <b>Technique (QW-410)</b><br>Travel Speed (in/min): <u>(1) 4 (2) 5</u><br>Thermal Processes: <u>(1 &amp; 2) No</u><br>String/Weave Bead: <u>(1 &amp; 2) Stringer and weave bead</u><br>Oscillation: <u>(1 &amp; 2) N/A</u><br>Mult./Single Pass (per side): <u>(1 &amp; 2) Multipass</u><br>Mult./Single Electrode: <u>(1 &amp; 2) N/A</u><br>Nozzle/Gas Cup Size: <u>(1 &amp; 2) 3/8</u><br>Contact Tube to Work Dist.: <u>(1 &amp; 2) 1/2</u> |
| (1)<br>*Rev. 1: Corrected FCAW Weld Metal Thickness.<br>**Rev. 2 (4/8/2008): Added Brinell Hardness.<br>(2) ***Rev. 3 (9/10/2015): Updated to latest Prowrite Format.<br>****Rev. 4 (1/5/2017): Added NACE MRO175 Vickers Hardness to PQR - Lab #W170004 Welder: Arturo Vallejo<br>****SEE LAB REPORT FOR ACTUAL HARDNESS READING LOCATIONS.  |   |

ISTI Plant Services  
Procedure Qualification Record (PQR)

PQR No.: P1-P1-1004 Rev. 4 (1/5/2017)

Page: 2 of 2

Tensile Test (QW-150)

| Specimen No. | Width (in.) | Thickness (in.) | Area (in <sup>2</sup> ) | Ultimate Total Load (lb) | Ultimate Stress (PSI) | Failure Type and Location |
|--------------|-------------|-----------------|-------------------------|--------------------------|-----------------------|---------------------------|
| 1            | 0.756       | 1.526           | 1.15                    | 85425                    | 74300                 | Ductile - BM              |
| 2            | 0.751       | 1.520           | 1.14                    | 83450                    | 73200                 | Ductile - BM              |

Guided Bend Test (QW-160)

| Figure Number and Type | Result | Figure Number and Type | Result |
|------------------------|--------|------------------------|--------|
| QW-462.2 Side bend     | Passed | QW-462.2 Side bend     | Passed |
| QW-462.2 Side bend     | Passed | QW-462.2 Side bend     | Passed |
| None                   |        | None                   |        |

Hardness Test - Brinell/Vickers Hardness

| Location   | Readings |       |       |       |       |       |     |       |       |
|--|----------|-------|-------|-------|-------|-------|-----|-------|-------|
|  | 1        | 2     | 3     | 4     | 5     | 6     | 7   | 8     | 9     |
| SA-516, Grade 70 BM (Brinell)                          | 174      | 168   | 163   | 169   | 168   | 171   |     |       |       |
| SA-516, Grade 70 HAZ (Brinell)                         | 174      | 168   | 171   | 175   | 182   | 183   |     |       |       |
| Weld metal (Brinell)                                   | 182      | 183   | 181   |       |       |       |     |       |       |
| SA-106, Grade B BM (Vickers)                           | 177.2    | 181.7 | 184   | 179.7 |       |       |     |       |       |
| SA-106, Grade B HAZ (Vickers)                          | 253.9    | 244.8 | 211.7 | 205.4 | 184.6 | 186.6 | 174 | 184.3 | 181.4 |
| SA-106, Grade B HAZ (Vickers),<br>Weld metal (Vickers) | 189.6    |       |       |       |       |       |     |       |       |
|  | 187.2    | 192.7 | 181.9 | 167   | 175.6 |       |     |       |       |

Jimmy Dick-102124379  
Mike Littrell-102126352  
Arturo Vallejo-W170004


Welder's Name: J. Dick-4379 M. Littrell-6352 A. Vallejo-004 ID: \_\_\_\_\_ Stamp: \_\_\_\_\_

Welding of coupon was witnessed

by: ISTI Plant Services

Tests Conducted By: Tulsa Gamma Ray Test ID.: See Above

We certify that the statements in this record are correct and that the test welds were prepared, welded, and tested in accordance with the requirements of Section IX of the ASME Code.

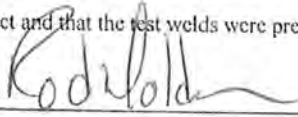Approved By:  1/5/2017  
Date



**TULSA GAMMA RAY, INC.**  
INSPECTION DIVISION  
1127 S. Lewis Avenue Tulsa, OK 74104-3900  
Phone 918-585-3228 Fax 918-584-5598

**TEST REPORT**

PQR# P1-P1-1004  
WPS# 1004  
Lab No. 102124379  
Material SA516-70  
Thickness 1.500"

Date 10-16-06

Weld Process GMAW/FCAW (ER70S-6/E71T-12M)

**TENSILE TEST (QW-150)**

| SPECIMEN NO. | WIDTH | THICKNESS | AREA | ULTIMATE TOATL LOAD (LB) | ULTIMATE UNIT STRESS (PSI) | TYPE OF FAILURE & LOCATION |
|--------------|-------|-----------|------|--------------------------|----------------------------|----------------------------|
| 1            | 0.756 | 1.526     | 1.15 | 85425                    | 74300                      | Ductile-BM                 |
| 2            | 0.751 | 1.520     | 1.14 | 83450                    | 73200                      | Ductile-BM                 |


**GUIDED BEND TESTS (QW-160)**

| TYPE AND FIGURE NO. | RESULTS                               |
|---------------------|---------------------------------------|
| 1 SIDE BEND         | NO DEFECT GREATER THAN 1/8". "PASSED" |
| 2 SIDE BEND         | NO DEFECT GREATER THAN 1/8". "PASSED" |
| 3 SIDE BEND         | NO DEFECT GREATER THAN 1/8". "PASSED" |
| 4 SIDE BEND         | NO DEFECT GREATER THAN 1/8". "PASSED" |

Welder Jimmy Dick

ISTI PLANT SERVICES

Client

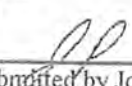  
Submitted by John Phillips

# TULSA GAMMA RAY, INC.

1127 S Lewis Ave Tulsa, OK 74104  
918.585.3228

## MECHANICAL TEST REPORT

|                  |  |   |           |
|------------------|--|---|-----------|
|                  | <input checked="" type="checkbox"/> Welder Qualification | <input checked="" type="checkbox"/> Weld Procedure Evaluation |           |
| Organization     | ISTI plant Services                                      | LAB #   | 102126352 |
| Base Metal Type  | SA106B   | PWHT  | NONE      |
| Coupon Thickness | 6" S/120 (6.625" x .562" wall)                           | Weld Process  | GMAW/FCAW |
| WPS No.          | 1004   | ID#   | N/A       |
| Welder's Name    | Mike Littrell  |   |           |

### BENDS

| Specimen Number | Bend Type | Results/Comments               |
|-----------------|-----------|--------------------------------|
| 1               | Side Bend | No Relevant Indications PASSED |
| 1               | Side Bend | No Relevant Indications PASSED |
| 3               | N/A       | N/A                            |
| 4               | N/A       | N/A                            |

### TENSILE TESTS

| Specimen Number | Specimen Size | Specimen Area sq. in. | Load at Failure PSI | Ultimate Tensile PSI | Break Location |
|-----------------|---------------|-----------------------|---------------------|----------------------|----------------|
| 1               | N/A           | N/A                   | N/A                 | N/A                  | N/A            |
| 2               | N/A           | N/A                   | N/A                 | N/A                  | N/A            |
| 3               | N/A           | N/A                   | N/A                 | N/A                  | N/A            |
| 4               | N/A           | N/A                   | N/A                 | N/A                  | N/A            |

### HARDNESS IN BHN

| Material 1 |      |     | Heat Affected Zone |     |     | Weld Metal |     |     |
|------------|------|-----|--------------------|-----|-----|------------|-----|-----|
| 1          | 2    | 3   | 1                  | 2   | 3   | 1          | 2   | 3   |
| 174        | 168  | 163 | 174                | 168 | 171 | 182        | 183 | 181 |
| Material 2 |      |     | Heat Affected Zone |     |     |            |     |     |
| 1          | 2    | 3   | 1                  | 2   | 3   |            |     |     |
| 169        | 1268 | 171 | 175                | 182 | 183 |            |     |     |

### CHARPY V-NOTCH IMPACT TESTING

| Specimen Number | Specimen Type | Specimen Size | Temp. F | Value Ft./Lbs. | Lateral Expansion | Percent Shear |
|-----------------|---------------|---------------|---------|----------------|-------------------|---------------|
| N/A             | N/A           | N/A           | N/A     | N/A            | N/A               | N/A           |
| N/A             | N/A           | N/A           | N/A     | N/A            | N/A               | N/A           |
| N/A             | N/A           | N/A           | N/A     | N/A            | N/A               | N/A           |
| N/A             | N/A           | N/A           | N/A     | N/A            | N/A               | N/A           |

Other Tests Performed: NONE

All test performed in accordance to methods specified in ASME SA-370 & ASTM Sec. IX.

Signature John Phillips *JP*

Date 4-8-08



American Piping Inspection, Metallurgical Lab  
 18501 E. Admiral Pl. Catoosa, Oklahoma 74015  
 Office: (918) 266-4130

Form: MR-8  
 Established: 10/2/16  
 Revision: 0  
 Date: 10/2/16


Mechanical/Lab Test Report

Organization: ISTI Plant Services Lab Number: W170004 Rev. 0  
 Base Material: 1 SA-106 GRB to 2 SA-106 GRB Heat Number: N/A  
 Coupon Dimension: 6.625" O.D. x 0.562" Pos. IGR Welder Name/ID: Arturo Vallejo ID. N/A  
 WPS/PQR #: 1004 Process(es): GMAW/FCAW  
 Filler Metal: ER70S-6/E71T-12M PWHT: N/A

Vickers Hardness (HV10)

| Indentation Number | Location | Hardness Value | Indentation Number | Location | Hardness Value | Indentation Number | Location | Hardness Value |
|--------------------|----------|----------------|--------------------|----------|----------------|--------------------|----------|----------------|
| 1                  | BM       | 177.2          | 11                 | HAZ      | 186.6          | N/A                |          |                |
| 2                  | HAZ      | 253.9          | 12                 | WM       | 171.9          | N/A                |          |                |
| 3                  | HAZ      | 244.8          | 13                 | WM       | 167            | N/A                |          |                |
| 4                  | WM       | 187.2          | 14                 | HAZ      | 174            | N/A                |          |                |
| 5                  | WM       | 192.7          | 15                 | HAZ      | 184.3          | N/A                |          |                |
| 6                  | HAZ      | 211.7          | 16                 | BM       | 179.7          | N/A                |          |                |
| 7                  | HAZ      | 205.4          | 17                 | HAZ      | 181.4          | N/A                |          |                |
| 8                  | BM       | 181.7          | 18                 | WM       | 175.6          | N/A                |          |                |
| 9                  | BM       | 184            | 19                 | HAZ      | 189.6          | N/A                |          |                |
| 10                 | HAZ      | 184.6          | N/A                |          |                | N/A                |          |                |
| Average BM:        |          | 180.65         | Average HAZ:       |          | 201.63         | Average WM:        |          | 178.88         |

For Reference Only

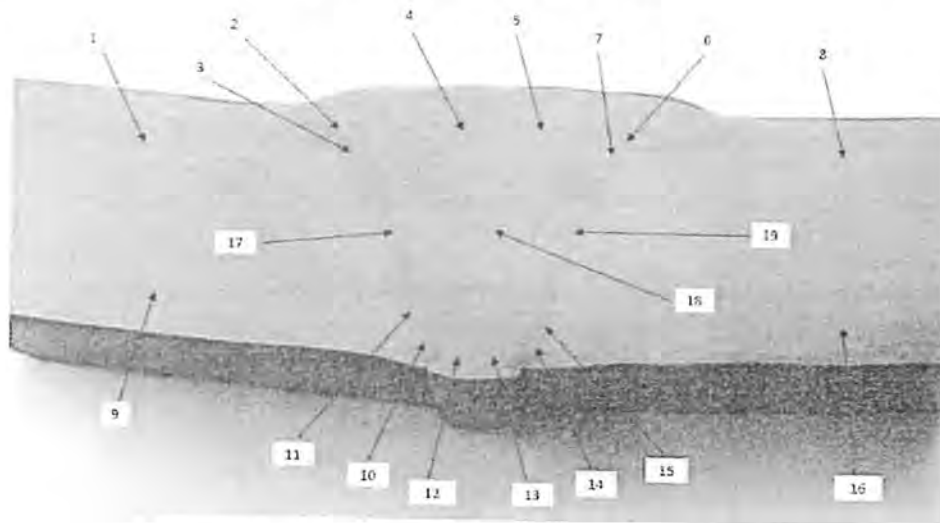

Comments

Other Tests: N/A

All testing performed in accordance with the methods specified in NACE MRO175

Approved by: Josh Mattox

Date: 1/5/2017

Signature: \_\_\_\_\_

Title: Certified Welding Inspector

\*Test results relate only to the items tested. This document shall not be reproduced, except in full, without the written approval of American Piping Inspection, Inc. Metallurgical Laboratory.

ISTI Plant Services  
 17207 East 21st Street  
 Tulsa, OK 74134

Welding Procedure Specification (WPS)

WPS No.: 1005 Date: 11/20/2006 Rev.: 7 Date: 1/23/2018 Page: 1 of 2

By: Rodolfo Date Signed: 1/23/2018

Supporting PQR's: P8-P8-1005-SS ; P8-P8-1005-SS-Supplemental

Welding Process(es) / Type(s): GTAW / Manual

| Joints (QW-402)                              |                      |              |              |           |               |
|--|----------------------|--------------|--------------|-----------|---------------|
| Joint Design: <u>Groove and fillet welds</u> |                      |              |              |           |               |
| Joint Type                                   | Backing              | Root Opening | Groove Angle | Root Face | Groove Radius |
| Single-V groove                              | No backing           | 3/16" max    | 50 deg min   | 1/8" max  | -             |
| Single bevel                                 | No backing           | 3/16" max    | 45 deg min   | 1/8" max  | -             |
| Single-V groove                              | Gouged & back welded | 1/4" max     | 50 deg min   | 3/16" max | -             |
| Double bevel                                 | Gouged & back welded | 1/4" max     | 45 deg min   | 3/16" max | -             |
| Double-V groove                              | Gouged & back welded | 1/4" max     | 45 deg min   | 3/16" max | -             |
| Square groove                                | T-joint              | 1/32" max    | -            | -         | -             |
| Square groove                                | No backing           | 3/32" max    | -            | -         | -             |

Fillet Welds: All fillet sizes on all base metal thicknesses and all diameters.

Retainers: None

SEE ENGINEERING DRAWINGS FOR MISALIGNMENT TOLERANCES. INTERNAL MISALIGNMENT TO BE 1/4 OF WALL THICKNESS, NOT TO EXCEED 1/8" MAX.

WELD JOINT DESCRIPTIONS SHOWN ARE NOT INCLUSIVE OF ALL THOSE FOUND ON A JOB. WELD JOINT DESIGN REFERENCE IN AN ENGINEERING SPECIFICATION OR A DESIGN DRAWING SHALL TAKE PRECEDENCE OVER WELD JOINTS SHOWN IN THIS WPS.

**Base Metals (QW-403)**  
 P-No.: 8 Group No.: 1 Thickness Range (in.): 0.1875 to 8.0000  
 to P-No.: 8 Group No.: 1

Rev. 1 11/8/08 Added Filler Metal to Base Metal direction.  
 Rev. 2 9/24/14 Added Backing Gas maintenance notation.  
 Rev. 3 7/12/16 Clarified no autogenous welding allowed and GTAW bead width limited to 4.5x filler metal diameter.  
 Rev. 4 7/28/16 Corrected typo from Rev. 3. Weld wire from ER70S-6 to ER308L.  
 Rev. 5 10/20/17 Removed preheat requirement and lowered interpass temperature to -350°F.  
 Rev. 6 12/7/17 Added PQR P8-P8-1005-SS-Supplemental to include NACR MR0175 hardness.  
 Rev. 7 1/23/18 Corrected SFA # to 5.9 & added filler metal to base metal claification

**Filler Metals (QW-404)**  
 Spec. No. (SFA): 5.9  
 AWS No. (Class): ER308L or ER316L  
 Filler Metal Use: Filler Metal Used  
 F No.: 6 A No.: 8  
 Weld Metal Thickness Range: 8.0000 in. maximum  
 Flux Type: N/A  
 Flux Trade Name: N/A  
 Consumable Insert: None  
 Other: \_\_\_\_\_  
 Flux: None  
 Product Form: Bare (Solid)  
 Strip Thickness or Width (in.): N/A

ISTI Plant Services  
Welding Procedure Specification (WPS)

WPS No.: 1005 Date: 11/20/2006 Rev.: 7 Date: 1/23/2018 Page: 2 of 2

|   |   |
|---|---|
| <b>Positions (QW-405)</b><br>Position of Joint: <u>All Positions</u><br>Weld Progression: <u>Vertical up</u>  | <b>Postweld Heat Treatment (QW-407)</b><br>Type: <u>No PWHT will be performed</u><br>Temperature Range: <u>None</u> °F<br>Time Range: <u>None</u>   |
| <b>Preheat (QW-406)</b><br>Preheat Temp. Min.: <u>50</u> °F<br>Interpass Temp. Max.: <u>350</u> °F<br>Preheat Maintenance: <u>None</u>  | <b>Gas (QW-408)</b><br><p style="text-align: center;">Gas Composition / Flow Rate</p> Shielding: <u>100% Argon / 27-36 CFH</u><br>Trailing: <u>None</u><br>Backing: <u>100% Argon / 23-30 CFH</u> |
| <b>Electrical Characteristics (QW-409)</b><br>Current Type / Polarity: <u>DCEN (straight)</u><br>Pulsed Current: <u>None</u><br>Tungsten Electrode Type and Size: <u>EWTh-2 / 1/8</u><br>Mode of Metal Transfer for GMAW(FCAW): <u>N/A</u><br>Max. Heat Input (J/in): <u>None</u>   |   |
| <b>Technique (QW-410)</b><br>Thermal Processes: <u>-</u><br>String or Weave Bead: <u>Stringer or weave bead</u><br>Orifice or Gas Cup Size: <u>#5 to #10</u><br>Initial and Interpass Cleaning: <u>With Stainless steel brush clean 2 inches (50 mm) on both sides of weld joint</u><br>Method of Back Gouging: <u>When required, grind until all defects are removed.</u><br>Oscillation: <u>N/A</u><br>Contact Tube to Work Distance: <u>N/A</u><br>Single or Multiple Passes (per side): <u>Multipass</u><br>Single or Multiple Electrodes: <u>N/A</u><br>Peening: <u>None</u> |   |
| Backing gas must be maintained through 2nd pass or until 0.250" weld deposit achieved.<br>No Autogenous welding allowed<br>GTAW Bead Width limited to 4.5x the filler metal diameter.   |   |

**Process Welding Parameters**

| Weld Layer(s) and/or Pass(es) | Process | Filler Metal |                  | Current         |                | Voltage Range | Travel Speed Range ( in/min ) |
|-------------------------------|---------|--------------|------------------|-----------------|----------------|---------------|-------------------------------|
|                               |         | Class        | Diameter ( in. ) | Type / Polarity | Amperage Range |               |                               |
| Any                           | GTAW    | ER308L       | 3/16             | DCEN (straight) | 200-375        | n/r           | Var.                          |
| Any                           | GTAW    | ER316L       | 1/8"             | DCEN (straight) | 130-275        | n/r           | Var.                          |
| Any                           | GTAW    | ER308L       | 3/32             | DCEN (straight) | 80-180         | n/r           | Var.                          |
| Any                           | GTAW    | ER316L       | 3/16             | DCEN (straight) | 200-375        | n/r           | Var.                          |
| Any                           | GTAW    | ER308L       | 1/8              | DCEN (straight) | 130-275        | n/r           | Var.                          |
| Any                           | GTAW    | ER316L       | 3/32             | DCEN (straight) | 80-180         | n/r           | Var.                          |


**Notes**

Filler Metal to Base Metal  
 Filler Metal ER308L allowable for 304 & 304L Base Metal.  
 Filler Metal ER316L allowable for 316 & 316L Base Metal

Procedure Qualification Record (PQR)

PQR No.: P8-P8-1005-SS WPS No.: 1005 Date: 11/20/2006 Page: 1 of 2

Welding Process(es) / Type(s): GTAW / Manual
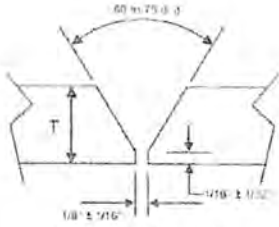
|   |   |   |
|---|---|---|
| <b>Joints (QW-402)</b><br>Weld Type: <u>Groove weld</u><br><u>Single-V groove</u><br>Backing: <u>Open butt, no back weld</u><br>Root Opening: <u>5/32</u> in. Root Face: <u>0</u> in.<br>Groove Angle: <u>37.5</u> °  |   |  <p>SINGLE VEE GROOVE</p> |
| <b>Base Metals (QW-403)</b><br>Material Spec., Type or Grade:<br><u>SA-240, Type 304L</u> to <u>SA-240, Type 304L</u><br>P-No.: <u>8</u> Group No.: <u>1</u> to P-No.: <u>8</u> Group No.: <u>1</u><br>Thickness of Test Coupon (in.): <u>1.500</u>   | <b>Postweld Heat Treatment (QW-407)</b><br>Type: <u>No PWHT performed</u><br>Temperature: <u>None</u> °F<br>Time: <u>None</u> hr  |   |
| <b>Filler Metals (QW-404)</b><br>SFA Specification: <u>5.9</u><br>AWS Classification: <u>ER308L</u><br>Filler Metal Use: <u>Filler Metal Used</u><br>Filler Metal F-No: <u>6</u><br>Weld Metal Analysis A-No: <u>8</u><br>Size of Filler Metal (in.): <u>1/8</u><br>Weld Deposit 'T' (in.): <u>1.500</u><br>Filler Metal Product Form: <u>Bare (Solid)</u><br>Consumable Insert: <u>None</u><br>Flux: <u>None</u> | <b>Gas (QW-408)</b><br>Gas Composition / Flow Rate<br>Shielding: <u>100% Argon / 30 CFH</u><br>Trailing: <u>None</u><br>Backing: <u>100% Argon / 25 CFH</u>   |   |
| <b>Positions (QW-405)</b><br>Position of Joint: <u>1G - Flat</u><br>Weld Progression: <u>N/A</u>  | <b>Electrical Characteristics (QW-409)</b><br>Current / Polarity: <u>DCEN (straight)</u><br>Amps: <u>180</u><br>Volts: <u>NR</u><br>Tungsten Type / Size: <u>EWTh-2 / 1/8</u><br>Heat Input: <u>N/R</u><br>Pulsed Current: <u>None</u>  |   |
| <b>Preheat (QW-406)</b><br>Preheat Temp.: <u>50</u> °F<br>Interpass Temp.: <u>300</u> °F<br>Preheat Maintenance: <u>None</u>  | <b>Technique (QW-410)</b><br>Travel Speed (in/min): <u>NR</u><br>Thermal Processes: <u>(1)No</u><br>String/Weave Bead: <u>Stringer bead</u><br>Oscillation: <u>N/A</u><br>Mult./Single Pass (per side): <u>Multipass</u><br>Mult./Single Electrode: <u>N/A</u><br>Nozzle/Gas Cup Size: <u>6</u> |   |

Additional Welding Parameters

| Layer(s) and/or Pass(es) | Process | Filler Metal       |            | Current         |                | Voltage Range | Travel Speed Range (in/min) |
|--------------------------|---------|--------------------|------------|-----------------|----------------|---------------|-----------------------------|
|                          |         | AWS Classification | Size (in.) | Type / Polarity | Amperage Range |               |                             |
| ALL                      | GTAW    | ER308L             | 1/8        | DCEN (straight) | 180            | NR            | NR                          |

ISTI Plant Services  
Procedure Qualification Record (PQR)

PQR No.: P8-P8-1005-SS

Page: 2 of 2

Tensile Test (QW-150)

| Specimen No. | Width (in.) | Thickness (in.) | Area (in <sup>2</sup> ) | Ultimate Total Load (lb) | Ultimate Stress (PSI) | Failure Type and Location |
|--------------|-------------|-----------------|-------------------------|--------------------------|-----------------------|---------------------------|
| 1            | 0.755       | 1.520           | 1.15                    | 93120                    | 81000                 | Ductile - BM              |
| 2            | 0.753       | 1.523           | 1.15                    | 94050                    | 81800                 | Ductile - BM              |

Guided Bend Test (QW-160)

| Figure Number and Type | Result     | Figure Number and Type | Result     |
|------------------------|------------|------------------------|------------|
| QW-462.2 Side bend     | Acceptable | QW-462.2 Side bend     | Acceptable |
| QW-462.2 Side bend     | Acceptable | QW-462.2 Side bend     | Acceptable |
| None                   |            | None                   |            |

Macro-Examination Test: None  
 Visual Examination: Acceptable  
 Liquid Penetration Test: None  
 Updated to latest ASME format by American Piping Inspection-Metlab 7/12/16

Welder's Name: Jimmy Dick ID: \_\_\_\_\_ Stamp: \_\_\_\_\_

Welding of coupon was witnessed  
 by: ISTI Plant Services

Tests Conducted By: Tulsa Gamma Ray Test ID.: 102124373

We certify that the statements in this record are correct and that the test welds were prepared, welded, and tested in accordance with the requirements of Section IX of the ASME Code.

Approved By:  11/20/2016  
Date



TULSA GAMMA RAY, INC.  
INSPECTION DIVISION  
1127 S. Lewis Avenue Tulsa, OK 74104-3900  
Phone 918-585-3228 Fax 918-584-5598

TEST REPORT

PQR# P8-P8-1005-SS Date 11-20-06  
WPS# 1005  
Lab No. 102124373  
Material SA240-304L Weld Process GTAW ER308L  
Thickness 1.500"

TENSILE TEST (QW-150)

| SPECIMEN NO. | WIDTH | THICKNESS | AREA | ULTIMATE TENSILE LOAD (LB) | ULTIMATE UNIT STRESS (PSI) | TYPE OF FAILURE & LOCATION |
|--------------|-------|-----------|------|----------------------------|----------------------------|----------------------------|
| 1            | 0.755 | 1.520     | 1.15 | 93120                      | 81000                      | Ductile-BM                 |
| 2            | 0.753 | 1.523     | 1.15 | 94050                      | 81800                      | Ductile-BM                 |

GUIDED BEND TESTS (QW-160)

| TYPE AND FIGURE NO. | RESULTS                               |
|---------------------|---------------------------------------|
| 1 SIDE BEND         | NO DEFECT GREATER THAN 1/8". "PASSED" |
| 2 SIDE BEND         | NO DEFECT GREATER THAN 1/8". "PASSED" |
| 3 SIDE BEND         | NO DEFECT GREATER THAN 1/8". "PASSED" |
| 4 SIDE BEND         | NO DEFECT GREATER THAN 1/8". "PASSED" |

Welder Jimmy Dick

ISTI PLANT SERVICES

Client

  
Submitted by John Phillips



American Piping Inspection, Metallurgical Lab  
 18501 E. Admiral Pl. Catoosa, Oklahoma 74015  
 Office: (918) 266-4130

Form: MR-16  
 Established: 10/2/16  
 Revision: 0  
 Date: 10/2/16

Mechanical/Lab Test Report

|                   |                                    |                 |                         |
|-------------------|------------------------------------|-----------------|-------------------------|
| Organization:     | ISTI Plant Services                | Lab Number:     | M170193 Rev. 0          |
| Base Material:    | 1 SA-312 TP304L to 2 SA-312 TP304L | Heat Number:    | N/A                     |
| Coupan Dimension: | 10.750" O.D. x 0.325" Pos. IGR     | Welder Name/ID: | Enid Valenzuela ID: N/A |
| WPS/PQR #:        | 1005                               | Process(es):    | GTAW                    |
| Filler Metal:     | ER308L                             | PWHT:           | N/A                     |

Charpy V-Notch Impact Test

| Specimen Number | Specimen Size (mm) | V-Notch Location | Temperature (°F) | Impact Value (ft/lbs) | Lateral Expansion (mils) | Percent Shear (%) | Average (ft/lbs) |
|-----------------|--------------------|------------------|------------------|-----------------------|--------------------------|-------------------|------------------|
| 1               | 10 x 7.5           | WM               | -325             | 41                    | 0.037                    | 30                | 38.67            |
| 2               | 10 x 7.5           | WM               | -325             | 37                    | 0.043                    | 40                |                  |
| 3               | 10 x 7.5           | WM               | -325             | 38                    | 0.043                    | 20                |                  |
| 4               | 10 x 7.5           | HAZ              | -325             | 67                    | 0.047                    | 40                |                  |
| 5               | 10 x 7.5           | HAZ              | -325             | 70                    | 0.055                    | 40                | 68               |
| 6               | 10 x 7.5           | HAZ              | -325             | 67                    | 0.048                    | 45                |                  |
| N/A             |                    |                  |                  |                       |                          |                   |                  |
| N/A             |                    |                  |                  |                       |                          |                   |                  |
Comments

\*Pipe honed to 0.325" wall thickness by customer.  
 \*Minimum thickness shall be 0.325" when used for Low-Temp. Service.

Other Tests: N/A

All testing performed in accordance with the methods specified in ASME SEC IX

Approved by: Eric Darge

Date: 2/7/2017

Signature:

Title: Certified Associate Welding Inspector

\*Test results relate only to the items tested. This document shall not be reproduced, except in full, without the written approval of American Piping Inspection, Inc. Metallurgical Laboratory.

ISTI Plant Services  
17207 East 21st Street  
Tulsa, OK 74134

Procedure Qualification Record (PQR)

PQR No.: P8-P8-1005-SS-Supplemental WPS No.: 1005 Date: 12/2/2017 Page: 1 of 2

Welding Process(es) / Type(s): GTAW / Manual

|   |  |
|---|--|
| <b>Joints (QW-402)</b><br>Weld Type: <u>Groove weld</u><br><u>Single-V groove</u><br>Backing: <u>Open butt, no back weld</u><br>Root Opening: <u>0.125</u> in. Root Face: <u>0</u> in.<br>Groove Angle: <u>75</u> °   |  |
| <b>Base Metals (QW-403)</b><br>Material Spec., Type or Grade:<br><u>SA-312, TP304L</u> to <u>SA-312, TP304L</u><br>P-No.: <u>8</u> Group No.: <u>1</u> to P-No.: <u>8</u> Group No.: <u>1</u><br>Thickness of Test Coupon (in.): <u>0.432</u><br>Diameter of Test Coupon (in.): <u>6.625</u>  | <b>Postweld Heat Treatment (QW-407)</b><br>Type: <u>No PWHT performed</u><br>Temperature: <u>None</u> °F<br>Time: <u>None</u> hr   |
| <b>Filler Metals (QW-404)</b><br>SFA Specification: <u>5.9</u><br>AWS Classification: <u>ER308L</u><br>Filler Metal Use: <u>Filler Metal Used</u><br>Filler Metal F-No: <u>6</u><br>Weld Metal Analysis A-No: <u>8</u><br>Size of Filler Metal (in.): <u>1/8</u><br>Weld Deposit 'V' (in.): <u>0.432</u><br>Filler Metal Product Form: <u>Bare (Solid)</u><br>Consumable Insert: <u>None</u><br>Flux: <u>None</u> | <b>Gas (QW-408)</b><br>Gas Composition / Flow Rate<br>Shielding: <u>100% Argon / 30 CFH</u><br>Trailing: <u>None</u><br>Backing: <u>100% CO2 / 25 CFH</u>  |
| <b>Positions (QW-405)</b><br>Position of Joint: <u>1GR - Rotated</u><br>Weld Progression: <u>N/A</u>  | <b>Electrical Characteristics (QW-409)</b><br>Current / Polarity: <u>DCEN (straight)</u><br>Amps: <u>180</u><br>Volts: <u>n/r</u><br>Tungsten Type / Size: <u>EWTh-2 / 1/8</u><br>Heat Input: <u>N/R</u><br>Pulsed Current: <u>None</u>  |
| <b>Preheat (QW-406)</b><br>Preheat Temp.: <u>50</u> °F<br>Interpass Temp.: <u>300</u> °F<br>Preheat Maintenance: <u>None</u>  | <b>Technique (QW-410)</b><br>Travel Speed (in/min): <u>n/r</u><br>Thermal Processes: <u>(1)No</u><br>String/Weave Bead: <u>Stringer bead</u><br>Oscillation: <u>N/A</u><br>Mult./Single Pass (per side): <u>Multipass</u><br>Mult./Single Electrode: <u>N/A</u><br>Nozzle/Gas Cup Size: <u>6</u> |

ISTI Plant Services  
Procedure Qualification Record (PQR)

PQR No.: P8-P8-1005-SS-Supplemental

Page: 2 of 2

Hardness Test - Vickers hardness

| Location             | Readings |        |        |        |        |   |   |   |   |
|----------------------|----------|--------|--------|--------|--------|---|---|---|---|
|                      | 1        | 2      | 3      | 4      | 5      | 6 | 7 | 8 | 9 |
| SA-312, TP304L BM#1  | 1-240    | 9-242  |        |        |        |   |   |   |   |
| SA-312, TP304L HAZ#1 | 2-246    | 3-244  | 10-246 | 11-243 | 17-241 |   |   |   |   |
| Weld metal           | 4-241    | 5-243  | 12-248 | 13-247 | 18-245 |   |   |   |   |
| SA-312, TP304L HAZ#2 | 6-247    | 7-243  | 14-246 | 15-243 | 19-237 |   |   |   |   |
| SA-312, TP304L BM#2  | 8-238    | 16-235 |        |        |        |   |   |   |   |

Macro-Examination Test: None

Visual Examination: Acceptable

Liquid Penetration Test: None


Refer to attached mechanical report diagram for individual hardness placement.

Welder's Name: Cardenas, Francisco ID: \_\_\_\_\_ Stamp: V8

Welding of coupon was witnessed  
by: ISTI Plant Services

Tests Conducted By: American Piping Inspection Test ID.: M172124

We certify that the statements in this record are correct and that the test welds were prepared, welded, and tested in accordance with the requirements of Section IX of the ASME Code.

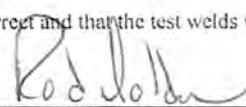Approved By:  12/2/2017  
Date



American Piping Inspection, Metallurgical Lab  
 18501 E. Admiral Pl. Catoosa, Oklahoma 74015  
 Office: (918) 266-4130


Form MR-8  
 Established 10/2/16  
 Revision: 0  
 Date 10/2/16

Mechanical/Lab Test Report

Organization: ISTI Plant Services Lab Number: M172124 Rev.  
 Base Material: 1 SA312-304L to 2 SA312-304L Heat Number: \_\_\_\_\_  
 Coupon Dimension: 6" Sch 80 (.432" WT) Pos. IGR Welder Name/ID: Francisco Cardenas ID. VS  
 WPS/PQR #: 1005 / P8-P8-1005-SS Process(es): GTAW  
 Filler Metal: ER308L PWITT: N/A

Vickers Hardness (HV10) Electrolytic 10% Oxalic Etch

| Indentation Number | Location | Hardness Value | Indentation Number | Location | Hardness Value | Indentation Number | Location | Hardness Value |
|--------------------|----------|----------------|--------------------|----------|----------------|--------------------|----------|----------------|
| 1                  | BM       | 240            | 11                 | HAZ      | 243            | N/A                |          |                |
| 2                  | HAZ      | 246            | 12                 | WM       | 248            | N/A                |          |                |
| 3                  | HAZ      | 244            | 13                 | WM       | 247            | N/A                |          |                |
| 4                  | WM       | 241            | 14                 | HAZ      | 246            | N/A                |          |                |
| 5                  | WM       | 243            | 15                 | HAZ      | 243            | N/A                |          |                |
| 6                  | HAZ      | 247            | 16                 | BM       | 235            | N/A                |          |                |
| 7                  | HAZ      | 243            | 17                 | HAZ      | 241            | N/A                |          |                |
| 8                  | BM       | 238            | 18                 | WM       | 245            | N/A                |          |                |
| 9                  | BM       | 242            | 19                 | HAZ      | 237            | N/A                |          |                |
| 10                 | HAZ      | 246            | N/A                |          |                | N/A                |          |                |
| Average BM:        |          | 238.75         | Average HAZ:       |          | 243.6          | Average WM:        |          | 244.3          |

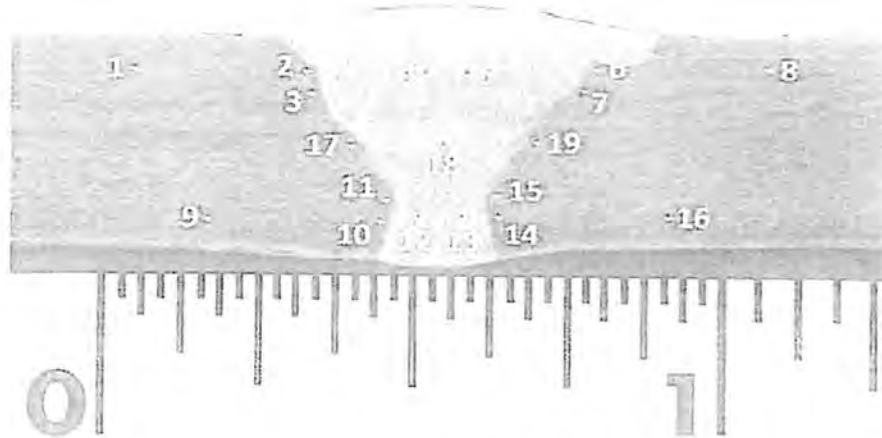

Comments

\_\_\_\_\_

Other Tests: \_\_\_\_\_  
 All testing performed in accordance with the methods specified in NACE MRO175  
 Approved by: Jason Pierce Date: 12/2/2017 Signature: Jason Pierce  
 Title: Laboratory Manager

\* Test results relate only to the items tested. This document shall not be reproduced, except in full, without the written approval of American Piping Inspection, Inc. Metallurgical Laboratory.



IST Plant Services  
17207 East 21st Street  
Tulsa, OK 74134

Welding Procedure Specification (WPS)

WPS No.: 1012 Date: 5/12/2007 Rev.: 1 Date: 6/30/2016 Page: 1 of 2  
By: [Signature] Date Signed: 6/30/2016

Supporting PQR's: PI-PI-1012

Welding Process(es) / Type(s): (1) GTAW / Manual (2) FCAW / Semiautomatic

Joins (QW-402)

Joint Design: Groove and fillet welds

| Joint Type      | Backing              | Root Opening | Groove Angle | Root Face | Groove Radius |
|-----------------|----------------------|--------------|--------------|-----------|---------------|
| Single-V groove | No backing           | 3/16" max    | 50 deg min   | 1/8" max  | -             |
| Single bevel    | No backing           | 3/16" max    | 45 deg min   | 1/8" max  | -             |
| Single-V groove | Gouged & back welded | 1/4" max     | 50 deg min   | 3/16" max | -             |
| Double bevel    | Gouged & back welded | 1/4" max     | 45 deg min   | 3/16" max | -             |
| Double-V groove | Gouged & back welded | 1/4" max     | 45 deg min   | 3/16" max | -             |
| Square groove   | T-joint              | 1/32" max    | -            | -         | -             |
| Square groove   | No backing           | 3/32" max    | -            | -         | -             |

Fillet Welds: All fillet sizes on all base metal thicknesses and all diameters.

Retainers: None

SEE ENGINEERING DRAWINGS FOR MISALIGNMENT TOLERANCES. INTERNAL MISALIGNMENT TO BE 1/4" OF WALL THICKNESS, NOT TO EXCEED 1/8" MAX.

WELD JOINT DESCRIPTIONS SHOWN ARE NOT INCLUSIVE OF ALL THOSE FOUND ON A JOB. WELD JOINT DESIGN REFERENCE IN AN ENGINEERING SPECIFICATION OR A DESIGN DRAWING SHALL TAKE PRECEDENCE OVER WELD JOINTS SHOWN IN THIS WPS.

Base Metals (QW-403)

P-No.: 1 Group No.: 1 Thickness Range (in.): 0.432 to 0.8640  
to P-No.: 1 Group No.: 1

Filler Metals (QW-404)

Spec. No. (SFA): (1) 5.18 (2) 5.20

AWS No. (Class): (1) ER70S-6 (2) E71T-12M

Filler Metal Use: (1) Filler Metal Used

F No.: (1 & 2) 6

A No.: (1) (verify chemistry) (2) 1

Weld Metal Thickness Range: (1) 0.3750 in. maximum (2) 0.4890 in. maximum No Pass Greater Than 1/2" Allowed

Flux Type: N/A

Flux Trade Name: N/A

Consumable Insert: (1) None

Other: \_\_\_\_\_

Flux: (1) None

Product Form: (1) Bare (Solid) (2) Flux cored

Trade Name: (2) Kobelco Frontarc-711

Supplemental Filler Metal: (2) None

Strip Thickness or Width (in.): N/A

ISTI Plant Services

Welding Procedure Specification (WPS)

WPS No.: 1012 Date: 5/12/2007 Rev.: I Date: 6/30/2016 Page: 2 of 2

|   |  |
|---|--|
| <p><b>Positions (QW-405)</b><br/>                 Position of Joint: <u>(1 &amp; 2) All Positions</u><br/>                 Weld Progression: <u>(1 &amp; 2) Vertical up</u></p> <p><b>Preheat (QW-406)</b><br/>                 Preheat Temp. Min.: <u>70</u> °F<br/>                 Interpass Temp. Max.: <u>550</u> °F<br/>                 Preheat Maintenance: <u>None</u><br/>                 When Base Metal is &lt; 50°F, preheat to 150°F minimum<br/>                 200°F for Base Metal 1-1/4" to 1-1/2"</p>  | <p><b>Postweld Heat Treatment (QW-407)</b><br/>                 Type: <u>No PWHT will be performed</u><br/>                 Temperature Range: <u>None</u> °F<br/>                 Time Range: <u>None</u></p> <p><b>Gas (QW-408)</b><br/>                 Gas Composition / Flow Rate<br/>                 Shielding: <u>(1) 100% Argon / 23-30 CFH</u><br/> <u>(2) 75% Argon, 25% CO2 / 32-42 CFH</u><br/>                 Trailing: <u>(1 &amp; 2) None</u><br/>                 Backing: <u>(1 &amp; 2) None</u></p> |
| <p><b>Electrical Characteristics (QW-409)</b><br/>                 Current Type / Polarity: <u>(1 &amp; 2) DCEP (reverse)</u><br/>                 Pulsed Current: <u>(1) None</u><br/>                 Tungsten Electrode Type and Size: <u>(1) EWTh-2 / 3/32 (2) N/A</u><br/>                 Mode of Metal Transfer for GMAW(FCAW): <u>(1) N/A (2) Globular arc</u><br/>                 Max. Heat Input (J/in): <u>(1) 48280 (2) 30360</u></p>  |  |
| <p><b>Technique (QW-410)</b><br/>                 Thermal Processes: <u>(1 &amp; 2) -</u><br/>                 String or Weave Bead: <u>(1 &amp; 2) Stringer and weave bead</u><br/>                 Orifice or Gas Cup Size: <u>(1) #5 to #10 (2) 3/8" to 5/8"</u><br/>                 Initial and Interpass Cleaning: <u>With wire brush clean 1 inch (25 mm) on both sides of weld joint</u><br/>                 Method of Back Gouging: <u>When required, grind until all defects are removed.</u><br/>                 Oscillation: <u>N/A</u><br/>                 Contact Tube to Work Distance: <u>(2) N/A</u><br/>                 Single or Multiple Passes (per side): <u>(1) Multipass (2) Multipass</u><br/>                 Single or Multiple Electrodes: <u>N/A</u><br/>                 Peening: <u>(1 &amp; 2) None</u></p> |  |
| <p>(1) GTAW Chemistry verified by manufacturer's typical Material Test Report (MTR).<br/>                 GTAW Bead Width limited to 4.5x rod diameter.<br/>                 No Autogenous Welding allowed</p>  |  |

Process Welding Parameters

| Weld Layer(s) and/or Pass(es) | Process | Filler Metal |                | Current         |                | Voltage Range | Travel Speed Range (in/min) |
|-------------------------------|---------|--------------|----------------|-----------------|----------------|---------------|-----------------------------|
|                               |         | Class        | Diameter (in.) | Type / Polarity | Amperage Range |               |                             |
| Any                           | GTAW    | ER70S-6      | 1/8            | DCEP (reverse)  | 100-142        | 14-17         | 3-6                         |
| Any                           | FCAW    | E71T-12M     | 0.045          | DCEP (reverse)  | 90-110         | 20-23         | 5-7                         |

Notes

\*Rev. I 6/30/16: Corrected A-No. Designation, Clarified FCAW Type, and adjusted GTAW/FCAW parameters, added "No single weld pass greater than 1/2"" note, added "No Autogenous Welding allowed" note, added GTAW bead width note, added B31.3 misalignment tolerance note and Preheat note, added GTAW Chemistry verified note, added "Kobelco Frontarc-711" to filler metals



ISTI Plant Services  
Procedure Qualification Record (PQR)

PQR No.: P1-P1-1012

Page: 2 of 2

Tensile Test (QW-150)

| Specimen No. | Width (in.) | Thickness (in.) | Area (in <sup>2</sup> ) | Ultimate Total Load (lb) | Ultimate Stress (PSI) | Failure Type and Location |
|--------------|-------------|-----------------|-------------------------|--------------------------|-----------------------|---------------------------|
| 1            | 0.506       | 0.419           | 0.2120                  | 13570                    | 64006                 | Ductile - BM              |
| 2            | 0.517       | 0.426           | 0.2202                  | 14380                    | 65292                 | Ductile - BM              |

Guided Bend Test (QW-160)

| Figure Number and Type | Result | Figure Number and Type | Result |
|------------------------|--------|------------------------|--------|
| QW-462.3(a) Face bend  | Passed | QW-462.3(a) Root bend  | Passed |
| QW-462.3(a) Face bend  | Passed | QW-462.3(a) Root bend  | Passed |
| None                   |        | None                   |        |

Toughness Test (QW-170)

| Specimen Number | Notch Location | Notch Type | Test Temp. (°F) | Impact Value (ft-lb) | Lateral Expansion |      | Drop Weight Break |
|-----------------|----------------|------------|-----------------|----------------------|-------------------|------|-------------------|
|                 |                |            |                 |                      | Shear %           | Mils |                   |
| 1               | Base metal     | "V"        | -40             | 21                   | 10                | 18   | Yes               |
| 2               | Base metal     | "V"        | -40             | 16                   | 10                | 15   | Yes               |
| 3               | Base metal     | "V"        | -40             | 18                   | 10                | 17   | Yes               |
| 4               | Weld metal     | "V"        | -40             | 34                   | 20                | 36   | Yes               |
| 5               | Weld metal     | "V"        | -40             | 20                   | 10                | 21   | Yes               |
| 6               | Weld metal     | "V"        | -40             | 17                   | 10                | 20   | Yes               |
| 7               | HAZ            | "V"        | -40             | 129                  | 40                | 76   | Yes               |
| 8               | HAZ            | "V"        | -40             | 124                  | 40                | 87   | Yes               |
| 9               | HAZ            | "V"        | -40             | 138                  | 40                | 79   | Yes               |
| 1.              | Weld metal     | "V"        | -50             | 18                   | 30                | 8    | No                |
| 2.              | Weld metal     | "V"        | -50             | 24                   | 20                | 10   | No                |
| 3.              | Weld metal     | "V"        | -50             | 25                   | 30                | 20   | No                |
| 4.              | HAZ            | "V"        | -50             | 45                   | 35                | 30   | No                |
| 5.              | HAZ            | "V"        | -50             | 10                   | 10                | 8    | No                |
| 6.              | HAZ            | "V"        | -50             | 80                   | 30                | 54   | No                |

(2/7/2017): Added -50F CVN Impacts to PQR – Lab #M170192 Welder: Eduardo Rubalcaba

Welder's Name: Raul Meza ID: \_\_\_\_\_ Stamp: \_\_\_\_\_


Welding of coupon was witnessed

by: \_\_\_\_\_ ISTI Plant Services

Tests Conducted By: Tulsa Gamma Ray, Inc.

Test ID.: 102125172

We certify that the statements in this record are correct and that the test welds were prepared, welded, and tested in accordance with the requirements of Section IX of the ASME Code.

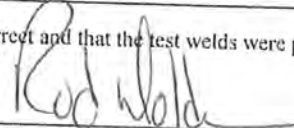Approved By:  5/22/2007  
Date

# TULSA GAMMA RAY, INC.

1127 S Lewis Ave Tulsa, OK 74104  
918.585.3228

## MECHANICAL TEST REPORT

Welder Qualification     Weld Procedure Evaluation  
**Organization** ISTI plant Services    **LAB #** 102125172  
**Base Metal Type** SA333 gr. 6    **PWHT** NONE  
**Coupon Thickness** 6" S/80 (6.625" x .432" wall)  
**WPS No.** 1012    **Weld Process** GTAW/FCAW  
**Welder's Name** Raul Meza    **ID#**

| Specimen Number | Bend Type | BENDS                   |        |
|-----------------|-----------|-------------------------|--------|
|                 |           | Results/Comments        |        |
| 1               | Root Bend | No Relevant Indications | PASSED |
| 1               | Face Bend | No Relevant Indications | PASSED |
| 3               | Root Bend | No Relevant Indications | PASSED |
| 4               | Face Bend | No Relevant Indications | PASSED |

| Specimen Number | Specimen Size   | Specimen Area sq. in. | TENSILE TESTS       |                      | Failure Type & Break Location |
|-----------------|-----------------|-----------------------|---------------------|----------------------|-------------------------------|
|                 |                 |                       | Load at Failure PSI | Ultimate Tensile PSI |                               |
| 1               | 0.506" x 0.419" | 0.2120                | 13570               | 64006                | Ductile - Base Metal          |
| 2               | 0.517" x 0.426" | 0.2202                | 14380               | 65292                | Ductile - Base Metal          |
| 3               | N/A             | N/A                   | N/A                 | N/A                  | N/A                           |
| 4               | N/A             | N/A                   | N/A                 | N/A                  | N/A                           |

| 1   | Material 1         |     |     | HARDNESS IN BHN |     |     | Weld Metal |     |     |
|-----|--------------------|-----|-----|-----------------|-----|-----|------------|-----|-----|
|     | Heat Affected Zone |     |     | 1               | 2   | 3   | 1          | 2   | 3   |
| N/A | N/A                | N/A | N/A | N/A             | N/A | N/A | N/A        | N/A | N/A |

| Specimen Number | Notch Type | Notch Location | Specimen Size | Temp. °F | CHARPY V-NOTCH IMPACT TESTING |                           |      | Drop Weight Break |
|-----------------|------------|----------------|---------------|----------|-------------------------------|---------------------------|------|-------------------|
|                 |            |                |               |          | Value Ft./Lbs.                | Lateral Expansion Shear % | Mils |                   |
| 1               | "V"        | BM             | 10mm x 10mm   | -40      | 21                            | 10                        | 18   | Yes               |
| 2               | "V"        | BM             | 10mm x 10mm   | -40      | 16                            | 10                        | 15   | Yes               |
| 3               | "V"        | BM             | 10mm x 10mm   | -40      | 18                            | 10                        | 17   | Yes               |
| 4               | "V"        | WM             | 10mm x 10mm   | -40      | 34                            | 20                        | 36   | Yes               |
| 5               | "V"        | WM             | 10mm x 10mm   | -40      | 20                            | 10                        | 21   | Yes               |
| 6               | "V"        | WM             | 10mm x 10mm   | -40      | 17                            | 10                        | 20   | Yes               |
| 7               | "V"        | HAZ            | 10mm x 10mm   | -40      | 129                           | 40                        | 76   | Yes               |
| 8               | "V"        | HAZ            | 10mm x 10mm   | -40      | 124                           | 40                        | 87   | Yes               |
| 9               | "V"        | HAZ            | 10mm x 10mm   | -40      | 138                           | 40                        | 79   | Yes               |

Other Tests Performed: NONE

All tests performed in accordance to methods specified in ASME SA-370 & ASTM Sec. IX.

Signature John Phillips

Date 5-22-07



American Piping Inspection, Metallurgical Lab  
 18501 E. Admiral Pl. Catoosa, Oklahoma 74015  
 Office: (918) 266-4130

Form: MR-16  
 Established: 10/2/16  
 Revision: 0  
 Date: 10/2/16

### Mechanical/Lab Test Report

Organization: ISTI Plant Services Lab Number: MI70192 Rev. 0  
 Base Material: 1 SA-333 GR6 to 2 SA-333 GR6 Heat Number: 951029  
 Coupon Dimension: 6.625" O.D. x 0.432" Pos. IGR Welder Name/ID: Eduardo Rubalcaba ID. N/A  
 WPS/PQR #: 1012 Process(es): GTAW/FCAW  
 Filler Metal: ER70S-6/E71T-12MJ PWHT: N/A

### Charpy V-Notch Impact Test

| Specimen Number | Specimen Size (mm) | V-Notch Location | Temperature (°F) | Impact Value (ft/lbs) | Lateral Expansion (mils) | Percent Shear (%) | Average (ft/lbs) |
|-----------------|--------------------|------------------|------------------|-----------------------|--------------------------|-------------------|------------------|
| 1               | 10 x 10            | WM               | -50              | 18                    | 0.008                    | 30                | 22.33            |
| 2               | 10 x 10            | WM               | -50              | 24                    | 0.010                    | 20                |                  |
| 3               | 10 x 10            | WM               | -50              | 25                    | 0.020                    | 30                |                  |
| 4               | 10 x 10            | HAZ              | -50              | 45                    | 0.030                    | 35                | 45               |
| 5               | 10 x 10            | HAZ              | -50              | 10                    | 0.008                    | 10                |                  |
| 6               | 10 x 10            | HAZ              | -50              | 80                    | 0.054                    | 30                |                  |
| N/A             |                    |                  |                  |                       |                          |                   |                  |
| N/A             |                    |                  |                  |                       |                          |                   |                  |
### Comments

Only one side of the HAZ tested since both base metals were the same Heat Number.

Other Tests: N/A  
 Approved by: Eric Darge Date: 2/7/2017 Signature: [Signature]  
 Title: Certified Associate Welding Inspector

\*Test results relate only to the items tested. This document shall not be reproduced, except in full, without the written approval of American Piping Inspection, Inc. Metallurgical Laboratory.

# ISTI Plant Services

Tulsa, Ok.

QW-482 SUGGESTED FORMAT FOR WELDING PROCEDURE SPECIFICATIONS (WPS)  
(See QW-200.1, Section IX, ASME Boiler and Pressure Vessel Code)

|  |   |
|--|---|
| Company Name <u>ISTI Plant Services</u>  | Approved by / Date <u><i>R. J. [Signature]</i> 11-17-2014</u>                   |
| WPS No: <u>1025</u> Date <u>11-17-2014</u>   | Supporting PQR No. (s) <u>P1-P1-1025a, P1-P1-1025b</u>                          |
| Revision No. <u>0</u> Date of Rev. <u>---</u>  |   |
| Welding Process(es) <u>GTAW</u>  | Type <u>Manual</u><br><small>(Automatic, Manual, Machine, or Semi-Auto)</small> |
| <b>JOINTS (QW-402)</b>   |   |
| Joint Design <u>All Allowable ASME Joint Configurations</u>  | <p>Details</p>  |
| Root Spacing _____   |   |
| Backing <u>WITH OR WITHOUT</u>   |   |
| Backing Material (Type) <u>PER CUSTOMER REQUIREMENT</u><br><small>Refer to both backing and retainers</small>  |   |
| <input type="checkbox"/> Metal <input type="checkbox"/> Nonfusing Metal<br><input type="checkbox"/> Nonmetallic <input type="checkbox"/> Other   |   |
| <p>Sketches, Production Drawings, Weld Symbols or Written Description should show the general arrangement of the parts to be welded. Where applicable, the root spacing and the details of weld groove may be specified.<br/>(At the option of the Mfr. / sketches may be attached to illustrate joint design, weld layers and bead sequence, e.g., for notch toughness procedures, for multiple process procedures, etc.)</p> <p style="text-align: right;">V, J or U bevel grooves, Fillets or other joints detailed on engineering drawings, production routing or repair procedures.</p> |   |
| <b>*BASE METALS (QW-403)</b>   |   |
| P-No. <u>1</u> Group No. <u>1 or 2</u>   | to P-No. <u>1</u> Group No. <u>1 or 2</u>                                       |
| OR   |   |
| Specification type and grade _____   |   |
| OR   |   |
| Chem. Analysis and Mech. Prop _____  |   |
| To Chem. Analysis and Mech. Prop _____   |   |
| Thickness Range: _____   |   |
| Base Metal: Groove <u>0.125" to 1.250"</u>   | Fillet <u>UNLIMITED</u>   |
| Pipe Dia.: Range Groove <u>UNLIMITED</u>   | Fillet <u>UNLIMITED</u>   |
| Maximum Pass Thickness $\leq 1/2$ in. (13mm) <input checked="" type="checkbox"/> Yes <input type="checkbox"/> No   |   |
| Other _____  | This procedure is qualified for low temperature service to -50°F                |
| <b>*FILLER METALS (QW-404)</b>   |   |
| Spec. No. (SFA) _____  | 1      2  |
| AWS No. (Class) _____  | 5.13  |
| F-No. _____  | ER70S-6 Verify Chemistry  |
| A-No. _____  | 6   |
| Size of Filler Metals _____  | 1 Verification confirmed by OEM Documentation                                   |
| Filler Metal Product Form _____  | 3/32", 1/8"   |
| Supplemental Filler Metal _____  | Solid   |
| Weld Metal _____   | None  |
| Deposited Thickness: _____   |   |
| Groove _____   | 0.125" to 1.250"  |
| Fillet _____   | Unlimited   |
| Electrode-Flux (Class) _____   | N.A.  |
| Flux Type _____  | No flux added to face of weld   |
| Flux Trade Name _____  | N.A.  |
| Consumable Insert _____  | None  |
| Other _____  |   |

\*Each base metal-filler metal combination should be recorded individually

**ISTI Plant Services**  
Tulsa, Ok.

WPS No. 1025 Rev. 0

|                           |  |   |   |
|---------------------------|--|---|---|
| <b>POSITIONS (QW-405)</b> |  | <b>POSTWELD HEAT TREATMENT (QW-407)</b> |   |
| Position of Groove        | ALL  | Temp Range                              | No PWHT Performed                                     |
| Welding Progression:      | <input checked="" type="checkbox"/> Up <input type="checkbox"/> Down | Time Range                              |   |
| Position(s) of Fillet     | ALL  | Other                                   | B31.3 Requires thickness greater than 3/4" to be PWHT |

|   |   |                     |           |           |
|---|---|---------------------|-----------|-----------|
| <b>PREHEAT (QW-406)</b>   |   | <b>GAS (QW-408)</b> |           |           |
| Preheat Temp. Min.  | 75°F Min. / 200°F for thickness of 1/4" to 1 1/2" | Percent Composition |           |           |
| Interpass Temp. Max.  | 450°F   | Gas(es)             | % Mixture | Flow Rate |
| Preheat Maintenance   | None  | Argon               | 100       | 20-35 CFH |
| Other   | N.A.  |                     |           |           |
| (Comments or special heating where applicable should be recorded) |   |                     |           |           |

| <b>ELECTRICAL CHARACTERISTICS (QW-409)</b> |         |                |          |                         |              |                         |                         |               |                      |                          |
|--|---------|----------------|----------|-------------------------|--------------|-------------------------|-------------------------|---------------|----------------------|--------------------------|
| Weld Layers                                | Process | Classification | Diameter | Current Type & Polarity | Amps (Range) | Wire Feed Speed (Range) | Energy or Power (Range) | Volts (Range) | Travel Speed (Range) | Other, Remarks, Addition |
| Any  | GTAW    | ER70S-6        | 3/32"    | DCEN                    | 130-160      | N.A.                    | N.A.                    | 15-19         | 5-8 ipm              |                          |
| Any  | GTAW    | ER70S-6        | 1/8"     | DCEN                    | 140-170      | N.A.                    | N.A.                    | 16-20         | 6-9 ipm              |                          |
|  |         |                |          |                         |              |                         |                         |               |                      |                          |
|  |         |                |          |                         |              |                         |                         |               |                      |                          |
Amps and volts, or power or energy range should be recorded for each electrode size, position and thickness, etc.

Pulsing Current No Pulsing Current Used Heat Input (max.) 24000 J/in Max with 3/32" 23314 J/in Max with 1/8"  
 Amperage/voltage may be decreased or travel speed increased to maintain maximum heat input  
 (Heat Input is a Nonessential Variable unless used for low temperature service.)

Tungsten Electrode Type and Size EWTH-2 3/32", 1/8"  
[Pure Tungsten, 2% Thoriated, etc.]

Mode of Metal Transfer for GMAW (FCAW) N.A.  
[Spray arc, short circuiting arc, etc.]

Other \_\_\_\_\_


|   |   |
|---|---|
| <b>TECHNIQUE (QW-410)</b>                                 |   |
| String or Weave Bead                                      | Stringer or Weave                                   |
| Orifice, Nozzle or Gas Cup Size                           | #5 to #10   |
| Initial and Interpass Cleaning (Brushing, Grinding, etc.) | Grinding or wire brush as required                  |
| Method of Back Gouging                                    | When required, grind until all defects are removed. |
| Oscillation   | N.A.  |
| Contact Tube to Work Distance                             | N.A.  |
| Multiple or Single (per side)                             | Multiple  |
| Multiple or Single Electrodes                             | Single  |
| Electrode Spacing   | N.A.  |
| Peening   | None Allowed  |
| Misalignment  | Misalignment shall not be greater than 1/4T         |

ISTI Plant Services  
Tulsa,  
Oklahoma

Procedure Qualification Record (PQR)

PQR No.: PI-PI-1025a WPS No.: 1025 Date: 11/17/2014 Page: 1 of 2

Welding Process(es) / Type(s): GTAW / Manual
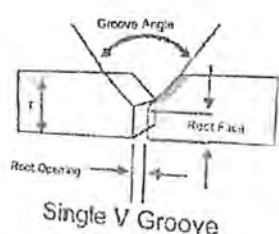
|   |  |   |
|---|--|---|
| <p><b>Joints (QW-402)</b></p> <p>Weld Type: <u>                    </u> <u>                    </u><br/> <u>                    </u> <u>                    </u><br/> <u>                    </u> <u>                    </u></p> <p>Backing: <u>                    </u> <u>                    </u><br/> <u>                    </u> <u>                    </u></p> <p>Root Opening: <u>0.125</u> in. Root Face: <u>0.0</u> in.</p> <p>Groove Angle: <u>75</u> °</p> |  |  <p>Single V Groove</p>   |
| <p><b>Base Metals (QW-403)</b></p> <p>Material Spec., Type or Grade:<br/> <u>SA-516-60/65/70</u> to <u>SA-516-60/65/70</u></p> <p>P-No.: <u>1</u> Group No.: <u>1</u> to P-No.: <u>1</u> Group No.: <u>2</u></p> <p>Thickness of Test Coupon (in.): <u>0.250</u></p> <p>Test Coupon certified to SA-516-60/65/70</p>  |  | <p><b>Postweld Heat Treatment (QW-407)</b></p> <p>Type: <u>                    </u> <u>                    </u><br/> <u>                    </u> <u>                    </u></p> <p>Temperature: <u>                    </u> °F</p> <p>Time: <u>                    </u> hr</p>   |
| <p><b>Filler Metals (QW-404)</b></p> <p>SFA Specification: <u>5.18</u></p> <p>AWS Classification: <u>ER70S-6</u></p> <p>Filler Metal F-No: <u>6</u></p> <p>Weld Metal Analysis A-No: <u>(verify chemistry)</u></p> <p>Size of Filler Metal (in.): <u>3/32</u></p> <p>Weld Deposit 't' (in.): <u>0.250</u></p> <p>Filler Metal Product Form: <u>Bare (Solid)</u></p> <p>Consumable Insert: <u>None</u></p> <p>Flux: <u>None Added</u></p>                                |  | <p><b>Gas (QW-408)</b></p> <p style="text-align: center;">Gas Composition / Flow Rate</p> <p>Shielding: <u>100% Argon / 25 CFH</u></p> <p>Trailing: <u>None</u></p> <p>Backing: <u>None</u></p>   |
| <p><b>Positions (QW-405)</b></p> <p>Position of Joint: <u>3G - Vertical</u></p> <p>Weld Progression: <u>Vertical up</u></p>   |  | <p><b>Electrical Characteristics (QW-409)</b></p> <p>Current / Polarity: <u>DCEN (straight)</u></p> <p>Amps: <u>150</u></p> <p>Volts: <u>17</u></p> <p>Tungsten Type / Size: <u>EWTh-2 / 3/32"</u></p> <p>Heat Input: <u>24000 J/in</u></p> <p>Pulsed Current: <u>No Pulsed Current</u></p>                                     |
| <p><b>Preheat (QW-406)</b></p> <p>Preheat Temp.: <u>75</u> °F</p> <p>Interpass Temp.: <u>450</u> °F</p> <p>Preheat Maintenance: <u>None</u></p>   |  | <p><b>Technique (QW-410)</b></p> <p>Travel Speed (in/min): <u>6</u></p> <p>Thermal Processes: <u>No</u></p> <p>String/Weave Bead: <u>Stringer bead</u></p> <p>Oscillation: <u>N/A</u></p> <p>Multi/Single Pass (per side): <u>Multi-pass</u></p> <p>Multi/Single Electrode: <u>N/A</u></p> <p>Nozzle/Gas Cup Size: <u>5</u></p> |
| <p>(1) Single Electrode</p>   |  |   |

Additional Welding Parameters

| Layer(s) and/or Pass(es) | Process | Filler Metal       |            | Current         |                | Voltage Range | Travel Speed Range (in/min) |
|--------------------------|---------|--------------------|------------|-----------------|----------------|---------------|-----------------------------|
|                          |         | AWS Classification | Size (in.) | Type / Polarity | Amperage Range |               |                             |
| All                      | GTAW    | ER70S-6            | 3/32       | DCEN (straight) | 150            | 15            | 6                           |

ISTI Plant Services  
Procedure Qualification Record (PQR)

PQR No.: P1-P1-1025a

Page: 2 of 2

Tensile Test (QW-150)

| Specimen No. | Width (in.) | Thickness (in.) | Area (in <sup>2</sup> ) | Ultimate Total Load (lb) | Ultimate Stress (PSI) | Failure Type and Location |
|--------------|-------------|-----------------|-------------------------|--------------------------|-----------------------|---------------------------|
| 1            | 0.750       | 0.202           | 0.152                   | 12263                    | 80700                 | Ductile - BM              |
| 2            | 0.750       | 0.208           | 0.156                   | 12705                    | 81400                 | Ductile - BM              |

Guided Bend Test (QW-160)

| Figure Number and Type | Result     | Figure Number and Type | Result     |
|------------------------|------------|------------------------|------------|
| QW-462.3(a) Face bend  | Acceptable | QW-462.3(a) Root bend  | Acceptable |
| QW-462.3(a) Face bend  | Acceptable | QW-462.3(a) Root bend  | Acceptable |
| None                   |            | None                   |            |

Toughness Test (QW-170)

| Specimen Number | Notch Location | Notch Type | Test Temp. (°F) | Impact Value (ft-lb) | Lateral Expansion |      | Drop Weight Break |
|-----------------|----------------|------------|-----------------|----------------------|-------------------|------|-------------------|
|                 |                |            |                 |                      | Shear %           | Mils |                   |
| 1               | Weld metal     | "V"        | -67             | 14                   | 25                | 23   | No                |
| 2               | Weld metal     | "V"        | -67             | 15                   | 30                | 23   | No                |
| 3               | Weld metal     | "V"        | -67             | 17                   | 30                | 25   | No                |
| 4               | HAZ            | "V"        | -67             | 20                   | 30                | 34   | No                |
| 5               | HAZ            | "V"        | -67             | 20                   | 30                | 36   | No                |
| 6               | HAZ            | "V"        | -67             | 19                   | 30                | 39   | No                |

Hardness Test - Vickers hardness

| Location                   | Readings |        |        |        |        |        |        |        |   |
|----------------------------|----------|--------|--------|--------|--------|--------|--------|--------|---|
|                            | 1        | 2      | 3      | 4      | 5      | 6      | 7      | 8      | 9 |
| SA-516-60/65/70 BM-1 Root  | 17-170   | 18-171 | 19-171 | 20-173 |        |        |        |        |   |
| SA-516-60/65/70 BM-1 Top   | 1-170    | 2-183  | 3-183  | 4-197  |        |        |        |        |   |
| SA-516-60/65/70 BM-2 Root  | 29-166   | 30-165 | 31-161 | 32-163 |        |        |        |        |   |
| SA-516-60/65/70 BM-2 Top   | 13-170   | 14-158 | 15-162 | 16-161 |        |        |        |        |   |
| SA-516-60/65/70 HAZ-1 Root | 21-172   | 22-165 |        |        |        |        |        |        |   |
| SA-516-60/65/70 HAZ-1 Top  | 5-197    | 6-192  |        |        |        |        |        |        |   |
| SA-516-60/65/70 HAZ-2 Root | 27-175   | 28-170 |        |        |        |        |        |        |   |
| SA-516-60/65/70 HAZ-2 Top  | 11-188   | 12-173 |        |        |        |        |        |        |   |
| Weld metal                 | 7-189    | 8-191  | 9-193  | 10-191 | 23-152 | 24-151 | 25-158 | 26-160 |   |

Macro-Examination Test: None

Visual Examination: Acceptable

Liquid Penetration Test: None

Vickers hardness in accordance with NACE SP0472-2010 Figure 2 and 3  
Charpy V Notch Specimen Size: 10mm x 5.0mm

Welder's Name: Eulid Vazquez

ID: \_\_\_\_\_

Stamp: \_\_\_\_\_

PQR was done and welding of

coupon was witnessed by:

ISTI Plant Services

Tests Conducted By: Tulsa Gamma Ray, Inc.

Test ID.: 10213328

We certify that the statements in this record are correct and that the test welds were prepared, welded, and tested in accordance with the requirements of Section IX of the ASME Code.

Prepared By: \_\_\_\_\_

*John Phillips*

11/17/14  
Date

Procedure Specialist

Accepted By: \_\_\_\_\_

*Kodol*

11/17/14  
Date

QC Manager



# TULSA GAMMA RAY, INC.

1127 S Lewis Ave Tulsa, OK 74104  
918.585.3228

## LAB / MECHANICAL TEST REPORT

Welder Qualification  Weld Procedure Evaluation

|                  |                     |          |             |
|------------------|---------------------|----------|-------------|
| Organization     | ISTI Plant Services | LAB #    | 102135828   |
| Base Metal Type  | SA516-60/65/70      | PWHT     | None        |
| Coupon Thickness | 0.250"              | PQR#     | P1-P1-1025a |
| WPS No.          | 1025                | Filler   | ER70S-6     |
| Weld Process     | GTAW                | ID#      |             |
| Welder's Name    | Eulid Valezquez     | Position | 3G-Up       |

### BENDS

| Specimen Number | Type of Bend | Results/Comments                                 |
|-----------------|--------------|--|
| 1               | FACE BEND #1 | PASSED No Relevant Indications Greater Than 1/8" |
| 2               | FACE BEND #2 | PASSED No Relevant Indications Greater Than 1/8" |
| 3               | ROOT BEND #1 | PASSED No Relevant Indications Greater Than 1/8" |
| 4               | ROOT BEND #2 | PASSED No Relevant Indications Greater Than 1/8" |

### TENSILE TESTS

| Specimen Number | Specimen Size   | Specimen Area sq. in. | Load at Failure (lbs.) | Ultimate Tensile (psi) | Type of Failure & Location |
|-----------------|-----------------|-----------------------|------------------------|------------------------|----------------------------|
| 1               | 0.750" X 0.202" | 0.152                 | 12263                  | 80700                  | Ductile-BM                 |
| 2               | 0.750" X 0.208" | 0.156                 | 12705                  | 81400                  | Ductile-BM                 |

### HARDNESS IN BHN

| Base Material #1      |     |     | Heat Affected Zone #1 |     |     | Weld Metal |     |     |
|-----------------------|-----|-----|-----------------------|-----|-----|------------|-----|-----|
| 1                     | 2   | 3   | 1                     | 2   | 3   | 1          | 2   | 3   |
| N/A                   | N/A | N/A | N/A                   | N/A | N/A | N/A        | N/A | N/A |
| Heat Affected Zone #2 |     |     | Base Material #2      |     |     |            |     |     |
| 1                     | 2   | 3   | 1                     | 2   | 3   |            |     |     |
| N/A                   | N/A | N/A | N/A                   | N/A | N/A |            |     |     |

### CHARPY V-NOTCH IMPACT TESTING

| Specimen Number | Specimen Type/Location | Specimen Size | Temp. | Value Ft./Lbs. | Lateral Expansion | Percent Shear | Drop Weight/Break |
|-----------------|------------------------|---------------|-------|----------------|-------------------|---------------|-------------------|
| 1               | V/Weld Metal           | 10mm x 5.0mm  | -67°F | 14             | 25                | 23            | No                |
| 2               | V/Weld Metal           | 10mm x 5.0mm  | -67°F | 17             | 30                | 23            | No                |
| 3               | V/Weld Metal           | 10mm x 5.0mm  | -67°F | 15             | 30                | 25            | No                |
| 4               | V/HAZ                  | 10mm x 5.0mm  | -67°F | 20             | 30                | 34            | No                |
| 5               | V/HAZ                  | 10mm x 5.0mm  | -67°F | 20             | 30                | 36            | No                |
| 6               | V/HAZ                  | 10mm x 5.0mm  | -67°F | 19             | 30                | 39            | No                |

Other Tests Performed: NONE

All tests performed in accordance to methods specified in ASME B31.3 & SEC IX.

Signature: John Phillips *John Phillips* Date: 11-17-2014



# TULSA GAMMA RAY, INC.

1127 S Lewis Ave Tulsa, OK 74104  
918.585.3228

## LAB / MECHANICAL TEST REPORT


Welder Qualification     Weld Procedure Evaluation

|                  |                     |          |             |
|------------------|---------------------|----------|-------------|
| Organization     | ISTI Plant Services | LAB #    | 102135828   |
| Base Metal Type  | SA516-60/65/70      | PWHT     | None        |
| Coupon Thickness | 0.250"              | PQR#     | P1-P1-1025a |
| WPS No.          | 1025                | Filler   | ER70S-6     |
| Weld Process     | GTAW                | ID#      |             |
| Welder's Name    | Eulid Valezquez     | Position | 3G-Up       |

### Microhardness Survey ASTM E384-11 NACE SP0472-2010, Figure 2 and 3

| Reading Number | HIV Value | Reading Number | HIV Value |
|----------------|-----------|----------------|-----------|
| 1              | 170       | 17             | 170       |
| 2              | 183       | 18             | 171       |
| 3              | 188       | 19             | 171       |
| 4              | 197       | 20             | 173       |
| 5              | 197       | 21             | 172       |
| 6              | 192       | 22             | 165       |
| 7              | 189       | 23             | 152       |
| 8              | 191       | 24             | 151       |
| 9              | 193       | 25             | 158       |
| 10             | 191       | 26             | 160       |
| 11             | 188       | 27             | 175       |
| 12             | 173       | 28             | 170       |
| 13             | 170       | 29             | 166       |
| 14             | 158       | 30             | 165       |
| 15             | 162       | 31             | 161       |
| 16             | 161       | 32             | 163       |

### Vickers Hardness Survey 2% Nital

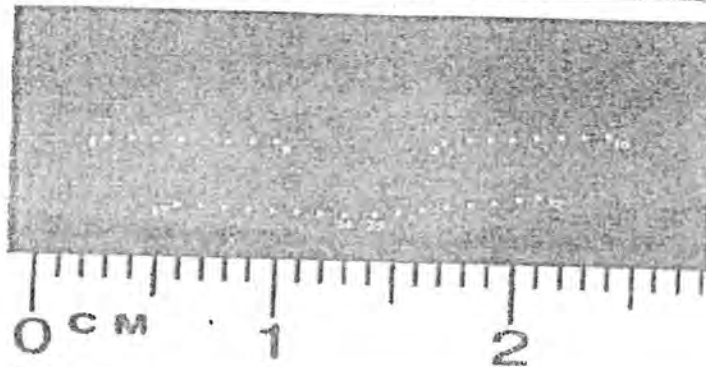

|  |                                    |
|--|------------------------------------|
| Other Tests Performed:   | NONE                               |
| All tests performed in accordance to methods specified in ASME B31.3 & SEC IX. |                                    |
| Signature  | John Phillips <i>John Phillips</i> |
| Date   | 11-17-2014                         |

ISTI Plant Services  
Tulsa  
Oklahoma


Procedure Qualification Record (PQR)

PQR No.: P1-P1-1025b WPS No.: 1025 Date: 11/17/2014 Page: 1 of 2

Welding Process(es) / Type(s): GTAW / Manual

**Joints (QW-402)**

Weld Type: Groove weld  
Single-V groove  
Backing: Open butt, no back weld  
Root Opening: 0.125 in. Root Face: 0 in.  
Groove Angle: 75 °

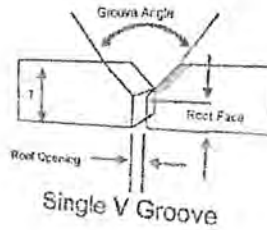

**Base Metals (QW-403)**

Material Spec., Type or Grade:  
SA-516-60/65/70 to SA-516-60/65/70  
P-No.: 1 Group No.: 1 to P-No.: 1 Group No.: 2  
Thickness of Test Coupon (in.): 0.625  
Test Coupon certified to SA516-60/65/70

**Postweld Heat Treatment (QW-407)**

Type: No PWHT performed  
Temperature: None °F  
Time: None hr

**Filler Metals (QW-404)**

SFA Specification: 5.18  
AWS Classification: ER70S-6  
Filler Metal F-No: 6  
Weld Metal Analysis A-No: (verify chemistry)  
Size of Filler Metal (in.): 1/8  
Weld Deposit 'Y' (in.): 0.625  
Filler Metal Product Form: Bare (Solid)  
Consumable Insert: No Consumable Insert or Retainers used  
Flux: No flux added

**Gas (QW-408)**

Gas Composition / Flow Rate  
Shielding: 100% Argon / 25 CFH  
Trailing: None  
Backing: None

**Electrical Characteristics (QW-409)**

Current / Polarity: DCEN (straight)  
Amps: 160  
Volts: 17  
Tungsten Type / Size: EWTh-2 / 1/8  
Heat Input: 23314 J/in  
Pulsed Current: No Pulsed Current used

**Positions (QW-405)**

Position of Joint: 3G - Vertical  
Weld Progression: Vertical up

**Technique (QW-410)**

Travel Speed (in/min): 7  
Thermal Processes: No  
String/Weave Bead: Stringer bead  
Oscillation: N/A  
Mult/Single Pass (per side): Multipass  
Mult/Single Electrode: N/A  
Nozzle/Gas Cup Size: #5

**Preheat (QW-406)**

Preheat Temp.: 75 °F  
Interpass Temp.: 450 °F  
Preheat Maintenance: None

(1) Single Electrode

**Additional Welding Parameters**

| Layer(s) and/or Pass(es) | Process | Filler Metal       |            | Current         |                | Voltage Range | Travel Speed Range (in/min) |
|--------------------------|---------|--------------------|------------|-----------------|----------------|---------------|-----------------------------|
|                          |         | AWS Classification | Size (in.) | Type / Polarity | Amperage Range |               |                             |
| Any                      | GTAW    | ER70S-6            | 1/8        | DCEN (straight) | 160            | 17            | 7                           |

ISTI Plant Services  
Procedure Qualification Record (PQR)

PQR No.: PI-PI-1025b

Page 2 of 2

Tensile Test (QW-150)

| Specimen No. | Width (in.) | Thickness (in.) | Area (in <sup>2</sup> ) | Ultimate Total Load (lb) | Ultimate Stress (PSI) | Failure Type and Location |
|--------------|-------------|-----------------|-------------------------|--------------------------|-----------------------|---------------------------|
| 1            | 0.750       | 0.504           | 0.378                   | 29906                    | 79100                 | Ductile - BM              |
| 2            | 0.750       | 0.554           | 0.416                   | 32876                    | 79000                 | Ductile - BM              |

Guided Bend Test (QW-160)

| Figure Number and Type | Result     | Figure Number and Type | Result     |
|------------------------|------------|------------------------|------------|
| QW-462.2 Side bend     | Acceptable | QW-462.2 Side bend     | Acceptable |
| QW-462.2 Side bend     | Acceptable | QW-462.2 Side bend     | Acceptable |
| None                   |            | None                   | Acceptable |

Toughness Test (QW-170)

| Specimen Number | Notch Location | Notch Type | Test Temp. (°F) | Impact Value (ft-lb) | Lateral Expansion |      | Drop Weight Break |
|-----------------|----------------|------------|-----------------|----------------------|-------------------|------|-------------------|
|                 |                |            |                 |                      | Shear %           | Mils |                   |
| 1               | Weld metal     | "V"        | -50             | 123                  | 55                | 71   | No                |
| 2               | Weld metal     | "V"        | -50             | 125                  | 60                | 71   | No                |
| 3               | Weld metal     | "V"        | -50             | 95                   | 30                | 59   | No                |
| 4               | HAZ            | "V"        | -30             | 37                   | 30                | 22   | No                |
| 5               | HAZ            | "V"        | -50             | 35                   | 30                | 20   | No                |
| 6               | HAZ            | "V"        | -50             | 30                   | 25                | 21   | No                |

Hardness Test - Vickers hardness

| Location                   | Readings |        |        |        |        |        |        |        |   |
|----------------------------|----------|--------|--------|--------|--------|--------|--------|--------|---|
|                            | 1        | 2      | 3      | 4      | 5      | 6      | 7      | 8      | 9 |
| SA-516-60/65/70 BM-1 Root  | 17-163   | 18-170 | 19-174 | 20-177 |        |        |        |        |   |
| SA-516-60/65/70 BM-1 Top   | 1-150    | 2-161  | 3-176  | 4-205  |        |        |        |        |   |
| SA-516-60/65/70 BM-2 Root  | 29-175   | 30-177 | 31-174 | 32-172 |        |        |        |        |   |
| SA-516-60/65/70 BM-2 Top   | 13-208   | 14-190 | 15-162 | 16-159 |        |        |        |        |   |
| SA-516-60/65/70 HAZ-1 Root | 21-185   | 22-183 |        |        |        |        |        |        |   |
| SA-516-60/65/70 HAZ-1 Top  | 5-229    | 6-233  |        |        |        |        |        |        |   |
| SA-516-60/65/70 HAZ-2 Root | 27-189   | 28-187 |        |        |        |        |        |        |   |
| SA-516-60/65/70 HAZ-2 Top  | 11-242   | 12-236 |        |        |        |        |        |        |   |
| Weld Metal                 | 7-233    | 8-223  | 9-245  | 10-240 | 23-182 | 24-194 | 25-191 | 26-185 |   |

Macro-Examination Test: None

Visual Examination: Acceptable

Liquid Penetration Test: None

Vickers hardness in accordance with NACE SP0472-2010 Figure 2 and 3.

Charpy V Notch Specimen Size: 10mm x 10mm.

Welder's Name: Enlid Valquez

ID: \_\_\_\_\_ Stamp: \_\_\_\_\_

PQR was done and welding of

coupon was witnessed by: ISTI Plant Services

Tests Conducted By: Tulsa Gamma Ray, Inc.

Test ID: 102135826

We certify that the statements in this record are correct and that the test welds were prepared, welded, and tested in accordance with the requirements of Section IX of the ASME Code.

Prepared By: John Phillips

11/17/14  
Date

Procedure Specialist

Accepted By: Rodolfo

11/17/14  
Date

QC Manager



# TULSA GAMMA RAY, INC.

1127 S Lewis Ave Tulsa, OK 74104  
918.585.3228

## LAB / MECHANICAL TEST REPORT

Welder Qualification     Weld Procedure Evaluation

|                  |                     |          |             |
|------------------|---------------------|----------|-------------|
| Organization     | ISTI Plant Services | LAB #    | 102135826   |
| Base Metal Type  | SA516-60/65/70      | PWHT     | None        |
| Coupon Thickness | 0.625"              | PQR#     | P1-P1-1025b |
| WPS No.          | 1025                | Filler   | ER70S-6     |
| Weld Process     | GTAW                | ID#      |             |
| Welder's Name    | Eulid Valezquez     | Position | 3G-Up       |

### BENDS

| Specimen Number | Type of Bend | Results/Comments                                 |
|-----------------|--------------|--|
| 1               | SIDE BEND #1 | PASSED No Relevant Indications Greater Than 1/8" |
| 2               | SIDE BEND #2 | PASSED No Relevant Indications Greater Than 1/8" |
| 3               | SIDE BEND #3 | PASSED No Relevant Indications Greater Than 1/8" |
| 4               | SIDE BEND #4 | PASSED No Relevant Indications Greater Than 1/8" |

### TENSILE TESTS

| Specimen Number | Specimen Size   | Specimen Area sq. in. | Load at Failure (lbs.) | Ultimate Tensile (psi) | Type of Failure & Location |
|-----------------|-----------------|-----------------------|------------------------|------------------------|----------------------------|
| 1               | 0.750" X 0.504" | 0.378                 | 29906                  | 79100                  | Ductile-BM                 |
| 2               | 0.750" X 0.554" | 0.416                 | 32876                  | 79000                  | Ductile-BM                 |

### HARDNESS IN BHN

| Base Material #1      |     |     | Heat Affected Zone #1 |     |     | Weld Metal |     |     |
|-----------------------|-----|-----|-----------------------|-----|-----|------------|-----|-----|
| 1                     | 2   | 3   | 1                     | 2   | 3   | 1          | 2   | 3   |
| N/A                   | N/A | N/A | N/A                   | N/A | N/A | N/A        | N/A | N/A |
| Heat Affected Zone #2 |     |     | Base Material #2      |     |     |            |     |     |
| 1                     | 2   | 3   | 1                     | 2   | 3   |            |     |     |
| N/A                   | N/A | N/A | N/A                   | N/A | N/A |            |     |     |

### CHARPY V-NOTCH IMPACT TESTING

| Specimen Number | Specimen Type/Location | Specimen Size | Temp. | Value Ft./Lbs. | Lateral Expansion | Percent Shear | Drop Weight/ Break |
|-----------------|------------------------|---------------|-------|----------------|-------------------|---------------|--------------------|
| 1               | V/Weld Metal           | 10mm x 10mm   | -50°F | 123            | 71                | 55            | No                 |
| 2               | V/Weld Metal           | 10mm x 10mm   | -50°F | 125            | 71                | 60            | No                 |
| 3               | V/Weld Metal           | 10mm x 10mm   | -50°F | 95             | 59                | 30            | No                 |
| 4               | V/HAZ                  | 10mm x 10mm   | -50°F | 37             | 22                | 30            | No                 |
| 5               | V/HAZ                  | 10mm x 10mm   | -50°F | 35             | 20                | 30            | No                 |
| 6               | V/HAZ                  | 10mm x 10mm   | -50°F | 30             | 21                | 25            | No                 |

Other Tests Performed: NONE

All tests performed in accordance to methods specified in ASME B31.3 & SEC IX.

Signature: John Phillips *John Phillips*

Date: 11-17-2014



# TULSA GAMMA RAY, INC.

1127 S Lewis Ave Tulsa, OK 74104  
918.585.3228

## LAB / MECHANICAL TEST REPORT


Welder Qualification     Weld Procedure Evaluation

|                  |                     |          |             |
|------------------|---------------------|----------|-------------|
| Organization     | ISTI Plant Services | LAB #    | 102135826   |
| Base Metal Type  | SA516-60/65/70      | PWHT     | None        |
| Coupon Thickness | 0.625"              | PQR#     | P1-P1-1025b |
| WPS No.          | 1025                | Filler   | ER70S-6     |
| Weld Process     | GTAW                | ID#      |             |
| Welder's Name    | Eulid Valezquez     | Position | 3G-Up       |

### Microhardness Survey ASTM E384-11 NACE SP0472-2010, Figure 2 and 3

| Reading Number | HIV Value | Reading Number | HIV Value |
|----------------|-----------|----------------|-----------|
| 1              | 150       | 17             | 168       |
| 2              | 161       | 18             | 170       |
| 3              | 176       | 19             | 174       |
| 4              | 205       | 20             | 177       |
| 5              | 229       | 21             | 185       |
| 6              | 233       | 22             | 188       |
| 7              | 233       | 23             | 182       |
| 8              | 223       | 24             | 194       |
| 9              | 245       | 25             | 191       |
| 10             | 240       | 26             | 185       |
| 11             | 242       | 27             | 189       |
| 12             | 236       | 28             | 187       |
| 13             | 208       | 29             | 175       |
| 14             | 190       | 30             | 177       |
| 15             | 162       | 31             | 174       |
| 16             | 159       | 32             | 172       |

### Vickers Hardness Survey 2% Nital

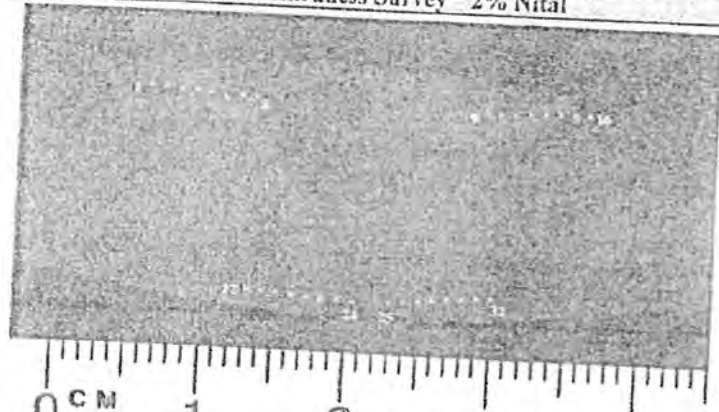

Other Tests Performed: NONE

All tests performed in accordance to methods specified in ASME B31.3 & SEC IX.

Signature: John Phillips *John Phillips*

Date: 11-17-2014

**J-447**

**SK2 Assy**  
**Spools**

**ISTI**  
**Welder Qualifications**



ISTI Plant Services  
17207 East 21st Street  
Tulsa, OK 74134

Welder or Welding Operator Performance Qualification (WPQ)

Welder's Name: Rendals, Justin Stamp: JZ  
Test WPS No.: 1001 Rev.: 3 WPQ No.: \_\_\_\_\_

Date: 2/24/2017

Welding process(es) / type(s) used: GTAW / Manual  
Type of joint welded: Pipe Groove weld Joint type(s) qualified: Groove and Fillet Welds  
Base metal(s) welded: SA-106, Grade B to SA-106, Grade B

| Welder Variables (QW-350)                  | Actual Values Used  | Range Qualified             |
|--|---------------------|-----------------------------|
| P- or S-Number to P- or S-Number           | P-No. 1 to P-No. 1  | P-1 thru P-15F, P-34 & P-4X |
| Base metal thickness (in.)                 | 0.218               | WPS Limits                  |
| Pipe diameter (in.)                        | 2.375               | 1.00" minimum               |
| Backing **                                 | GTAW / Manual       | GTAW / Manual               |
| AWS classification                         | No backing used     | With or without backing     |
| Filler metal specification (SFA)           | ER70S-6             |                             |
| Filler metal F-No.                         | 5.18                | 5.xx                        |
| Filler metal product form                  | 6                   | F-No. 6                     |
| Consumable insert                          | Bare (Solid)        | Bare / metal cored          |
| Deposit thickness (in.) [ $\geq 3$ layers] | No insert used      | Without insert only         |
| Welding position                           | 0.218 [N/A]         | 0.4360" maximum             |
| Weld progression                           | 6G - 45 degree pipe | All Positions               |
| Backing gas                                | Vertical up         | Vertical up (n4)            |
| GTAW welding current / polarity            | No backing gas used | With or Without backing gas |
|  | DCEN (straight)     | DCEN (straight)             |

| Machine Welding Variables (QW-360) | Actual Values Used | Range Qualified |
|------------------------------------|--------------------|-----------------|
| Direct / remote visual control     | N/A                | N/A             |
| Automatic voltage control          | N/A                | N/A             |
| Automatic joint tracking           | N/A                | N/A             |
| Welding position                   | N/A                | N/A             |
| Consumable insert                  | N/A                | N/A             |
| Backing **                         | N/A                | N/A             |
| Single / multiple pass per side    | N/A                | N/A             |

Fillet Welds: Qualified to make fillet welds of any size on all base material thicknesses and pipe diameters of any size.  
\*\* Welds with backing include fillets and double-welded groove welds.  
Notes: ( n4 ) The root pass, when removed to sound weld metal in preparation for welding the second side, and the cover or wash pass may be up or down.

| Guided Bend Test (QW-160) |        |                        |        |
|---------------------------|--------|------------------------|--------|
| Figure Number and Type    | Result | Figure Number and Type | Result |
| QW-462.3(a) Face bend     | Passed | QW-462.3(a) Root bend  | Passed |
| QW-462.3(a) Face bend     | Passed | QW-462.3(a) Root bend  | Passed |
| None                      |        | None                   |        |

Visual examination results: Visual exam satisfactory per QW-302.4 and QW-194

Volumetric test results: None

Welding test conducted by: ISTI Plant Services

Mechanical/Radiographic tests conducted by: American Piping Inspection

Lab test no.: W170118

We certify that the statements in this record are correct and that the test welds were prepared, welded, and tested in accordance with the requirements of Section IX of the ASME Code.

Approved By: \_\_\_\_\_

*Justin Rendals*

Organization: ISTI Plant Services

2/24/2017  
Date



ISTI Plant Services  
17207 East 21st Street  
Tulsa OK 74134

Welder or Welding Operator Performance Qualification (WPQ)

Welder's Name: Rendals, Justin Stamp: HZ

Test WPS No.: 1004 Rev.: 3 WPQ No.: \_\_\_\_\_

Date: 2/24/2017

Welding process(es) / type(s) used: GMAW / Semiautomatic and FCAW / Semiautomatic

Type of joint welded: Pipe Groove weld Joint type(s) qualified: Groove and Fillet Welds

Base metal(s) welded: SA-106, Grade B to SA-106, Grade B

| Welder Variables (QW-350)                  | Actual Values Used     |                        | Range Qualified             |                            |
|--|------------------------|------------------------|-----------------------------|----------------------------|
|  | P-No. 1 to P-No. 1     |                        | P-1 thru P-15F, P-34 & P-4X |                            |
| P- or S-Number to P- or S-Number           | 0.562                  |                        | WPS Limits                  |                            |
| Base metal thickness (in.)                 | 6.625                  |                        | 2.875" minimum              |                            |
| Pipe diameter (in.)                        | <u>GMAW / Semiauto</u> | <u>FCAW / Semiauto</u> | <u>GMAW / Semiauto</u>      | <u>FCAW / Semiauto</u>     |
|  | No backing used        | Backing used           | With or without backing     | With backing only          |
| Backing **                                 | ER70S-6                | E71T-12M               |                             |                            |
| AWS classification                         | 5.18                   | 5.20                   | 5.xx                        | 5.xx                       |
| Filler metal specification (SFA)           | 6                      | 6                      | F-No. 6                     | F-No. 6                    |
| Filler metal F-No.                         | N/A                    | N/A                    | N/A                         | N/A                        |
| Filler metal product form                  | N/A                    | N/A                    | N/A                         | N/A                        |
| Consumable insert                          | 0.125 [N/A]            | 0.437 [N/A]            | 0.2500" maximum             | 0.8740" maximum            |
| Deposit thickness (in.) [ $\geq 3$ layers] | I GR - Rotated         | I GR - Rotated         | Flat only                   | Flat only                  |
| Welding position                           | N/A                    | N/A                    | N/A                         | N/A                        |
| Weld progression                           | No backing gas used    | No backing gas used    | W/WO backing gas            | W/WO backing gas           |
| Backing gas                                | Globular arc           | Globular arc           | Spray, Pulsed, or Globular  | Spray, Pulsed, or Globular |
| GMAW / FCAW transfer mode                  |                        |                        |                             |                            |

| Machine Welding Variables (QW-360) | Actual Values Used             |     | Range Qualified |     |
|------------------------------------|--------------------------------|-----|-----------------|-----|
|                                    | Direct / remote visual control | N/A | N/A             | N/A |
| Automatic voltage control          | N/A                            | N/A | N/A             | N/A |
| Automatic joint tracking           | N/A                            | N/A | N/A             | N/A |
| Welding position                   | N/A                            | N/A | N/A             | N/A |
| Consumable insert                  | N/A                            | N/A | N/A             | N/A |
| Backing **                         | N/A                            | N/A | N/A             | N/A |
| Single / multiple pass per side    | N/A                            | N/A | N/A             | N/A |

Fillet Welds: Qualified to make fillet welds of any size on all base material thicknesses and pipe diameters of any size.

\*\* Welds with backing include fillets and double-welded groove welds.

Notes:

Guided Bend Test (QW-160)

| Figure Number and Type | Result | Figure Number and Type | Result |
|------------------------|--------|------------------------|--------|
| QW-462.2 Side bend     | Passed | QW-462.2 Side bend     | Passed |
| None                   |        | None                   |        |
| None                   |        | None                   |        |

Visual examination results: Visual exam satisfactory per QW-302.4 and QW-194

Volumetric test results: None

Welding test conducted by: ISTI Plant Services

Mechanical/Radiographic tests conducted by: American Piping Inspection

Lab test no.: W170119

We certify that the statements in this record are correct and that the test welds were prepared, welded, and tested in accordance with the requirements of Section IX of the ASME Code.

Approved By: \_\_\_\_\_

*Justin Rendals*

Organization: ISTI Plant Services

2/24/2017  
Date

ISTI Plant Services  
17207 East 21st Street  
Tulsa, OK 74134

Welder or Welding Operator Performance Qualification (WPQ)

Welder's Name: Hughart, Jesse Stamp: H8

Test WPS No.: 100I Rev.: 0 WPQ No.: \_\_\_\_\_

Date: 4/7/2017

Welding process(es) / type(s) used: GTAW / Manual

Type of joint welded: Pipe Groove weld Joint type(s) qualified: Groove and Fillet Welds

Base metal(s) welded: SA-106, Grade B to SA-106, Grade B

| Welder Variables (QW-350)                  | Actual Values Used   | Range Qualified             |
|--|----------------------|-----------------------------|
| P- or S-Number to P- or S-Number           | P-No. 1 to P-No. 1   | P-1 thru P-15F, P-34 & P-4X |
| Base metal thickness (in.)                 | 0.218                | WPS Limits                  |
| Pipe diameter (in.)                        | 2.375                | 1.00" minimum               |
|  | <u>GTAW / Manual</u> | <u>GTAW / Manual</u>        |
| Backing **                                 | No backing used      | With or without backing     |
| AWS classification                         | ER70S-6              |                             |
| Filler metal specification (SFA)           | 5.18                 | 5.xx                        |
| Filler metal F-No.                         | 6                    | F-No. 6                     |
| Filler metal product form                  | Bare (Solid)         | Bare / metal cored          |
| Consumable insert                          | No insert used       | Without insert only         |
| Deposit thickness (in.) [ $\geq 3$ layers] | 0.218 [N/A]          | 0.4360" maximum             |
| Welding position                           | 6G - 45 degree pipe  | All Positions               |
| Weld progression                           | Vertical up          | Vertical up (n4)            |
| Backing gas                                | No backing gas used  | With or Without backing gas |
| GTAW welding current / polarity            | DCEN (straight)      | DCEN (straight)             |

| Machine Welding Variables (QW-360) | Actual Values Used | Range Qualified |
|------------------------------------|--------------------|-----------------|
| Direct / remote visual control     | N/A                | N/A             |
| Automatic voltage control          | N/A                | N/A             |
| Automatic joint tracking           | N/A                | N/A             |
| Welding position                   | N/A                | N/A             |
| Consumable insert                  | N/A                | N/A             |
| Backing **                         | N/A                | N/A             |
| Single / multiple pass per side    | N/A                | N/A             |

Fillet Welds: Qualified to make fillet welds of any size on all base material thicknesses and pipe diameters of any size.  
 \*\* Welds with backing include fillets and double-welded groove welds.  
 Notes: ( n4 ) The root pass, when removed to sound weld metal in preparation for welding the second side, and the cover or wash pass may be up or down.

Guided Bend Test (QW-160)

| Figure Number and Type | Result | Figure Number and Type | Result |
|------------------------|--------|------------------------|--------|
| QW-462.3(a) Face bend  | Passed | QW-462.3(a) Root bend  | Passed |
| QW-462.3(a) Face bend  | Passed | QW-462.3(a) Root bend  | Passed |
| None                   |        | None                   |        |

Visual examination results: Visual exam satisfactory per QW-302.4 and QW-194

Volumetric test results: None

Welding test conducted by: ISTI Plant Services

Mechanical/Radiographic tests conducted by: American Piping Inspection

Lab test no.: W170232

We certify that the statements in this record are correct and that the test welds were prepared, welded, and tested in accordance with the requirements of Section IX of the ASME Code.

Approved By: \_\_\_\_\_

*Rodold*

Organization: ISTI Plant Services

4/10/17  
Date

ISTI Plant Services  
17207 East 21st Street  
Tulsa, OK 74134

Welder or Welding Operator Performance Qualification (WPQ)

Welder's Name: Lopez, Jaime Stamp: JI  
Test WPS No.: 1001 Rev.: 0 WPQ No.: \_\_\_\_\_

Date: 8/2/2017

Welding process(es) / type(s) used: GTAW / Manual

Type of joint welded: Pipe Groove weld Joint type(s) qualified: Groove and Fillet Welds

Base metal(s) welded: SA-106, Grade B to SA-106, Grade B

| Welder Variables (QW-350)                  | Actual Values Used   | Range Qualified             |
|--|----------------------|-----------------------------|
| P- or S-Number to P- or S-Number           | P-No. 1 to P-No. 1   | P-1 thru P-15F, P-34 & P-4X |
| Base metal thickness (in.)                 | 0.218                | WPS Limits                  |
| Pipe diameter (in.)                        | 2.375                | 1.00" minimum               |
|  | <u>GTAW / Manual</u> | <u>GTAW / Manual</u>        |
| Backing **                                 | No backing used      | With or without backing     |
| AWS classification                         | ER70S-6              |                             |
| Filler metal specification (SFA)           | 5.18                 | 5.xx                        |
| Filler metal F-No.                         | 6                    | F-No. 6                     |
| Filler metal product form                  | Bare (Solid)         | Bare / metal cored          |
| Consumable insert                          | No insert used       | Without insert only         |
| Deposit thickness (in.) [ $\geq 3$ layers] | 0.218 [N/A]          | 0.4360" maximum             |
| Welding position                           | 6G - 45 degree pipe  | All Positions               |
| Weld progression                           | Vertical up          | Vertical up (n4)            |
| Backing gas                                | No backing gas used  | With or Without backing gas |
| GTAW welding current / polarity            | DCEN (straight)      | DCEN (straight)             |

| Machine Welding Variables (QW-360) | Actual Values Used | Range Qualified |
|------------------------------------|--------------------|-----------------|
| Direct / remote visual control     | N/A                | N/A             |
| Automatic voltage control          | N/A                | N/A             |
| Automatic joint tracking           | N/A                | N/A             |
| Welding position                   | N/A                | N/A             |
| Consumable insert                  | N/A                | N/A             |
| Backing **                         | N/A                | N/A             |
| Single / multiple pass per side    | N/A                | N/A             |

Fillet Welds: Qualified to make fillet welds of any size on all base material thicknesses and pipe diameters of any size.

\*\* Welds with backing include fillets and double-welded groove welds.

Notes: ( n4 ) The root pass, when removed to sound weld metal in preparation for welding the second side, and the cover or wash pass may be up or down.

Guided Bend Test (QW-160)

| Figure Number and Type | Result | Figure Number and Type | Result |
|------------------------|--------|------------------------|--------|
| QW-462.3(a) Face bend  | Passed | QW-462.3(a) Root bend  | Passed |
| QW-462.3(a) Face bend  | Passed | QW-462.3(a) Root bend  | Passed |
| None                   |        | None                   |        |

Visual examination results: Visual exam satisfactory per QW-302.4 and QW-194

Volumetric test results: None


Welding test conducted by: ISTI Plant Services

Mechanical/Radiographic tests conducted by: American Piping Inspection

Lab test no.: M171154

We certify that the statements in this record are correct and that the test welds were prepared, welded, and tested in accordance with the requirements of Section IX of the ASME Code.

Approved By: \_\_\_\_\_

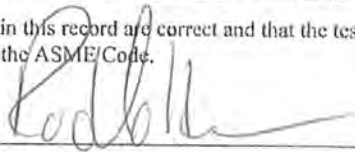

Organization: ISTI Plant Services

8/2/17  
Date

ISTI Plant Services  
17207 East 21st Street  
Tulsa, OK 74134

Welder or Welding Operator Performance Qualification (WPQ)

Welder's Name: Lopez, Jaime Stamp: JL

Test WPS No.: 1004 Rev.: 3 WPQ No.: \_\_\_\_\_

Date: 8/2/2017

Welding process(es) / type(s) used: GMAW / Semiautomatic and FCAW / Semiautomatic

Type of joint welded: Pipe Groove weld Joint type(s) qualified: Groove and Fillet Welds

Base metal(s) welded: SA-106, Grade B to SA-106, Grade B

Welder Variables (QW-350)

| P- or S-Number to P- or S-Number           | Actual Values Used   |                     | Range Qualified             |                            |
|--|----------------------|---------------------|-----------------------------|----------------------------|
|  | P-No. 1 to P-No. 1   |                     | P-1 thru P-15F, P-34 & P-4X |                            |
| Base metal thickness (in.)                 | 0.718                |                     | WPS Limits                  |                            |
| Pipe diameter (in.)                        | 6.625                |                     | 2.875" minimum              |                            |
|  | GMAW / Semiauto      | FCAW / Semiauto     | GMAW / Semiauto             | FCAW / Semiauto            |
| Backing **                                 | No backing used      | Backing used        | With or without backing     | With backing only          |
| AWS classification                         | ER70S-6              | E71T-12M            |                             |                            |
| Filler metal specification (SFA)           | 5.18                 | 5.20                | 5.xx                        | 5.xx                       |
| Filler metal F-No.                         | 6                    | 6                   | F-No. 6                     | F-No. 6                    |
| Filler metal product form                  | N/A                  | N/A                 | N/A                         | N/A                        |
| Consumable insert                          | N/A                  | N/A                 | N/A                         | N/A                        |
| Deposit thickness (in.) [ $\geq 3$ layers] | 0.125 [N/A]          | 0.593 [No]          | 0.1375" maximum             | 1.1860" maximum            |
| Welding position                           | 1GR - Rotated        | 1GR - Rotated       | Flat only                   | Flat only                  |
| Weld progression                           | N/A                  | N/A                 | N/A                         | N/A                        |
| Backing gas                                | No backing gas used  | No backing gas used | W/WO backing gas            | W/WO backing gas           |
| GMAW / FCAW transfer mode                  | Short-circuiting arc | Globular arc        | Short-circuiting arc        | Spray, Pulsed, or Globular |

Machine Welding Variables (QW-360)

|                                 | Actual Values Used             |     | Range Qualified |     |
|---------------------------------|--------------------------------|-----|-----------------|-----|
|                                 | Direct / remote visual control | N/A | N/A             | N/A |
| Automatic voltage control       | N/A                            | N/A | N/A             | N/A |
| Automatic joint tracking        | N/A                            | N/A | N/A             | N/A |
| Welding position                | N/A                            | N/A | N/A             | N/A |
| Consumable insert               | N/A                            | N/A | N/A             | N/A |
| Backing **                      | N/A                            | N/A | N/A             | N/A |
| Single / multiple pass per side | N/A                            | N/A | N/A             | N/A |

Fillet Welds: Qualified to make fillet welds of any size on all base material thicknesses and pipe diameters of any size.

\*\* Welds with backing include fillets and double-welded groove welds.

Notes:

Guided Bend Test (QW-160)

| Figure Number and Type | Result | Figure Number and Type | Result |
|------------------------|--------|------------------------|--------|
| QW-462.2 Side bend     | Passed | QW-462.2 Side bend     | Passed |
| None                   |        | None                   |        |
| None                   |        | None                   |        |

Visual examination results: Visual exam satisfactory per QW-302.4 and QW-194

Volumetric test results: None

Welding test conducted by: ISTI Plant Services

Mechanical/Radiographic tests conducted by: American Piping Inspection

Lab test no.: M171153

We certify that the statements in this record are correct and that the test welds were prepared, welded, and tested in accordance with the requirements of Section IX of the ASME Code.

Approved By: \_\_\_\_\_

*[Signature]*

Organization: ISTI Plant Services

8/2/17  
Date

**QW-484A SUGGESTED FORMAT A FOR WELDER PERFORMANCE QUALIFICATIONS (WPQ)**  
 (See QW-301, Section IX, ASME Boiler and Pressure Vessel Code)

Welder's Name Antonio Flores

Identification No. Q8

**TEST DESCRIPTION**

Identification of WPS followed WPS 1001  Test Coupon  Production Weld  
 Specification of base metal(s) SA106B Thickness 0.218"

**TESTING CONDITIONS & QUALIFICATIONS**

| Welding Variables (QW-350)  | Actual values | Range Qualified        |
|---|---------------|------------------------|
| Welding Process(es)   | GTAW          | GTAW                   |
| Type (i.e.: manual, semi-auto) used   | MANUAL        | MANUAL                 |
| Backing (metal, weld metal, double-welded, etc.)  | WITHOUT       | WITH/WITHOUT           |
| <input type="checkbox"/> Plate <input checked="" type="checkbox"/> Pipe (enter diameter if pipe or tube)    | 2"            | 1" & GREATER           |
| Base metal P or S-Number to P- or S Number  | P1 to P1      | P1 thru P15E, P34, P4X |
| Filler metal or electrode specification(s) (SFA) (info only)  | 5.18/5.20     |                        |
| Filler metal or electrode classification(s) ( info only)  | ER70S-6       |                        |
| Filler metal F-Numbers  | F6            | ALL F6                 |
| Consumable Insert (GTAW or PAW)   | NONE          | NONE                   |
| Filler type (solid/metal or flux cored/powdered) (GTAW or PAW)  | SOLID         | SOLID                  |
| Deposit thickness for each process  | -----         | -----                  |
| Process 1: <u>GTAW</u> 3 layers minimum <input type="checkbox"/> yes <input checked="" type="checkbox"/> no | 0.218 "       | 0.436" MAX             |
| Process 2: <u>N/A</u> 3 layers minimum <input type="checkbox"/> yes <input type="checkbox"/> no             | N/A           | N/A                    |
| Position qualified (2G, 6G, 3F, etc.)   | 1GR           | 1GR, 1F                |
| Vertical progression (uphill or downhill)   | UPHILL        | UPHILL                 |
| Type of fuel gas (OFW)  | N/A           | N/A                    |
| Inert gas backing (GTAW, PAW, GMAW)   | N/A           | N/A                    |
| Transfer mode (spray/globular or pulse to short circuit-GMAW)   | N/A           | N/A                    |
| GTAW current type/polarity (AC, DCEP, DCEN)   | DCEN          | DCEN                   |

**RESULTS**

Visual Examination of Completed Weld (QW-302.4) ACCEPTABLE

Bend Test  Transverse Root and Face [QW-462.2(a)]  Longitudinal Root and Face [QW-462.3(b)]  Side [QW-462.2]  
 Pipe bend specimen, corrosion-resistant overlay [QW-462.5(c)]  Plate bend specimen, corrosion resistant overlay [QW-462.5(d)]  
 Macro test fusion [QW-462.5 (b)]  Macro test for fusion [QW-462.5(e)]

| Type    | Result     | Type    | Result     | Type | Result |
|---------|------------|---------|------------|------|--------|
| FACE #1 | ACCEPTABLE | ROOT #2 | ACCEPTABLE | N/A  | N/A    |
| N/A     | N/A        | N/A     | N/A        | N/A  | N/A    |

Alternative radiographic examination results (QW-191) N/A

Fillet weld - fracture test (QW-180) N/A Length and percent of defects N/A  
 Macro examination (QW-184) N/A Fillet size (in.)     x     Concavity/convexity (in.) N/A

Other Tests N/A

Film or Specimens evaluated by John Phillips Company Tulsa Gamma Ray, Inc.

Mechanical tests conducted by TULSA GAMMA RAY, Inc. Laboratory Tests 102135525

Welding supervised by ISTI Plant Services

We certify that the statements in this record are correct and that the test welds were prepared, welded, and tested in accordance with the latest requirements of Section IX of the ASME Code.

Organization ISTI Plant Services

Date 09-29-2014

By Rodolfo

# American Piping Inspection

18501 E Admiral Pl. Catoosa, OK 74015  
PH 918.266.4130

## QW-484A SUGGESTED FORMAT A FOR WELDER PERFORMANCE QUALIFICATIONS (WPQ) (See QW-301, Section IX, ASME Boiler and Pressure Vessel Code)

Welder's Name Antonio Flores Identification No. Q8

### TEST DESCRIPTION

Identification of WPS followed 1004  Test Coupon  Production Weld  
Specification of base metal(s) SA106B Thickness 0.562"

### TESTING CONDITIONS & QUALIFICATIONS

| Welding Variables (QW-350)  | Actual values                | Range Qualified              |
|---|------------------------------|------------------------------|
| Welding Process(es)   | (1)GMAW/(2)FCAW              | (1)GMAW/(2)FCAW              |
| Type (i.e.: manual, semi-auto) used   | (1)SEMI/(2)SEMI              | (1)SEMI/(2)SEMI              |
| Backing (metal, weld metal, double-welded, etc.)  | (1)WITHOUT/(2) WITH          | (1)WITH OR WITHOUT/(2) WITH  |
| <input type="checkbox"/> Plate <input checked="" type="checkbox"/> Pipe (enter diameter if pipe or tube)    | 6.625"                       | 2 7/8" to UNLIMITED          |
| Base metal P or S-Number to P- or S Number  | P1 to P1                     | P1- P15F, P34 & P4X          |
| Filler metal or electrode specification(s) (SFA) (info only)  | (1)5.18/(2)5.20              | (1)5.18/(2)5.20              |
| Filler metal or electrode classification(s) ( info only)  | (1)ER70S-2/(2)E71T-12M       | (1)ER70S-6/(2)E71T-12M       |
| Filler metal F-Numbers  | F6                           | ALL F6                       |
| Consumable Insert (GTAW or PAW)   | NONE                         | NONE                         |
| Filler type (solid/metal or flux cored/powdered) (GTAW or PAW)  | (1)SOLID/(2)TUBULAR          | (1)SOLID/(2)TUBULAR          |
| Deposit thickness for each process  | -----                        | -----                        |
| Process 1: <u>(1)GMAW</u> 3 layers min. <input type="checkbox"/> yes <input checked="" type="checkbox"/> no | (1) 0.125"                   | (1) 0.1375" MAX              |
| Process 2: <u>(2)FCAW</u> 3 layers min. <input checked="" type="checkbox"/> yes <input type="checkbox"/> no | (2) 0.437"                   | (2) 0.874"                   |
| Position qualified (2G, 6G, 3F, etc.)   | 1GR                          | 1G, 1F                       |
| Vertical progression (uphill or downhill)   | N/A                          | N/A                          |
| Type of fuel gas (OFW)  | N/A                          | N/A                          |
| Inert gas backing (GTAW, PAW, GMAW)   | NONE                         | NONE                         |
| Transfer mode (spray/globular or pulse to short circuit-GMAW)   | (1)SHORT CIRCUIT/(2)GLOBULAR | (1)SHORT CIRCUIT/(2)GLOBULAR |
| GTAW current type/polarity (AC, DCEP, DCEN)   | (1)DCEP/(2)DCEP              | (1)DCEP/(2)DCEP              |

### RESULTS

Visual Examination of Completed Weld (QW-302.4) ACCEPTABLE

Bend Test  Transverse Root and Face [QW-462.3(a)]  Longitudinal Root and Face [QW-462.3(b)]  Side [QW-462.2]

Pipe bend specimen, corrosion-resistant overlay [QW-462.5 (c)]  Plate bend specimen, corrosion resistant overlay [QW-462.5(d)]

Macro test fusion [QW-462.5 (b)]  Macro test for fusion [QW-462.5(a)]

| Type         | Result     | Type         | Result     | Type | Result |
|--------------|------------|--------------|------------|------|--------|
| SIDE BEND #1 | ACCEPTABLE | SIDE BEND #2 | ACCEPTABLE | N/A  | N/A    |
| N/A          | N/A        | N/A          | N/A        | N/A  | N/A    |

Alternative radiographic examination results (QW-191) N/A

Fillet weld - fracture test (QW-180) N/A Length and percent of defects N/A

Macro examination (QW-184) N/A Fillet size (in.)     x     Concavity/convexity (in.) N/A

Other Tests N/A

Film or Specimens evaluated by Maxwell D. Stocker Company American Piping Inspection

Mechanical tests conducted by American Piping Inspection Laboratory Tests M150327-1D

Welding supervised by ISTI Plant Services

We certify that the statements in this record are correct and that the test welds were prepared, welded, and tested in accordance with the requirements of Section IX of the ASME Code.

Date 3-27-15 Organization ISTI Plant Services  
By Rodolfo

QW-484A SUGGESTED FORMAT A FOR WELDER PERFORMANCE QUALIFICATIONS (WPQ)  
 (See QW-301, Section IX, ASME Boiler and Pressure Vessel Code)

Welder's Name HUGO MEZA

Identification No W

TEST DESCRIPTION

Identification of WPS followed 1001  
 Specification of base metal(s) SA106B  
 Test Coupon  Production Weld  
 Thickness 218"

TESTING CONDITIONS & QUALIFICATIONS

| Welding Variables (QW-350)   | Actual values | Range Qualified |
|--|---------------|-----------------|
| Welding Process(es)  | GTAW          | GTAW            |
| Type (i.e., manual, semi-auto) used  | MANUAL        | MANUAL          |
| Backing (metal, weld metal, double-welded, etc.)   | NONE          | WITH OR WITHOUT |
| <input type="checkbox"/> Plate <input checked="" type="checkbox"/> Pipe (enter diameter if pipe or tube)   | 2"            | 1" to UNLIMITED |
| Base metal P or S-Number to P or S Number  | P1 to P1      | P1-P1           |
| Filler metal or electrode specification(s) (SFA) (info only)   | 518           |                 |
| Filler metal or electrode classification(s) (info only)  | ER70S-6       |                 |
| Filler metal E-Numbers   | 6             | 6               |
| Consumable Insert (GTAW or PAW)  | NONE          | NONE            |
| Filler type (solid metal or flux cored powdered) (GTAW or PAW)   | SOLID         | SOLID           |
| Deposit thickness for each process   | 218"          | .436"           |
| Process 1 <u>GTAW</u> 3 layers minimum <input checked="" type="checkbox"/> yes <input type="checkbox"/> no |               |                 |
| Process 2 3 layers minimum <input type="checkbox"/> yes <input type="checkbox"/> no                        | N.A.          | N.A.            |
| Position qualified (2G, 6G, 3F, etc.)  | 6G            | ALL             |
| Vertical progression (uphill or downhill)  | UPHILL        | UPHILL          |
| Type of fuel gas (OFW)   | N.A.          | N.A.            |
| Inert gas backing (GTAW PAW, GMAW)   | NONE          | NONE            |
| Transfer mode (spray globular or pulse to short circuit-CMAW)  | N.A.          | N.A.            |
| GTAW current type polarity (AC, DCEP, DCEN)  | DCEN          | DCEN            |

RESULTS

Visual Examination of Completed Weld (QW-302.4) ACCEPTABLE

- Bend Test  Transverse Root and face (QW-402.5.1)  Longitudinal root and face (QW-402.5.2)  Side (QW-402.5.3)  
 Pipe bend specimen, corrosion-resistant overlay (QW-402.5.4)  Plate bend specimen, corrosion-resistant overlay (QW-402.5.5)  
 Macro test fusion (QW-402.3.04)  Macro test for fusion (QW-402.3.04)

| Face | Result     | Type | Result     | Type | Result |
|------|------------|------|------------|------|--------|
| Face | Acceptable | Face | Acceptable |      |        |
| Root | Acceptable | Root | Acceptable |      |        |

Alternative radiographic examination results (QW-401) N/A  
 Filler weld fracture test (QW-180) N/A  
 Macro examination (QW-184) N/A Filler size (in.) N/A Length and percent of defects N/A  
 Other Tests N/A Concavity/convexity (in.) N/A

Filler or Specimens evaluated by RICK PRICE Company Tulsa Gamma Ray, Inc.  
 Mechanical tests conducted by RICK PRICE Laboratory Tests 102122039  
 Welding supervised by ISTI Plant Services Radiography Ticker # N/A

We certify that the statements in this record are correct and that the test welds were prepared, welded, and tested in accordance with the requirements of Section IX of the ASME Code

Organization

ISTI Plant Services  
Rick Price

# TULSA GAMMA RAY INC

1127 South Lewis Ave Tulsa OK 74104  
 PH 918.585.3228 FX 918.584.5598

## QW-484A SUGGESTED FORMAT A FOR WELDER PERFORMANCE QUALIFICATIONS (WPQ) (See QW-301, Section IX, ASME Boiler and Pressure Vessel Code)

Welder's Name HUGO MEZA Identification No. W

### TEST DESCRIPTION

Identification of WPS followed 1004  Test Coupon  Production Weld  
 Specification of base metal(s) SA106-B Thickness 0.562"

### TESTING VARIABLES & QUALIFICATION LIMITS

| Welding Variables (QW-350)   | Actual values       | Range Qualified             |
|--|---------------------|-----------------------------|
| Welding Process(es)  | (1)GMAW/(2)FCAW     | (1)GMAW/(2)FCAW             |
| Type (i.e.: manual, semi-auto) used  | (1)SEMI/(2)SEMI     | (1)SEMI/(2)SEMI             |
| Backing (metal, weld metal, double-welded, etc.)   | (1)Without/(2)With  | (1)With or Without/(2) With |
| <input type="checkbox"/> Plate <input checked="" type="checkbox"/> Pipe (enter diameter if pipe or tube) | 6"                  | 2 7/8" to UNLIMITED         |
| Base metal P or S-Number to P- or S Number   | P1-P1               | P1 thru P15E, P34 & P4X     |
| Filler metal or electrode specification(s) (SFA) (info only)   | 5.18 5.20           |                             |
| Filler metal or electrode classification(s) (info only)  | ER70S-6/E71T-12M    |                             |
| Filler metal F-Numbers   | 6/6                 | 6/6                         |
| Consumable Insert (GTAW or PAW)  | NONE                | NONE                        |
| Filler type (solid/metal or flux cored/powdered) (GTAW or PAW)   | (1)SOLID/(2)TUBULAR | (1)SOLID/(2)TUBULAR         |
| Deposit thickness for each process   |                     |                             |
| Process 1: <u>GMAW</u> 3 layers min. <input type="checkbox"/> yes <input checked="" type="checkbox"/> no | 0.125"              | 0.1375" MAX                 |
| Process 2: <u>FCAW</u> 3 layers min. <input checked="" type="checkbox"/> yes <input type="checkbox"/> no | 0.307"              | 0.614"                      |
| Position qualified (2G, 6G, 3F, etc.)  | 1G                  | 1G, 1F                      |
| Vertical progression (uphill or downhill)  | N.A.                | N.A.                        |
| Type of fuel gas (OFW)   | N.A.                | N.A.                        |
| Inert gas backing (GTAW, PAW, GMAW)  | NONE                | NONE                        |
| Transfer mode (spray-globular or pulse to short circuit-GMAW)  | SHORT CIRCUIT       | SHORT CIRCUIT               |
| GTAW current type/polarity (AC, DCEP, DCEN)  | DCEP                | DCEP                        |

### RESULTS

Visual Examination of Completed Weld (QW-302.4) ACCEPTABLE

Bend Test  Transverse Root and Face [QW-462.5(a)]  Longitudinal Root and Face [QW-462.5(b)]  Side [QW-462.2]  
 Pipe bend specimen, corrosion-resistant overlay [QW-462.5(c)]  Plate bend specimen, corrosion resistant overlay [QW-462.5(d)]  
 Macro test fusion [QW-462.5(b)]  Macro test for fusion [QW-462.5(c)]

| Type         | Result | Type | Result | Type | Result |
|--------------|--------|------|--------|------|--------|
| SIDE BEND #1 | PASS   |      |        |      |        |
| SIDE BEND #2 | PASS   |      |        |      |        |

Alternative radiographic examination results (QW-191) N/A  
 Fillet weld - fracture test (QW-180) N/A Length and percent of defects N/A  
 Macro examination (QW-184) N/A Fillet size (in.) x Concavity/convexity (in.) N/A  
 Other Tests N/A

Film or Specimens evaluated by ROBERT BAKER Company TULSA GAMMA RAY, Inc.  
 Mechanical tests conducted by ROBERT BAKER Laboratory Tests 102132585  
 Welding supervised by ISTI PLANT SERVICES

We certify that the statements in this record are correct and that the test welds were prepared, welded, and tested in accordance with the requirements of Section IX of the ASME Code.

Date 12-7-12 Manufacturer or Contractor ISTI PLANT SERVICES  
 Certified by [Signature]

# TULSA GAMMA RAY INC.

1127 South Lewis Ave. Tulsa OK 74104  
 PH 918.585.3228 FX 918.584.5598

## QW-484A SUGGESTED FORMAT A FOR WELDER PERFORMANCE QUALIFICATIONS (WPQ)

(See QW-301, Section IX, ASME Boiler and Pressure Vessel Code)

Welder's Name Hugo Meza Identification No. W

### TEST DESCRIPTION

Identification of WPS followed 1002  Test Coupon  Production Weld  
 Specification of base metal(s) SA106B Thickness 0.562"

### TESTING CONDITIONS & QUALIFICATIONS

| Welding Variables (QW-350)  | Actual values       | Range Qualified        |
|---|---------------------|------------------------|
| Welding Process(es)   | GTAW / SMAW         | GTAW / SMAW            |
| Type (i.e.: manual, semi-auto) used   | MANUAL              | MANUAL                 |
| Backing (metal, weld metal, double-welded, etc.)  | WITHOUT / WITH      | WITH or WITHOUT / WITH |
| <input type="checkbox"/> Plate <input checked="" type="checkbox"/> Pipe (enter diameter if pipe or tube)    | 6.625"              | 2.875" & ABOVE         |
| Base metal P or S-Number to P- or S Number  | PI TO PI            | PI-P15F, P34 & P4X     |
| Filler metal or electrode specification(s) (SFA) (info only)  | 5.18/5.1            |                        |
| Filler metal or electrode classification(s) ( info only)  | (1)ER70S-6/(2)E7018 |                        |
| Filler metal F-Numbers  | F6/F3               | ALL CLASSIFICATIONS    |
| Consumable Insert (GTAW or PAW)   | N/A                 | N/A                    |
| Filler type (solid/metal or flux cored/powdered) (GTAW or PAW)  | COATED              | COATED                 |
| Deposit thickness for each process  | -----               | -----                  |
| Process 1: <u>GTAW</u> 3 layers minimum <input type="checkbox"/> yes <input checked="" type="checkbox"/> no | 0.125"              | 0.250" MAX.            |
| Process 2: <u>SMAW</u> 3 layers minimum <input checked="" type="checkbox"/> yes <input type="checkbox"/> no | 0.437"              | 0.874" MAX             |
| Position qualified (2G, 6G, 3F, etc.)   | 6G                  | ALL                    |
| Vertical progression (uphill or downhill)   | UPHILL              | UPHILL                 |
| Type of fuel gas (OFW)  | N/A                 | N/A                    |
| Inert gas backing (GTAW, PAW, GMAW)   | N/A                 | N/A                    |
| Transfer mode (spray/globular or pulse to short circuit-GMAW)   | N/A                 | N/A                    |
| GTAW current type/polarity (AC, DCEP, DCEN)   | DCEN/DCEP           | DCEN/DCEP              |

### RESULTS

Visual Examination of Completed Weld (QW-302.4) ACCEPTABLE

Bend Test  Transverse Root and face [QW-462.3(a)]  Longitudinal root and face [QW-462.3(b)]  Side [QW-462.2]  
 Pipe bend specimen, corrosion-resistant overlay [QW-462.5(c)]  Plate bend specimen, corrosion resistant overlay [QW-462.5(d)]  
 Macro test fusion [QW-462.5(b)]  Macro test for fusion [QW-462.5(e)]

| TYPE         | RESULT     | TYPE        | RESULT     | TYPE | RESULT |
|--------------|------------|-------------|------------|------|--------|
| SIDE BEND #1 | ACCEPTABLE | SIDE BEND#3 | ACCEPTABLE | N/A  | N/A    |
| SIDE BEND #2 | ACCEPTABLE | SIDE BEND#4 | ACCEPTABLE | N/A  | N/A    |

Alternative radiographic examination results (QW-191) N/A  
 Fillet weld - fracture test (QW-180) N/A Length and percent of defects N/A  
 Macro examination (QW-184) N/A Fillet size (in.) x Concavity/convexity (in.) N/A  
 Other Tests N/A

Film or Specimens evaluated by Maxwell D. Stocker Company Tulsa Gamma Ray, Inc.  
 Mechanical tests conducted by TULSA GAMMA RAY, INC. Laboratory Tests 102136018  
 Welding supervised by ISTI Plant Services



We certify that the statements in this record are correct and that the test welds were prepared, welded, and tested in accordance with the requirements of ASME Section IX Boiler & Pressure Vessel Code.

Date 12-2-2014 Organization ISTI Plant Services  
 By [Signature]

**J-447**


**SK2 Assy**  
**Spools**

**ISTI**  
**Weld Maps**

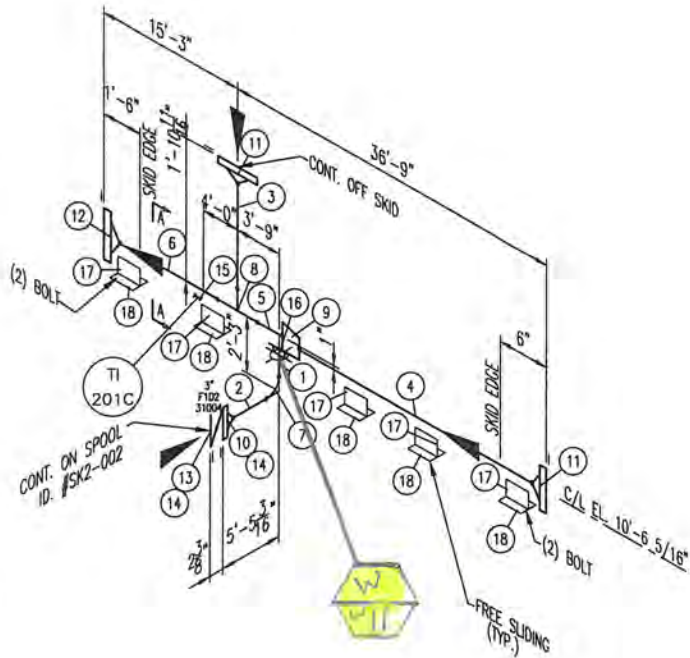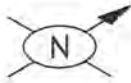

BILL OF MATERIAL

| MARK | QTY | SIZE  | DESCRIPTION   | LENGTH     |
|------|-----|-------|---|------------|
| 1    | 1   | 3"    | PIPE, XH SMLS, A-333-6  | 1'-4 7/16" |
| 2    | 1   | 3"    | PIPE, XH SMLS, A-333-6  | 4'-9 3/16" |
| 3    | 1   | 6"    | PIPE, XH SMLS, A-333-6  | 11 3/16"   |
| 4    | 1   | 6"    | PIPE, XH SMLS, A-333-6  | 31'-7 7/8" |
| 5    | 1   | 8"    | PIPE, XH SMLS, A-333-6  | 3'-7 1/4"  |
| 6    | 1   | 8"    | PIPE, XH SMLS, A-333-6  | 14'-2 1/2" |
| 7    | 1   | 3"    | ELL, 90 LR XH, A-420-WPL6   |            |
| 8    | 1   | 8"x6" | TEE, REDUCING XH, A-420-WPL6  |            |
| 9    | 1   | 8"x6" | REDUCER, ECC XH, A-420-WPL6   |            |
| 10   | 1   | 3"    | FLG, RFWN 600LB XH, A-350-LF2   |            |
| 11   | 2   | 6"    | FLG, RFWN 600LB XH, A-350-LF2   |            |
| 12   | 1   | 8"    | FLG, RFWN 600LB XH, A-350-LF2   |            |
| 13   | 1   | 3/4"  | (8) STUD BOLTS, A-193-B7 w/ TWO HEAVY HEX NUTS, A-194-2H                                    | 7 1/2"     |
| 14   | 2   | 3"    | GASKET, 1/8" THK, 600LB RF, SPIRALWOUND, 304SS WINDING, FLEXITE SUPER FILLER, CS GUIDE RING |            |
| 15   | 1   | 3/4"  | CPLG, THRD, 3000LB FS, A-350-LF2  |            |
| 16   | 1   | 8"x3" | WOL, XH, A-350-LF2  |            |
| 17   | 5   |       | PLATE, 1/4" THK. x 2 3/4" x 6" (SA-516-70 MATERIAL)   |            |
| 18   | 5   |       | PLATE, 1/4" THK. x 6" x 6" (SA-516-70 MATERIAL)   |            |

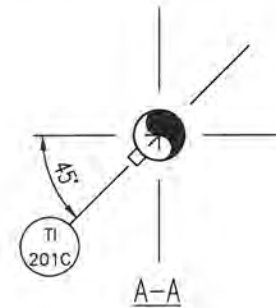

J-447  
12/19/16  
IFC

\*\*\* = JOB #



SHOP WELD

Oct 04, 2013 - 11:26am Z:\100 - Jobs\SC6\_60MM Cryo\17.0 Drawings\REV\_A\17.4 Piping\SPools\Skid #2\



|                |            |                |                |     |                        |          |     |     |
|----------------|------------|----------------|----------------|-----|------------------------|----------|-----|-----|
| DESIGN PRESS.  | 1100 Psig  | FAB. LOCATION  | SHOP           |     |                        |          |     |     |
| DESIGN TEMP.   | 150 °F     | SPOOL LOCATION | SKID #2        |     |                        |          |     |     |
| OPER. PRESS.   | 870 Psia   |                |                |     |                        |          |     |     |
| OPER. TEMP.    | 37 °F      | CORR. ALLOW.   | .0625"         |     |                        |          |     |     |
| STRESS RELIEVE | NO         | INSULATION     | 1.5°C          | 0   | ISSUE FOR CONSTRUCTION | 04/25/11 | PLD | LH  |
| RADIOGRAPHY    | 15% NORMAL | PAINT          | TRCO SYSTEM #3 | NO. | REVISION               |          |     | APR |

**CONFIDENTIAL STATEMENT**  
THIS DRAWING IS THE PROPERTY OF THE THOMAS RUSSELL CO. AND IS NOT TO BE USED FOR ANY PURPOSE OTHER THAN THAT FOR WHICH IT IS SPECIFICALLY FURNISHED.

**FABRICATION NOTES:**  
ALL VALVES ARE TRIMMED FACE UNLESS NOTED.  
ALL FITTING MAKE-UP & CUT LENGTHS FOR BWP PIPE DO NOT INCLUDE WELD GAPS.  
SHOP TO MAKE ADJUSTMENTS FOR WELD GAPS.  
ALL PIPE SEAMLESS UNLESS NOTED OTHERWISE.  
ALL COUPLING TO BE SHOULDER ON.

**Thomas Russell Co.**  
7050 S. Yale, Suite 210  
Tulsa, Oklahoma 74136  
PH: 918-481-5682

|                  |                    |               |          |
|------------------|--------------------|---------------|----------|
| LINE No.         | 155-D1-LT-6" 1.5°C |               |          |
| ASSEMBLY DRAWING | SC6-402            |               |          |
| DRAWING          | ***-231            |               |          |
| DRAWN BY         | DV                 | DATE DRAWN    | 03/21/11 |
| JOB No.          | SC6-               | SPOOL ID. No. | SK2-005  |
| REV.             | 0                  |               |          |

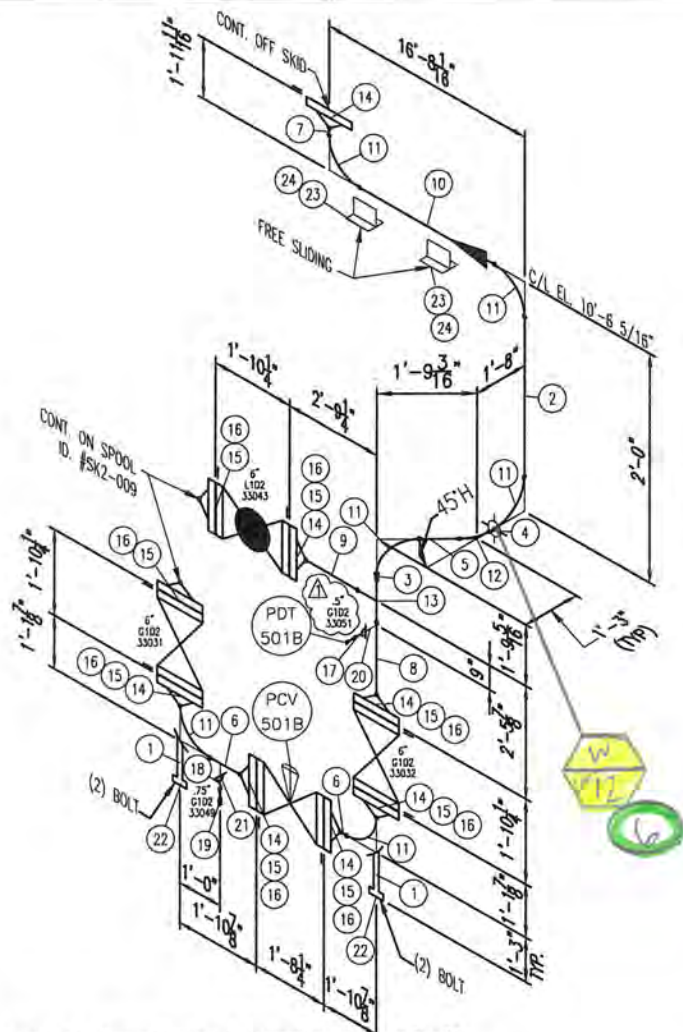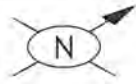

  
 SEP 29 2017  
**J6733**

Nov 01, 2016 - 11:26am Z:\400 - Drafting\001-PROJECTS\445-CRYO\DRAWINGS\400-Piping\SPOOLS\SKID#2\

 SHOP WELD

J-447  
 12/19/16  
 IFC

\*\*\* = JOB #

**BILL OF MATERIAL**


| MARK | QTY | SIZE    | DESCRIPTION   | LENGTH      |
|------|-----|---------|---|-------------|
| 1    | 2   | 3"      | PIPE, STD SMLS, A-333-6   | 1'-11 1/2"  |
| 2    | 1   | 6"      | PIPE, XH SMLS, A-333-6  | 6"          |
| 3    | 1   | 6"      | PIPE, XH SMLS, A-333-6  | 6 11/16"    |
| 4    | 1   | 6"      | PIPE, XH SMLS, A-333-6  | 7 1/4"      |
| 5    | 1   | 6"      | PIPE, XH SMLS, A-333-6  | 8 7/16"     |
| 6    | 2   | 6"      | PIPE, XH SMLS, A-333-6  | 9"          |
| 7    | 1   | 6"      | PIPE, XH SMLS, A-333-6  | 9 13/16"    |
| 8    | 1   | 6"      | PIPE, XH SMLS, A-333-6  | 1'-7 3/8"   |
| 9    | 1   | 6"      | PIPE, XH SMLS, A-333-6  | 1'-10 3/4"  |
| 10   | 1   | 6"      | PIPE, XH SMLS, A-333-6  | 15'-2 1/16" |
| 11   | 6   | 6"      | ELL, 90 LR XH, A-420-WPL6   |             |
| 12   | 1   | 6"      | ELL, 45 LR XH, A-420-WPL6   |             |
| 13   | 1   | 6"      | TEE, STR. XH, A-420-WPL6  |             |
| 14   | 7   | 6"      | FLG, RFWN 600LB XH, A-350-LF2   |             |
| 15   | 8   | 1"      | (12) STUD BOLTS, A-193-B7 w/ TWO HEAVY HEX NUTS, A-194-2H                                   | 7"          |
| 16   | 8   | 6"      | GASKET, 1/8" THK, 600LB RF, SPIRALWOUND, 304SS WINDING, FLEXITE SUPER FILLER, CS GUIDE RING |             |
| 17   | 1   | 1/2"    | NIPPLE, S/160 SMLS, A-333-6 POE-TOE   | 3"          |
| 18   | 1   | 3/4"    | NIPPLE, S/160 SMLS, A-333-6 POE-TOE   | 3"          |
| 19   | 1   | 3/4"    | PLUG, SOLID STEEL, ROUND HEAD, THR'D, A-350-LF2   |             |
| 20   | 1   | 6"x1/2" | SOL, 3000LB FS, A-350-LF2   |             |
| 21   | 1   | 6"x3/4" | SOL, 3000LB FS, A-350-LF2   |             |
| 22   | 2   |         | BASE PLATE, 1/2" THK. x 6" x 6" (SA-36 MATERIAL)  |             |
| 23   | 2   |         | PLATE, 1/4" THK. x 2 3/4" x 6" (SA-516-70 MATERIAL)   |             |
| 24   | 2   |         | PLATE, 1/4" THK. x 6" x 6" (SA-516-70 MATERIAL)   |             |

|                |            |                |                |     |                              |          |         |          |
|----------------|------------|----------------|----------------|-----|------------------------------|----------|---------|----------|
| DESIGN PRESS.  | 1100 Psig  | FAB. LOCATION  | SHOP           |     |                              |          |         |          |
| DESIGN TEMP.   | 150 °F     | SPOOL LOCATION | SKID #2        |     |                              |          |         |          |
| OPER. PRESS.   | 865 Psia   |                |                |     |                              |          |         |          |
| OPER. TEMP.    | 0 °F       | CORR. ALLOW.   | .0625"         | 1   | REV. ITEM #19, AND VALVE TAG | 10/31/16 | T.HAGAR | R.CARTER |
| STRESS RELIEVE | NO         | INSULATION     | 1.5 °C         | 0   | ISSUE FOR CONSTRUCTION       | 04/25/11 | PLD     | LH       |
| RADIOGRAPHY    | 15% NORMAL | PAINT          | TRCo SYSTEM #3 | NO. | REVISION                     | DATE     | BY      | APR      |

**CONFIDENTIAL STATEMENT**  
 THIS DRAWING IS THE PROPERTY OF THE THOMAS RUSSELL CO. AND IS NOT TO BE USED FOR ANY PURPOSE OTHER THAN THAT FOR WHICH IT IS SPECIFICALLY FURNISHED.  
**FABRICATION NOTES:**  
 ALL VALUES ARE ROUNDED UP UNLESS NOTED.  
 ALL FITTING MAKE-UP & CUT LENGTHS FOR BW PIPE DO NOT INCLUDE WELD GAPS.  
 SHOP TO MAKE ADJUSTMENTS FOR WELD GAPS.  
 ALL PIPE SEAMLESS UNLESS NOTED OTHERWISE.  
 ALL COPYING TO BE SHOPLED ON.



**Thomas Russell Co.**  
 7050 S. Yale, Suite 210  
 Tulsa, Oklahoma 74130  
 PH: 918-481-5882

|                  |                     |
|------------------|---------------------|
| LINE No.         | 159-D1-LT-6" 1.5 °C |
| ASSEMBLY DRAWING | SC6-402             |
| FIELD DRAWING    | ***-233             |
| DRAWN BY         | DV                  |
| DATE DRAWN       | 03/21/11            |
| JOB No.          | SC6-                |
| SPOOL ID. No.    | SK2-010             |
| REV.             | 1                   |

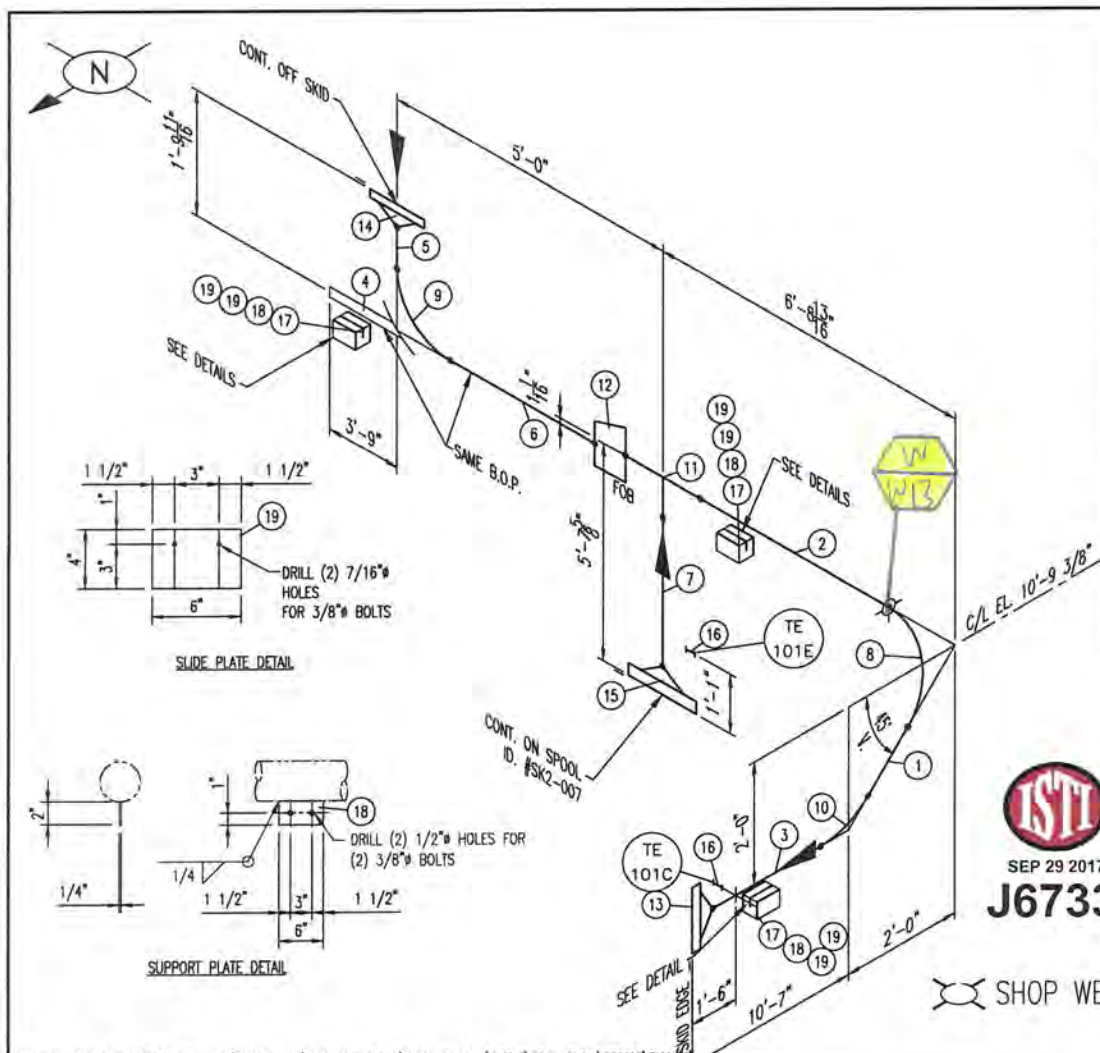


**BILL OF MATERIAL**

| MARK | QTY | SIZE   | DESCRIPTION   | LENGTH      |
|------|-----|--------|---|-------------|
| 1    | 1   | 10"    | PIPE, S/40S EFW, A-312-TP304/304L                     | 1'-0 11/16" |
| 2    | 1   | 10"    | PIPE, S/40S EFW, A-312-TP304/304L                     | 4'-9 5/16"  |
| 3    | 1   | 10"    | PIPE, S/40S EFW, A-312-TP304/304L                     | 9'-8 1/8"   |
| 4    | 1   | 4"     | PIPE, S/10S EFW, A-312-TP304/304L                     | 4'-9"       |
| 5    | 1   | 8"     | PIPE, S/40S EFW, A-312-TP304/304L                     | 5 5/16"     |
| 6    | 1   | 8"     | PIPE, S/40S EFW, A-312-TP304/304L                     | 2'-8 1/2"   |
| 7    | 1   | 8"     | PIPE, S/40S EFW, A-312-TP304/304L                     | 4'-6 1/8"   |
| 8    | 1   | 10"    | ELL, 90 LR S/40S, A-403-WP304/304L                    |             |
| 9    | 1   | 8"     | ELL, 90 LR S/40S, A-403-WP304/304L                    |             |
| 10   | 1   | 10"    | ELL, 45 LR S/40S, A-403-WP304/304L                    |             |
| 11   | 1   | 10"x8" | TEE, RED S/40S, A-403-WP304/304L                      |             |
| 12   | 1   | 10"x8" | REDUCER, ECC S/40S, A-403-WP304/304L                  |             |
| 13   | 1   | 10"    | FLG, RFWN 300LB S/40S, A-182-F304/304L                |             |
| 14   | 1   | 8"     | FLG, RFWN 300LB S/40S, A-182-F304/304L                |             |
| 15   | 1   | 8"     | FLG, RFWN 600LB S/40S, A-182-F304/304L                |             |
| 16   | 2   | 3/4"   | CPLG, TOE x 3" LG, 3000LB FS, A-182-F304/304L         |             |
| 17   | 3   |        | NYLON BLOCK, 4" x 4" x 6" LG                          |             |
| 18   | 3   |        | PLATE, 1/4" THK x 2" x 6" LG A-240-304SS (PER DETAIL) |             |
| 19   | 6   |        | PLATE, 1/4" THK x 4" x 6" LG A-240-304SS (PER DETAIL) |             |

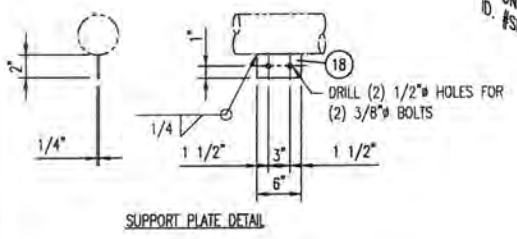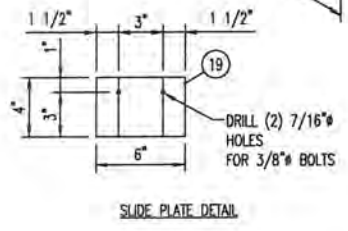

SHOP WELD

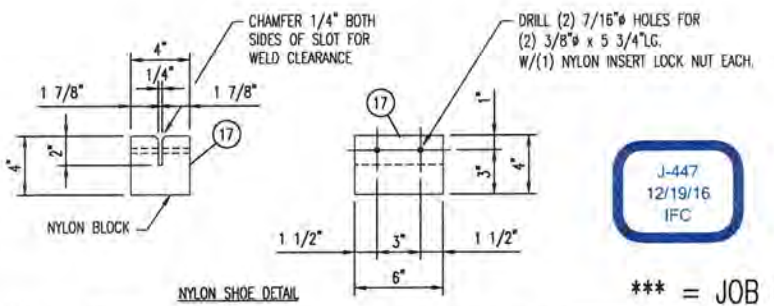

\*\*\* = JOB #

Oct 04, 2013 - 11:27am Z:\100 - Jobs\SC6\_60MM Cryo\17.0 Drawings\REV\_A\17.4 Piping\SPHOOLS\Skid #2


|                |            |                |         |     |                        |          |     |     |
|----------------|------------|----------------|---------|-----|------------------------|----------|-----|-----|
| DESIGN PRESS.  | 400 Psig   | FAB. LOCATION  | SHOP    |     |                        |          |     |     |
| DESIGN TEMP.   | 150 °F     | SPOOL LOCATION | SKID #2 |     |                        |          |     |     |
| OPER. PRESS.   | 220 Psia   |                |         |     |                        |          |     |     |
| OPER. TEMP.    | -83 °F     | CORR. ALLOW.   | 0"      |     |                        |          |     |     |
| STRESS RELIEVE | NO         | INSULATION     | 2.5°C   | 0   | ISSUE FOR CONSTRUCTION | 04/25/11 | PLD | LH  |
| RADIOGRAPHY    | 15% NORMAL | PAINT          | NONE    | NO. | REVISION               | DATE     | BY  | APR |

**CONFIDENTIAL STATEMENT**  
 THIS DRAWING IS THE PROPERTY OF THE THOMAS RUSSELL CO. AND IS NOT TO BE USED FOR ANY PURPOSE OTHER THAN THAT FOR WHICH IT IS SPECIFICALLY FURNISHED.

**FABRICATION NOTES:**  
 ALL VALVES ARE RASSED FACE UNLESS NOTED.  
 ALL FITTING MAKE-UP & CUT LENGTHS FOR BW PIPE DO NOT INCLUDE WELD GAPS.  
 SHOP TO MAKE ADJUSTMENTS FOR WELD GAPS.  
 ALL PIPE SEAMLESS UNLESS NOTED OTHERWISE.  
 ALL COUPLING TO BE SHOULDED ON.

**Thomas Russell Co.**  
 7050 S. Yale, Suite 210  
 Tulsa, Oklahoma 74138  
 PH: 918-481-5682

|                  |                        |     |  |
|------------------|------------------------|-----|--|
| LINE No.         | 166-B0-304SS-10" 2.5"C |     |  |
| ASSEMBLY DRAWING | SC6-402                |     |  |
| PART DRAWING     | ***-233                |     |  |
| DRAWN BY         | DATE DRAWN             |     |  |
| DV               | 03/21/11               |     |  |
| JOB No.          | SPPOOL ID. No.         | REV |  |
| -SC6-            | SK2-015                | 0   |  |

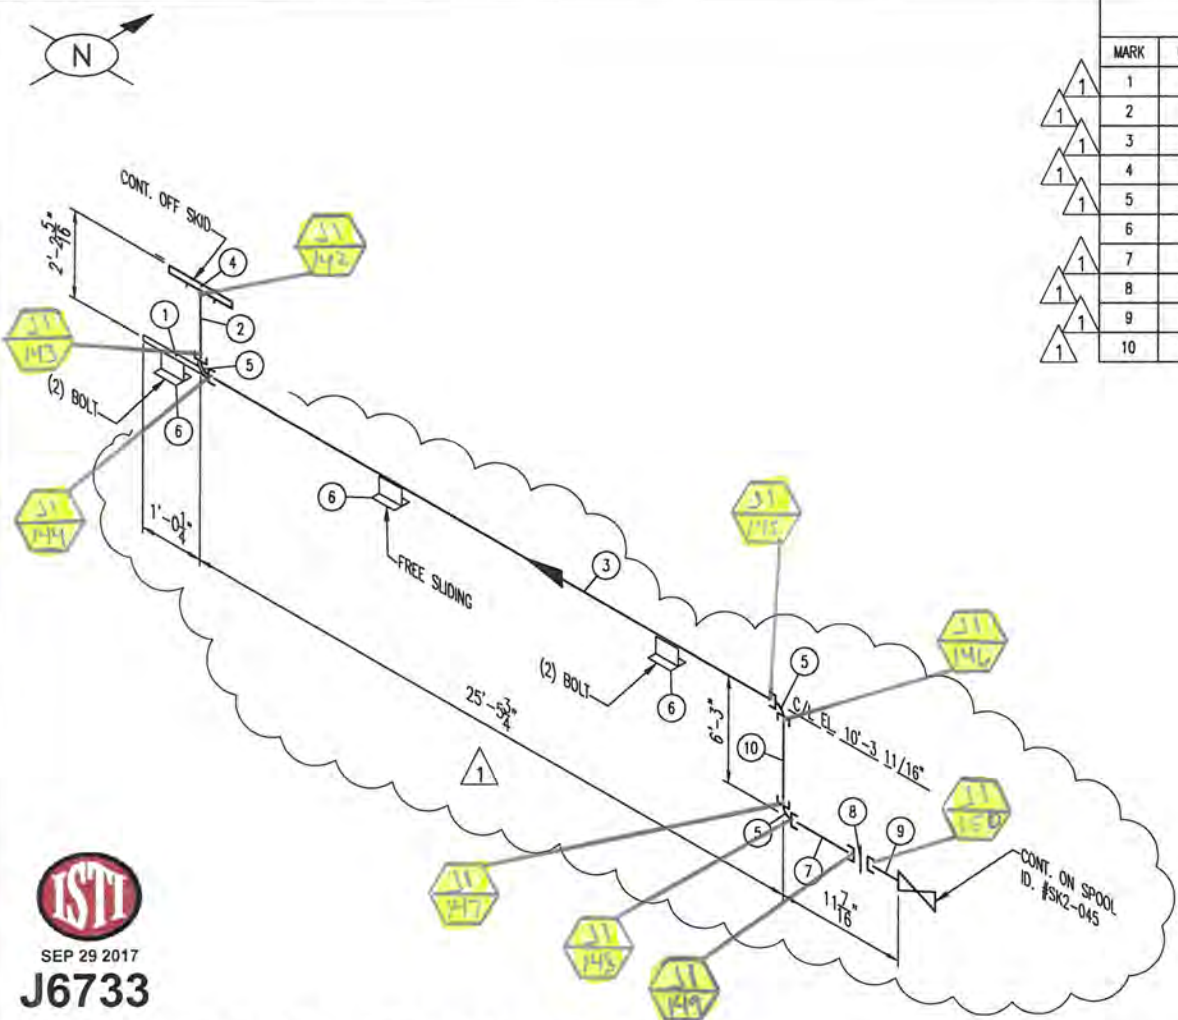

| BILL OF MATERIAL |     |      |                                     |           |
|------------------|-----|------|-------------------------------------|-----------|
| MARK             | QTY | SIZE | DESCRIPTION                         | LENGTH    |
| 1                | 1   | 1"   | PIPE, XH SMLS, A-106-B              | 1'-1 1/8" |
| 2                | 1   | 1"   | PIPE, XH SMLS, A-106-B PBE          | 2'-0 7/8" |
| 3                | 1   | 1"   | PIPE, XH SMLS, A-106-B PBE          | 25'-4"    |
| 4                | 1   | 1"   | FLG, RFSW 300LB XH, A-105           |           |
| 5                | 3   | 1"   | ELL, 90 SW, 3000LB FS, A-105        |           |
| 6                | 3   |      | PIPE SHOE, 6" LG x 3" HI FROM W6x15 |           |
| 7                | 1   | 1"   | PIPE, XH SMLS, A-106-B PBE          | 5 1/16"   |
| 8                | 1   | 1"   | UNION, SW, 3000LB FS, A-105         |           |
| 9                | 1   | 1"   | NIPPLE, XH SMLS, A-106-B POE-TOE    | 4"        |
| 10               | 1   | 1"   | PIPE, XH SMLS, A-106-B PBE          | 6'-1 1/4" |

J-447  
12/19/16  
IFC

\*\*\* = JOB #

Oct 04, 2013 - 11:27am Z:\100 - Jobs\SC6\_60MM Cryo\17.0 Drawings\REV\_A\17.4 Piping\SPHOOLS\Skid #2\



|                |          |                |                |     |                        |          |     |     |  |
|----------------|----------|----------------|----------------|-----|------------------------|----------|-----|-----|--|
| DESIGN PRESS.  | 400 Psig | FAB. LOCATION  | SHOP           |     |                        |          |     |     |  |
| DESIGN TEMP.   | 150 °F   | SPOOL LOCATION | SKID #2        |     |                        |          |     |     |  |
| OPER. PRESS.   | 175 Psig |                |                |     |                        |          |     |     |  |
| OPER. TEMP.    | 73 °F    | CORR. ALLOW.   | .0625"         | 1   | REVISED AS NOTED       | 02/06/12 | DV  | LH  |  |
| STRESS RELIEVE | NO       | INSULATION     | 1"H            | 0   | ISSUE FOR CONSTRUCTION | 04/25/11 | PLD | LH  |  |
| RADIOGRAPHY    | NONE     | PAINT          | TRCO SYSTEM #3 | NO. | REVISION               | DATE     | BY  | APR |  |

**CONFIDENTIAL STATEMENT**  
THIS DRAWING IS THE PROPERTY OF THE THOMAS RUSSELL CO. AND IS NOT TO BE USED FOR ANY PURPOSE OTHER THAN THAT FOR WHICH IT IS SPECIFICALLY FURNISHED.

**FABRICATION NOTES:**  
ALL VALVES ARE RANSED FACE UNLESS NOTED.  
ALL FITTING MAKE-UP & CUT LENGTHS FOR BW PIPE DO NOT INCLUDE WELD GAPS.  
SHOP TO MAKE ADJUSTMENTS FOR WELD GAPS.  
ALL PIPE SEAMLESS UNLESS NOTED OTHERWISE.  
ALL COUPLING TO BE SHOULDER ON.

**Thomas Russell Co.**  
7050 S. Yale, Suite 210  
Tulsa, Oklahoma 74138  
PH: 918-481-5682

|                  |                  |
|------------------|------------------|
| LIVE No.         | 198-B1-CS-1" 1"H |
| ASSEMBLY DRAWING | SC6-402          |
| FIELD DRAWING    | ***-233          |
| DRAWN BY         | DV               |
| DATE DRAWN       | 03/23/11         |
| JOB No.          | -SG6-            |
| SPOOL ID. No.    | SK2-020          |
| REV.             | 1                |

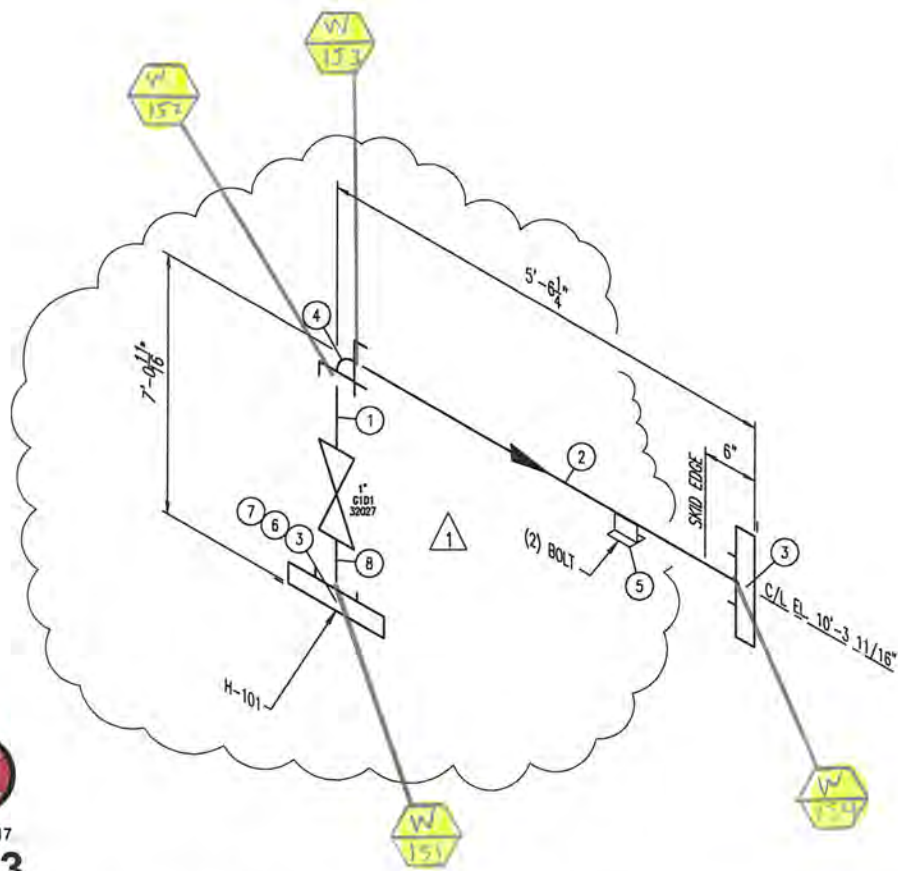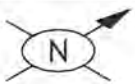

**BILL OF MATERIAL**

| MARK | QTY | SIZE | DESCRIPTION   | LENGTH     |
|------|-----|------|---|------------|
| 1    | 1   | 1"   | PIPE, S/160 SMLS, A-106-B POE-TOE   | 6'-4 1/4"  |
| 2    | 1   | 1"   | PIPE, S/160 SMLS, A-106-B PBE   | 5'-4 9/16" |
| 3    | 2   | 1"   | FLG, RFSW 600LB S/160, A-105  |            |
| 4    | 1   | 1"   | ELL, 90 SW, 3000LB FS, A-105  |            |
| 5    | 1   |      | PIPE SHOE, 6" LG x 3" HI FROM W6x15   |            |
| 6    | 1   | 1"   | GASKET, 1/8" THK, 600LB RF, SPIRALWOUND, 304SS WINDING, FLEXITE SUPER FILLER, CS GUIDE RING |            |
| 7    | 1   | 5/8" | (4) STUD BOLTS, A-193-B7 w/ TWD HEAVY HEX NUTS, A-194-2H                                    | 3 3/4"     |
| 8    | 1   | 1"   | PIPE, S/160 SMLS, A-106-B POE-TOE   | 4"         |



J-447  
12/19/16  
IFC

\*\*\* = JOB #

Oct 04, 2013 - 11:28am Z:\100 - Jobs\SC6\_60MM Cryo\17.0 Drawings\REV\_A\17.4 Piping\SPOOLS\Skid #2\



|                |           |                |                |     |                        |          |     |     |
|----------------|-----------|----------------|----------------|-----|------------------------|----------|-----|-----|
| DESIGN PRESS.  | 1100 Psig | FAB. LOCATION  | SHOP           |     |                        |          |     |     |
| DESIGN TEMP.   | 350 °F    | SPOOL LOCATION | SKID #2        |     |                        |          |     |     |
| OPER. PRESS.   | 515 Psig  |                |                |     |                        |          |     |     |
| OPER. TEMP.    | 120 °F    | CORR. ALLOW.   | .0625"         | 1   | REVISED AS SHOWN       | 2/7/12   | DV  | LH  |
| STRESS RELIEVE | NO        | INSULATION     | 1"H            | 0   | ISSUE FOR CONSTRUCTION | 04/25/11 | PLD | LH  |
| RADIOGRAPHY    | NONE      | PAINT          | TRCo SYSTEM #3 | NO. | REVISION               |          |     | APR |

**CONFIDENTIAL STATEMENT**  
THIS DRAWING IS THE PROPERTY OF THE THOMAS RUSSELL CO. AND IS NOT TO BE USED FOR ANY PURPOSE OTHER THAN THAT FOR WHICH IT IS SPECIALLY FURNISHED.

**FABRICATION NOTES:**  
ALL VALUES ARE BASED FACE UNLESS NOTED.  
ALL FITTING MAKE-UP & CUT LENGTHS FOR BW PIPE DO NOT INCLUDE WELD GAPS.  
SHOP TO MAKE ADJUSTMENTS FOR WELD GAPS.  
ALL PIPE SEAMLESS UNLESS NOTED OTHERWISE.  
ALL COUPLING TO BE SHOULDER OK.

**Thomas Russell Co.**  
7050 S. Yale, Suite 210  
Tulsa, Oklahoma 74136  
PH: 918-481-5682


|                  |                  |
|------------------|------------------|
| LINE No.         | 199-D1-CS-1" 1"H |
| ASSEMBLY DRAWING | SC6-402          |
| P&ID DRAWING     | ***-233          |
| DRAWN BY         | DV               |
| DATE DRAWN       | 03/22/11         |
| JOB No.          | SC6-             |
| SPOOL I.D. No.   | SK2-023          |
| REV.             | 1                |

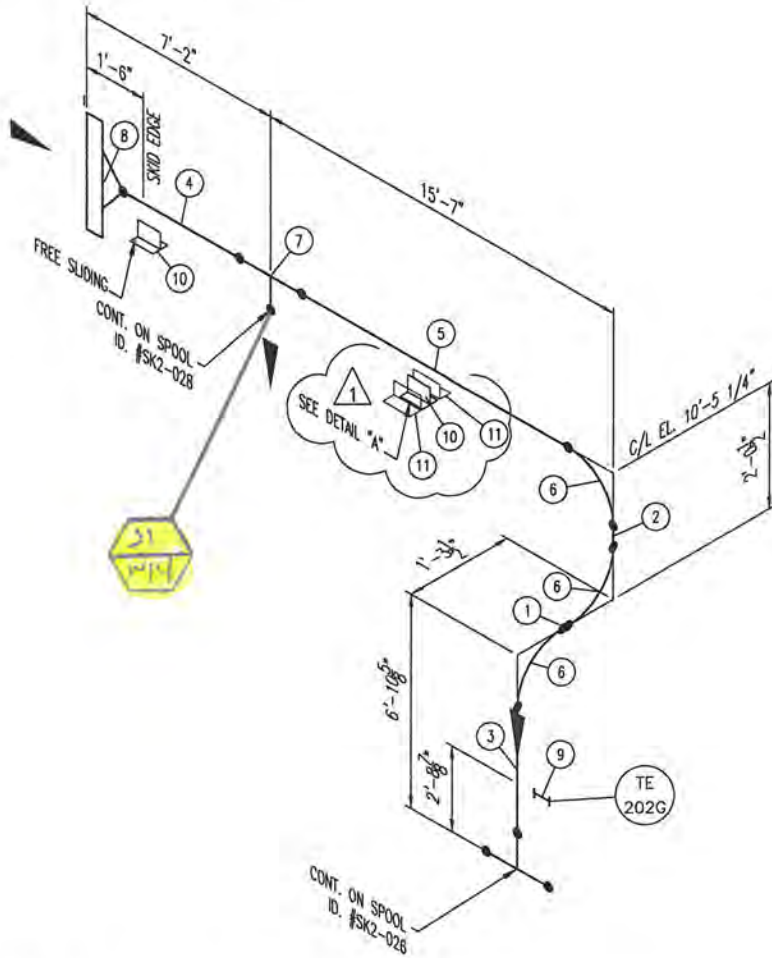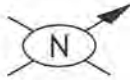

| BILL OF MATERIAL |     |       |  |            |  |
|------------------|-----|-------|--|------------|--|
| MARK             | QTY | SIZE  | DESCRIPTION                                    | LENGTH     |  |
| 1                | 1   | 4"    | PIPE, XH SMLS, A-106-B                         | 3 1/2"     |  |
| 2                | 1   | 4"    | PIPE, XH SMLS, A-106-B                         | 1'-0 1/2"  |  |
| 3                | 1   | 4"    | PIPE, XH SMLS, A-106-B                         | 6'-0 1/2"  |  |
| 4                | 1   | 4"    | PIPE, XH SMLS, A-106-B                         | 6'-5 1/16" |  |
| 5                | 1   | 4"    | PIPE, XH SMLS, A-106-B                         | 14'-8 7/8" |  |
| 6                | 3   | 4"    | ELL, 90 LR XH, A-234-WPB                       |            |  |
| 7                | 1   | 4"x3" | TEE, RED XH, A-234-WPB                         |            |  |
| 8                | 1   | 4"    | FLG, RTJWN 900LB XH, A-105                     |            |  |
| 9                | 1   | 3/4"  | CPLG, THRD, 3000LB FS, A-105                   |            |  |
| 10               | 2   |       | PIPE SHOE, 8" LG x 3" HI FROM W6x15            |            |  |
| 11               | 2   |       | ANGLE, 2" x 3" x 1/4" x 8" LG. A-36 PER DETAIL |            |  |



SEP 29 2017  
**J6733**

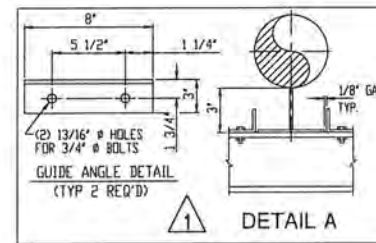

J-447  
 12/19/16  
 IFC

\*\*\* = JOB #

Jun 09, 2016 - 1:20pm Z:\400 - Drafting\001-PROJECTS\419 BRAZOS SC6 MAF\DRAWINGS\400-Piping\SPOOLS\CRIO REV\



|                |            |                |                |     |                                  |          |     |     |  |
|----------------|------------|----------------|----------------|-----|----------------------------------|----------|-----|-----|--|
| DESIGN PRESS.  | 1440 Psig  | FAB. LOCATION  | SHOP           |     |                                  |          |     |     |  |
| DESIGN TEMP.   | 200°F      | SPOOL LOCATION | SKID #2        |     |                                  |          |     |     |  |
| OPER. PRESS.   | 740 Psia   |                |                |     |                                  |          |     |     |  |
| OPER. TEMP.    | 27°F       | CORR. ALLOW.   | .0625"         | 1   | ADDED GUIDE & ITEM #11 W/ DETAIL | 05/26/16 | LG  | LH  |  |
| STRESS RELIEVE | NO         | INSULATION     | 1"C            | 0   | ISSUE FOR CONSTRUCTION           | 04/25/11 | PLO | LH  |  |
| RADIOGRAPHY    | 15% NORMAL | PAINT          | TRCo SYSTEM #3 | NO. | REVISION                         | DATE     | BY  | APR |  |

**CONFIDENTIAL STATEMENT**  
 THIS DRAWING IS THE PROPERTY OF THE THOMAS RUSSELL Co. AND IS NOT TO BE USED FOR ANY PURPOSE OTHER THAN THAT FOR WHICH IT IS SPECIFICALLY FURNISHED.

**FABRICATION NOTES:**  
 ALL VALVES ARE RASSED FACE UNLESS NOTED.  
 ALL FITTING MAKE-UP & CUT LENGTHS FOR BW PIPE DO NOT INCLUDE WELD GAPS.  
 SHOP TO MAKE ADJUSTMENTS FOR WELD GAPS.  
 ALL PIPE SEAMLESS UNLESS NOTED OTHERWISE.  
 ALL COUPLING TO BE SHOULDED ON.


**Thomas Russell Co.**  
 7050 S. Yale, Suite 210  
 Tulsa, Oklahoma 74136  
 PH: 918-481-5682

|                  |                  |
|------------------|------------------|
| LINE No.         | 215-E1-CS-4" 1"C |
| ASSEMBLY DRAWING | SC6-402          |
| PROD DRAWING     | ***-231/236      |
| DRAWN BY         | DV               |
| DATE DRAWN       | 03/22/11         |
| JOB No.          | SC6-             |
| SPOOL ID. No.    | SK2-027          |
| REV.             | 1                |

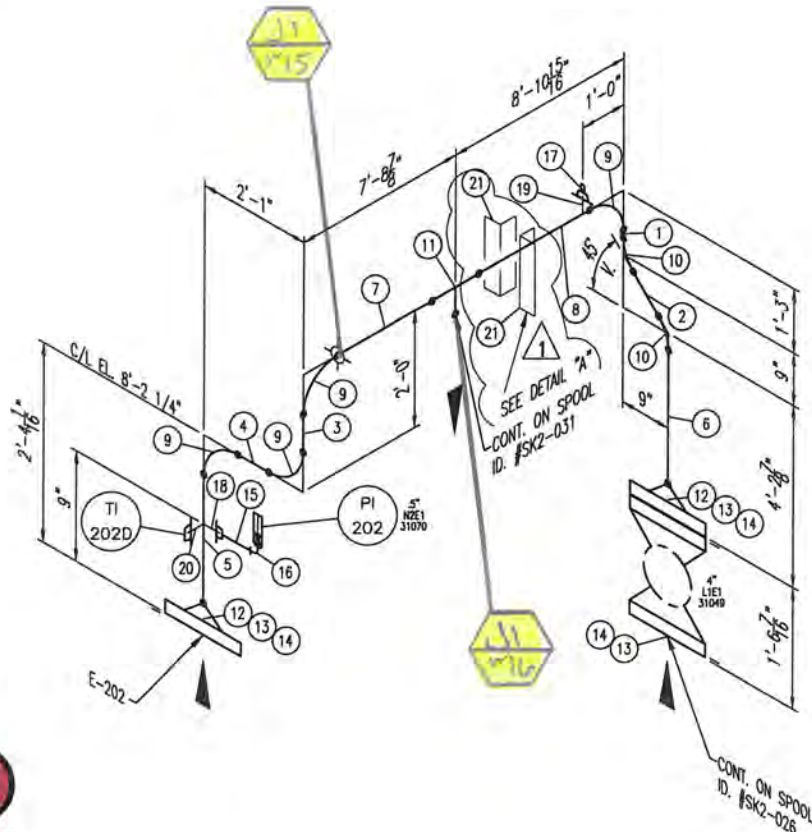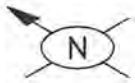

**BILL OF MATERIAL**

| MARK | QTY | SIZE    | DESCRIPTION  | LENGTH      |
|------|-----|---------|--|-------------|
| 1    | 1   | 4"      | PIPE, XH SMLS, A-106-B                                   | 6 1/2"      |
| 2    | 1   | 4"      | PIPE, XH SMLS, A-106-B                                   | 7 11/16"    |
| 3    | 1   | 4"      | PIPE, XH SMLS, A-106-B                                   | 1'-0"       |
| 4    | 1   | 4"      | PIPE, XH SMLS, A-106-B                                   | 1'-1"       |
| 5    | 1   | 4"      | PIPE, XH SMLS, A-106-B                                   | 1'-5 1/4"   |
| 6    | 1   | 4"      | PIPE, XH SMLS, A-106-B                                   | 3'-7 9/16"  |
| 7    | 1   | 4"      | PIPE, XH SMLS, A-106-B                                   | 6'-10 3/4"  |
| 8    | 1   | 4"      | PIPE, XH SMLS, A-106-B                                   | 8'-0 13/16" |
| 9    | 4   | 4"      | ELL, 90 LR XH, A-234-WPB                                 |             |
| 10   | 2   | 4"      | ELL, 45 LR XH, A-234-WPB                                 |             |
| 11   | 1   | 4"      | TEE, STR. XH, A-234-WPB                                  |             |
| 12   | 2   | 4"      | FLG, RTJWN 900LB XH, A-105                               |             |
| 13   | 3   | 1 1/8"  | (8) STUD BOLTS, A-193-B7 w/ TWO HEAVY HEX NUTS, A-194-2H | 7"          |
| 14   | 3   | 4"      | GASKET, RTJ, 900LB R37                                   |             |
| 15   | 1   | 1/2"    | NIPPLE, S/160 SMLS, A-106-B POE-TOE                      | 6"          |
| 16   | 1   | 1/2"    | ELL, 90 THRD. 3000LB FS, A-105                           |             |
| 17   | 1   | 1/2"    | PLUG, SOLID STEEL, ROUND HEAD, A-105                     |             |
| 18   | 1   | 4"x1/2" | SOL, 3000LB FS, A-105                                    |             |
| 19   | 1   | 4"x1/2" | TOL, 3000LB FS, A-105                                    |             |
| 20   | 1   | 4"x3/4" | TOL, 3000LB FS, A-105                                    |             |
| 21   | 2   |         | ANGLE, 2" x 2" x 1/4" x 3" LG. A-36                      |             |

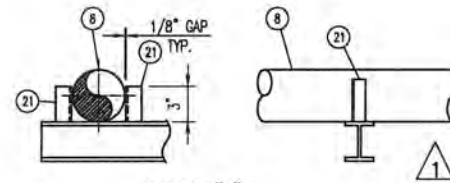

**DETAIL "A"**  
SCALE N.T.S.



\*\*\* = JOB #

SHOP WELD



SEP 29 2017  
**J6733**

Jun 09, 2016 - 1:20pm Z:\400 - Drafting\001-PROJECTS\419 BRAZOS SC6 MAFT\DRAWINGS\400-Piping\SPOOLS\CRYO REV\

|                |            |                |                |     |                          |          |     |     |
|----------------|------------|----------------|----------------|-----|--------------------------|----------|-----|-----|
| DESIGN PRESS.  | 1440 Psig  | FAB. LOCATION  | SHOP           |     |                          |          |     |     |
| DESIGN TEMP.   | 200°F      | SPOOL LOCATION | SKID #2        |     |                          |          |     |     |
| OPER. PRESS.   | 735 Psia   |                |                |     |                          |          |     |     |
| OPER. TEMP.    | 56°F       | CORR. ALLOW.   | .0625"         | 1   | ADDED ITEM #21 W/ DETAIL | 5/31/16  | LG  | LH  |
| STRESS RELIEVE | NO         | INSULATION     | NONE           | 0   | ISSUE FOR CONSTRUCTION   | 04/25/11 | PLD | LH  |
| RADIOGRAPHY    | 15% NORMAL | PAINT          | TRCO SYSTEM #3 | NO. | REVISION                 | DATE     | BY  | APR |



**CONFIDENTIAL STATEMENT**  
THIS DRAWING IS THE PROPERTY OF THE THOMAS RUSSELL CO. AND IS NOT TO BE USED FOR ANY PURPOSE OTHER THAN THAT FOR WHICH IT IS SPECIFICALLY FURNISHED.

**FABRICATION NOTES:**  
ALL WELDS ARE FINISHED FACE UNLESS NOTED.  
ALL FITTING MAKE-UP & CUT LENGTHS FOR BW PIPE DO NOT INCLUDE WELD GAPS.  
SHOP TO MAKE ADJUSTMENTS FOR WELD GAPS.  
ALL PIPE SEAMLESS UNLESS NOTED OTHERWISE.  
ALL COUPLING TO BE SHOULDER ON.

**Thomas Russell Co.**  
7050 S. Yale, Suite 210  
Tulsa, Oklahoma 74136  
PH: 918-481-5682

|                  |              |               |          |
|------------------|--------------|---------------|----------|
| LINE No.         | 216-E1-CS-4" |               |          |
| ASSEMBLY DRAWING | SC6-402      |               |          |
| PLD DRAWING      | ***-231      |               |          |
| DRAWN BY         | DV           | DATE DRAWN    | 03/22/11 |
| JOB No.          | SC6-         | SPOOL ID. No. | SK2-030  |
| REV.             |              |               | 1        |



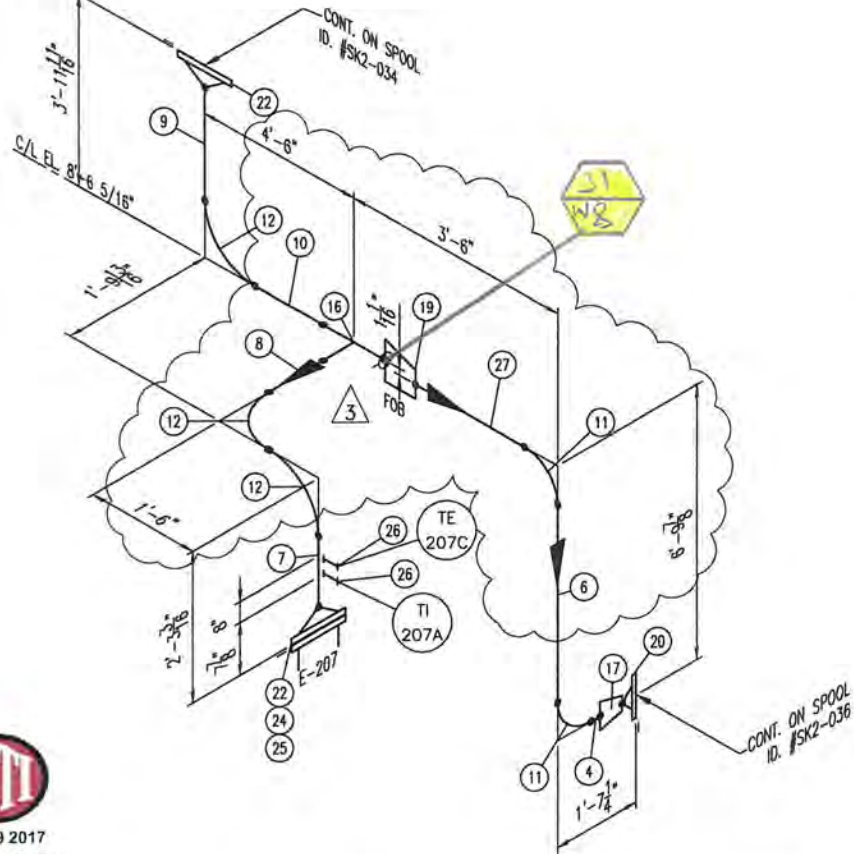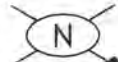

SHOP WELD

BILL OF MATERIAL

| MARK | QTY | SIZE  | DESCRIPTION   | LENGTH      |
|------|-----|-------|---|-------------|
| 1    |     |       |   |             |
| 2    |     |       |   |             |
| 3    |     |       |   |             |
| 4    | 1   | 4"    | PIPE, STD SMLS, A-106-B   | 6 3/4"      |
| 5    | 1   | 4"    | PIPE, STD SMLS, A-106-B   | 8 3/4"      |
| 6    | 1   | 4"    | PIPE, STD SMLS, A-106-B   | 5'-9 7/8"   |
| 7    | 1   | 6"    | PIPE, STD SMLS, A-106-B   | 1'-2 11/16" |
| 8    | 1   | 6"    | PIPE, STD SMLS, A-106-B   | 7 3/16"     |
| 9    | 1   | 6"    | PIPE, STD SMLS, A-106-B   | 2'-11 3/16" |
| 10   | 1   | 6"    | PIPE, STD SMLS, A-106-B   | 3'-3 3/8"   |
| 11   | 2   | 4"    | ELL, 90 LR STD, A-234-WPB   |             |
| 12   | 3   | 6"    | ELL, 90 LR STD, A-234-WPB   |             |
| 13   |     |       |   |             |
| 14   |     |       |   |             |
| 15   |     |       |   |             |
| 16   | 1   | 6"    | TEE, STR. STD, A-234-WPB  |             |
| 17   | 1   | 4"x2" | REDUCER, CONC STD - XH, A-234-WPB   |             |
| 18   |     |       |   |             |
| 19   | 1   | 6"x4" | REDUCER, ECC STD, A-234-WPB   |             |
| 20   | 1   | 2"    | FLG, RFWN 150LB XH, A-105   |             |
| 21   |     |       |   |             |
| 22   | 2   | 6"    | FLG, RFWN 150LB STD, A-105  |             |
| 23   |     |       |   |             |
| 24   | 1   | 3/4"  | (8) STUD BOLTS, A-193-B7 w/ TWO HEAVY HEX NUTS, A-194-2H                                    | 4 3/4"      |
| 25   | 1   | 6"    | GASKET, 1/8" THK, 150LB RF, SPIRALWOUND, 304SS WINDING, FLEXITE SUPER FILLER, CS GUIDE RING |             |
| 26   | 2   | 3/4"  | CPLG, TOE x 2 1/2" LG, 3000LB FS, A-105   |             |
| 27   | 1   | 4"    | PIPE, STD SMLS, A-106-B   | 2'-0 7/8"   |

J-447  
12/19/16  
IFC

\*\*\* = JOB #



Oct 04, 2013 - 11:29am Z:\100 - Job\SC6\_60MM Cryo\17.0 Drawings\REV\_A\17.4 Piping\SPOOLS\Skid #2\

| DESIGN PRESS.  | 150 Psig   | FAB. LOCATION  | SHOP           |     |                          |          |     |     |
|----------------|------------|----------------|----------------|-----|--------------------------|----------|-----|-----|
| DESIGN TEMP.   | 400 °F     | SPOOL LOCATION | SKID #2        | 3   | REVISED & REMOVED PIPING | 10/03/13 | MSD | KK  |
| OPER. PRESS.   | 50 Psia    |                |                | 2   | REVISED AS NOTED         | 2/9/12   | DV  | LH  |
| OPER. TEMP.    | 300 °F     | CORR. ALLOW.   | .0625"         | 1   | REVISED AS NOTED         | 12/27/11 | DV  | LH  |
| STRESS RELIEVE | NO         | INSULATION     | 2"H            | 0   | ISSUE FOR CONSTRUCTION   | 04/25/11 | PLO | LH  |
| RADIOGRAPHY    | 15% NORMAL | PAINT          | TRCo SYSTEM #2 | NO. | REVISION                 | DATE     | BY  | APR |

**CONFIDENTIAL STATEMENT**  
THIS DRAWING IS THE PROPERTY OF THE THOMAS RUSSELL CO. AND IS NOT TO BE USED FOR ANY PURPOSE OTHER THAN THAT FOR WHICH IT IS SPECIFICALLY FURNISHED.  
**FABRICATION NOTES:**  
ALL VALUES ARE ROUNDED UP UNLESS NOTED.  
ALL FITTING MAKE-UP & CUT LENGTHS FOR ON PIPE DO NOT INCLUDE WELD GAPS.  
SHOP TO MAKE ADJUSTMENTS FOR WELD GAPS.  
ALL PIPE SEAMLESS UNLESS NOTED OTHERWISE.  
ALL COUPLING TO BE SHOULDED ON.


**Thomas Russell Co.**  
7050 S. Yale, Suite 210  
Tulsa, Oklahoma 74136  
PH: 918-481-5682

|                  |                  |               |          |
|------------------|------------------|---------------|----------|
| LINE No.         | 611-A1-CS-6" 2"H |               |          |
| ASSEMBLY DRAWING | SC6-402          |               |          |
| PART DRAWING     | ***-291          |               |          |
| DRAWN BY         | DV               | DATE DRAWN    | 03/22/11 |
| JOB No.          | SC6              | SPOOL ID. No. | SK2-033  |
|                  |                  |               | 3        |

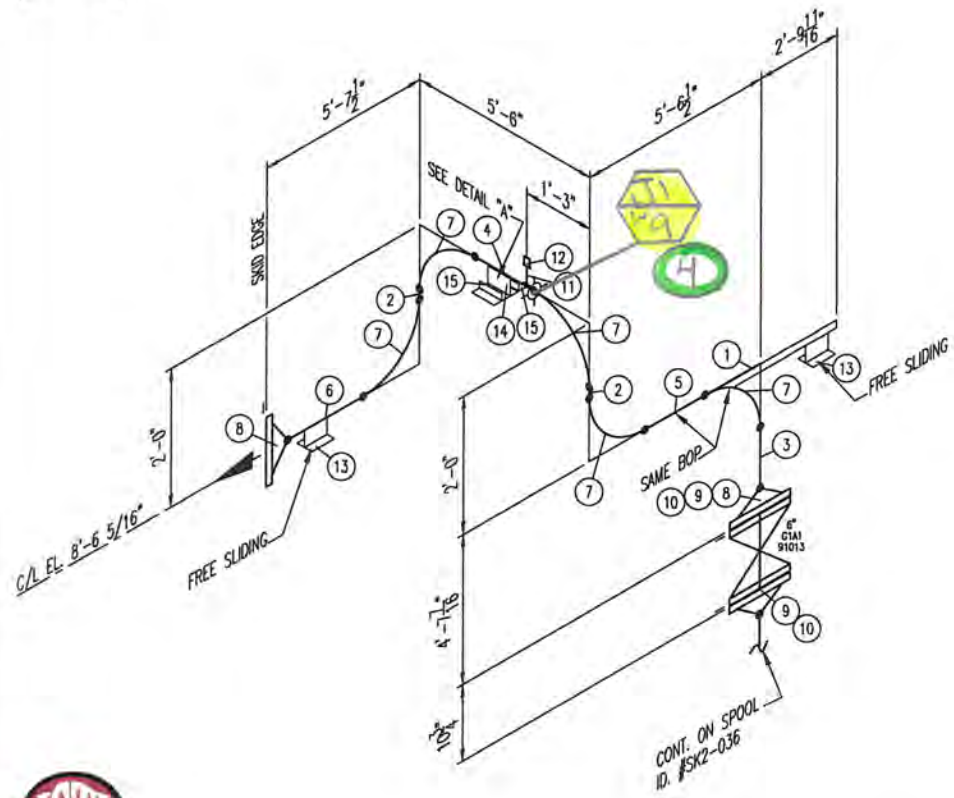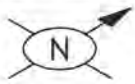

**BILL OF MATERIAL**

| MARK | QTY | SIZE | DESCRIPTION   | LENGTH      |
|------|-----|------|---|-------------|
| 1    | 1   | 3"   | PIPE, STD SMLS, A-106-B   | 3'-6 11/16" |
| 2    | 2   | 6"   | PIPE, STD SMLS, A-106-B   | 6"          |
| 3    | 1   | 6"   | PIPE, STD SMLS, A-106-B   | 3'-6 15/16" |
| 4    | 1   | 6"   | PIPE, STD SMLS, A-106-B   | 4'-0"       |
| 5    | 1   | 6"   | PIPE, STD SMLS, A-106-B   | 4'-0 1/2"   |
| 6    | 1   | 6"   | PIPE, STD SMLS, A-106-B   | 4'-7"       |
| 7    | 5   | 6"   | ELL, 90 LR STD, A-234-WPB   |             |
| 8    | 2   | 6"   | FLG, RFWN 150LB STD, A-105  |             |
| 9    | 2   | 3/4" | (8) STUD BOLTS, A-193-B7 w/ TWO HEAVY HEX NUTS, A-194-2H                                    | 4 1/4"      |
| 10   | 2   | 6"   | GASKET, 1/8" THK, 150LB RF, SPIRALWOUND, 304SS WINDING, FLEXITE SUPER FILLER, CS GUIDE RING |             |
| 11   | 1   | 1/2" | CPLG, TOE x 2 1/2" LG, 3000LB FS, A-105   |             |
| 12   | 1   | 1/2" | PLUG, SOLID STEEL, ROUND HEAD, A-105  |             |
| 13   | 2   |      | PIPE SHOE, 6" LG x 3" HI FROM W6x15   |             |
| 14   | 1   |      | PIPE SHOE, 8" LG x 3" HI FROM W6x15   |             |
| 15   | 2   |      | ANGLE, 3" x 2" x 1/4" x 8" LG. (DRILL PER DETAIL)   |             |

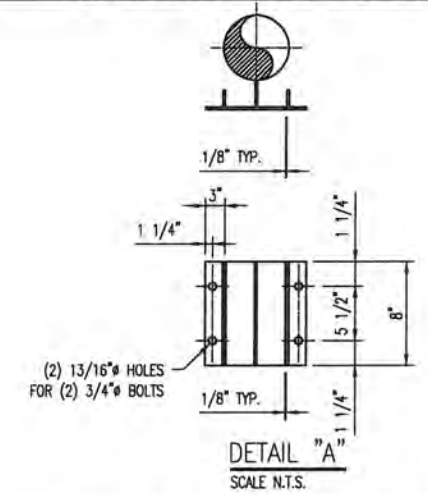

J-447  
12/19/16  
IFC

\*\*\* = JOB #

SHOP WELD

**IST**  
SEP 29 2017  
**J6733**

Oct 04, 2013 - 11:29am Z:\100 - Jobs\SC6\_60MM Cryo\17.0 Drawings\REV\_A\17.4 Piping\SPOOLS\Skid #2\

|                |            |                |                |     |                        |          |        |
|----------------|------------|----------------|----------------|-----|------------------------|----------|--------|
| DESIGN PRESS.  | 150 Psig   | FAB. LOCATION  | SHOP           |     |                        |          |        |
| DESIGN TEMP.   | 400 °F     | SPOOL LOCATION | SKID #2        |     |                        |          |        |
| OPER. PRESS.   | 40 Psig    |                |                |     |                        |          |        |
| OPER. TEMP.    | 200 °F     | CORR. ALLOW.   | .0625"         |     |                        |          |        |
| STRESS RELIEVE | NO         | INSULATION     | 2"H            | 0   | ISSUE FOR CONSTRUCTION | 04/25/11 | PLD LH |
| RADIOGRAPHY    | 15% NORMAL | PAINT          | TRCo SYSTEM #2 | NO. | REVISION               | DATE     | BY     |

**CONFIDENTIAL STATEMENT**  
THIS DRAWING IS THE PROPERTY OF THE THOMAS RUSSELL CO. AND IS NOT TO BE USED FOR ANY PURPOSE OTHER THAN THAT FOR WHICH IT IS SPECIFICALLY FURNISHED.



**FABRICATION NOTES:**  
ALL VALUES ARE ROUNDED UP UNLESS NOTED.  
ALL FITTING MAKE-UP & CUT LENGTHS FOR BW PIPE DO NOT INCLUDE WELD OAPS.  
SHOP TO MAKE ADJUSTMENTS FOR WELD OAPS.  
ALL PIPE SEAMLESS UNLESS NOTED OTHERWISE.  
ALL COUPLING TO BE SHOULDER ON.

**Thomas Russell Co.**  
7050 S. Yale, Suite 210  
Tulsa, Oklahoma 74138  
PH: 918-481-5882


|                  |                  |
|------------------|------------------|
| LINE NO.         | 614-A1-CS-6" 2"H |
| ASSEMBLY DRAWING | SC6-402          |
| P&ID DRAWING     | ***-291          |
| DRAWN BY         | DV               |
| DATE DRAWN       | 03/22/11         |
| JOB NO.          | -SG6-            |
| SPOOL ID. NO.    | SK2-037          |
| REV.             | 0                |





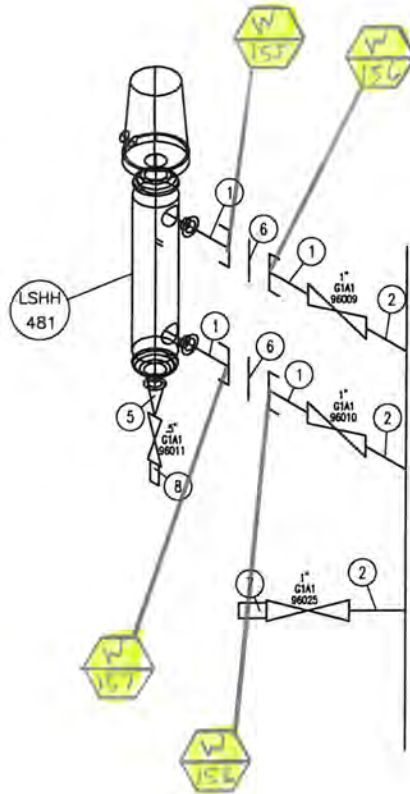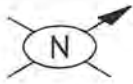

V-481

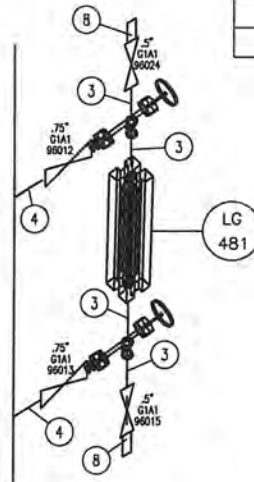

BILL OF MATERIAL

| MARK | QTY | SIZE    | DESCRIPTION                          | LENGTH |
|------|-----|---------|--------------------------------------|--------|
| 1    | 4   | 1"      | NIPPLE, XH SMLS, A-106-B POE-TOE     | 4"     |
| 2    | 3   | 1"      | NIPPLE, XH SMLS, A-106-B TBE         | 4"     |
| 3    | 4   | 1/2"    | NIPPLE, S/160 SMLS, A-106-B TBE      | 3"     |
| 4    | 2   | 3/4"    | NIPPLE, XH SMLS, A-106-B TBE         | 3"     |
| 5    | 1   | 1"x1/2" | SWAGE, CONC, S/160, A-106-B TLE-TSE  |        |
| 6    | 2   | 1"      | UNION, SW, 3000LB FS, A-105          |        |
| 7    | 1   | 1"      | PLUG, SOLID STEEL, ROUND HEAD, A-105 |        |
| 8    | 3   | 1/2"    | PLUG, SOLID STEEL, ROUND HEAD, A-105 |        |



SEP 29 2017

J6733



\*\*\* = JOB #

Oct 04, 2013 - 11:29am Z:\100 - Jobs\SC6\_60MM Cryo\17.0 Drawings\REV\_A\17.4 Piping\SPOOLS\Skid #2\

|                |          |                |                |     |                        |          |     |     |
|----------------|----------|----------------|----------------|-----|------------------------|----------|-----|-----|
| DESIGN PRESS.  | 150 Psig | FAB. LOCATION  | SHOP           |     |                        |          |     |     |
| DESIGN TEMP.   | 150 °F   | SPOOL LOCATION | SKID #2        |     |                        |          |     |     |
| OPER. PRESS.   | 100 Psig |                |                |     |                        |          |     |     |
| OPER. TEMP.    | 105 °F   | CORR. ALLOW.   | .0625"         |     |                        |          |     |     |
| STRESS RELIEVE | NO       | INSULATION     | 1"H W/ET       | 0   | ISSUE FOR CONSTRUCTION | 04/25/11 | PLD | LH  |
| RADIOGRAPHY    | NONE     | PAINT          | TRCo SYSTEM #3 | NO. | REVISION               |          |     | APR |



**CONFIDENTIAL STATEMENT**  
 THIS DRAWING IS THE PROPERTY OF THE THOMAS RUSSELL CO. AND IS NOT TO BE USED FOR ANY PURPOSE OTHER THAN THAT FOR WHICH IT IS SPECIFICALLY FURNISHED.

**FABRICATION NOTES:**  
 ALL VALUES ARE BASED FACE UNLESS NOTED.  
 ALL FITTING MAKE-UP & CUT LENGTHS FOR DW PIPE DO NOT INCLUDE WELD GAPS.  
 SHOP TO MAKE ADJUSTMENTS FOR WELD GAPS.  
 ALL PIPE SEAMLESS UNLESS NOTED OTHERWISE.  
 ALL COUPLING TO BE SADDLED ON.

**Thomas Russell Co.**  
 7050 S. Yale, Suite 210  
 Tulsa, Oklahoma 74136  
 PH: 918-481-5682

|                  |                    |               |          |
|------------------|--------------------|---------------|----------|
| LINE No.         | V-481 TRIM (A1-CS) |               |          |
| ASSEMBLY DRAWING | SC6-402            |               |          |
| PART DRAWING     | ***-296            |               |          |
| DRAWN BY         | DV                 | DATE DRAWN    | 03/22/11 |
| JOB No.          | -SC6-              | SPOOL ID. No. | SK2-044  |
| REV.             |                    |               | 0        |

447

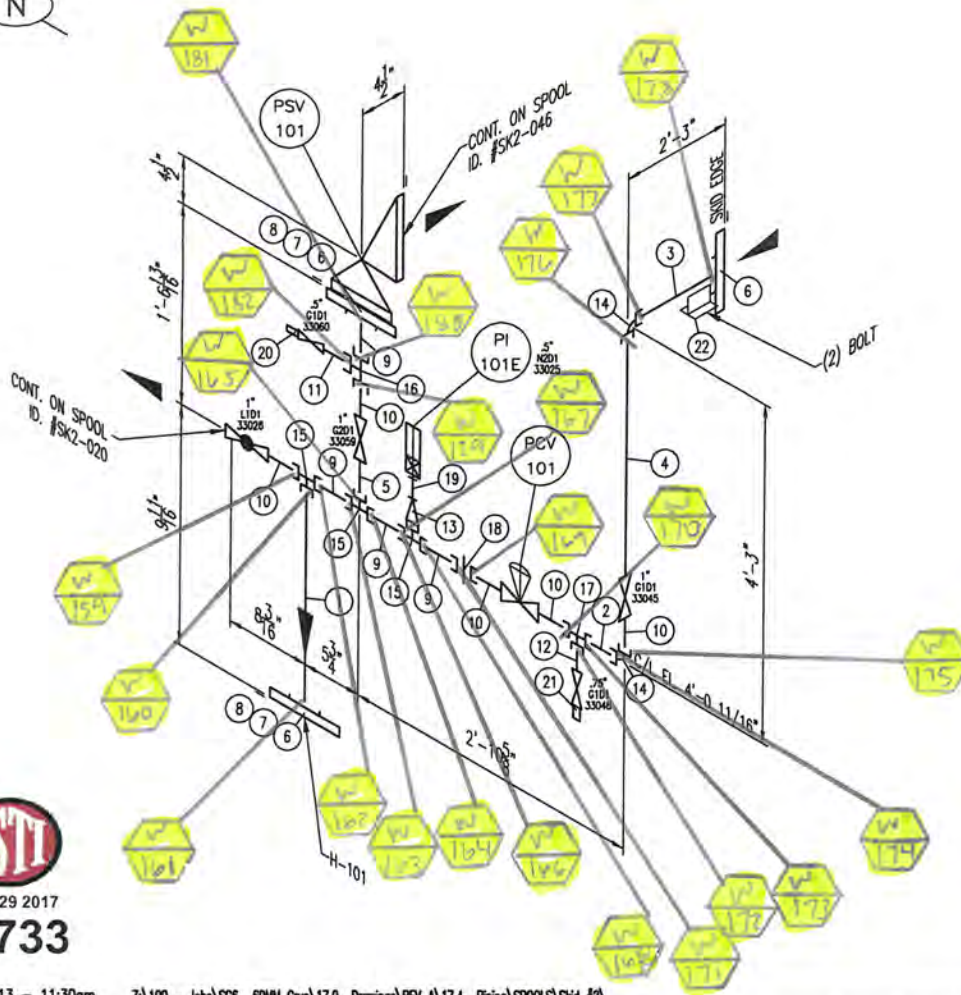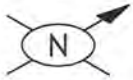

BILL OF MATERIAL

| MARK | QTY | SIZE      | DESCRIPTION   | LENGTH     |
|------|-----|-----------|---|------------|
| 1    | 1   | 1"        | PIPE, S/160 SMLS, A-106-B PBE   | 8"         |
| 2    | 1   | 1"        | PIPE, S/160 SMLS, A-106-B PBE   | 9 1/8"     |
| 3    | 1   | 1"        | PIPE, S/160 SMLS, A-106-B PBE   | 2'-1 5/16" |
| 4    | 1   | 1"        | PIPE, S/160 SMLS, A-106-B POE-TOE   | 3'-6 9/16" |
| 5    | 1   | 1"        | PIPE, S/160 SMLS, A-106-B POE-TOE   | 4 7/8"     |
| 6    | 3   | 1"        | FLG, RFSW 600LB S/160, A-105  |            |
| 7    | 2   | 5/8"      | (4) STUD BOLTS, A-193-B7 w/ TWO HEAVY HEX NUTS, A-194-2H                                    | 3 3/4"     |
| 8    | 2   | 1"        | GASKET, 1/8" THK, 600LB RF, SPIRALWOUND, 304SS WINDING, FLEXITE SUPER FILLER, CS GUIDE RING |            |
| 9    | 4   | 1"        | NIPPLE, S/160 SMLS, A-106-B PBE   | 4"         |
| 10   | 5   | 1"        | NIPPLE, S/160 SMLS, A-106-B POE-TOE   | 4"         |
| 11   | 1   | 1/2"      | NIPPLE, S/160 SMLS, A-106-B POE-TOE   | 3"         |
| 12   | 1   | 3/4"      | NIPPLE, S/160 SMLS, A-106-B POE-TOE   | 3"         |
| 13   | 1   | 1"x1/2"   | SWAGE, CONC, S/160, A-106-B PLE-TSE   |            |
| 14   | 2   | 1"        | ELL, 90 SW, 3000LB FS, A-105  |            |
| 15   | 3   | 1"        | TEE, SW, 3000LB FS, A-105   |            |
| 16   | 1   | 1" x 1/2" | TEE, RED SW, 3000LB FS, A-105   |            |
| 17   | 1   | 1" x 3/4" | TEE, RED, SW, 3000LB FS, A-105  |            |
| 18   | 1   | 1"        | UNION, SW, 3000LB FS, A-105   |            |
| 19   | 1   | 1/2"      | CPLG, THRD, 3000LB FS, A-105  |            |
| 20   | 1   | 1/2"      | PLUG, SOLID STEEL, ROUND HEAD, A-105  |            |
| 21   | 1   | 3/4"      | PLUG, SOLID STEEL, ROUND HEAD, A-105  |            |
| 22   | 1   |           | PIPE SHOE, 6" LG x 3" HI FROM W6x15   |            |



SEP 29 2017

J6733

J-447  
12/19/16  
IFC

\*\*\* = JOB #

Oct 04, 2013 - 11:30am Z:\100 - Jobs\SC6\_60MM Cryo\17.0 Drawings\REV\_A\17.4 Piping\SPOOLS\Skid #2\

|                |           |                |                |     |                        |        |        |
|----------------|-----------|----------------|----------------|-----|------------------------|--------|--------|
| DESIGN PRESS.  | 1100 Psig | FAB. LOCATION  | SHOP           |     |                        |        |        |
| DESIGN TEMP.   | 150 °F    | SPOOL LOCATION | SKID #2        |     |                        |        |        |
| OPER. PRESS.   | 515 Psia  |                |                |     |                        |        |        |
| OPER. TEMP.    | 100 °F    | CORR. ALLOW.   | .0625"         |     |                        |        |        |
| STRESS RELIEVE | NO        | INSULATION     | 1"H            | 0   | ISSUE FOR CONSTRUCTION | 2/7/12 | DV LH  |
| RADIOGRAPHY    | NONE      | PAINT          | TRCo SYSTEM #3 | NO. | REVISION               | DATE   | BY APR |

**CONFIDENTIAL STATEMENT**  
THIS DRAWING IS THE PROPERTY OF THE THOMAS RUSSELL CO. AND IS NOT TO BE USED FOR ANY PURPOSE OTHER THAN THAT FOR WHICH IT IS SPECIFICALLY FURNISHED.

**FABRICATION NOTES:**  
ALL VALUES ARE ROUNDED UP UNLESS NOTED.  
ALL FITTING MAKE-UP & CUT LENGTHS FOR BIV PIPE DO NOT INCLUDE WELD GAPS.  
SHOP TO MAKE ADJUSTMENTS FOR WELD GAPS.  
ALL PIPE SEAMLESS UNLESS NOTED OTHERWISE.  
ALL COUPLING TO BE SADDLED ON.

**Thomas Russell Co.**

7050 S. Yale, Suite 210  
Tulsa, Oklahoma 74138  
PH: 918-481-5682

|                  |                  |
|------------------|------------------|
| LINE No.         | 197-D1-CS-1" 1"H |
| ASSEMBLY DRAWING | SC6-402          |
| PAGE DRAWING     | ***-233          |
| DRAWN BY         | DV               |
| DATE DRAWN       | 02/07/12         |
| JOB No.          | SC6-             |
| SPOOL ID. No.    | SK2-045          |
| REV.             | 0                |

**J-447**

**SK2 Assy**  
**Spools**

**ISTI**  
**NDE Test Reports**

# Advanced Inspection Technologies

## Radiographic Inspection Report

TOMER 15T1 LOC. Catrosa DATE 10-20-17 PAGE 1 OF 1  
 JOB# 6733 PART# 3-474 JR#2 P.O. \_\_\_\_\_  
 MAT'L CS CODE B31-3 NP PROC.# RT-1 ORIG. FILM  REPAIR FILM \_\_\_\_\_  
 TRAVEL MILES \_\_\_\_\_ TRAVEL HRS. \_\_\_\_\_ WORK HRS. \_\_\_\_\_ STANDBY HRS. \_\_\_\_\_ TOTAL HRS. \_\_\_\_\_  
 RADIOGRAPHER Byron Edmondson LEVEL II ASSISTANT Spotts LEVEL I  
 INTERPRETED BY Byron Edmondson

### TESTING VARIABLES

IR192     CO60     X-RAY    Ci 74 Kv \_\_\_\_\_ Ma \_\_\_\_\_ Focal Spot .135  
 PROCESSING:     MANUAL     AUTOMATIC    FILM/CASSETTE \_\_\_\_\_     SINGLE FILM     Comp Film  
 EXPOSURE:     DWE/SWV     DWE/DWV     SWE/SWV  
 FILM: TYPE F-29, 80 CLASS I SENSITIVITY 2-2T  
 FILM USAGE:    3-1/2 x 8-1/2 6    3-1/2 x 10 \_\_\_\_\_    3-1/2 x 17 \_\_\_\_\_    4-1/2 x 10 \_\_\_\_\_  
                   4-1/2 x 17 \_\_\_\_\_    7 x 8-1/2 \_\_\_\_\_    7 x 17 \_\_\_\_\_    8 x 10 \_\_\_\_\_  
                   14 x 17 \_\_\_\_\_    70 MM \_\_\_\_\_    OTHER \_\_\_\_\_

| FILM ID | INTERVAL | I.Q.I | SHIM | MAT. THK. | WELD THK. | REINF. | OFD | SOD  | DIA. | DEN. | DISCONTINUITIES | ACCEPT                              | REJECT |
|---------|----------|-------|------|-----------|-----------|--------|-----|------|------|------|-----------------|-------------------------------------|--------|
| ①W XR-6 | 100      | 8F    | -    | 482       | .557      | .125   | 557 | 643  | 6"   | 2.4  |                 | <input checked="" type="checkbox"/> |        |
| ②W XR-7 | V        | 15F   | 094  | 300       | .425      | L      | 425 | 3.45 | 3"   | L    |                 | <input checked="" type="checkbox"/> |        |
| 3       |          |       |      |           |           |        |     |      |      |      |                 |                                     |        |
| 4       |          |       |      |           |           |        |     |      |      |      |                 |                                     |        |
| 5       |          |       |      |           |           |        |     |      |      |      |                 |                                     |        |
*Jonathan Cantillo*



# Advanced Inspection Technologies

## Radiographic Inspection Report

TOMER 1571 LOC. Catoosa DATE 10-10-17 PAGE 1 OF 1  
 JOB# 6733 PART# J-474 SR#2 P.O. \_\_\_\_\_  
 MAT'L CS CODE B31.3 NS PROC.# RT1 ORIG. FILM  REPAIR FILM \_\_\_\_\_  
 TRAVEL MILES \_\_\_\_\_ TRAVEL HRS. \_\_\_\_\_ WORK HRS. \_\_\_\_\_ STANDBY HRS. \_\_\_\_\_ TOTAL HRS. \_\_\_\_\_  
 RADIOGRAPHER Byron Edmondson LEVEL II ASSISTANT S Burks LEVEL I  
 INTERPRETED BY Byron Edmondson

### TESTING VARIABLES

IR192     CO60     X-RAY    Ci 80    Kv \_\_\_\_\_    Ma \_\_\_\_\_    Focal Spot 140  
 PROCESSING:     MANUAL     AUTOMATIC    FILM/CASSETTE \_\_\_\_\_     SINGLE FILM     Comp Film  
 EXPOSURE:     DWE/SWV     DWE/DWV     SWE/SWV  
 FILM: TYPE F-80    CLASS I    SENSITIVITY 2-2T  
 FILM USAGE:    3-1/2 x 8-1/2 3    3-1/2 x 10 \_\_\_\_\_    3-1/2 x 17 \_\_\_\_\_    4-1/2 x 10 \_\_\_\_\_  
                   4-1/2 x 17 \_\_\_\_\_    7 x 8-1/2 \_\_\_\_\_    7 x 17 \_\_\_\_\_    8 x 10 \_\_\_\_\_  
                   14 x 17 \_\_\_\_\_    70 MM \_\_\_\_\_    OTHER \_\_\_\_\_

| FILM ID          | INTERVAL    | I.Q.I     | SHIM     | MAT. THK.   | WELD THK.   | REINF.      | OFD        | SOD         | DIA.      | DEN.       | DISCONTINUITIES | ACCEPT                              | REJECT |
|------------------|-------------|-----------|----------|-------------|-------------|-------------|------------|-------------|-----------|------------|-----------------|-------------------------------------|--------|
| 1 <u>J1 XR-4</u> | <u>1000</u> | <u>BF</u> | <u>-</u> | <u>.280</u> | <u>.405</u> | <u>.125</u> | <u>405</u> | <u>6545</u> | <u>6"</u> | <u>2.4</u> |                 | <input checked="" type="checkbox"/> |        |
| 2                |             |           |          |             |             |             |            |             |           |            |                 |                                     |        |
| 3                |             |           |          |             |             |             |            |             |           |            |                 |                                     |        |
*Jonathan Casfile*



**J-447**

**SK2 Assy**  
**Spools**

**ISTI**  
**Pressure Test Reports**



**PLANT SERVICES**

# PNEUMATIC TEST FORM

TEST PACKAGE # 06

ISTI Client UOP Russell LLC.

ISTI Job# J-6733

TEST PRESSURE 440 psi

TEST MEDIA Nitrogen

## PRE-PNEUMATIC

Test Supervisor Jerry Allen

Date: 10/31/2017

ISTI Quality Rep. Rod Holden

Date: 10/31/2017

## PNEUMATIC TEST START

Date: 10/31/2017  
Time: 3:05 PM

Test Gauge # Digital  
576360

## PNEUMATIC TEST COMPLETE

Date: 10/31/2017  
Time: 4:15 PM

Chart Recorder# 0-1000 psi  
08176

Test Supervisor Jerry Allen

Date: 10/31/2017

ISTI Quality Rep. Rod Holden

Date: 10/31/2017

## POST -PNEUMATIC

System Piping Dried Date: 10/31/2017

Test Supervisor Jerry Allen


Date: 10/31/2017

ISTI Quality Rep. Rod Holden

Date: 10/31/2017

ISTI Plant Services J-6733  
Client: UOP Russell

| Spool ID    | TEST # | Test Date  | Test Pressure |
|-------------|--------|------------|---------------|
| SK2-012     | TP#6   | 10/31/2017 | 440           |
| SK2-014     | TP#6   | 10/31/2017 | 440           |
| SK2-015     | TP#6   | 10/31/2017 | 440           |
| SK2-018     | TP#6   | 10/31/2017 | 440           |
| SK2-020     | TP#6   | 10/31/2017 | 440           |
| SK2-021-PC2 | TP#6   | 10/31/2017 | 440           |
| SK2-024     | TP#6   | 10/31/2017 | 440           |
| SK2-025     | TP#6   | 10/31/2017 | 440           |
| SK2-029     | TP#6   | 10/31/2017 | 440           |
| SK2-040     | TP#6   | 10/31/2017 | 440           |
| SK3-001     | TP#6   | 10/31/2017 | 440           |
| SK3-002     | TP#6   | 10/31/2017 | 440           |

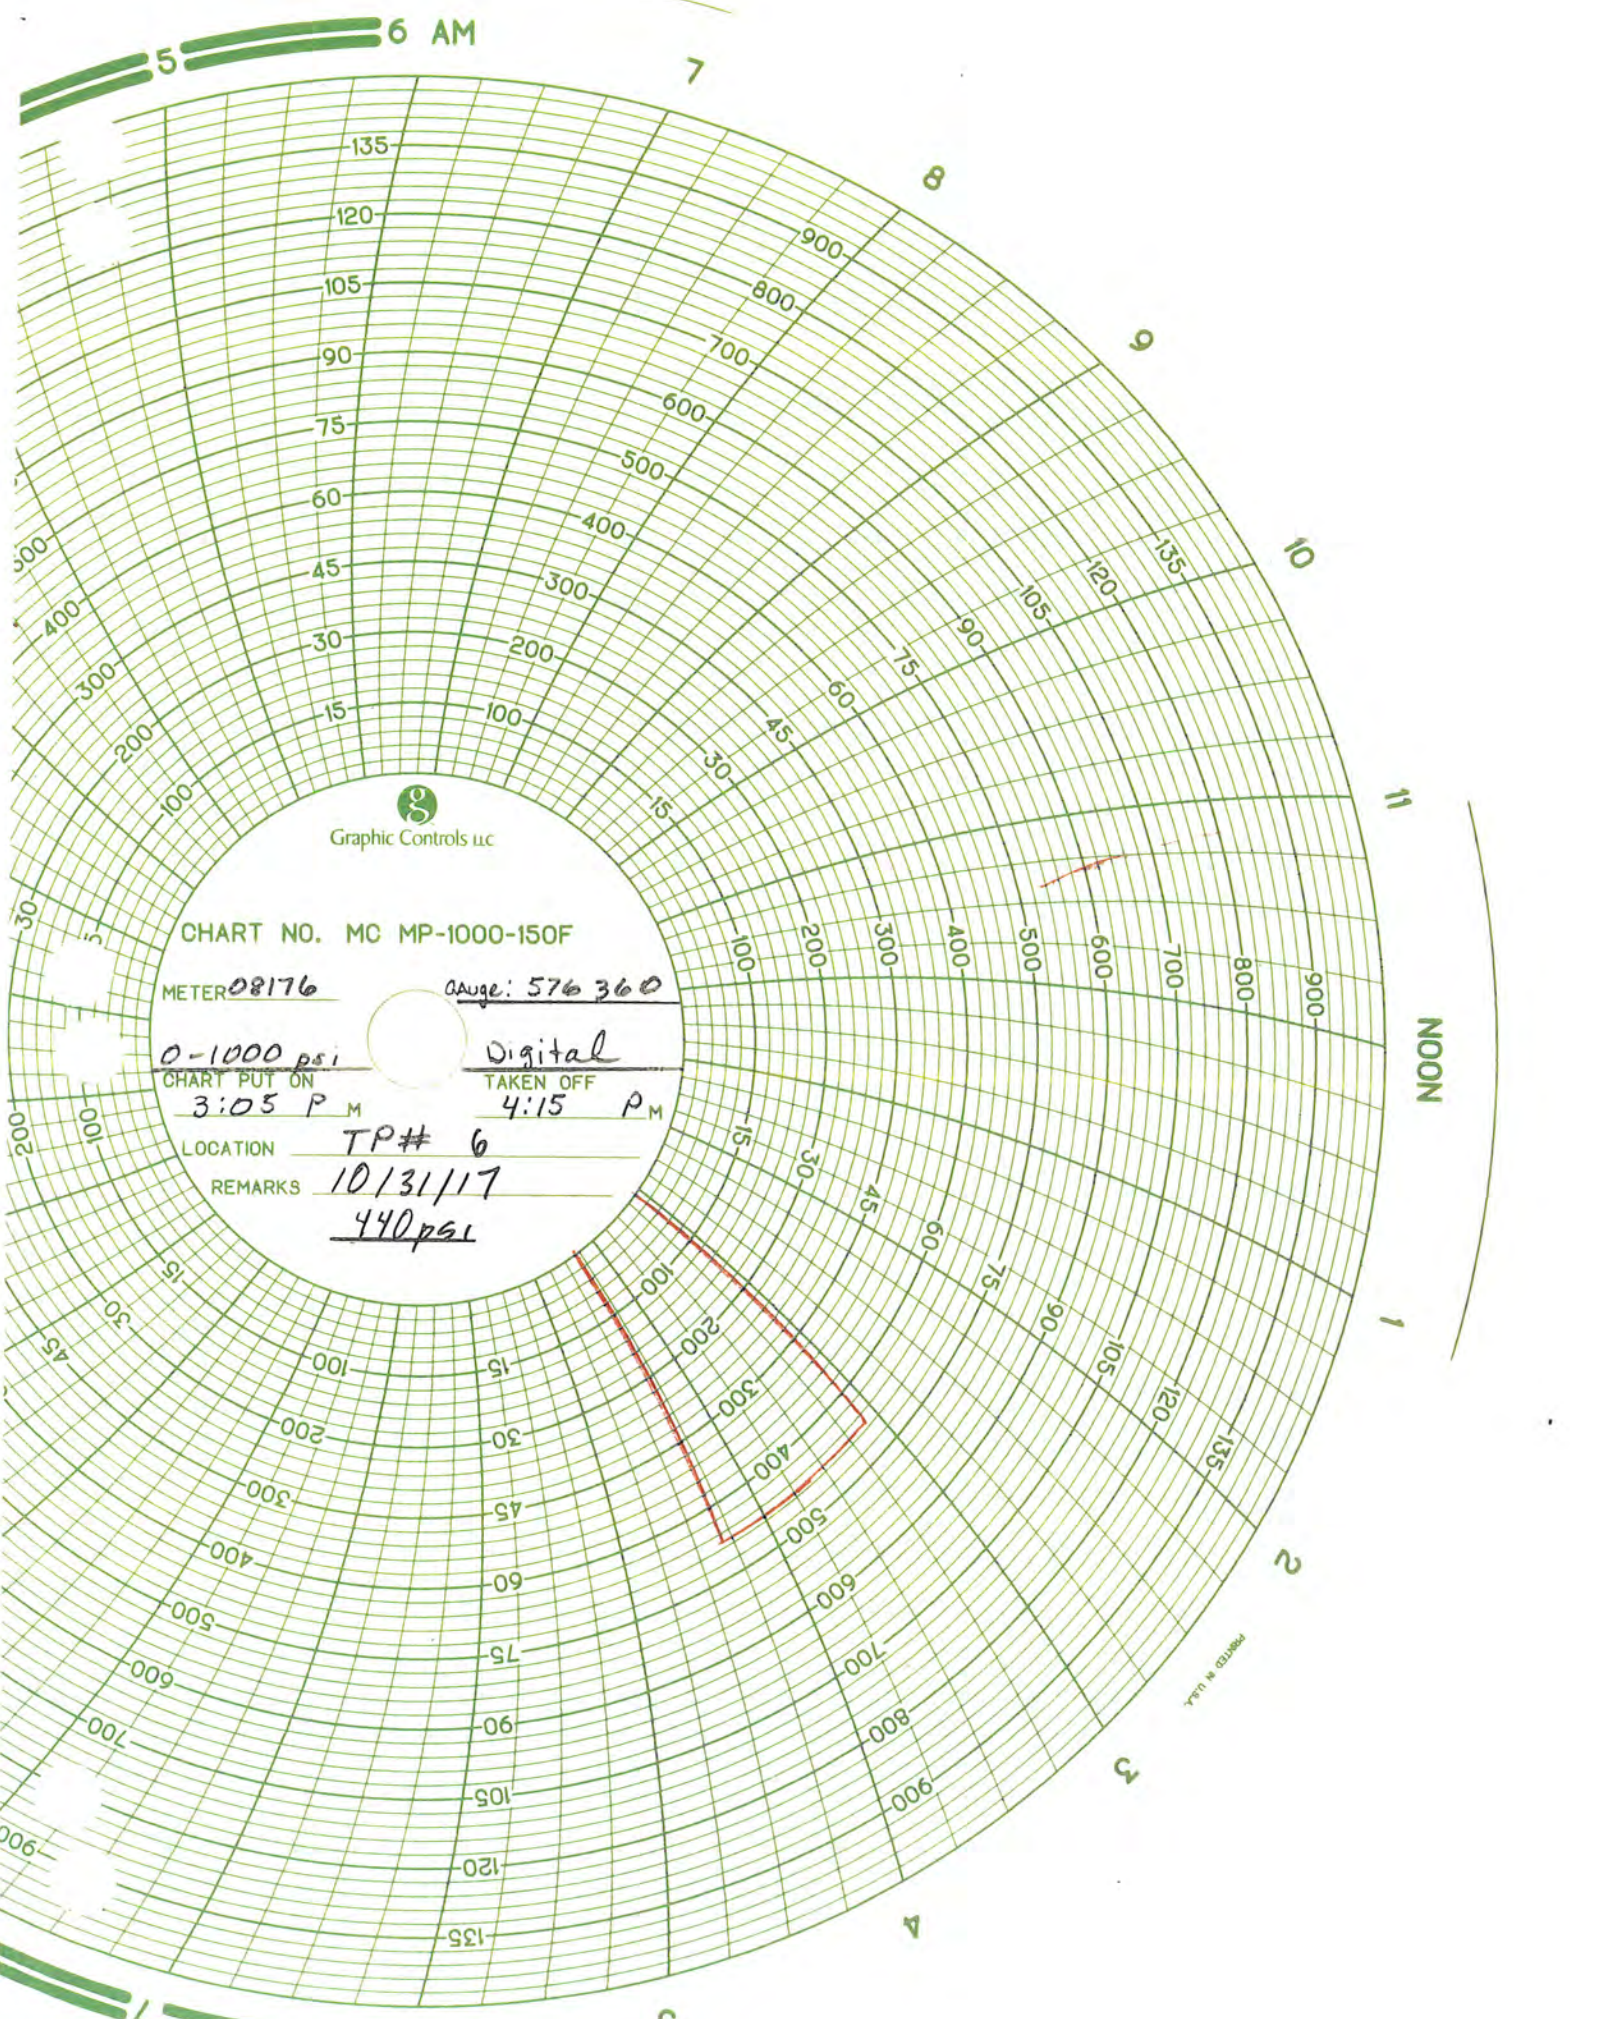

Graphic Controls LLC

CHART NO. MC MP-1000-150F

METER 08176

Gauge: 576 360

0-1000 psi

Digital

CHART PUT ON  
3:05 P<sub>M</sub>

TAKEN OFF  
4:15 P<sub>M</sub>

LOCATION TP# 6

REMARKS 10/31/17  
440 psi

PRINTED IN U.S.A.



**PLANT SERVICES**

# PNEUMATIC TEST FORM

TEST PACKAGE # 07

ISTI Client UOP Russell LLC.

ISTI Job# J-6733

TEST PRESSURE 550 psi

TEST MEDIA Nitrogen

## PRE-PNEUMATIC

Test Supervisor Jerry Allen

Date: 10/31/2017

ISTI Quality Rep. Rod Holden

Date: 10/31/2017

## PNEUMATIC TEST START

Date: 10/31/2017  
Time: 3:15 PM

Test Gauge # Digital  
567628

## PNEUMATIC TEST COMPLETE

Date: 10/31/2017  
Time: 4:30 PM

Chart Recorder# 0-1000 psi  
08176

Test Supervisor Jerry Allen

Date: 10/31/2017

ISTI Quality Rep. Rod Holden

Date: 10/31/2017

## POST -PNEUMATIC

System Piping Dried Date: 10/31/2017


Test Supervisor Jerry Allen Date: 10/31/2017

ISTI Quality Rep. Rod Holden Date: 10/31/2017

ISTI Plant Services J-6733

Client: UOP Russell

|          | TEST | Test       | Test     |
|----------|------|------------|----------|
| Spool ID | #    | Date       | Pressure |
| SK2-019  | TP#7 | 10/31/2017 | 550      |

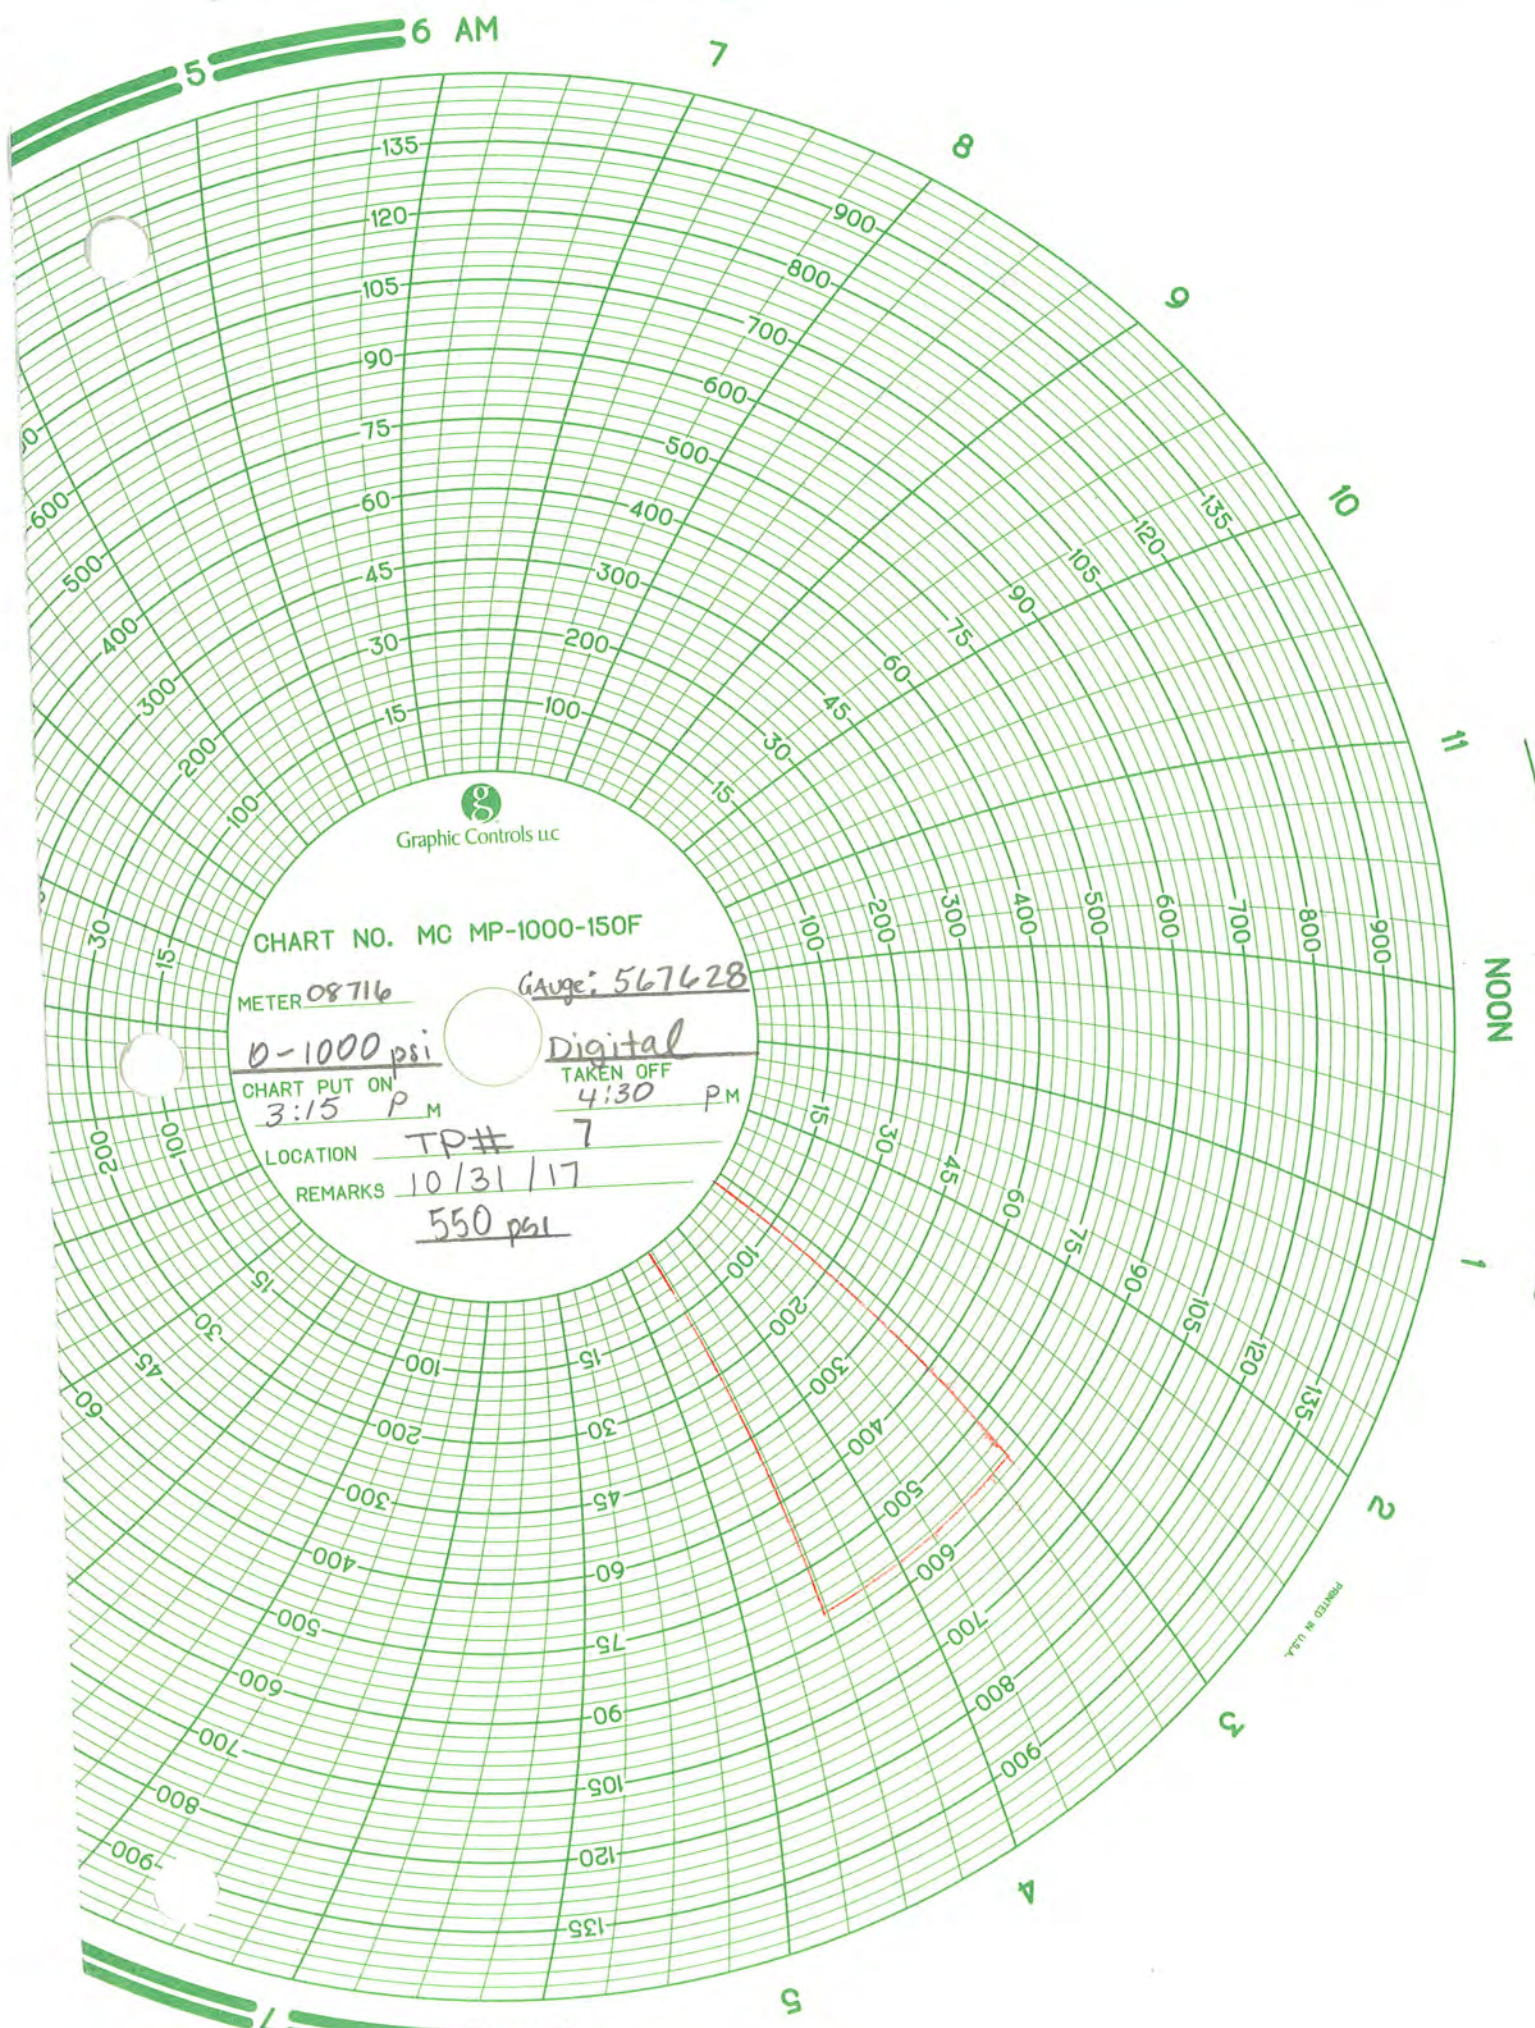

Graphic Controls LLC

CHART NO. MC MP-1000-150F

METER 08716

Gauge: 567628

0-1000 psi

Digital

CHART PUT ON 3:15 P.M.

TAKEN OFF 4:30 P.M.

LOCATION

TP# 7

REMARKS

10/31/17

550 psi

PRINTED IN U.S.A.



**PLANT SERVICES**

# PNEUMATIC TEST FORM

TEST PACKAGE # 08

ISTI Client UOP Russell LLC.

ISTI Job# J-6733

TEST PRESSURE 1584 psi

TEST MEDIA Nitrogen

## PRE-PNEUMATIC

Test Supervisor Jerry Allen

Date: 10/31/2017

ISTI Quality Rep. Rod Holden

Date: 10/31/2017

## PNEUMATIC TEST START

Date: 10/31/2017

Time: 4:15 PM

Test Gauge # Digital  
576360

## PNEUMATIC TEST COMPLETE

Date: 10/31/2017

Time: 5:15 PM

Chart Recorder# 0-3000 psi  
202A-156510

Test Supervisor Jerry Allen

Date: 10/31/2017

ISTI Quality Rep. Rod Holden

Date: 10/31/2017

## POST -PNEUMATIC

System Piping Dried Date: 10/31/2017

Test Supervisor Jerry Allen


Date: 10/31/2017

ISTI Quality Rep. Rod Holden

Date: 10/31/2017

ISTI Plant Services J-6733  
Client: UOP Russell

| Spool ID | TEST # | Test Date  | Test Pressure |
|----------|--------|------------|---------------|
| SK2-026  | TP#8   | 10/31/2017 | 1584          |
| SK2-027  | TP#8   | 10/31/2017 | 1584          |
| SK2-028  | TP#8   | 10/31/2017 | 1584          |
| SK2-030  | TP#8   | 10/31/2017 | 1584          |
| SK2-031  | TP#8   | 10/31/2017 | 1584          |
| SK2-042  | TP#8   | 10/31/2017 | 1540          |
| SK2-043  | TP#8   | 10/31/2017 | 1540          |

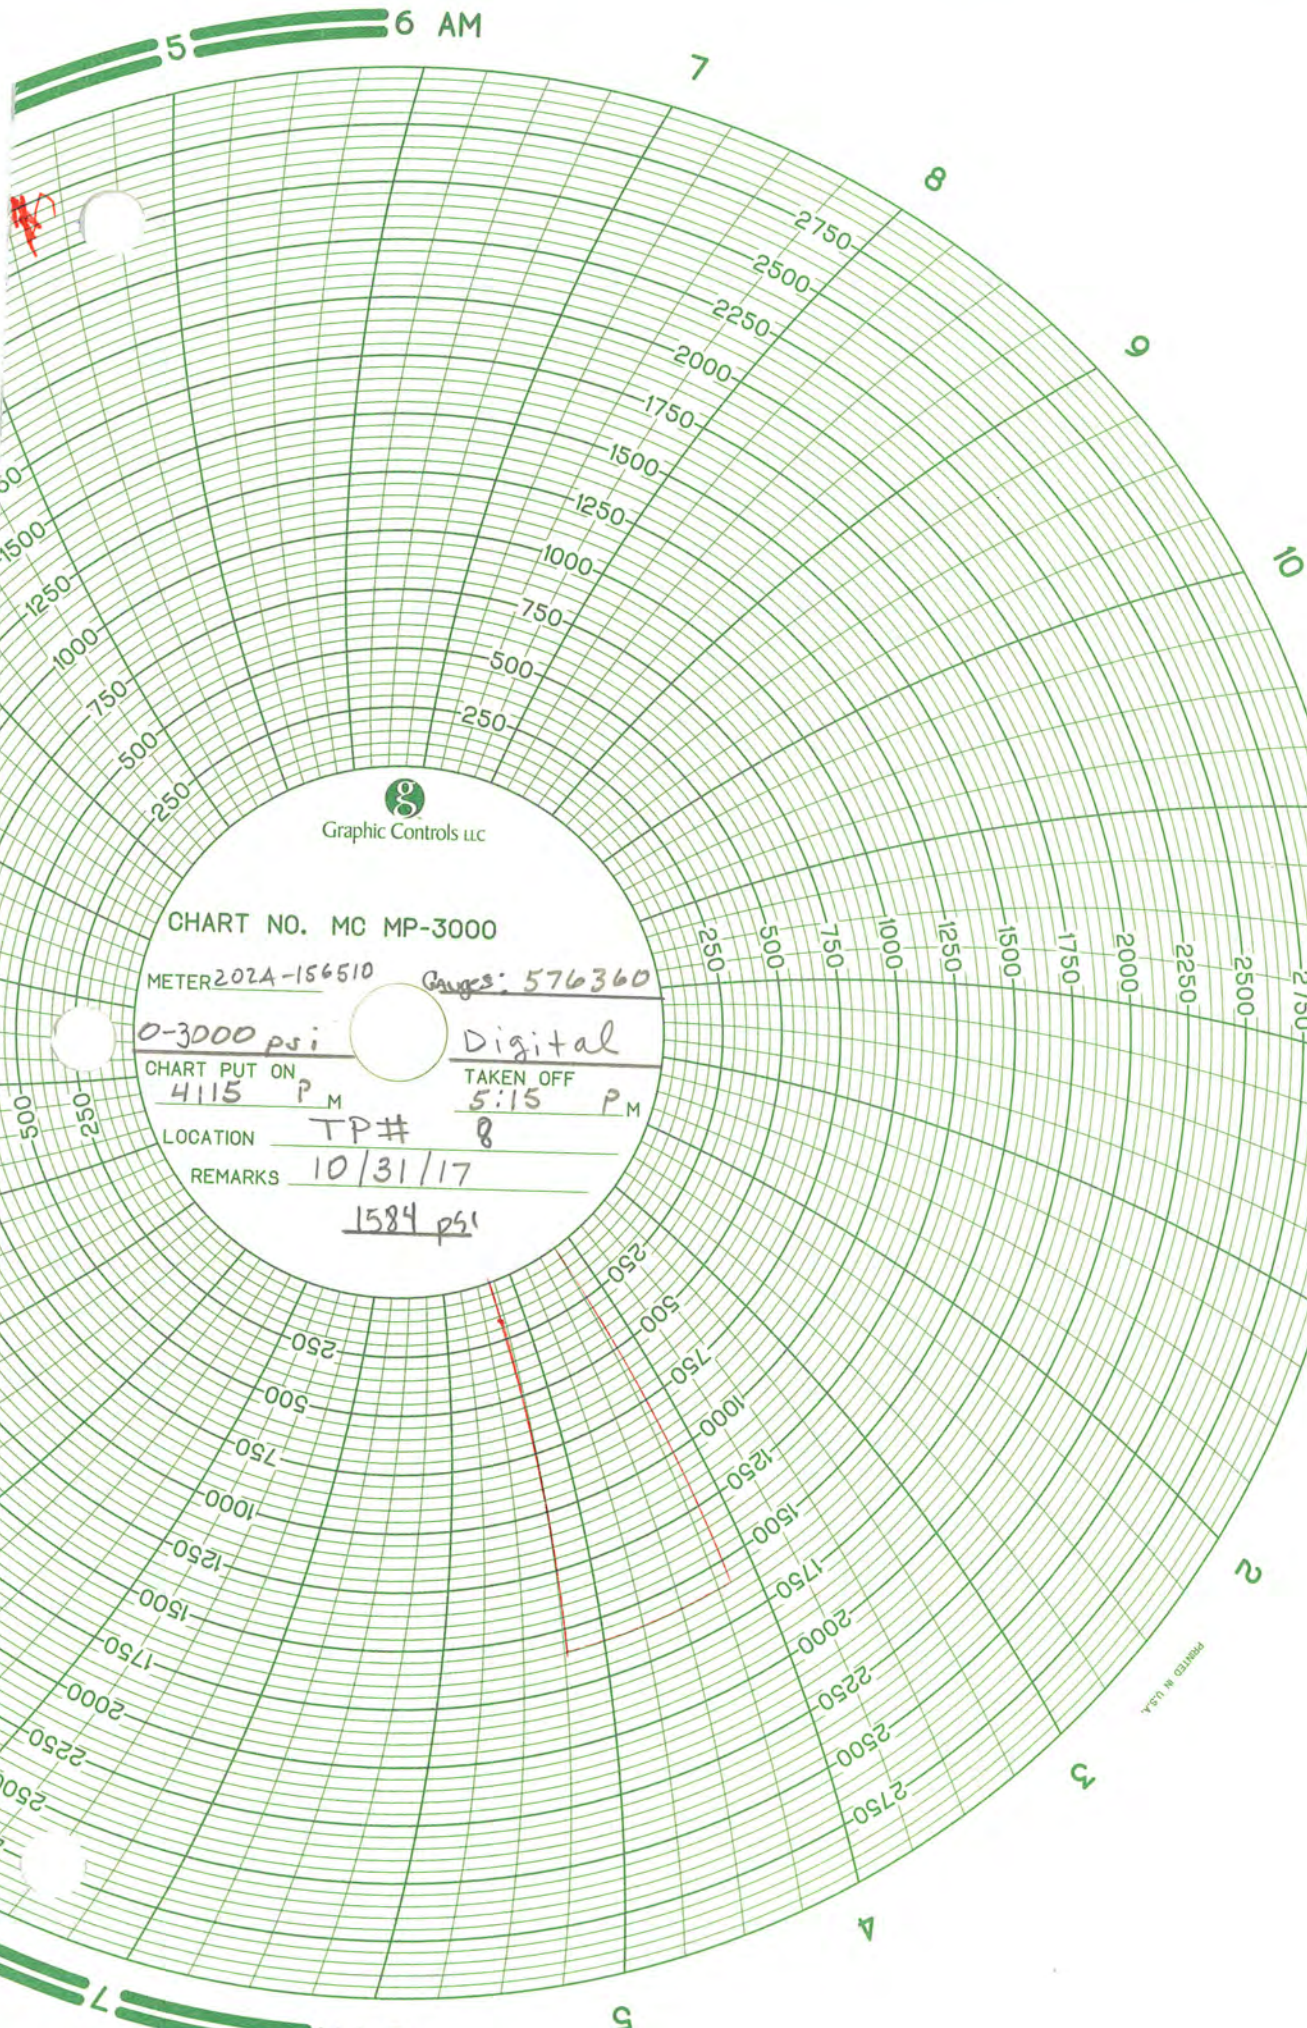

Graphic Controls LLC

CHART NO. MC MP-3000

METER 202A-156510

Gauge: 576360

0-3000 psi

Digital

CHART PUT ON

4:15 P.M.

TAKEN OFF

5:15 P.M.

LOCATION

TP# 8

REMARKS

10/31/17

1584 psi

MADE IN U.S.A.



PLANT SERVICES

# PNEUMATIC TEST FORM

TEST PACKAGE # 09

ISTI Client UOP Russell LLC.

ISTI Job# J-6733

TEST PRESSURE 165psi

TEST MEDIA Nitrogen

## PRE-PNEUMATIC

Test Supervisor Jerry Allen

Date: 10/31/2017

ISTI Quality Rep. Rod Holden

Date: 10/31/2017

## PNEUMATIC TEST START

Date: 10/31/2017

Time: 4:45 PM

Test Gauge # Digital  
794666

## PNEUMATIC TEST COMPLETE

Date: 10/31/2017

Time: 6:00 PM

Chart Recorder# 0-1000 psi  
265-42857

Test Supervisor Jerry Allen

Date: 10/31/2017

ISTI Quality Rep. Rod Holden

Date: 10/31/2017

## POST -PNEUMATIC

System Piping Dried Date: 10/31/2017

Test Supervisor Jerry Allen

Date: 10/31/2017


ISTI Quality Rep. Rod Holden

Date: 10/31/2017

ISTI Plant Services J-6733

Client: UOP Russell

| Spool ID | TEST # | Test Date  | Test Pressure |
|----------|--------|------------|---------------|
| SK2-032  | TP#9   | 10/31/2017 | 165           |
| SK2-033  | TP#9   | 10/31/2017 | 165           |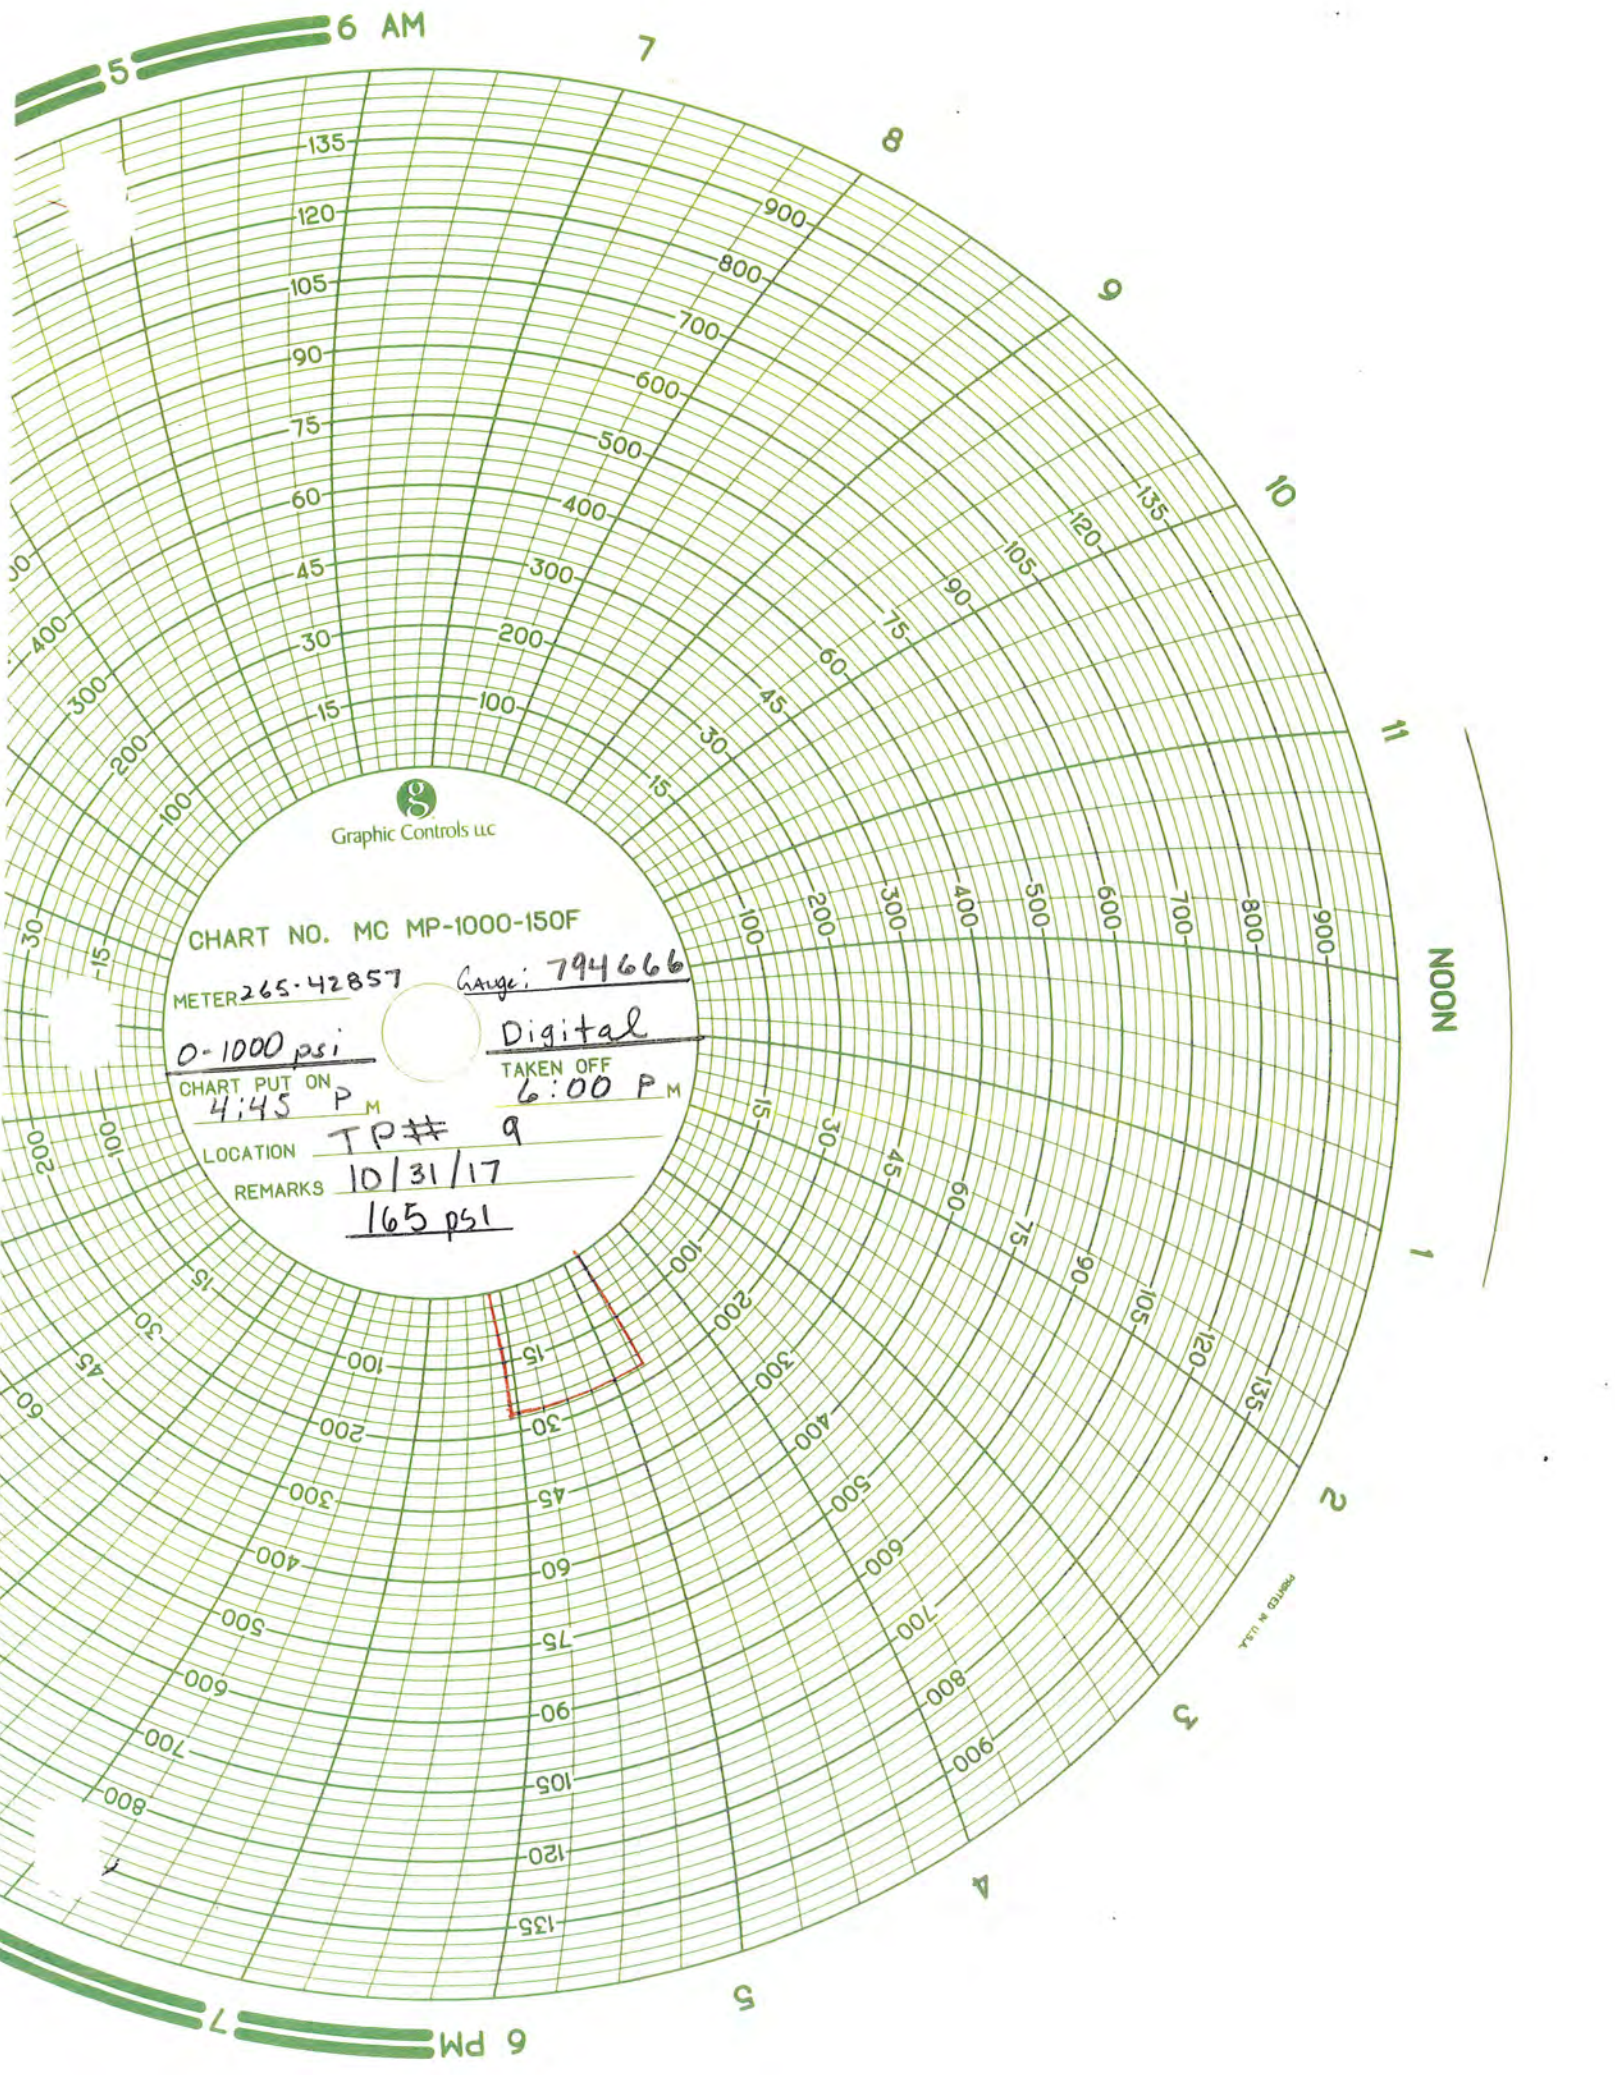
Graphic Controls LLC

CHART NO. MC MP-1000-150F


METER 265-42857 Gauge: 794666

0-1000 psi Digital

CHART PUT ON 4:45 P M TAKEN OFF 6:00 P M

LOCATION TP# 9

REMARKS 10/31/17  
165 psi

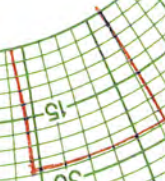

PRINTED IN U.S.A.



**PLANT SERVICES**

# PNEUMATIC TEST FORM

TEST PACKAGE # 10

ISTI Client UOP Russell LLC.

ISTI Job# J-6733

TEST PRESSURE 1210 psi

TEST MEDIA Nitrogen

## PRE-PNEUMATIC

Test Supervisor Jerry Allen

Date: 10/31/2017

ISTI Quality Rep. Rod Holden

Date: 10/31/2017

## PNEUMATIC TEST START

Date: 10/31/2017  
Time: 6:15 PM

Test Gauge # Digital  
567628

## PNEUMATIC TEST COMPLETE

Date: 10/31/2017  
Time: 7:20 PM

Chart Recorder# 0-2000 psi  
202A-4998

Test Supervisor Jerry Allen

Date: 10/31/2017

ISTI Quality Rep. Rod Holden

Date: 10/31/2017

## POST -PNEUMATIC

System Piping Dried Date: 10/31/2017

Test Supervisor Jerry Allen

Date: 10/31/2017


ISTI Quality Rep. Rod Holden

Date: 10/31/2017

ISTI Plant Services J-6733

Client: UOP Russell

| Spool ID    | TEST # | Test Date  | Test Pressure |
|-------------|--------|------------|---------------|
| SK2-001     | TP#10  | 10/31/2017 | 1210          |
| SK2-002     | TP#10  | 10/31/2017 | 1210          |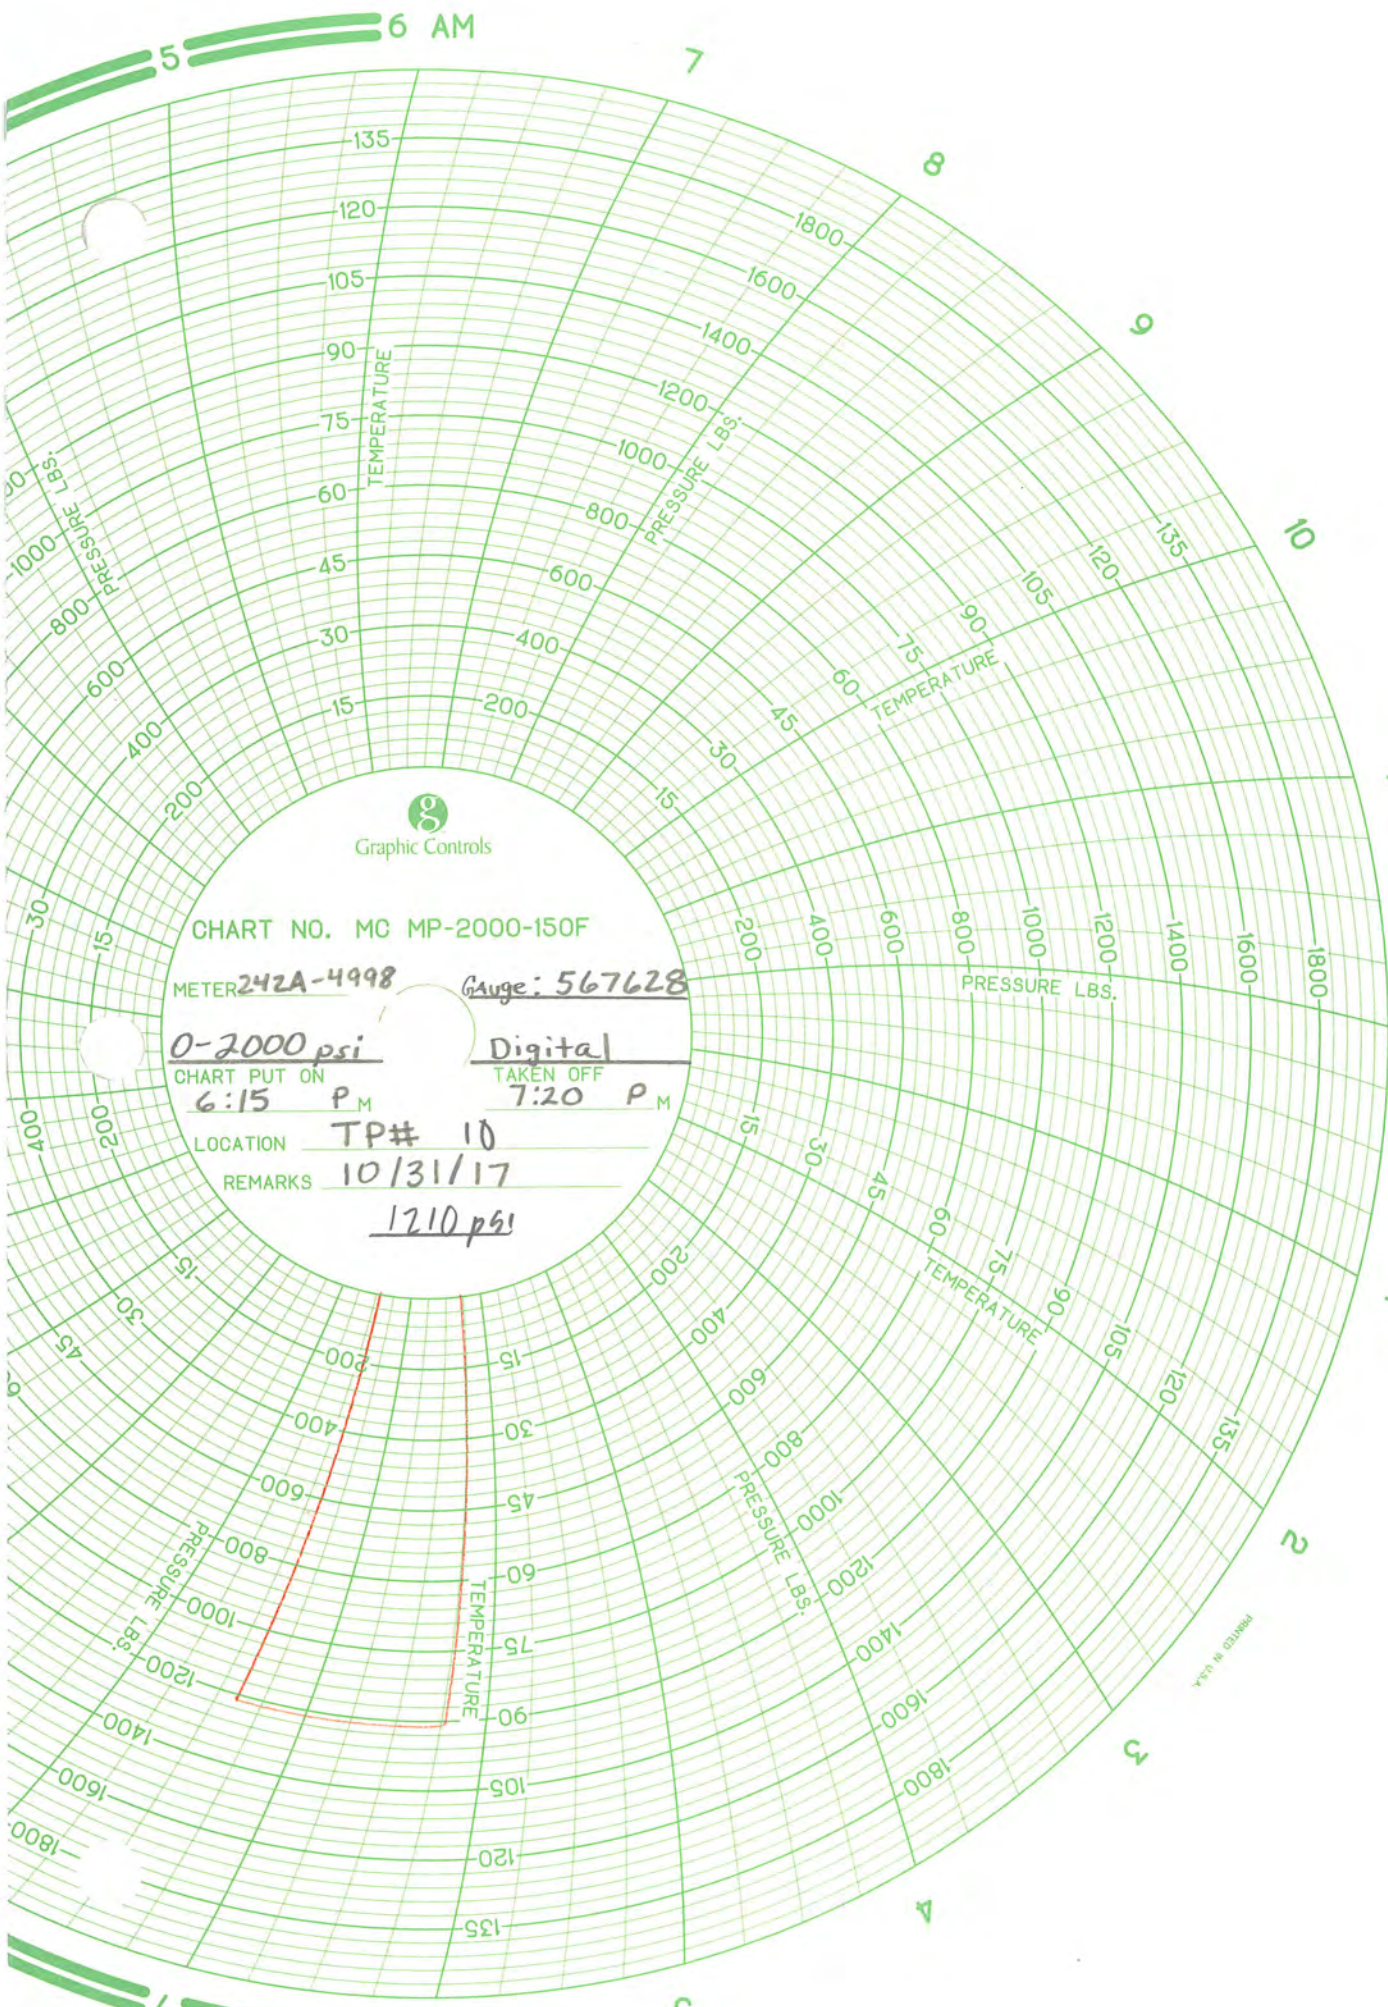
6 AM

5

7

8

9

10

11

NOON

1

2

3

4

5

6 PM

7



Graphic Controls

CHART NO. MC MP-2000-150F

METER 242A-4998

Gauge: 567628

0-2000 psi

Digital

CHART PUT ON 6:15 P<sub>M</sub>

TAKEN OFF 7:20 P<sub>M</sub>

LOCATION TP# 10

REMARKS 10/31/17

1210 psi

PRINTED IN U.S.A.



**PLANT SERVICES**

# PNEUMATIC TEST FORM

TEST PACKAGE # 11

ISTI Client UOP Russell LLC.

ISTI Job# J-6733

TEST PRESSURE 1210 psi

TEST MEDIA Nitrogen

## PRE-PNEUMATIC

Test Supervisor Jerry Allen

Date: 11/10/2017

ISTI Quality Rep. Rod Holden

Date: 11/10/2017

## PNEUMATIC TEST START

Date: 11/10/2017  
Time: 8:15 AM

Test Gauge # Digital  
794845

## PNEUMATIC TEST COMPLETE

Date: 11/10/2017  
Time: 9:30 AM

Chart Recorder# 0-2000 psi  
202-21048

Test Supervisor Jerry Allen

Date: 11/10/2017

ISTI Quality Rep. Rod Holden

Date: 11/10/2017

## POST -PNEUMATIC

System Piping Dried Date: 11/10/2017

Test Supervisor Jerry Allen

Date: 11/10/2017

ISTI Quality Rep. Rod Holden

Date: 11/10/2017

ISTI Plant Services J-6733  
Client: UOP Russell

|          | TEST  | Test       | Test     |
|----------|-------|------------|----------|
| Spool ID | #     | Date       | Pressure |
| SK2-013B | TP#11 | 11/10/2017 | 1210     |

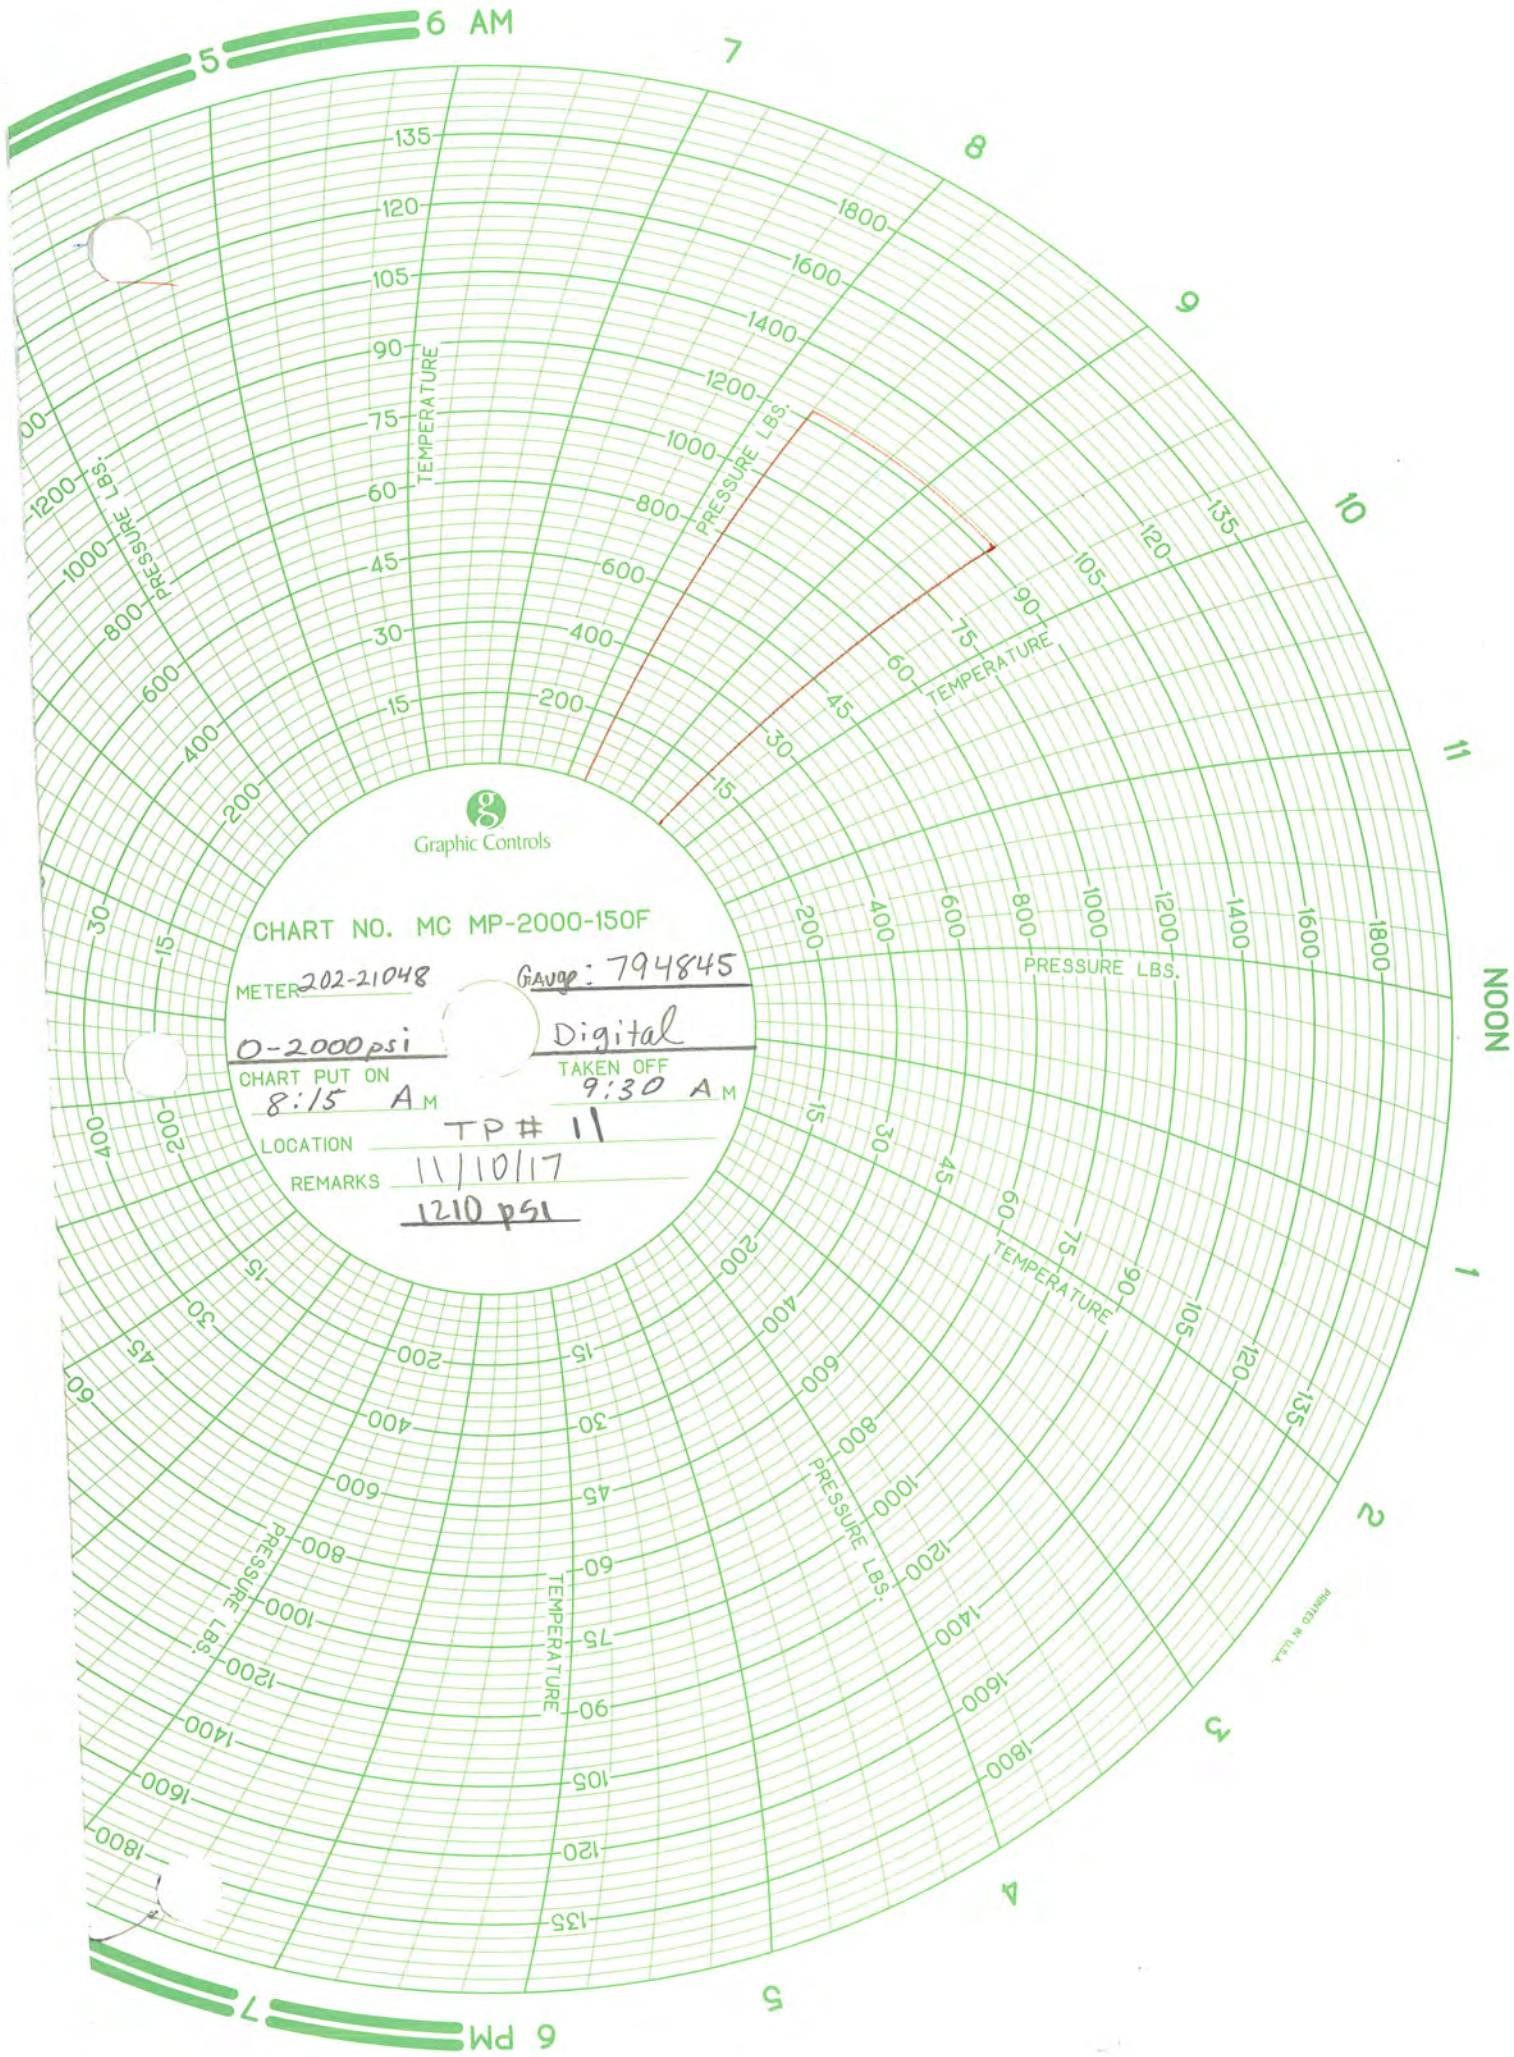


CHART NO. MC MP-2000-150F

METER 202-21048

GAUGE: 794845

0-2000 psi

Digital

CHART PUT ON  
8:15 A.M.

TAKEN OFF  
9:30 A.M.

LOCATION

TP # 11

REMARKS

11/10/17

1210 psi

PRINTED IN U.S.A.

**J-447**

**SK2 Assy**  
**Spools**

**ISTI**  
**Calibration Certificates**

# HYDRO CHART

Calibration → Certification → Repair → Rental

www.hydro-chart.com

7709 E. 42<sup>nd</sup> Place, Suite 128 Tulsa, OK 74145

918-834-3210

## CERTIFICATE OF CALIBRATION

|                    |                                      |
|--------------------|--------------------------------------|
| Customer Name:     | ISTI                                 |
| Model:             | Barton Pressure/Temperature Recorder |
| Serial Number:     | 202-21048                            |
| Range:             | 0 - 2,000 psi / 0 - 150 Deg. F.      |
| Accuracy +/- :     | 1%                                   |
| Condition as Left: | Within Tolerance                     |
| Date Calibrated:   | September 26, 2017                   |
| Action Performed:  | Calibrated/Certified                 |

Tech: Mark M. Harrison

Authorized Signature: Mark M. Harrison

This certificate applies solely for the equipment listed above.

The primary test and measuring equipment used is calibrated and traceable to the National Institute of Standards and Technology (NIST) United States.

Additel SN: 211H13610038 Asset # 1123679 Due Date: 09/05/2018

Crystal SN: 261773 Asset # 1126050 Due Date: 09/05/2018

Fluke SN: 20000054 Asset # 1141857 Due Date: 10/17/2017

Based on Standard Gravity @72 Deg. F. and 39% Relative Humidity.

## CERTIFICATION OF CALIBRATION

THE INSTRUMENTS LISTED BELOW MEET-OR EXCEED PUBLISHED SPECIFICATION AND HAS BEEN CALIBRATED UNDER CONTROLLED CONDITIONS TRACEABLE TO THE NATIONAL INSTITUTE OF STANDARDS AND TECHNOLOGY (FORMERLY N.B.S.). M & M INSTRUMENTS CONFORMS TO ANSI Z540-1.

---

CERTIFICATION#: 39190

INSTRUMENT MAKE: CRYSTAL DIGITAL TEST GAUGE

MODEL: XP2i

ID#: NONE

S/N: 356841

DATE: 09-21-17

DUE: 09-21-18

HUMIDITY: 63.2% TEMPERATURE: 74.18 DEG F

SOURCE 1: PRESSUREMENTS W2000/3HP

CERT#: 2103511

SOURCE 2:

CERT#:

SOURCE 3:

CERT#:

INSTRUMENT RECEIVED: IN TOL.

MANUFACTURER ACCURACY: +/-0.1% RDG. 20-100%F.S., +/-0.02%F.S. 0-20%F.S.

COMMENTS:

CERTIFIED BY

EP

M & M INSTRUMENTS

5022 SYCAMORE AVE.

PASADENA, TX 77503

PHONE (281) 991-5036

FAX (281) 991-5077



# HYDRO CHART

Calibration → Certification → Repair → Rental

www.hydro-chart.com

7709 E. 42<sup>nd</sup> Place, Suite 128 Tulsa, OK 74145

918-834-3210

## CERTIFICATE OF CALIBRATION

|                    |                                      |
|--------------------|--------------------------------------|
| Customer Name:     | ISTI                                 |
| Model:             | Barton Pressure/Temperature Recorder |
| Serial Number:     | 202A-40940                           |
| Range:             | 0 - 1,000 psi / 0 - 150 Deg. F.      |
| Accuracy +/- :     | 1%                                   |
| Condition as Left: | Within Tolerance                     |
| Date Calibrated:   | September 5, 2017                    |
| Action Performed:  | Calibrated/Certified                 |

Tech: Mark M. Harrison

Authorized Signature: Mark M. Harrison

This certificate applies solely for the equipment listed above.  
The primary test and measuring equipment used is calibrated and traceable to the National  
Institute of Standards and Technology (NIST) United States.

Crystal Engineering SN: 070569      Asset# 1121166 Due Date: 11/10/2017

Fluke SN: 20000054      Asset # 1141857 Due Date: 10/17/2017

Based on Standard Gravity @72 Deg. F. and 39% Relative Humidity.

# HYDRO-CHART

Calibration → Certification → Repair → Rental

www.hydro-chart.com

7709 E. 42<sup>nd</sup> Place, Suite 128 Tulsa, OK 74145

918-834-3210

## CERTIFICATE OF CALIBRATION

|                    |                                      |
|--------------------|--------------------------------------|
| Customer Name:     | ISTI                                 |
| Model:             | Barton Pressure/Temperature Recorder |
| Serial Number:     | 242A-4998                            |
| Range:             | 0 - 2,000 psi / 0 - 150 Deg. F.      |
| Accuracy +/- :     | 1%                                   |
| Condition as Left: | Within Tolerance                     |
| Date Calibrated:   | September 5, 2017                    |
| Action Performed:  | Calibrated/Certified                 |

Tech: Mark M. Harrison

Authorized Signature: Mark M. Harrison

This certificate applies solely for the equipment listed above.  
The primary test and measuring equipment used is calibrated and traceable to the National  
Institute of Standards and Technology (NIST) United States.

Crystal Engineering SN: 070569

Asset# 1121166 Due Date: 11/10/2017

Fluke SN: 20000054

Asset # 1141857 Due Date: 10/17/2017

Based on Standard Gravity @72 Deg. F. and 39% Relative Humidity.

CERTIFICATION OF CALIBRATION

THE INSTRUMENTS LISTED BELOW MEET-OR EXCEED PUBLISHED SPECIFICATION AND HAS BEEN CALIBRATED UNDER CONTROLLED CONDITIONS TRACEABLE TO THE NATIONAL INSTITUTE OF STANDARDS AND TECHNOLOGY (FORMERLY N.B.S.). M & M INSTRUMENTS CONFORMS TO ANSI Z540-1.

CERTIFICATION#: 38889

INSTRUMENT MAKE: CRYSTAL DIGITAL TEST GAUGE  
MODEL: XP21  
ID#: NONE  
S/N: 567628  
DATE: 07-27-17  
DUE: 07-27-18  
HUMIDITY: 55.6% TEMPERATURE: 78.00 DEG F

SOURCE 1: PRESSUREMENTS W2000/3HP  
SOURCE 2:  
SOURCE 3:

CERT#: 2103511  
CERT#:  
CERT#:

INSTRUMENT RECEIVED: IN TOL.

MANUFACTURER ACCURACY: +/-0.1% RDG, 20-100%F.S., +/-0.02%F.S, 0-20%F.S.

COMMENTS: REPLACED SENSOR AND BATTERIES.

CERTIFIED BY EP

M & M INSTRUMENTS  
5022 SYCAMORE AVE.  
PASADENA, TX 77503  
PHONE (281) 991-5036  
FAX (281) 991-5077

## Certificate of Calibration

Calibrations comply with  
ISO/IEC 17025:2005 and  
ANSI NCSL Z540-1-1994



| Device Information     |              |
|------------------------|--------------|
| Model                  | 5KPSIXP2I    |
| Serial Number          | 794845       |
| Water Column (@ 1 Atm) | 4° C         |
| Calibration Date       | 11 July 2017 |
| Verification Date      | 12 July 2017 |
| As Received Condition  | New          |
| As Left Condition      | In Tolerance |

| Laboratory Conditions                                     |              |
|---|--------------|
| Laboratory ambient conditions throughout this calibration |              |
| Temperature   | 19 to 23° C  |
| Humidity  | 20 to 60% RH |

### Definitions

- Temperature ..... Measured temperature of Device Under Test (DUT) during data collection.
- Reference Reading ..... True value according to our reference standards.
- Indicated Reading ..... Displayed reading from test unit.
- Condition ..... Pass or Fail.
- Difference ..... Indicated reading minus reference reading.
- Relative Difference ..... (Difference / reference reading) x 100.
- Allowable Tolerance ..... ± according to manufacturer's specifications.
- Pressure Medium ..... Nitrogen.

### Traceability Statement

Reference Standards used in this calibration are traceable to the National Institute of Standards and Technology of the United States (NIST) or other NMI.


### System Expanded Uncertainty

System expanded uncertainty evaluation includes the calibration reference used and device under test and is calculated in accordance with ISO "Guide to the Expression of Uncertainty in Measurement" (GUM). The uncertainties reported represent expanded uncertainties using a coverage factor (k) to approximate a percentage (%) confidence level. *In Tolerance or Pass* conditions are based on test results falling within specified limits with no reduction by the uncertainty of the measurement. The results contained herein relate only to the item calibrated. Test methods defined by COI-054.

|                      |      |
|----------------------|------|
| Coverage Factor (k)  | 2    |
| Confidence Level (%) | ~ 95 |

### Traceable Reference Standards

| Manufacturer | Calibration Reference Used            | Serial Number | Report No. | Reference Cal. Due |
|--------------|---------------------------------------|---------------|------------|--------------------|
| DHI          | PPCH-G 618 10KPSI Pressure Controller | 618           | 16028      | 19 November 2017   |

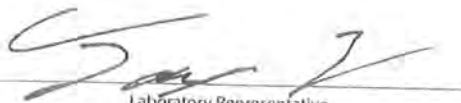  
Laboratory Representative  
Tony Ly

  
Quality Representative  
Bruce Hitt

## Certificate of Calibration

Calibrations comply with  
ISO/IEC 17025:2005 and  
ANSI NCSL Z540-1-1994



| Device Information     |              |
|------------------------|--------------|
| Model                  | SKPSIXP2I    |
| Serial Number          | 794666       |
| Water Column (@ 1 Atm) | 4° C         |
| Calibration Date       | 06 July 2017 |
| Verification Date      | 06 July 2017 |
| As Received Condition  | New          |
| As Left Condition      | In Tolerance |

| Laboratory Conditions                                     |              |
|---|--------------|
| Laboratory ambient conditions throughout this calibration |              |
| Temperature   | 19 to 23° C  |
| Humidity  | 20 to 60% RH |

### Definitions

Temperature ..... Measured temperature of Device Under Test (DUT) during data collection.  
Reference Reading ..... True value according to our reference standards.  
Indicated Reading ..... Displayed reading from test unit.  
Condition ..... Pass or Fail.  
Difference ..... Indicated reading minus reference reading.  
Relative Difference ..... (Difference / reference reading) x 100.  
Allowable Tolerance ..... ± according to manufacturer's specifications.  
Pressure Medium ..... Nitrogen.

### Traceability Statement

Reference Standards used in this calibration are traceable to the National Institute of Standards and Technology of the United States (NIST) or other NMI.

### System Expanded Uncertainty

System expanded uncertainty evaluation includes the calibration reference used and device under test and is calculated in accordance with ISO "Guide to the Expression of Uncertainty in Measurement" (GUM). The uncertainties reported represent expanded uncertainties using a coverage factor (k) to approximate a percentage (%) confidence level. *In Tolerance* or *Pass* conditions are based on test results falling within specified limits with no reduction by the uncertainty of the measurement. The results contained herein relate only to the item calibrated, Test methods defined by COI-054.

|                      |      |
|----------------------|------|
| Coverage Factor (k)  | 2    |
| Confidence Level (%) | ~ 95 |

| Traceable Reference Standards |                                       |               |            |                    |
|-------------------------------|---------------------------------------|---------------|------------|--------------------|
| Manufacturer                  | Calibration Reference Used            | Serial Number | Report No. | Reference Cal. Due |
| DHI                           | PPCH-G 618 10KPSI Pressure Controller | 618           | 16028      | 19 November 2017   |

Laboratory Representative

Tony Ly

Quality Representative

Bruce Hitt

# HYDRO CHART

Calibration → Certification → Repair → Rental

www.hydro-chart.com

7709 E. 42<sup>nd</sup> Place, Suite 128 Tulsa, OK 74145


918-834-3210

## CERTIFICATE OF CALIBRATION

|                        |                                      |
|------------------------|--------------------------------------|
| Customer Name:         | ISTI                                 |
| Model:                 | Barton Pressure/Temperature Recorder |
| Serial Number:         | 265-42857                            |
| Range:                 | 0 - 1,000 psi and 0 - 150° F.        |
| Accuracy +/- :         | 1%                                   |
| Date Calibrated:       | June 19, 2017                        |
| Condition as received: | Could not test - Clogged Tube        |
| Condition as left:     | Within Tolerance                     |
| Action Performed:      | Calibrated/Certified                 |

Tech: Mark M. Harrison

Authorized Signature:

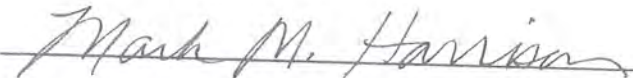

This certificate applies solely for the equipment listed above. Calibration is performed on-site at 7709 E. 42nd Place #128, Tulsa OK, 74145.

The primary test and measuring equipment used is calibrated and traceable to the National Institute of Standards and Technology (NIST) United States.

Additel SN: 211H136100338

Asset # 1123679 Due Date: 08/23/2017

Fluke SN: 20000054

Asset # 1141857 Due Date: 10/17/2017

Based on Standard Gravity @72 Deg. F. and 39% Relative Humidity.

# HYDRO CHART

CALIBRATION SERVICES

7709 EAST 42<sup>nd</sup> PLACE, SUITE 128 TULSA, OK 74145 918-834-3210

## CALIBRATION CERTIFICATION

We certify the instrument identified below has been tested using precision Standards traceable to NIST and the accuracy found is attested to below:

CUSTOMER PIPELINE SUPPLY & SERVICE

MODEL Crystal Engineering XP2i Digital Test Gauge

SERIAL NUMBER 576360

RANGE 0 - 5,000 psi

ACCURACY +/- 0.1 %

CALIBRATED BY *Mark M. Harrison* Mark M. Harrison

DATE March 27, 2017

The primary test and measuring equipment used is calibrated and traceable to NIST  
(National Institute of Standards and Technology) United States

Additel SN 211H136100338

Asset # 1123679 Due Date: 08/23/2017

Fluke SN: 20000054

Asset # 1141857 Due Date: 10/17/2017

Based on Standard Gravity @72 Deg. F and 39% Relative Humidity

# HYDRO CHART

CALIBRATION SERVICES

7709 EAST 42<sup>nd</sup> PLACE, SUITE 128 TULSA, OK 74145 918-834-3210

## CALIBRATION CERTIFICATION

We certify the instrument identified below has been tested using precision Standards traceable to NIST and the accuracy found is attested to below:

CUSTOMER

ISTI

MODEL

Barton Pressure / Temperature Recorder

SERIAL NUMBER

202A - 156510

RANGE

0 - 3,000 psi and 0 - 150° F.

ACCURACY +/-

1 %

CALIBRATED BY

*Mark M. Harrison*

Mark M. Harrison

DATE

February 6, 2017

*The primary test and measuring equipment used is calibrated and traceable to NIST (National Institute of Standards and Technology) United States*

Additel SN 211H136100338

Asset # 1123679 Due Date: 08/23/2017

Floke SN: 20000054

Asset # 1141857 Due Date: 10/17/2017

Based on Standard Gravity @72 Deg. F and 39% Relative Humidity

| SPOOL#    | METHOD USED | DESIGN PRESSURE (PSIG) | DESIGN TEMP | TEMPERATURE CORRECTION FACTOR (HYDRO ONLY) | TEST PRESSURE USED (PSIG) | GAUGE USED | CALIBRATION DATE | DATE TESTED | REMARKS        |
|-----------|-------------|------------------------|-------------|--|---------------------------|------------|------------------|-------------|----------------|
| 2         | Nitrogen    | 1100                   | 150°F       | NA   | 1210 PSIG                 | DG-3       | 1/23/2018        | 11/20/2018  |                |
| 6         | Nitrogen    | 1100                   | 150°F       | NA   | 1210 PSIG                 | DG-3       | 1/23/2018        | 11/20/2018  |                |
| 7         | Nitrogen    | 1100                   | 150°F       | NA   | 1210 PSIG                 | DG-3       | 1/23/2018        | 11/20/2018  |                |
| 8         | Nitrogen    | 1100                   | 150°F       | NA   | 1210 PSIG                 | DG-3       | 1/23/2018        | 11/20/2018  |                |
| 9         | Nitrogen    | 1100                   | 150°F       | NA   | 1210 PSIG                 | DG-3       | 1/23/2018        | 11/20/2018  |                |
| 10        | Nitrogen    | 1100                   | 150°F       | NA   | 1210 PSIG                 | DG-3       | 1/23/2018        | 11/20/2018  |                |
| 11        | Nitrogen    | 1100                   | 150°F       | NA   | 1210 PSIG                 | DG-3       | 1/23/2018        | 11/20/2018  |                |
| 12        | Nitrogen    | 400                    | 150°F       | NA   | 440 PSIG                  | DG-3       | 1/23/2018        | 11/21/2018  |                |
| 15        | Nitrogen    | 400                    | 150°F       | NA   | 440 PSIG                  | DG-3       | 1/23/2018        | 11/21/2018  |                |
| 17        | Nitrogen    | 1100                   | 150°F       | NA   | 1210 PSIG                 | DG-3       | 1/23/2018        | 11/20/2018  |                |
| 21(D1-CS) | Nitrogen    | 1100                   | 150°F       | NA   | 1210 PSIG                 | DG-3       | 1/23/2018        | 11/20/2018  |                |
| 21(D1-LT) | Nitrogen    | 1100                   | 150°F       | NA   | 1210 PSIG                 | DG-3       | 1/23/2018        | 11/20/2018  |                |
| 21(B1-LT) | Nitrogen    | 400                    | 200°F       | NA   | 440 PSIG                  | DG-3       | 1/23/2018        | 11/21/2018  |                |
| 23        | Nitrogen    | 1100                   | 350°F       | NA   | 1210 PSIG                 | DG-3       | 1/23/2018        | 11/20/2018  |                |
| 29        | Nitrogen    | 400                    | 200°F       | NA   | 440 PSIG                  | DG-3       | 1/23/2018        | 11/21/2018  |                |
| 38        | Nitrogen    | 150                    | 150°F       | NA   | 165 PSIG                  | DG-3       | 1/23/2018        | 11/21/2018  |                |
| 41        | SHOP AIR    | 150                    | 150°F       | NA   | 90 PSIG                   | DG-3       | 1/23/2018        | 11/21/2018  | INSTRUMENT AIR |
| 42        | Nitrogen    | 1400                   | 150°F       | NA   | 1540 PSIG                 | DG-3       | 1/23/2018        | 11/20/2018  |                |
| 43        | Nitrogen    | 1400                   | 150°F       | NA   | 1540 PSIG                 | DG-3       | 1/23/2018        | 11/20/2018  |                |
| 44        | Nitrogen    | 150                    | 150°F       | NA   | 165 PSIG                  | DG-3       | 1/23/2018        | 11/21/2018  |                |
| 100       | Nitrogen    | 150                    | 400°F       | NA   | 165 PSIG                  | DG-3       | 1/23/2018        | 11/21/2018  |                |
| 101       | Nitrogen    | 150                    | 400°F       | NA   | 165 PSIG                  | DG-3       | 1/23/2018        | 11/21/2018  |                |
| 102       | Nitrogen    | 150                    | 400°F       | NA   | 165 PSIG                  | DG-3       | 1/23/2018        | 11/21/2018  |                |
| 103       | Nitrogen    | 150                    | 400°F       | NA   | 165 PSIG                  | DG-3       | 1/23/2018        | 11/21/2018  |                |
| 104       | Nitrogen    | 150                    | 400°F       | NA   | 165 PSIG                  | DG-3       | 1/23/2018        | 11/21/2018  |                |
| 105       | Nitrogen    | 150                    | 400°F       | NA   | 165 PSIG                  | DG-3       | 1/23/2018        | 11/21/2018  |                |
| 106       | Nitrogen    | 150                    | 400°F       | NA   | 165 PSIG                  | DG-3       | 1/23/2018        | 11/21/2018  |                |
| 107       | Nitrogen    | 150                    | 400°F       | NA   | 165 PSIG                  | DG-3       | 1/23/2018        | 11/21/2018  |                |
| 108       | Nitrogen    | 150                    | 400°F       | NA   | 165 PSIG                  | DG-3       | 1/23/2018        | 11/21/2018  |                |
| 109       | Nitrogen    | 150                    | 400°F       | NA   | 165 PSIG                  | DG-3       | 1/23/2018        | 11/21/2018  |                |

**\*Hold all pressure tests for a minimum of 10 minutes**

Witnessed by: *David Osborn*



| SPOOL# | METHOD USED | DESIGN PRESSURE (PSIG) | DESIGN TEMP | TEMPERATURE CORRECTION FACTOR (HYDRO ONLY) | TEST PRESSURE USED (PSIG) | GAUGE USED | CALIBRATION DATE | DATE TESTED | REMARKS |
|--------|-------------|------------------------|-------------|--|---------------------------|------------|------------------|-------------|---------|
| 110    | Nitrogen    | 400                    | 150°F       | NA   | 440 PSIG                  | DG-3       | 1/23/2018        | 11/21/2018  |         |
| 111    | Nitrogen    | 150                    | 150°F       | NA   | 165 PSIG                  | DG-3       | 1/23/2018        | 11/21/2018  |         |
| 112    | Nitrogen    | 500                    | 250°F       | NA   | 550 PSIG                  | DG-3       | 1/23/2018        | 11/21/2018  |         |
| 113    | Nitrogen    | 1100                   | 150°F       | NA   | 1210 PSIG                 | DG-3       | 1/23/2018        | 11/20/2018  |         |
| 114    | Nitrogen    | 400                    | 200°F       | NA   | 440 PSIG                  | DG-3       | 1/23/2018        | 11/21/2018  |         |
| 115    | Nitrogen    | 1100                   | 150°F       | NA   | 1210 PSIG                 | DG-3       | 1/23/2018        | 11/20/2018  |         |
| 116    | Nitrogen    | 1100                   | 150°F       | NA   | 1210 PSIG                 | DG-3       | 1/23/2018        | 11/20/2018  |         |
| 117    | Nitrogen    | 1100                   | 150°F       | NA   | 1210 PSIG                 | DG-3       | 1/23/2018        | 11/20/2018  |         |
| 118    | Nitrogen    | 1100                   | 150°F       | NA   | 1210 PSIG                 | DG-3       | 1/23/2018        | 11/20/2018  |         |
| 119    | Nitrogen    | 500                    | 350°F       | NA   | 550 PSIG                  | DG-3       | 1/23/2018        | 11/21/2018  |         |
| 120    | Nitrogen    | 1100                   | 150°F       | NA   | 1210 PSIG                 | DG-3       | 1/23/2018        | 11/20/2018  |         |
| 121    | Nitrogen    | 1100                   | 150°F       | NA   | 1210 PSIG                 | DG-3       | 1/23/2018        | 11/20/2018  |         |
| 122    | Nitrogen    | 1100                   | 150°F       | NA   | 1210 PSIG                 | DG-3       | 1/23/2018        | 11/20/2018  |         |
| 123    | Nitrogen    | 1100                   | 150°F       | NA   | 1210 PSIG                 | DG-3       | 1/23/2018        | 11/20/2018  |         |
| 124    | Nitrogen    | 1100                   | 150°F       | NA   | 1210 PSIG                 | DG-3       | 1/23/2018        | 11/20/2018  |         |
| 125    | Nitrogen    | 1100                   | 150°F       | NA   | 1210 PSIG                 | DG-3       | 1/23/2018        | 11/20/2018  |         |
| 126    | Nitrogen    | 1100                   | 150°F       | NA   | 1210 PSIG                 | DG-3       | 1/23/2018        | 11/20/2018  |         |
| 127    | Nitrogen    | 1100                   | 150°F       | NA   | 1210 PSIG                 | DG-3       | 1/23/2018        | 11/20/2018  |         |
| 128    | Nitrogen    | 400                    | 150°F       | NA   | 440 PSIG                  | DG-3       | 1/23/2018        | 11/21/2018  |         |
| 129    | Nitrogen    | 400                    | 200°F       | NA   | 440 PSIG                  | DG-3       | 1/23/2018        | 11/21/2018  |         |
| 130    | Nitrogen    | 400                    | 200°F       | NA   | 440 PSIG                  | DG-3       | 1/23/2018        | 11/21/2018  |         |
| 131    | Nitrogen    | 400                    | 150°F       | NA   | 440 PSIG                  | DG-3       | 1/23/2018        | 11/21/2018  |         |
| 132    | Nitrogen    | 1440                   | 200°F       | NA   | 1584 PSIG                 | DG-3       | 1/23/2018        | 11/20/2018  |         |
| 133    | Nitrogen    | 1440                   | 200°F       | NA   | 1584 PSIG                 | DG-3       | 1/23/2018        | 11/20/2018  |         |
| 134    | Nitrogen    | 1440                   | 200°F       | NA   | 1584 PSIG                 | DG-3       | 1/23/2018        | 11/20/2018  |         |
| 135    | Nitrogen    | 1440                   | 200°F       | NA   | 1584 PSIG                 | DG-3       | 1/23/2018        | 11/20/2018  |         |
| 136    | Nitrogen    | 150                    | 150°F       | NA   | 165 PSIG                  | DG-3       | 1/23/2018        | 11/21/2018  |         |
| 137    | Nitrogen    | 1440                   | 200°F       | NA   | 1584 PSIG                 | DG-3       | 1/23/2018        | 11/20/2018  |         |
| 138    | Nitrogen    | 650                    | 200°F       | NA   | 710 PSIG                  | DG-3       | 1/23/2018        | 11/21/2018  |         |
|        |             |                        |             |  |                           |            |                  |             |         |

**\*Hold all pressure tests for a minimum of 10 minutes**

Witnessed by: *David Osborn*





# TGR INDUSTRIAL SERVICES

TX/LA/MS/AL OK/KS/MO/AR  
713 - 636-2288 • 1 - 800 - 625-9288  
www.tgrind.com

## TECHNIQUE/INSPECTION REPORT

DATE 10-23-18 DAY Tue

|                           |              |                             |
|---------------------------|--------------|-----------------------------|
| CUSTOMER DATA             |              | TGR JOB# <u>TL-102318-2</u> |
| NAME <u>UOP Honeywell</u> |              |                             |
| ADDRESS _____             |              |                             |
| PHONE _____               | ATTN: _____  |                             |
| W.O. # <u>2488</u>        | P.O. # _____ |                             |
| JOB LOCATION _____        |              |                             |
| DESCRIPTION _____         |              | MATERIAL TYPE: <u>C15</u>   |

| DEFECT CODE             |  |  |                             |  |  |                           |  |  |  | ABBREVIATED TERMS                            |  |  |                     |  |  |               |  |  |              |  |  |
|-------------------------|--|--|-----------------------------|--|--|---------------------------|--|--|--|--|--|--|---------------------|--|--|---------------|--|--|--------------|--|--|
| AB - ARC BURN           |  |  | HB - HOLLOW BEAD            |  |  | SLI - SLAG INCLUSION      |  |  |  | SOD - SOURCE TO OBJECT DISTANCE              |  |  |                     |  |  |               |  |  |              |  |  |
| AI - ALIGNED INDICATION |  |  | IF - INADEQUATE FUSION      |  |  | SLL - SLAG LINE           |  |  |  | OFD - SOURCE SIDE OF OBJECT TO FILM DISTANCE |  |  | OD - OUTER DIAMETER |  |  | REP - REPAIR  |  |  | RET - RETAKE |  |  |
| BT - BURN THROUGH       |  |  | IP - INCOMPLETE PENETRATION |  |  | SURF - SURFACE INDICATION |  |  |  | WT - WELD THICKNESS                          |  |  | RES - RESHOOT       |  |  | DEN - DENSITY |  |  |              |  |  |
| CON - CONCAVITY         |  |  | MA - MISALIGNMENT           |  |  | UCE - UNDERCUT EXTERNAL   |  |  |  | WR - WELD REINFORCEMENT                      |  |  | BM - BASE MATERIAL  |  |  |               |  |  |              |  |  |
| CRACK - CRACK           |  |  | POR - POROSITY              |  |  | UCI - UNDERCUT INTERNAL   |  |  |  |  |  |  |                     |  |  |               |  |  |              |  |  |

| WELD/FILM NUMBER | JOB NUMBER          | OD         | BM         | WR         | WT          | WITHIN STD'S |    | # FILM   | FILM SIZE / MFG / TYPE | SOD      | OFD        | IQI S <sub>D</sub> | # EXP    | DEN | DEFECT LOCATION |
|------------------|---------------------|------------|------------|------------|-------------|--------------|----|----------|------------------------|----------|------------|--------------------|----------|-----|-----------------|
|                  |                     |            |            |            |             | YES          | NO |          |                        |          |            |                    |          |     |                 |
| 1 <u>LX-1</u>    | <u>J488 SK2-111</u> | <u>4.5</u> | <u>237</u> | <u>125</u> | <u>.362</u> |              |    | <u>3</u> | <u>3 1/2 X 10 500V</u> | <u>4</u> | <u>362</u> | <u>10</u>          | <u>3</u> |     | <u>T-2 IP</u>   |
| 2 <u>PX-1</u>    | <u>J488 SK2-135</u> | <u>3.5</u> | <u>300</u> | <u>125</u> | <u>.425</u> |              |    | <u>3</u> | <u>3 1/2 X 10 500V</u> | <u>3</u> | <u>425</u> | <u>10</u>          | <u>3</u> |     |                 |
| 3                |                     |            |            |            |             |              |    |          |                        |          |            |                    |          |     |                 |
| 4                |                     |            |            |            |             |              |    |          |                        |          |            |                    |          |     |                 |
|   |                                     |                            |   |                             |                                     |                                 |
|---|-------------------------------------|----------------------------|---|-----------------------------|-------------------------------------|---------------------------------|
| PROCEDURE <u>CR</u>                       | EXP. ARRANGEMENT <u>D</u>           | SOURCE <u>IR-192</u>       | CURIES/KV <u>90</u>   | SOURCE SIZE DIA. <u>10x</u> | DEV. TEMP <u>Auto</u>               | DEV. TIME <u>Auto</u>           |
| JO. OF WELDS <u>2</u>                     | FT. LONG SEAMS                      | STANDARDS <u>B31-3 NPS</u> | NO. OF FILM <u>6</u>  | FILM/CASSETTE <u>1</u>      | EXPOSURE: DBL WALL <u>X</u> S. WALL | MR/R <u>2</u> SCREENS <u>PB</u> |
| TRUCK NO. / <u>F129</u>                   | REPORT NO. OF                       | PAGE NO. OF                | PER DIEM <input type="checkbox"/> YES <input type="checkbox"/> NO | ON SITE HOURS               | TRAVEL HOURS                        | TOTAL HOURS                     |
| FILM INTERPRETER                          | ASST. NAME <u>La, Stunner Waver</u> |                            |   | ASNT LEVEL <u>II</u>        |                                     |                                 |
| COMPANY REPRESENTATIVE <u>Jeremy Murr</u> |                                     |                            | NDT TECHNICIAN <u>Jeremy Murr</u>                                 |                             |                                     | ASNT LEVEL <u>II</u>            |

SIGNATURE CERTIFIES TIME & MATERIALS CORRECT

No. **011636**

# TGR INDUSTRIAL SERVICES

TX/LA/MS/AL OK/KS/MO/AR  
713 - 636-2288 • 1 - 800 - 625-9288  
www.tgrind.com


## TECHNIQUE/INSPECTION REPORT

DATE 10-30-18 DAY TUESDAY

|                             |                          |                |
|-----------------------------|--------------------------|----------------|
| CUSTOMER DATA               |                          | TGR JOB# _____ |
| NAME <u>UOP Honeywell</u>   |                          |                |
| ADDRESS _____               |                          |                |
| PHONE _____                 | ATTN: _____              |                |
| W.O. # _____                | P.O. # _____             |                |
| JOB LOCATION <u>Catoosa</u> | MATERIAL TYPE: <u>CS</u> |                |
| DESCRIPTION <u>S488 SKZ</u> |                          |                |

| DEFECT CODE             |  |  |                             |  |  |                           |  |  |  | ABBREVIATED TERMS                            |  |  |                     |  |  |               |  |  |              |  |  |
|-------------------------|--|--|-----------------------------|--|--|---------------------------|--|--|--|--|--|--|---------------------|--|--|---------------|--|--|--------------|--|--|
| AB - ARC BURN           |  |  | HB - HOLLOW BEAD            |  |  | SLI - SLAG INCLUSION      |  |  |  | SOD = SOURCE TO OBJECT DISTANCE              |  |  |                     |  |  |               |  |  |              |  |  |
| AI - ALIGNED INDICATION |  |  | IF - INADEQUATE FUSION      |  |  | SLL - SLAG LINE           |  |  |  | OFD = SOURCE SIDE OF OBJECT TO FILM DISTANCE |  |  | OD = OUTER DIAMETER |  |  | REP = REPAIR  |  |  | RET = RETAKE |  |  |
| BT - BURN THROUGH       |  |  | IP - INCOMPLETE PENETRATION |  |  | SURF - SURFACE INDICATION |  |  |  | WT = WELD THICKNESS                          |  |  | RES = RESHOOT       |  |  | DEN = DENSITY |  |  |              |  |  |
| CON - CONCAVITY         |  |  | MA - MISALIGNMENT           |  |  | UCE - UNDERCUT EXTERNAL   |  |  |  | WR = WELD REINFORCEMENT                      |  |  | BM = BASE MATERIAL  |  |  |               |  |  |              |  |  |
| CRACK - CRACK           |  |  | POR - POROSITY              |  |  | UCI - UNDERCUT INTERNAL   |  |  |  |  |  |  |                     |  |  |               |  |  |              |  |  |

| WELD/FILM NUMBER | JOB NUMBER  | OD    | BM  | WR  | WT  | WITHIN STD'S |    | # FILM | FILM SIZE / MFG / TYPE | SOD   | OFD | IQI S-F | # EXP | DEN | DEFECT LOCATION |
|------------------|-------------|-------|-----|-----|-----|--------------|----|--------|------------------------|-------|-----|---------|-------|-----|-----------------|
|                  |             |       |     |     |     | YES          | NO |        |                        |       |     |         |       |     |                 |
| 1 T-2            | SKZ-111 LX1 | 4.5   | 237 | 125 | 367 | /            | /  | 1      | 3 1/2 x 10 50um        | 4.5   | 367 | 10P     | 1     |     |                 |
| 2 Z-3            |             | ↓     | ↓   | ↓   | ↓   | /            | /  |        | ↓                      | ↓     | ↓   | ↓       |       |     |                 |
| 3 Z-T            |             | ↓     | ↓   | ↓   | ↓   | /            | /  |        | ↓                      | ↓     | ↓   | ↓       |       |     |                 |
| 4 T-2            | SKZ-100 PX2 | 8 7/8 | 322 |     | 447 | /            | /  |        | 3 1/2 x 17 50um        | 8 7/8 | 447 | 12P     |       |     |                 |
| 5 Z-3            |             | ↓     | ↓   | ↓   | ↓   | /            | /  |        | ↓                      | ↓     | ↓   | ↓       |       |     |                 |
| 6 Z-T            |             | ↓     | ↓   | ↓   | ↓   | /            | /  |        | ↓                      | ↓     | ↓   | ↓       |       |     |                 |
| 7 T-2            | SKZ-134 PX3 | 6 1/2 | 432 |     | 557 | /            | /  |        |                        | 6 1/2 | 557 | 1B      |       |     |                 |
| 8 Z-3            |             | ↓     | ↓   | ↓   | ↓   | /            | /  |        | ↓                      | ↓     | ↓   | ↓       |       |     |                 |
| 9 Z-T            |             | ↓     | ↓   | ↓   | ↓   | /            | /  |        | ↓                      | ↓     | ↓   | ↓       |       |     |                 |
| 10 T-2           | SKZ-134 PX4 | ↓     | ↓   | ↓   | ↓   | /            | /  |        | ↓                      | ↓     | ↓   | ↓       |       |     |                 |
| 11 Z-3           |             | ↓     | ↓   | ↓   | ↓   | /            | /  |        | ↓                      | ↓     | ↓   | ↓       |       |     |                 |
| 12 Z-T           |             | ↓     | ↓   | ↓   | ↓   | /            | /  |        | ↓                      | ↓     | ↓   | ↓       |       |     |                 |
| 13               |             |       |     |     |     |              |    |        |                        |       |     |         |       |     |                 |
| 14               |             |       |     |     |     |              |    |        |                        |       |     |         |       |     |                 |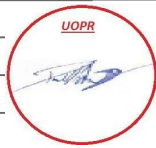
|                        |   |                                       |  |                              |  |                       |
|------------------------|---|---------------------------------------|--|------------------------------|--|-----------------------|
| PROCEDURE <u>CR</u>    | EXP. ARRANGEMENT                        | SOURCE <u>IR192</u>                   | CURIES/KV <u>85</u>  | SOURCE SIZE DIA. <u>1106</u> | DEV. TEMP <u>Auto</u>  | DEV. TIME <u>Auto</u> |
| NO. OF WELDS <u>4</u>  | FT. LONG SEAMS <u>NA</u>                | STANDARDS <u>B31.3 NORMAL</u>         | NO. OF FILM <u>12</u>  | FILM/CASSETTE <u>1</u>       | EXPOSURE: DBL WALL <input checked="" type="checkbox"/> S. WALL | MR/R SCREENS <u>3</u> |
| TRUCK NO. / <u>129</u> | REPORT NO. <u>1</u> OF <u>1</u>         | PAGE NO. <u>1</u> OF <u>1</u>         | PER DIEM <input type="checkbox"/> YES <input checked="" type="checkbox"/> NO | ON SITE HOURS                | TRAVEL HOURS   | TOTAL HOURS           |
| SHOP <u>129</u>        | FILM INTERPRETER <u>Jeremy McMaster</u> | ASST. NAME <u>Levi Adams</u>          | ASNT LEVEL <u>II</u>   |                              | ASNT LEVEL <u>II</u>   |                       |
| COMPANY REPRESENTATIVE |   | NDT TECHNICIAN <u>Jeremy McMaster</u> |  | SIGNATURE                    |  |                       |

SIGNATURE CERTIFIES TIME & MATERIALS CORRECT

TGR INDUSTRIAL SERVICES ASSUMES NO RESPONSIBILITY FOR LOSSES DUE TO INTERPRETATION

No.

013281

# TGR INDUSTRIAL SERVICES

TX/LA/MS/AL OK/KS/MO/AR  
713 - 636-2288 • 1 - 800 - 625-9288  
www.tgrind.com


CUSTOMER DATA TGR JOB# TC110218-4  
NAME UOP Honeywell  
ADDRESS \_\_\_\_\_  
PHONE \_\_\_\_\_ ATTN: \_\_\_\_\_  
W.O. # \_\_\_\_\_ P.O. # \_\_\_\_\_  
JOB LOCATION Catoosa  
DESCRIPTION S488 SKZ MATERIAL TYPE: C.S/SS

## TECHNIQUE/INSPECTION REPORT

DATE 11-2-18 DAY FRIDAY

| DEFECT CODE:            |                             |                           |                                 |  |  |  |  |  |                    | ABBREVIATED TERMS |  |              |  |  |  |
|-------------------------|-----------------------------|---------------------------|---------------------------------|--|--|--|--|--|--------------------|-------------------|--|--------------|--|--|--|
| AB - ARC BURN           | HB - HOLLOW BEAD            | SLI - SLAG INCLUSION      | SOD = SOURCE TO OBJECT DISTANCE |  |  | OFD = SOURCE SIDE OF OBJECT TO FILM DISTANCE |  |  | REP = REPAIR       |                   |  | RET = RETAKE |  |  |  |
| AI - ALIGNED INDICATION | IF - INADEQUATE FUSION      | SLL - SLAG LINE           | OD = OUTER DIAMETER             |  |  | RES = RESHOOT                                |  |  | DEN = DENSITY      |                   |  |              |  |  |  |
| BT - BURN THROUGH       | IP - INCOMPLETE PENETRATION | SURF - SURFACE INDICATION | WT = WELD THICKNESS             |  |  | WR = WELD REINFORCEMENT                      |  |  | BM = BASE MATERIAL |                   |  |              |  |  |  |
| CON - CONCAVITY         | MA - MISALIGNMENT           | UCE - UNDERCUT EXTERNAL   |                                 |  |  |  |  |  |                    |                   |  |              |  |  |  |
| CRACK - CRACK           | POR - POROSITY              | UCI - UNDERCUT INTERNAL   |                                 |  |  |  |  |  |                    |                   |  |              |  |  |  |

| WELD/FILM NUMBER | JOB NUMBER  | OD   | BM   | WR   | WT   | WITHIN STD'S |    | # FILM | FILM SIZE / MFG / TYPE | SOD  | OFD  | IQI S-F | # EXP | DEN | DEFECT LOCATION |
|------------------|-------------|------|------|------|------|--------------|----|--------|------------------------|------|------|---------|-------|-----|-----------------|
|                  |             |      |      |      |      | YES          | NO |        |                        |      |      |         |       |     |                 |
| 1 T-2            | SKZ-137 PX5 | 6.75 | 4.32 | 1.25 | 5.62 |              |    | 1      | 3 1/2 x 10 50um        | 6.75 | 5.62 | 1B      | 1     |     |                 |
| 2 Z-3            |             |      |      |      |      |              |    |        |                        |      |      |         |       |     |                 |
| 3 B-T            |             |      |      |      |      |              |    |        |                        |      |      |         |       |     |                 |
| 4 T-2            | SKZ-124 PX6 | 3.37 | 2.16 |      | 3.41 |              |    |        |                        | 3.37 | 3.41 | 10P     |       |     |                 |
| 5 Z-3            |             |      |      |      |      |              |    |        |                        |      |      |         |       |     |                 |
| 6 B-T            |             |      |      |      |      |              |    |        |                        |      |      |         |       |     |                 |
| 7 T-2            | SKZ-124 PX7 |      |      |      |      |              |    |        |                        |      |      |         |       |     |                 |
| 8 Z-3            |             |      |      |      |      |              |    |        |                        |      |      |         |       |     |                 |
| 9 B-T            |             |      |      |      |      |              |    |        |                        |      |      |         |       |     |                 |
| 10               |             |      |      |      |      |              |    |        |                        |      |      |         |       |     |                 |
| 11               |             |      |      |      |      |              |    |        |                        |      |      |         |       |     |                 |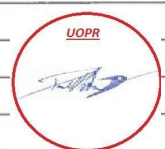
PROCEDURE CR EXP. ARRANGEMENT \_\_\_\_\_ SOURCE IR19Z CURIES/KV 80 SOURCE SIZE DIA. .106 DEV. TEMP Auto DEV. TIME Auto

NO. OF WELDS 3 FT. LONG SEAMS \_\_\_\_\_ STANDARDS B31.3 NORMAL NO. OF FILM 9 FILM/CASSETTE 1 EXPOSURE: DBL WALL  S. WALL \_\_\_\_\_ MR/R SCREENS 3

TRUCK NO. 129 REPORT NO. 1 OF 1 PAGE NO. 1 OF 1 PER DIEM  YES  NO ON SITE HOURS \_\_\_\_\_ TRAVEL HOURS \_\_\_\_\_ TOTAL HOURS \_\_\_\_\_ MILEAGE \_\_\_\_\_

FILM INTERPRETER Jeremy McMaster ASST. NAME Levi Adams ASNT LEVEL II

COMPANY REPRESENTATIVE \_\_\_\_\_ NDT TECHNICIAN Jeremy McMaster ASNT LEVEL II

SIGNATURE CERTIFIES TIME & MATERIALS CORRECT

SIGNATURE

No. 011684

# TGR INDUSTRIAL SERVICES

TX/LA/MS/AL OK/KS/MO/AR  
713 - 636-2288 • 1 - 800 - 625-9288  
www.tgrind.com

CUSTOMER DATA TGR JOB# \_\_\_\_\_  
NAME UOP Honeywell  
ADDRESS \_\_\_\_\_  
PHONE \_\_\_\_\_ ATTN: \_\_\_\_\_  
W.O. # \_\_\_\_\_ P.O. # \_\_\_\_\_  
JOB LOCATION Catoosa  
DESCRIPTION J488 SKZ MATERIAL TYPE: CS

## TECHNIQUE/INSPECTION REPORT

DATE 11-15-18 DAY THURSDAY

| DEFECT CODE             |                             |                           |  |  |  |  |  |  |                     | ABBREVIATED TERMS |               |              |              |  |  |
|-------------------------|-----------------------------|---------------------------|--|--|--|--|--|--|---------------------|-------------------|---------------|--------------|--------------|--|--|
| AB - ARC BURN           | HB - HOLLOW BEAD            | SLI - SLAG INCLUSION      | SOD = SOURCE TO OBJECT DISTANCE              |  |  | OFD = SOURCE SIDE OF OBJECT TO FILM DISTANCE |  |  | OD = OUTER DIAMETER |                   |               | REP = REPAIR | RET = RETAKE |  |  |
| AI - ALIGNED INDICATION | IF - INADEQUATE FUSION      | SLL - SLAG LINE           | OFD = SOURCE SIDE OF OBJECT TO FILM DISTANCE |  |  | OD = OUTER DIAMETER                          |  |  | WT = WELD THICKNESS | RES = RESHOOT     | DEN = DENSITY |              |              |  |  |
| BT - BURN THROUGH       | IP - INCOMPLETE PENETRATION | SURF - SURFACE INDICATION | WR = WELD REINFORCEMENT                      |  |  | BM = BASE MATERIAL                           |  |  |                     |                   |               |              |              |  |  |
| CON - CONCAVITY         | MA - MISALIGNMENT           | UCE - UNDERCUT EXTERNAL   |  |  |  |  |  |  |                     |                   |               |              |              |  |  |
| CRACK - CRACK           | POR - POROSITY              | UCI - UNDERCUT INTERNAL   |  |  |  |  |  |  |                     |                   |               |              |              |  |  |

| WELD/FILM NUMBER | JOB NUMBER  | OD   | BM  | WR  | WT  | WITHIN STD'S |    | # FILM | FILM SIZE / MFG / TYPE | SOD  | OFD | IQI S-F | # EXP | DEN | DEFECT LOCATION |
|------------------|-------------|------|-----|-----|-----|--------------|----|--------|------------------------|------|-----|---------|-------|-----|-----------------|
|                  |             |      |     |     |     | YES          | NO |        |                        |      |     |         |       |     |                 |
| 1 T-2            | SKZ-105 PX8 | 8.75 | 322 | 125 | 447 | /            |    | 1      | 3/2x17100UM            | 8.75 | 447 | 12P     | 1     |     |                 |
| 2 Z-3            |             | ↓    | ↓   | ↓   | ↓   | /            |    |        |                        | ↓    | ↓   | ↓       | ↓     |     |                 |
| 3 3-T            |             | ↓    | ↓   | ↓   | ↓   | /            |    |        |                        | ↓    | ↓   | ↓       | ↓     |     |                 |
| 4 T-2            | SKZ-105 PX9 | ↓    | ↓   | ↓   | ↓   | /            |    |        |                        | ↓    | ↓   | ↓       | ↓     |     |                 |
| 5 Z-3            |             | ↓    | ↓   | ↓   | ↓   | /            |    |        |                        | ↓    | ↓   | ↓       | ↓     |     |                 |
| 6 3-T            |             | ↓    | ↓   | ↓   | ↓   | /            |    |        |                        | ↓    | ↓   | ↓       | ↓     |     |                 |
| 7                |             |      |     |     |     |              |    |        |                        |      |     |         |       |     |                 |
| 8                |             |      |     |     |     |              |    |        |                        |      |     |         |       |     |                 |
PROCEDURE CR EXP. ARRANGEMENT \_\_\_\_\_ SOURCE IR192 CURIES/KV 70 SOURCE SIZE DIA. .106 DEV. TEMP Auto DEV. TIME Auto

NO. OF WELDS 2 FT. LONG SEAMS \_\_\_\_\_ STANDARDS B313 NORMAL NO. OF FILM 6 FILM/CASSETTE 1 EXPOSURE: DBL WALL X S. WALL \_\_\_\_\_ MR/R 3 SCREENS

TRUCK NO. 129 REPORT NO. 1 of 1 PAGE NO. 1 of 1 PER DIEM  YES  NO ON SITE HOURS \_\_\_\_\_ TRAVEL HOURS \_\_\_\_\_ TOTAL HOURS \_\_\_\_\_ MILEAGE \_\_\_\_\_



FILM INTERPRETER Jeremy McMaster ASST. NAME Levi Adams ASNT LEVEL II

COMPANY REPRESENTATIVE \_\_\_\_\_ NDT TECHNICIAN Jeremy McMaster ASNT LEVEL II

SIGNATURE CERTIFIES TIME & MATERIALS CORRECT

SIGNATURE

No. 012112

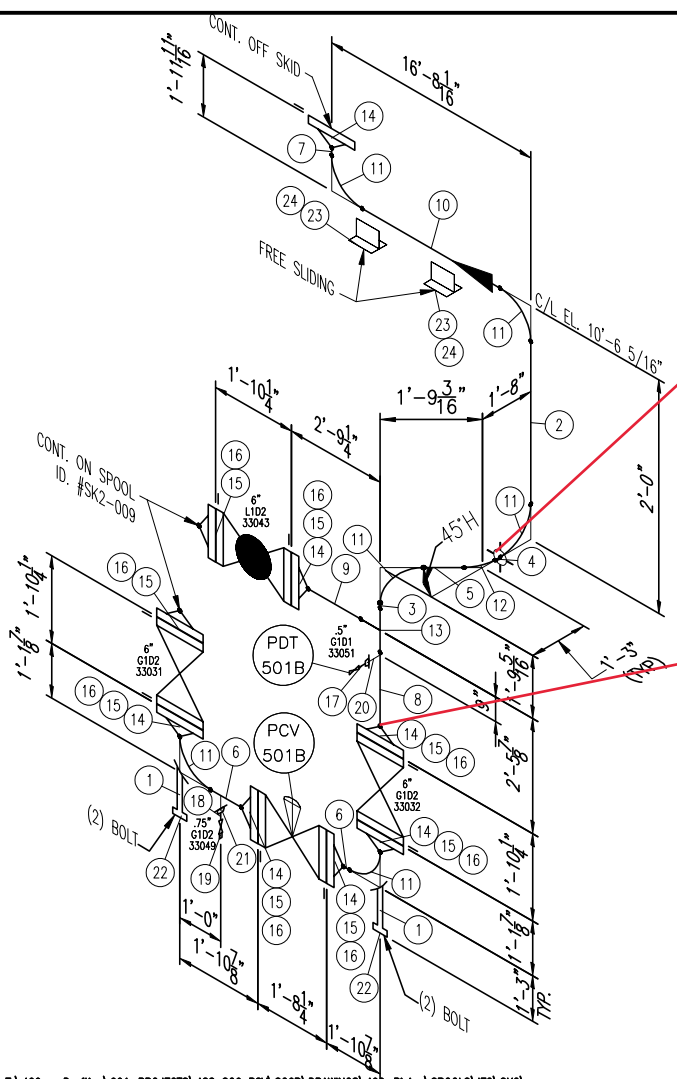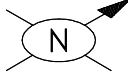

**P**  
**15**

**P**  
**13**

SHOP WELD

BILL OF MATERIAL

| MARK | QTY | SIZE    | DESCRIPTION   | LENGTH      |
|------|-----|---------|---|-------------|
| 1    | 2   | 3"      | PIPE, STD SMLS, A-333-6   | 1'-11 1/2"  |
| 2    | 1   | 6"      | PIPE, XH SMLS, A-333-6  | 6"          |
| 3    | 1   | 6"      | PIPE, XH SMLS, A-333-6  | 6 11/16"    |
| 4    | 1   | 6"      | PIPE, XH SMLS, A-333-6  | 7 1/4"      |
| 5    | 1   | 6"      | PIPE, XH SMLS, A-333-6  | 8 7/16"     |
| 6    | 2   | 6"      | PIPE, XH SMLS, A-333-6  | 9"          |
| 7    | 1   | 6"      | PIPE, XH SMLS, A-333-6  | 9 13/16"    |
| 8    | 1   | 6"      | PIPE, XH SMLS, A-333-6  | 1'-7 3/8"   |
| 9    | 1   | 6"      | PIPE, XH SMLS, A-333-6  | 1'-10 3/4"  |
| 10   | 1   | 6"      | PIPE, XH SMLS, A-333-6  | 15'-2 1/16" |
| 11   | 6   | 6"      | ELL, 90 LR XH, A-420-WPL6   |             |
| 12   | 1   | 6"      | ELL, 45 LR XH, A-420-WPL6   |             |
| 13   | 1   | 6"      | TEE, STR. XH, A-420-WPL6  |             |
| 14   | 7   | 6"      | FLG, RFWN 600LB XH, A-350-LF2   |             |
| 15   | 8   | 1"      | (12) STUD BOLTS, A-193-B7 w/ TWO HEAVY HEX NUTS, A-194-2H                                   | 7"          |
| 16   | 8   | 6"      | GASKET, 1/8" THK, 600LB RF, SPIRALWOUND, 304SS WINDING, FLEXITE SUPER FILLER, CS GUIDE RING |             |
| 17   | 1   | 1/2"    | NIPPLE, S/160 SMLS, A-333-6 POE-TOE   | 3"          |
| 18   | 1   | 3/4"    | NIPPLE, S/160 SMLS, A-333-6 POE-TOE   | 3"          |
| 19   | 1   | 3/4"    | PLUG, SOLID STEEL, ROUND HEAD, A-350-LF2  |             |
| 20   | 1   | 6"x1/2" | SOL, 3000LB FS, A-350-LF2   |             |
| 21   | 1   | 6"x3/4" | SOL, 3000LB FS, A-350-LF2   |             |
| 22   | 2   |         | BASE PLATE, 1/2" THK. x 6" x 6" (SA-36 MATERIAL)  |             |
| 23   | 2   |         | PLATE, 1/4" THK. x 2 3/4" x 6" (SA-516-70 MATERIAL)   |             |
| 24   | 2   |         | PLATE, 1/4" THK. x 6" x 6" (SA-516-70 MATERIAL)   |             |

**J-488**  
**04/11/18**  
**IFC**

\*\*\* = JOB #

Apr 10, 2018 - 4:12pm Z:\400 - Drafting\001-PROJECTS\488 SC6 RSV\SC6R\DRAWINGS\400-Piping\SPOOLS\IFC\SK2\

|                |            |                |                |     |                        |          |     |     |
|----------------|------------|----------------|----------------|-----|------------------------|----------|-----|-----|
| DESIGN PRESS.  | 1100 Psig  | FAB. LOCATION  | SHOP           |     |                        |          |     |     |
| DESIGN TEMP.   | 150 °F     | SPOOL LOCATION | SKID #2        |     |                        |          |     |     |
| OPER. PRESS.   | 865 Psia   |                |                |     |                        |          |     |     |
| OPER. TEMP.    | 0 °F       | CORR. ALLOW.   | .0625"         |     |                        |          |     |     |
| STRESS RELIEVE | NO         | INSULATION     | 1.5°C          | 0   | ISSUE FOR CONSTRUCTION | 04/25/11 | PLD | LH  |
| RADIOGRAPHY    | 15% NORMAL | PAINT          | TRCo SYSTEM #3 | NO. | REVISION               |          |     | APR |


**CONFIDENTIAL STATEMENT**  
THIS DRAWING IS THE PROPERTY OF THE THOMAS RUSSELL CO. AND IS NOT TO BE USED FOR ANY PURPOSE OTHER THAN THAT FOR WHICH IT IS SPECIFICALLY FURNISHED.

**FABRICATION NOTES:**  
ALL VALVES ARE RAISED FACE UNLESS NOTED.  
ALL FITTING MAKE-UP & CUT LENGTHS FOR BW PIPE DO NOT INCLUDE WELD GAPS.  
SHOP TO MAKE ADJUSTMENTS FOR WELD GAPS.  
ALL PIPE SEAMLESS UNLESS NOTED OTHERWISE.  
ALL COUPLING TO BE SHOULDER ON.


**Thomas Russell Co.**

7050 S. Yale, Suite 210  
Tulsa, Oklahoma 74136  
PH.: 918-481-5682

|                  |                    |               |          |
|------------------|--------------------|---------------|----------|
| LINE No.         | 159-D1-LT-6" 1.5°C |               |          |
| ASSEMBLY DRAWING | SC6-402            |               |          |
| P&ID DRAWING     | ***-233            |               |          |
| DRAWN BY         | DV                 | DATE DRAWN    | 03/21/11 |
| JOB No.          | SC6                | SPOOL LD. No. | SK2-010  |
| REV.             |                    |               | 0        |

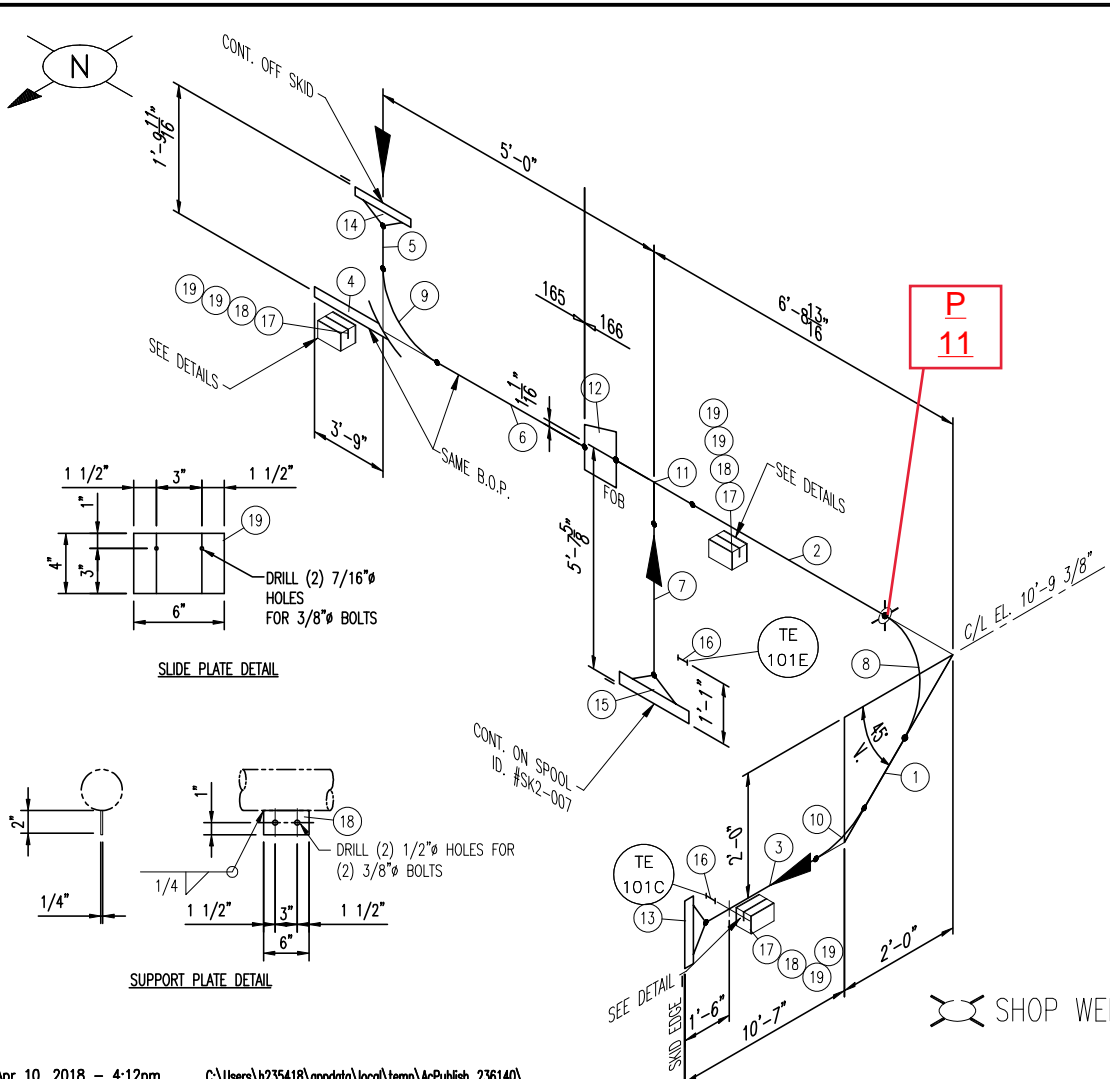

| BILL OF MATERIAL |     |        |   |             |
|------------------|-----|--------|---|-------------|
| MARK             | QTY | SIZE   | DESCRIPTION   | LENGTH      |
| 1                | 1   | 10"    | PIPE, S/40S EFW, A-312-TP304/304L                     | 1'-0 11/16" |
| 2                | 1   | 10"    | PIPE, S/40S EFW, A-312-TP304/304L                     | 4'-9 5/16"  |
| 3                | 1   | 10"    | PIPE, S/40S EFW, A-312-TP304/304L                     | 9'-8 1/8"   |
| 4                | 1   | 4"     | PIPE, S/10S EFW, A-312-TP304/304L                     | 4'-9"       |
| 5                | 1   | 8"     | PIPE, S/40S EFW, A-312-TP304/304L                     | 5 5/16"     |
| 6                | 1   | 8"     | PIPE, S/40S EFW, A-312-TP304/304L                     | 2'-8 1/2"   |
| 7                | 1   | 8"     | PIPE, S/40S EFW, A-312-TP304/304L                     | 4'-6 1/8"   |
| 8                | 1   | 10"    | ELL, 90 LR S/40S, A-403-WP304/304L                    |             |
| 9                | 1   | 8"     | ELL, 90 LR S/40S, A-403-WP304/304L                    |             |
| 10               | 1   | 10"    | ELL, 45 LR S/40S, A-403-WP304/304L                    |             |
| 11               | 1   | 10"x8" | TEE, RED S/40S, A-403-WP304/304L                      |             |
| 12               | 1   | 10"x8" | REDUCER, ECC S/40S, A-403-WP304/304L                  |             |
| 13               | 1   | 10"    | FLG, RFWN 300LB S/40S, A-182-F304/304L                |             |
| 14               | 1   | 8"     | FLG, RFWN 300LB S/40S, A-182-F304/304L                |             |
| 15               | 1   | 8"     | FLG, RFWN 600LB S/40S, A-182-F304/304L                |             |
| 16               | 2   | 3/4"   | CPLG, TOE x 3" LG, 3000LB FS, A-182-F304/304L         |             |
| 17               | 3   |        | NYLON BLOCK, 4" x 4" x 6" LG                          |             |
| 18               | 3   |        | PLATE, 1/4" THK x 2" x 6" LG A-240-304SS (PER DETAIL) |             |
| 19               | 6   |        | PLATE, 1/4" THK x 4" x 6" LG A-240-304SS (PER DETAIL) |             |

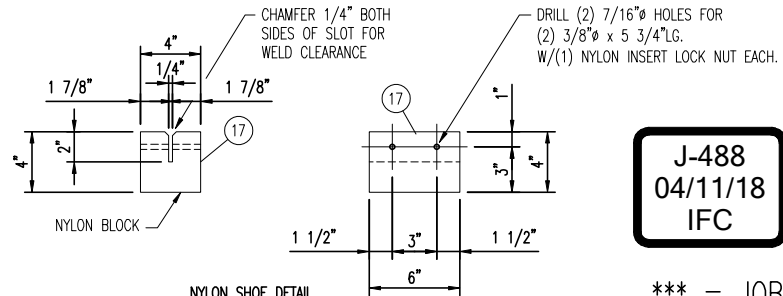

**J-488**  
04/11/18  
IFC

\*\*\* = JOB #

Apr 10, 2018 - 4:12pm C:\Users\h235418\appdata\local\temp\AcPublish\_236140\


|                |            |                |         |     |                        |          |     |     |
|----------------|------------|----------------|---------|-----|------------------------|----------|-----|-----|
| DESIGN PRESS.  | 400 Psig   | FAB. LOCATION  | SHOP    |     |                        |          |     |     |
| DESIGN TEMP.   | 150 °F     | SPOOL LOCATION | SKID #2 |     |                        |          |     |     |
| OPER. PRESS.   | 220 Psia   |                |         |     |                        |          |     |     |
| OPER. TEMP.    | -83 °F     | CORR. ALLOW.   | 0"      |     |                        |          |     |     |
| STRESS RELIEVE | NO         | INSULATION     | 2.5"C   | 0   | ISSUE FOR CONSTRUCTION | 04/25/11 | PLD | LH  |
| RADIOGRAPHY    | 15% NORMAL | PAINT          | NONE    | NO. | REVISION               |          | BY  | APR |

**CONFIDENTIAL STATEMENT**  
THIS DRAWING IS THE PROPERTY OF THE THOMAS RUSSELL Co. AND IS NOT TO BE USED FOR ANY PURPOSE OTHER THAN THAT FOR WHICH IT IS SPECIALLY FURNISHED.


**FABRICATION NOTES:**  
ALL VALVES ARE RAISED FACE UNLESS NOTED.  
ALL FITTING MAKE-UP & CUT LENGTHS FOR BW PIPE DO NOT INCLUDE WELD GAPS.  
SHOP TO MAKE ADJUSTMENTS FOR WELD GAPS.  
ALL PIPE SEAMLESS UNLESS NOTED OTHERWISE.  
ALL COUPLING TO BE SHOULDER ON.

**Thomas Russell Co.**  
7050 S. Yale, Suite 210  
Tulsa, Oklahoma 74136  
PH.: 918-481-5682

|                  |                        |               |          |
|------------------|------------------------|---------------|----------|
| LINE No.         | 166-B0-304SS-10" 2.5"C |               |          |
| ASSEMBLY DRAWING | SC6-402                |               |          |
| P&ID DRAWING     | ***-233                |               |          |
| DRAWN BY         | DV                     | DATE DRAWN    | 03/21/11 |
| JOB No.          | SC6                    | SPOOL LD. No. | SK2-015  |
| REV.             |                        |               | 0        |

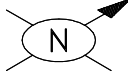

**P  
14**

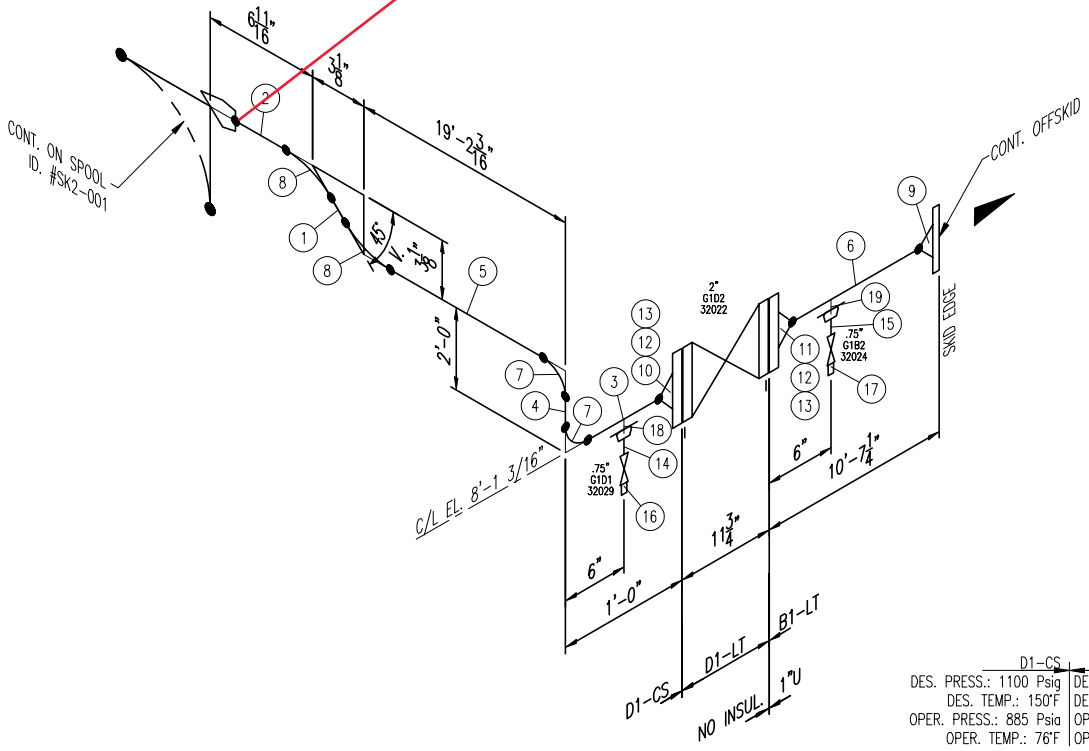

| D1-CS                  | D1-LT                  | B1-LT                  |
|------------------------|------------------------|------------------------|
| DES. PRESS.: 1100 Psig | DES. PRESS.: 1100 Psig | DES. PRESS.: 400 Psig  |
| DES. TEMP.: 150°F      | DES. TEMP.: 150°F      | DES. TEMP.: 200°F      |
| OPER. PRESS.: 885 Psia | OPER. PRESS.: 885 Psia | OPER. PRESS.: 220 Psia |
| OPER. TEMP.: 76°F      | OPER. TEMP.: 60°F      | OPER. TEMP.: 60°F      |

BILL OF MATERIAL

| MARK | QTY | SIZE    | DESCRIPTION   | LENGTH       |
|------|-----|---------|---|--------------|
| 1    | 1   | 2"      | PIPE, XH SMLS, A-106-B  | 1 11/16"     |
| 2    | 1   | 2"      | PIPE, XH SMLS, A-106-B  | 3"           |
| 3    | 1   | 2"      | PIPE, XH SMLS, A-106-B  | 5 7/8"       |
| 4    | 1   | 2"      | PIPE, XH SMLS, A-106-B  | 1'-6"        |
| 5    | 1   | 2"      | PIPE, XH SMLS, A-106-B  | 18'-9 13/16" |
| 6    | 1   | 2"      | PIPE, XH SMLS, A-333-6  | 10'-1 3/8"   |
| 7    | 2   | 2"      | ELL, 90 LR XH, A-234-WPB  |              |
| 8    | 2   | 2"      | ELL, 45 LR XH, A-234-WPB  |              |
| 9    | 1   | 2"      | FLG, RFWN 300LB XH, A-350-LF2   |              |
| 10   | 1   | 2"      | FLG, RFWN 600LB XH, A-105   |              |
| 11   | 1   | 2"      | FLG, RFWN 600LB XH, A-350-LF2   |              |
| 12   | 2   | 5/8"    | (8) STUD BOLTS, A-193-B7 w/ TWO HEAVY HEX NUTS, A-194-2H                                    | 4 1/2"       |
| 13   | 2   | 2"      | CASKET, 1/8" THK, 600LB RF, SPIRALWOUND, 304SS WINDING, FLEXITE SUPER FILLER, CS GUIDE RING |              |
| 14   | 1   | 3/4"    | NIPPLE, S/160 SMLS, A-106-B POE-TOE   | 3"           |
| 15   | 1   | 3/4"    | NIPPLE, XH SMLS, A-333-6 POE-TOE  | 3"           |
| 16   | 1   | 3/4"    | PLUG, SOLID STEEL, ROUND HEAD, A-105  |              |
| 17   | 1   | 3/4"    | PLUG, SOLID STEEL, ROUND HEAD, A-350-LF2  |              |
| 18   | 1   | 2"x3/4" | SOL, 3000LB FS, A-105   |              |
| 19   | 1   | 2"x3/4" | SOL, 3000LB FS, A-350-LF2   |              |

**J-488**  
04/11/18  
IFC

\*\*\* = JOB #

Apr 10, 2018 - 4:12pm C:\Users\h235418\appdata\local\temp\AcPublish\_236140\

|                |            |                |                |     |                        |          |        |
|----------------|------------|----------------|----------------|-----|------------------------|----------|--------|
| DESIGN PRESS.  | NOTED Psig | FAB. LOCATION  | SHOP           |     |                        |          |        |
| DESIGN TEMP.   | NOTED °F   | SPOOL LOCATION | SKID #2        |     |                        |          |        |
| OPER. PRESS.   | NOTED Psia |                |                |     |                        |          |        |
| OPER. TEMP.    | NOTED °F   | CORR. ALLOW.   | .0625"         |     |                        |          |        |
| STRESS RELIEVE | NO         | INSULATION     | NOTED          | 0   | ISSUE FOR CONSTRUCTION | 04/25/11 | PLD LH |
| RADIOGRAPHY    | 15% NORMAL | PAINT          | TRCo SYSTEM #3 | NO. | REVISION               | DATE     | BY APR |


**CONFIDENTIAL STATEMENT**  
THIS DRAWING IS THE PROPERTY OF THE THOMAS RUSSELL CO. AND IS NOT TO BE USED FOR ANY PURPOSE OTHER THAN THAT FOR WHICH IT IS SPECIFICALLY FURNISHED.

**FABRICATION NOTES:**  
ALL VALVES ARE RAISED FACE UNLESS NOTED.  
ALL FITTING MAKE-UP & CUT LENGTHS FOR BW PIPE DO NOT INCLUDE WELD GAPS.  
SHOP TO MAKE ADJUSTMENTS FOR WELD GAPS.  
ALL PIPE SEAMLESS UNLESS NOTED OTHERWISE.  
ALL COUPLING TO BE SHOULDER ON.

**Thomas Russell Co.**

7050 S. Yale, Suite 210  
Tulsa, Oklahoma 74136  
PH.: 918-481-5682

|                  |              |               |          |
|------------------|--------------|---------------|----------|
| LINE No.         | 110-D1-CS-2" |               |          |
| ASSEMBLY DRAWING | SC6-402      |               |          |
| P&ID DRAWING     | ***-221/232  |               |          |
| DRAWN BY         | DV           | DATE DRAWN    | 03/22/11 |
| JOB No.          | SC6          | SPOOL LD. No. | SK2-021  |
| REV.             |              |               | 0        |

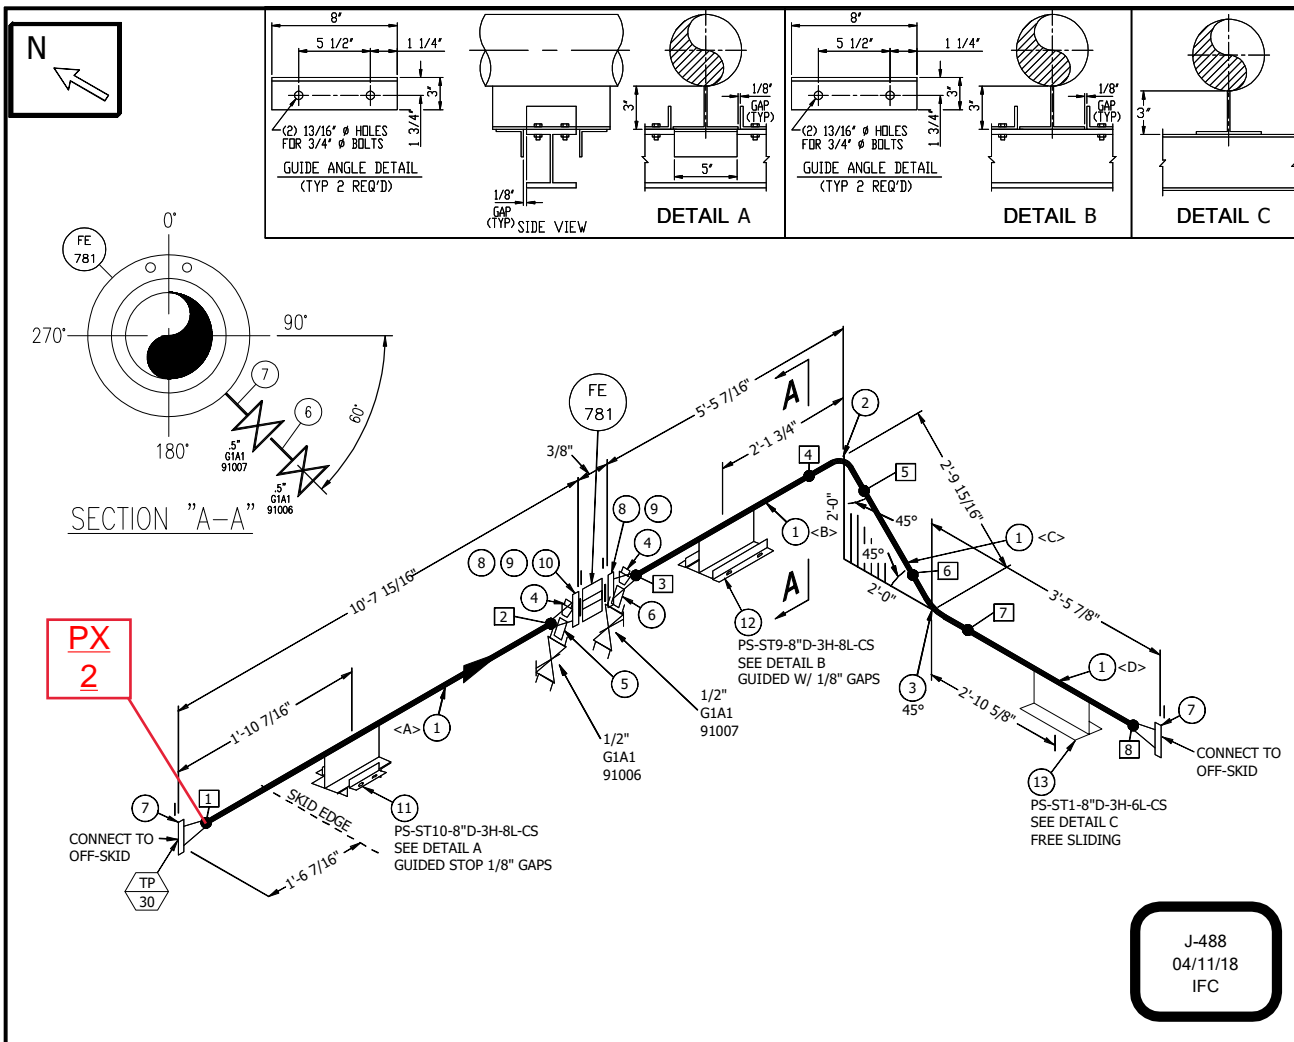

| BILL OF MATERIAL |      |  |             |
|------------------|------|--|-------------|
| MARK             | SIZE | DESCRIPTION  | QTY         |
| 1                | 8    | PIPE, STD, SMLS, A-106 Gr. B, BBE  | 18'-2 7/16" |
| 2                | 8    | ELL 90 LR, BW, STD, A-234 Gr. WPB  | 1           |
| 3                | 8    | ELL 45, BW, STD, A-234 Gr. WPB   | 1           |
| 4                | 1/2  | PLUG, SOLID STEEL, RND HD, THRD, 3000#, A-105  | 2           |
| 5                | 1/2  | NIPPLE, S/160, SMLS, A-106 Gr. B, TBE (6" LG)  | 1           |
| 6                | 1/2  | NIPPLE, S/160, SMLS, A-106 Gr. B, TBE (3" LG)  | 1           |
| 7                | 8    | FLG, RFWN, 150#, STD, A-105  | 2           |
| 8                | 8    | FLG, ORIFICE, RFWN, 300#, STD, A-105 w/ 1/2" NPT TAPS  | 2           |
| 9                | 8    | GSKT, 1/8" THK, 300#, RF, SPIRAL WOUND, 304SS WINDING, FLEXITE SUPER FILLER, C.S. GUIDE RING, ASME B16.20 (YELLOW W/ PINK STRIPE)            | 2           |
| 10               | 7/8  | (12) STUD BOLTS, 300# x 6" LG, A-193 Gr. B7, w/ 2 HVY HEX NUTS, A-194 Gr. 2H (ZINC PLATED)   | 1           |
| 11               |      | PIPE SHOE (TYPE 10) 3" HI. x 12" LG. FROM W6x15 A-992 (2) STOP ANG, 2" x 2" x 1/4" x 5" LG. A-36 (2) GUIDE ANG, 2" x 3" x 1/4" x 8" LG. A-36 | 1           |
| 12               |      | PIPE SHOE (TYPE 9) 3" HI. x 12" LG. FROM W6x15 A-992 (2) GUIDE ANGLE, 2" x 3" x 1/4" x 8" LG. A-36   | 1           |
| 13               |      | PIPE SHOE (TYPE 1) 3" HI. x 6" LG. FROM W6x15 A-992  | 1           |

| WELD MAPPING |      |      |     | PIPE CUT LIST |      |             |       |       |
|--------------|------|------|-----|---------------|------|-------------|-------|-------|
| MARK         | SIZE | TYPE | SCH | MARK          | SIZE | LENGTH      | END 1 | END 2 |
| 1            | 8"   | BW   |     | A             | 8"   | 9'-11 9/16" | BEVEL | BEVEL |
| 2            | 8"   | BW   |     | B             | 8"   | 4'-1 1/16"  | BEVEL | BEVEL |
| 3            | 8"   | BW   |     | C             | 8"   | 1'-4 15/16" | BEVEL | BEVEL |
| 4            | 8"   | BW   |     | D             | 8"   | 2'-8 7/8"   | BEVEL | BEVEL |
| 5            | 8"   | BW   |     |               |      |             |       |       |
| 6            | 8"   | BW   |     |               |      |             |       |       |
| 7            | 8"   | BW   |     |               |      |             |       |       |
| 8            | 8"   | BW   |     |               |      |             |       |       |

J-488  
04/11/18  
IFC

|                |            |                |           |     |                         |          |    |     |  |
|----------------|------------|----------------|-----------|-----|-------------------------|----------|----|-----|--|
| DESIGN PRESS.  | 150 Psig   | FAB. LOCATION  | SHOP      |     |                         |          |    |     |  |
| DESIGN TEMP.   | 400 °F     | SPOOL LOCATION | SKID#2    |     |                         |          |    |     |  |
| OPER. PRESS.   | 50 Psia    |                |           |     |                         |          |    |     |  |
| OPER. TEMP.    | 300 °F     | CORR. ALLOW.   | .0625"    |     |                         |          |    |     |  |
| STRESS RELIEVE | NO         | INSULATION     | 2"H       | 0   | ISSUED FOR CONSTRUCTION | 11/07/17 | CW | WD  |  |
| RADIOGRAPHY    | 15% NORMAL | PAINT          | SYSTEM #2 | NO. | REVISION                | DATE     | BY | APR |  |

**CONFIDENTIAL STATEMENT**  
THIS DRAWING IS THE PROPERTY OF THE THOMAS RUSSELL Co. AND IS NOT TO BE USED FOR ANY PURPOSE OTHER THAN THAT FOR WHICH IT IS SPECIFICALLY FURNISHED.




**FABRICATION NOTES:**  
ALL VALVES ARE RAISED FACE UNLESS NOTED.  
ALL FITTING MAKE-UP & CUT LENGTHS FOR BW PIPE DO NOT INCLUDE WELD GAPS.  
SHOP TO MAKE ADJUSTMENTS FOR WELD GAPS.  
ALL PIPE SEAMLESS UNLESS NOTED OTHERWISE.  
ALL COUPLING TO BE SADDLED ON.

**UOP Russell Honeywell UOP**

7050 S. Yale, Suite 210  
Tulsa, Oklahoma 74136

Phone: 918-481-5882  
Fax: 918-481-7427

|                  |                  |                |          |
|------------------|------------------|----------------|----------|
| LINE No.         | 611-A1-CS-8" 2"H |                |          |
| ASSEMBLY DRAWING | SC6R-402         |                |          |
| FIELD DRAWING    | ***-291          |                |          |
| DRAWN BY         | CW               | DATE DRAWN     | 11/07/17 |
| JOB No.          | 488              | SPOOL I.D. No. | SK2-100  |
| REV.             | 0                |                |          |

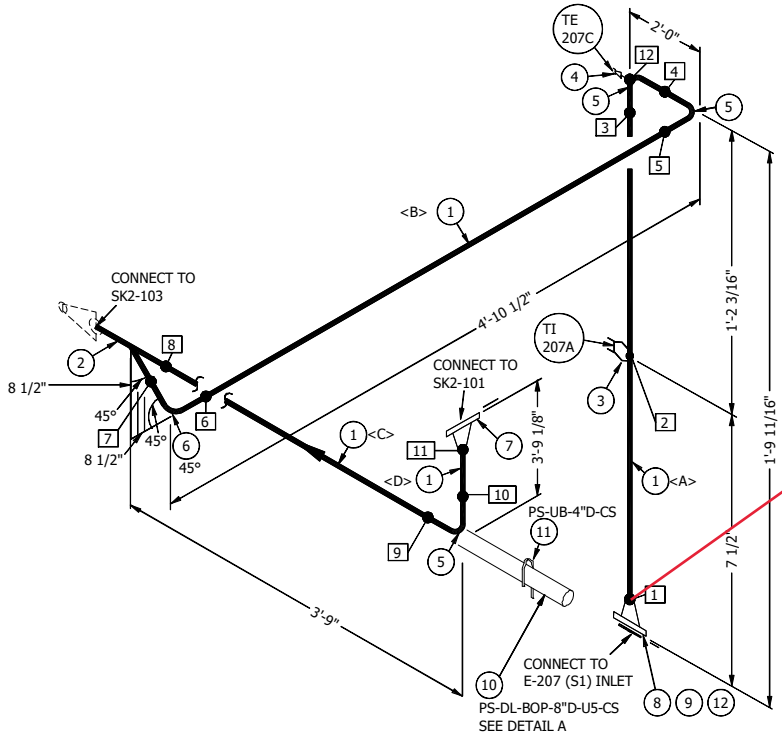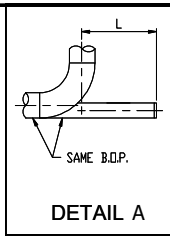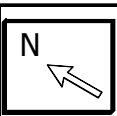

P  
10

J-488  
04/11/18  
IFC

**BILL OF MATERIAL**

| MARK | SIZE  | DESCRIPTION   | QTY         |
|------|-------|---|-------------|
| 1    | 8     | PIPE, STD, SMLS, A-106 Gr. B, BBE   | 8'-5 15/16" |
| 2    | 8X8   | TEE, BW, STD, A-234 Gr. WPB   | 1           |
| 3    | 8X3/4 | CPLG, TOE, x 2 1/2" LG, 3000#, A-105  | 1           |
| 4    | 8X3/4 | E-O-L, THRD, 3000#, A-105   | 1           |
| 5    | 8     | ELL 90 LR, BW, STD, A-234 Gr. WPB   | 3           |
| 6    | 8     | ELL 45, BW, STD, A-234 Gr. WPB  | 1           |
| 7    | 8     | FLG, RFWN, 150#, STD, A-105   | 1           |
| 8    | 8     | GSKT, 1/8" THK, 300#, RF, SPIRAL WOUND, 304SS WINDING, FLEXITE SUPER FILLER, C.S. GUIDE RING, ASME B16.20 (YELLOW W/ PINK STRIPE) | 1           |
| 9    | 7/8   | (12) STUD BOLTS, 300#, A-193 Gr. B7, w/ 2 HVY HEX NUTS, A-194 Gr. 2H (ZINC PLATED) (5 3/4" LG)                                    | 1           |
| 10   |       | (1) PIPE, 4" STD, SMLS, x 4'-5 1/4" LG. A-106 Gr. B (1) END PL, 1/4" THK. x 4 3/8" O.D. A-36 (L=3'-5 1/4")                        | 1           |
| 11   |       | U-BOLT FOR 4" DIA PIPE W/ (4) HEX NUTS EA (CS ZINC PL)  | 1           |
| 12   | 8     | FLG, RFWN, 300#, STD, A-105   | 1           |

**WELD MAPPING**

| MARK | SIZE | TYPE | SCH |
|------|------|------|-----|
| 1    | 8"   | BW   |     |
| 2    | 3/4" | LET  |     |
| 3    | 8"   | BW   |     |
| 4    | 8"   | BW   |     |
| 5    | 8"   | BW   |     |
| 6    | 8"   | BW   |     |
| 7    | 8"   | BW   |     |
| 8    | 8"   | BW   |     |
| 9    | 8"   | BW   |     |
| 10   | 8"   | BW   |     |
| 11   | 8"   | BW   |     |
| 12   | 3/4" | LET  |     |

**PIPE CUT LIST**

| MARK | SIZE | LENGTH    | END 1 | END 2 |
|------|------|-----------|-------|-------|
| A    | 8"   | 5 5/16"   | BEVEL | BEVEL |
| B    | 8"   | 3'-5 1/2" | BEVEL | BEVEL |
| C    | 8"   | 2'-2"     | BEVEL | BEVEL |
| D    | 8"   | 2'-5 1/8" | BEVEL | BEVEL |

|                |            |                |           |     |                         |          |    |     |  |
|----------------|------------|----------------|-----------|-----|-------------------------|----------|----|-----|--|
| DESIGN PRESS.  | 150 Psig   | FAB. LOCATION  | SHOP      |     |                         |          |    |     |  |
| DESIGN TEMP.   | 400 °F     | SPOOL LOCATION | SKID#2    |     |                         |          |    |     |  |
| OPER. PRESS.   | 50 Psia    |                |           |     |                         |          |    |     |  |
| OPER. TEMP.    | 300 °F     | CORR. ALLOW.   | .0625"    |     |                         |          |    |     |  |
| STRESS RELIEVE | NO         | INSULATION     | 2"H       | 0   | ISSUED FOR CONSTRUCTION | 11/17/17 | CW | WD  |  |
| RADIOGRAPHY    | 15% NORMAL | PAINT          | SYSTEM #2 | NO. | REVISION                | DATE     | BY | APR |  |

**CONFIDENTIAL STATEMENT**  
THIS DRAWING IS THE PROPERTY OF THE THOMAS RUSSELL Co. AND IS NOT TO BE USED FOR ANY PURPOSE OTHER THAN THAT FOR WHICH IT IS SPECIFICALLY FURNISHED.




**FABRICATION NOTES:**  
ALL VALVES ARE RAISED FACE UNLESS NOTED.  
ALL FITTING MAKE-UP & CUT LENGTHS FOR BW PIPE DO NOT INCLUDE WELD CAPS.  
SHOP TO MAKE ADJUSTMENTS FOR WELD CAPS.  
ALL PIPE SEAMLESS UNLESS NOTED OTHERWISE.  
ALL COUPLING TO BE SADDLED ON.

UOP Russell  
Honeywell  
Uop

|                  |                  |
|------------------|------------------|
| LINE No.         | 611-A1-CS-8" 2"H |
| ASSEMBLY DRAWING | SC6R-402         |
| FIELD DRAWING    | 888-291          |
| DRAWN BY         | CW               |
| DATE DRAWN       | 11/13/17         |
| JOB No.          | 488              |
| SPOOL I.D. No.   | SK2-102          |
| REV.             | 0                |

7050 S. Yale, Suite 210  
Tulsa, Oklahoma 74136

Phone: 918-461-5600  
Fax: 918-461-7427

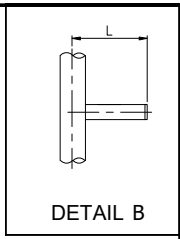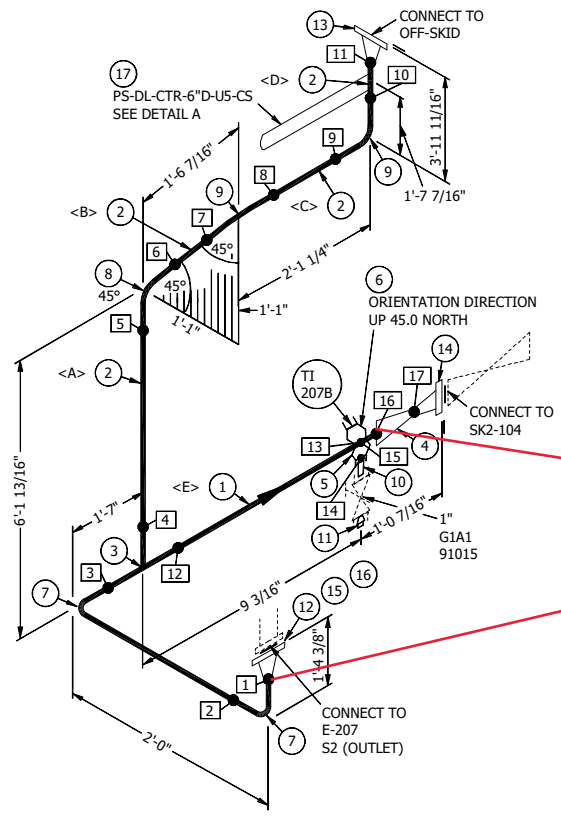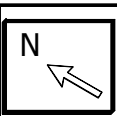

PX  
9

PX  
8

J-488  
04/11/18  
IFC

**BILL OF MATERIAL**

| MARK | SIZE  | DESCRIPTION   | QTY       |
|------|-------|---|-----------|
| 1    | 8     | PIPE, STD, SMLS, A-106 Gr. B, BBE   | 0'-5 5/8" |
| 2    | 6     | PIPE, STD, SMLS, A-106 Gr. B, BBE   | 9'-3 1/2" |
| 3    | 8X6   | TEE RED, BW, STD - STD, A-234 Gr. WPB   | 1         |
| 4    | 8X4   | RED CONC, BW, STD - STD, A-234 Gr. WPB  | 1         |
| 5    | 8X1   | S-O-L, SW, 3000#, A-105   | 1         |
| 6    | 8X3/4 | CPLG, TOE, x 2 1/2" LG, 3000#, A-105  | 1         |
| 7    | 8     | ELL 90 LR, BW, STD, A-234 Gr. WPB   | 2         |
| 8    | 6     | ELL 45, BW, STD, A-234 Gr. WPB  | 1         |
| 9    | 6     | ELL 90 LR, BW, STD, A-234 Gr. WPB   | 2         |
| 10   | 1     | NIPPLE, XH, SMLS, A-106 Gr. B, x 3" LG, POE-TOE   | 1         |
| 11   | 1     | PLUG, SOLID STEEL, RND HD, THRD, 3000#, A-105   | 1         |
| 12   | 8     | FLG, RFWN, 300#, STD, A-105   | 1         |
| 13   | 6     | FLG, RFWN, 150#, STD, A-105   | 1         |
| 14   | 4     | FLG, RFWN, 150#, STD, A-105   | 1         |
| 15   | 8     | GSKT, 1/8" THK, 300#, RF, SPIRAL WOUND, 304SS WINDING, FLEXITE SUPER FILLER, C.S. GUIDE RING, ASME B16.20 (YELLOW W/ PINK STRIPE) | 1         |
| 16   | 7/8   | (12) STUD BOLTS, 300# x 5 3/4" LG, A-193 Gr. B7, w/ 2 HVY HEX NUTS, A-194 Gr. 2H (ZINC PLATED)                                    | 1         |
| 17   | 6     | (1) PIPE, 3" STD, SMLS, x 2'-0" LG. A-106 Gr. B (1) END PL, 1/4" THK. x 3 3/8" O.D. A-36 (L=2'-0")                                | 1         |

**WELD MAPPING**

| MARK | SIZE | TYPE | SCH |
|------|------|------|-----|
| 1    | 8"   | BW   |     |
| 2    | 8"   | BW   |     |
| 3    | 8"   | BW   |     |
| 4    | 6"   | BW   |     |
| 5    | 6"   | BW   |     |
| 6    | 6"   | BW   |     |
| 7    | 6"   | BW   |     |
| 8    | 6"   | BW   |     |
| 9    | 6"   | BW   |     |
| 10   | 6"   | BW   |     |
| 11   | 6"   | BW   |     |
| 12   | 8"   | BW   |     |
| 13   | 1"   | LET  |     |
| 14   | 1"   | SW   |     |
| 15   | 3/4" | LET  |     |
| 16   | 8"   | BW   |     |
| 17   | 4"   | BW   |     |

**PIPE CUT LIST**

| MARK | SIZE | LENGTH      | END 1 | END 2 |
|------|------|-------------|-------|-------|
| A    | 6"   | 5'-3 7/16"  | BEVEL | BEVEL |
| B    | 6"   | 5 5/8"      | BEVEL | BEVEL |
| C    | 6"   | 7 1/4"      | BEVEL | BEVEL |
| D    | 6"   | 2'-11 3/16" | BEVEL | BEVEL |
| E    | 8"   | 5 5/8"      | BEVEL | BEVEL |




|                |            |                |           |     |                         |          |    |     |  |
|----------------|------------|----------------|-----------|-----|-------------------------|----------|----|-----|--|
| DESIGN PRESS.  | 150 Psig   | FAB. LOCATION  | SHOP      |     |                         |          |    |     |  |
| DESIGN TEMP.   | 400 °F     | SPOOL LOCATION | SKID#2    |     |                         |          |    |     |  |
| OPER. PRESS.   | 40 Psia    |                |           |     |                         |          |    |     |  |
| OPER. TEMP.    | 200 °F     | CORR. ALLOW.   | .0625"    |     |                         |          |    |     |  |
| STRESS RELIEVE | NO         | INSULATION     | 2"H       | 0   | ISSUED FOR CONSTRUCTION | 11/17/17 | CW | WD  |  |
| RADIOGRAPHY    | 15% NORMAL | PAINT          | SYSTEM #2 | NO. | REVISION                | DATE     | BY | APR |  |

**CONFIDENTIAL STATEMENT**  
THIS DRAWING IS THE PROPERTY OF THE THOMAS RUSSELL CO. AND IS NOT TO BE USED FOR ANY PURPOSE OTHER THAN THAT FOR WHICH IT IS SPECIFICALLY FURNISHED.

**FABRICATION NOTES:**  
ALL VALVES ARE RAISED FACE UNLESS NOTED.  
ALL FITTING MAKE-UP & CUT LENGTHS FOR BW PIPE DO NOT INCLUDE WELD GAPS.  
SHOP TO MAKE ADJUSTMENTS FOR WELD GAPS.  
ALL PIPE SEAMLESS UNLESS NOTED OTHERWISE.  
ALL COUPLING TO BE SADDLED ON.

**UOP Russell Honeywell**

|                  |                  |
|------------------|------------------|
| LINE No.         | 614-A1-CS-8" 2"H |
| ASSEMBLY DRAWING | SC6R-402         |
| FIELD DRAWING    | ***-291          |
| DRAWN BY         | CW               |
| DATE DRAWN       | 11/14/17         |
| JOB No.          | 488              |
| SPOOL I.D. No.   | SK2-105          |
| REV.             | 0                |

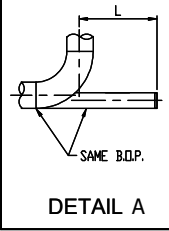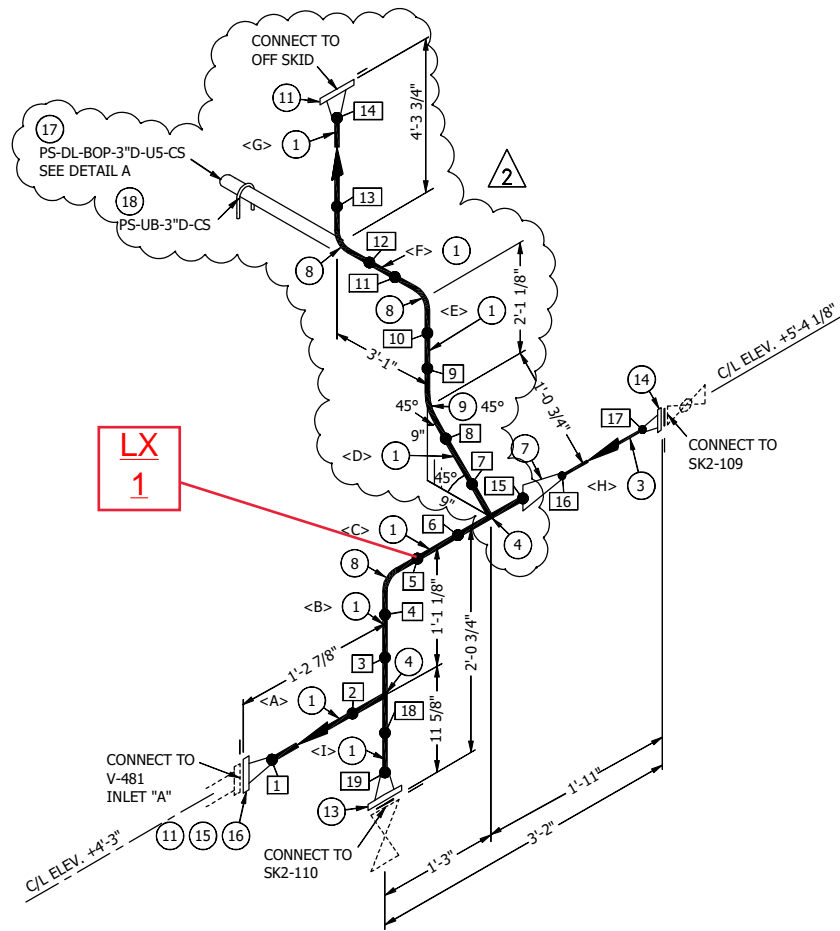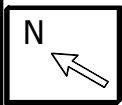

**BILL OF MATERIAL**

| MARK | SIZE            | DESCRIPTION   | QTY       |
|------|-----------------|---|-----------|
| 1    | 4" $\Delta$ 2   | PIPE, STD, SMLS, A-106 Gr. B, BBE   | 9'-2 1/4" |
| 3    | 2" $\Delta$ 2   | PIPE, XH, SMLS, A-106 Gr. B, BBE  | 1'-0 1/8" |
| 4    | 4X4" $\Delta$ 2 | TEE, BW, STD, A-234 Gr. WPB   | 2         |
| 7    | 4X2" $\Delta$ 2 | RED CONC, BW, STD - XH, A-234 Gr. WPB   | 1         |
| 8    | 4" $\Delta$ 2   | ELL 90 LR, BW, STD, A-234 Gr. WPB   | 3         |
| 9    | 4" $\Delta$ 2   | ELL 45, BW, STD, A-234 Gr. WPB  | 1         |
| 11   | 4" $\Delta$ 2   | FLG, RFWN, 150#, STD, A-105   | 2         |
| 13   | 4" $\Delta$ 2   | FLG, RFWN, 300#, STD, A-105   | 1         |
| 14   | 2" $\Delta$ 2   | FLG, RFWN, 300#, XH, A-105  | 1         |
| 15   | 4" $\Delta$ 2   | GSKT, 1/8" THK, 150#, RF, SPIRAL WOUND, 304SS WINDING, FLEXITE SUPER FILLER, C.S. GUIDE RING, ASME B16.20 (YELLOW W/ PINK STRIPE) | 1         |
| 16   | 5/8" $\Delta$ 2 | (8) STUD BOLTS, 150# x 3 3/4" LG, A-193 Gr. B7, w/ 2 HVY HEX NUTS, A-194 Gr. 2H (ZINC PLATED)                                     | 1         |
| 17   | 2" $\Delta$ 2   | (1) PIPE, 3" STD, SMLS, x 2'-1 7/8" LG. A-106 Gr. B (1) END PL, 1/4" THK. x 3 3/8" O.D. A-36 (L=1'-7 7/8")                        | 1         |
| 18   | 3" $\Delta$ 2   | U-BOLT FOR 3" DIA PIPE W/ (4) HEX NUTS EA (CS ZINC PL)  | 1         |

**WELD MAPPING**

**PIPE CUT LIST**

| MARK | SIZE | TYPE | SCH | MARK | SIZE | LENGTH    | END 1 | END 2 |
|------|------|------|-----|------|------|-----------|-------|-------|
| 1    | 4"   | BW   |     | A    | 4"   | 7 3/4"    | BEVEL | BEVEL |
| 2    | 4"   | BW   |     | B    | 4"   | 3"        | BEVEL | BEVEL |
| 3    | 4"   | BW   |     | C    | 4"   | 4 7/8"    | BEVEL | BEVEL |
| 4    | 4"   | BW   |     | D    | 4"   | 6 1/8"    | BEVEL | BEVEL |
| 5    | 4"   | BW   |     | E    | 4"   | 1'-4 5/8" | BEVEL | BEVEL |
| 6    | 4"   | BW   |     | F    | 4"   | 2'-1"     | BEVEL | BEVEL |
| 7    | 4"   | BW   |     | G    | 4"   | 3'-6 3/4" | BEVEL | BEVEL |
| 8    | 4"   | BW   |     | H    | 2"   | 1'-0 1/8" | BEVEL | BEVEL |
| 9    | 4"   | BW   |     | I    | 4"   | 4 1/8"    | BEVEL | BEVEL |
| 10   | 4"   | BW   |     |      |      |           |       |       |
| 11   | 4"   | BW   |     |      |      |           |       |       |
| 12   | 4"   | BW   |     |      |      |           |       |       |
| 13   | 4"   | BW   |     |      |      |           |       |       |
| 14   | 4"   | BW   |     |      |      |           |       |       |
| 15   | 4"   | BW   |     |      |      |           |       |       |
| 16   | 2"   | BW   |     |      |      |           |       |       |
| 17   | 2"   | BW   |     |      |      |           |       |       |
| 18   | 4"   | BW   |     |      |      |           |       |       |
| 19   | 4"   | BW   |     |      |      |           |       |       |

J-488  
06/10/18  
REV

| DESIGN PRESS.  | 150 Psig   | FAB. LOCATION  | SHOP      |     |                                       |        |        |
|----------------|------------|----------------|-----------|-----|---------------------------------------|--------|--------|
| DESIGN TEMP.   | 150 °F     | SPOOL LOCATION | SKID #2   |     |                                       |        |        |
| OPER. PRESS.   | 100 Psig   |                |           | 2   | REVISED FOR SIZE CHANGE IN PSV-481    | 6/5/18 | COB WD |
| OPER. TEMP.    | 69 °F      | CORR. ALLOW.   | .0625"    | 1   | REVISED FOR CONTROL VALVE SIZE CHANGE | 5/9/18 | COB WD |
| STRESS RELIEVE | NO         | INSULATION     | NONE      | 0   | ISSUED FOR CONSTRUCTION               | 5/9/18 | COB WD |
| RADIOGRAPHY    | 15% NORMAL | PAINT          | SYSTEM #3 | NO. | REVISION                              | DATE   | BY     |




**CONFIDENTIAL STATEMENT**  
THIS DRAWING IS THE PROPERTY OF THE THOMAS RUSSELL Co. AND IS NOT TO BE USED FOR ANY PURPOSE OTHER THAN THAT FOR WHICH IT IS SPECIFICALLY FURNISHED.

**FABRICATION NOTES:**  
ALL VALVES ARE RAISED FACE UNLESS NOTED.  
ALL FITTING MAKE-UP & CUT LENGTHS FOR BW PIPE DO NOT INCLUDE WELD GAPS.  
SHOP TO MAKE ADJUSTMENTS FOR WELD GAPS.  
ALL PIPE SEAMLESS UNLESS NOTED OTHERWISE.  
ALL COUPLING TO BE SHOULDER ON.

**UOP Russell Honeywell Uop**

7050 S. Yale, Suite 210  
Tulsa, Oklahoma 74133  
Phone: 918-481-5922  
Fax: 918-481-7427

|                  |              |
|------------------|--------------|
| LINE No.         | 702-A1-CS-4" |
| ASSEMBLY DRAWING | SC6R-402     |
| P&ID DRAWING     | 488-296      |
| DRAWN BY         | CW           |
| DATE DRAWN       | 11/20/17     |
| JOB No.          | 488          |
| SPOOL I.D. No.   | SK2-111      |
| REV.             | 2            |

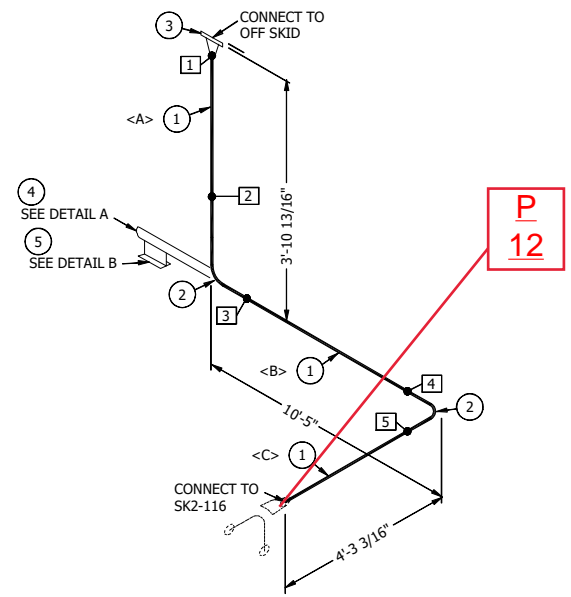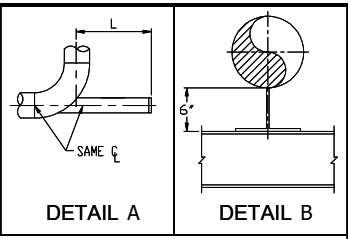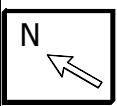

J-488  
04/11/18  
IFC

**BILL OF MATERIAL**

| MARK | SIZE | DESCRIPTION   | QTY        |
|------|------|---|------------|
| 1    | 2    | PIPE, XH, SMLS, A-106 Gr. B, BBE  | 17'-3 7/8" |
| 2    | 2    | ELL 90 LR, BW, XH, A-234 Gr. WPB  | 2          |
| 3    | 2    | FLG, RFWN, 600#, XH, A-105  | 1          |
| 4    |      | (1) PIPE, 1 1/2" XH SMLS, x 2'-5" LG. A-106-B (1) END PL,<br>1/4" THK. x 1 3/4" O.D. A-36 (L=2'-2") | 1          |
| 5    |      | PIPE SHOE (TYPE 1) 6" HL. x 6" LG. FROM W8x24 A-992   | 1          |

**WELD MAPPING**

| MARK | SIZE | TYPE | SCH |
|------|------|------|-----|
| 1    | 2"   | BW   |     |
| 2    | 2"   | BW   |     |
| 3    | 2"   | BW   |     |
| 4    | 2"   | BW   |     |
| 5    | 2"   | BW   |     |

**PIPE CUT LIST**

| MARK | SIZE | LENGTH      | END 1 | END 2 |
|------|------|-------------|-------|-------|
| 1    | A    | 3'-4 11/16" | BEVEL | BEVEL |
| 2    | B    | 9'-11"      | BEVEL | BEVEL |
| 3    | C    | 4'-0 3/16"  | BEVEL | BEVEL |

|                |            |                |           |     |                        |          |     |     |  |
|----------------|------------|----------------|-----------|-----|------------------------|----------|-----|-----|--|
| DESIGN PRESS.  | 1100 Psig  | FAB. LOCATION  | SHOP      |     |                        |          |     |     |  |
| DESIGN TEMP.   | 150 °F     | SPOOL LOCATION | SKID #2   |     |                        |          |     |     |  |
| OPER. PRESS.   | 820 Psig   |                |           |     |                        |          |     |     |  |
| OPER. TEMP.    | 85 °F      | CORR. ALLOW.   | 0.0625"   |     |                        |          |     |     |  |
| STRESS RELIEVE | NO         | INSULATION     | NONE      | 0   | ISSUE FOR CONSTRUCTION | 12/20/17 | COB | WD  |  |
| RADIOGRAPHY    | 15% NORMAL | PAINT          | SYSTEM #3 | NO. | REVISION               | DATE     | BY  | APR |  |

**CONFIDENTIAL STATEMENT**  
THIS DRAWING IS THE PROPERTY OF THE THOMAS RUSSELL Co. AND IS NOT TO BE USED FOR ANY PURPOSE OTHER THAN THAT FOR WHICH IT IS SPECIFICALLY FURNISHED.


**FABRICATION NOTES:**  
ALL VALVES ARE RAISED FACE UNLESS NOTED.  
ALL FITTING MAKE-UP & CUT LENGTHS FOR BW PIPE DO NOT INCLUDE WELD GAPS.  
SHOP TO MAKE ADJUSTMENTS FOR WELD GAPS.  
ALL PIPE SEAMLESS UNLESS NOTED OTHERWISE.  
ALL COUPLING TO BE SADDLED ON.

**UOP Russell Honeywell Uop**

7050 S. Yale, Suite 210  
Tulsa, Oklahoma 74136

Phone: 918-461-5600  
Fax: 918-461-7427

|                  |              |
|------------------|--------------|
| LINE No.         | 151-D1-CS-8" |
| ASSEMBLY DRAWING | SC6R-402     |
| FIELD DRAWING    | ***-231      |
| DRAWN BY         | COB          |
| DATE DRAWN       | 12/13/17     |
| JOB No.          | 488          |
| SPOOL I.D. No.   | SK2-117      |
| REV.             | 0            |

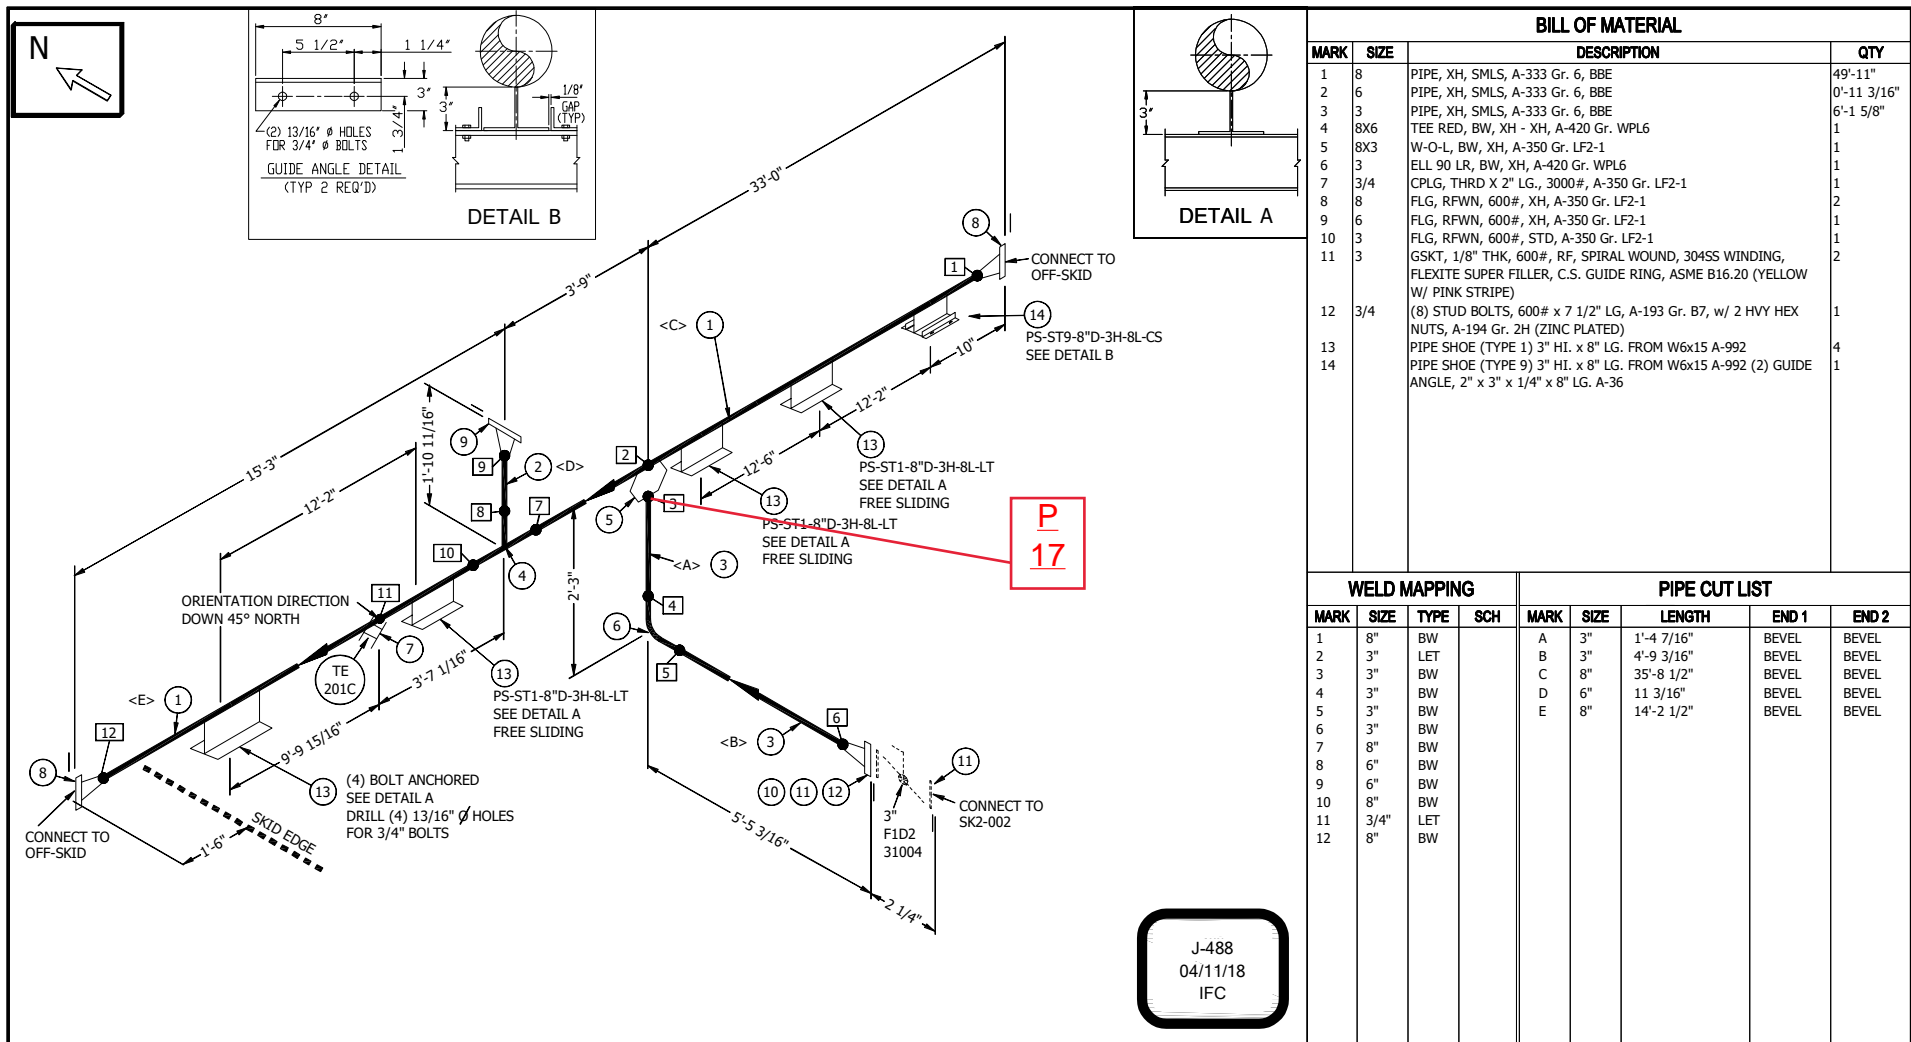

| BILL OF MATERIAL |      |   |             |
|------------------|------|---|-------------|
| MARK             | SIZE | DESCRIPTION   | QTY         |
| 1                | 8    | PIPE, XH, SMLS, A-333 Gr. 6, BBE  | 49'-11"     |
| 2                | 6    | PIPE, XH, SMLS, A-333 Gr. 6, BBE  | 0'-11 3/16" |
| 3                | 3    | PIPE, XH, SMLS, A-333 Gr. 6, BBE  | 6'-1 5/8"   |
| 4                | 8X6  | TEE RED, BW, XH - XH, A-420 Gr. WPL6  | 1           |
| 5                | 8X3  | W-O-L, BW, XH, A-350 Gr. LF2-1  | 1           |
| 6                | 3    | ELL 90 LR, BW, XH, A-420 Gr. WPL6   | 1           |
| 7                | 3/4  | CPLG, THRD X 2" LG., 3000#, A-350 Gr. LF2-1   | 1           |
| 8                | 8    | FLG, RFWN, 600#, XH, A-350 Gr. LF2-1  | 2           |
| 9                | 6    | FLG, RFWN, 600#, XH, A-350 Gr. LF2-1  | 1           |
| 10               | 3    | FLG, RFWN, 600#, STD, A-350 Gr. LF2-1   | 1           |
| 11               | 3    | GSKT, 1/8" THK, 600#, RF, SPIRAL WOUND, 304SS WINDING, FLEXITE SUPER FILLER, C.S. GUIDE RING, ASME B16.20 (YELLOW W/ PINK STRIPE) | 2           |
| 12               | 3/4  | (8) STUD BOLTS, 600# x 7 1/2" LG, A-193 Gr. B7, w/ 2 HVY HEX NUTS, A-194 Gr. 2H (ZINC PLATED)                                     | 1           |
| 13               |      | PIPE SHOE (TYPE 1) 3" HI. x 8" LG. FROM W6x15 A-992   | 4           |
| 14               |      | PIPE SHOE (TYPE 9) 3" HI. x 8" LG. FROM W6x15 A-992 (2) GUIDE ANGLE, 2" x 3" x 1/4" x 8" LG. A-36                                 | 1           |

| WELD MAPPING |      |      |     | PIPE CUT LIST |      |            |       |       |
|--------------|------|------|-----|---------------|------|------------|-------|-------|
| MARK         | SIZE | TYPE | SCH | MARK          | SIZE | LENGTH     | END 1 | END 2 |
| 1            | 8"   | BW   |     | A             | 3"   | 1'-4 7/16" | BEVEL | BEVEL |
| 2            | 3"   | LET  |     | B             | 3"   | 4'-9 3/16" | BEVEL | BEVEL |
| 3            | 3"   | BW   |     | C             | 8"   | 35'-8 1/2" | BEVEL | BEVEL |
| 4            | 3"   | BW   |     | D             | 6"   | 11 3/16"   | BEVEL | BEVEL |
| 5            | 3"   | BW   |     | E             | 8"   | 14'-2 1/2" | BEVEL | BEVEL |
| 6            | 3"   | BW   |     |               |      |            |       |       |
| 7            | 8"   | BW   |     |               |      |            |       |       |
| 8            | 6"   | BW   |     |               |      |            |       |       |
| 9            | 6"   | BW   |     |               |      |            |       |       |
| 10           | 8"   | BW   |     |               |      |            |       |       |
| 11           | 3/4" | LET  |     |               |      |            |       |       |
| 12           | 8"   | BW   |     |               |      |            |       |       |

J-488  
04/11/18  
IFC


|                |            |                |           |     |                        |          |     |     |  |
|----------------|------------|----------------|-----------|-----|------------------------|----------|-----|-----|--|
| DESIGN PRESS.  | 1100 Psig  | FAB. LOCATION  | SHOP      |     |                        |          |     |     |  |
| DESIGN TEMP.   | 150 °F     | SPOOL LOCATION | SKID #2   |     |                        |          |     |     |  |
| OPER. PRESS.   | 820 Psia   |                |           |     |                        |          |     |     |  |
| OPER. TEMP.    | 71 °F      | CORR. ALLOW.   | .0625"    |     |                        |          |     |     |  |
| STRESS RELIEVE | NO         | INSULATION     | 1.5" C    | 0   | ISSUE FOR CONSTRUCTION | 12-21-17 | COB | WD  |  |
| RADIOGRAPHY    | 15% NORMAL | PAINT          | SYSTEM #3 | NO. | REVISION               | DATE     | BY  | APR |  |

**CONFIDENTIAL STATEMENT**  
THIS DRAWING IS THE PROPERTY OF THE THOMAS RUSSELL CO. AND IS NOT TO BE USED FOR ANY PURPOSE OTHER THAN THAT FOR WHICH IT IS SPECIFICALLY FURNISHED.

**FABRICATION NOTES:**  
ALL VALVES ARE RAISED FACE UNLESS NOTED.  
ALL FITTING MAKE-UP & CUT LENGTHS FOR BW PIPE DO NOT INCLUDE WELD CAPS.  
SHOP TO MAKE ADJUSTMENTS FOR WELD CAPS.  
ALL PIPE SEAMLESS UNLESS NOTED OTHERWISE.  
ALL COUPLING TO BE SADDLED ON.

**UOP Russell Honeywell**

|                  |                    |
|------------------|--------------------|
| LINE No.         | 155-D1-LT-8" 1.5"C |
| ASSEMBLY DRAWING | SC6R-402           |
| FIELD DRAWING    | ***-231            |
| DRAWN BY         | COB                |
| DATE DRAWN       | 3-17-17            |
| JOB No.          | 488                |
| SPOOL I.D. No.   | SK2-118            |
| REV.             | 0                  |

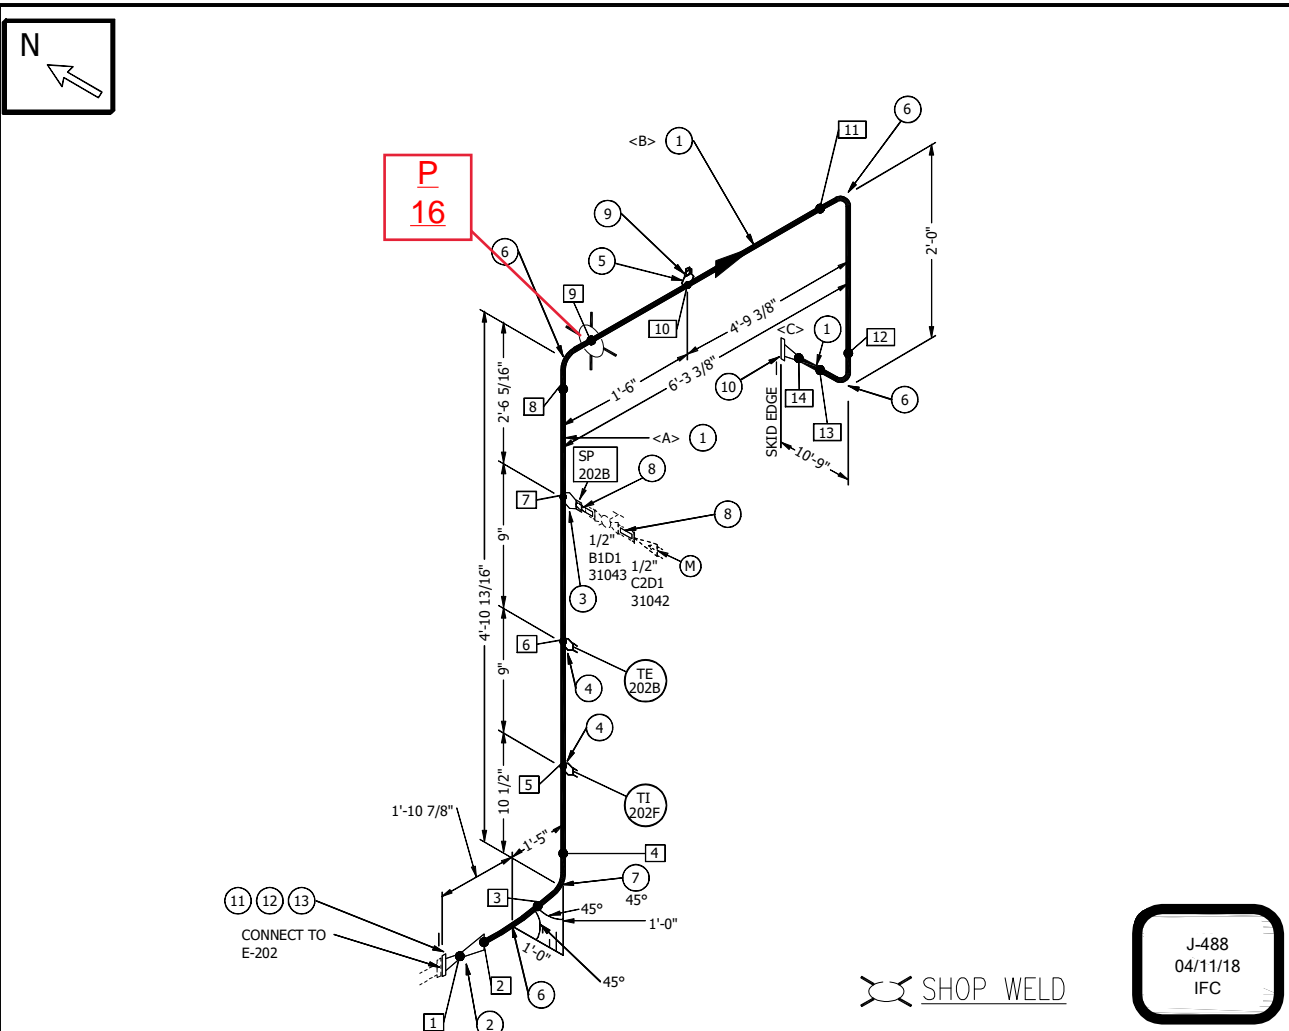

| BILL OF MATERIAL |         |   |            |
|------------------|---------|---|------------|
| MARK             | SIZE    | DESCRIPTION   | QTY        |
| 1                | 8       | PIPE, XH, SMLS, A-106 Gr. B, BBE  | 17'-0 3/4" |
| 2                | 8X6     | RED CONC, BW, XH - XH, A-234 Gr. WPB  | 1          |
| 3                | 8X1 1/2 | T-O-L, THRD, 3000#, A-105   | 1          |
| 4                | 8X3/4   | T-O-L, THRD, 3000#, A-105   | 2          |
| 5                | 8X1/2   | T-O-L, THRD, 3000#, A-105   | 1          |
| 6                | 8       | ELL 90 LR, BW, XH, A-234 Gr. WPB  | 4          |
| 7                | 8       | ELL 45, BW, XH, A-234 Gr. WPB   | 1          |
| 8                | 1/2     | NIPPLE, S/160, SMLS, A-106 Gr. B, x 3" LG, TBE (3" LG)  | 2          |
| 9                | 1/2     | PLUG, SOLID STEEL, RND HD, THRD, 3000#, A-105   | 1          |
| 10               | 8       | FLG, RFWN, 600#, XH, A-105  | 1          |
| 11               | 6       | FLG, RFWN, 600#, XH, A-105  | 1          |
| 12               | 6       | GSKT, 1/8" THK, 600#, RF, SPIRAL WOUND, 304SS WINDING, FLEXITE SUPER FILLER, C.S. GUIDE RING, ASME B16.20 (YELLOW W/ PINK STRIPE) | 1          |
| 13               | 1       | (12) STUD BOLTS, 600# x 7" LG, A-193 Gr. B7, w/ 2 HVY HEX NUTS, A-194 Gr. 2H (ZINC PLATED) (7" LG)                                | 1          |

| WELD MAPPING |        |      |     | PIPE CUT LIST |      |             |       |       |
|--------------|--------|------|-----|---------------|------|-------------|-------|-------|
| MARK         | SIZE   | TYPE | SCH | MARK          | SIZE | LENGTH      | END 1 | END 2 |
| 1            | 6"     | BW   |     | A             | 8"   | 3'-5 13/16" | BEVEL | BEVEL |
| 2            | 8"     | BW   |     | B             | 8"   | 4'-3 3/8"   | BEVEL | BEVEL |
| 3            | 8"     | BW   |     | C             | 8"   | 9'-3 9/16"  | BEVEL | BEVEL |
| 4            | 8"     | BW   |     |               |      |             |       |       |
| 5            | 3/4"   | LET  |     |               |      |             |       |       |
| 6            | 3/4"   | LET  |     |               |      |             |       |       |
| 7            | 1 1/2" | LET  |     |               |      |             |       |       |
| 8            | 8"     | BW   |     |               |      |             |       |       |
| 9            | 8"     | BW   |     |               |      |             |       |       |
| 10           | 1/2"   | LET  |     |               |      |             |       |       |
| 11           | 8"     | BW   |     |               |      |             |       |       |
| 12           | 8"     | BW   |     |               |      |             |       |       |
| 13           | 8"     | BW   |     |               |      |             |       |       |
| 14           | 8"     | BW   |     |               |      |             |       |       |

J-488  
04/11/18  
IFC

SHOP WELD

|                |            |                |           |     |                        |         |     |     |  |
|----------------|------------|----------------|-----------|-----|------------------------|---------|-----|-----|--|
| DESIGN PRESS.  | 1100 Psig  | FAB. LOCATION  | SHOP      |     |                        |         |     |     |  |
| DESIGN TEMP.   | 150 °F     | SPOOL LOCATION | SKID #2   |     |                        |         |     |     |  |
| OPER. PRESS.   | 830 Psia   |                |           |     |                        |         |     |     |  |
| OPER. TEMP.    | 109 °F     | CORR. ALLOW.   | 0.0625"   |     |                        |         |     |     |  |
| STRESS RELIEVE | NO         | INSULATION     | NONE      | 0   | ISSUE FOR CONSTRUCTION | 1/12/18 | COB | WD  |  |
| RADIOGRAPHY    | 15% NORMAL | PAINT          | SYSTEM #3 | NO. | REVISION               | DATE    | BY  | APR |  |


**CONFIDENTIAL STATEMENT**  
THIS DRAWING IS THE PROPERTY OF THE THOMAS RUSSELL Co. AND IS NOT TO BE USED FOR ANY PURPOSE OTHER THAN THAT FOR WHICH IT IS SPECIFICALLY FURNISHED.

**FABRICATION NOTES:**  
ALL VALVES ARE RAISED FACE UNLESS NOTED.  
ALL FITTING MAKE-UP & CUT LENGTHS FOR BW PIPE DO NOT INCLUDE WELD CAPS.  
SHOP TO MAKE ADJUSTMENTS FOR WELD CAPS.  
ALL PIPE SEAMLESS UNLESS NOTED OTHERWISE.  
ALL COUPLING TO BE SADDLED ON.

**UOP Russell Honeywell Uop**

7050 S. Yale, Suite 210  
Tulsa, Oklahoma 74136  
Phone: 918-461-5800  
Fax: 918-461-7427

LINE No. 153-D1-CS-8"  
ASSEMBLY DRAWING SC6R-402  
PART DRAWING \*\*\*-231  
DRAWN BY COB DATE DRAWN 1/8/18  
JOB No. 488 SPOOL I.D. No. SK2-121 REV. 0

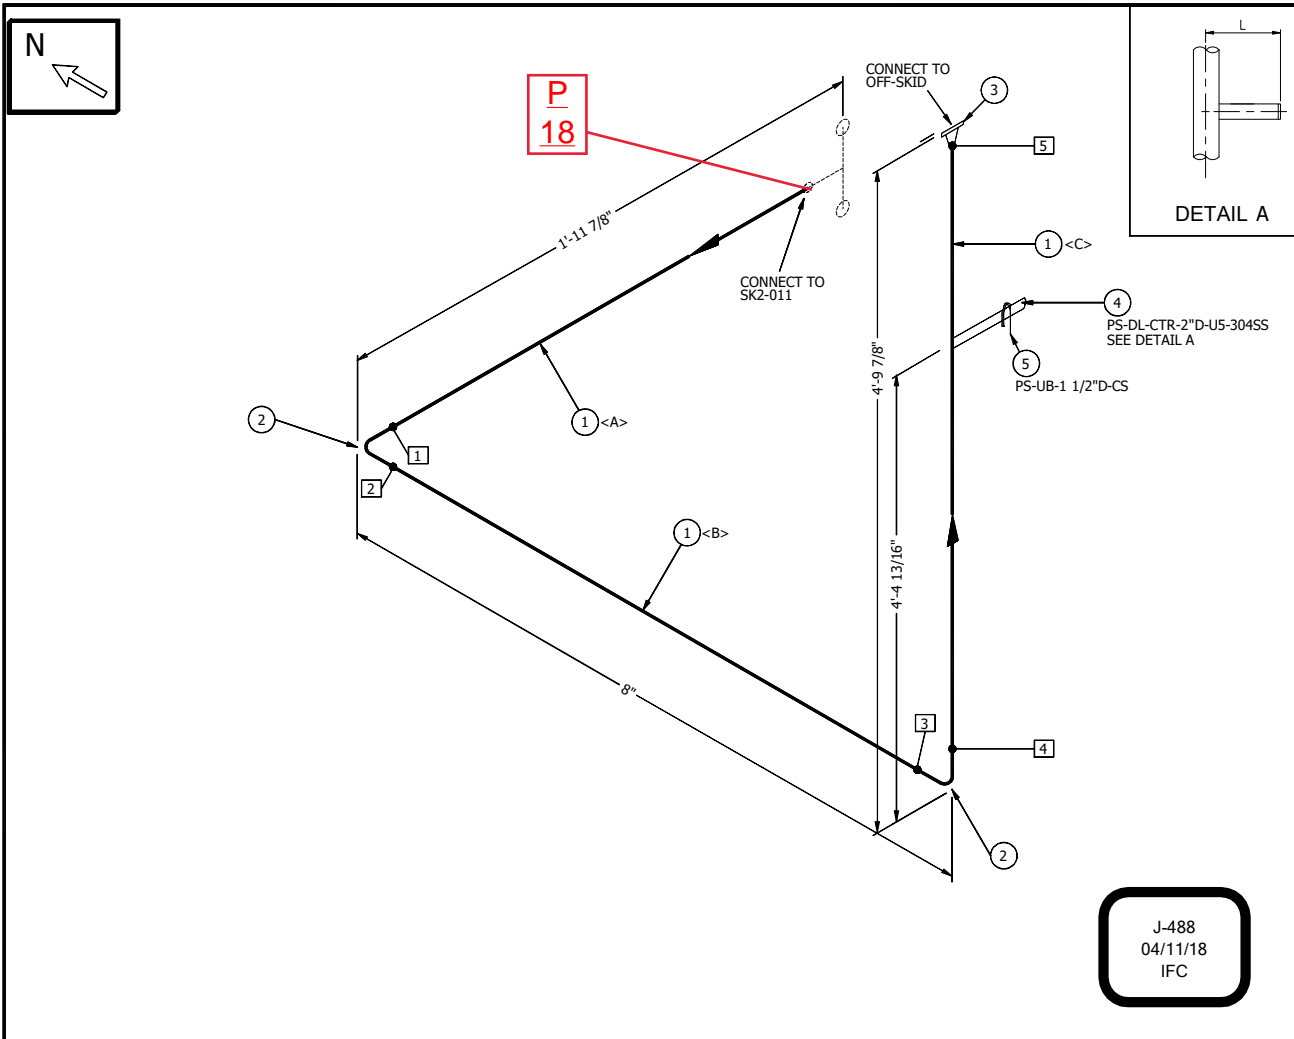

| BILL OF MATERIAL |       |   |            |  |
|------------------|-------|---|------------|--|
| MARK             | SIZE  | DESCRIPTION   | QTY        |  |
| 1                | 2     | PIPE, S/40S, SMLS, A-312 Gr. TP-304/304L, BBE   | 5'-11 1/8" |  |
| 2                | 2     | ELL 90 LR, BW, S/40S, A-403 Gr. WP-304/304L   | 2          |  |
| 3                | 2     | FLG, RFWN, 600#, S/40S, A-182 Gr. F304/304L   | 1          |  |
| 4                | 2     | (1) PIPE, 1 1/2" S/80S, SMLS OR WLD, x 1'-7 1/8" LG. A-312 Gr. TP-304/304L (1) END PL, 1/4" THK. x 1 3/4" O.D. A-36 (L=2'-1") | 1          |  |
| 5                | 1 1/2 | U-BOLT FOR 1 1/2" DIA PIPE W/ (4) HEX NUTS EA (CS ZINC PL)  | 1          |  |

| WELD MAPPING |      |      |     | PIPE CUT LIST |      |           |       |       |
|--------------|------|------|-----|---------------|------|-----------|-------|-------|
| MARK         | SIZE | TYPE | SCH | MARK          | SIZE | LENGTH    | END 1 | END 2 |
| 1            | 2"   | BW   |     | A             | 2"   | 1'-5 3/8" | BEVEL | BEVEL |
| 2            | 2"   | BW   |     | B             | 2"   | 2"        | BEVEL | BEVEL |
| 3            | 2"   | BW   |     | C             | 2"   | 4'-3 3/4" | BEVEL | BEVEL |
| 4            | 2"   | BW   |     |               |      |           |       |       |
| 5            | 2"   | BW   |     |               |      |           |       |       |

|                |            |                |         |     |                        |          |    |     |  |
|----------------|------------|----------------|---------|-----|------------------------|----------|----|-----|--|
| DESIGN PRESS.  | 1100 Psig  | FAB. LOCATION  | SHOP    |     |                        |          |    |     |  |
| DESIGN TEMP.   | 150 °F     | SPOOL LOCATION | SKID #2 |     |                        |          |    |     |  |
| OPER. PRESS.   | 810 Psia   |                |         |     |                        |          |    |     |  |
| OPER. TEMP.    | -71 °F     | CORR. ALLOW.   | NONE    |     |                        |          |    |     |  |
| STRESS RELIEVE | NO         | INSULATION     | 2.5 °C  | 0   | ISSUE FOR CONSTRUCTION | 01/09/18 | CW | WD  |  |
| RADIOGRAPHY    | 15% NORMAL | PAINT          | NONE    | NO. | REVISION               | DATE     | BY | APR |  |

**CONFIDENTIAL STATEMENT**  
 THIS DRAWING IS THE PROPERTY OF THE THOMAS RUSSELL Co. AND IS NOT TO BE USED FOR ANY PURPOSE OTHER THAN THAT FOR WHICH IT IS SPECIFICALLY FURNISHED.




**FABRICATION NOTES:**  
 ALL VALVES ARE RAISED FACE UNLESS NOTED.  
 ALL FITTING MAKE-UP & OUT LENGTHS FOR BW PIPE DO NOT INCLUDE WELD GAPS.  
 SHOP TO MAKE ADJUSTMENTS FOR WELD GAPS.  
 ALL PIPE SEAMLESS UNLESS NOTED OTHERWISE.  
 ALL COUPLING TO BE SADDLED ON.

**UOP Russell Honeywell**

7050 S. Yale, Suite 210  
Tulsa, Oklahoma 74136

Phone: 918-461-5800  
Fax: 918-461-7427

|                  |                        |                |          |
|------------------|------------------------|----------------|----------|
| LINE No.         | 160-D0-304SS-4" 2.5 °C |                |          |
| ASSEMBLY DRAWING | SC6R-402               |                |          |
| PARD DRAWING     | ***-231                |                |          |
| DRAWN BY         | CW                     | DATE DRAWN     | 01/09/18 |
| JOB No.          | 488                    | SPOOL I.D. No. | SK2-122  |
| REV.             |                        |                | 0        |

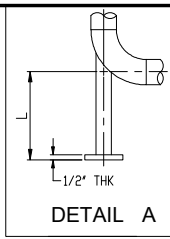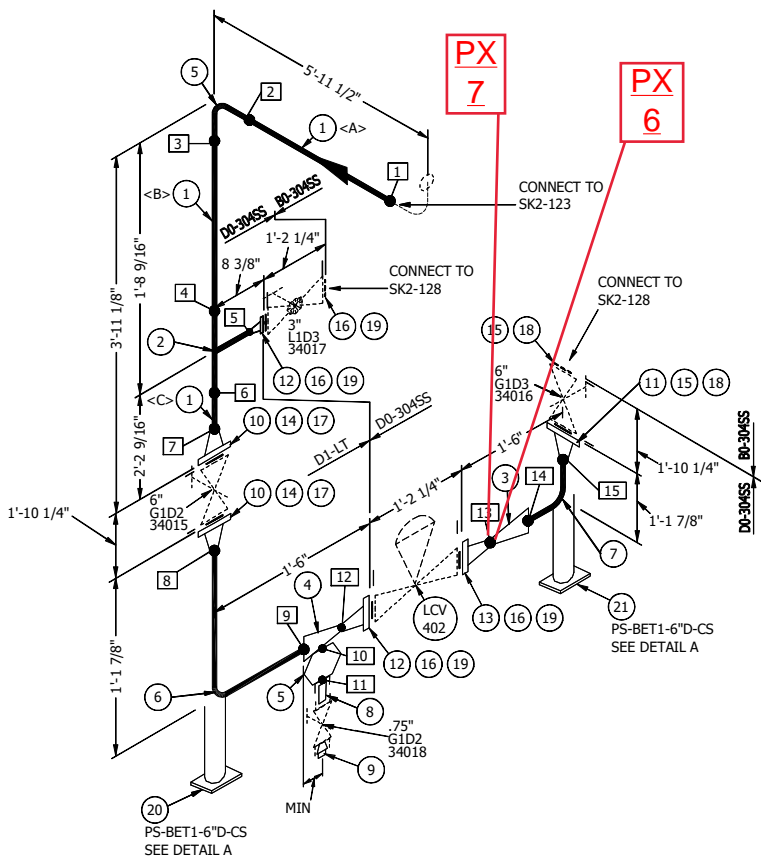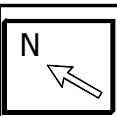

J-488  
 04/11/18  
 IFC

**BILL OF MATERIAL**

| MARK | SIZE  | DESCRIPTION   | QTY       |
|------|-------|---|-----------|
| 1    | 6     | PIPE, XH, SMLS, A-333 Gr. 6, BBE  | 6'-3 1/2" |
| 2    | 6X3   | TEE RED, BW, XH - XH, A-420 Gr. WPL6  | 1         |
| 3    | 6X3   | RED CONC, BW, XH - XH, A-420 Gr. WPL6   | 1         |
| 4    | 6X3   | RED CONC, BW, S/405 - S/405, A-403 Gr. WP-304/304L  | 1         |
| 5    | 6X3/4 | S-O-L, SW, 3000#, A-350 Gr. LF2-1   | 1         |
| 6    | 6     | ELL 90 LR, BW, XH, A-420 Gr. WPL6   | 2         |
| 7    | 6     | ELL 90 LR, BW, S/405, A-403 Gr. WP-304/304L   | 1         |
| 8    | 3/4   | NIPPLE, S/160, SMLS, A-333 Gr. 6, x 3" LG, (3" LG)  | 1         |
| 9    | 3/4   | PLUG, SOLID STEEL, RND HD, THRD, 3000#, A-350 Gr. LF2-1   | 1         |
| 10   | 6     | FLG, RFWN, 600#, XH, A-350 Gr. LF2-1  | 2         |
| 11   | 6     | FLG, RFWN, 600#, S/405, A-182 Gr. F304/304L   | 1         |
| 12   | 3     | FLG, RFWN, 600#, XH, A-350 Gr. LF2-1  | 2         |
| 13   | 3     | FLG, RFWN, 600#, S/405, A-182 Gr. F304/304L   | 1         |
| 14   | 6     | GSKT, 1/8" THK, 600#, RF, SPIRAL WOUND, 304SS WINDING, FLEXITE SUPER FILLER, C.S. GUIDE RING, ASME B16.20 (YELLOW W/ PINK STRIPE)     | 2         |
| 15   | 6     | GSKT, 1/8" THK, 600#, RF, SPIRAL WOUND, 304SS WINDING, FLEXIBLE GRAPHITE FILLER, C.S. GUIDE RING, ASME B16.20 (YELLOW W/ GREY STRIPE) | 2         |
| 16   | 3     | GSKT, 1/8" THK, 600#, RF, SPIRAL WOUND, 304SS WINDING, FLEXIBLE GRAPHITE FILLER, C.S. GUIDE RING, ASME B16.20 (YELLOW W/ GREY STRIPE) | 4         |
| 17   | 1     | (12) STUD BOLTS, 600# x 7" LG, A-193 Gr. B7, w/ 2 HVY HEX NUTS, A-194 Gr. 2H (ZINC PLATED)  | 2         |
| 18   | 1     | (12) STUD BOLTS, 600# x 7" LG, A-193 Gr. B8 Cl. 2, w/ 2 HVY HEX NUTS, A-194 Gr. 8 (ZINC PLATED)                                       | 2         |
| 19   | 3/4   | (8) STUD BOLTS, 600# x 5 1/4" LG, A-193 Gr. B8 Cl. 2, w/ 2 HVY HEX NUTS, A-194 Gr. 8 (ZINC PLATED)                                    | 4         |
| 20   | 6     | (1) PIPE, 3" STD, SMLS, x 2'-2 1/2" LG. A-333 Gr. 6 (1) BASE PL, 1/2" THK. x 6" x 6" A-36 (L=1'-6")                                   | 1         |
| 21   | 6     | (1) PIPE, 3" S/105, SMLS OR WLD, x 2'-2 1/2" LG. A-312 Gr. TP-304/304L (1) BASE PL, 1/2" THK. x 6" x 6" A-36 (L=1'-6")                | 1         |

**WELD MAPPING**

| MARK | SIZE | TYPE | SCH |
|------|------|------|-----|
| 1    | 6"   | BW   |     |
| 2    | 6"   | BW   |     |
| 3    | 6"   | BW   |     |
| 4    | 6"   | BW   |     |
| 5    | 3"   | BW   |     |
| 6    | 6"   | BW   |     |
| 7    | 6"   | BW   |     |
| 8    | 6"   | BW   |     |
| 9    | 6"   | BW   |     |
| 10   | 3/4" | LET  |     |
| 11   | 3/4" | SW   |     |
| 12   | 3"   | BW   |     |
| 13   | 3"   | BW   |     |
| 14   | 6"   | BW   |     |
| 15   | 6"   | BW   |     |


**PIPE CUT LIST**

| MARK | SIZE | LENGTH     | END 1 | END 2 |
|------|------|------------|-------|-------|
| A    | 6"   | 4'-5 1/2"  | BEVEL | BEVEL |
| B    | 6"   | 5' 15/16"  | BEVEL | BEVEL |
| C    | 6"   | 1'-4 1/16" | BEVEL | BEVEL |

|                |            |                |           |     |                        |          |    |     |  |
|----------------|------------|----------------|-----------|-----|------------------------|----------|----|-----|--|
| DESIGN PRESS.  | 1100 Psig  | FAB. LOCATION  | SHOP      |     |                        |          |    |     |  |
| DESIGN TEMP.   | 150 °F     | SPOOL LOCATION | SKID #2   |     |                        |          |    |     |  |
| OPER. PRESS.   | 800 Psia   |                |           |     |                        |          |    |     |  |
| OPER. TEMP.    | -30 °F     | CORR. ALLOW.   | .0625"    |     |                        |          |    |     |  |
| STRESS RELIEVE | NO         | INSULATION     | 1.5"C     | 0   | ISSUE FOR CONSTRUCTION | 01/10/18 | CW | WD  |  |
| RADIOGRAPHY    | 15% NORMAL | PAINT          | SYSTEM #3 | NO. | REVISION               | DATE     | BY | APR |  |



**CONFIDENTIAL STATEMENT**  
 THIS DRAWING IS THE PROPERTY OF THE THOMAS RUSSELL Co. AND IS NOT TO BE USED FOR ANY PURPOSE OTHER THAN THAT FOR WHICH IT IS SPECIFICALLY FURNISHED.

**FABRICATION NOTES:**  
 ALL VALVES ARE RAISED FACE UNLESS NOTED.  
 ALL FITTING MAKE-UP & CUT LENGTHS FOR BW PIPE DO NOT INCLUDE WELD CAPS.  
 SHOP TO MAKE ADJUSTMENTS FOR WELD CAPS.  
 ALL PIPE SEAMLESS UNLESS NOTED OTHERWISE.  
 ALL COUPLING TO BE SADDLED ON.

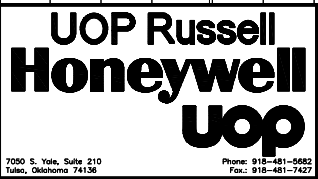

|                  |                    |
|------------------|--------------------|
| LINE No.         | 170-D1-LT-6" 1.5"C |
| ASSEMBLY DRAWING | SC6R-402           |
| FRID DRAWING     | ***-234            |
| DRAWN BY         | CW                 |
| DATE DRAWN       | 01/10/18           |
| JOB No.          | 488                |
| SPOOL I.D. No.   | SK2-124            |
| REV              | 0                  |



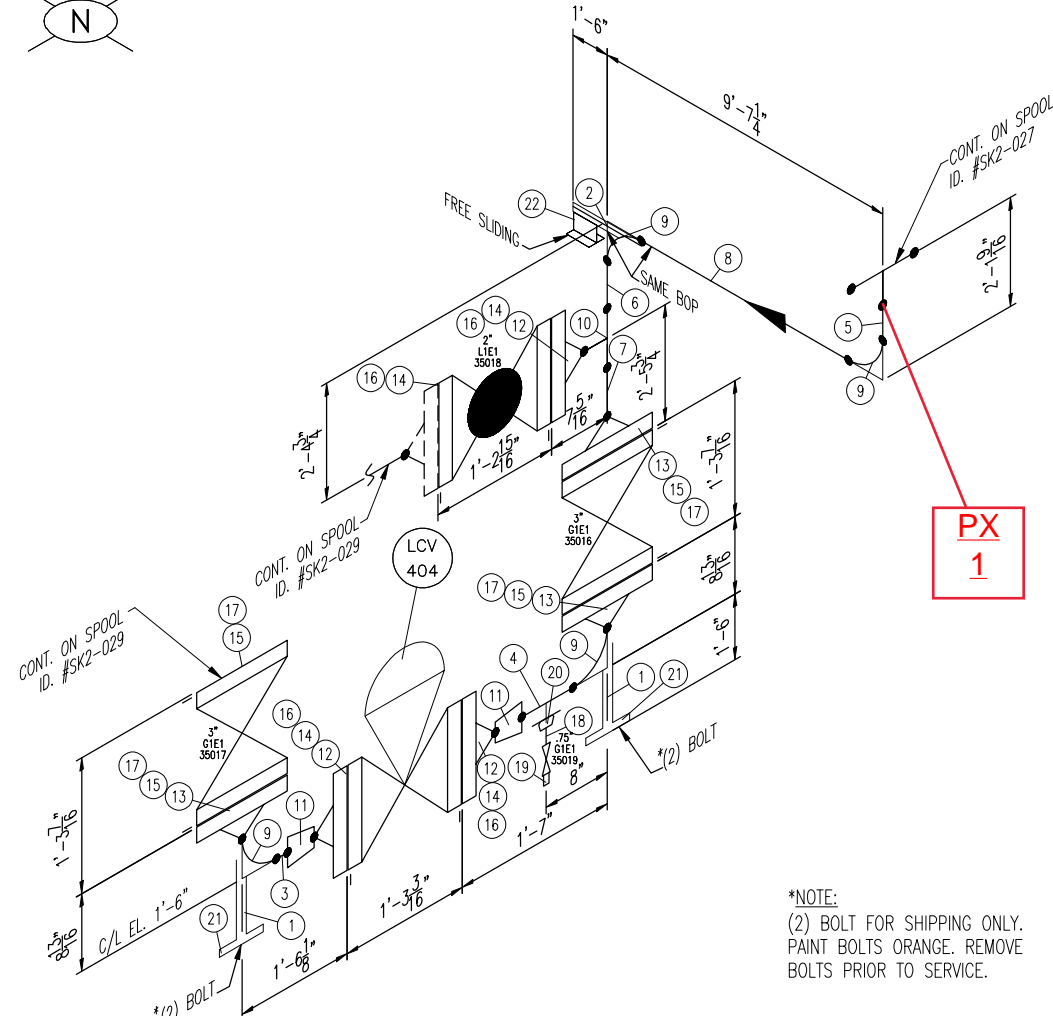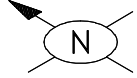

\*NOTE:  
 (2) BOLT FOR SHIPPING ONLY.  
 PAINT BOLTS ORANGE. REMOVE  
 BOLTS PRIOR TO SERVICE.

BILL OF MATERIAL

| MARK | QTY | SIZE    | DESCRIPTION  | LENGTH      |
|------|-----|---------|--|-------------|
| 1    | 2   | 2"      | PIPE, XH SMLS, A-106-B, BBE  | 1'-10"      |
| 2    | 1   | 2"      | PIPE, XH SMLS, A-106-B, BBE  | 1'-8 1/2"   |
| 3    | 1   | 3"      | PIPE, XH SMLS, A-106-B, BBE  | 5 13/16"    |
| 4    | 1   | 3"      | PIPE, XH SMLS, A-106-B, BBE  | 6 11/16"    |
| 5    | 1   | 3"      | PIPE, XH SMLS, A-106-B, BBE  | 1'-4 3/16"  |
| 6    | 1   | 3"      | PIPE, XH SMLS, A-106-B, BBE  | 1'-8 7/8"   |
| 7    | 1   | 3"      | PIPE, XH SMLS, A-106-B, BBE  | 1'-10 1/16" |
| 8    | 1   | 3"      | PIPE, XH SMLS, A-106-B, BBE  | 8'-10 1/4"  |
| 9    | 4   | 3"      | ELL, 90 LR XH, A-234-WPB   |             |
| 10   | 1   | 3"x2"   | TEE, RED XH, A-234-WPB   |             |
| 11   | 2   | 3"x2"   | REDUCER, CONC XH, A-234-WPB  |             |
| 12   | 3   | 2"      | FLG, RTJWN 900LB XH, A-105   |             |
| 13   | 3   | 3"      | FLG, RTJWN 900LB XH, A-105   |             |
| 14   | 4   | 7/8"    | (8) STUD BOLTS, A-193-B7 w/ TWO HEAVY HEX NUTS, A-194-2H (ZINC PLATED) | 6"          |
| 15   | 4   | 7/8"    | (8) STUD BOLTS, A-193-B7 w/ TWO HEAVY HEX NUTS, A-194-2H (ZINC PLATED) | 6"          |
| 16   | 4   | 2"      | GASKET, RTJ, 900LB R24   |             |
| 17   | 4   | 3"      | GASKET, RTJ, 900LB R31   |             |
| 18   | 1   | 3/4"    | NIPPLE, S/160 SMLS, A-106-B POE-TOE                                    | 3"          |
| 19   | 1   | 3/4"    | PLUG, SOLID STEEL, ROUND HEAD, A-105                                   |             |
| 20   | 1   | 3"x3/4" | SOL, 3000LB FS, A-105  |             |
| 21   | 2   |         | BASE PLATE, 1/2" THK. x 5" x 5" (SA-36 MATERIAL)                       |             |
| 22   | 1   |         | PIPE SHOE, 6" LG x 3" HI FROM W6x15                                    |             |



Apr 11, 2018 - 7:39am Z:\400 - Drafting\001-PROJECTS\488 SC6 RSV\SC6R\DRAWINGS\400-Piping\SPOOLS\IFC\SK2\

|                |            |                |           |     |                        |          |        |
|----------------|------------|----------------|-----------|-----|------------------------|----------|--------|
| DESIGN PRESS.  | 1440 Psig  | FAB. LOCATION  | SHOP      |     |                        |          |        |
| DESIGN TEMP.   | 200 °F     | SPOOL LOCATION | SKID #2   |     |                        |          |        |
| OPER. PRESS.   | 1270 Psia  |                |           |     |                        |          |        |
| OPER. TEMP.    | 154 °F     | CORR. ALLOW.   | .0625"    |     |                        |          |        |
| STRESS RELIEVE | NO         | INSULATION     | 1°C       | 0   | ISSUE FOR CONSTRUCTION | 01/11/18 | COB WD |
| RADIOGRAPHY    | 15% NORMAL | PAINT          | SYSTEM #3 | NO. | REVISION               | DATE     | BY APR |




**CONFIDENTIAL STATEMENT**  
 THIS DRAWING IS THE PROPERTY OF THE THOMAS RUSSELL CO. AND IS NOT TO BE USED FOR ANY PURPOSE OTHER THAN THAT FOR WHICH IT IS SPECIFICALLY FURNISHED.

**FABRICATION NOTES:**  
 ALL VALVES ARE RAISED FACE UNLESS NOTED.  
 ALL FITTING MAKE-UP & CUT LENGTHS FOR BW PIPE DO NOT INCLUDE WELD GAPS.  
 SHOP TO MAKE ADJUSTMENTS FOR WELD GAPS.  
 ALL PIPE SEAMLESS UNLESS NOTED OTHERWISE.  
 ALL COUPLING TO BE SHOULDER ON.

**Thomas Russell Co.**

7050 S. Yale, Suite 210  
 Tulsa, Oklahoma 74136  
 PH.: 918-481-5682

|                  |                  |               |          |
|------------------|------------------|---------------|----------|
| LINE No.         | 235-E1-CS-3" 1"C |               |          |
| ASSEMBLY DRAWING | SC6-402          |               |          |
| FIELD DRAWING    | ***-235/236      |               |          |
| DRAWN BY         | COB              | DATE DRAWN    | 01/10/18 |
| JOB No.          | 488              | SPOOL LD. No. | SK2-135  |
| REV.             |                  |               | 0        |

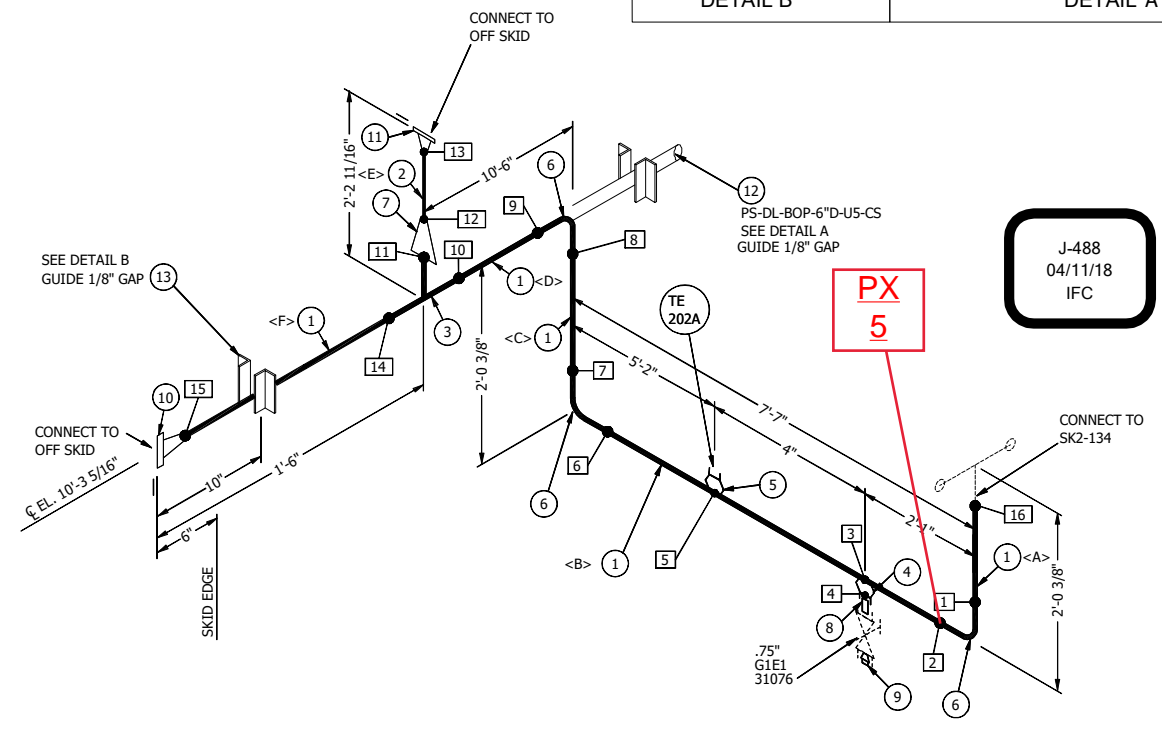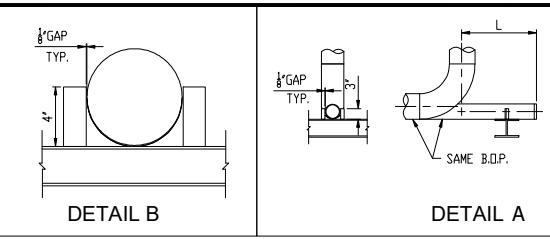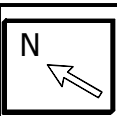

**BILL OF MATERIAL**

| MARK | SIZE  | DESCRIPTION  | QTY         |
|------|-------|--|-------------|
| 1    | 6     | PIPE, XH, SMLS, A-106 Gr. B, BBE   | 17'-3 1/16" |
| 2    | 2     | PIPE, XH, SMLS, A-106 Gr. B, BBE   | 1'-2"       |
| 3    | 6X3   | TEE RED, BW, XH - XH, A-234 Gr. WPB  | 1           |
| 4    | 6X3/4 | S-O-L, SW, 3000#, A-105  | 1           |
| 5    | 6X3/4 | T-O-L, THRD, 3000#, A-105  | 1           |
| 6    | 6     | ELL 90 LR, BW, XH, A-234 Gr. WPB   | 3           |
| 7    | 3X2   | RED CONC, BW, XH - XH, A-234 Gr. WPB   | 1           |
| 8    | 3/4   | NIPPLE, S/160, SMLS, A-106 Gr. B, x 3" LG, POE-TOE (3" LG)   | 1           |
| 9    | 3/4   | PLUG, SOLID STEEL, RND HD, THRD, 3000#, A-105  | 1           |
| 10   | 6     | FLG, RTJWN, 900#, XH, A-105  | 1           |
| 11   | 2     | FLG, RTJWN, 900#/1500#, XH, A-105  | 1           |
| 12   | 6     | (1) PIPE, 3" STD, SMLS, x 30" LG. A-106 Gr. B (1) END PL, 1/4" THK x 3 3/8" O.D. A-36 (L=18"), (2) ANGLE, 2" x 2" x 1/4"x3" LG. A-36 | 1           |
| 13   | 4     | ANGLE, 2" x 2" x 1/4" x 4" LG. A-36  | 2           |

**WELD MAPPING**

| MARK | SIZE | TYPE | SCH |
|------|------|------|-----|
| 1    | 6"   | BW   |     |
| 2    | 6"   | BW   |     |
| 3    | 3/4" | LET  |     |
| 4    | 3/4" | SW   |     |
| 5    | 3/4" | LET  |     |
| 6    | 6"   | BW   |     |
| 7    | 6"   | BW   |     |
| 8    | 6"   | BW   |     |
| 9    | 6"   | BW   |     |
| 10   | 6"   | BW   |     |
| 11   | 3"   | BW   |     |
| 12   | 2"   | BW   |     |
| 13   | 2"   | BW   |     |
| 14   | 6"   | BW   |     |
| 15   | 6"   | BW   |     |
| 16   | 6"   | BW   |     |

**PIPE CUT LIST**

| MARK | SIZE | LENGTH    | END 1 | END 2 |
|------|------|-----------|-------|-------|
| A    | 6"   | 9 3/4"    | BEVEL | BEVEL |
| B    | 6"   | 6'-1"     | BEVEL | BEVEL |
| C    | 6"   | 6 3/8"    | BEVEL | BEVEL |
| D    | 6"   | 9'-3 3/8" | BEVEL | BEVEL |
| E    | 2"   | 1'-2"     | BEVEL | BEVEL |
| F    | 6"   | 6 9/16"   | BEVEL | BEVEL |

|                |            |                |           |     |                        |          |    |     |  |
|----------------|------------|----------------|-----------|-----|------------------------|----------|----|-----|--|
| DESIGN PRESS.  | 1440 Psig  | FAB. LOCATION  | SHOP      |     |                        |          |    |     |  |
| DESIGN TEMP.   | 200 °F     | SPOOL LOCATION | SKID #2   |     |                        |          |    |     |  |
| OPER. PRESS.   | 1265 Psig  |                |           |     |                        |          |    |     |  |
| OPER. TEMP.    | 72 °F      | CORR. ALLOW.   | .0625"    |     |                        |          |    |     |  |
| STRESS RELIEVE | NO         | INSULATION     | NONE      | 0   | ISSUE FOR CONSTRUCTION | 01/10/18 | CW | WD  |  |
| RADIOGRAPHY    | 15% NORMAL | PAINT          | SYSTEM #3 | NO. | REVISION               | DATE     | BY | APR |  |

**CONFIDENTIAL STATEMENT**  
 THIS DRAWING IS THE PROPERTY OF THE THOMAS RUSSELL CO. AND IS NOT TO BE USED FOR ANY PURPOSE OTHER THAN THAT FOR WHICH IT IS SPECIFICALLY FURNISHED.

**FABRICATION NOTES:**  
 ALL VALVES ARE RAISED FACE UNLESS NOTED.  
 ALL FITTING MAKE-UP & OUT LENGTHS FOR BW PIPE DO NOT INCLUDE WELD GAPS.  
 SHOP TO MAKE ADJUSTMENTS FOR WELD GAPS.  
 ALL PIPE SEAMLESS UNLESS NOTED OTHERWISE.  
 ALL COUPLING TO BE SADDLED ON.

**UOP Russell Honeywell**

7050 S. Yale, Suite 210  
Tulsa, Oklahoma 74136

Phone: 918-461-5800  
Fax: 918-461-7427

|                  |              |                |          |
|------------------|--------------|----------------|----------|
| LINE No.         | 216-E1-CS-6" |                |          |
| ASSEMBLY DRAWING | SC6R-402     |                |          |
| P&ID DRAWING     | ***-231      |                |          |
| DRAWN BY         | CW           | DATE DRAWN     | 01/10/18 |
| JOB No.          | 488          | SPOOL I.D. No. | SK2-137  |
| REV.             |              |                | 0        |