




TOP VIEW

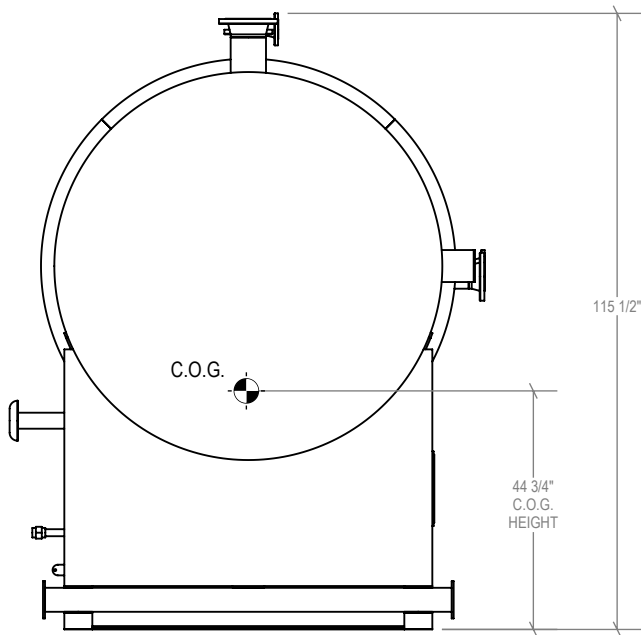

LEFT VIEW

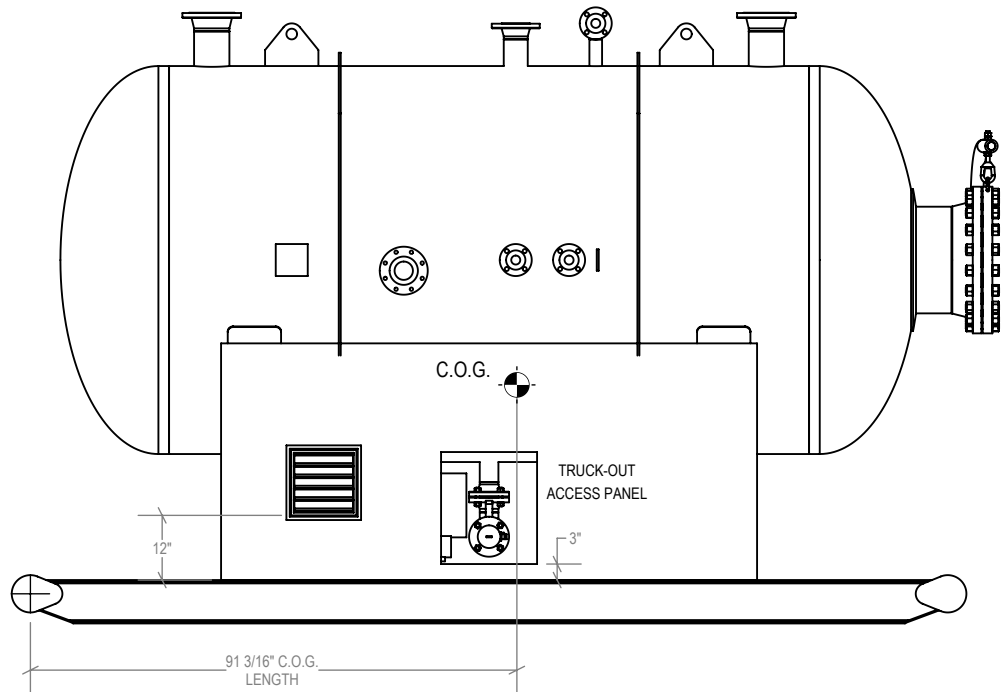

FRONT VIEW

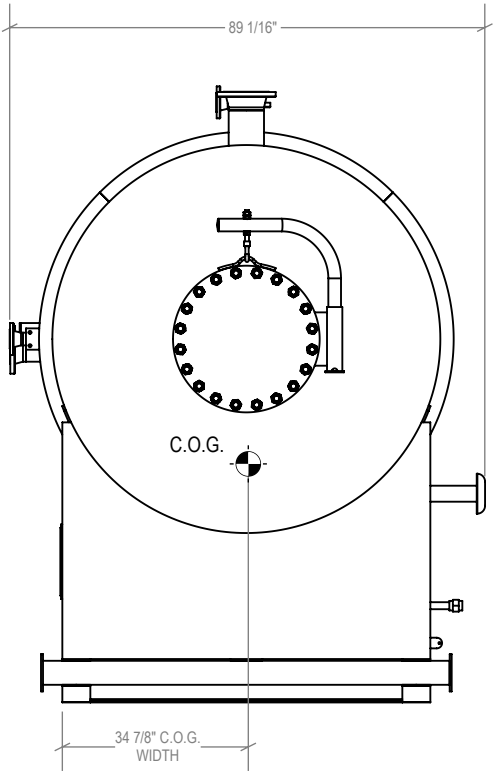

RIGHT VIEW



ISSUED FOR CONSTRUCTION
PROCEED-NO CHANGES__AS NOTED__
BY:____DATE:____

AS BUILT


- NOTES:**
1. SHIPPING DIMENSIONS: 7'-6"W X 15'-6"L X 9'-8" H
 2. SHIPPING WEIGHT: APPROXIMATELY 11,300 LBS
 3. PAINTING: (SKID, SPOOL)
SURFACE PREPARATION: SSPC-SP-3
PRIMER: CLOVERDALE SHOP COAT T-101 AS PER MANUFACTURER'S SPECIFICATIONS
PAINT: CLOVERDALE INDUSTRIAL ENAMEL AS PER MANUFACTURER'S SPECIFICATIONS
COLOR: WARM GREY F-34 (#74021)
 4. INTERNAL COATING: (VESSEL, SPOOL)
INTERNAL PREPARATION: SSPC-SP-5
COATING: DEVOE 253 AS PER MANUFACTURER'S SPECIFICATION
 5. INSULATION: 1 1/2" BLACK SPRAY FOAM

0	2021/07/11	ISSUED FOR CONSTRUCTION	JMR	MC	PA/AS
B	2024/07/04	ISSUED FOR APPROVAL	MC	PA	AS
A	2024/06/07	ISSUED FOR APPROVAL	MC	PA	AS
REV. No.	DATE YYYY/MM/DD	DESCRIPTION	REV. BY	CHK'D BY	APPR BY

CLIENT:

PROJECT:

TITLE:



925 - 23 Street SW., Medicine Hat, Alberta, T1A 8R1
TEL: (403) 526-3142 FAX: (403) 526-1061 Toll: (800) 215-9806

72"ID X 10'-0" S/S X 50 PSIG
FLARE KNOCKOUT PACKAGE

LAYOUT

WO No.:

SIZE: B

DRAWING No.:

STK132 LAYOUT

DRAWN BY: M. CASH


SCALE: 1:36

DRAWN DATE: 2024-06-06


SHEET: 1 OF 5

REVISION:

0

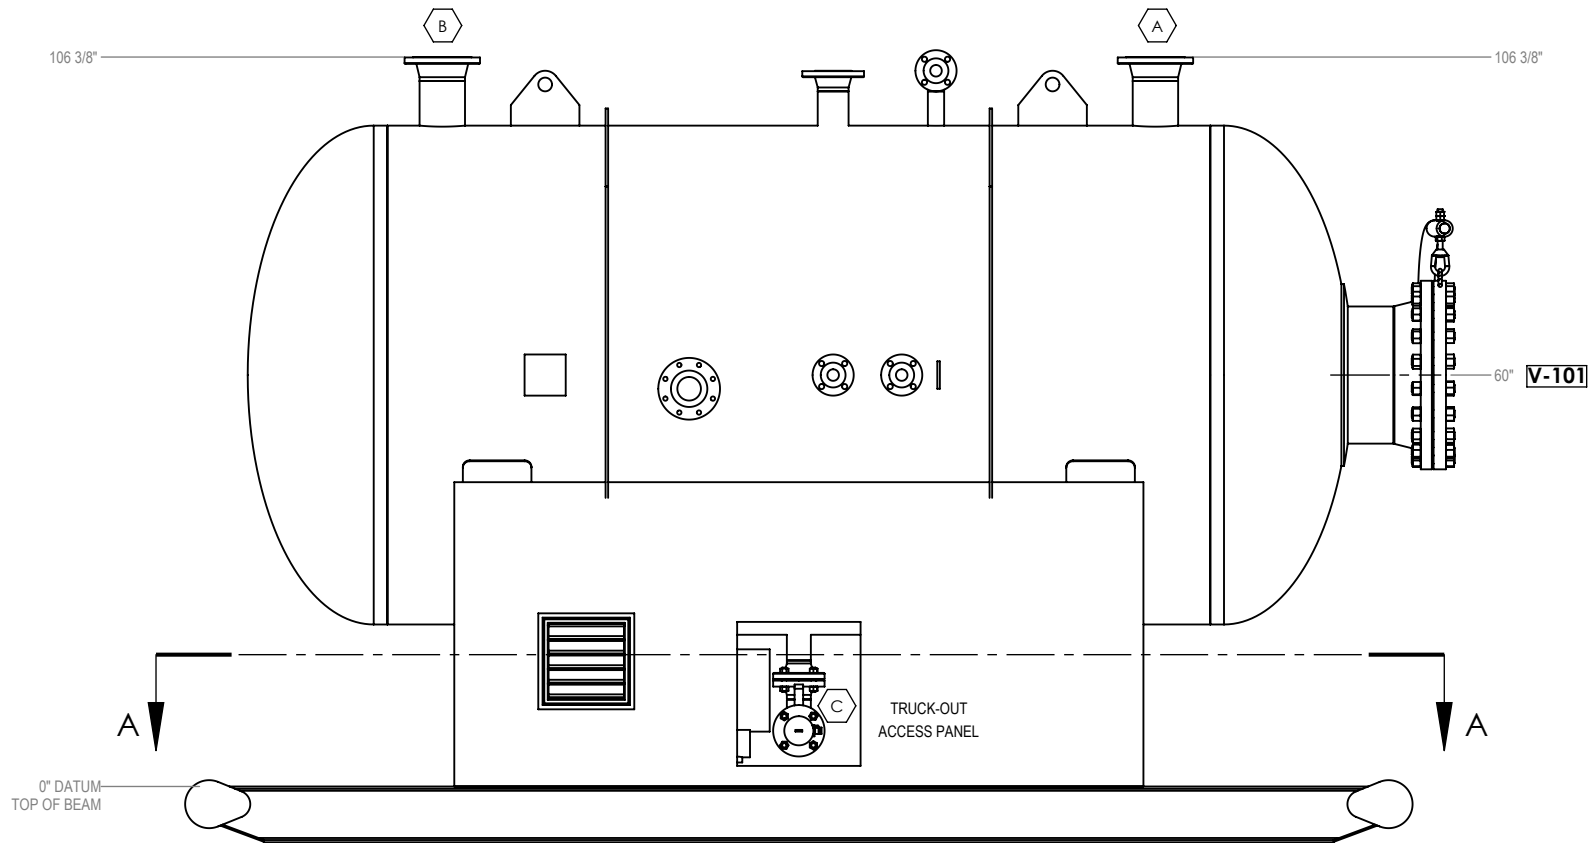

FRONT VIEW

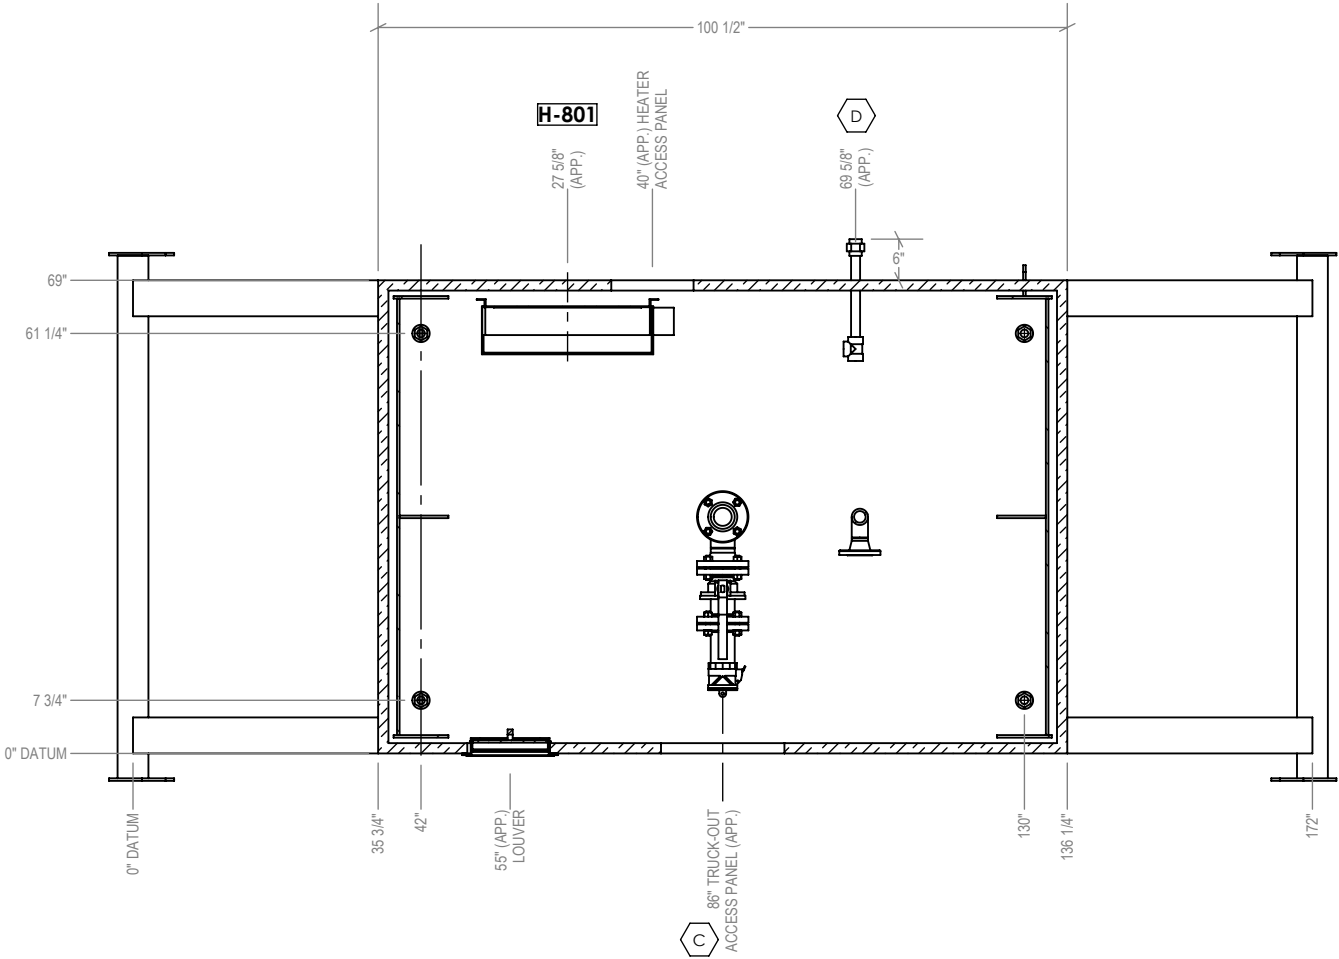

SECTION A-A

AS BUILT




ISSUED FOR CONSTRUCTION
PROCEED-NO CHANGES___ AS NOTED___
BY:_____ DATE:_____

July 16, 2024 7:13:59 AM

PACKAGE CONNECTION SCHEDULE

TAG	SIZE	RATING	DESCRIPTION
A	6"	CL 150 RF	INLET
B	6"	CL 150 RF	OUTLET
C	3"	CL 150 RF	DRAIN / TRUCK OUT
D	1"	3M-NPT	FUEL GAS INLET

CLIENT:		 925 - 23 Street SW., Medicine Hat, Alberta, T1A 8R1 TEL: (403) 526-3142 FAX: (403) 526-1061 Toll: (800) 215-9806	
PROJECT:		72"ID X 10'-0" S/S X 50 PSIG FLARE KNOCKOUT PACKAGE	
TITLE:		LAYOUT	
WO No.:		DRAWN BY: M. CASH	
SIZE:	DRAWING No.	DRAWN DATE:	REVISION:
B	STK132 LAYOUT	2024-06-06	0
SHEET:	SCALE:		
2 OF 5	1:28		

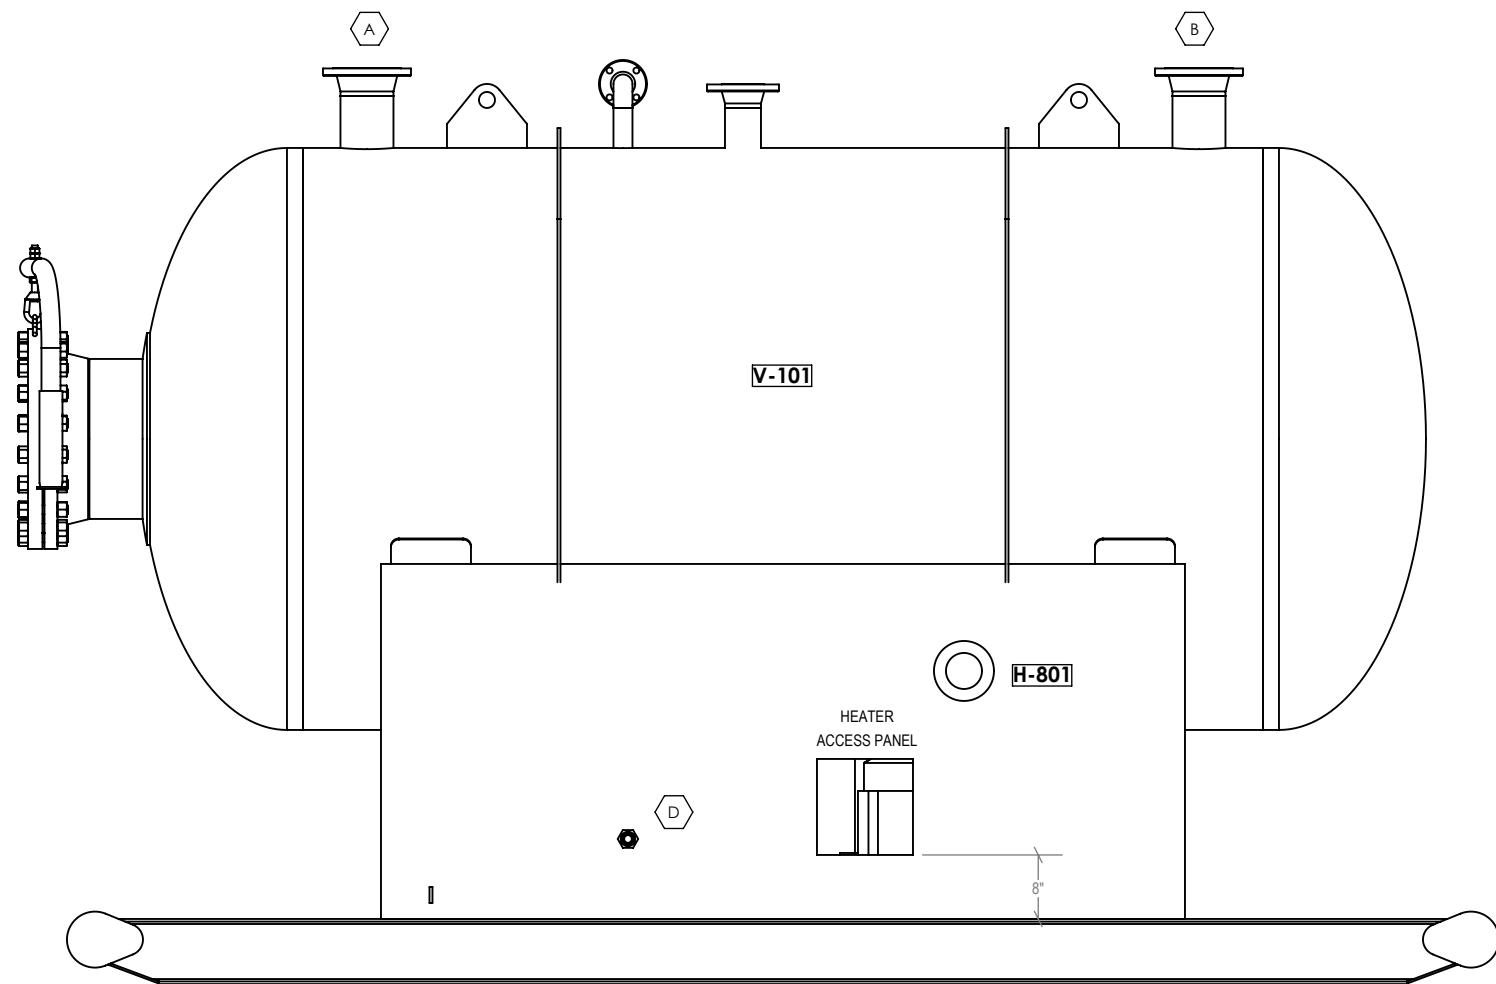

BACK VIEW


AS BUILT




ISSUED FOR CONSTRUCTION
PROCEED-NO CHANGES__AS NOTED__

BY:_____DATE:_____


July 16, 2024 7:13:59 AM

CLIENT:		 925 - 23 Street SW., Medicine Hat, Alberta, T1A 8R1 TEL: (403) 526-3142 FAX: (403) 526-1061 Toll: (800) 215-9806		
PROJECT:		72"ID X 10'-0" S/S X 50 PSIG FLARE KNOCKOUT PACKAGE		
TITLE:		LAYOUT		
WO No.:		DRAWN BY: M. CASH		REVISION:
SIZE:	DRAWING No.	DRAWN DATE:	2024-06-06	0
B	STK132 LAYOUT	SHEET:	3 OF 5	
		SCALE:	1:24	

NOTE:
ELEVATION MEASUREMENTS TO BOTTOM OF PIPE

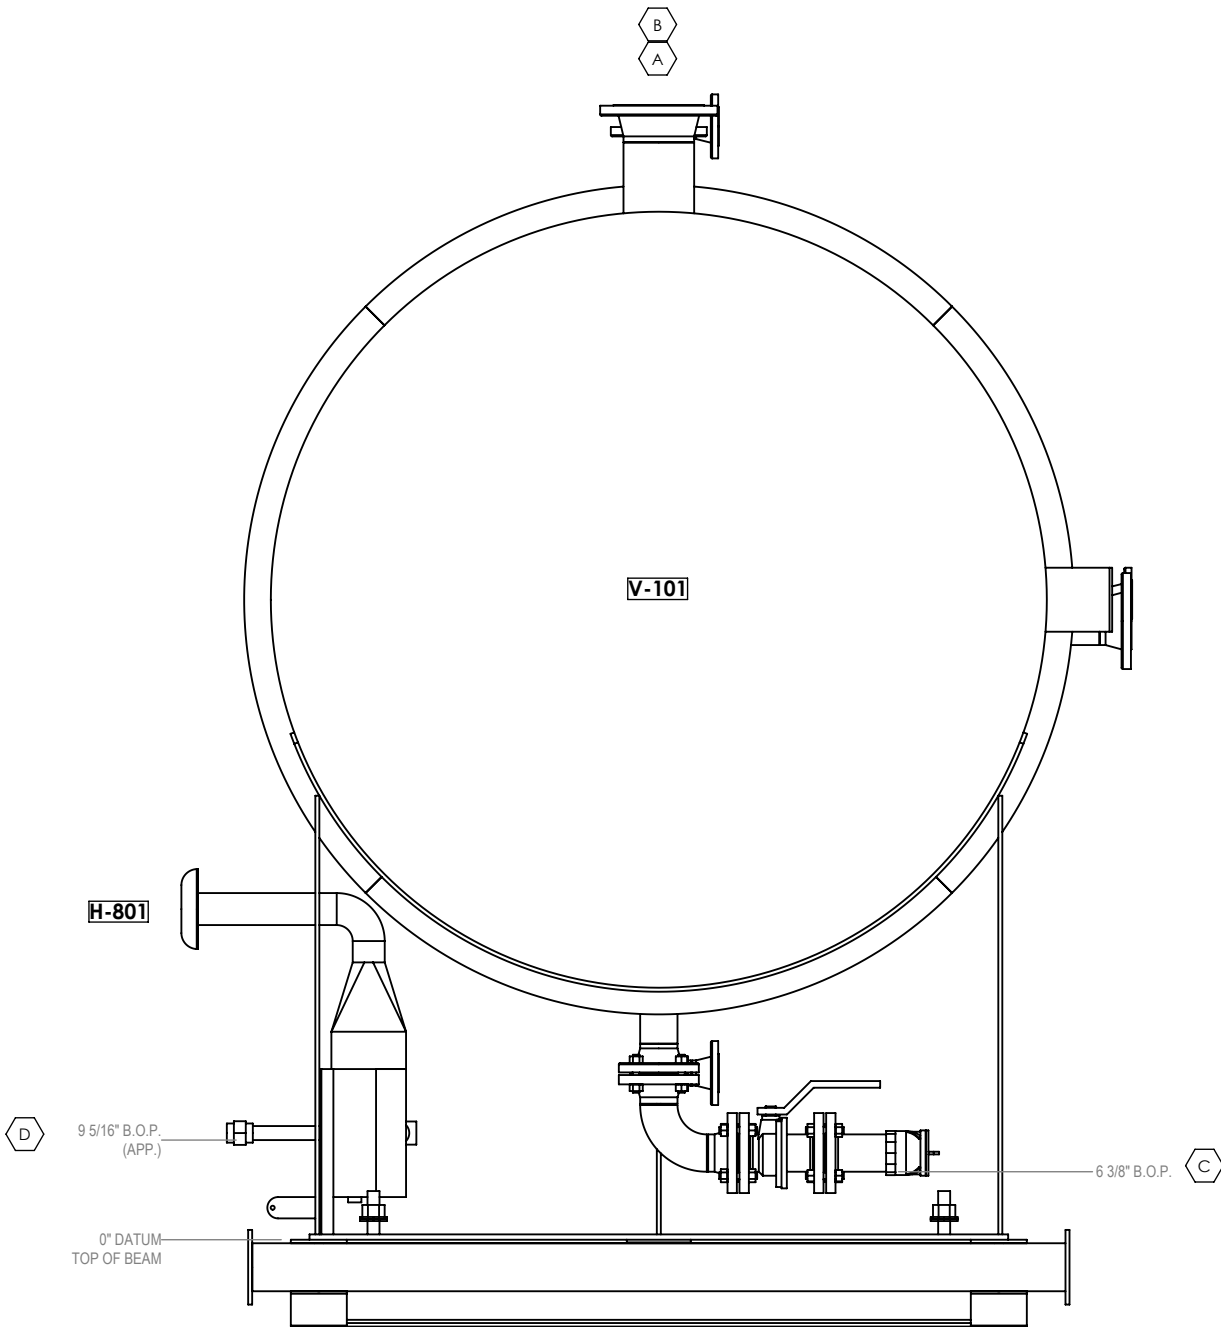

LEFT SIDE VIEW
BUILDING & SADDLE HIDDEN FOR CLARITY

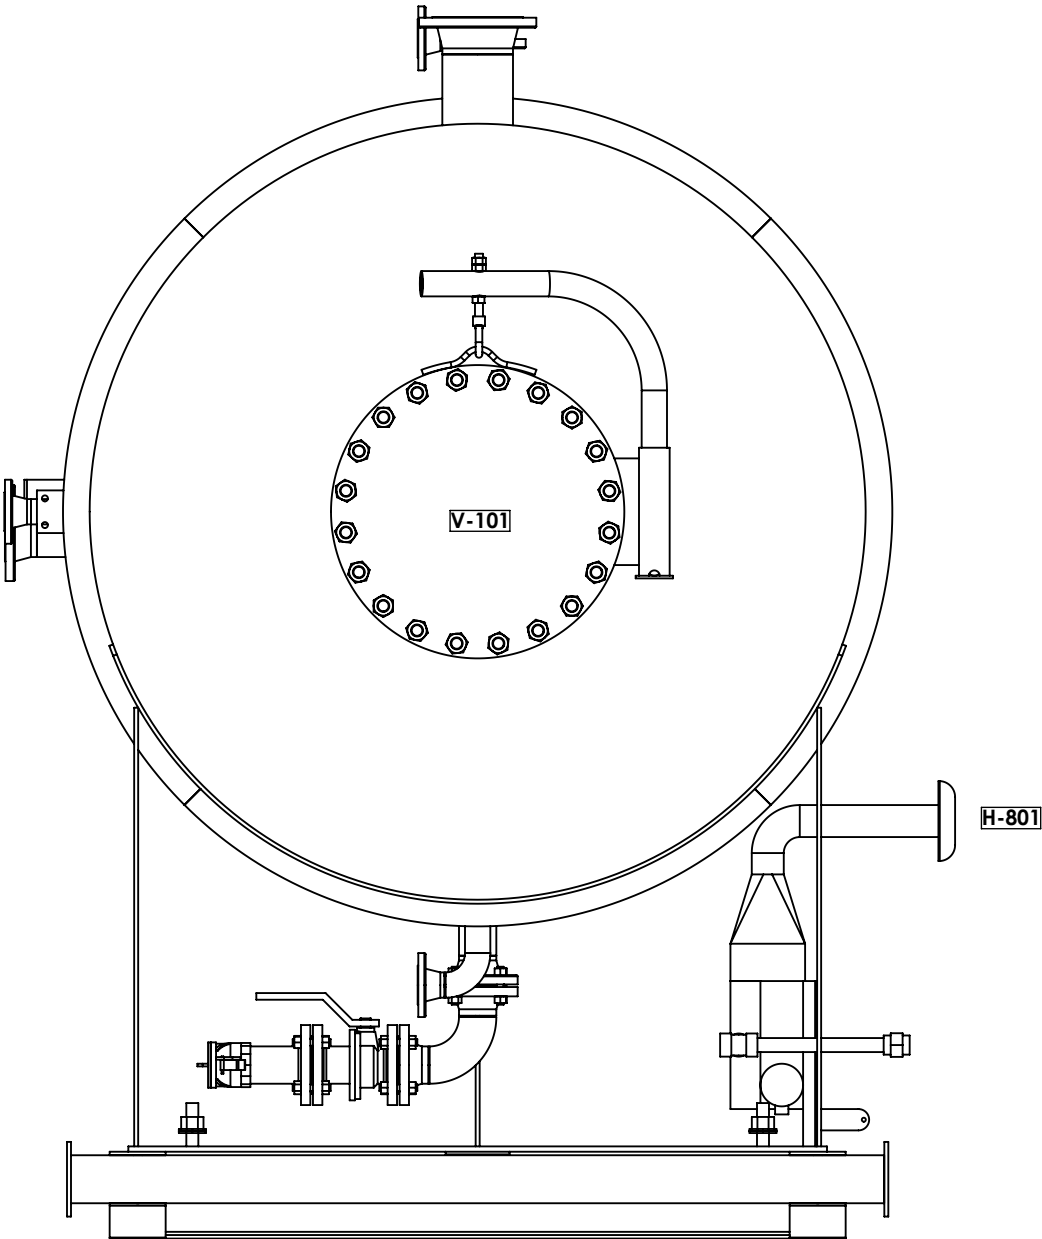


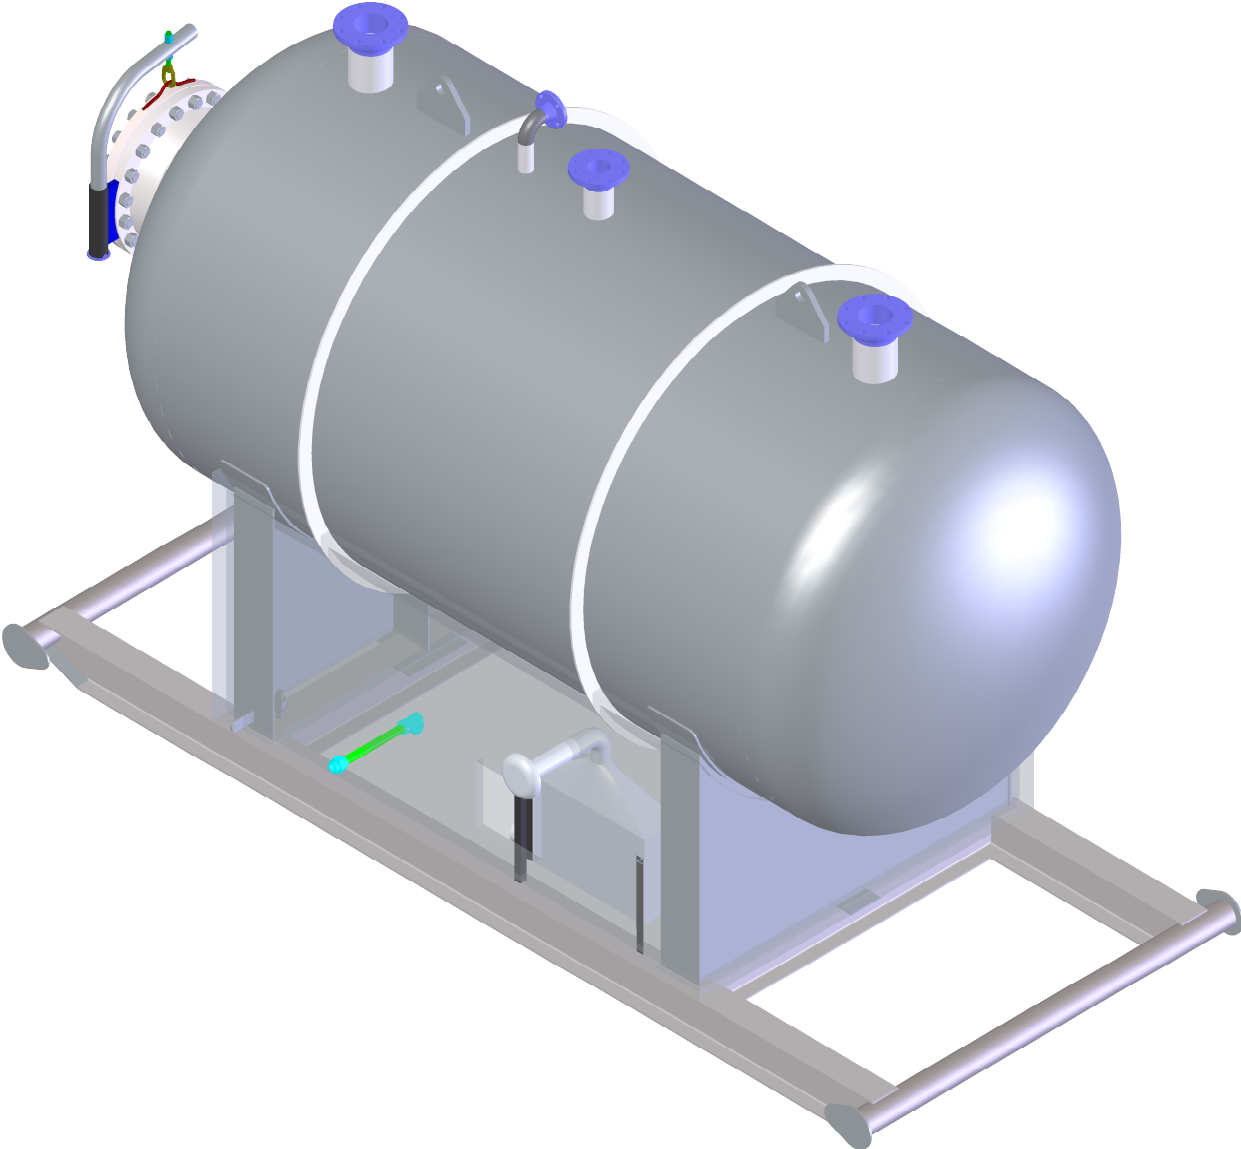
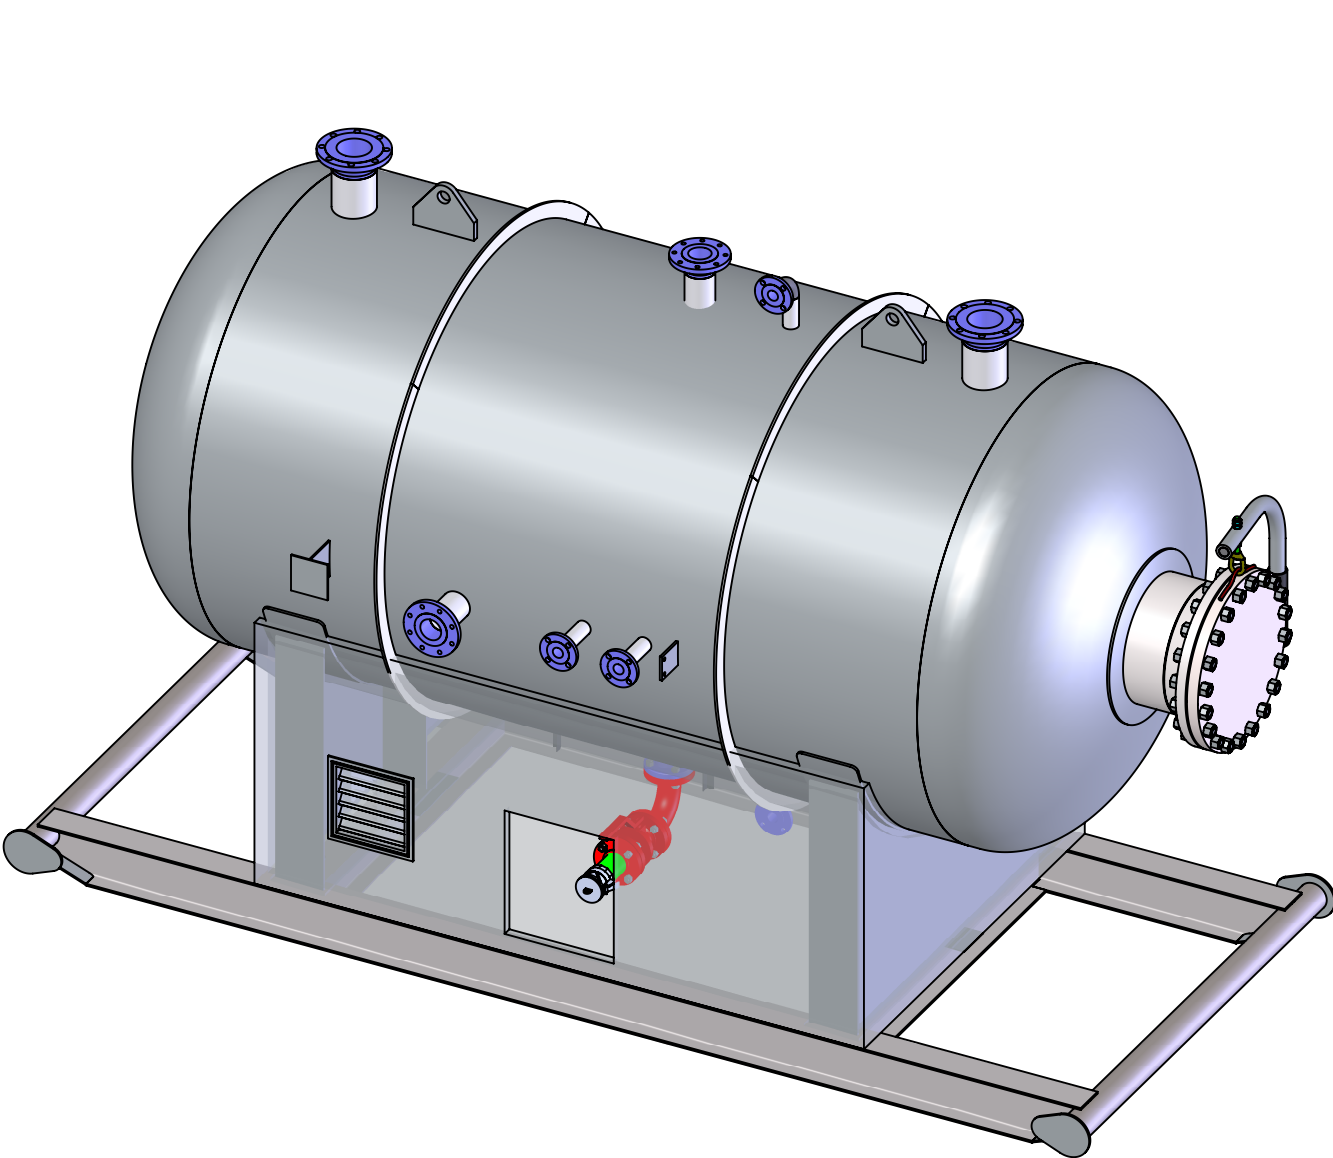
RIGHT SIDE VIEW
BUILDING & SADDLE HIDDEN FOR CLARITY

July 16, 2024 7:13:59 AM

AS BUILT


ARGO
SALES LP
ISSUED FOR CONSTRUCTION
PROCEED-NO CHANGES__ AS NOTED__
BY: _____ DATE: _____

CLIENT:		 925 - 23 Street SW., Medicine Hat, Alberta, T1A 8R1 TEL: (403) 526-3142 FAX: (403) 526-1061 Toll: (800) 215-9806	
PROJECT:		72"ID X 10'-0" S/S X 50 PSIG FLARE KNOCKOUT PACKAGE	
TITLE:		LAYOUT	
WO No.:		DRAWN BY: M. CASH	REVISION:
SIZE: B	LINE No.: -	DRAWING No.:	0
		STK132 LAYOUT	
		SCALE: 1:18	




July 16, 2024 7:13:59 AM

AS BUILT



ARGO
SALES LP

ISSUED FOR CONSTRUCTION
PROCEED-NO CHANGES___ AS NOTED___
BY: _____ DATE: _____

CLIENT:		 925 - 23 Street SW., Medicine Hat, Alberta, T1A 8R1 TEL: (403) 526-3142 FAX: (403) 526-1061 Toll: (800) 215-9806	
PROJECT:		72"ID X 10'-0" S/S X 50 PSIG FLARE KNOCKOUT PACKAGE	
TITLE:		LAYOUT	
WO No.:		DRAWN BY: M. CASH	DRAWN DATE: 2024-06-06
SIZE: B	LINE No.: -	DRAWING No.:	REVISION: 0
STK132 LAYOUT		SHEET: 5 OF 5	SCALE: 1:28