


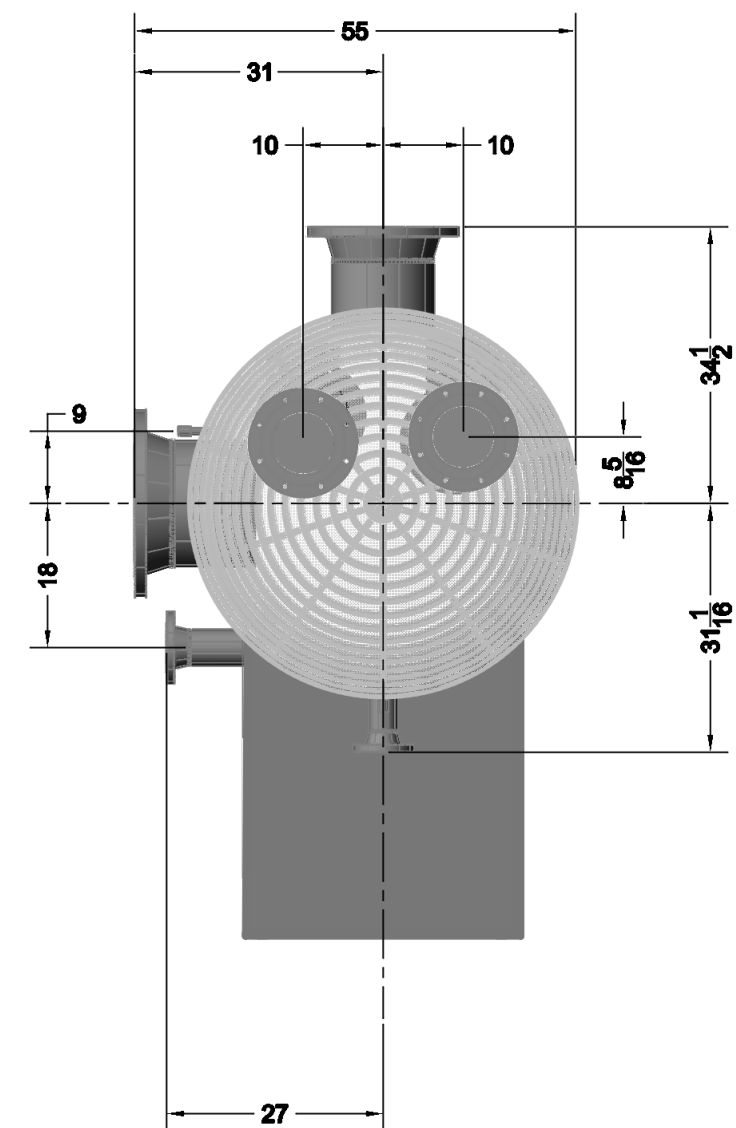

				RARE OILFIELD SERVICES 502 MITCHELL DRIVE SE REDCLIFF, ALBERTA, T0J 2P0	RARE EQUIPMENT #		DRAWING TITLE	FILE NAME	
					16218 - SLIDGE CATCHER			16218 25BBL SLUG CATCHER AS BUILT	
								LAYOUT NAME	
								SHT 1	
REV	DESC				BY	DATE		REVISION	
REVISIONS									
							16044 - SLUDGE CATCHER ORIGINAL BUILD BY MALONEY STEEL GENERAL ARRANGEMENT SHEET 1 OF 3		