
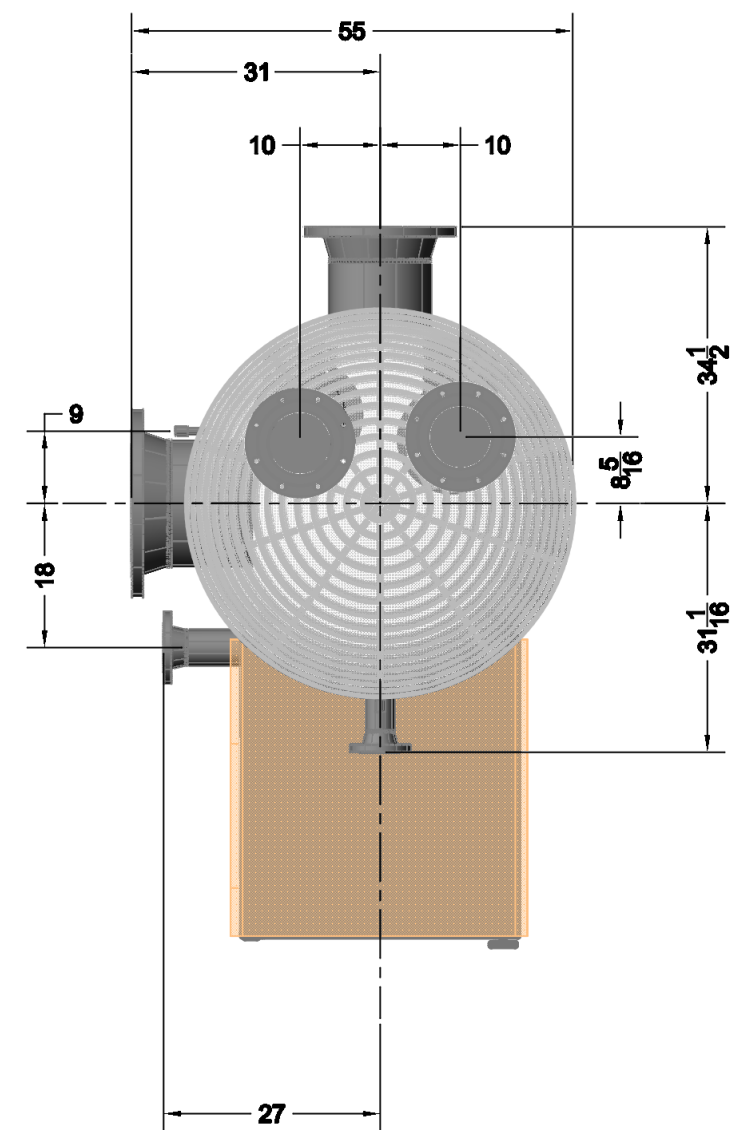
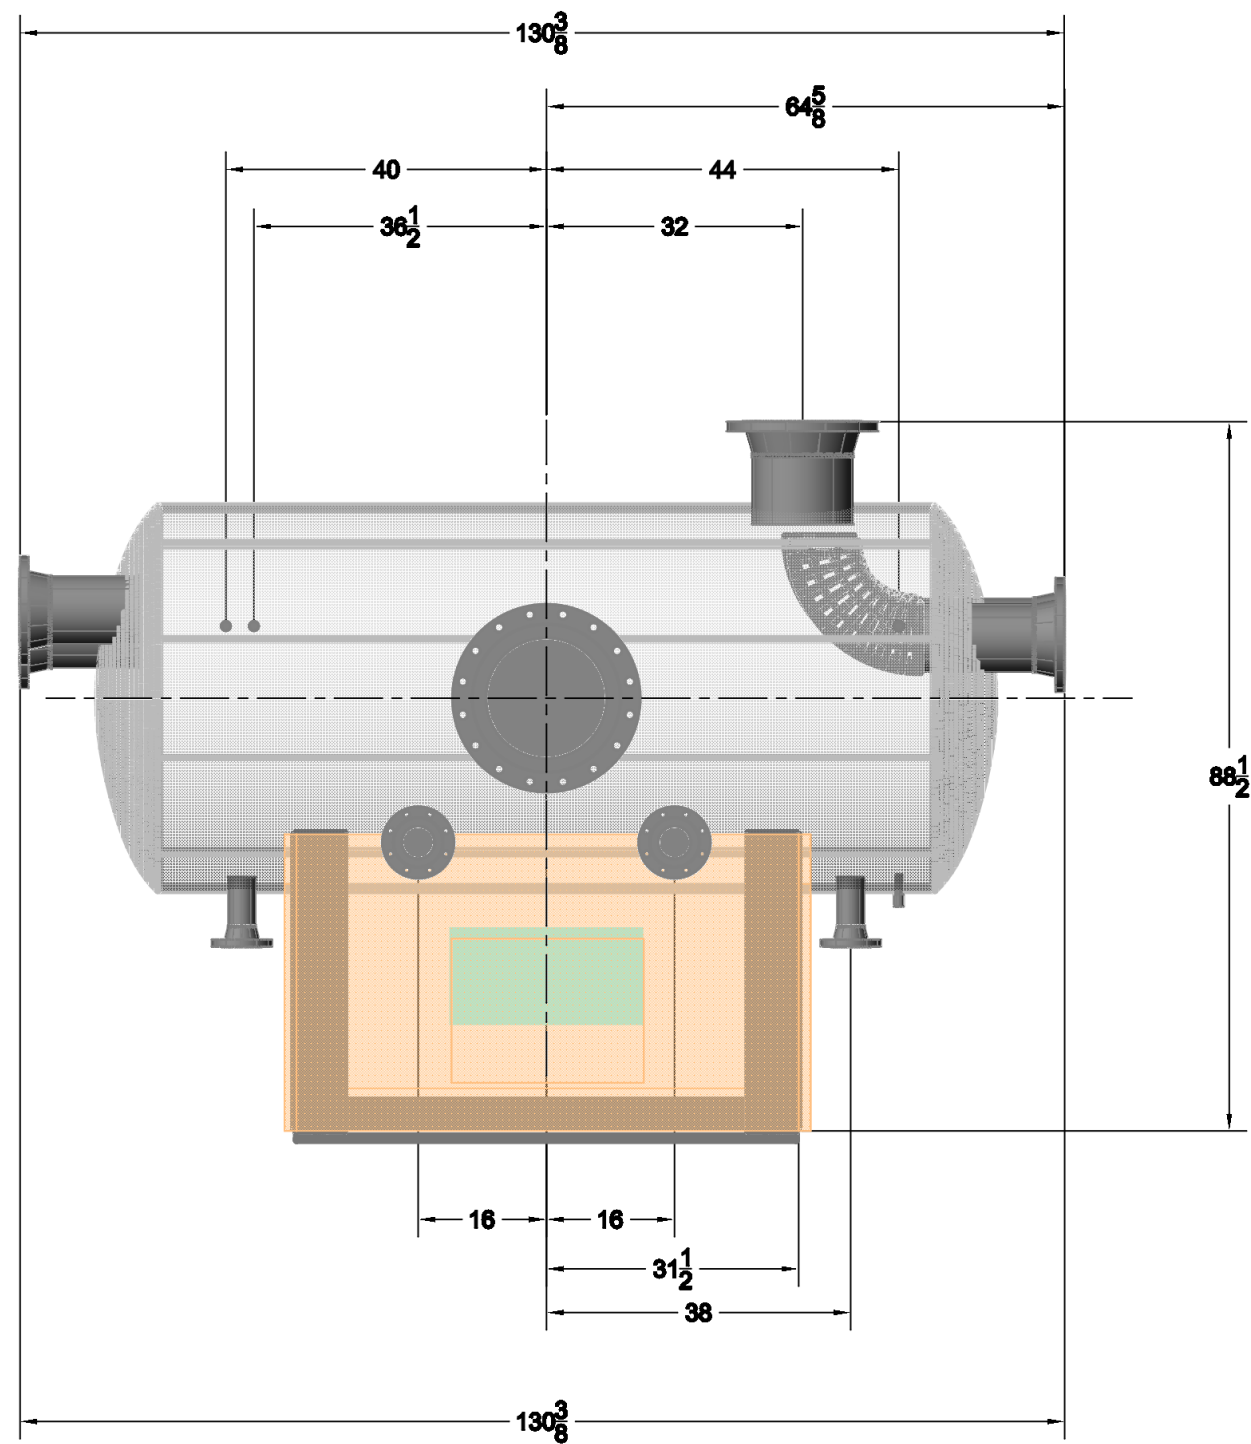


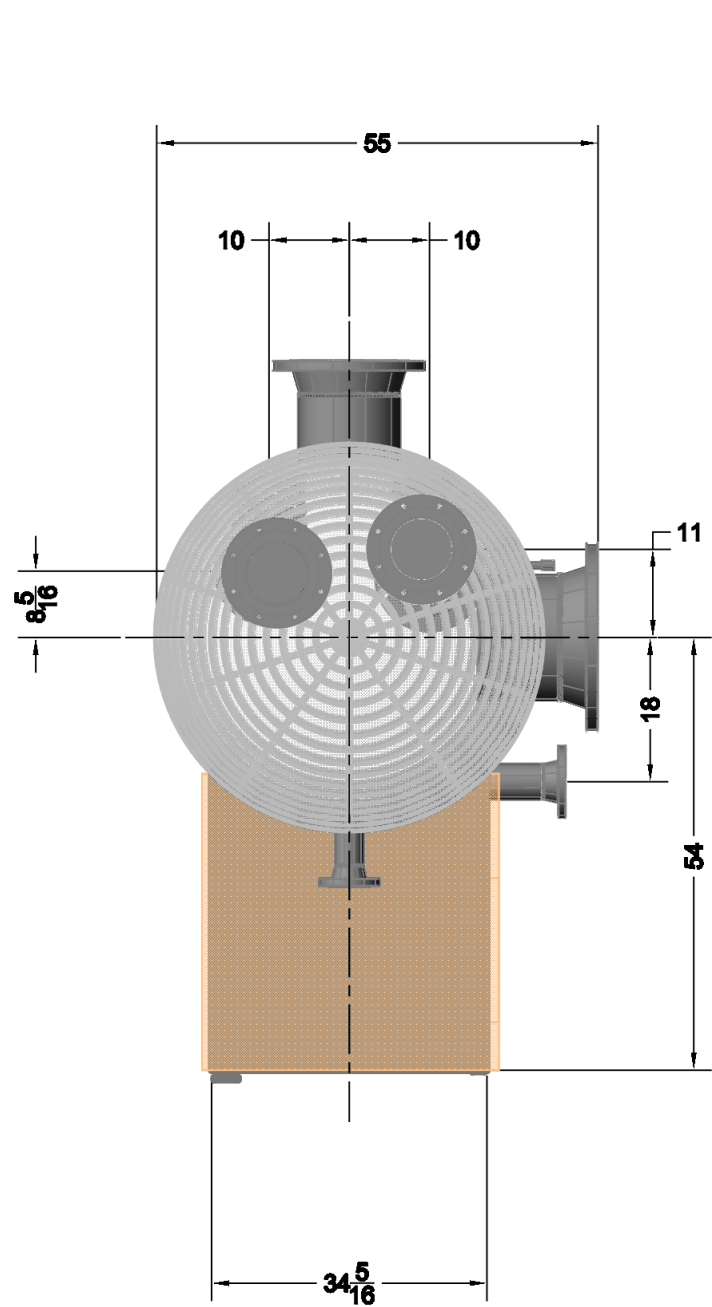

- NOTES:
- ADD 4" CHANNEL TO SUPPORT INSULATED PANELS
 - ADD INSULATED SANDWICH PANELS TO VESSEL UNDERSIDE
 - ADD 12 X 24, 12V CATADYNE IN INSULATED ENCLOSURE.

				RARE OILFIELD SERVICES 502 MITCHELL DRIVE SE REDCLIFF, ALBERTA, T0J 2P0	RARE EQUIPMENT # 16218 - SLIDGE CATCHER		DRAWING TITLE 16044 - SLUDGE CATCHER ORIGINAL BUILD BY MALONEY STEEL GENERAL ARRANGEMENT SHEET 1 OF 3	FILE NAME 16218 25BBL SLUG CATCHER AS BUILT		
								LAYOUT NAME SHT 1		
					DATE JULY 6, 2026			DRAWN BY K HOBMAN		
REV	DESC	BY	DATE					REVISION A		REVISION DATE
REVISIONS										