


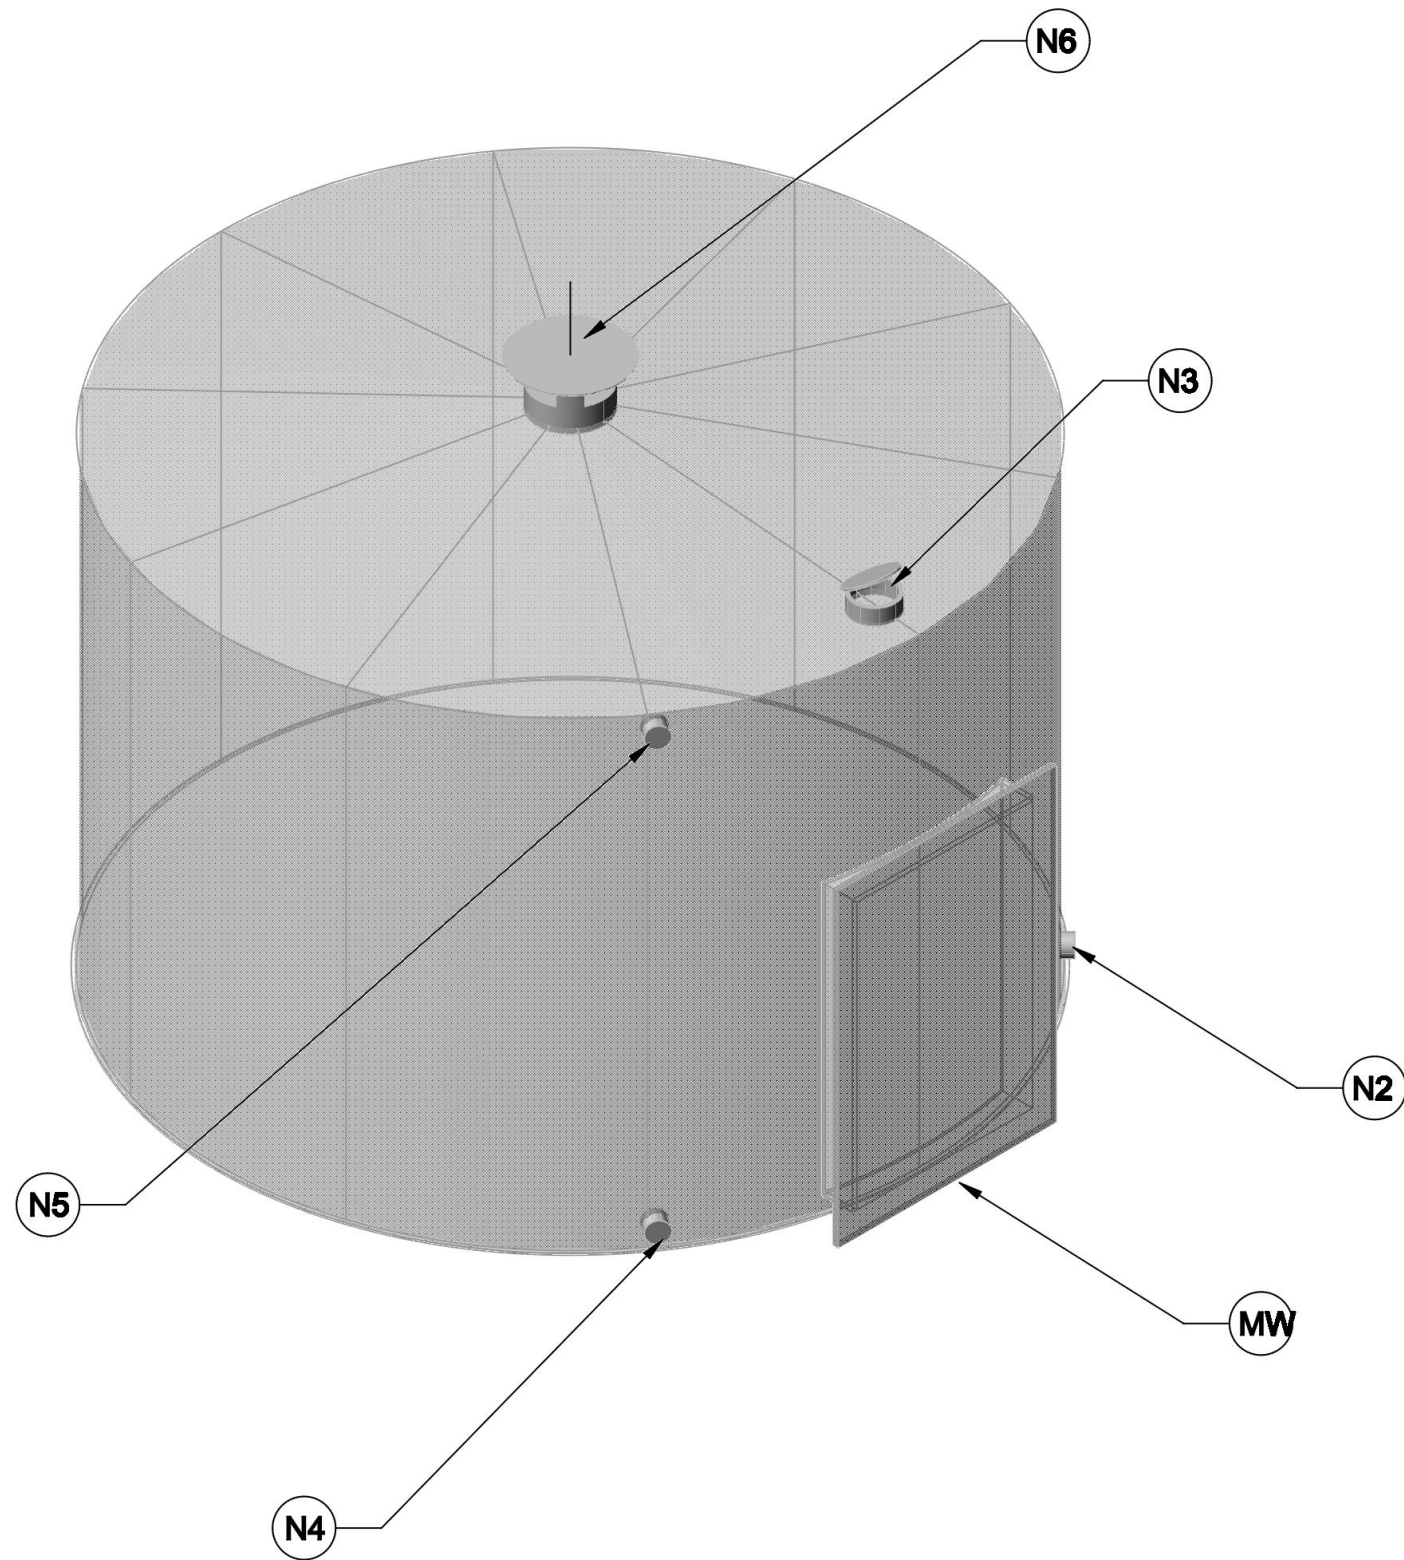

				RARE OILFIELD SERVICES 502 MITCHELL DRIVE SE REDCLIFF, ALBERTA, T0J 2P0	RARE EQUIPMENT # 16220 - 40 BBL TANK BY DAPAJ0		DRAWING TITLE 16220 - 40BBL TANK GENERAL ARRANGMENT SHT 2 OF 2	FILE NAME 16220 40 BBL TANK AS BUILT	
								LAYOUT NAME SHT 2	
					DATE Oct 13, 2026			DRAWN BY K HOBMAN	
REV	DESC			BY	DATE				
REVISIONS									