

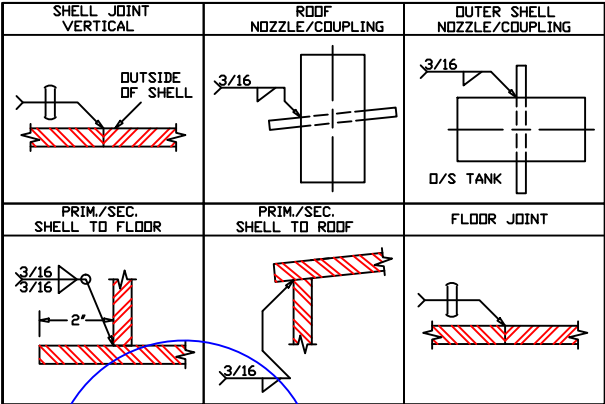


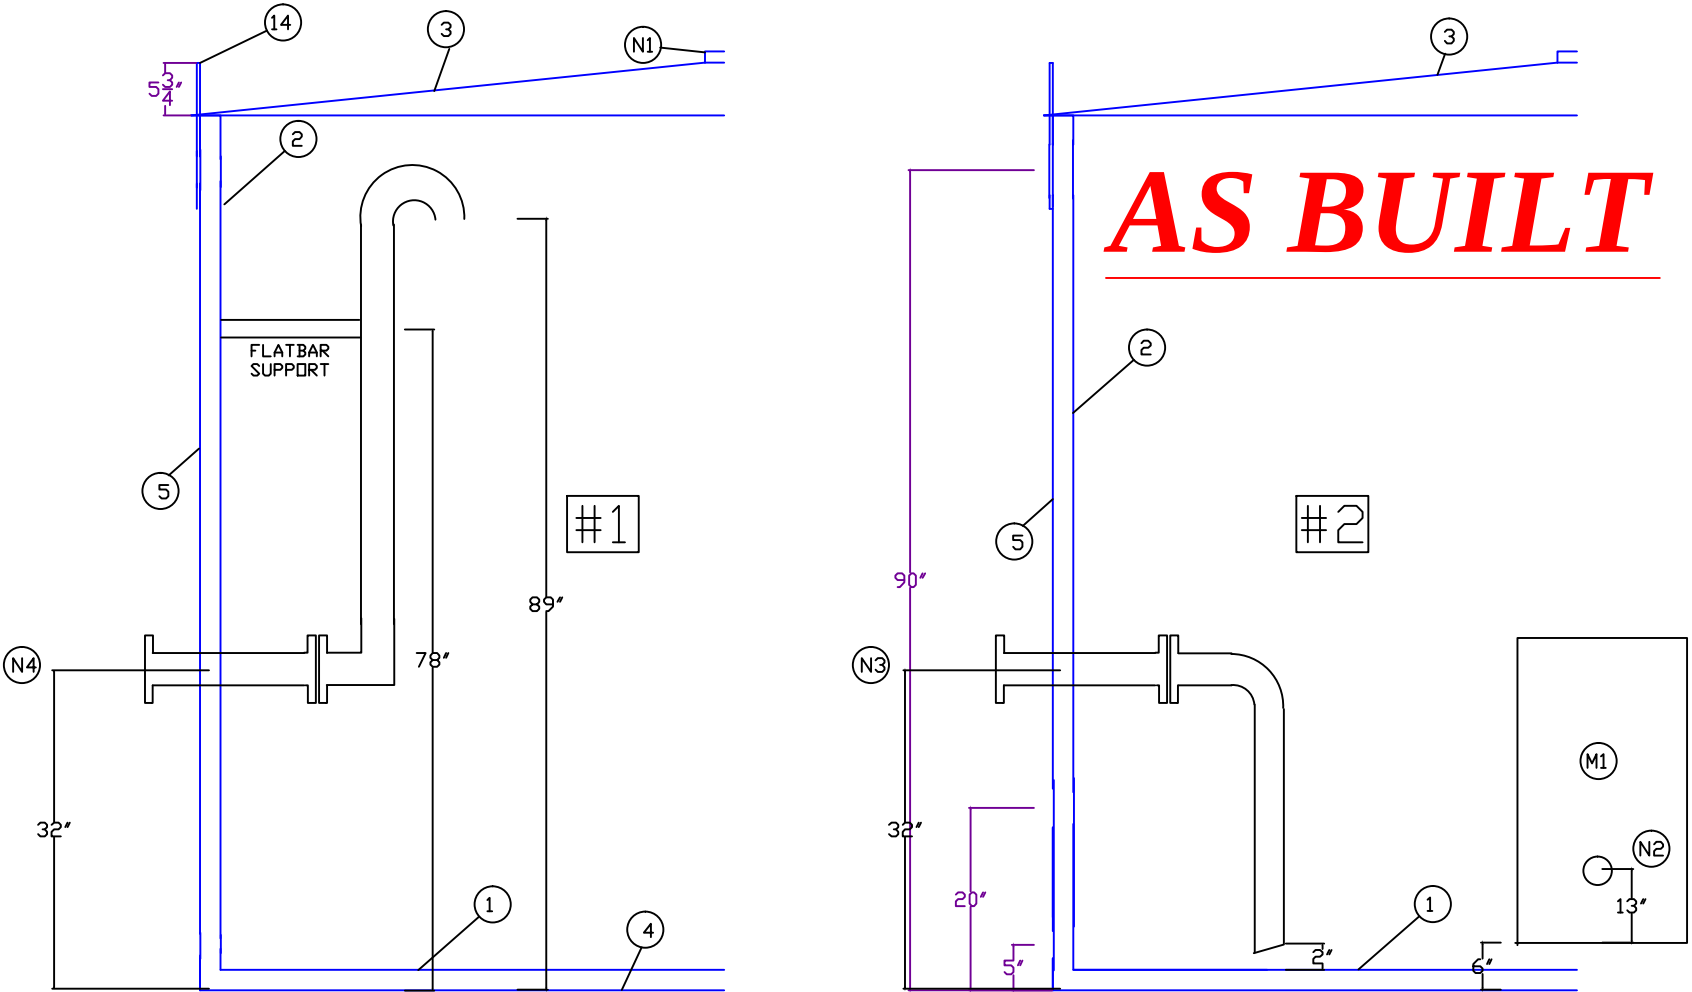

CONNECTION SCHEDULE								
MK	QTY	SIZE	SCH	RATING	TYPE	ELEVATION	PROJECTION	DESCRIPTION
N1	1	10"	SCH. 40	150#	RFSD	DOME	6"	VENT C/W ½" SCREEN PLATE
N2	1	4"	SCH. 40	150#	RFSD	13" M.L.	6"	ANNODE
N3	1	3"	SCH. 40	150#	RFSD	32"	8"	PUMP OUT C/W REMOVABLE DOWNCOMER
N4	1	2"	SCH. 40	150#	RFSD	32"	6"	INLET WITH REMOVABLE RISER
C4	1	2"	-	3000#	HALF CPLG	3"	2"	SEC. DRAIN
C5	1	3"	-	3000#	FULL CPLG	87"	3"	LSH
C6	1	2"	-	3000#	FULL CPLG	87"	3"	SPARE
C7	1	1-1/2"	-	3000#	FULL CPLG	DOME	2"	GAUGE BOARD ASSEMBLY
C8	1	1/2"	-	3000#	FULL CPLG	90"	1"	BREATHER VENT
C9	1	1/2"	-	3000#	HALF CPLG	3"	3"	SEC. SITE GLASS
C10	1	2"	-	3000#	FULL CPLG	87"	3"	SPARE
M1	1	24" x 48"	-	-	-	30"		MANWAY
TH1	1	8"	-	-	-	DOME	6"	THIEF HATCH </td

BILL OF MATERIALS			
MK	QTY	DESCRIPTION	
1	1	PRIMARY FLOOR: 1/4" THK x 120" WIDE x 120" LONG FLAT PLATE	
2	1	PRIMARY WALL: 3/16" THK x 96" WIDE x 347" LONG FLAT PLATE (LOOPED)	
3	1	PRIMARY ROOF: 3/16" THK x 120" WIDE x 120" LONG FLAT PLATE	
4	1	SECONDARY FLOOR: 3/16" THK. x 120" WIDE x 120" LONG FLAT PLATE	
5	1	SECONDARY WALL: 3/16" THK. x 96" WIDE x 367" LONG FLAT PLATE (LOOPED)	
6	1	10" 150# rfso C/W ½" FLANGED SCREEN	
7	1	2" 150# INLET	
8	1	2" NIPPLE X 8" (NIPPLE NEEDS TO BE CUT IN HALF) (NPT x CUT) & BULLSEYE SIGHT GLASS	
9	1	3" 150# LOAD OUT C/W 3" REMOVABLE DOWN COMER	
10	1	3" 3000# COUPLING HLSD	
11	1	1-1/2" 3000# COUPLING	
12	2	2" 3000# COUPLING	
13	1	1/2" 3000# COUPLING	
14	2	3/8" THK x 6" WIDE x 16" LONG LIFT LUGS	
15	1	TANKSTORE 24" X 48" SINGLE MANWAY SET C/W TH BLIND & NEOPRENE GASKET	
16	2	2" 3000# COUPLING WITH 12" PIPE NOZZLES	
17	1	1/2" 3000# COUPLING	
18	1	NAMEPLATE BACKING AND NAMEPLATE	
19	1	8' LADDER C/W 1 SAFETY CAGE & 4 BRACKET CLIPS & 5/8" BOLTS & FLAT WASHERS	
20	1	8" GAUGE BOARD ASSEM C/W FLOAT ASSEMBLY 3" ANGLE IRON TABS (3)	
21	1		
22	1	8" std. service thief hatch set at 4 oz.	
23	3	2" 90 DEGREE ELBOWS	
24	1	BUILDING FLANGE SET	
25	1	1 1/2" WIDE x 3/16" THK. FLAT BAR x 3' LONG	
26	1	2" WIDE x 3/16" THK. FLAT BAR x 6' LONG (SHOP TO CUT TO FIT)	
27	1	2" WIDE x 1" LONG x 3/16" THK. FLAT BAR (SHOP TO CUT TO FIT)	

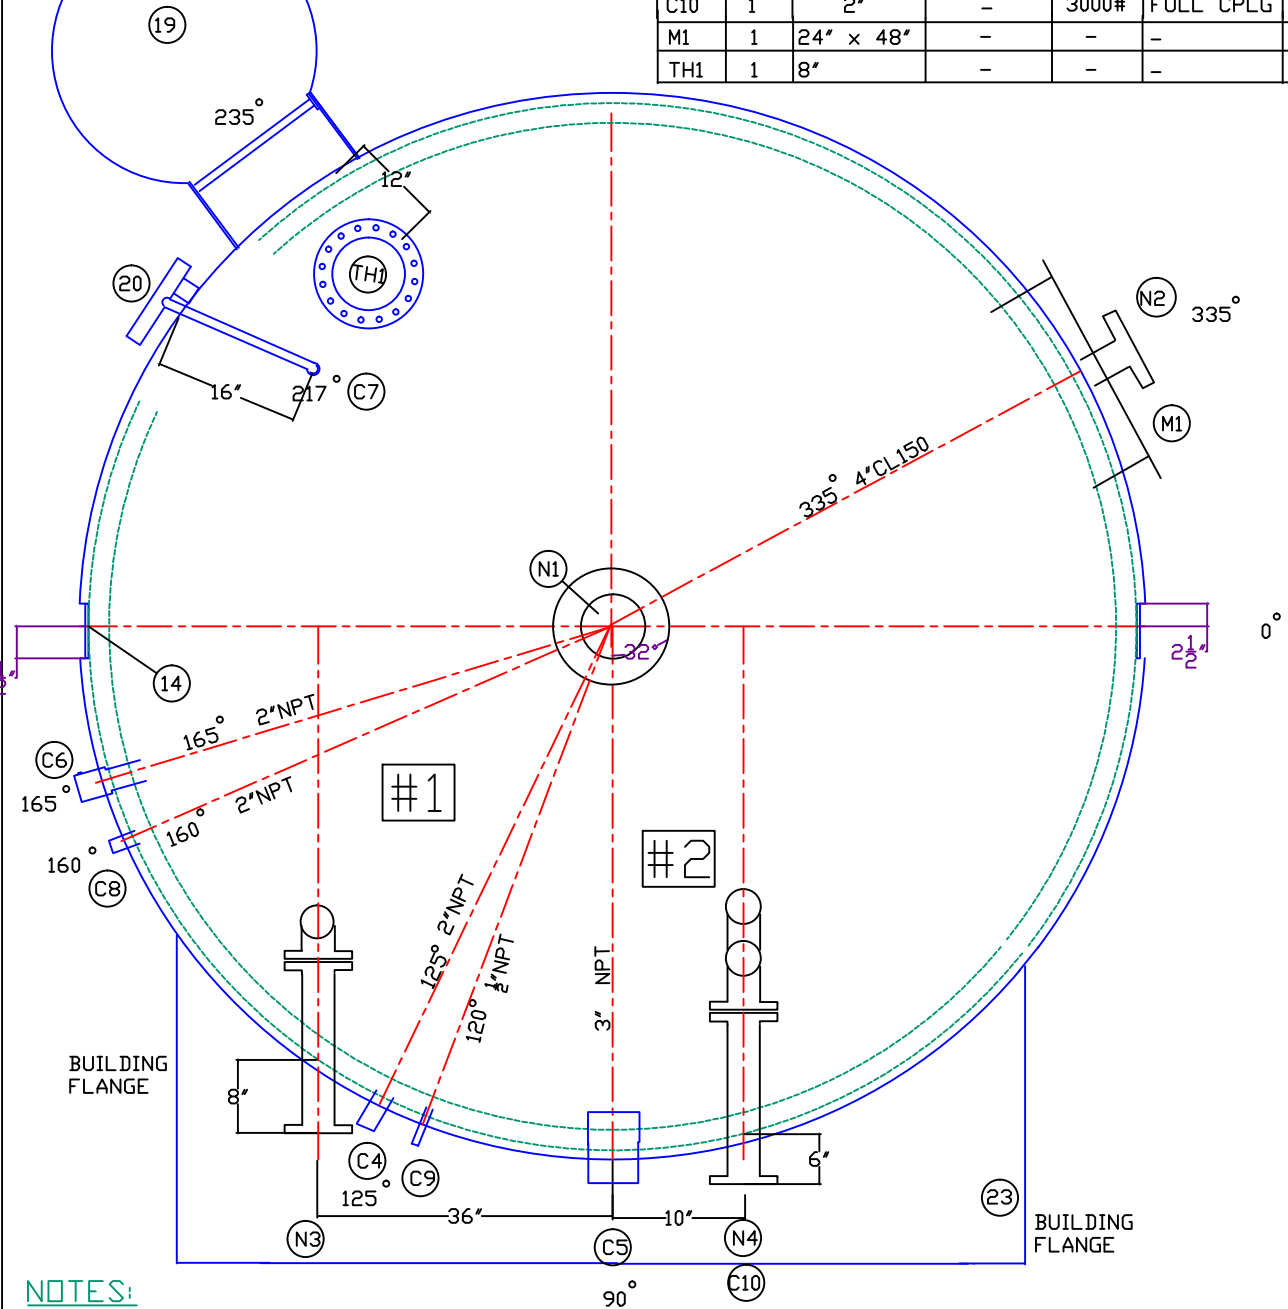

NO.	DATE	REVISION	BY	APP
2	15-01-19	AS BUILT	CT	CT
1	14-11-26	REVISED AS PER CUSTOMER MARK UPS	CT	CT
0	14-11-25	ISSUED FOR APPROVAL	CT	CT



TANKSTORE LTD.
Box 100
Halkirk, Alberta,
Canada, T0C 1M0
403 884 2001

DATE 2015-01-19	CLIENT FOREMOST		
DESIGNED BY	TITLE 100 BBL SC TANK		
DRAWN BY C. TURIGAN	PROJECT # 5904		
CHECKED BY	FILE NAME 5904		
APPROVED BY	SCALE 1 TO 1	SHEET # 1 OF 1	REV # 5904