




TOP VIEW

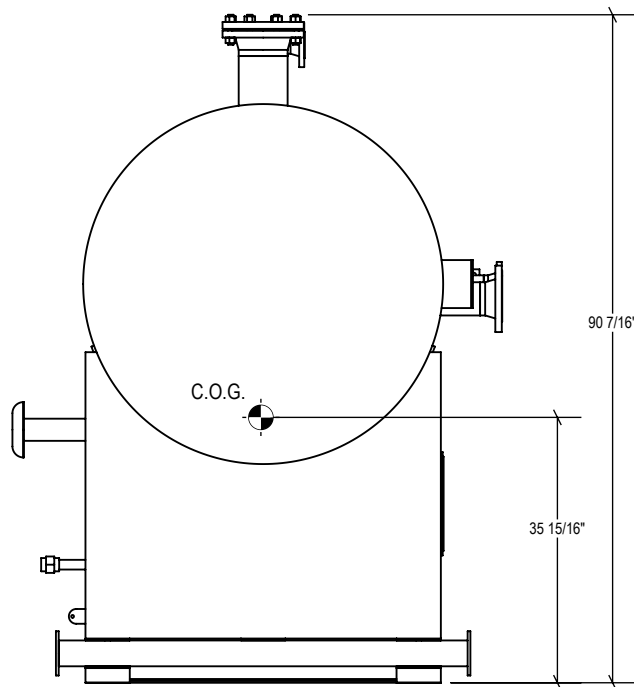

LEFT VIEW

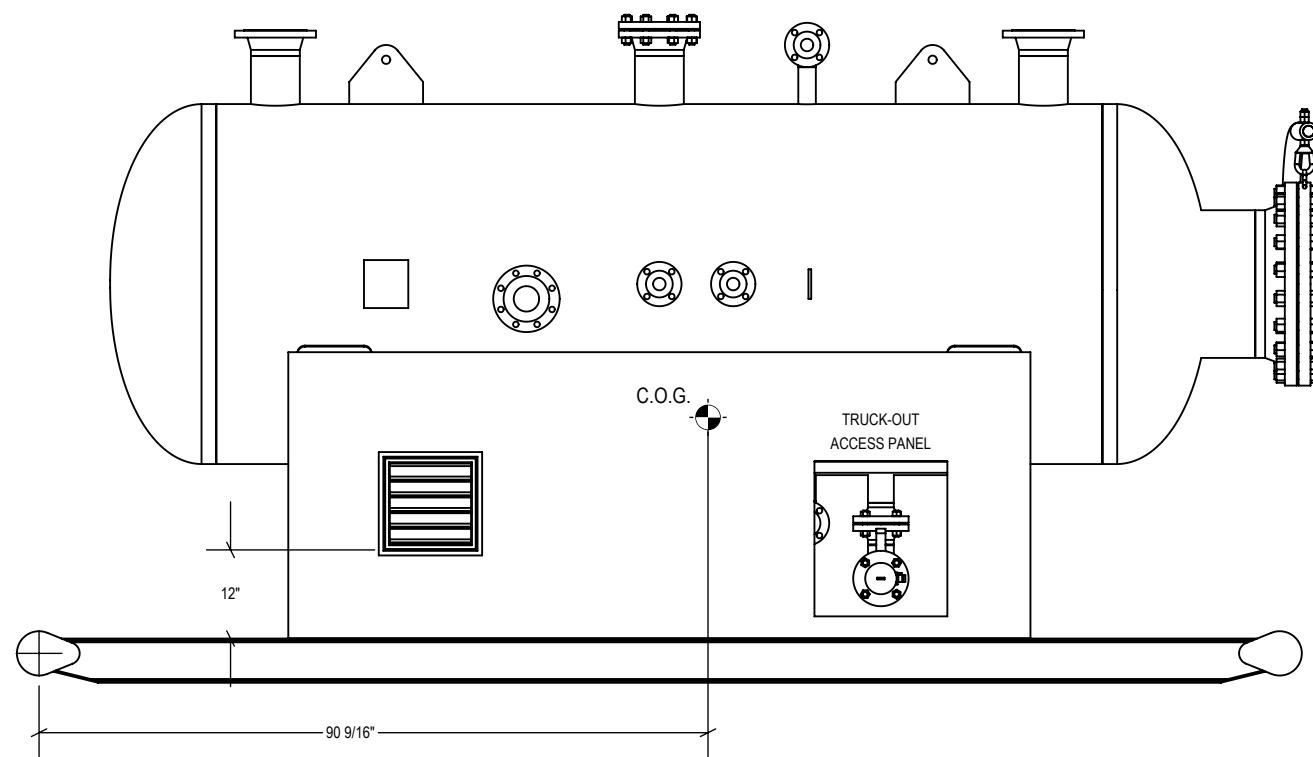

FRONT VIEW

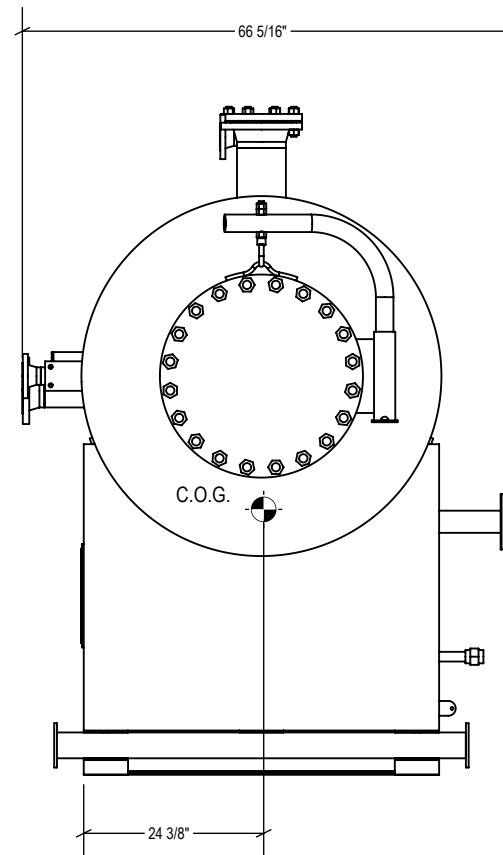

RIGHT VIEW




NOTES:


1. SHIPPING DIMENSIONS: 5'-7"W X 14'-9"L X 7'-7" H
2. SHIPPING WEIGHT: APPROXIMATELY 7,400 LBS
3. PAINTING: (SKID, SPOOL)  
SURFACE PREPARATION: SSPC-SP-3  
PRIMER: CLOVERDALE SHOP COAT T-101 AS PER MANUFACTURER'S SPECIFICATIONS  
PAINT: CLOVERDALE INDUSTRIAL ENAMEL AS PER MANUFACTURER'S SPECIFICATIONS  
COLOR: WARM GREY F-34 (#74021)
4. INTERNAL COATING: (VESSEL, SPOOL)  
INTERNAL PREPARATION: SSPC-SP-5  
COATING: DEVOE 253 AS PER MANUFACTURER'S SPECIFICATION
5. INSULATION: 1 1/2" BLACK SPRAY FOAM

0	2024/07/17	ISSUED FOR CONSTRUCTION	JMR	MC	PA/AS
REV. No.	DATE YYYY/MM/DD	DESCRIPTION	REV. BY	CHK'D BY	APPR BY

CLIENT:		ARGO SALES LP 925 - 23 Street SW., Medicine Hat, Alberta, T1A 8R1 TEL: (403) 526-3142 FAX: (403) 526-1061 Toll: (800) 215-9806	
PROJECT:		48"ID X 10'-0" S/S X 50 PSIG FLARE KNOCKOUT PACKAGE	
TITLE:		LAYOUT	
WO No.:		DRAWN BY: J.REIMER	
SIZE: B		DRAWING No. STK131 LAYOUT	
SHEET: 1 OF 5		SCALE: 1:26	
REVISION:		0	

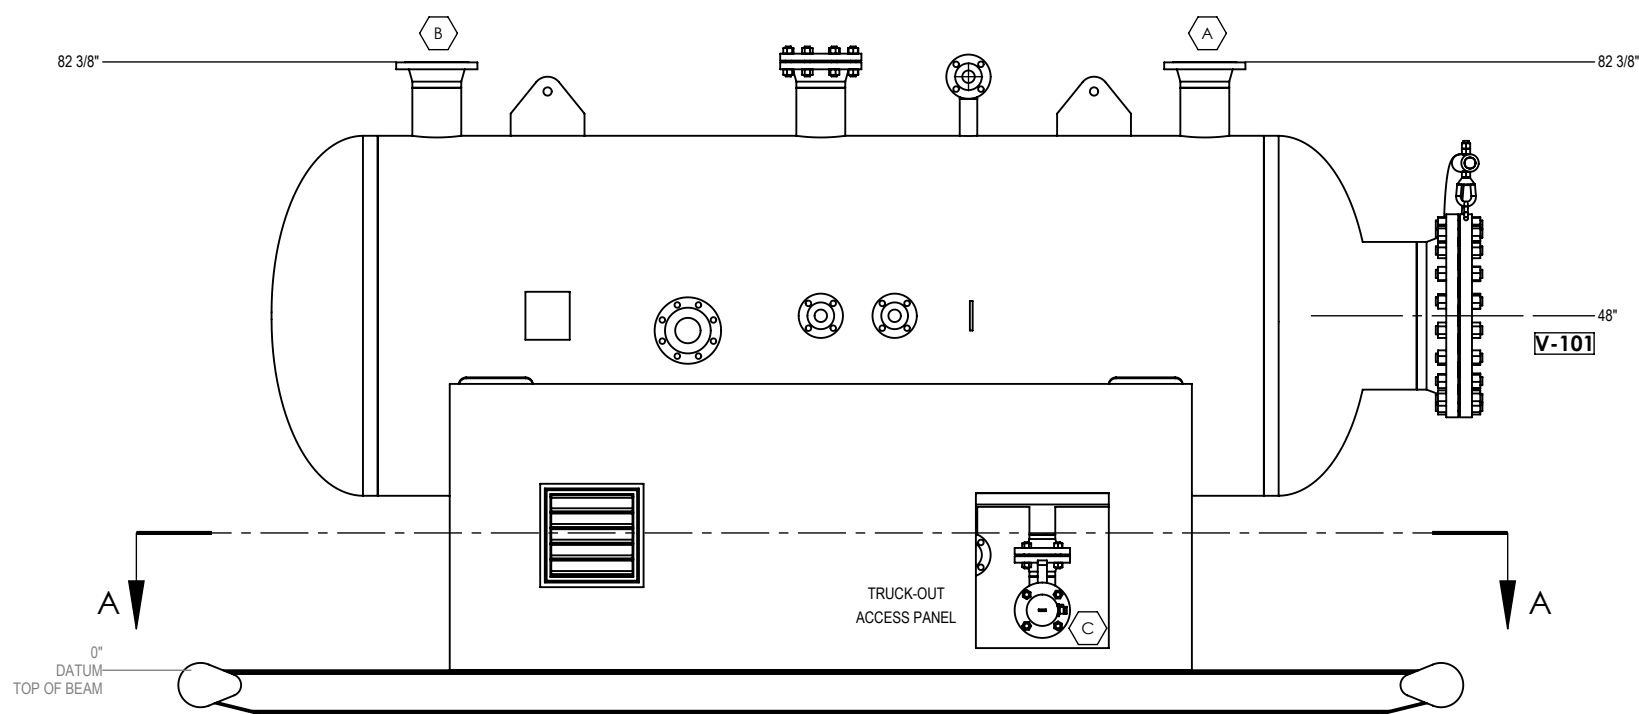

**FRONT VIEW**

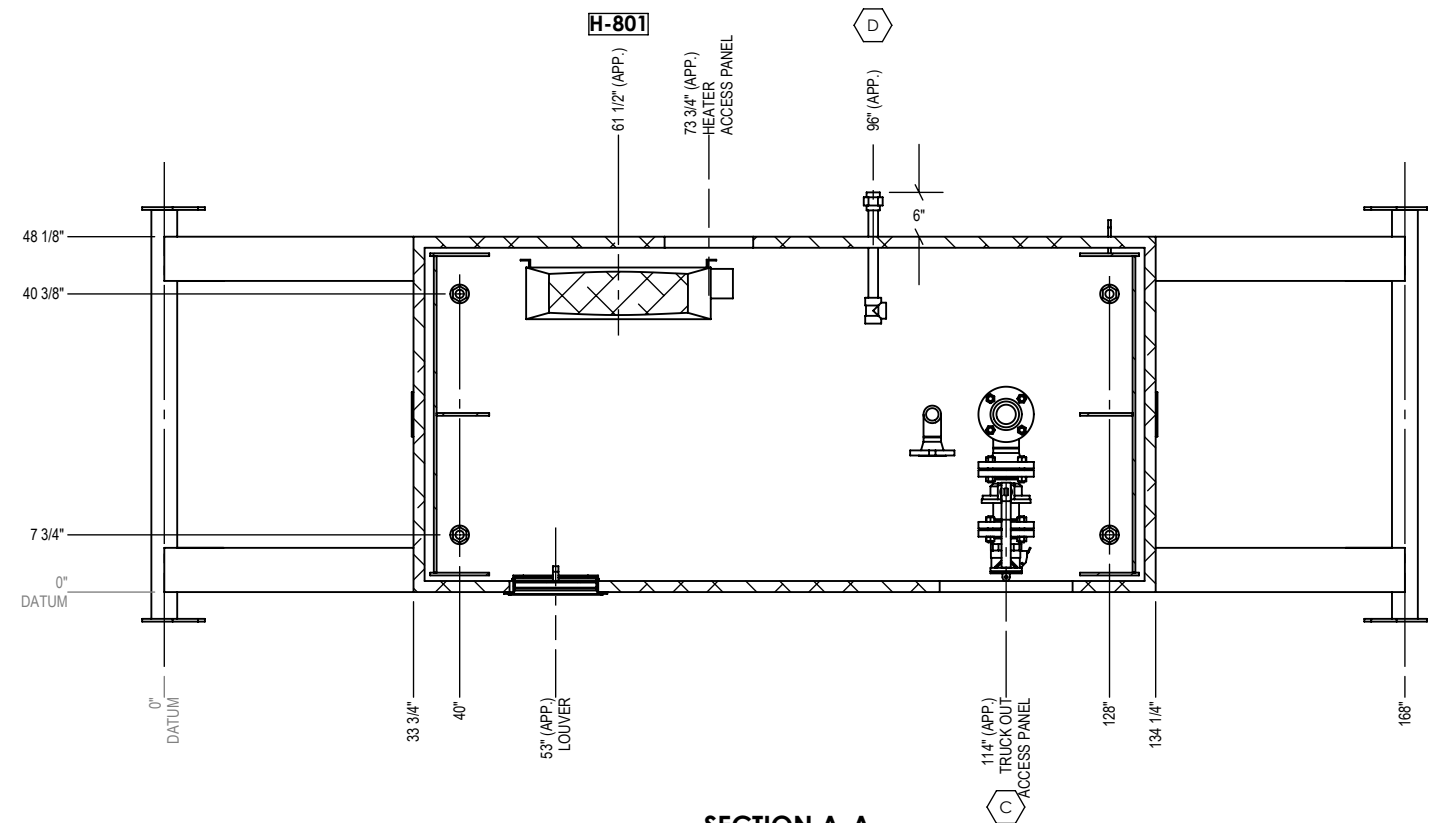

**SECTION A-A**

January 27, 2025 1:09:55 PM

**PACKAGE CONNECTION SCHEDULE**


TAG	SIZE	RATING	DESCRIPTION
A	6"	CL 150 RF	INLET
B	6"	CL 150 RF	OUTLET
C	3"	CL 150 RF	DRAIN / TRUCK OUT
D	1"	3M-NPT	FUEL GAS INLET



ISSUED FOR CONSTRUCTION  
PROCEED-NO CHANGES\_\_ AS NOTED\_\_

BY:\_\_\_\_\_ DATE:\_\_\_\_\_

CLIENT:		<p>925 - 23 Street SW., Medicine Hat, Alberta, T1A 8R1 TEL: (403) 526-3142 FAX: (403) 526-1061 Toll: (800) 215-9806</p>	
PROJECT:		48"ID X 10'-0" S/S X 50 PSIG FLARE KNOCKOUT PACKAGE	
TITLE:		LAYOUT	
WO No.:		DRAWN BY: J.REIMER	DRAWN DATE: 2024-07-16
SIZE: B	DRAWING No. STK131 LAYOUT	SHEET: 2 OF 5	SCALE: 1:26
REVISION:			0

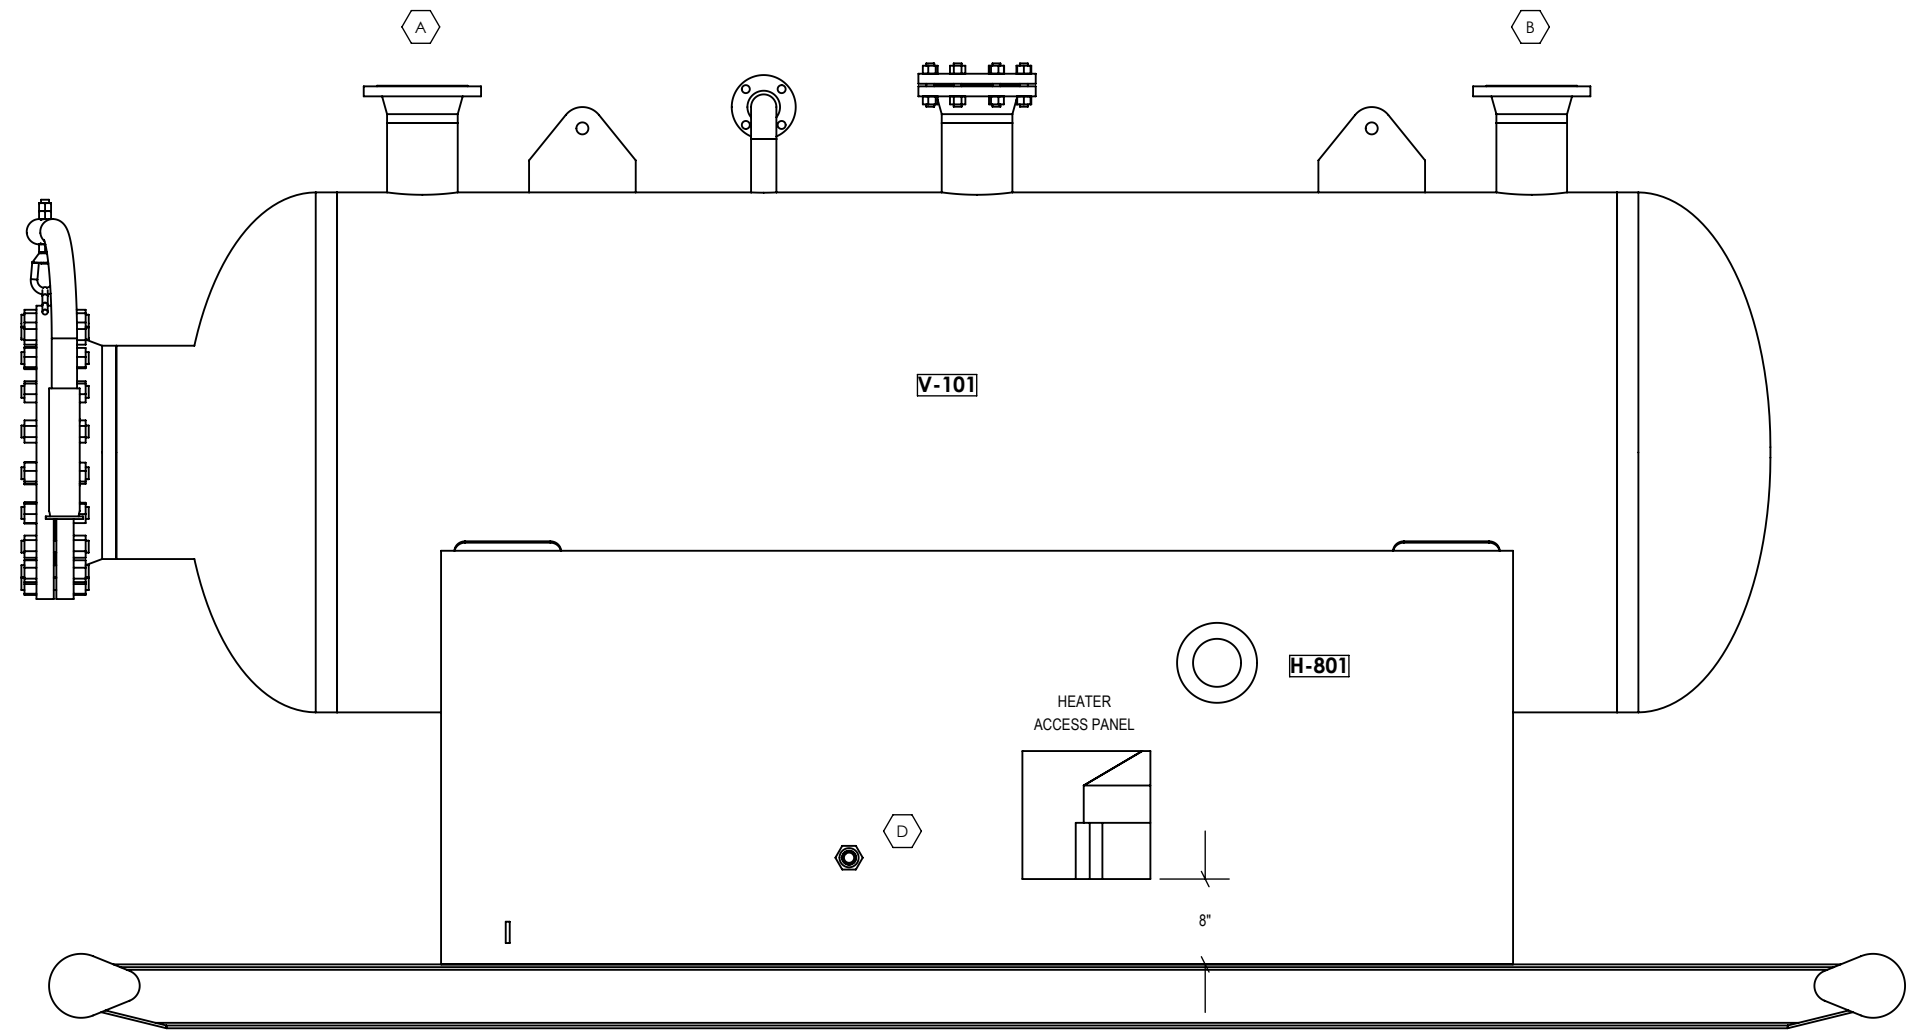


**BACK VIEW**




**ISSUED FOR CONSTRUCTION**  
PROCEED-NO CHANGES\_\_ AS NOTED\_\_  
BY:\_\_\_\_\_ DATE:\_\_\_\_\_


January 27, 2025 1:09:55 PM

CLIENT:		 925 - 23 Street SW., Medicine Hat, Alberta, T1A 8R1 TEL: (403) 526-3142 FAX: (403) 526-1061 Toll: (800) 215-9806	
PROJECT:		48"ID X 10'-0" S/S X 50 PSIG FLARE KNOCKOUT PACKAGE	
TITLE:		LAYOUT	
WO No.:		DRAWN BY: J.REIMER	
SIZE: B		DRAWN DATE: 2024-07-16	
DRAWING No. STK131 LAYOUT		SHEET: 3 OF 5	
		SCALE: 1:18	
		REVISION: 0	

**NOTE:**  
ELEVATION MEASUREMENTS TO BOTTOM OF PIPE

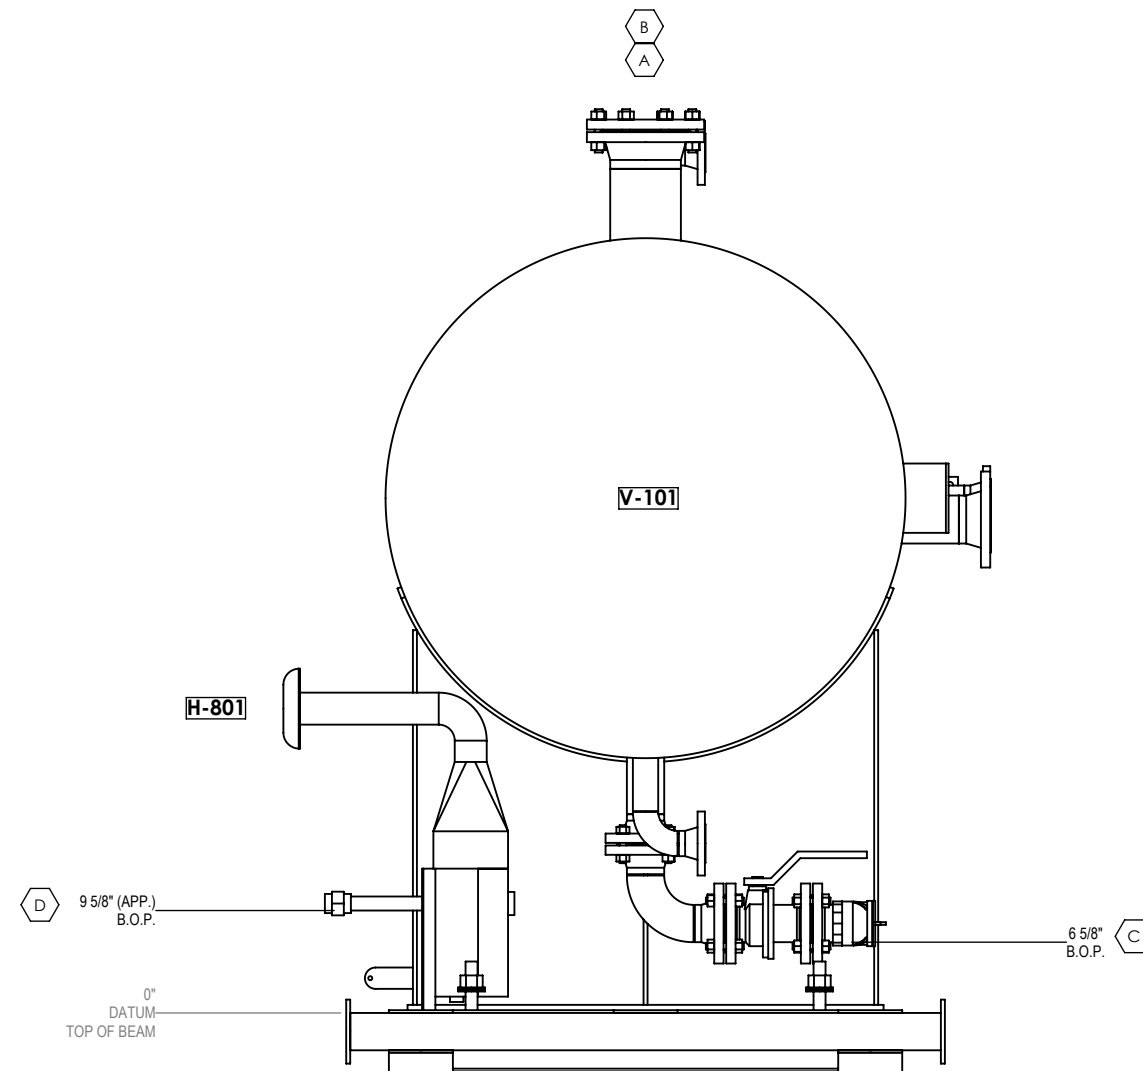

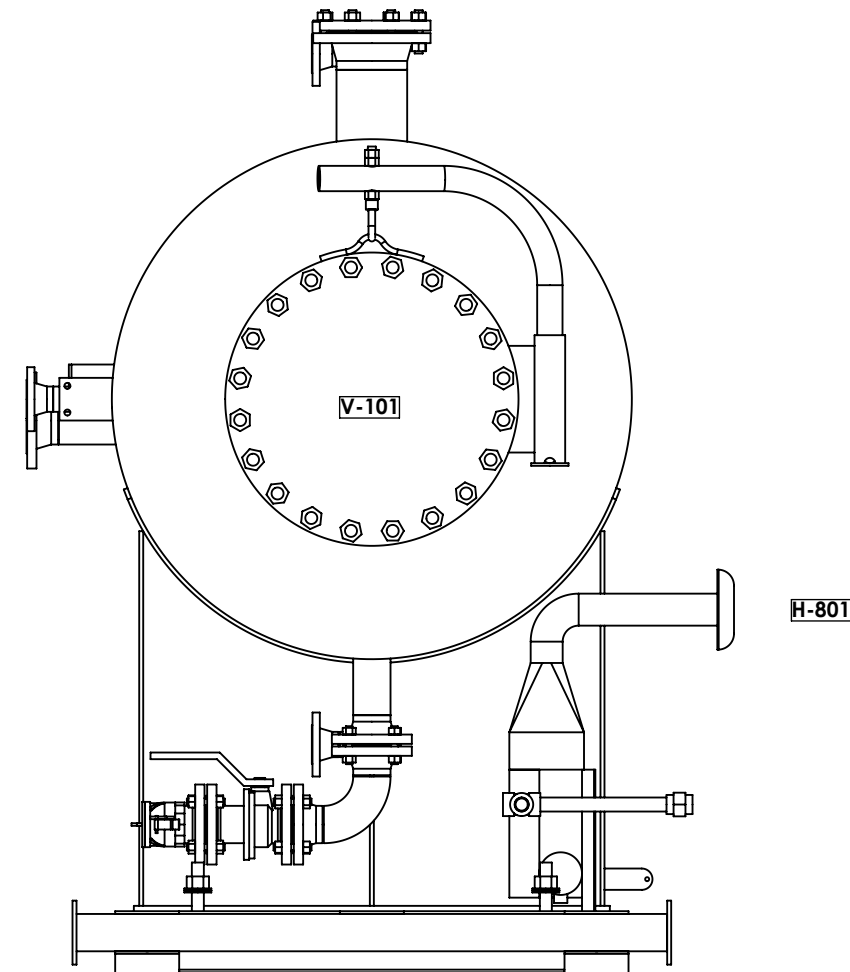

**LEFT SIDE VIEW**  
\*\*\*BUILDING & SADDLE HIDDEN FOR CLARITY\*\*\*




**RIGHT SIDE VIEW**  
\*\*\*BUILDING & SADDLE HIDDEN FOR CLARITY\*\*\*



January 27, 2025 1:09:55 PM

CLIENT:		 925 - 23 Street SW., Medicine Hat, Alberta, T1A 8R1 TEL: (403) 526-3142 FAX: (403) 526-1061 Toll: (800) 215-9806	
PROJECT: 48"ID X 10'-0" S/S X 50 PSIG FLARE KNOCKOUT PACKAGE			
TITLE: LAYOUT			
WO No.:		DRAWN DATE: 2024-07-16	
SIZE: B	LINE No.: -	DRAWN BY: J.REIMER	YYY/YY/MM/DD SHEET: 4 OF 5 SCALE: 1:18
DRAWING No. STK131 LAYOUT		REVISION:  0	



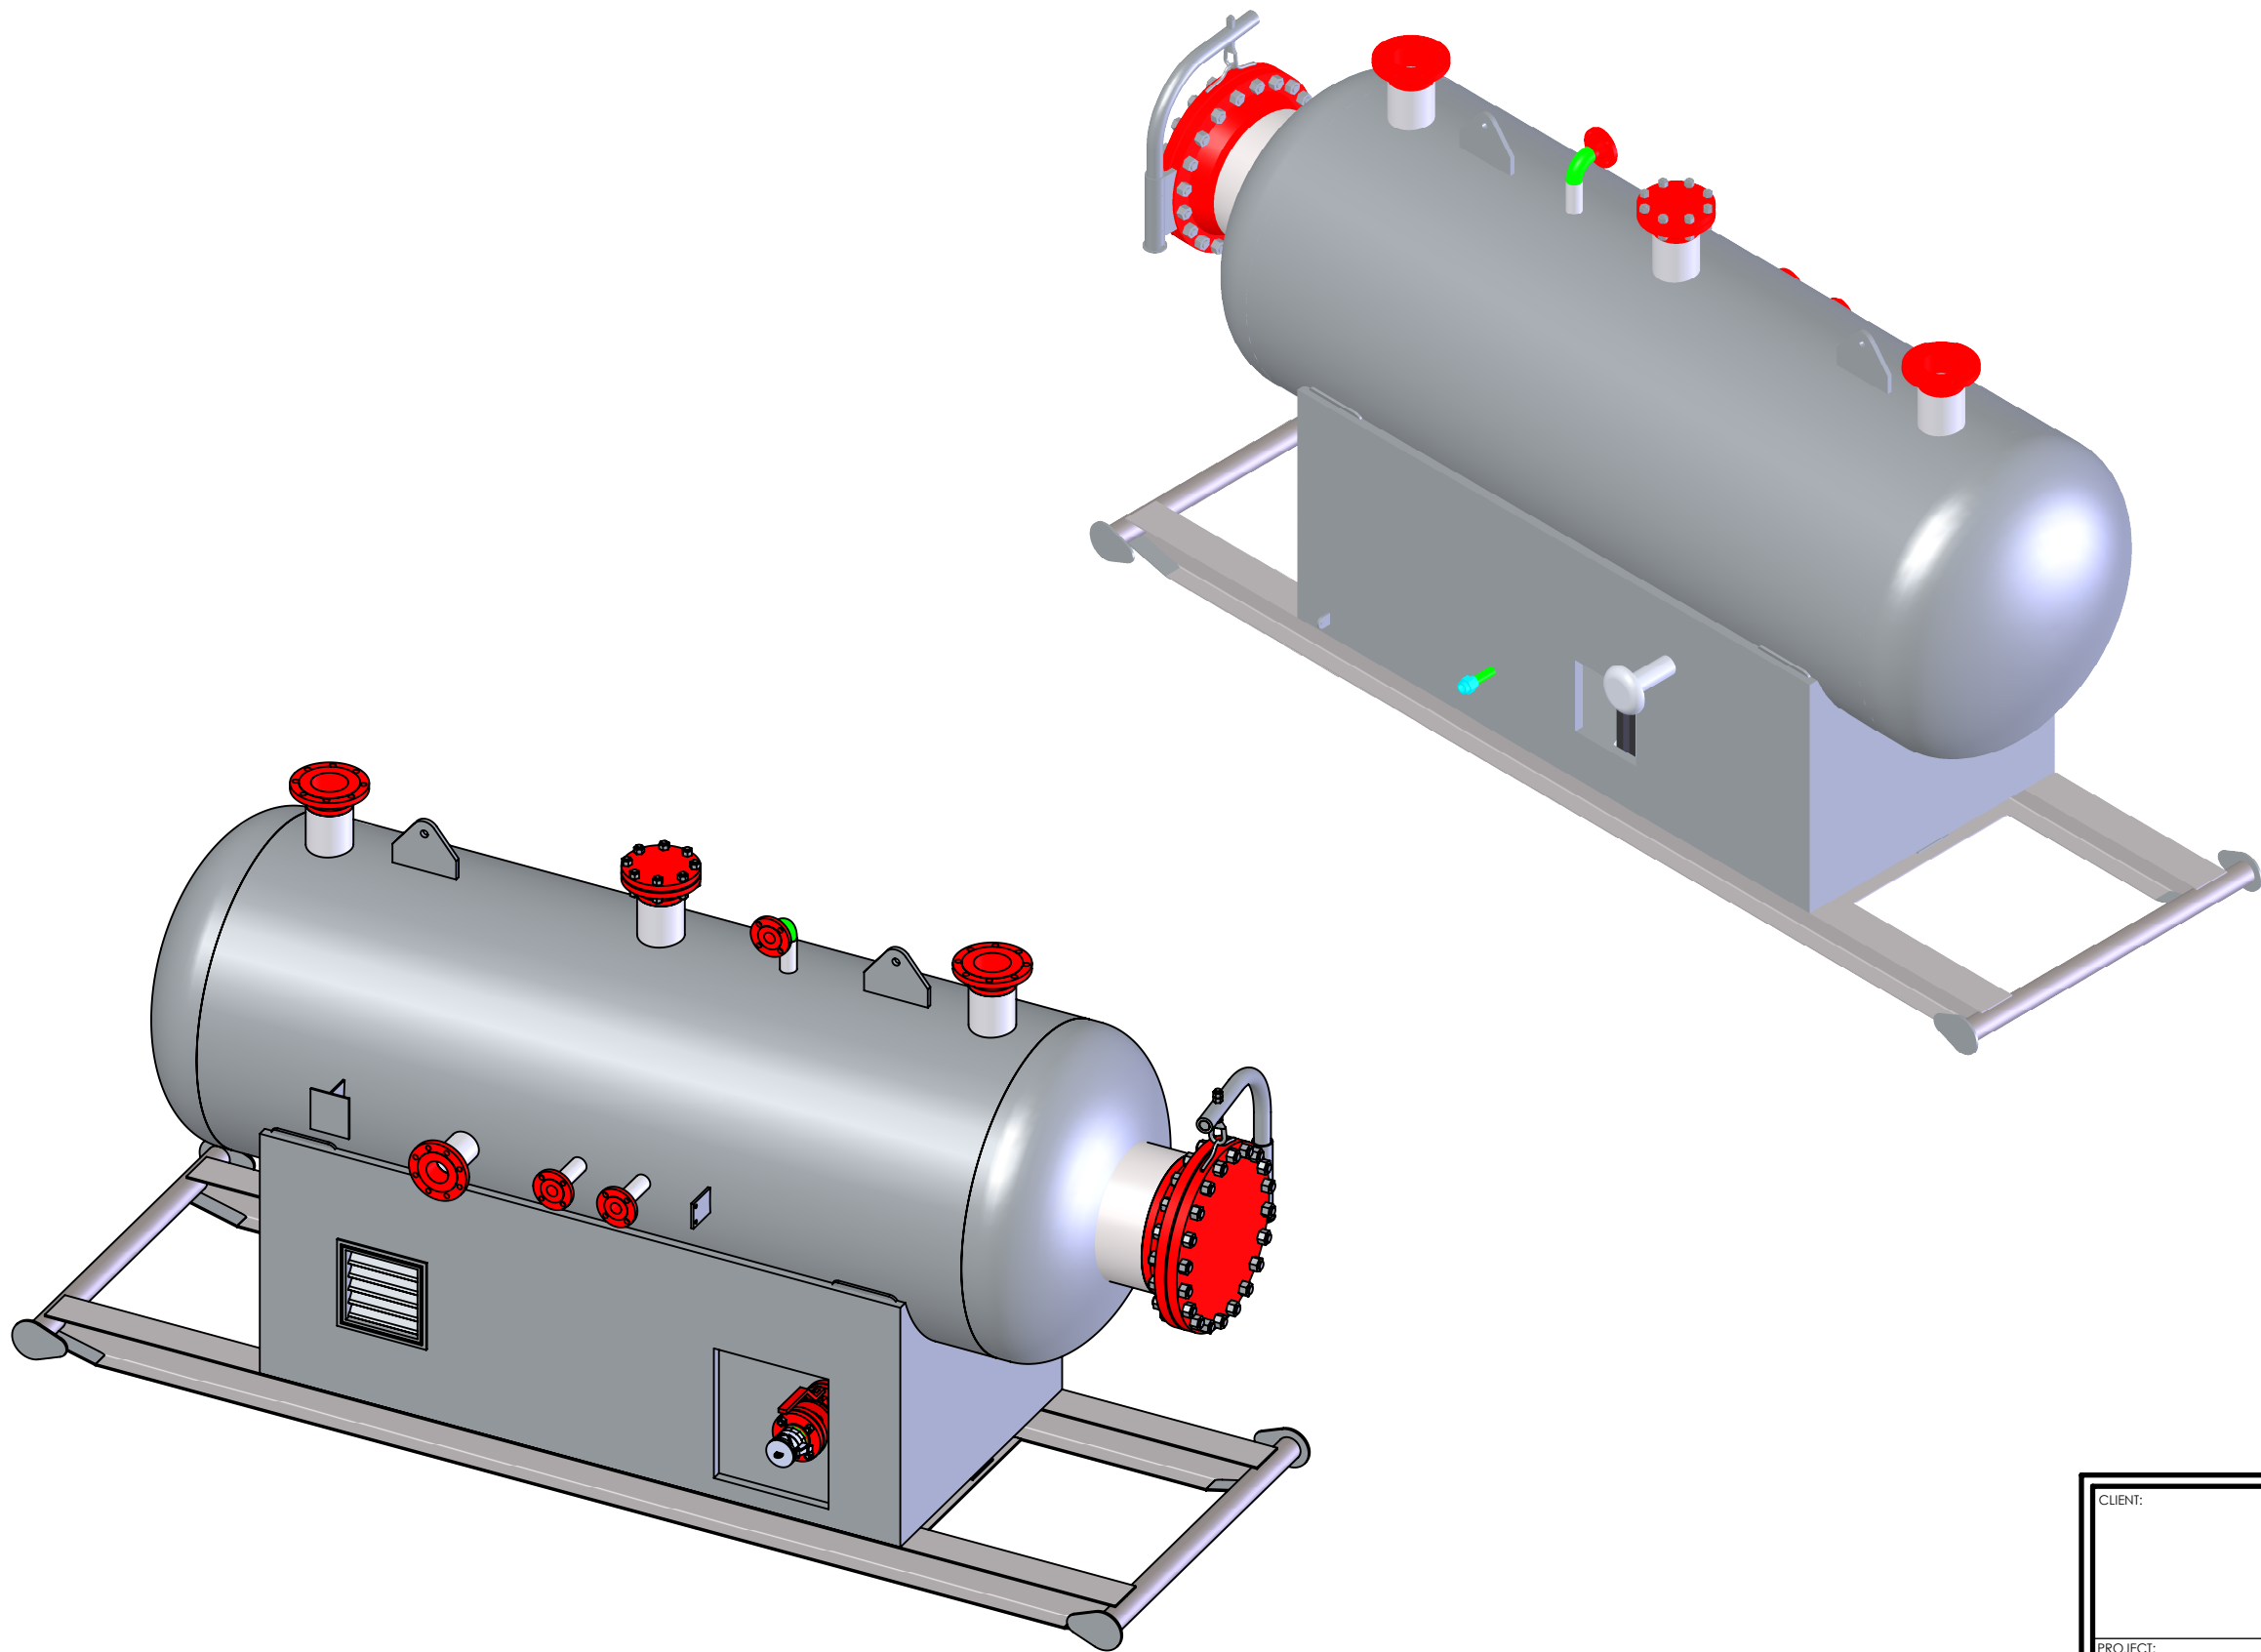




ISSUED FOR CONSTRUCTION  
PROCEED-NO CHANGES\_\_AS NOTED\_\_  
BY: \_\_\_\_\_ DATE: \_\_\_\_\_

January 27, 2025 1:09:55 PM

CLIENT:		 925 - 23 Street SW., Medicine Hat, Alberta, T1A 8R1 TEL: (403) 526-3142 FAX: (403) 526-1061 Toll: (800) 215-9806	
PROJECT:		48"ID X 10'-0" S/S X 50 PSIG FLARE KNOCKOUT PACKAGE	
TITLE:		LAYOUT	
WO No.:		REVISION:	
SIZE: B	LINE No.: -	DRAWN BY: J.REIMER	DRAWN DATE: 2024-07-16
DRAWING No. STK131 LAYOUT		SHEET: 5 OF 5	SCALE: 1:26

