

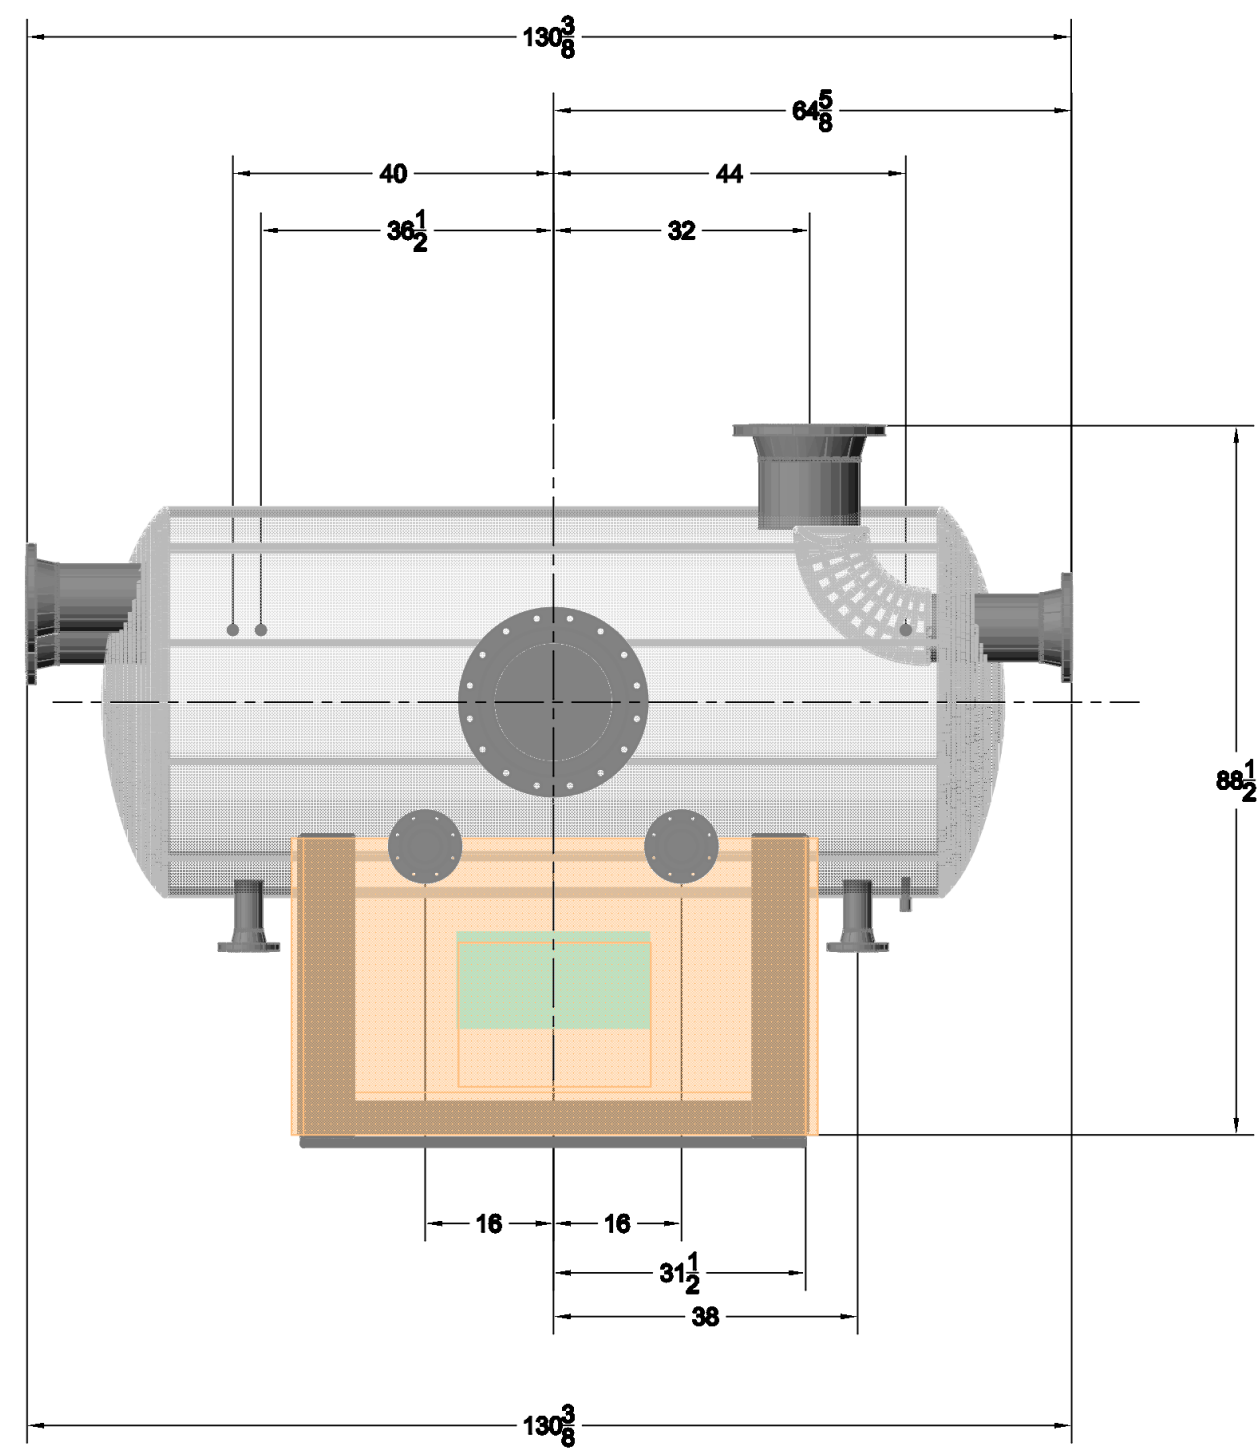


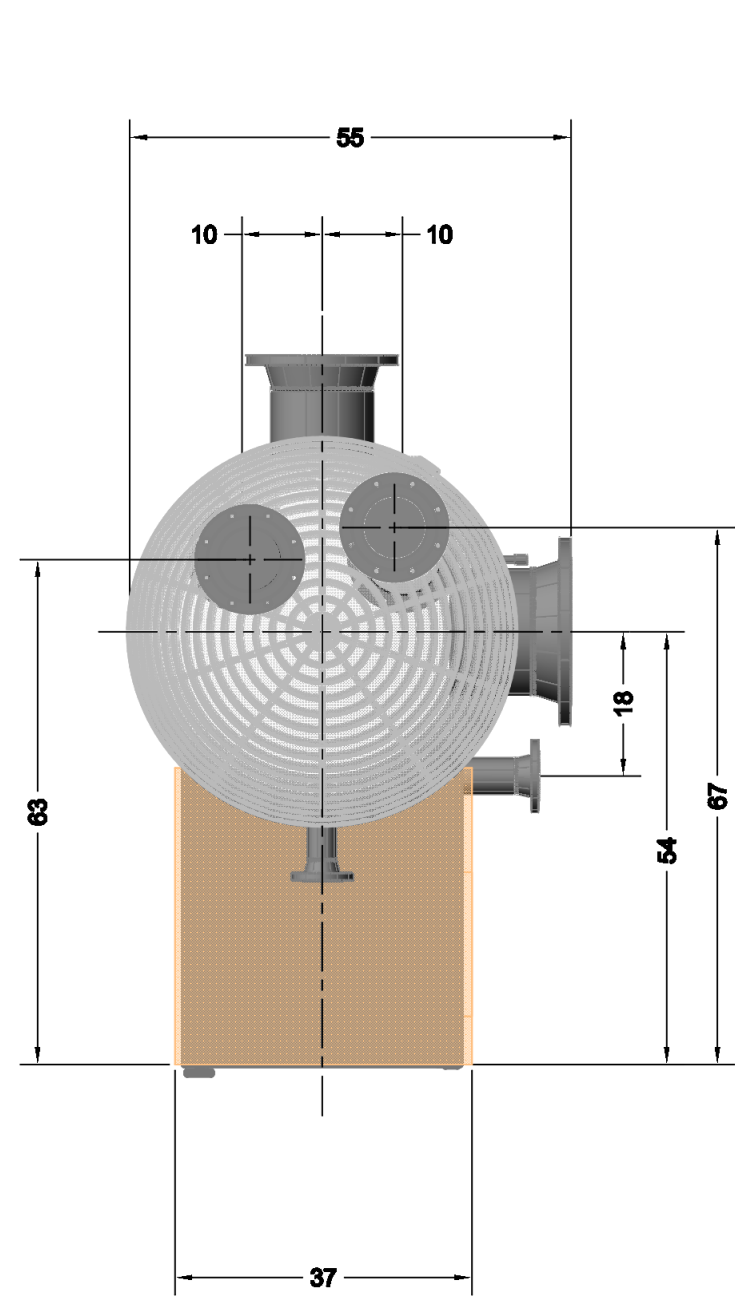

NOTES:
- ADD 4" CHANNEL TO SUPPORT INSULATED PANELS
- ADD INSULATED SANDWICH PANELS TO VESSEL UNDERSIDE
- ADD 12 X 24, 12V CATADYNE IN INSULATED ENCLOSURE.

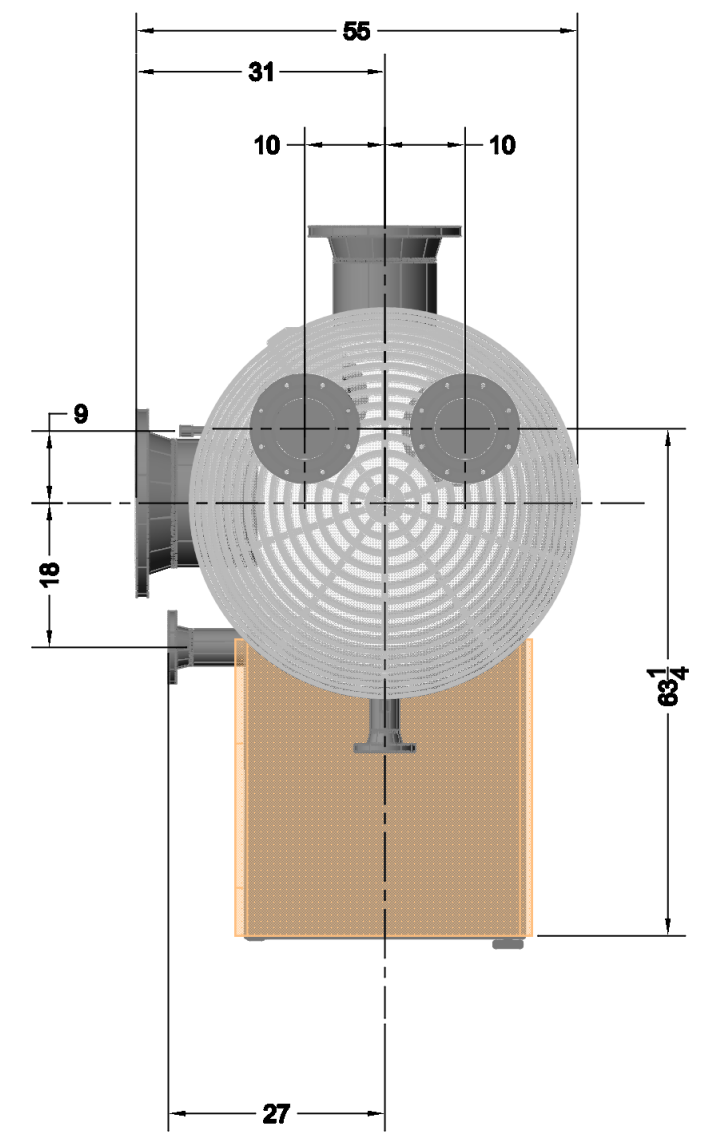

				RARE OILFIELD SERVICES 502 MITCHELL DRIVE SE REDCLIFF, ALBERTA, T0J 2P0		RARE EQUIPMENT # 16218 - SLUDGE CATCHER		DRAWING TITLE 16044 - SLUDGE CATCHER ORIGINAL BUILD BY MALONEY STEEL GENERAL ARRANGEMENT SHEET 1 OF 3		FILE NAME 16218 25BBL SLUG CATCHER AS BUILT	
						DATE JULY 6, 2026		DRAWN BY K HOBMAN		LAYOUT NAME SHT 1	
REV				DESC		BY		DATE		REVISION A	
				REVISIONS						REVISION DATE	