
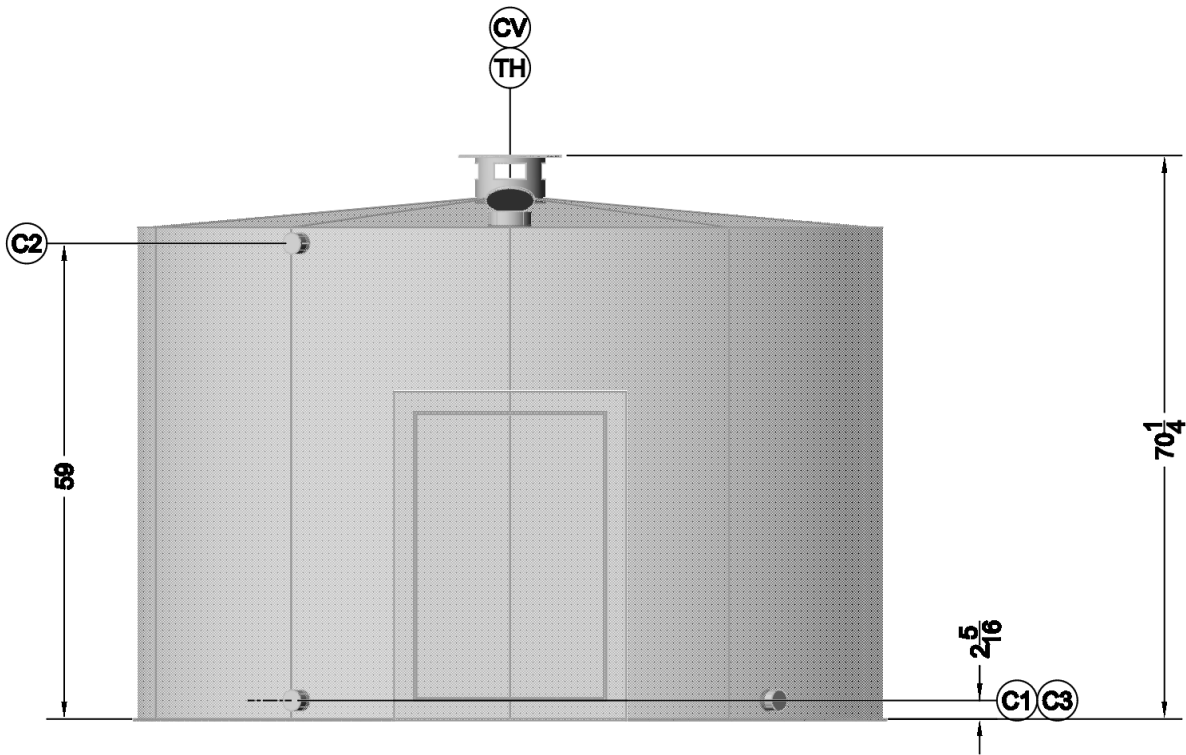


TAG	SIZE	TYPE	CONNECTION
C1	2"	3000# HC	PUMP OUT
C2	2"	3000# HC	SPARE
C3	2"	3000# HC	HIGH LEVEL
TH	4"	NOT API	FLAPPER CLOSURE
CV	8"	NOT API	CENTER VENT
MW		STANDARD	MANWAY

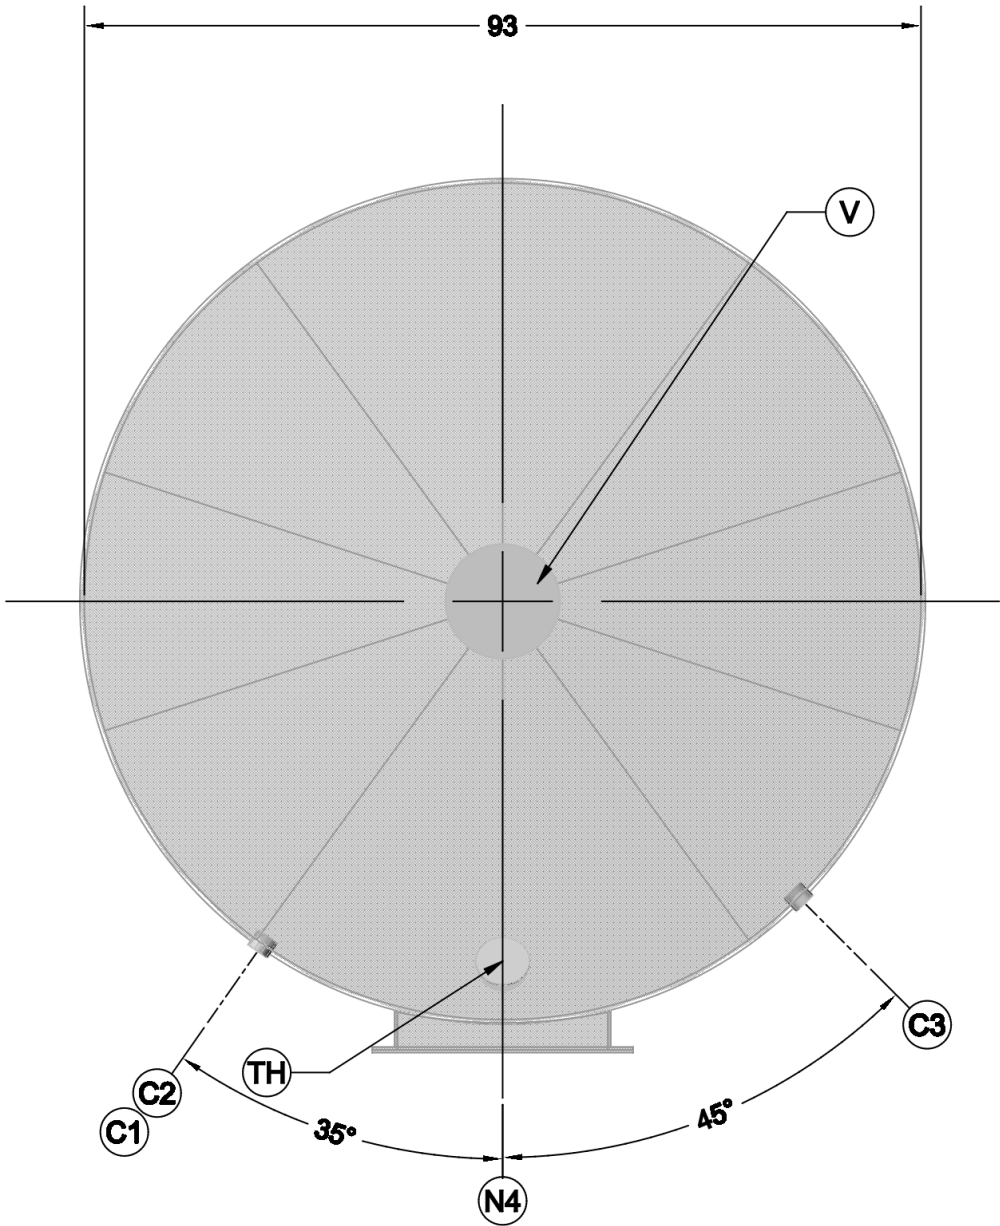

				 RARE OILFIELD SERVICES 502 MITCHELL DRIVE SE REDCLIFF, ALBERTA, T0J 2P0	RARE EQUIPMENT # 16220 - 40 BBL TANK BY DAPAJ0		DRAWING TITLE 16220 - 40BBL TANK GENERAL ARRANGMENT SHT 1 OF 2	FILE NAME 16220 40 BBL TANK AS BUILT		
REV	DESC		BY		DATE	DATE Oct 13, 2026		DRAWN BY K HOBMAN	LAYOUT NAME SHT 1	
REVISIONS								REVISION A		REVISION DATE