


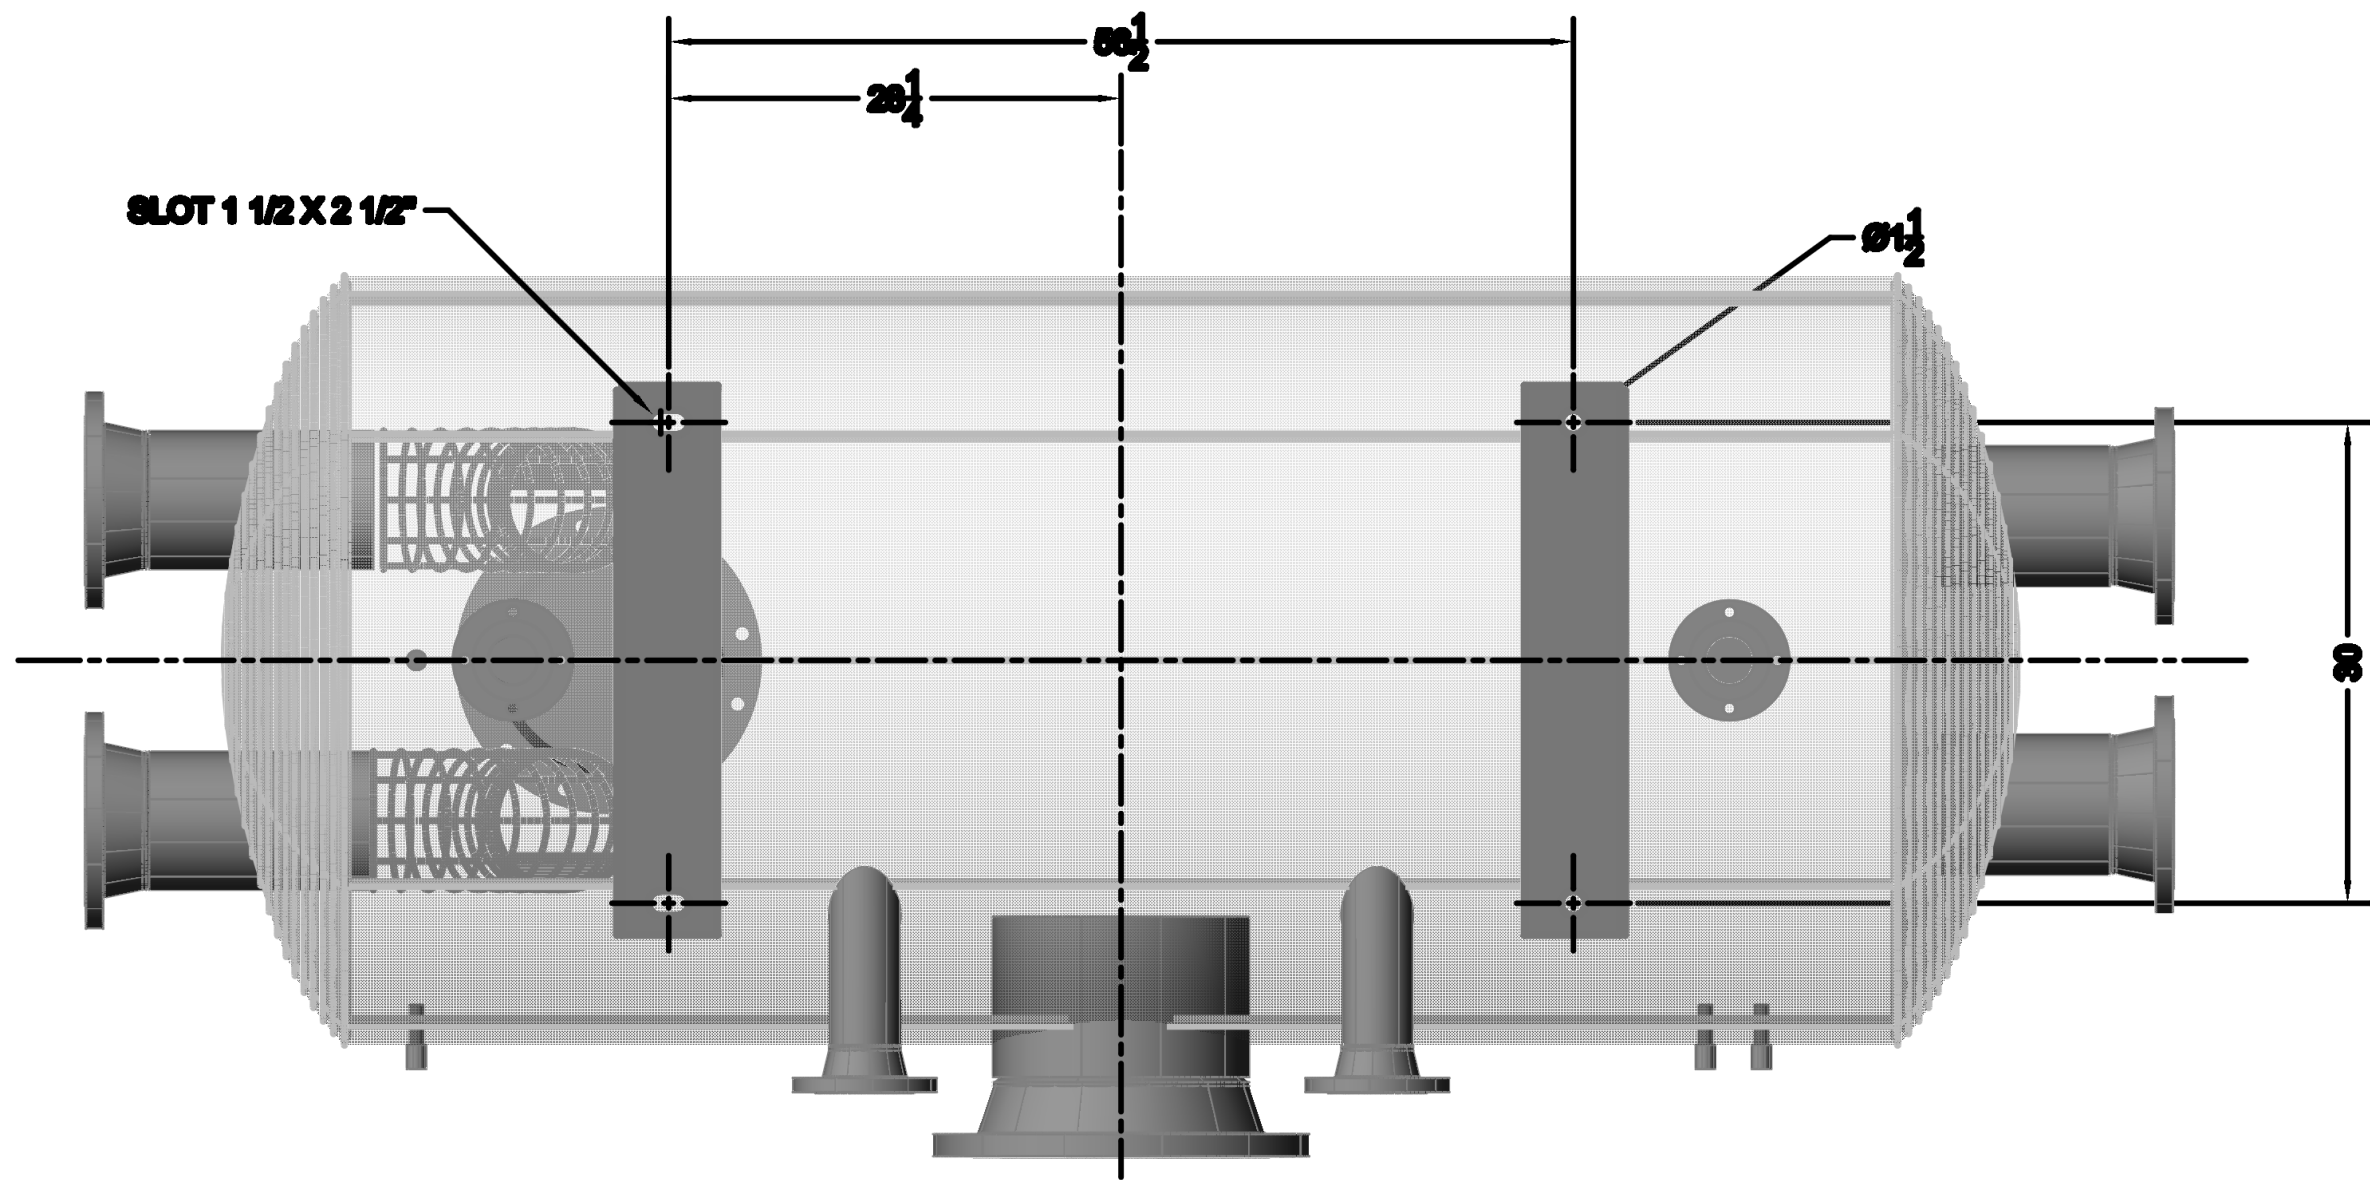

BOTTOM VIEW

				RARE OILFIELD SERVICES 502 MITCHELL DRIVE SE REDCLIFF, ALBERTA, T0J 2P0	RARE EQUIPMENT # 16218 - SLIDGE CATCHER		DRAWING TITLE 16044 - SLUDGE CATCHER ORIGINAL BUILD BY MALONEY STEEL GENERAL ARRANGEMENT SHEET 3 OF 3	FILE NAME 16218 25BBL SLUG CATCHER AS BUILT		
								LAYOUT NAME SHT 3		
REV	DESC	BY	DATE		DATE JULY 6, 2026	DRAWN BY K HOBMAN		REVISION A	REVISION DATE	
REVISIONS										