



AS BUILT




ISSUED FOR CONSTRUCTION
PROCEED-NO CHANGES__ AS NOTED __
BY: _____ DATE: _____

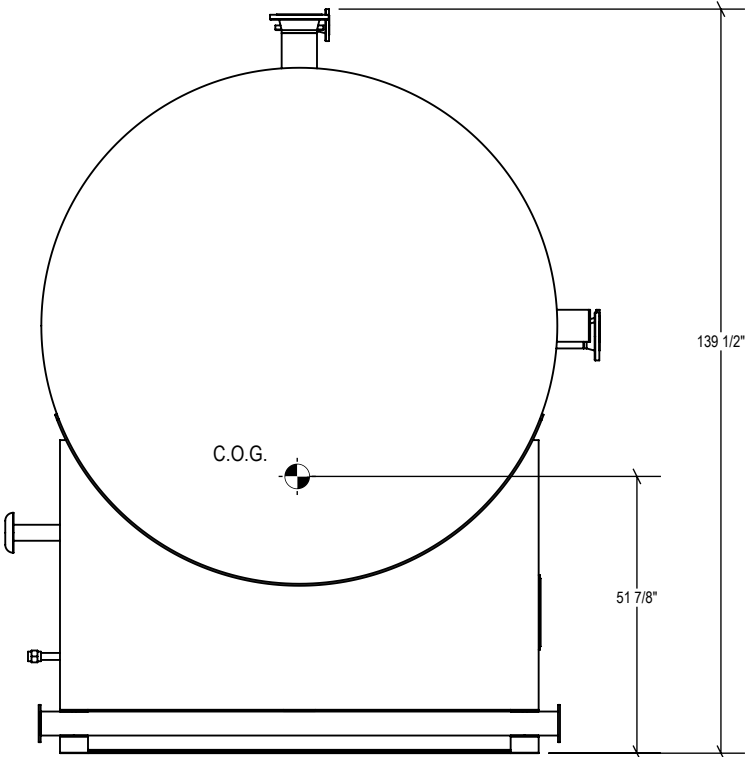

LEFT VIEW

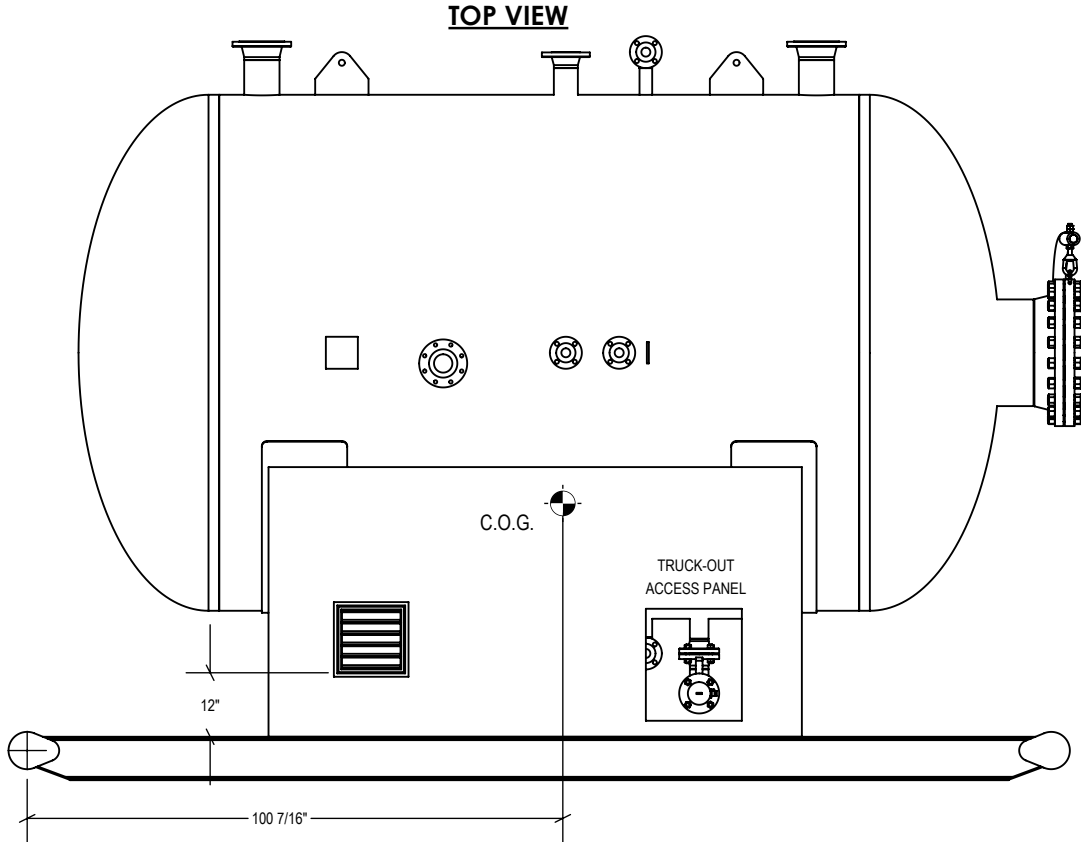

FRONT VIEW

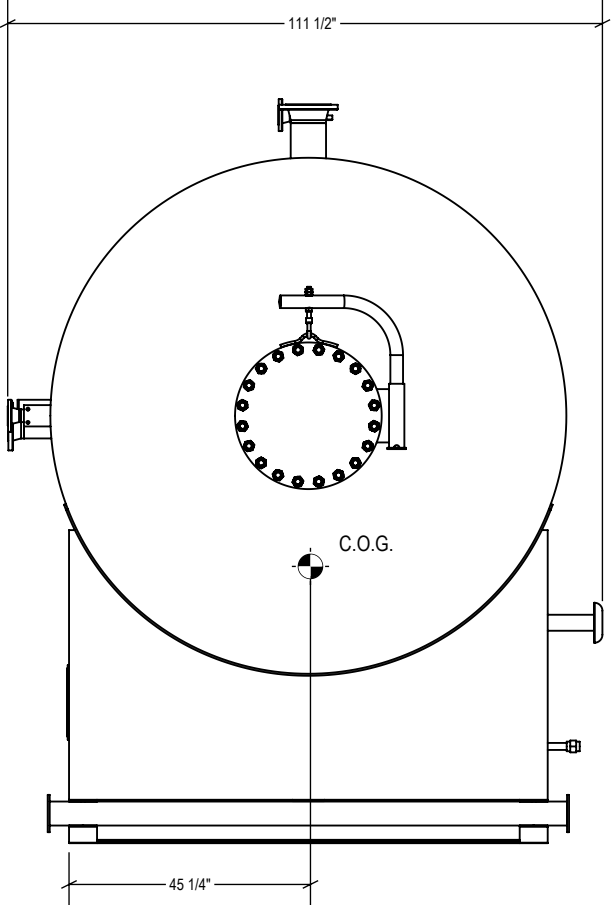

RIGHT VIEW

NOTES:

1.

SHIPPING DIMENSIONS: 9'-4"W X 16'-10"L X 11'-8" H
2.

SHIPPING WEIGHT: APPROXIMATELY 15,000 LBS
3.

PAINTING: (SKID, SPOOL)
SURFACE PREPARATION: SSPC-SP-3
PRIMER: CLOVERDALE SHOP COAT T-101 AS PER MANUFACTURER'S SPECIFICATIONS
PAINT: CLOVERDALE INDUSTRIAL ENAMEL AS PER MANUFACTURER'S SPECIFICATIONS
COLOR: WARM GREY F-34 (#74021)
4.


INTERNAL COATING: (VESSEL, SPOOL)
INTERNAL PREPARATION: SSPC-SP-5
COATING: DEVOE 253 AS PER MANUFACTURER'S SPECIFICATION
5.

INSULATION: 1 1/2" BLACK SPRAY FOAM

January 27, 2025 2:03:37 PM

0	2024/07/17	ISSUED FOR CONSTRUCTION	JMR	MC	PA/AS
REV. No.	DATE YYYY/MM/DD	DESCRIPTION	REV. BY	CHK'D BY	APPR BY

CLIENT:



925 - 23 Street SW., Medicine Hat, Alberta, T1A 8R1
TEL: (403) 526-3142 FAX: (403) 526-1061 Toll: (800) 215-9806

PROJECT:

96"ID X 10'-0" S/S X 50 PSIG
FLARE KNOCKOUT PACKAGE

TITLE:

LAYOUT

WO No.:

DRAWN BY: J.REIMER

DRAWING No. STK133 LAYOUT

REVISION:

0

SCALE:


1:36

DATE:


2024-07-16

SHEET:

1 OF 5

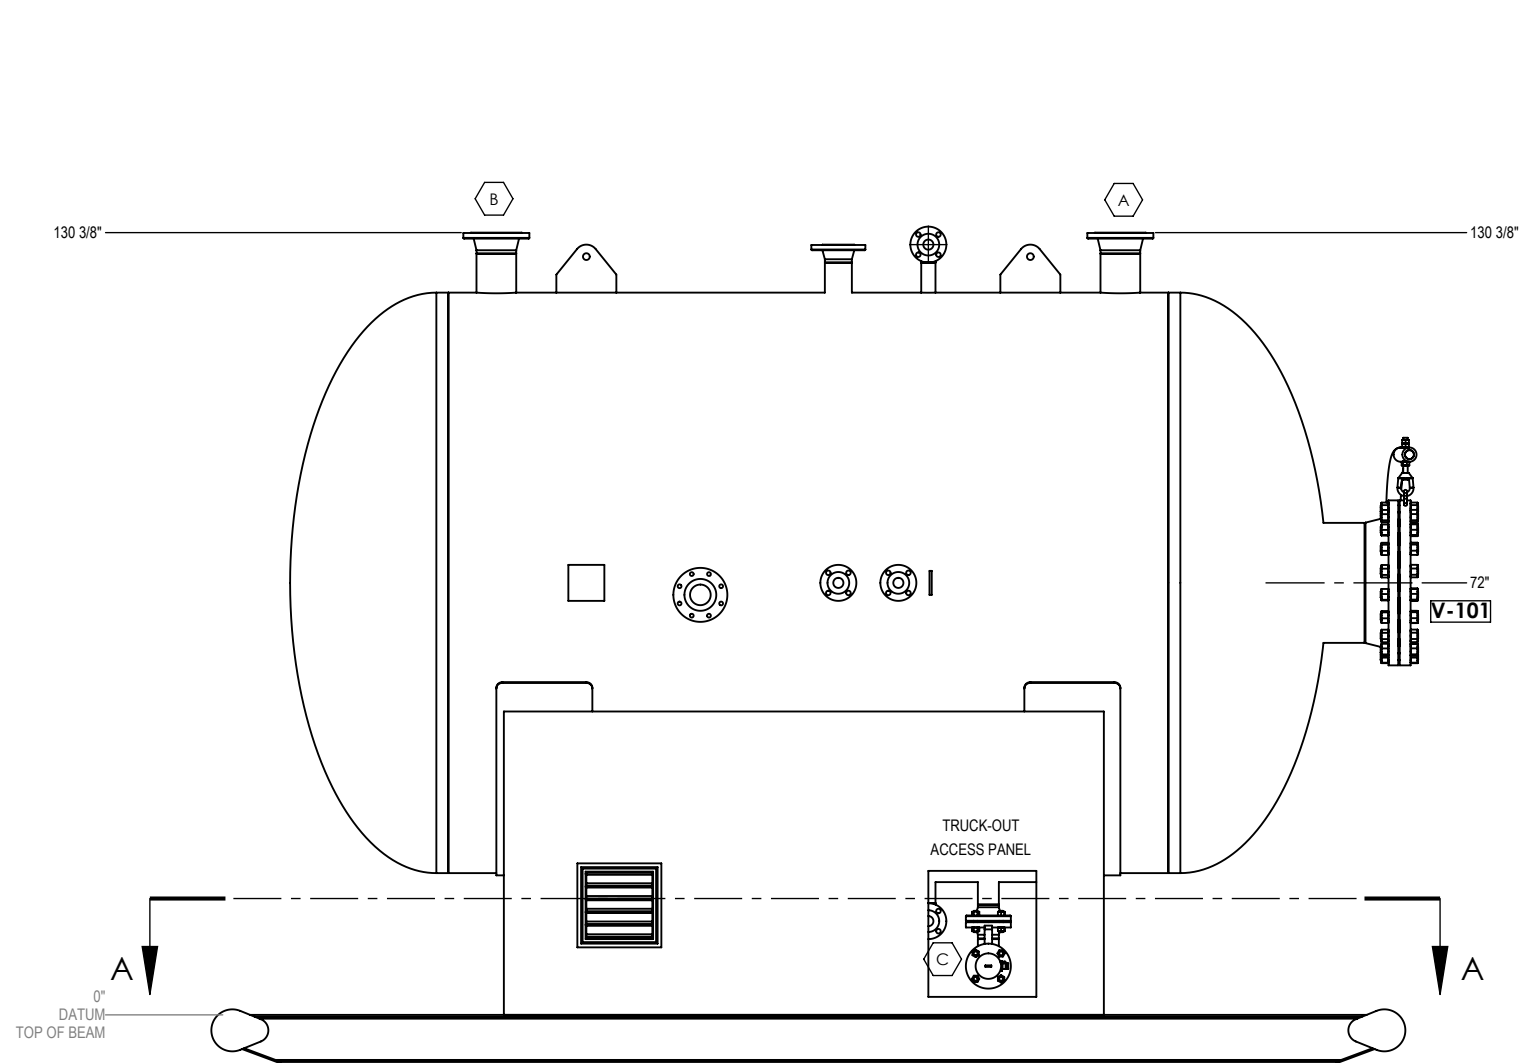

FRONT VIEW

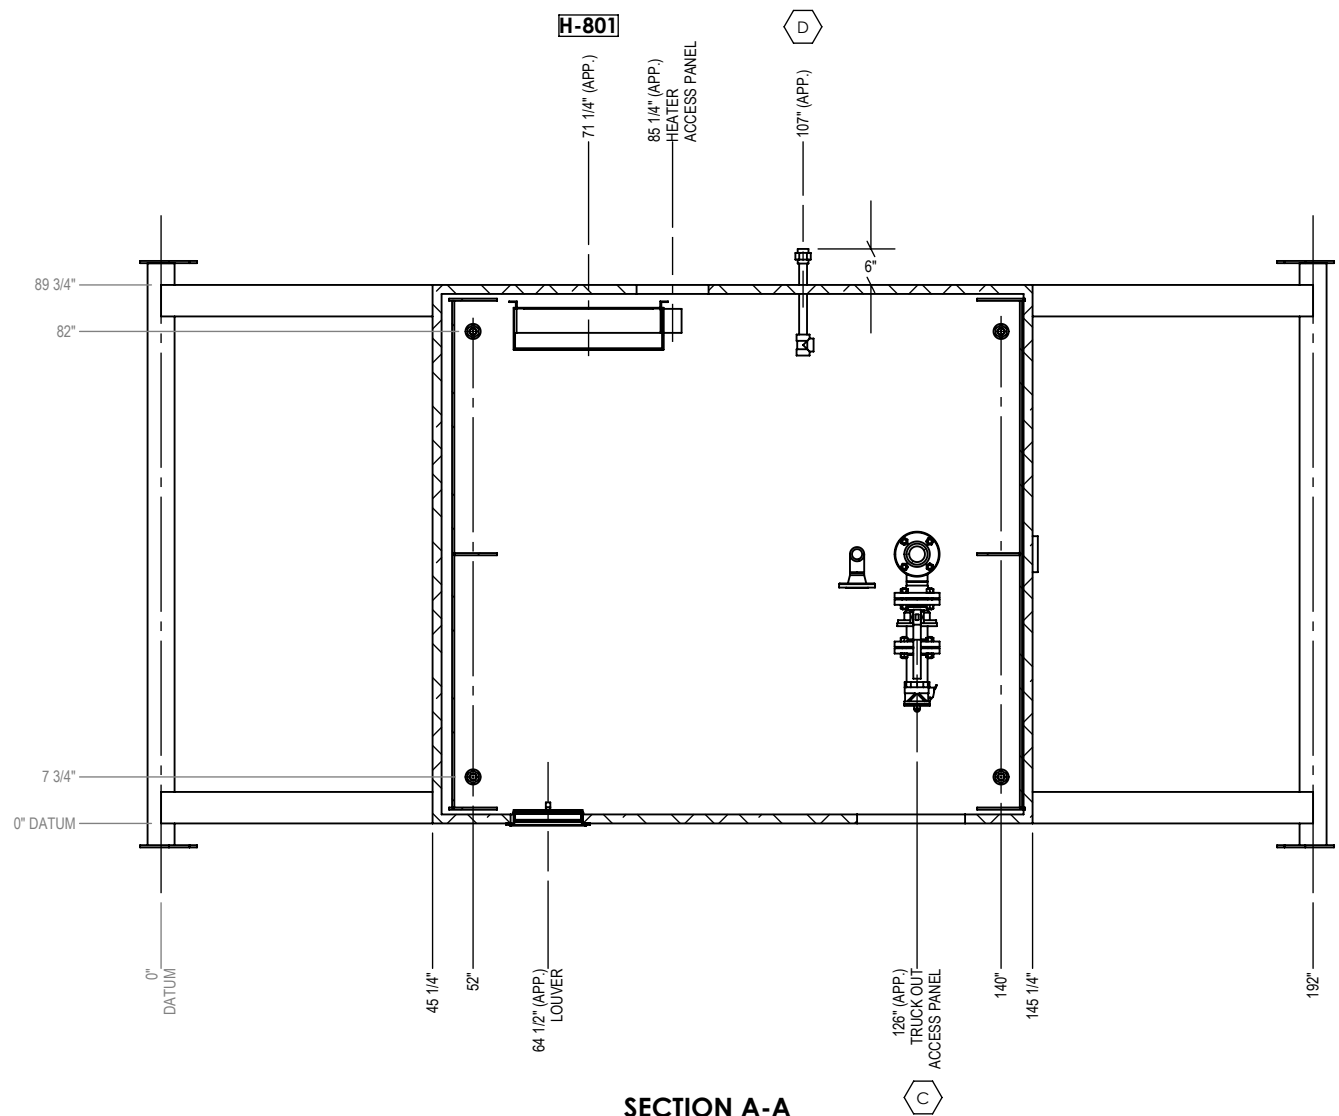

SECTION A-A

January 27, 2025 2:03:37 PM


PACKAGE CONNECTION SCHEDULE			
TAG	SIZE	RATING	DESCRIPTION
A	6"	CL 150 RF	INLET
B	6"	CL 150 RF	OUTLET
C	3"	CL 150 RF	DRAIN / TRUCK OUT
D	1"	3M-NPT	FUEL GAS INLET

AS BUILT

ARGO
SALES LP

ISSUED FOR CONSTRUCTION
PROCEED-NO CHANGES__AS NOTED__
BY:_____DATE:_____

CLIENT:		<p>925 - 23 Street SW., Medicine Hat, Alberta, T1A 8R1 TEL: (403) 526-3142 FAX: (403) 526-1061 Toll: (800) 215-9806</p>	
PROJECT:		96"ID X 10'-0" S/S X 50 PSIG FLARE KNOCKOUT PACKAGE	
TITLE:		LAYOUT	
WO No.:		DRAWN BY: J.REIMER	DRAWN DATE: 2024-07-16
SIZE: B	DRAWING No. STK133 LAYOUT	SHEET: 2 OF 5	SCALE: 1:32
REVISION:			0

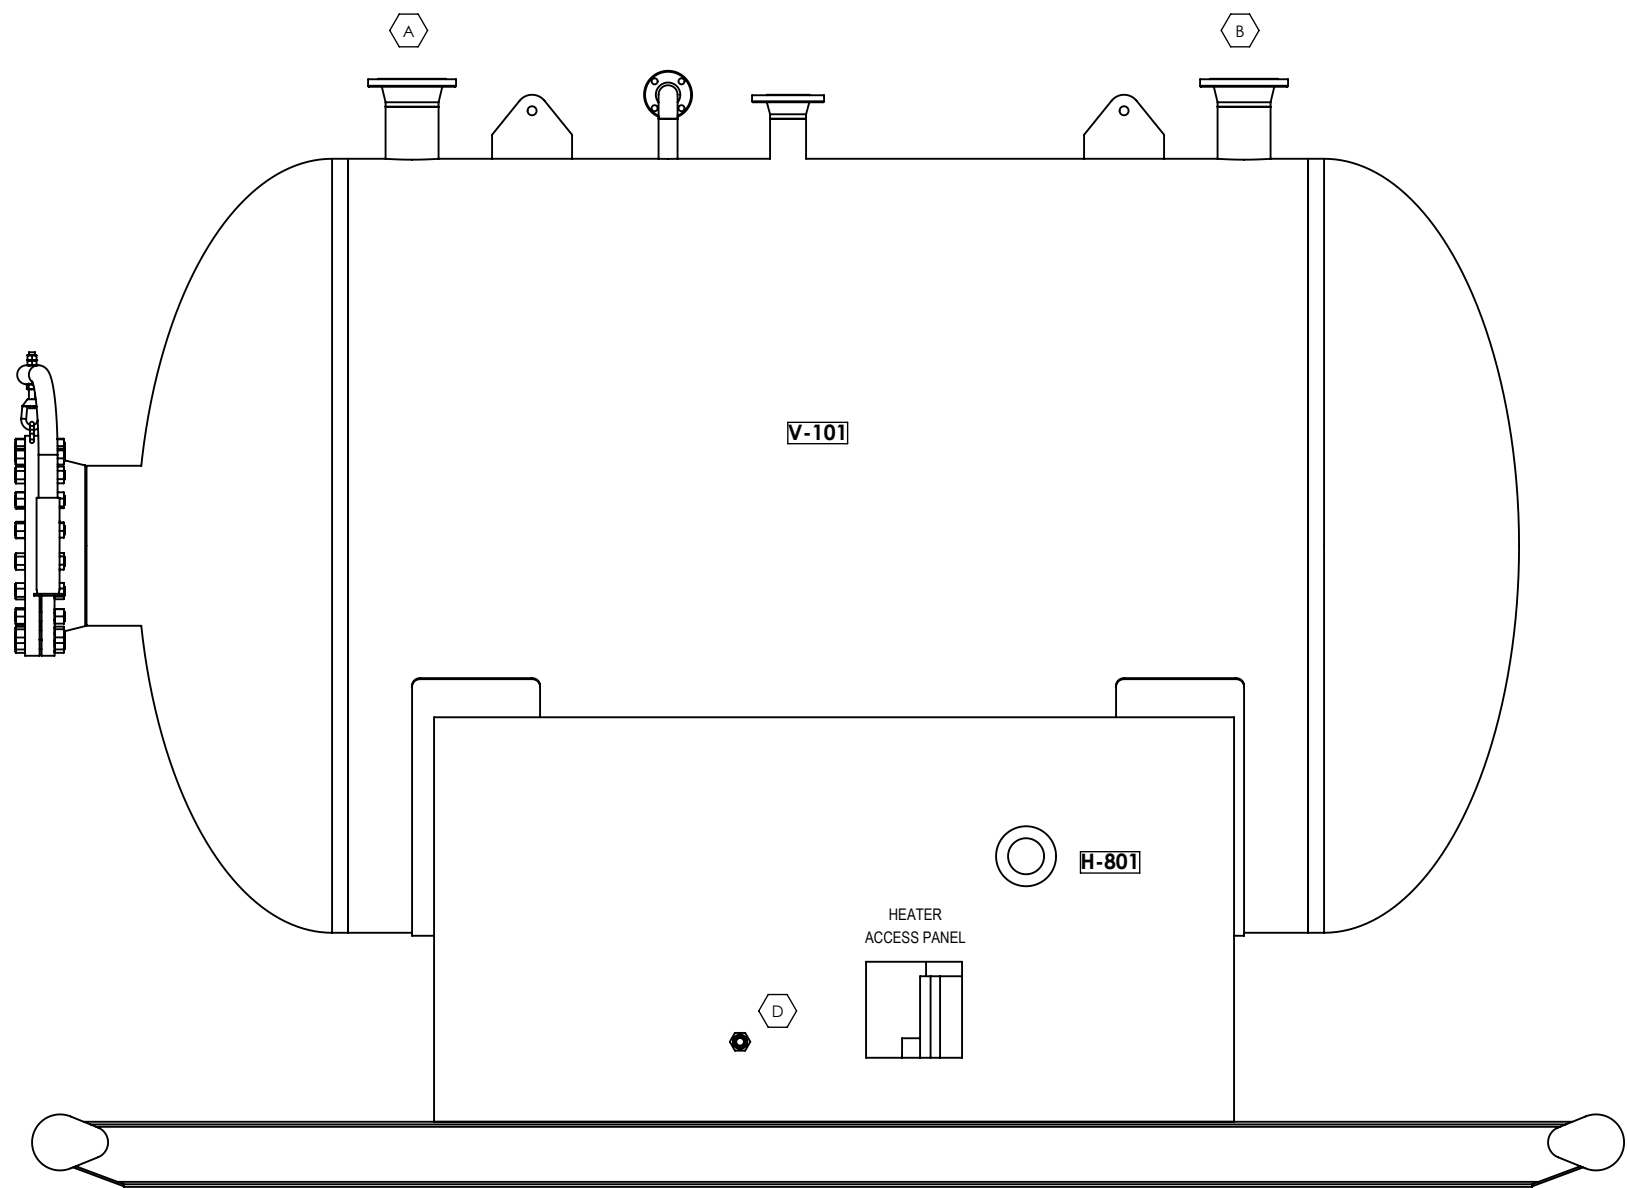



BACK VIEW

AS BUILT




ISSUED FOR CONSTRUCTION
PROCEED-NO CHANGES__ AS NOTED__
BY:_____ DATE:_____


January 27, 2025 2:03:37 PM

CLIENT:		 925 - 23 Street SW., Medicine Hat, Alberta, T1A 8R1 TEL: (403) 526-3142 FAX: (403) 526-1061 Toll: (800) 215-9806	
PROJECT:		96"ID X 10'-0" S/S X 50 PSIG FLARE KNOCKOUT PACKAGE	
TITLE:		LAYOUT	
WO No.:		REVISION:	
SIZE: B	DRAWN BY: J.REIMER	DRAWN DATE: 2024-07-16	
DRAWING No. STK133 LAYOUT		SHEET: 3 OF 5 SCALE: 1:24	

NOTE:
ELEVATION MEASUREMENTS TO BOTTOM OF PIPE

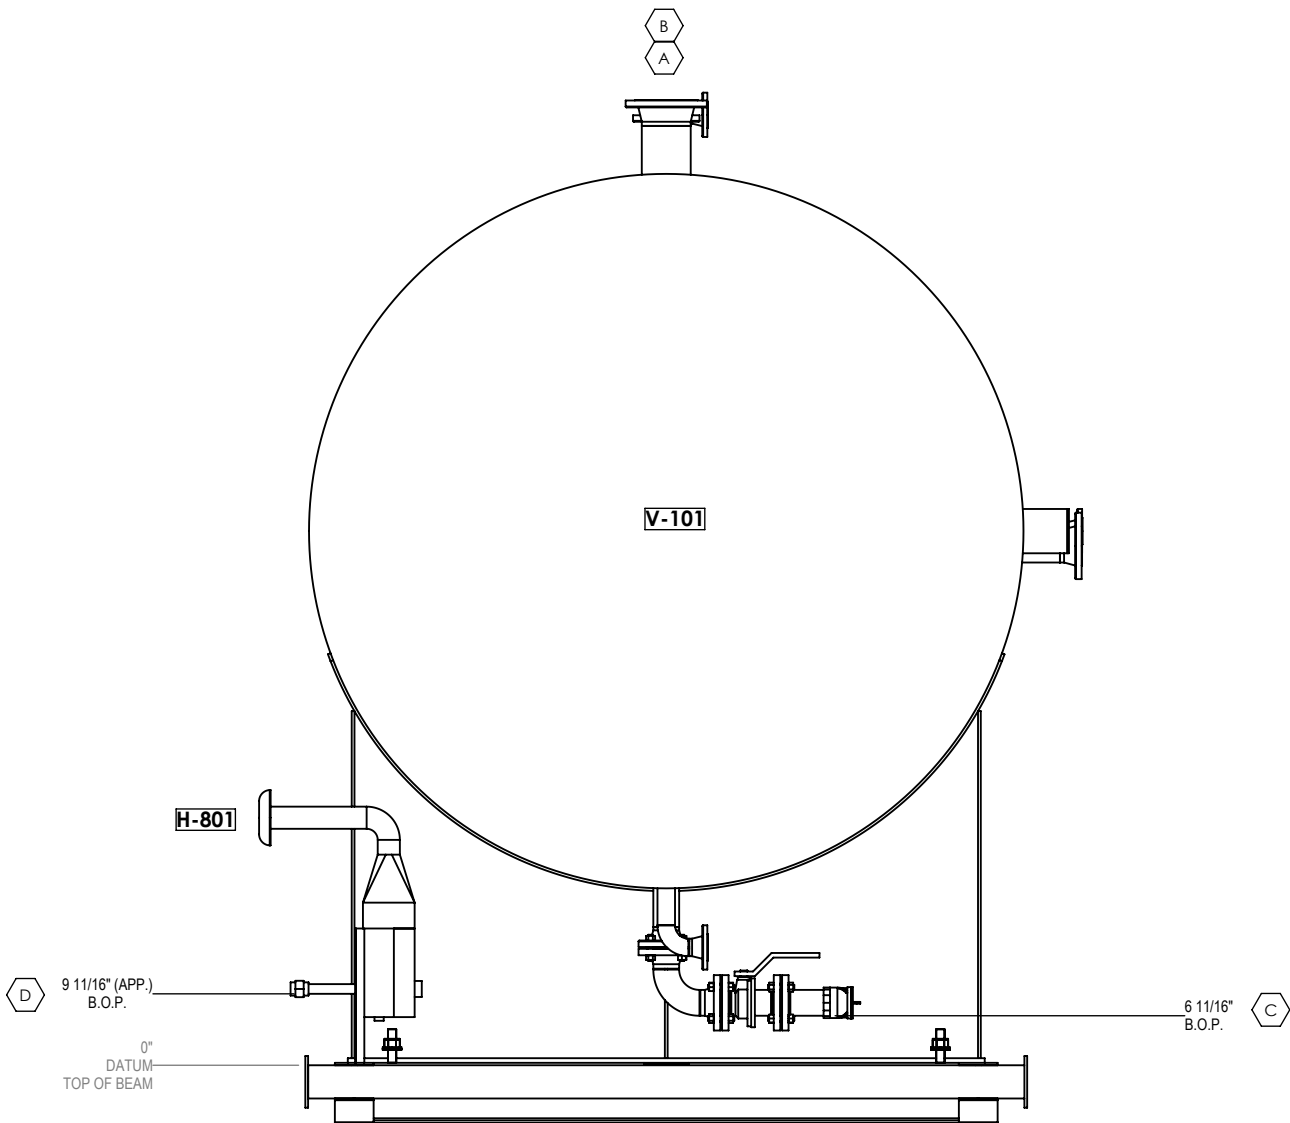

LEFT SIDE VIEW
BUILDING & SADDLE HIDDEN FOR CLARITY

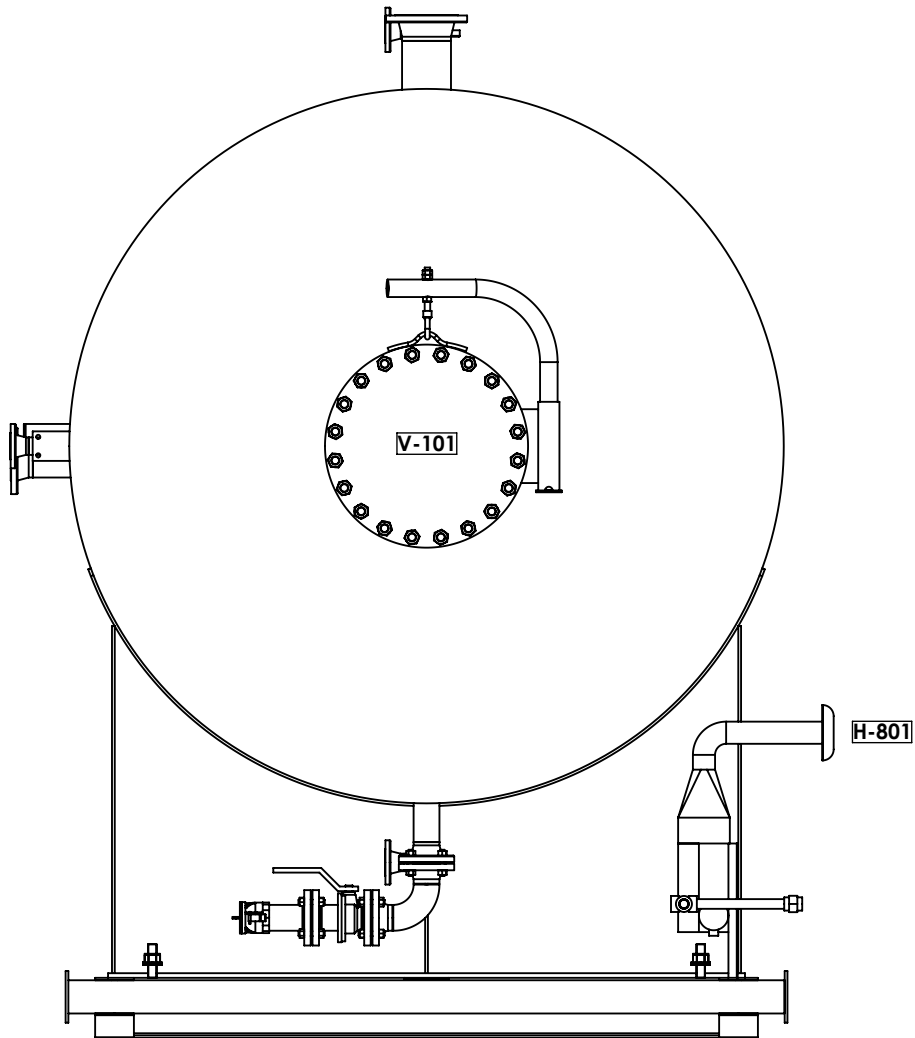


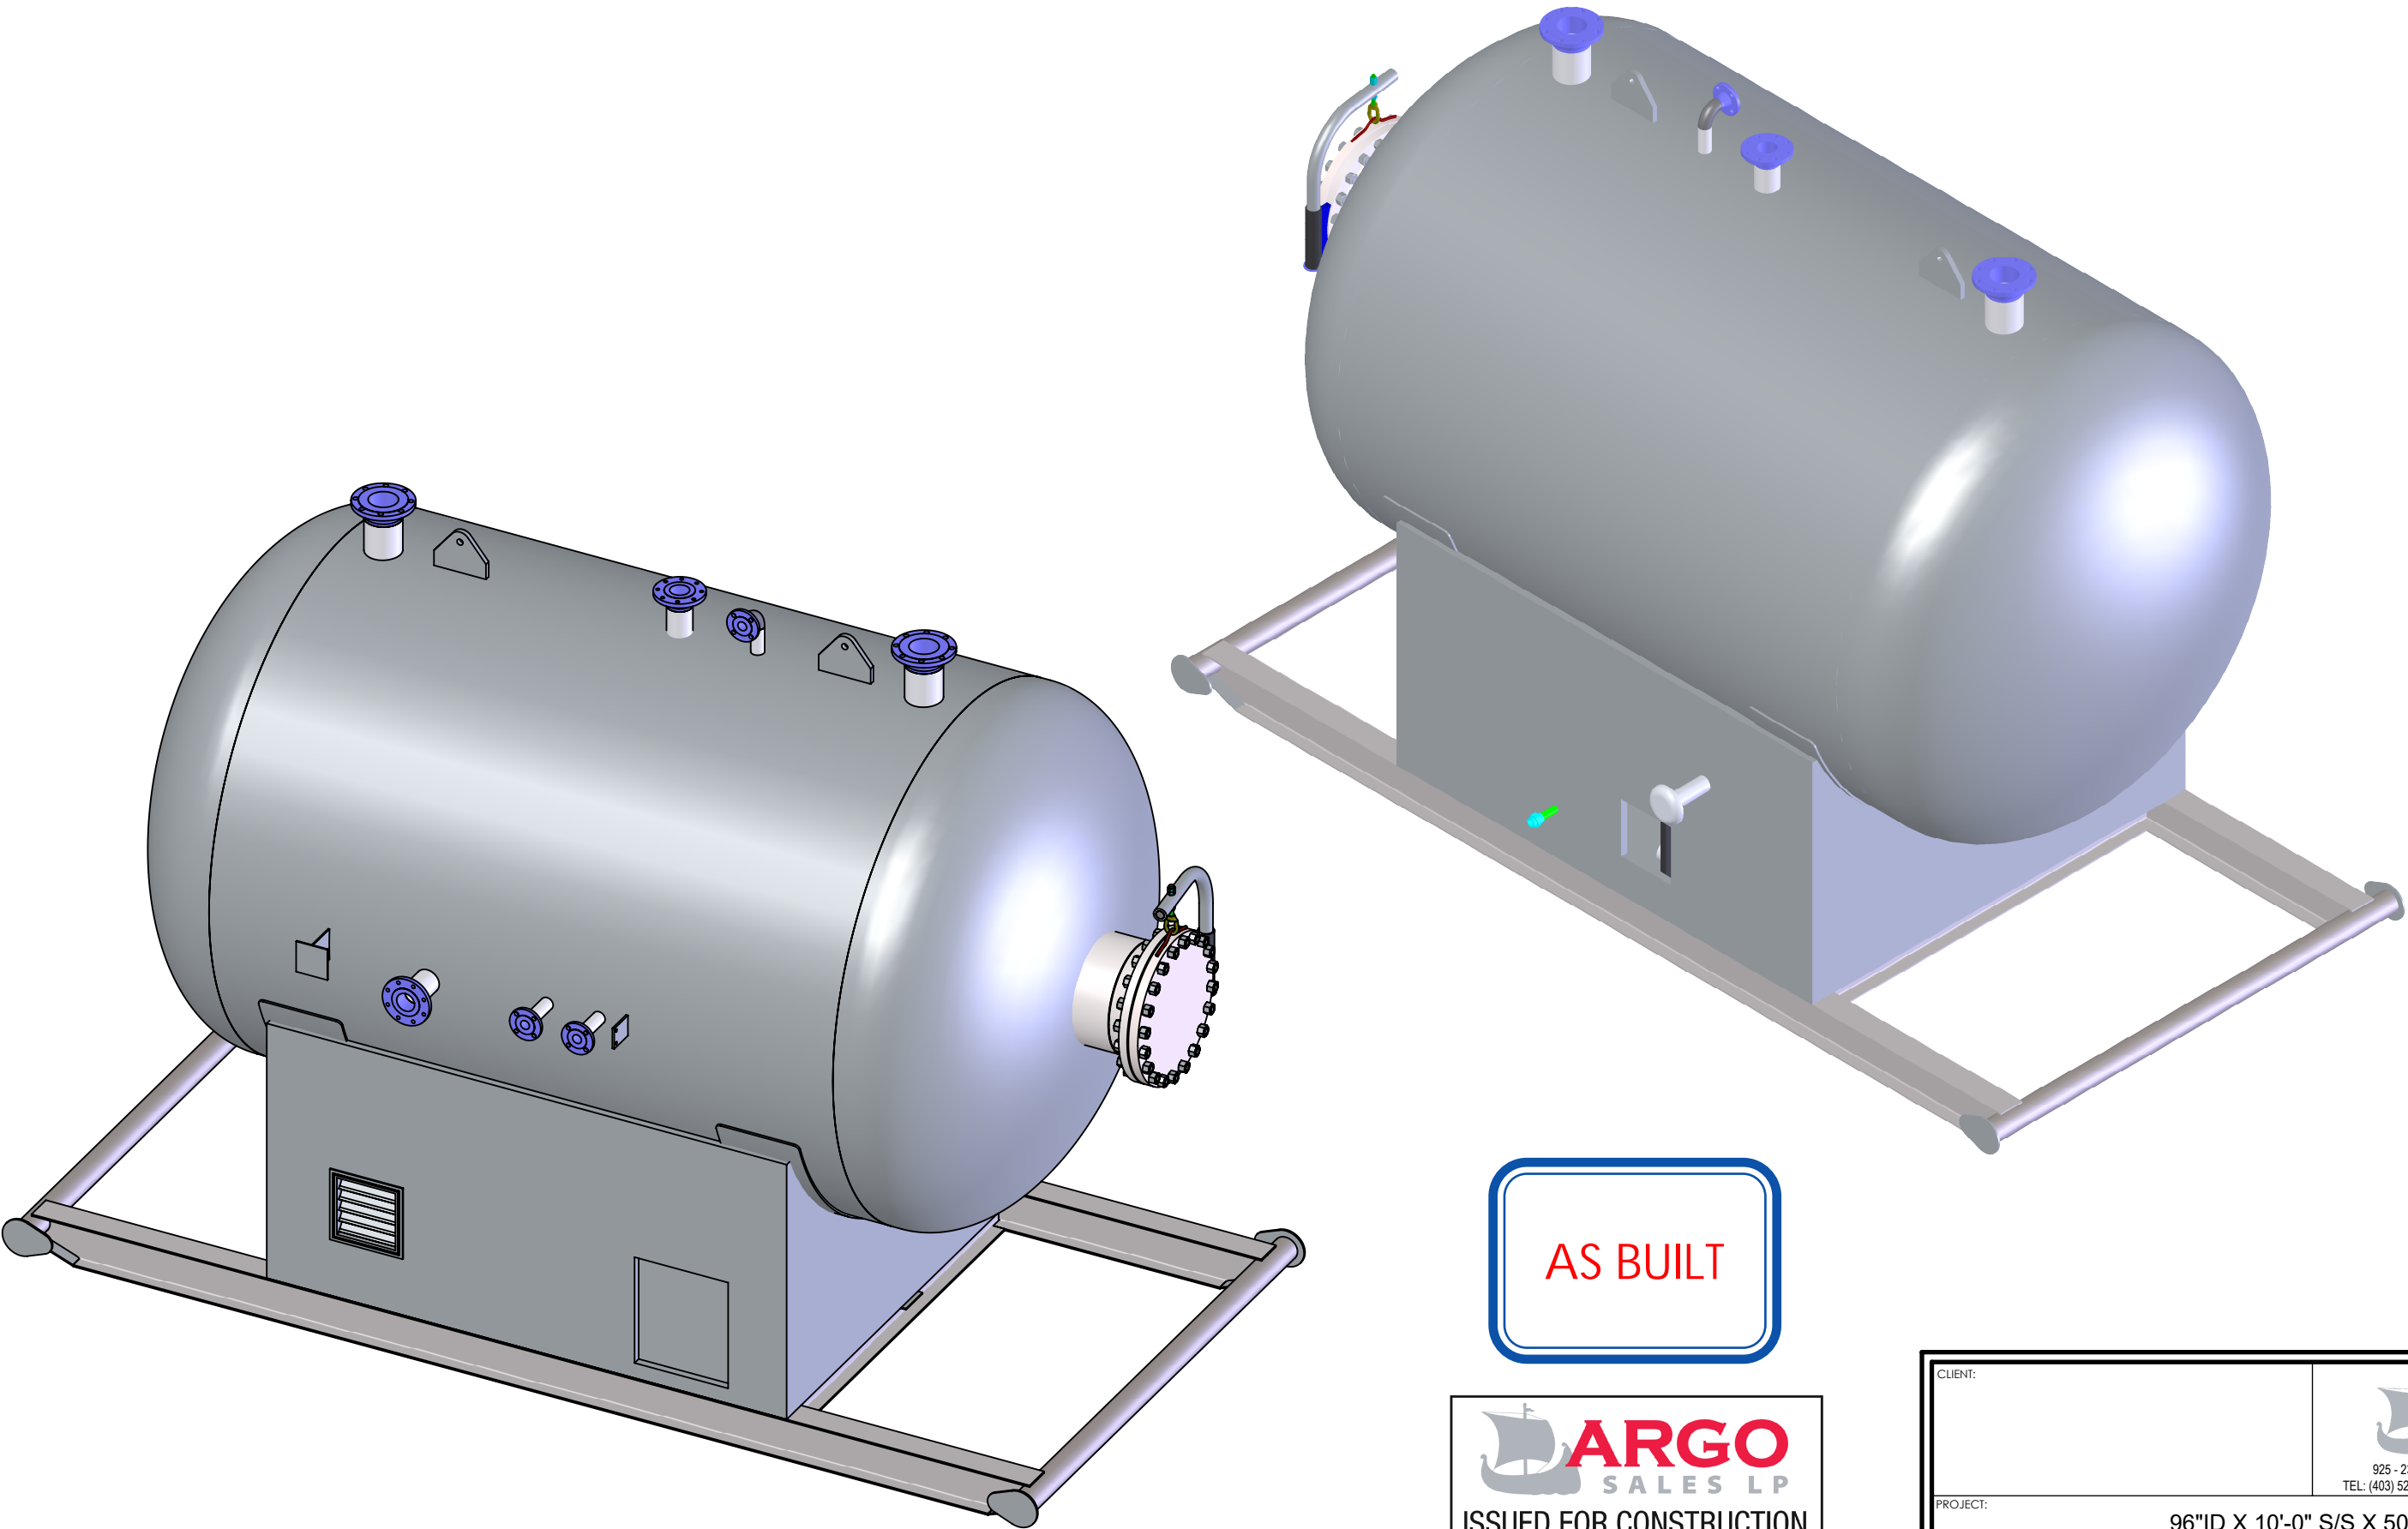
RIGHT SIDE VIEW
BUILDING & SADDLE HIDDEN FOR CLARITY

January 27, 2025 2:03:37 PM

AS BUILT

ARGO
SALES LP
ISSUED FOR CONSTRUCTION
PROCEED-NO CHANGES__ AS NOTED__
BY:____ DATE:____

CLIENT:		 925 - 23 Street SW., Medicine Hat, Alberta, T1A 8R1 TEL: (403) 526-3142 FAX: (403) 526-1061 Toll: (800) 215-9806	
PROJECT:		96"ID X 10'-0" S/S X 50 PSIG FLARE KNOCKOUT PACKAGE	
TITLE:		LAYOUT	
WO No.:		DRAWN BY: J.REIMER	REVISION:
SIZE: B	LINE No.: -	DRAWING No.:	STK133 LAYOUT
		DRAWN DATE: 2024-07-16	REVISION: 0
		SHEET: 4 OF 5	SCALE: 1:26




AS BUILT

**ARGO**
SALES LP

ISSUED FOR CONSTRUCTION
PROCEED-NO CHANGES___AS NOTED___
BY:_____DATE:_____

CLIENT:

**ARGO**
SALES LP
925 - 23 Street SW., Medicine Hat, Alberta, T1A 8R1
TEL: (403) 526-3142 FAX: (403) 526-1061 Toll: (800) 215-9806

PROJECT:

96"ID X 10'-0" S/S X 50 PSIG
FLARE KNOCKOUT PACKAGE

TITLE:

LAYOUT

WO No.:		DRAWN BY: J.REIMER		DRAWN DATE: 2024-07-16	REVISION: 0
SIZE: B	LINE No.: -	DRAWING No. STK133 LAYOUT		SHEET: 5 OF 5	SCALE: 1:28

January 27, 2025 2:03:37 PM