



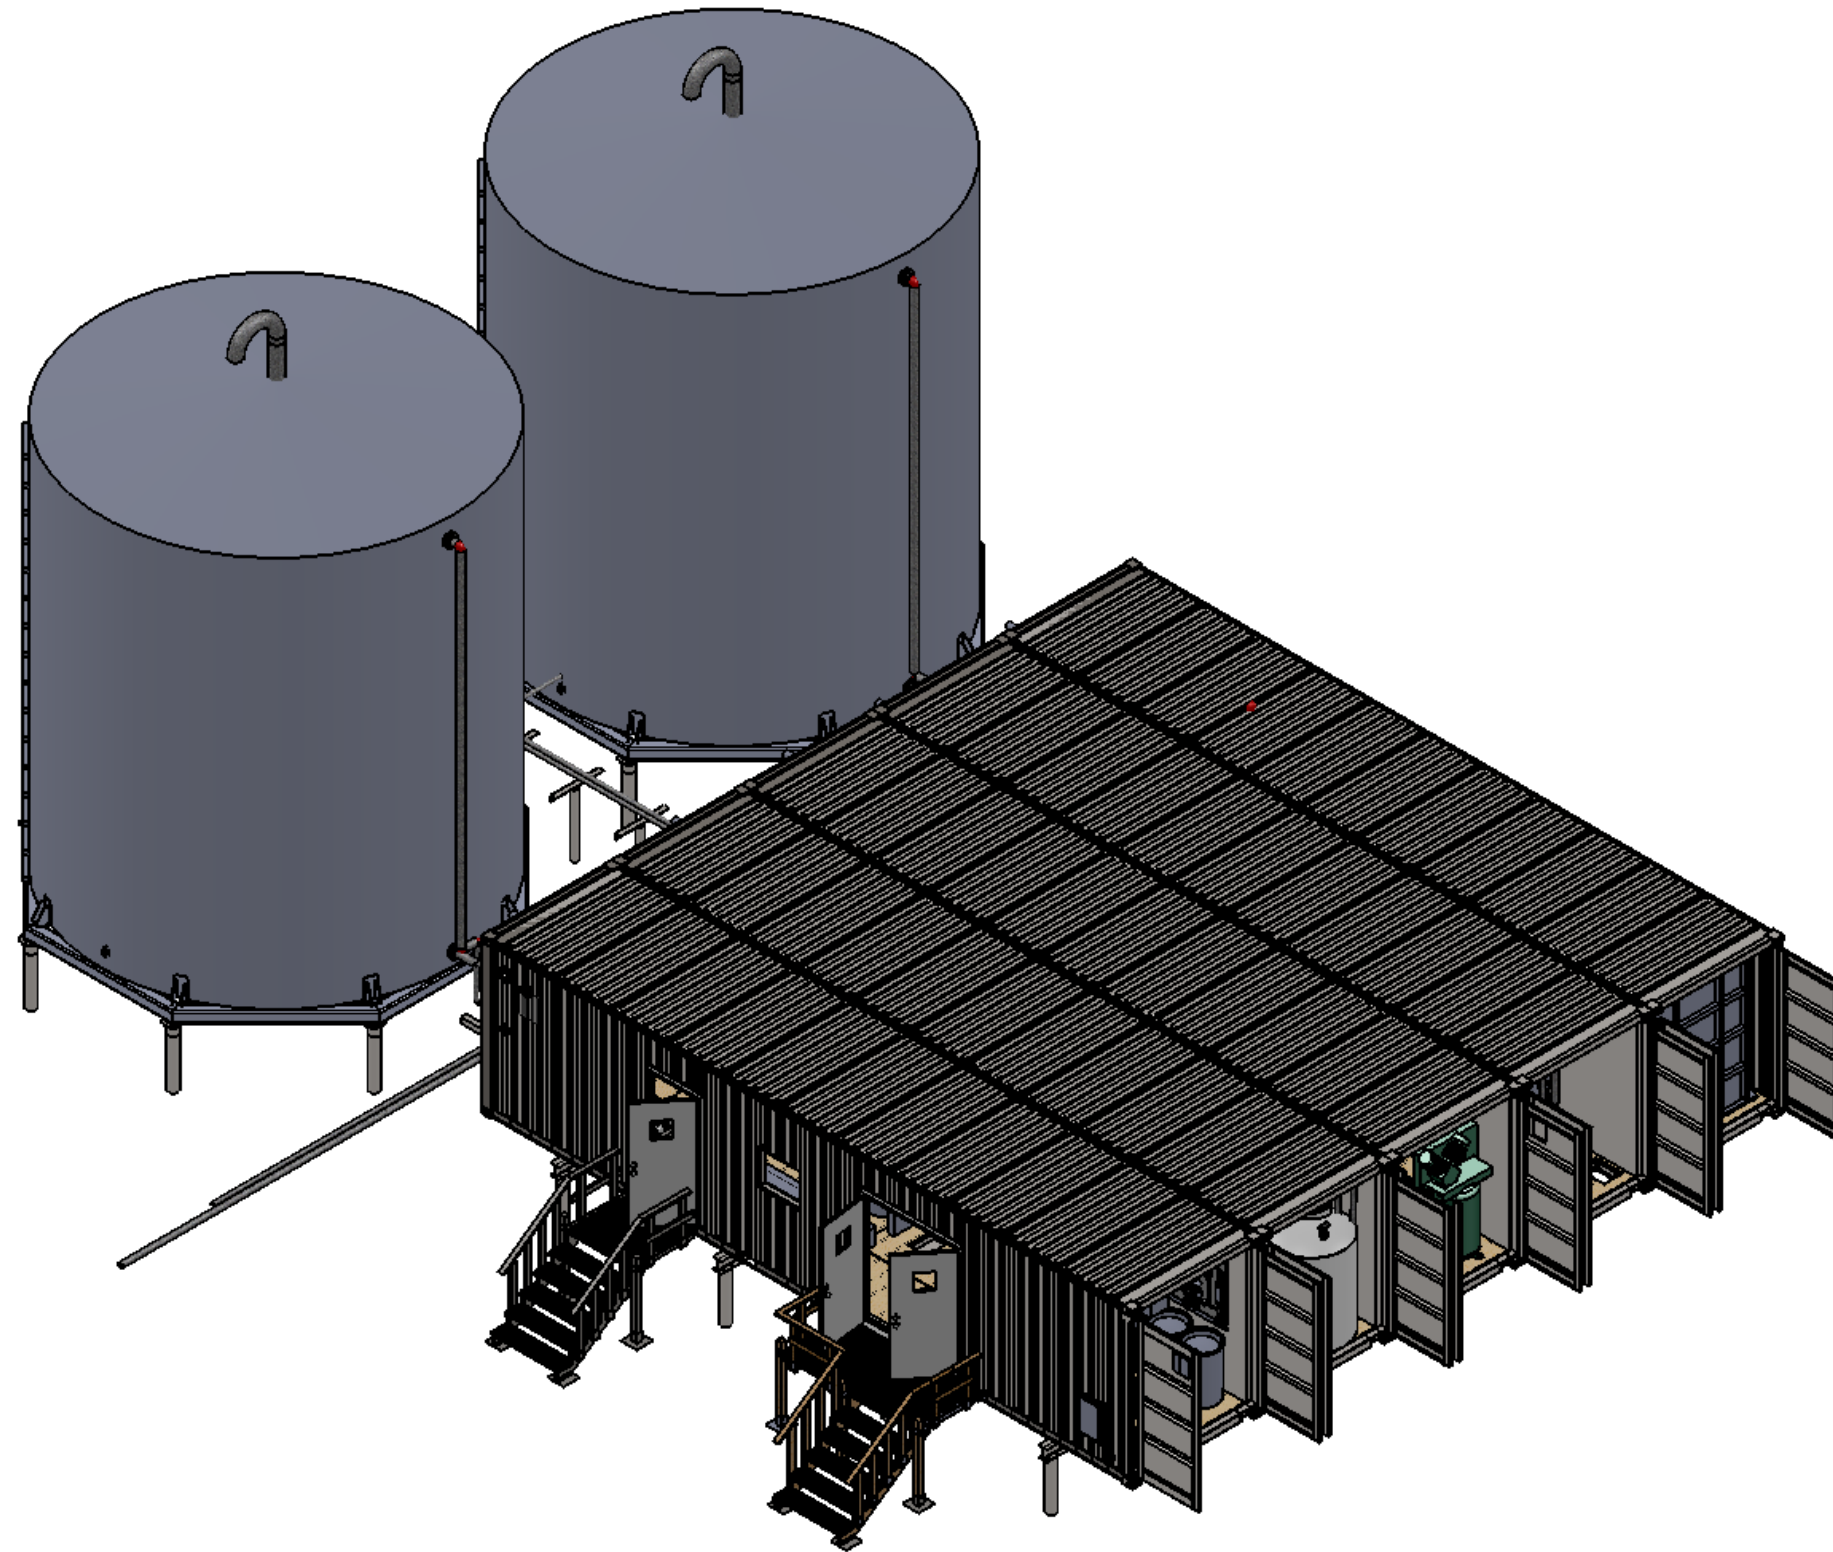

GENERAL TOLERANCES .XX ± .125" .XXX ± .0625" UNLESS OTHERWISE SPECIFIED DIMENSIONS ARE IN INCHES THIS INFORMATION IS THE PROPERTY OF newterra AND CANNOT BE REUSED OR REPRODUCED WITHOUT WRITTEN CONSENT.					DWG. NO:	300510-30	PROJECT NUMBER:	300510
					TITLE:	LAYOUT DRAWING		
					CUSTOMER:	Cenovus Energy	DRAWN BY:	GM
							DATE:	14/05/2014
								SHEET 1 OF 5
	C	16/05/2014	GM	AS BUILT				
	B	16/05/2014	GM	FOR PRODUCTION				
	A	16/05/2014	GM	FOR REVIEW				
	LEVEL	DATE	BY	REVISION				

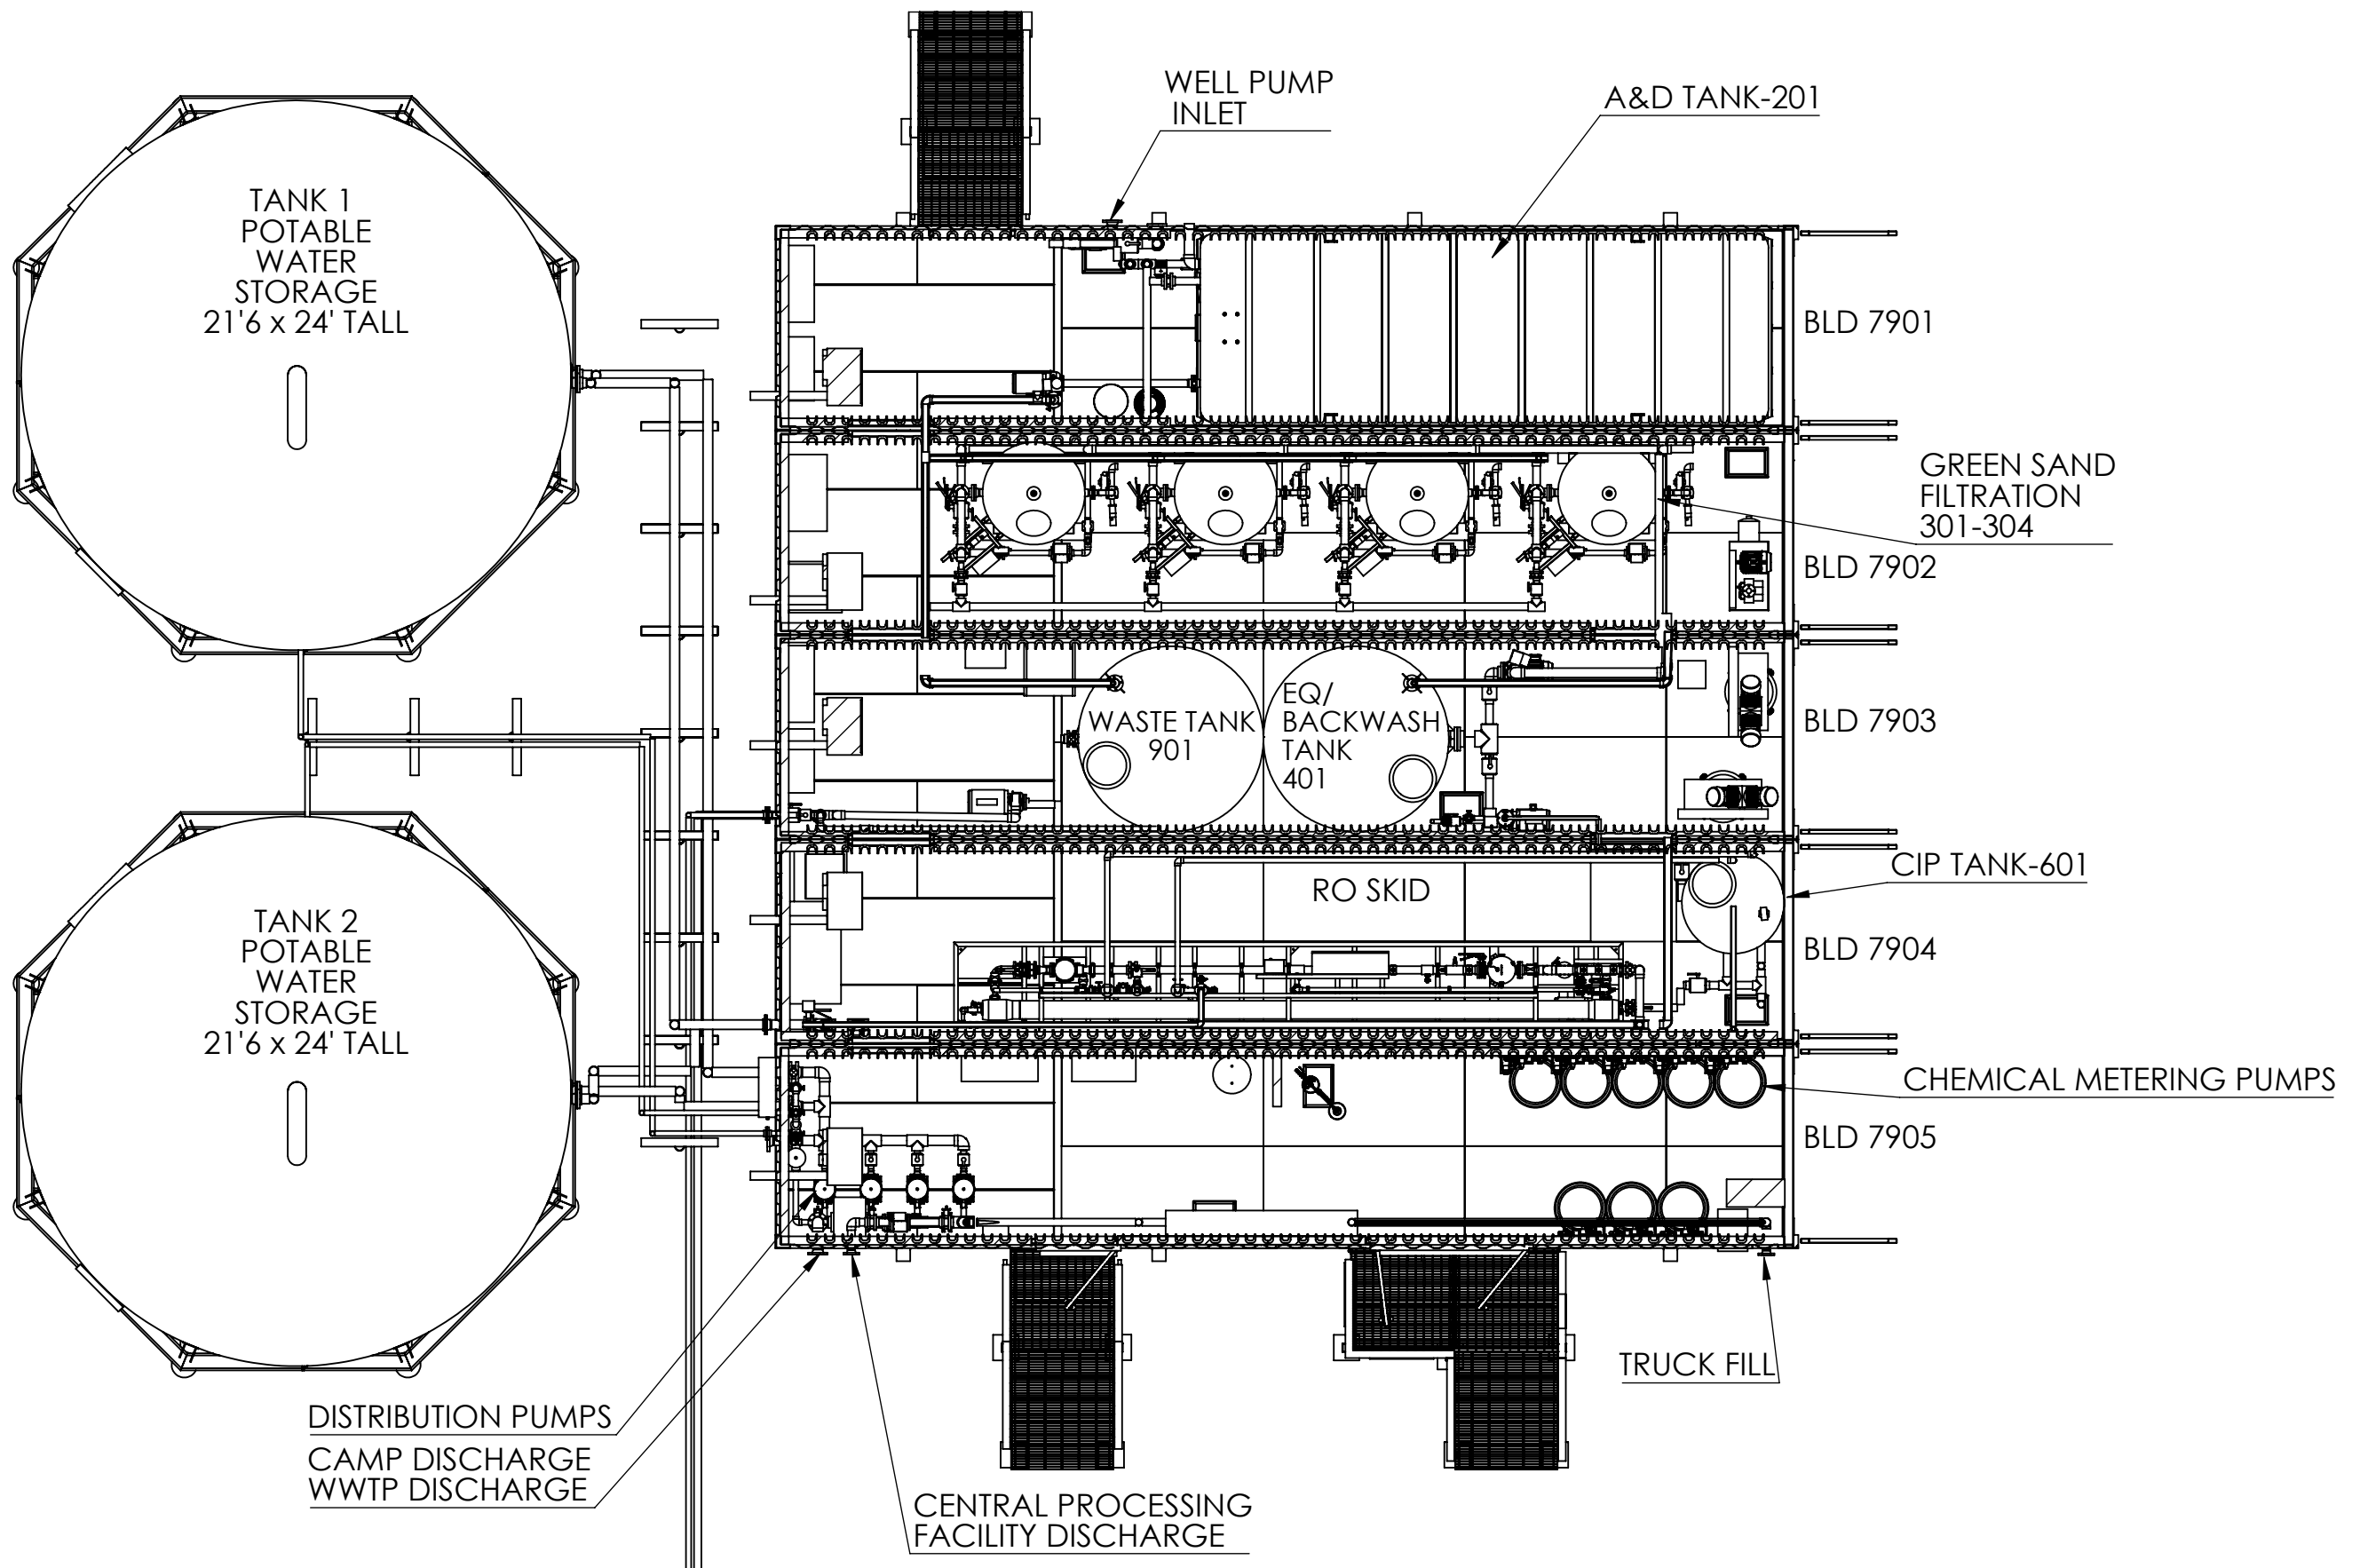


GENERAL TOLERANCES
 .XX ± .125"
 .XXX ± .0625"

UNLESS OTHERWISE SPECIFIED
 DIMENSIONS ARE IN INCHES
 THIS INFORMATION IS THE PROPERTY OF newterra
 AND CANNOT BE REUSED
 OR REPRODUCED WITHOUT WRITTEN CONSENT.

C	16/05/2014	GM	AS BUILT
B	16/05/2014	GM	FOR PRODUCTION
A	16/05/2014	GM	FOR REVIEW
LEVEL DATE		BY REVISION	

DWG. NO:	300510-30	PROJECT NUMBER:	300510
TITLE:	LAYOUT DRAWING	DRAWN BY:	GM
CUSTOMER:	Cenovus Energy	DATE:	14/05/2014
			SHEET 2 OF 5

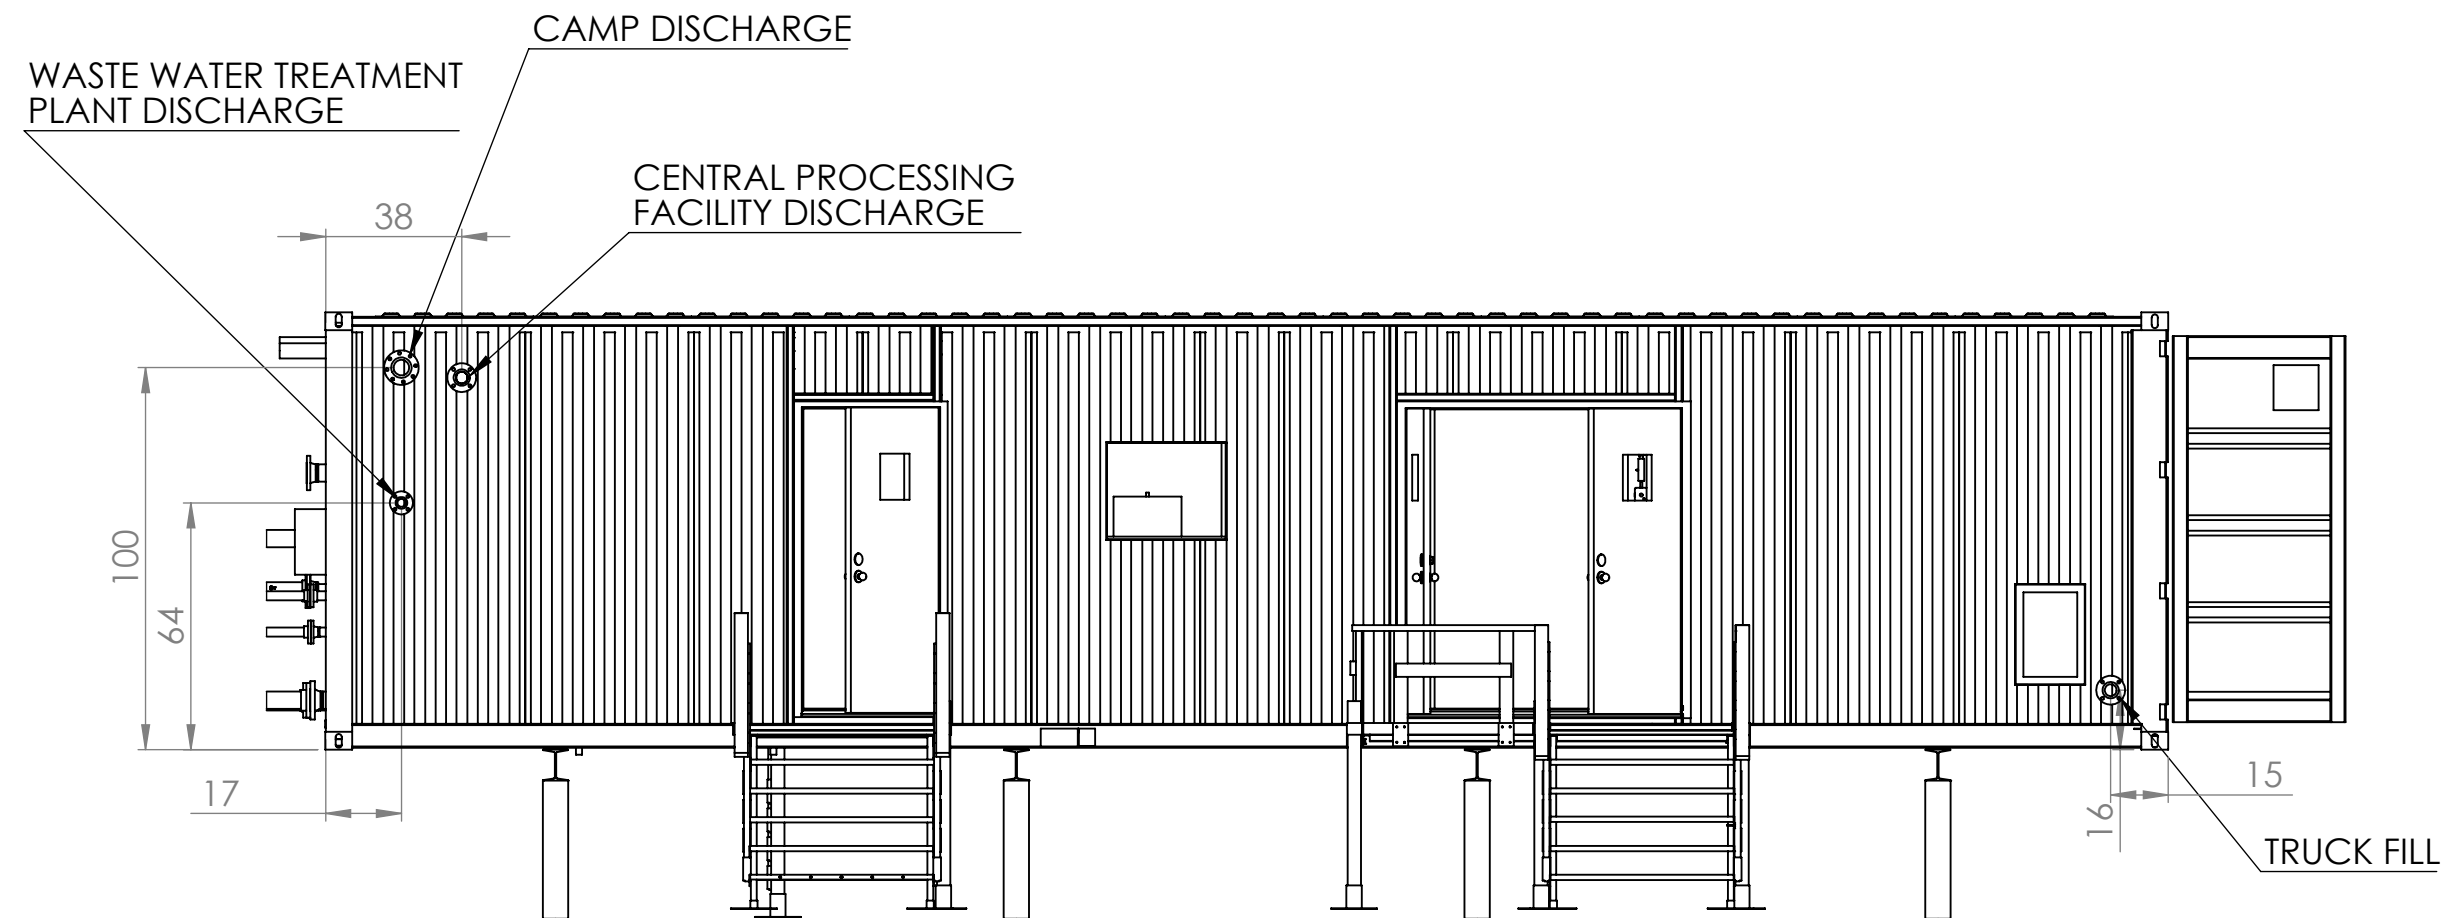


GENERAL TOLERANCES
.XX $\pm$.125"
.XXX $\pm$.0625"

UNLESS OTHERWISE SPECIFIED
DIMENSIONS ARE IN INCHES

THIS INFORMATION IS THE PROPERTY OF newterra
AND CANNOT BE REUSED
OR REPRODUCED WITHOUT WRITTEN CONSENT.

LEVEL	DATE	BY	REVISION
C	16/05/2014	GM	AS BUILT
B	16/05/2014	GM	FOR REVIEW
A	14/04/2014	GM	FOR PRODUCTION

DWG. NO:	300510-30	PROJECT NUMBER:	300510
TITLE:	LAYOUT DRAWING	DRAWN BY:	GM
CUSTOMER:	Cenovus Energy	DATE:	14/05/2014
			SHEET 3 OF 5

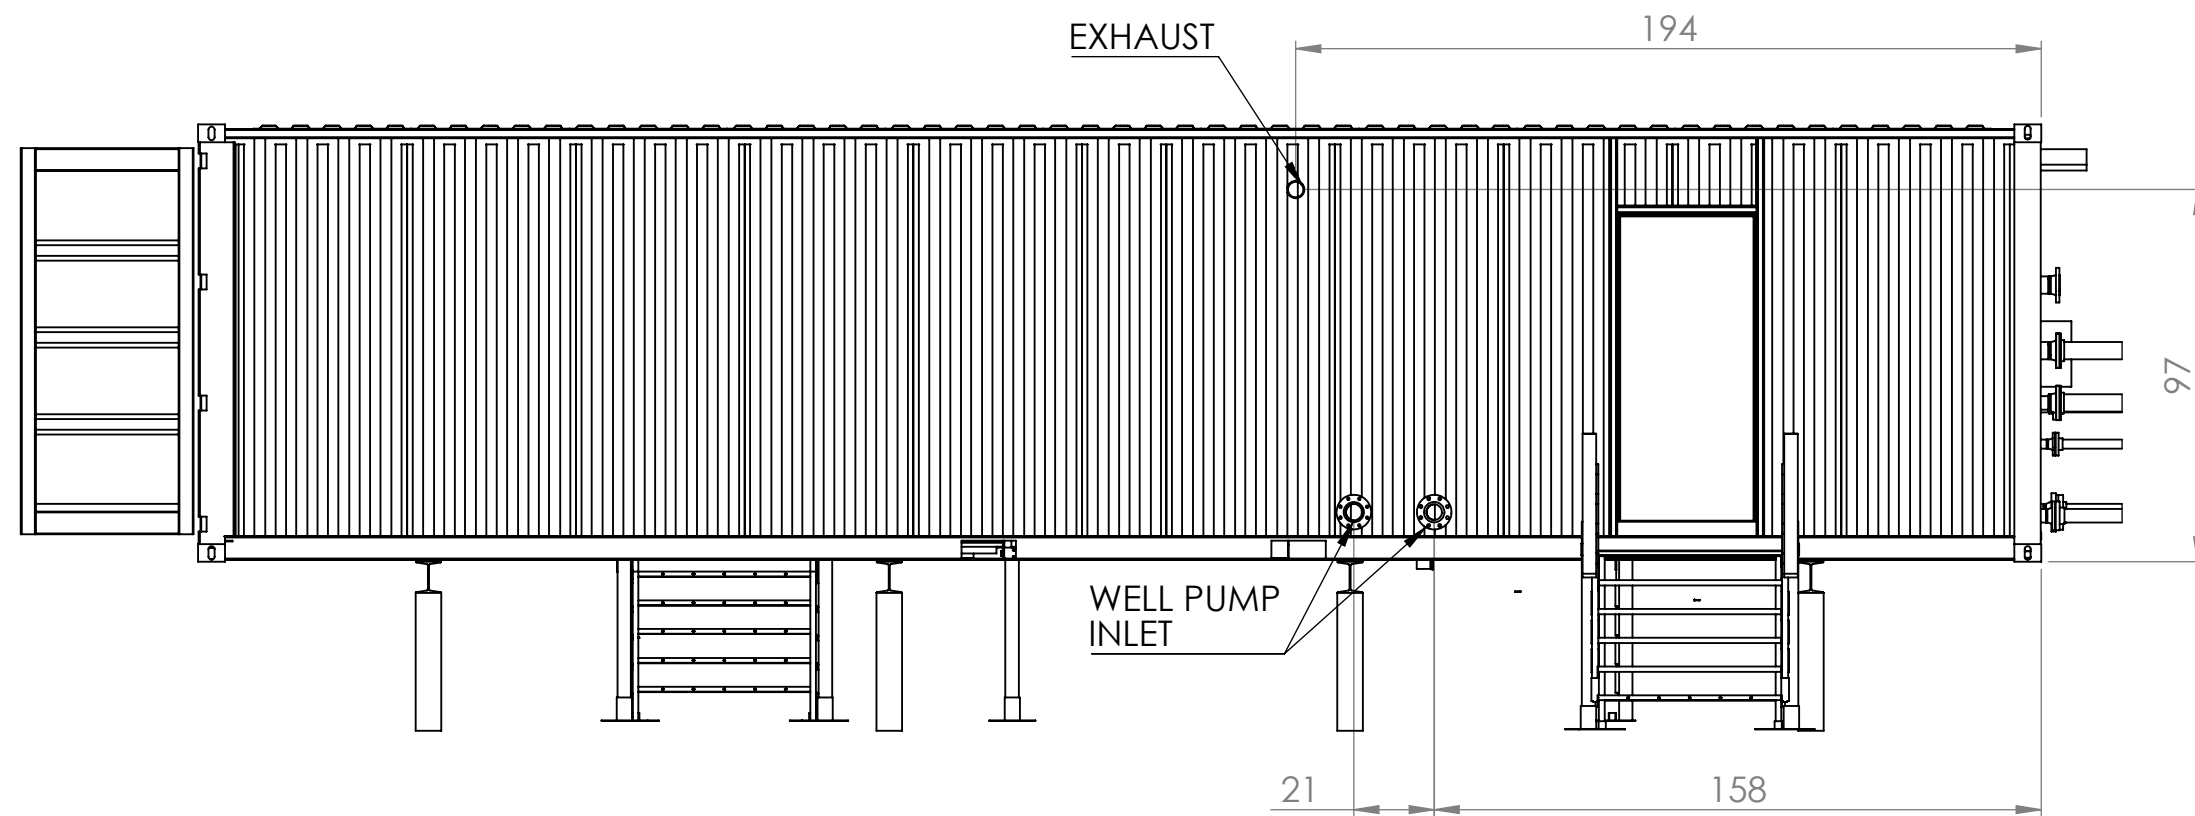


GENERAL TOLERANCES
.XX ± .125"
.XXX ± .0625"

UNLESS OTHERWISE SPECIFIED
DIMENSIONS ARE IN INCHES
THIS INFORMATION IS THE PROPERTY OF newterra
AND CANNOT BE REUSED
OR REPRODUCED WITHOUT WRITTEN CONSENT.

LEVEL	DATE	BY	REVISION
C	16/05/2014	GM	AS BUILT
B	16/05/2014	GM	FOR PRODUCTION
A	16/05/2014	GM	FOR REVIEW

DWG. NO:	300510-30	PROJECT NUMBER:	300510
TITLE:	LAYOUT DRAWING	DRAWN BY:	GM
CUSTOMER:	Cenovus Energy	DATE:	14/05/2014
			SHEET 4 OF 5

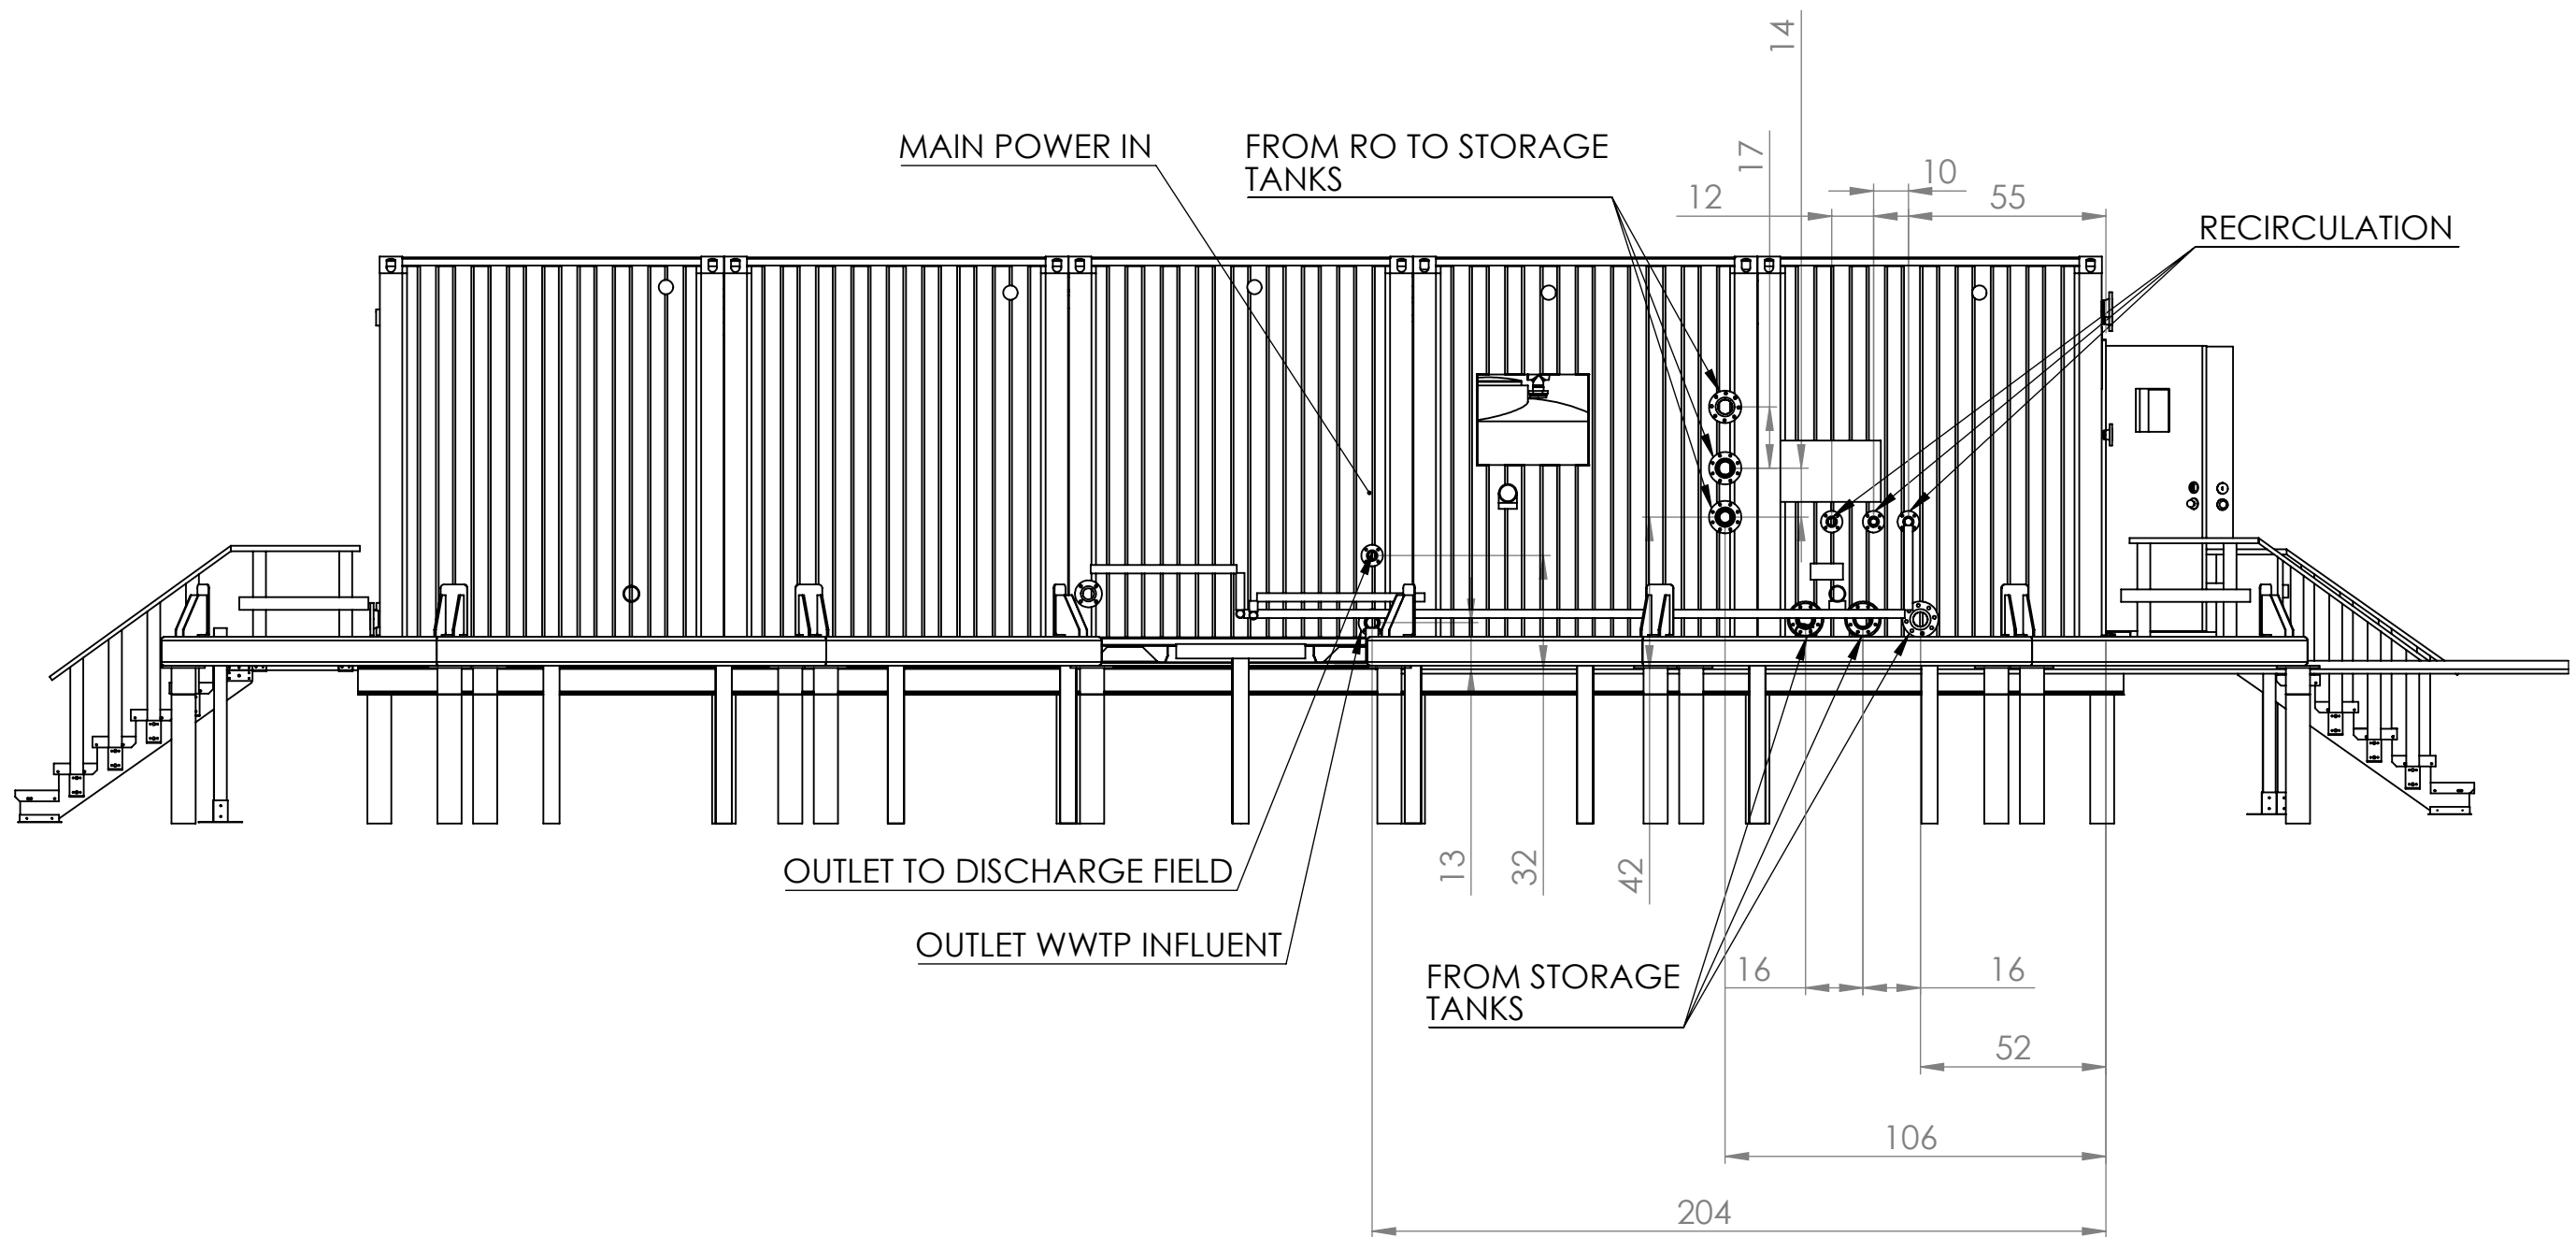

GENERAL TOLERANCES
 .XX ± .125"
 .XXX ± .0625"

UNLESS OTHERWISE SPECIFIED
 DIMENSIONS ARE IN INCHES
 THIS INFORMATION IS THE PROPERTY OF newterra
 AND CANNOT BE REUSED
 OR REPRODUCED WITHOUT WRITTEN CONSENT.

LEVEL	DATE	BY	REVISION
C	16/05/2014	GM	AS BUILT
B	16/05/2014	GM	FOR PRODUCTION
A	16/05/2014	GM	FOR REVIEW

DWG. NO:	300510-30	PROJECT NUMBER:	300510
TITLE:	LAYOUT DRAWING	DRAWN BY:	GM
CUSTOMER:	Cenovus Energy	DATE:	14/05/2014
		SHEET	5 OF 5