



1 GENERAL

1.1 MACHINE NAME AND MODEL NO.

Pinhole Inspector for Plastic Ampuls, Model No. HDI-12

1.2 MACHINE FUNCTION AND BASIC OPERATION

The machine inspects plastic cards in strip for possible liquid leakage or seal detect by means of a non-destructive technique by applying high frequency high voltage to the solution-filled ampuls and rejects the leaky cards automatically.

Filled and sealed cards are placed on the machine lying horizontally on the infeed side.

The cards on the conveyor move past the inspection stations where leaky or empty containers are detected by the high frequency, high voltage principle. Reject cards are discharged through reject chute to the outside of the machine.



1.3 HDI-12 HIGH VOLTAGE INSPECTION METHOD

DRAWING NO. 2-65219-3

High voltage is applied to a product in a hermetically sealed container made of non-conductive material. If pinhole or crack is present on the container, the discharge current flows through the pinhole or crack into the product. The defective container is detected by the difference of the current from the current flows in the intact container.

1.4.1 Inspection Section

When production starts, products are exposed to the high voltage at one inspection station. The station inspects the sealed base area of the container.

1) Inverter	1 unit
2) Product Confine Optic Sensor	1 unit
3) Product Posture Alarm Detect Optic Sensor	1 unit
4) Inspection Electrode 4 channels	1 unit
5) High Voltage Transformer	1 unit
6) Safety Cover	1 unit

1.4.3 Discharge Section

1) Discharge Conveyor	1 unit
2) Reject control motor with reject confirming sensor	1 unit

1.4.4 Control and Operation Section

1) Control unit and Operation Panel	1 unit
-------------------------------------	--------

1.4.5 Drive Section

1) Main Motor	1 unit
2) Ozona Decomposed Exhaust Blower and Filter Box	1 unit



1.5 MACHINE DESIGN

1.5.1 Material and Finish

Discharge Height: 850 ± 50mm

Product contact surface: Hairline or buffed stainless steel, Anodized aluminum, and plastic resin

Frame and product non-contact area: Epoxy painted electroplated steel, anodized aluminum, and plastic resin

Gearing, actuating machine, etc.: Phosphated steel and electroplated steel

Exterior: Stainless steel and clear PVC where visibility is deemed necessary

Console Panel: Hairlined aluminum

Product traveling direction is from right to left viewed from the front of the machine.

1.5.4 Construction

Stainless steel machine heights adjust bolts with plastic discs at floor contact and plastic swivel casters will be provided.

Devices and components incorporated in product transferring units will be of simple drip-proof construction, but not of watertight construction.

IMPORTANT


If product should break during production, immediately stop the machine, remove the size parts wet with solution and wipe off with alcohol and water solution.



1.5.2 Machine Height

Infeed Height: $855 \pm 50\text{mm}$

Discharge Height: $850 \pm 50\text{mm}$

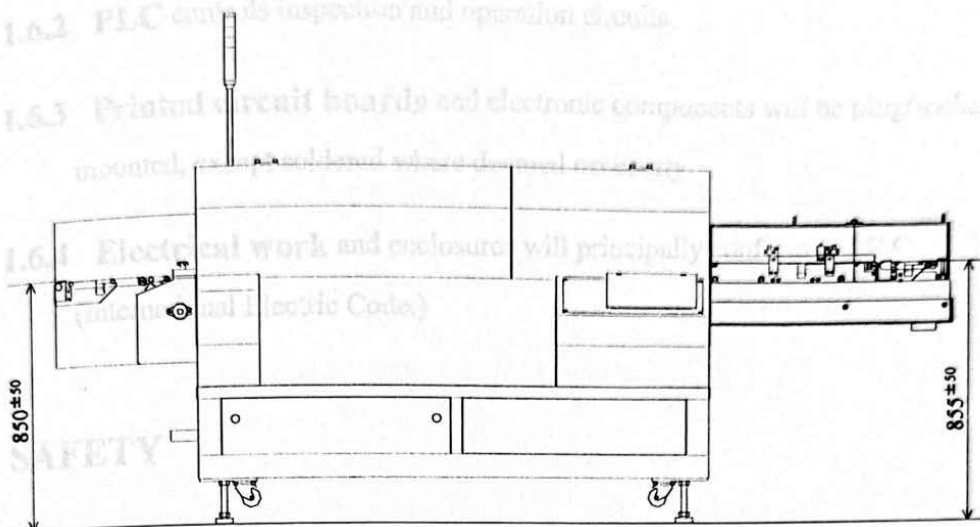

1.5.3 Product Traveling Direction

Product traveling direction is from right to left viewed from the front of the machine.

1.5.4 Construction

Stainless steel machine heights adjust bolts with plastic discs at floor contact and plastic swivel casters will be provided.

Devices and components incorporated in product transferring units will be of simple drip-proof construction, but not of watertight construction.

IMPORTANT

If product should break during production, immediately stop the machine, remove the size parts wet with solution and wipe off with alcohol and water solution.



1.6 MACHINE ELECTRICAL SYSTEM

- 1.6.1 Control circuits** (switches, sensors, solenoids, relays, etc.) are by DC 24V.
- 1.6.2 PLC** controls inspection and operation circuits.
- 1.6.3 Printed circuit boards** and electronic components will be plug/socket mounted, except soldered where deemed necessary.
- 1.6.4 Electrical work** and enclosures will principally conform to I.E.C.
(International Electric Code.)

1.7 SAFETY

- 1.7.1 Emergency stop switches**
- 1.7.2 Safety covers**
- 1.7.3 Ozone decomposition and exhaust**
- 1.7.4 Alarms**
- 1.7.5 Grounding**
- 1.7.6 Anti-overload function (torque limiter) will be built in.**



1.8 UTILITY AND ROOM CONDITIONS

1.8.1 Electric Power: AC208V \pm 10%

1.8.2 Consumption: 3 kVA

1.8.3 Air source: 3 kg/cm², 60NI/min.

1.8.4 Grounding: Class D or better (with a grounding resistance of 100 Ω or less)

1.8.5 Operation Room Conditions

The cards must be dry (free or moisture) on its surface.

Room temperature: 10°C - 35°C

Room humidity: 20% - 80%

1.11 INSPECTION PERFORMANCE

1.11.1 Inspection areas

CH1: Twist-off ~ Jolat line(8mm)

CH2: Bottom

1.11.2 Processing speed

50 Pieces/Minutes = 3000 Pieces/Hour



1.9 PRODUCT

Vial Card Size	Height	Width
2ml	58.5(mm)	52.3(mm)

1.10 PRODUCT CONDITIONS

1.10.1 Electric Conductivity of solution $50\mu\text{Scm}$ ($20\text{k}\Omega$)

1.10.2 Product surface shall be dry and free of dust and dirt.

1.10.3 Capacity of product and volume of solution should be as near as possible

1.11 INSPECTION PERFORMANCE


1.11.1 Inspection areas

CH1: Twist-off ~ Joint line(8mm)


CH2: Bottom


1.11.2 Processing speed

50 Pieces/Minutes = 3000 Pieces/Hour

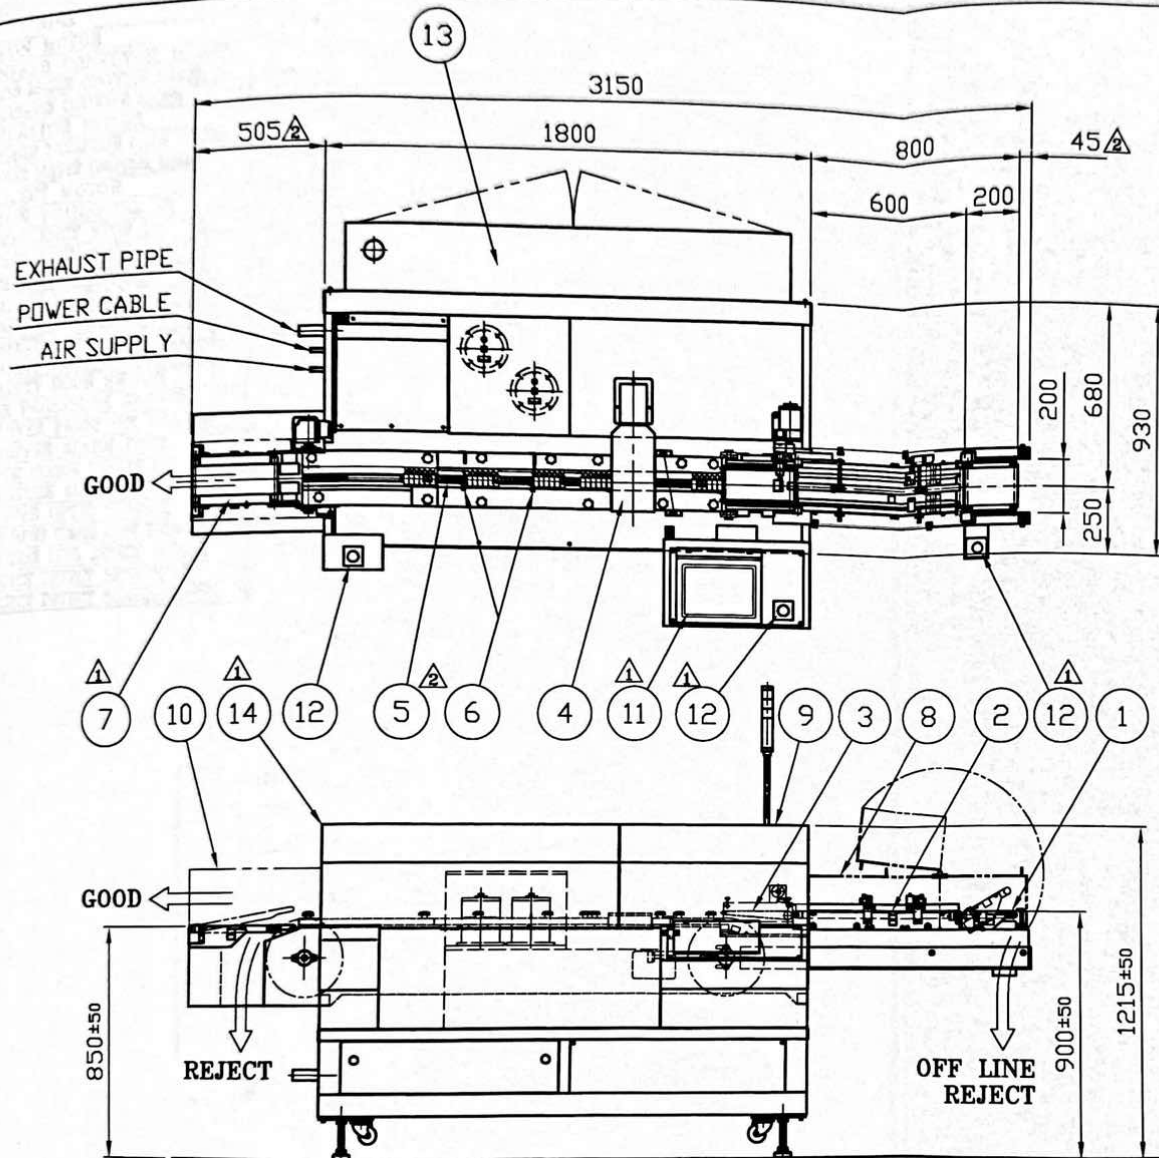


MARK	NAME	QTY
1	OFF LINE DISCHARGE DUMPER	1
2	INFEED CONVEYOR	1
3	AUTO LOADER	1
4	VIBRATOR UNIT	1
5	MAIN CONVEYOR	1
6	INSPECTION ELECTRODE	2
7	DISCHARGE CONVEYOR	1
8	INFEED COVER	1
9	INSPECTION COVER	1
10	DISCHARGE COVER	1
11	OPERATION PANEL	1
12	EMERGENCY STOP SWITCH	3
13	CONTROL BOX	1
14	INSPECTION SAFETY COVER	1

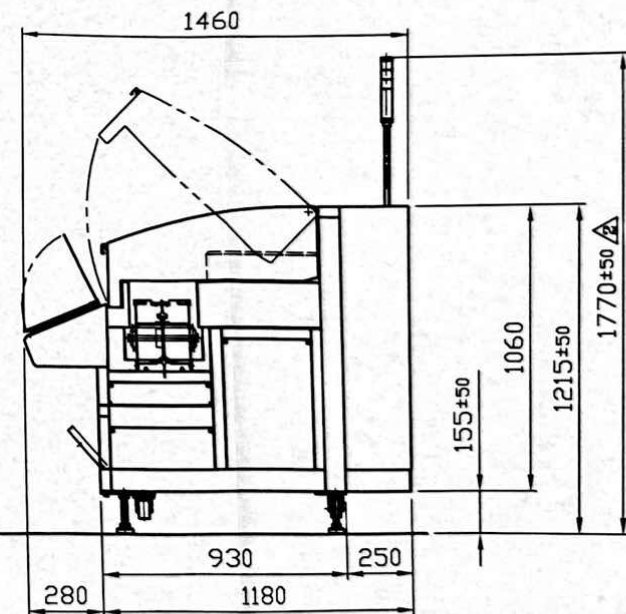

A			SCALE	DRAWING NAME	ORDER NO.
A Description & Size correction '12.02.23 Y.I			1 / 20	HDI-12 Outside Drawing	3104-384
A Change description '12.02.10 Y.I					
APPROVED	CHECKED	DESIGNED	DRAWN	DRAWING NUMBER	
Jim. J	Jim. J	Y.Nagano	Y.Nagano	02-65219-3A	
'12. 2. 23	'12. 2. 23	NOV.17'11	NOV.17'11		

AS BUILT


MARK	NAME	MARK	NAME
M1	MAIN MOTOR	PX7	VIBRATOR ALARM DETECT
M2	INFEED CONVEYOR MOTOR	HVT1	HIGH VOLTAGE TRANSFORMER
M3	AUTO LOADER CONVEYOR MOTOR	HVT2	HIGH VOLTAGE TRANSFORMER
M4	DISCHARGE CONVEYOR MOTOR	HC3	HIGH VOLTAGE CAPACITOR
M5	VIBRATOR MOTOR	HC4	HIGH VOLTAGE CAPACITOR
M6	EXHAUST DECOMPOSED OZONE BLOWER	C01	CONNECTOR
M7	INFEED DUMPER CONVEYOR MOTOR	C02	CONNECTOR
M8	REJECT MOTOR	ENC1	ROTARY ENCODER
MT	MAIN TRANSFORMER	RP1	CAM POSITIONER
S13	EMERGENCY STOP SWITCH	OZ	OZONE FILTER BOX
S14	EMERGENCY STOP SWITCH	AG1	AIR REGULATOR
S15	EMERGENCY STOP SWITCH	V1	INFEED STOPPER VALVE
S30	SAFETY DOOR LOCK SWITCH	V2	INFEED DUMPER CONVEYOR VALVE
S31	SAFETY DOOR LOCK SWITCH	SPC5	SPEED CONTROLLER FOR VIBRATOR
S32	SAFETY DOOR LOCK SWITCH	S01	MAIN SWITCH
S33	SAFETY DOOR SWITCH		
S34	SAFETY DOOR SWITCH		
S36	AIR PRESSURE SWITCH		
S37	BLOWER PRESSURE SENSOR		
PH2	STOPPER ALARM DETECT		
PH3	OPTIC SENSOR (INFEED STOPPER)		
PH5	POSTURE ALARM DETECT		
PH6	INFEED OPTIC SENSOR		
PH7	FOR INFEED DUMPER CLOSE TIMING SENSOR		
PH15	REVERSE FEED DETECT SENSOR		
PH16	REJECT DETECT SENSOR(UP)		
	REJECT DETECT SENSOR(DOWN)		

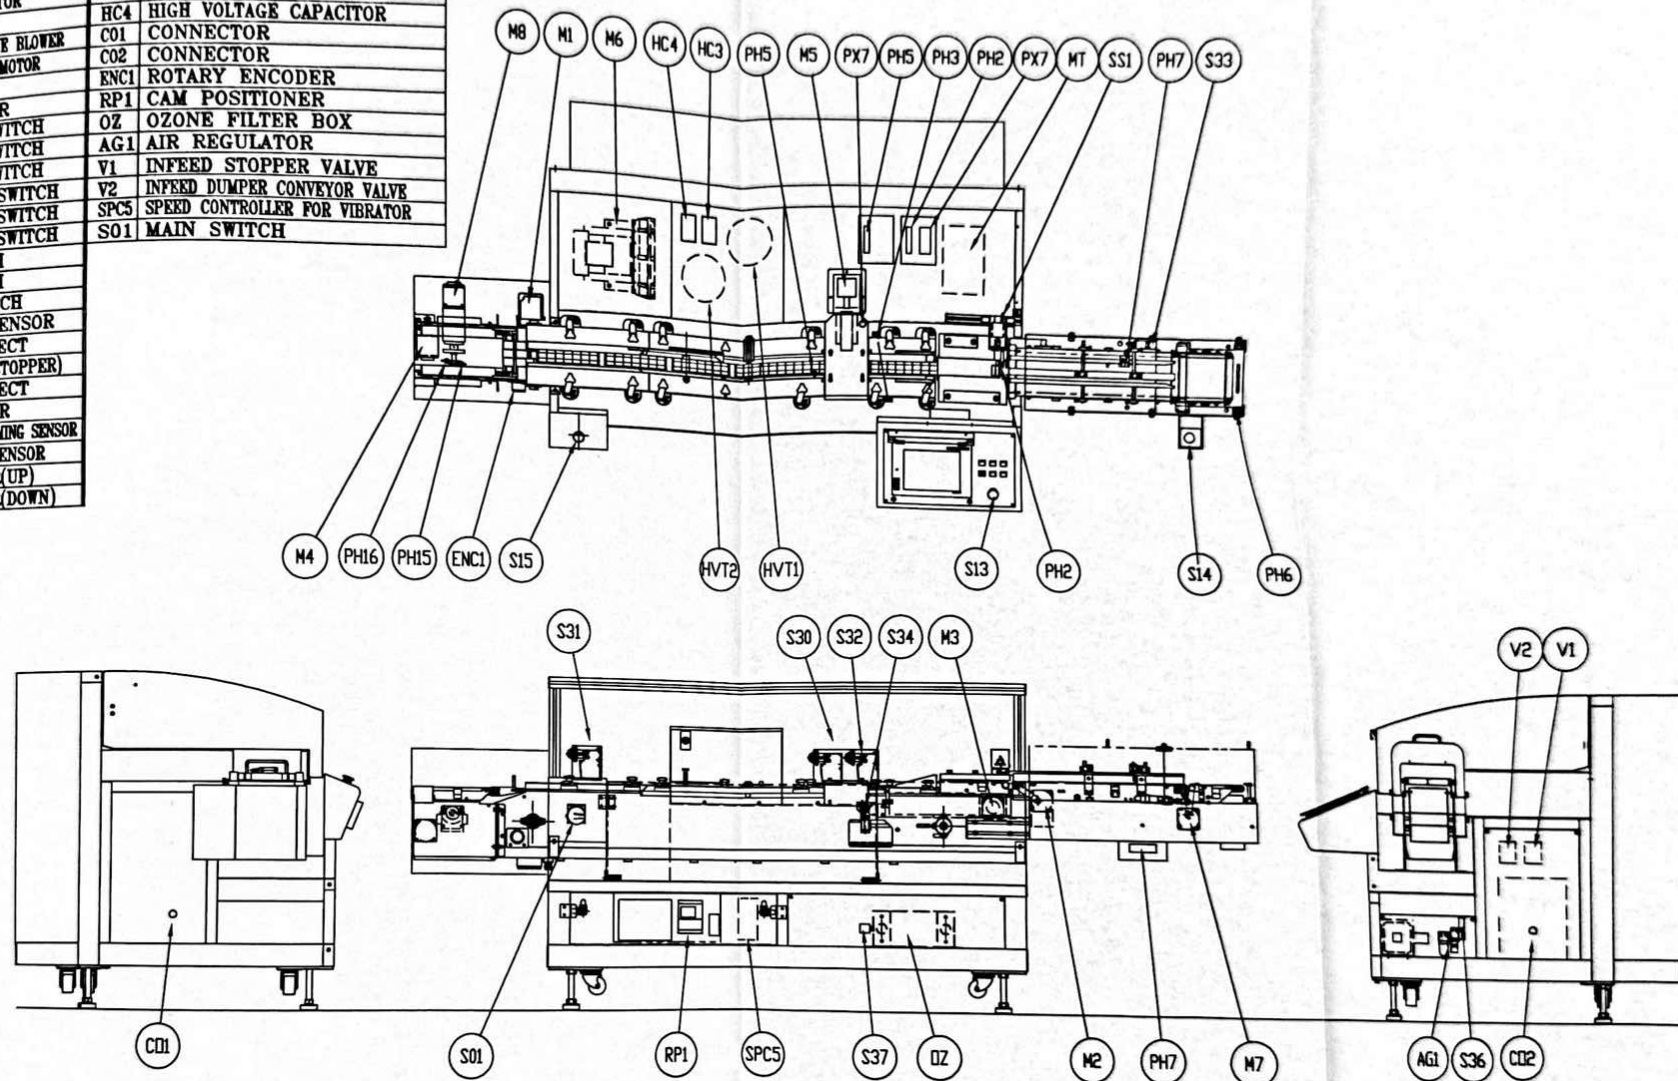


AS BUILT

<div> <div>△</div> <div>△</div> <div>△</div> </div>				SCALE	DRAWING NAME	ORDER NO.
				1/20	HDI-12 DEVICE LAYOUT	3104-384
APPROVED	CHECKED	DESIGNED	DRAWN	DRAWING NUMBER		
Jan. 8	Jan. 8	IIZUKA	IIZUKA	02-65692-3		
'12.2.23	'12.2.23	Feb.10.2012	Feb.23.2012			



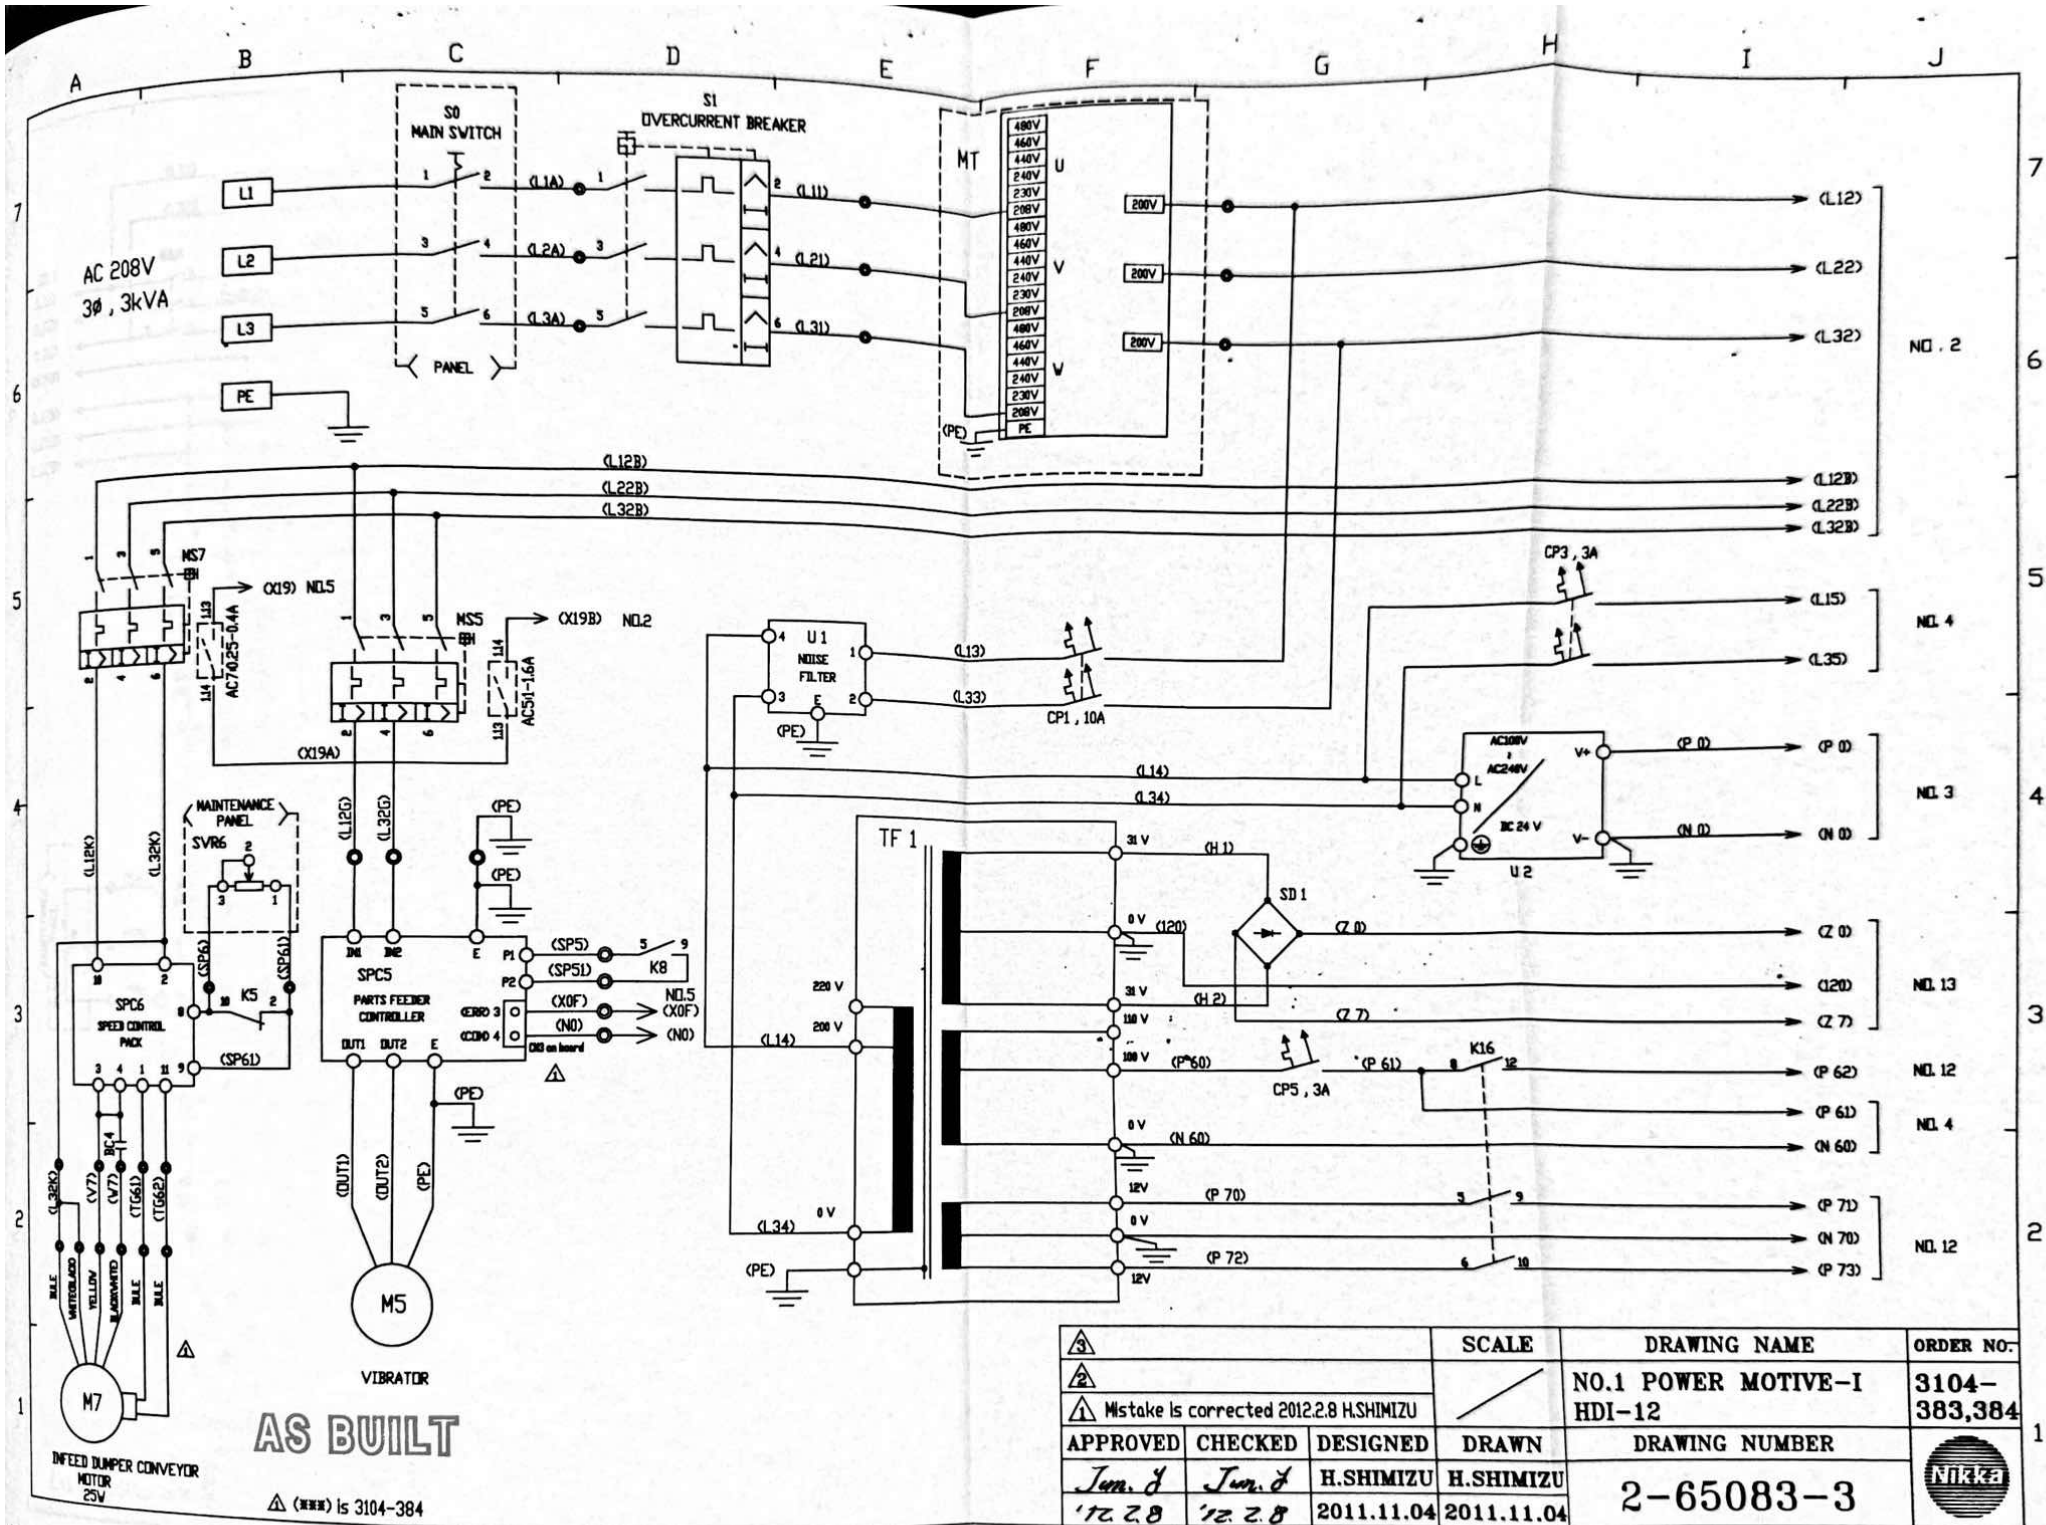

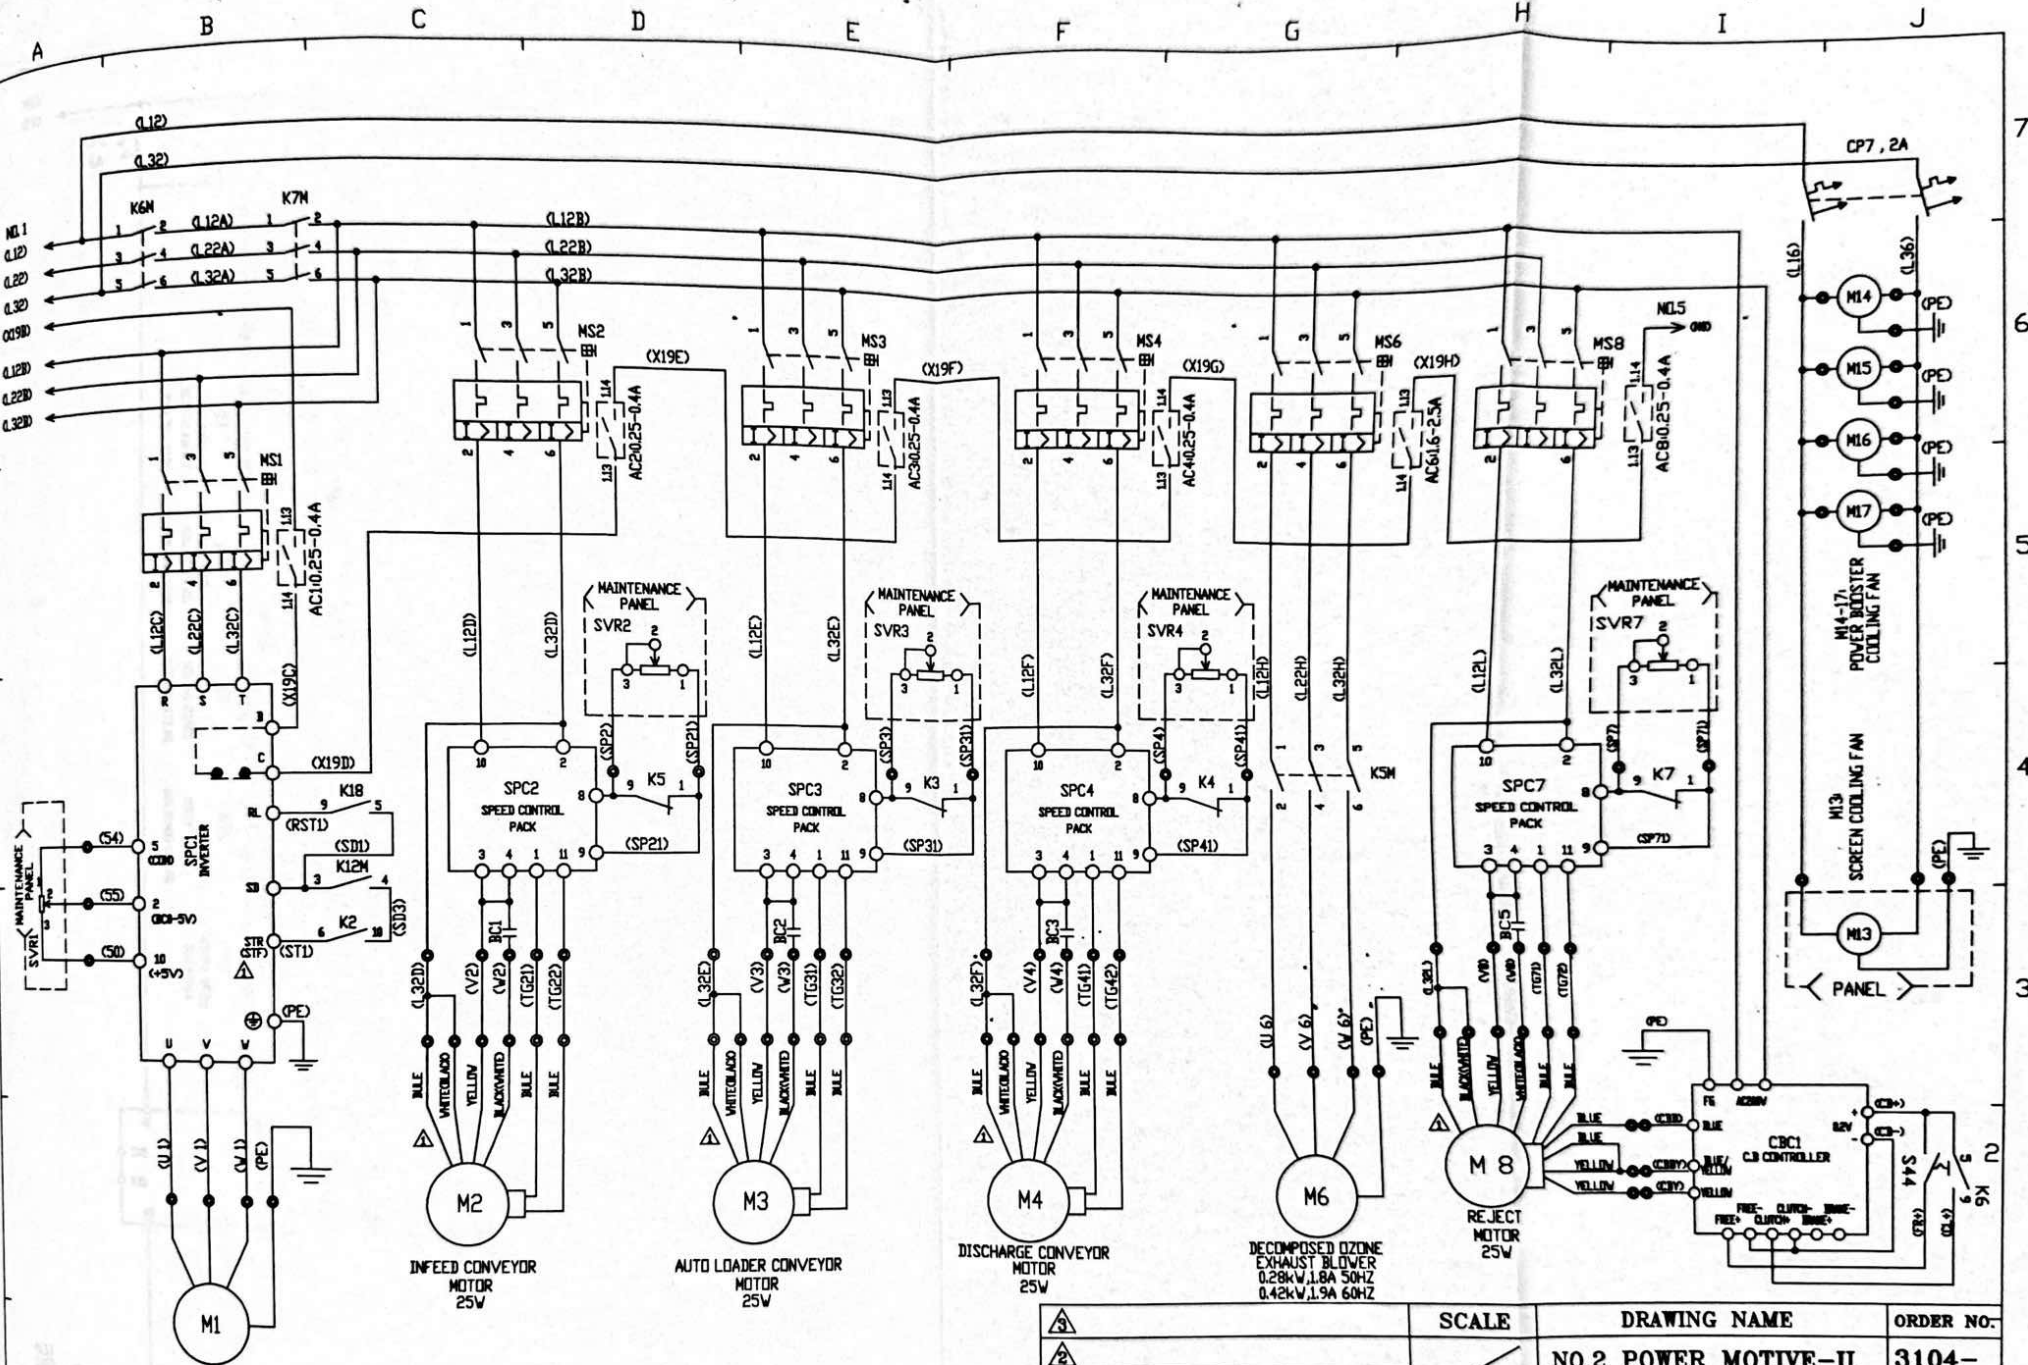

AS BUILT

Δ (REV) Is 3104-384

<div> <div>3</div> <div>2</div> <div>Mistake is corrected 2012.2.8 H.SHIMIZU</div> </div>		SCALE	DRAWING NAME	ORDER NO.
APPROVED	CHECKED	DESIGNED	DRAWN	
Jun. 8 '12.2.8	Jun. 8 '12.2.8	H.SHIMIZU	H.SHIMIZU	
2-65084-3 Δ				3104-383,384
Nikka				

