

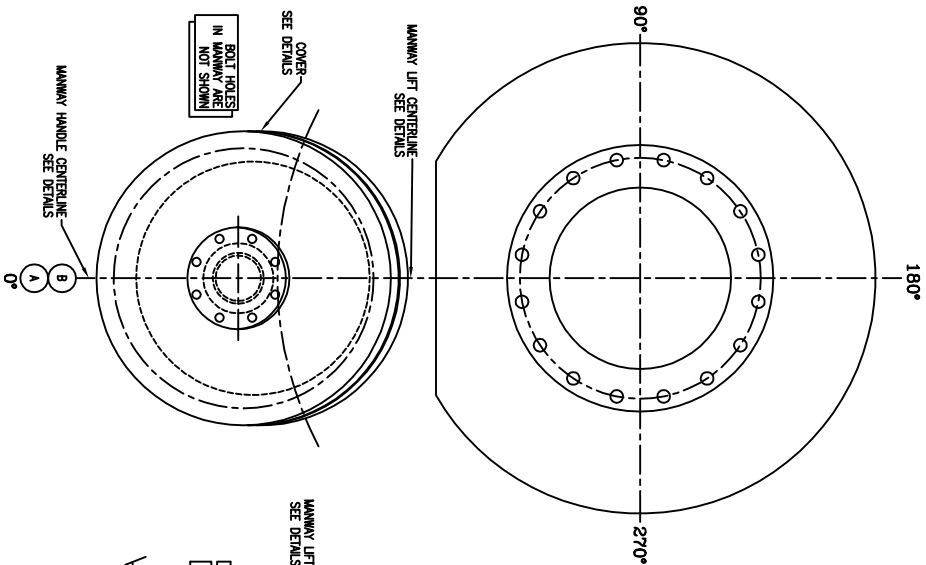



MANWAY 'A' SIGHT GLASS ASSEMBLY
SCALE: 1 1/2"=12"

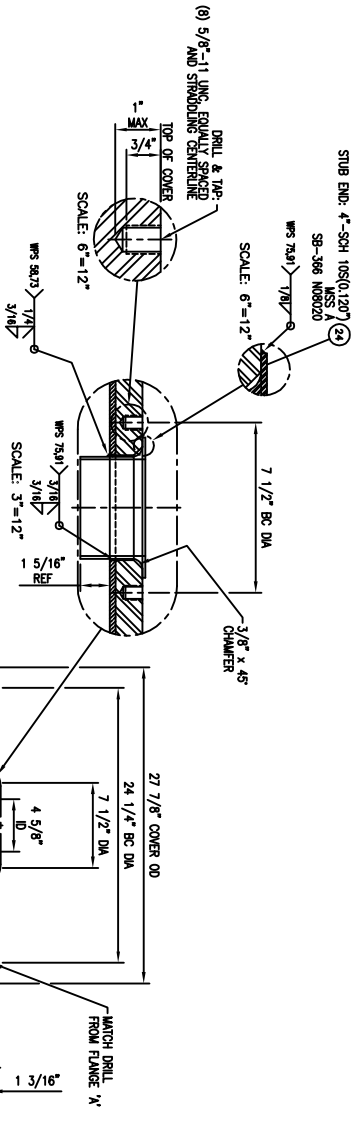


MANWAY 'A' COVER DETAILS
SCALE: 1 1/2"=12"

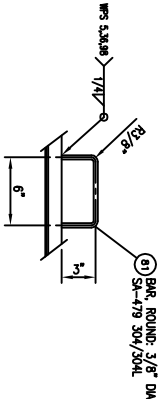



MANWAY HANDLE DETAIL
SCALE: 1 1/2"=12"

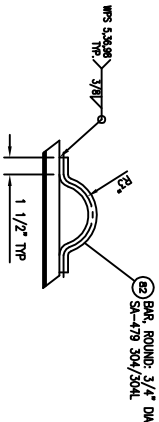

MANWAY LIFT DETAIL
SCALE: 1 1/2"=12"

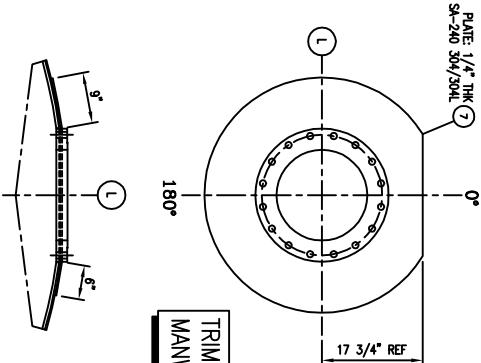

NOZ 'L' REPAD DETAILS
SCALE: 3/4"=12"

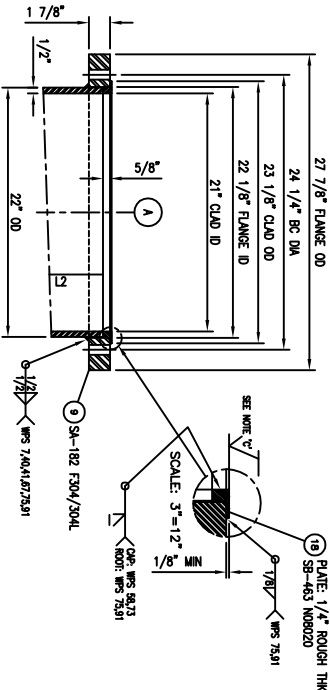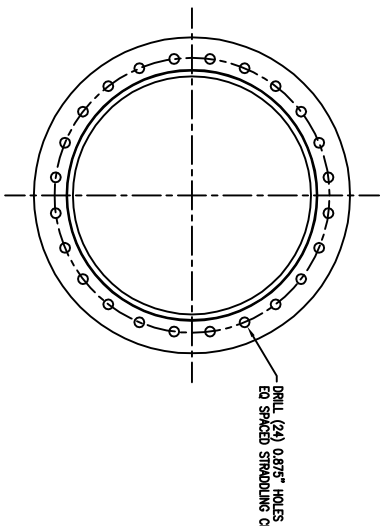

MANWAY 'A' FLANGE DETAILS
SCALE: 1 1/2"=12"

AS-BUILT PRINT
WARD TANK AND
HEAT EXCHANGER CORP
By: WIETLE
Date: 2/2/2014

REV NO	DATE	DESCRIPTION	BY
1	2/7/2014	REVISED PER CUSTOMER COMMENTS/	
0	1/10/14	FOR CUSTOMER APPROVAL	

WARD TANK AND
HEAT EXCHANGER CORP
9870 E. HARRIS BLVD
CHARLOTTE, NC 28213

TITLE			
HYDROLYSIS KETTLE No. 5			
CUSTOMER			
SOUTHA		PURCHASE ORDER NUMBER	
TRENTON, MI		42234701	
EQUIPMENT NO. 145			
SCALE AS NOTED			
NO REV'D 1			
APPROVED			
DATE			
DRAWING NUMBER			
REL. NO. 1			
DATE 1/9/2014			
2013-WC-8883			
SHEET 3 OF 3			