



4/23/2018 12:43:26 PM
X: MOORE CONTROL SYSTEMS - MARATHON SCRIBBLES 18165.DWG

ITEM	QUANTITY	MATERIAL	DESCRIPTION	NORMALIZED	IMPACT TEST	PWHT
1	2	SA-516 70	CYLINDER - 48" OD x 3/8" WALL x 10'-0" LG	NO	NO	NO
2	2	SA-516 70	2:1 HEAD - 48" OD x 5/16" MIN (3/8" NOM) THICK, 2" SF, SF MIN THK = .3007"	NO	NO	NO
3	1	SA-516 70	SKIRT - 40" OD x 1'-6" LONG x 1/4" WALL	NO	NO	NO
4	1	SA-105	NOZZLE FLANGE - 18" 150# RF SO WITH BLIND FLANGE/GASKET AND BOLTING	NO	NO	NO
5	2	SA-105	NOZZLE FLANGE - 6" 150# RFWN, BORE = SCH 80	NO	NO	NO
6	3	SA-105	CPLG - 0.5" 6000# FULL CPLG	NO	NO	NO
7	1	SA-105	CPLG - 0.5" 6000# CPLG x 3" LG (TOE)	NO	NO	NO
8	1'-6"	SA-106 B SMLS PIPE	NOZZLE NECK - 2" SCH 80	NO	NO	NO
9	1	SA-105	CPLG - 2" 3000# CPLG x 6" LG (TOE)	NO	NO	NO
10	2	SA-105	CPLG - 2" 3000# FULL CPLG	NO	NO	NO
11	1	SA-105	CPLG - 3" 3000# FULL CPLG	NO	NO	NO
12	1'-2"	SA-106 B SMLS PIPE	NOZZLE NECK - 6" SCH 80	NO	NO	NO
13	1'-0"	SA-106 B SMLS PIPE	NOZZLE NECK - 18" SCH 80	NO	NO	NO
14	1	SA-516 70	REINFORCEMENT PAD - 10.625" OD x .375" THK (TOP HEAD)	NO	NO	NO
15	1	SA-516 70	REINFORCEMENT PAD - 22" OD x .375" THK	NO	NO	NO
16	1	SA-234-WPB	WELDELL - 2" SCH 80 L.R. 90°	NO	NO	NO
17	1	SA-234-WPB	WELDELL - 6" SCH 80 45°	NO	NO	NO
18	2	SA-105	CPLG - 0.75" 6000# FULL CPLG	NO	NO	NO

CONSTRUCTION DETAIL	
DESCRIPTION	DATA
MAWP (INT) @ DESIGN TEMP.	250 PSI @ 150°F
MDMT @ MAWP	-20/ @ 250 PSI
MAWP LIMITED BY	DESIGN
HYDROSTATIC TEST	325 PSI
CORROSION ALLOWANCE	0"
RADIOGRAPHY	RT-2
PWHT	NONE
CODE CASE(S)	NONE
CODE STAMP REQ'D	YES
NT'L BOARD REQ'D	YES
CONSTRUCTION CODE	ASME SEC. VIII DIV.1 2017
WPS(S)	BY MCSI
WIND CODE	ASCE-7 10
SEISMIC CODE	ASCE-7 10
WEIGHT	5,208 LBS

SERIAL NO.	SERVICE	NB NO.
18165-1	VERTICAL 2-PHASE SEPARATOR	1
18165-2	VERTICAL 2-PHASE SEPARATOR	2
18165-3	VERTICAL 2-PHASE SEPARATOR	3
18165-4	VERTICAL 2-PHASE SEPARATOR	8
18165-5	VERTICAL 2-PHASE SEPARATOR	7
18165-6	VERTICAL 2-PHASE SEPARATOR	14
18165-7	VERTICAL 2-PHASE SEPARATOR	15
18165-8	VERTICAL 2-PHASE SEPARATOR	16
18165-9	VERTICAL 2-PHASE SEPARATOR	19
18165-10	VERTICAL 2-PHASE SEPARATOR	17

C15 OIL LEVEL HIGH	.75	CPLG	6000#	3	1.05	.35	25	—	—	.5	4	.375	.375	.25	—	—			
C14 WATER LEVEL LOW	.75	CPLG	6000#	3	1.05	.35	25	—	—	.5	4	.375	.375	.25	—	—			
C13 RELIEF	2	CPLG	3000#	3	2.375	.3125	25	—	—	1.875	4	.375	.375	.25	—	—			
C10 WATER LLC	2	CPLG	3000#	3	2.375	.3125	25	—	—	1.875	4	.375	.375	.25	—	—			
C8 PI	0.5	CPLG	6000#	3	.84	.33	25	—	—	.5	4	.375	.375	.25	—	—			
C7 SAFETY HEAD	2	CPLG	3000#	3	2.375	.3125	ELEV	—	—	.25	4	.375	.3125	.25	—	—			
C6 GAS OUTLET	6	RFWN	150#	2	5.761	.432	ELEV	.375	10.625	.5	11	.375	.3125	.375	.3125	—			
C5 DRAIN	2	CPLG	3000#	SEE DETAIL															
C4 SUPPLY GAS	0.5	CPLG	6000#	3	.84	.33	ELEV	—	—	.25	4	.375	.3125	.25	—	—			
C3B GAUGE GLASS	0.5	CPLG	6000#	3	.84	.33	25	—	—	.5	4	.375	.375	.25	—	—			
C3A GAUGE GLASS	0.5	CPLG	6000#	3	.84	.33	25	—	—	.5	4	.375	.375	.25	—	—			
C2 WATER OUTLET	3	CPLG	3000#	3	3.5	.375	25	—	—	1.75	4	.375	.375	.25	—	—			
C1 INLET	6	RFWN	150#	3	5.761	.432	30	—	—	2	4	.375	.375	.375	—	—			
M1 MANWAY	18	RF SO	150#	4	16.124	.938	30	.375	22	.75	11	.375	.3125	.375	.375	—			
MARK	IDENTIFIER	SIZE	TYPE	CLASS	TYPE	A	B	C	D	E	F	TYPE	A	B	C	D	E		
		FLANGE			NOZZLE STYLE										WELD				
		NOZZLE SCHEDULE																	

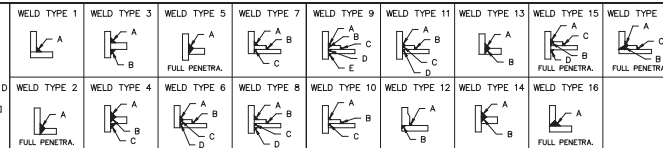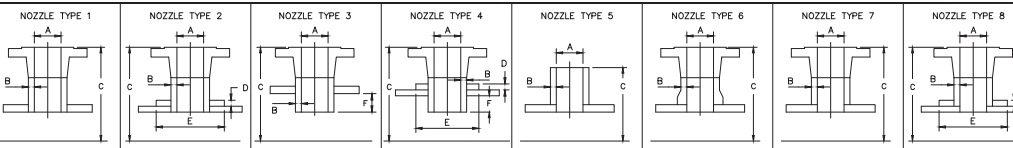

--	--	
THIS DOCUMENT IS CONFIDENTIAL AND IS THE PROPERTY OF MOORE CONTROL SYSTEMS, INC. IT MAY NOT BE COPIED OR REPRODUCED IN ANY WAY WITHOUT THE EXPRESS WRITTEN CONSENT OF MOORE CONTROL SYSTEMS, INC. THIS DOCUMENT ALSO IS AN UNPUBLISHED WORK OF MOORE CONTROL SYSTEMS, INC. MOORE CONTROL SYSTEMS, INC. INTENDS TO, AND IS MAINTAINING THE WORK AS CONFIDENTIAL INFORMATION. MOORE CONTROL SYSTEMS, INC. ALSO MAY SEEK TO PROTECT THIS WORK AS AN UNPUBLISHED COPYRIGHT. IN THE EVENT OF EITHER INADVERTENT OR DELIBERATE PUBLICATION, MOORE CONTROL SYSTEMS, INC. INTENDS TO ENFORCE ITS RIGHTS TO THIS WORK UNDER THE COPYRIGHT LAWS AS A PUBLISHED WORK. THOSE HAVING ACCESS TO THIS WORK MAY NOT COPY, USE, OR DISCLOSE THE INFORMATION IN THIS WORK UNLESS EXPRESSLY AUTHORIZED BY MOORE CONTROL SYSTEMS, INC.

MCSI MOORE CONTROL SYSTEMS, INC.
KATY, TEXAS


(281) 392-7747

WWW.MOORE-CONTROL.COM

CUSTOMER
MARATHON OIL CO.

CARLSBAD, NEW MEXICO
DATE/CUSTOMER JOB NO
18165-XXXX SHT 1

VERTICAL 2 PHASE SEPARATOR
FABRICATION DRAWING
DRAWN BY MLR DATE 1/22/18 SCALE 1" = 1'-0" MCSI JOB NO 18165
SHEET 1 OF 2 REV 2

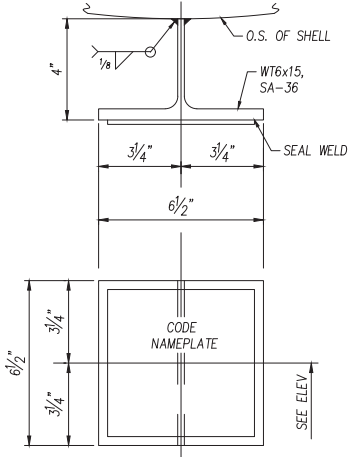

18" * SEE TABLE

CERTIFIED BY: **MCSI** MOORE CONTROL SYSTEMS, INC.
OPTIONAL: U W RT-2

MAWP: 250 PSI @ 150 ° F
MDMT: -20 ° F @ 250 PSI

2018 S/N: * SEE TABLE
YEAR BUILT TAG:

VERTICAL 2 PHASE SEPARATOR
48" O.D. x 20'-0" S/S | CA: 0"



ALL DIMENSIONS ARE
MEASURED FROM THIS LINE
UNLESS NOTED OTHERWISE

ISSUED FOR CONSTRUCTION 1
MCSI # 18165 DATE: 3/20/18

THIS DOCUMENT IS CONFIDENTIAL AND IS THE PROPERTY OF MOORE CONTROL SYSTEMS, INC. IT MAY NOT BE COPIED OR REPRODUCED IN ANY WAY WITHOUT THE EXPRESS WRITTEN CONSENT OF MOORE CONTROL SYSTEMS, INC. THIS DOCUMENT ALSO IS AN UNPUBLISHED WORK OF MOORE CONTROL SYSTEMS, INC. MOORE CONTROL SYSTEMS, INC. INTENDS TO, AND IS MAINTAINING THE WORK AS AN UNPUBLISHED WORK OF MOORE CONTROL SYSTEMS, INC. ANY DISCLOSURE OF THIS WORK AS AN UNPUBLISHED COPYRIGHT, IN THE EVENT OF EITHER INADVERTENT OR DELIBERATE PUBLICATION, MOORE CONTROL SYSTEMS, INC. INTENDS TO ENFORCE ITS RIGHTS TO THIS WORK UNDER THE COPYRIGHT LAW AS A PUBLISHED WORK. ACCESS TO THIS WORK MAY NOT COPY, USE, OR DISCLOSE THE INFORMATION IN THIS WORK UNLESS EXPRESSLY AUTHORIZED BY MOORE CONTROL SYSTEMS, INC.

(281) 392-7747

WWW.MOORE-CONTROL.COM


CUSTOMER	MARATHON OIL CO
----------	-----------------

AFE/CUSTOMER JOB NO	
---------------------	--


VERTICAL 2 PHASE SEPARATOR FABRICATION DRAWING			
DRAWN BY MLR	DATE 1/22/18	SCALE *	MCS JOB 1816
DRAWING NO 18165-XXXX SHT 2		SHEET 2 OF	

4/23/2018 12:43:27 PM


X:\MOORE CONTROL SYSTEMS\18165 - MARATHON SCRIBBER\18165.DWG

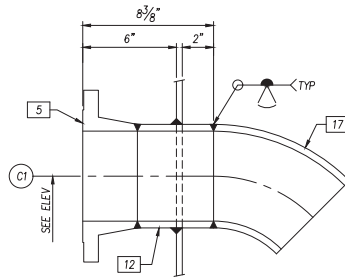


DETAIL OF 6" 150# NOZZLE MK "C1"
ONE (1) REQ'D

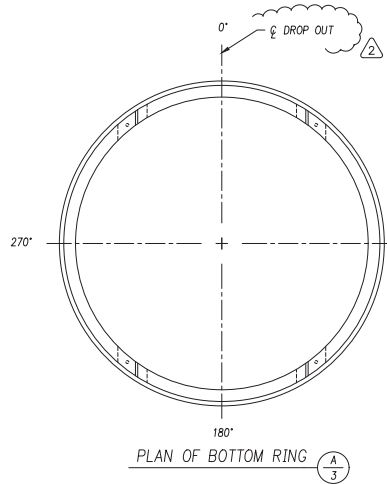


PLAN OF BOTTOM RING
A 3

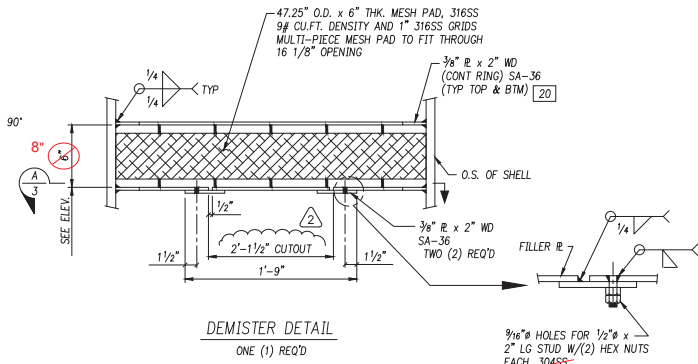

DEMISTER DETAIL
ONE (1) REQ'D

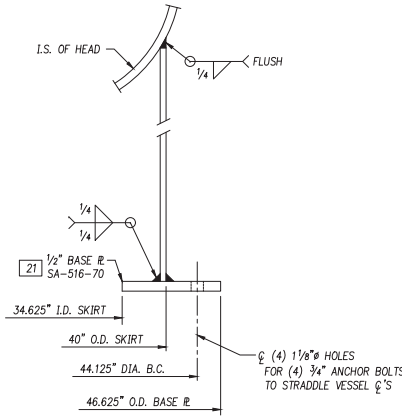


SKIRT & BASEPLATE DETAIL

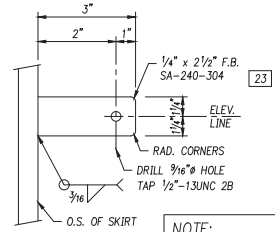


GROUNDING LUG DETAIL
ONE (1) REQ'D


NOTE:
DO NOT PAINT
GROUND LUG

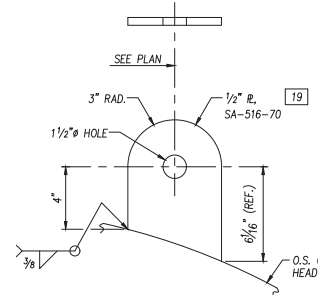

LIFTING LUG DETAIL
TWO (2) REQ'D

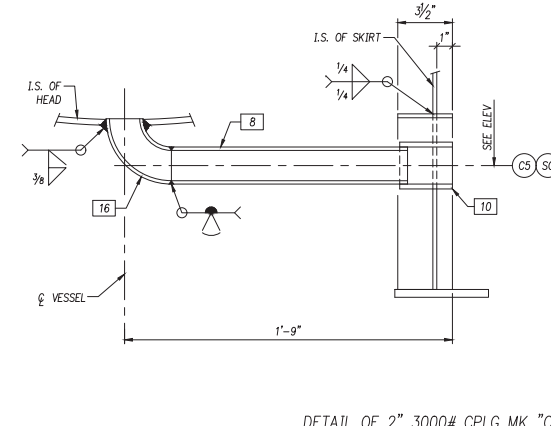

DETAIL OF 2" 3000# CPLG MK "C5" & SKIRT SLEEVE MK "SO"
ONE (1) REQ'D

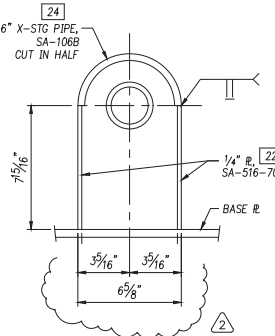

AS BUILT

ISSUED FOR CONSTRUCTION
MCSI# 18165 DATE: 4/23/18


THIS DOCUMENT IS CONFIDENTIAL AND IS THE PROPERTY OF MOORE CONTROL SYSTEMS, INC. IT MAY NOT BE COPIED OR REPRODUCED IN ANY WAY WITHOUT THE EXPRESS WRITTEN CONSENT OF MOORE CONTROL SYSTEMS, INC. THIS DOCUMENT ALSO IS AN UNPUBLISHED WORK OF MOORE CONTROL SYSTEMS, INC. MOORE CONTROL SYSTEMS, INC. INTENDS TO, AND IS MAINTAINING THE WORK AS CONFIDENTIAL INFORMATION. MOORE CONTROL SYSTEMS, INC. ALSO MAY SEEK TO PROTECT THIS WORK AS AN UNPUBLISHED COPYRIGHT. IN THE EVENT OF EITHER INADVERTENT OR DELIBERATE PUBLICATION, MOORE CONTROL SYSTEMS, INC. INTENDS TO ENFORCE ITS RIGHTS TO THIS WORK UNDER THE COPYRIGHT LAWS AS A PUBLISHED WORK. THOSE HAVING ACCESS TO THIS WORK MAY NOT COPY, USE, OR DISCLOSE THE INFORMATION IN THIS WORK UNLESS EXPRESSLY AUTHORIZED BY MOORE CONTROL SYSTEMS, INC.

MCSI MOORE CONTROL SYSTEMS, INC.
KATY, TEXAS




(281) 392-7747 WWW.MOORE-CONTROL.COM

CUSTOMER
MARATHON OIL CO.
DATE/CUSTOMER JOB NO
CARLSBAD, NEW MEXICO

VERTICAL 2 PHASE SEPARATOR
FABRICATION DRAWING
DRAWN BY
MLR
DATE
2/14/18
SCALE
1" = 6"
SHEET
3 OF 3
REV
2

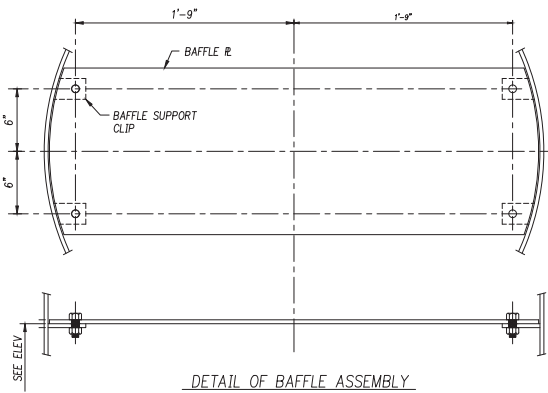


DETAIL OF BAFFLE ASSEMBLY

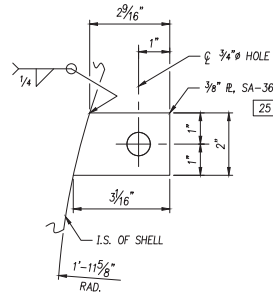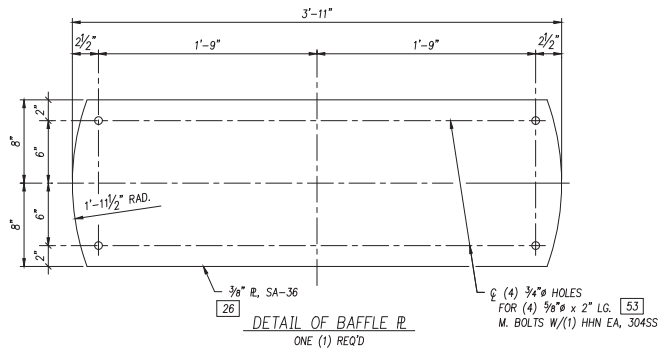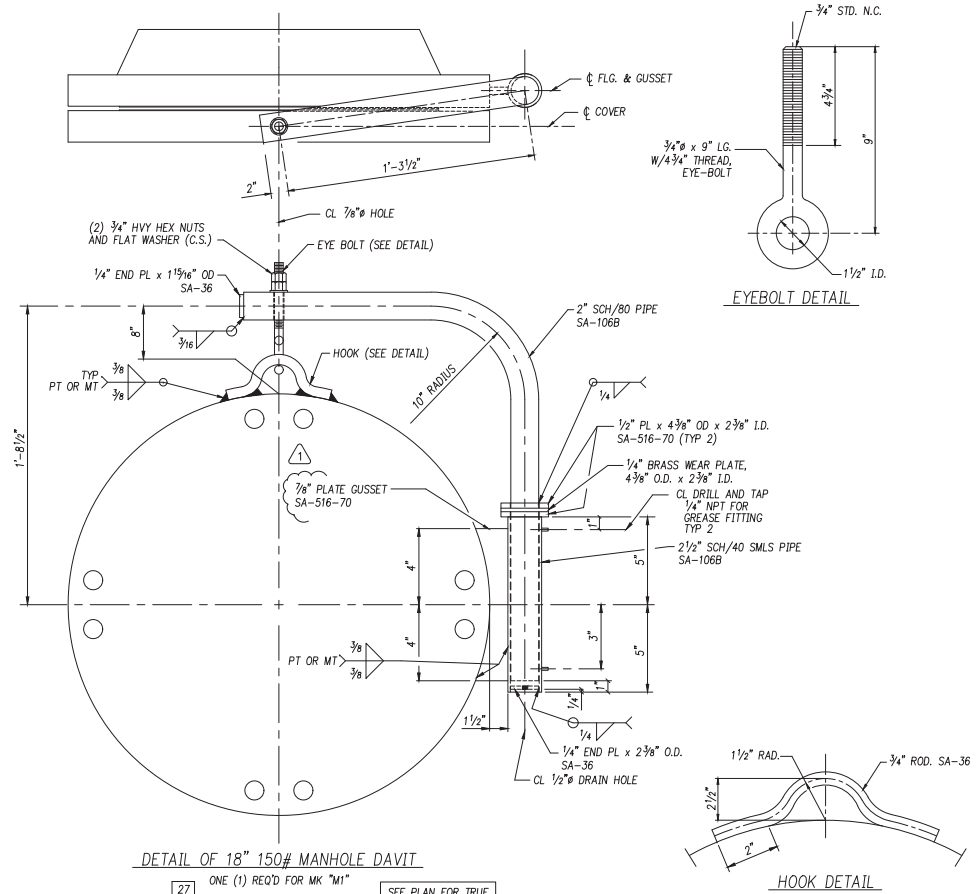DETAIL OF BAFFLE SUPPORT CLIP
FOUR (4) REQ'DDETAIL OF BAFFLE R.
ONE (1) REQ'D

DETAIL OF 18" 150# MANHOLE DAVIT

ONE (1) REQ'D FOR MK "M1"

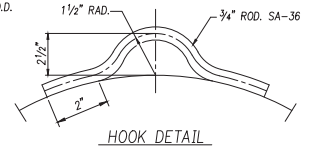SEE PLAN FOR TRUE
DAVIT ORIENTATION

HOOK DETAIL

AS BUILT**ISSUED FOR
CONSTRUCTION**

MCSI# 18165 DATE: 4/23/18

REFERENCE DRAWING	DRAWING DESCRIPTION	NO	REVISION DESCRIPTION	DATE	BY	CWD
1	REVISED AS BUILT	4/23/18	MLR	RR		
0	ISSUED FOR CONSTRUCTION	3/20/18	MAK	RR		
A	ISSUED FOR APPROVAL	2/14/18	MLR	RR		

THIS DOCUMENT IS CONFIDENTIAL AND IS THE PROPERTY OF MOORE CONTROL SYSTEMS, INC. IT MAY NOT BE COPIED OR REPRODUCED IN ANY WAY WITHOUT THE EXPRESS WRITTEN CONSENT OF MOORE CONTROL SYSTEMS, INC. THIS DOCUMENT ALSO IS AN UNPUBLISHED WORK OF MOORE CONTROL SYSTEMS, INC. MOORE CONTROL SYSTEMS, INC. INTENDS TO, AND IS MAINTAINING THE WORK AS CONFIDENTIAL INFORMATION. MOORE CONTROL SYSTEMS, INC. ALSO MAY SEEK TO PROTECT THIS WORK AS AN UNPUBLISHED COPYRIGHT. IN THE EVENT OF EITHER INADVERTENT OR DELIBERATE PUBLICATION, MOORE CONTROL SYSTEMS, INC. INTENDS TO ENFORCE ITS RIGHTS TO THIS WORK UNDER THE COPYRIGHT LAWS AS A PUBLISHED WORK. THOSE HAVING ACCESS TO THIS WORK MAY NOT COPY, USE, OR DISCLOSE THE INFORMATION IN THIS WORK UNLESS EXPRESSLY AUTHORIZED BY MOORE CONTROL SYSTEMS, INC.

MCSI MOORE CONTROL SYSTEMS, INC.
KATY, TEXAS

(281) 392-7747

WWW.MOORE-CONTROL.COM

CUSTOMER
MARATHON OIL CO.

CARLSBAD, NEW MEXICO
ATE/CUSTOMER JOB NO

VERTICAL 2 PHASE SEPARATOR
FABRICATION DRAWING
DRAWN BY MLR DATE 2/14/18 SCALE 1" = 1'-0" MCSI JOB NO 18165
DRAWING NO 18165-XXXX SHT 4 OF 4 REV 1