


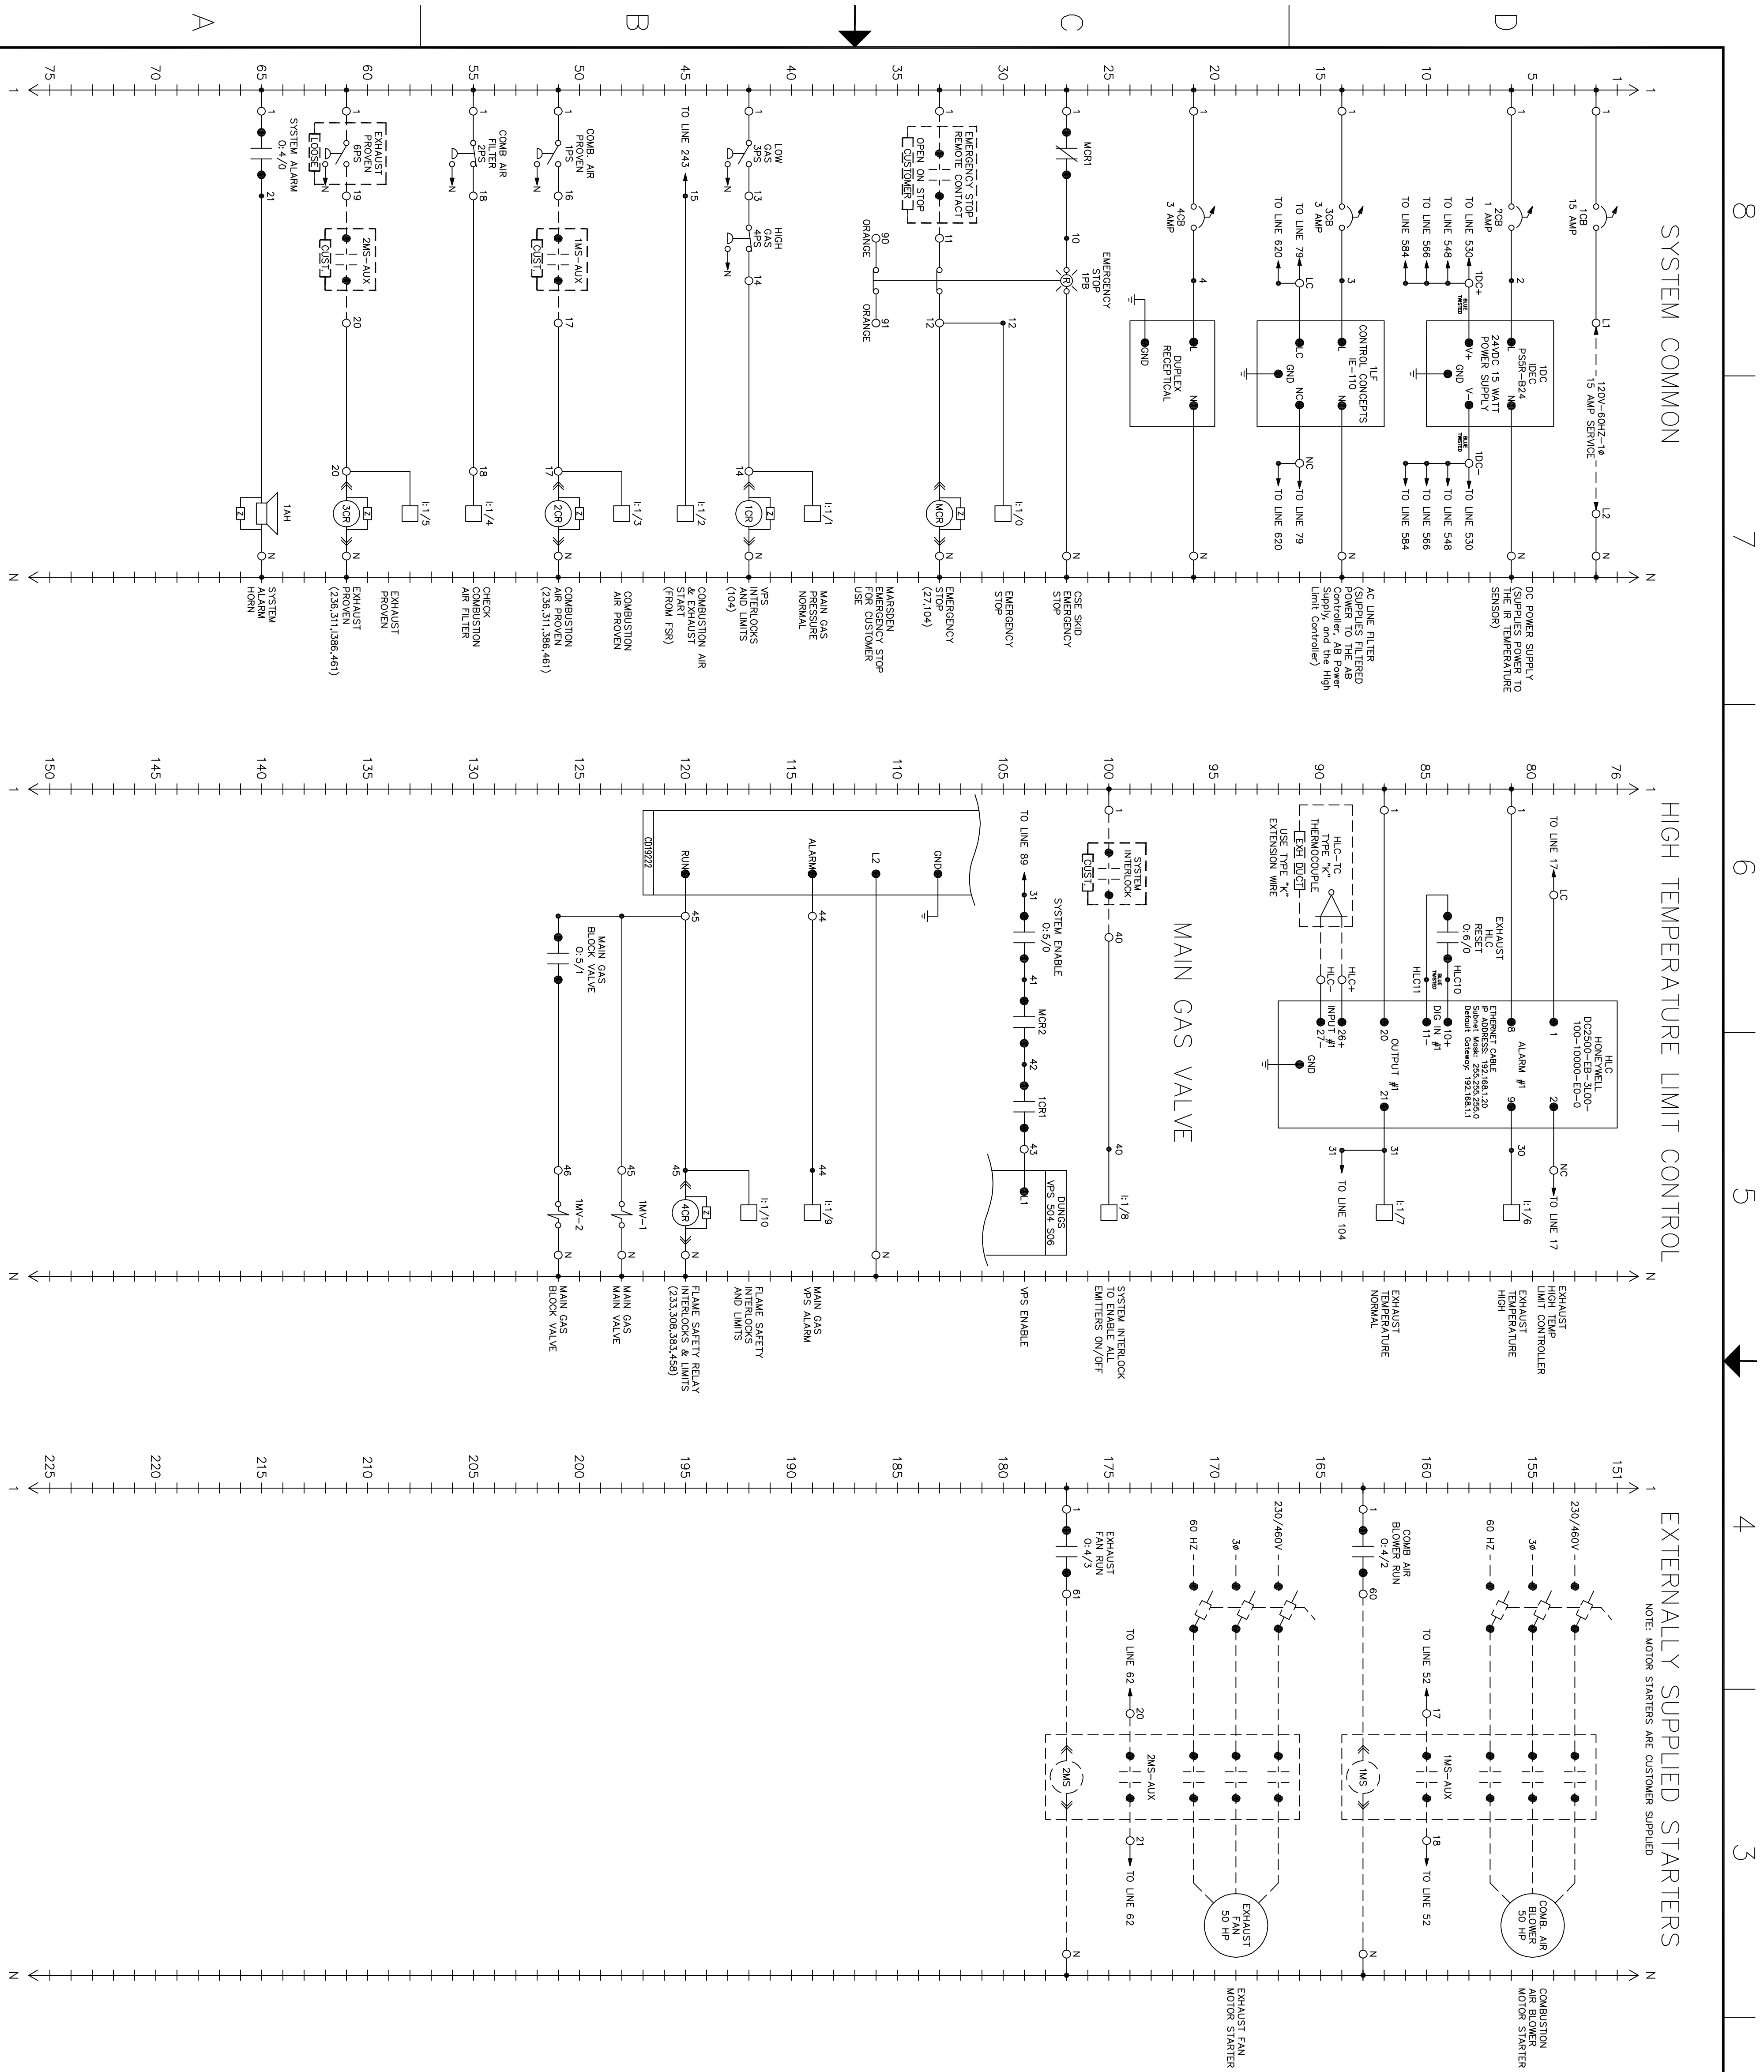

REVISIONS				
REV	CON #	DESCRIPTION OF CHANGE	RECEIVED BY	DATE
1	12-07	ISSUE CERTIFIED DRAWINGS WITH REVISIONS	WP	06/04/2012
8	12-09	ISSUE AS-BUILT DRAWINGS	WP	06/06/2012

- 1) —○— TERMINAL BLOCK CONNECTIONS.
- 2) ——— INTERNAL WIRING COMPLETE.
- 3) ——— EXTERNAL FIELD WIRING TO BE COMPLETED/CUSTOMER SUPPLIED ITEMS
- 4) ——— DENOTES FIELD DEVICE LOCATION.
- 5) GROUND SUBPANEL TO BURNER PIPING.
- 6) USE NO. 14 AWG TW-19 STRAND, 1/32 INSULATION, MACHINE TOOL WIRING, UNLESS OTHERWISE SPECIFIED.
- 7) GROUND SEPARATELY AND DIRECTLY IN ACCORDANCE WITH ALL LOCAL CODES.
- 8) RELAY CONTACTS ARE SHOWN IN THEIR DE-ENERGIZED STATE.
- 9) INSTALL ALL FLAME ROD WIRES IN NON-METALLIC CONDUIT WITH NO OTHER WIRING. EVERY EFFORT SHOULD BE MADE TO MINIMIZE THE LENGTH OF THE WIRE RUN.
- 10) (MAX. LENGTH 50 FT)
INSTALL SPARK PLUG WIRES IN SEPARATE CONDUITS (MAX. LENGTH 15 FT).
- 11) ——— HIGH TEMPERATURE FIELD WIRING (SEE MARSDEN SPECIFICATION SP-102).
- 12) ——— ALL SCHEMATICS DRAWN IN LIGHT BROKEN LINES ARE NOT SUPPLIED IN THIS DESIGN AND FOR FUTURE REF. ONLY.

STAMP AREA	RELEASED ON _____
AS-BUILT	PLEASE SIGN AND RETURN BY _____ OR
	DELIVERY WILL BE AFFECTED

AS-BUILT

STAMP AREA

RELEASED ON _____
PLEASE SIGN AND RETURN
BY _____ OR _____

DELIVERY WILL BE AFFECTED

This print is the property of Marsden Inc. and is subject to recall on demand, and use, disclosure, reproduction, tracing, or use of information contained herein, without prior written approval of Marsden Inc. is prohibited.

inches
 (pt. 08 notes)
WILKSDEIN
 6800 WESTFIELD AVE
 PENNSAUKEN, NJ 08110-1532 USA
 Quality System Registered Acco