



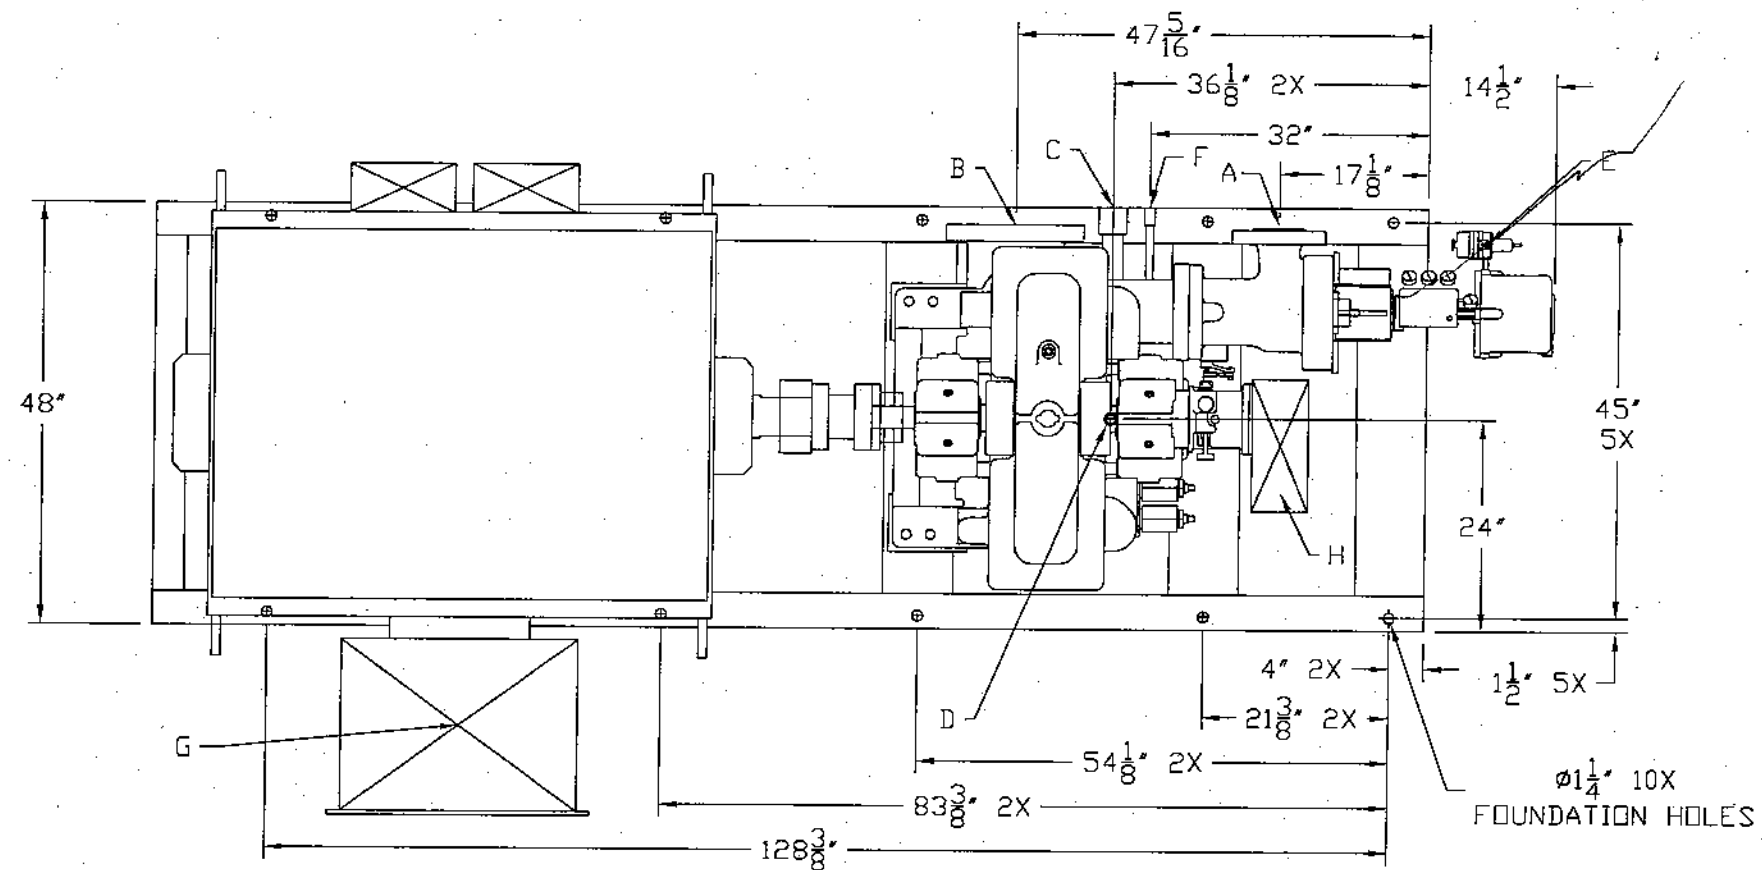

- SITE CONNECTIONS:
- A - STEAM INLET - 4" 600# RF
 - B - STEAM EXHAUST - 10" 300 RF
 - C - STEAM ATMOSPHERIC VENT - 2" NPTF
 - D - CONDENSATE GRAVITY DRAIN - 1" NPTF
 - E - CONTROL AIR - 3/8" NPTF
 - F - COOLING WATER INLET - 1/2" NPTF
 - G - POWER CONDUIT ENTRY - 3" NPTF X 2
 - H - CONTROL CONDUIT ENTRY - FIELD INSTALLED

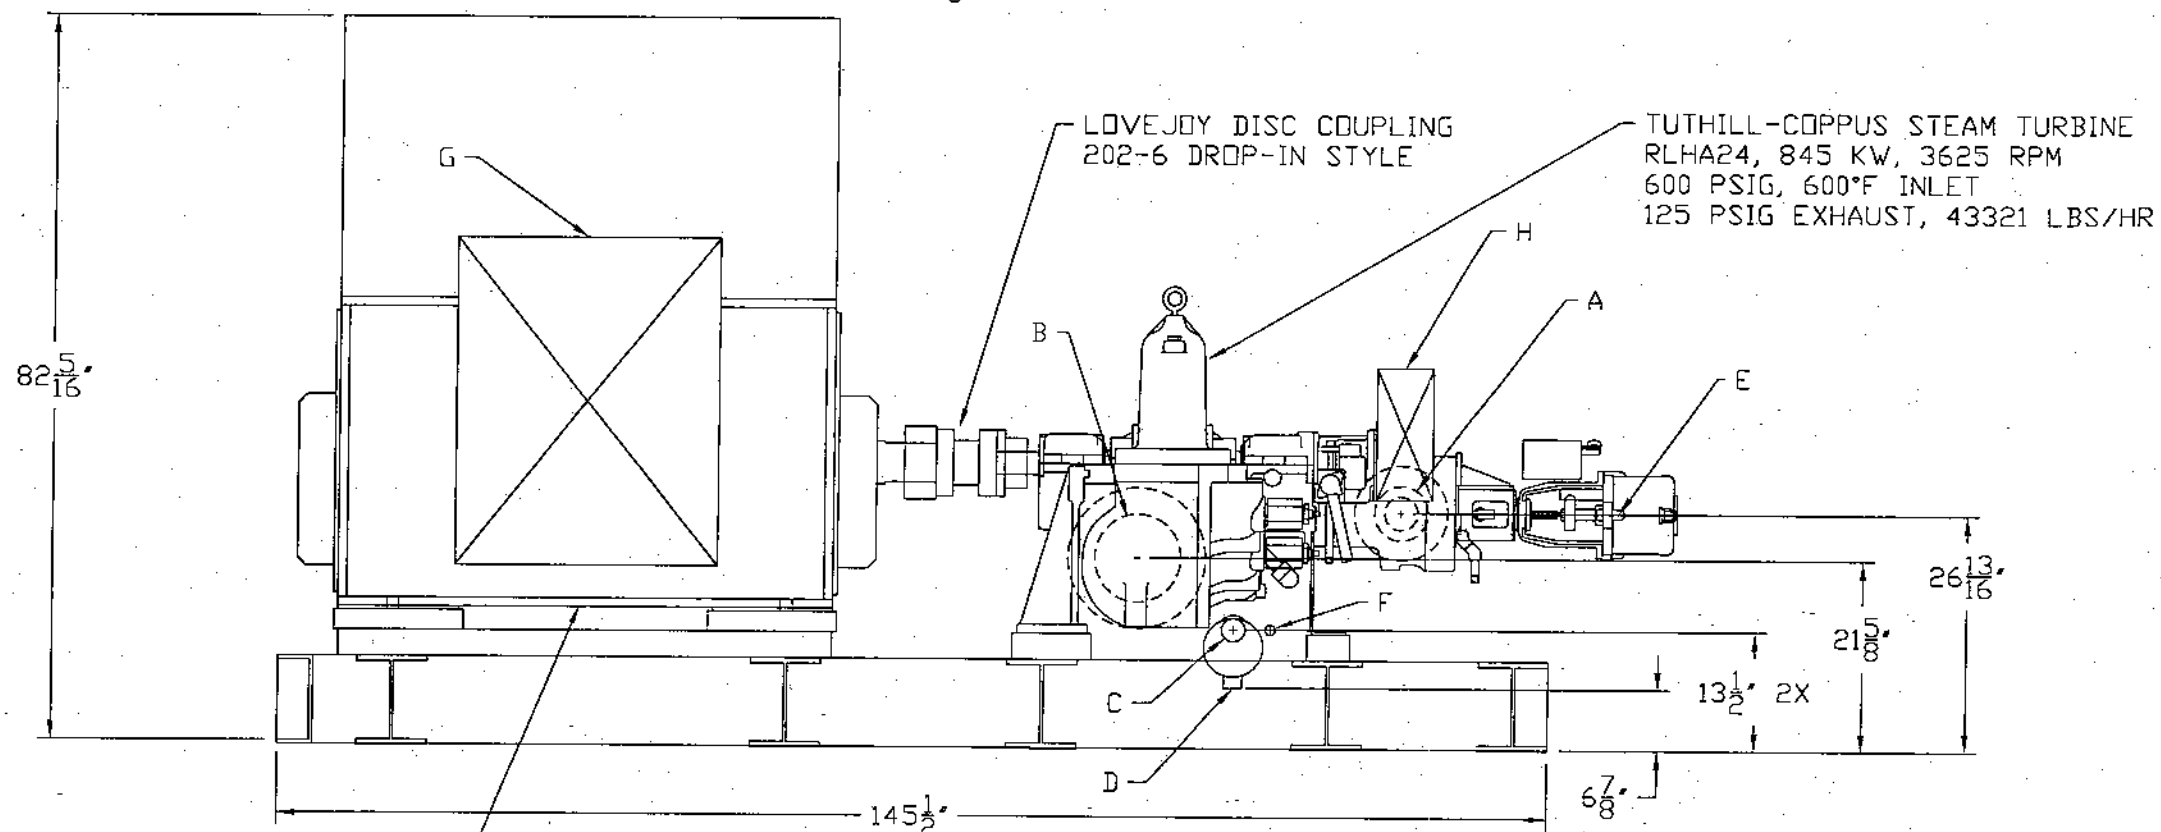

NOTES:

APPROXIMATE WEIGHT - 15,000 LBS

SEE PROCESS AND INSTRUMENTATION DRAWING FOR CONNECTION CAPACITIES

FOUNDATION HOLES THROUGH LOWER FLANGE ONLY

PIPING CONNECTION DIMENSIONS MAY VARY AFTER ASSEMBLY

GENERATOR TERMINAL BOX AND NOISE HOOD TO BE REMOVED FOR RIGGING

WEG INDUCTION GENERATOR
2 POLE, 900 KW, 480 V
3 PH, 60 HZ, 3625 RPM



161 INDUSTRIAL BLVD., TURNERS FALLS, MA 01376

SCHWEITZER-LEE
EQUIPMENT ASSEMBLY
DRAWING

DRAWN BY: SJS		DATE: 12/19/03	
CHECKED BY: SJS		SIZE: B	SHEET: 1 OF 1
SCALE: NTS		DWG NO: 03154-ASSY	REV 0
REV	DESCRIPTION	DATE	BY
0	FABRICATION AS BUILT	03/29/04	SJS
REVISIONS			