

[illegible]


NOTE:
BASIC NOTES.
1. 1/2" PLUGGED SAMPLE POINTS TO BE PROVIDED.

AS-BUILT
DATE FEB 14 2005

EFX Compression

TITLE: SERVICE FLOW
ENGINEER GLYCOL SYSTEM
ARIEL JGK/4, CAT. G3516TALE, AXC 132EH
MUSKY OIL

FOR:		LSD: 13-29-33-21 W44M	
TOLMAN		JOB No.: Q40655	
CONSULTANT:		DWG. No.	
P.O.:		DATE: 04/10/01	
DRAWN BY: SS	DESIGN BY: SS	DATE: 7/2/11	
CHECKED BY: MA	APPROVED BY: MA	SF-Q40655-24	
SCALE: NTS		2	

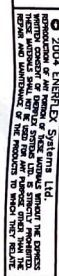


NOTE:
1. 1/2" PLUGGED SAMPLE POINTS TO BE PROVIDED.

EFX Compression


REV	DESCRIPTION	DATE	DRAWN BY	CHECKED BY
3	AS BUILT	03/01/07	NSP	
2	CORRECTED INSTRUMENTATION	04/11/17	NOS	
1	ISSUED FOR CONSTRUCTION	04/01/06	MCN	
0	ISSUED FOR APPROVAL	04/09/28	CSF	

LSD: 13-29-33-21 WAM
JOB No.: 040656

DESCRIPTION	SHEAVE Ø	RPM
ENGINE SHAFT	9.75"	1200
JACK SHAFT		
ENGINE END	16.4"	576
COOLER END	13.4"	
DILER	9.6"	N/A
COOLER END		
COOLER SHAFT	36.0"	256

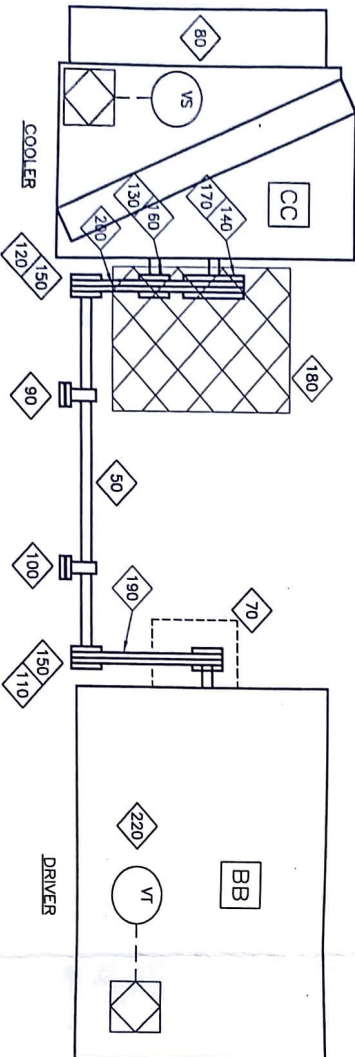

ITEM QTY	EFFX CODE	DESCRIPTION
20	1	COUPLING, ADAPTER PLATE 26.5" OD 10/32" C/P 31L HUB, 98 (FOURPIECES, F3900)
50	1	JACKSHAF 2-15/16" DIA. C/P 3/4" X 3/16" X 8" ACTVAT 8 BORN ENDS (61--84)
60	1	GUARD, COUPLING, ALUMINUM, NON-SPRANGING
70	1	ENGINE DRIVE BELT GUARD, ALUMINUM, NON-SPRANGING
80	1	SWITCH, VIBRATION, ELECTRIC C/P MANUAL RESET (MURPHY, V82)
90	1	PULLER BLOCK, 2-15/16" NON-DEFORMATION (BROWNING, P8370NEX 2-15/16)
100	1	SHOULDER, 5-68000E, USED WITH R1 BUSHING (BROWNING, SC1600)
110	1	SHOULDER, 5-68000E, USED WITH R1 BUSHING (BROWNING, SC1600)
120	1	SHOULDER, 5-68000E, USED WITH R1 BUSHING (BROWNING, SC1600)
130	1	SHOULDER, 5-68000E, USED WITH R1 BUSHING (BROWNING, SC1600)
140	1	SHOULDER, 5-68000E, USED WITH R1 BUSHING (BROWNING, SC1600)
150	1	BUSHING, R1 2-15/16" (BROWNING, R1)
160	1	BUSHING, R2 2-7/16" (BROWNING, R2)
170	1	FINCE, CHAIN LINK, 1/2" BROAD, 1-5/8" OD AS PER DRAWING
180	1	FINCE, CHAIN LINK, 1/2" BROAD, 1-5/8" OD AS PER DRAWING
190	5	***BELL, C-SECTION, SHIP TO SPECIFY LENGTH (GENERAL)
200	5	***BELL, C-SECTION, SHIP TO SPECIFY LENGTH (GENERAL)
210	5	***BELL, C-SECTION, SHIP TO SPECIFY LENGTH (GENERAL)
220	2	TRANSMITTER, VIBRATION, 4-20MA, 24VDC OPA, 15, CENELEC (METRIC, STRAKE-787)

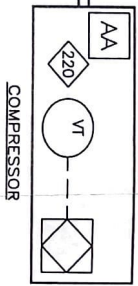

AS-BUILT
DATE FEB 14 2005

Compression

REV	DESCRIPTION	DATE	DRAWN BY	CHECKED BY
1	AS BUILT	02/02/11	NBP	
2	CHANGED VIB SWITCHES TO TRANSMITTERS	02/02/11	NBP	
3	ISSUED FOR CONSTRUCTION	04/10/26	NBP	
0	FOR APPROVAL	04/09/29	NBP	

4700 47 Street SE Calgary AB Canada T2B 3K1 Canada Tel: +1.403.236.8800 Fax: +1.403.279.0357

© 2004 Enerflex Systems Ltd.
REPRODUCTION OF ANY PORTION OF THESE MATERIALS WITHOUT THE EXPRESS WRITTEN PERMISSION OF ENERFLEX SYSTEMS LTD. IS EXPRESSLY PROHIBITED. THE INFORMATION CONTAINED HEREIN IS SOLELY FOR THE USE OF THE CUSTOMER AND IS NOT TO BE REPRODUCED OR TRANSMITTED IN ANY FORM OR BY ANY MEANS, ELECTRONIC OR MECHANICAL, INCLUDING PHOTOCOPYING, RECORDING, OR BY ANY INFORMATION STORAGE AND RETRIEVAL SYSTEM. THE PRODUCTS TO WHICH THEY RELATE.

DRIVE TRAIN MODULE
ARIEL JACK, 6, CHLUSKY OIL
TOLMAN

DATE 2/14/11

SCALE 1:1

NTS

QD NO. 040856

REV NO. SF-040856-28

BILL OF MATERIAL

ITEM QTY	PART #	DESCRIPTION
10	107887	BARREL TRANSFER STATION, 1/2" NPT (MKA 1021100)
11	104848	COOLER, 1/2" NPT, 1/2" NPT (MKA 1021100)
12	107888	CONTROLLER, 1/2" NPT, 1/2" NPT (MKA 1021100)
13	107889	WAKE BALL, 1/2" NPT, 1/2" NPT (MKA 1021100)
14	107890	WAKE BALL, 1/2" NPT, 1/2" NPT (MKA 1021100)
15	107891	WAKE BALL, 1/2" NPT, 1/2" NPT (MKA 1021100)
100	107976	WAKE BALL, 1/2" NPT, 1/2" NPT (MKA 1021100)

AS-BUILT

DATE FEB 14 2005

FRAME	JCK/6
FRAME CRANKCASE VOLUME	212 L
OIL FLOWRATE	2.9 L/S
CONNECTION "A"	1-1/2" NPT
PIPE "B"	1-1/2" NPT
HOSE "C"	1-1/4" 350
CONNECTION "D"	1" NPT

NOTES:

- > VENT CRANKCASE OUTSIDE OF BUILDING FOR SOUR SERVICE.
- 1. 1/2" PLUGGED SAMPLE POINTS TO BE PROVIDED.

Compression

4700 47 Street SE Calgary AB Canada T2B 3R1 Canada Tel: +1 403 236 6800 Fax: +1 403 279 0257

www.ariel.com

TITLE: SERVICE FLOW COMPRESSOR SYSTEM

ARIEL JCK/6, CAT. 63515TAL, AXC 132EH


FOR: HUSKY OIL TOLMAN

CONSULTANT: LSP 13-29-33-21 WAM

DESIGNED BY: JCK/6 DATE: 04/10/20 DWG. No. 040656

DRAWN BY: JCK/6 DATE: 04/10/20 SF-040656-20

CHECKED BY: JCK/6 DATE: 04/10/20

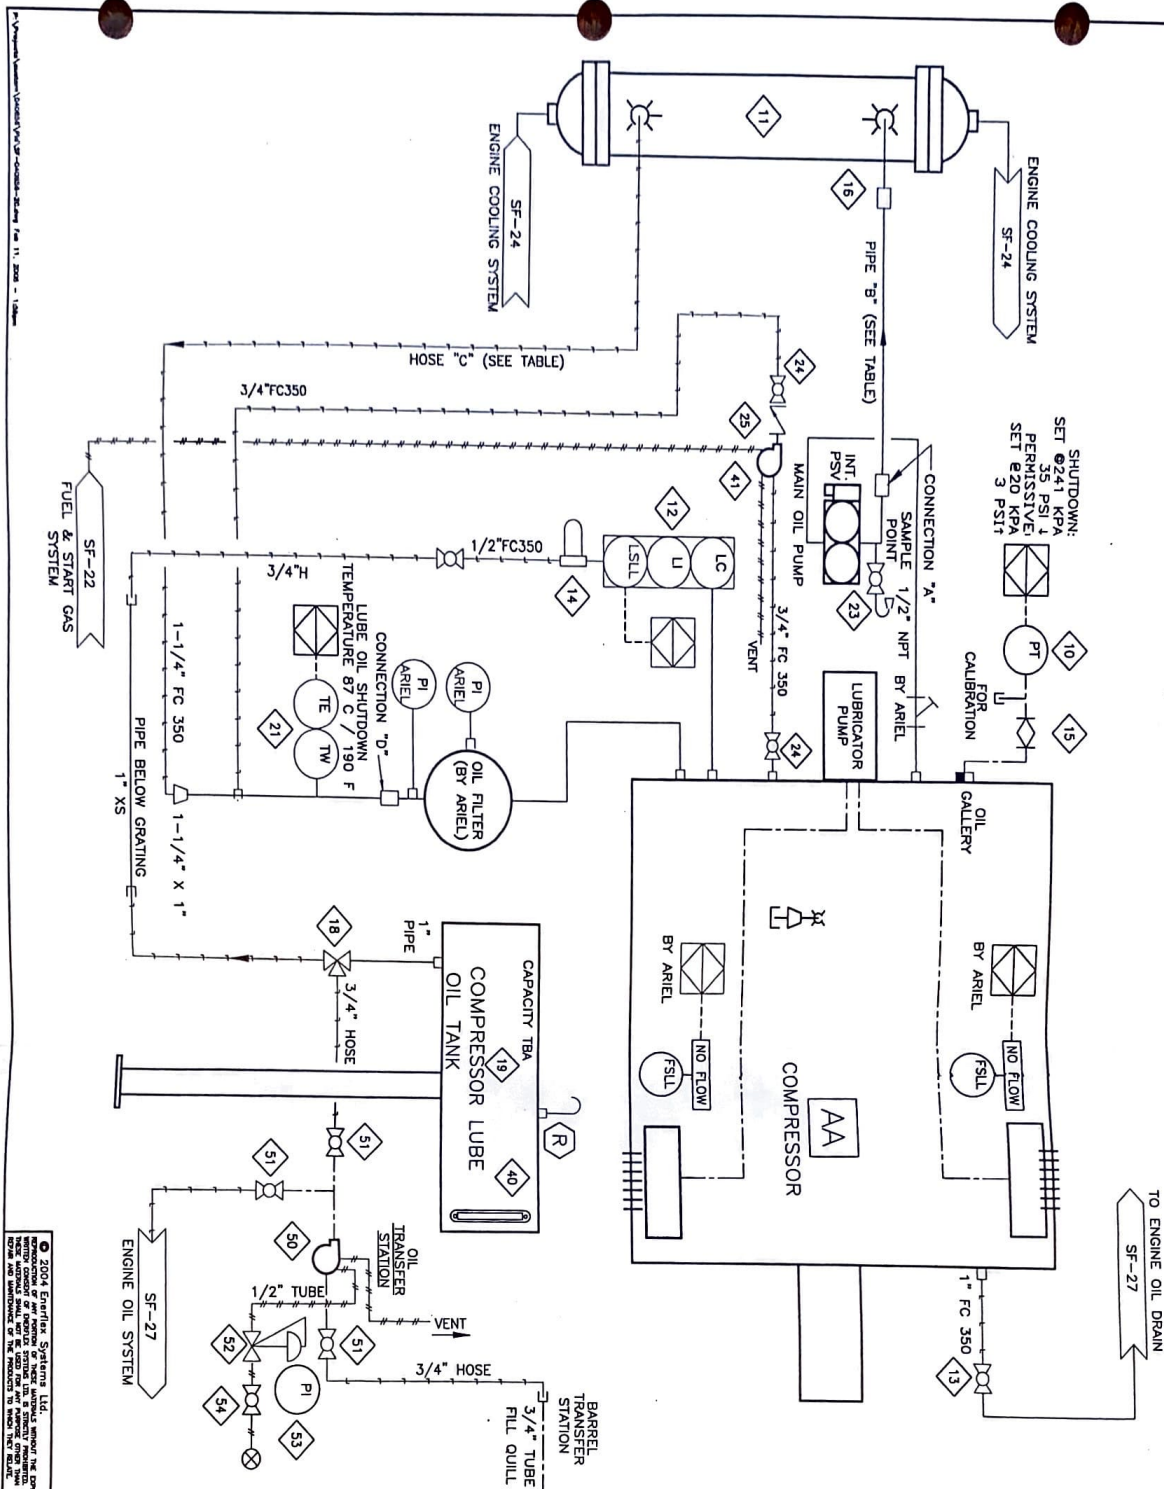

MATERIAL LIST		
ITEM	QTY	PART # DESCRIPTION
10	6	112780
11	6	114680
12	6	114680
NOTE: OIL SEAL POT AND VACUUM PUMP ASSY REQUIRED WHEN CUSTOMER CONNECTING TO FLARE SYSTEM
PACKING COOLING SYSTEM REQUIRED ON 5-3/8" CYLINDERS ONLY

AS-BUILT
DATE FEB 14 2005


REV	DESCRIPTION	DATE	DRAWN BY	CHECKED BY
0	AS BUILT	02/07/07	NSP	
1	ADDED PACKING COOLING SYSTEM FOR 5-3/8" CYLINDERS	04/11/23	NSP	
2	REVISED PIPING, ELIMINATED SPOD EDGE CONNECTION	04/11/23	NSP	
3	ISSUED FOR CONSTRUCTION	04/08/29	NSP	
4	ISSUE FOR APPROVAL	04/08/29	NSP	

PF Compression

4700 47 Street SE Calgary AB Canada T2B 3S1 Canada Tel: 4163256580 Fax: 41632792657
www.pfcompression.com

SERVICE FLOW
TITLE: PACKING VENT & DRAIN SYSTEM OCH2S<100 PPM
COMPRESSOR PACKAGE

FOR: HUSKY OIL TOLMAN
CONSULTANT: -
P.O.: -
DRAWN BY: S4
DATE: 04/04/07
CHECKED BY: S4
DATE: 04/04/07
APPROVED BY: S4
DATE: 04/04/07
SCALE: 1/2" = 1'-0"

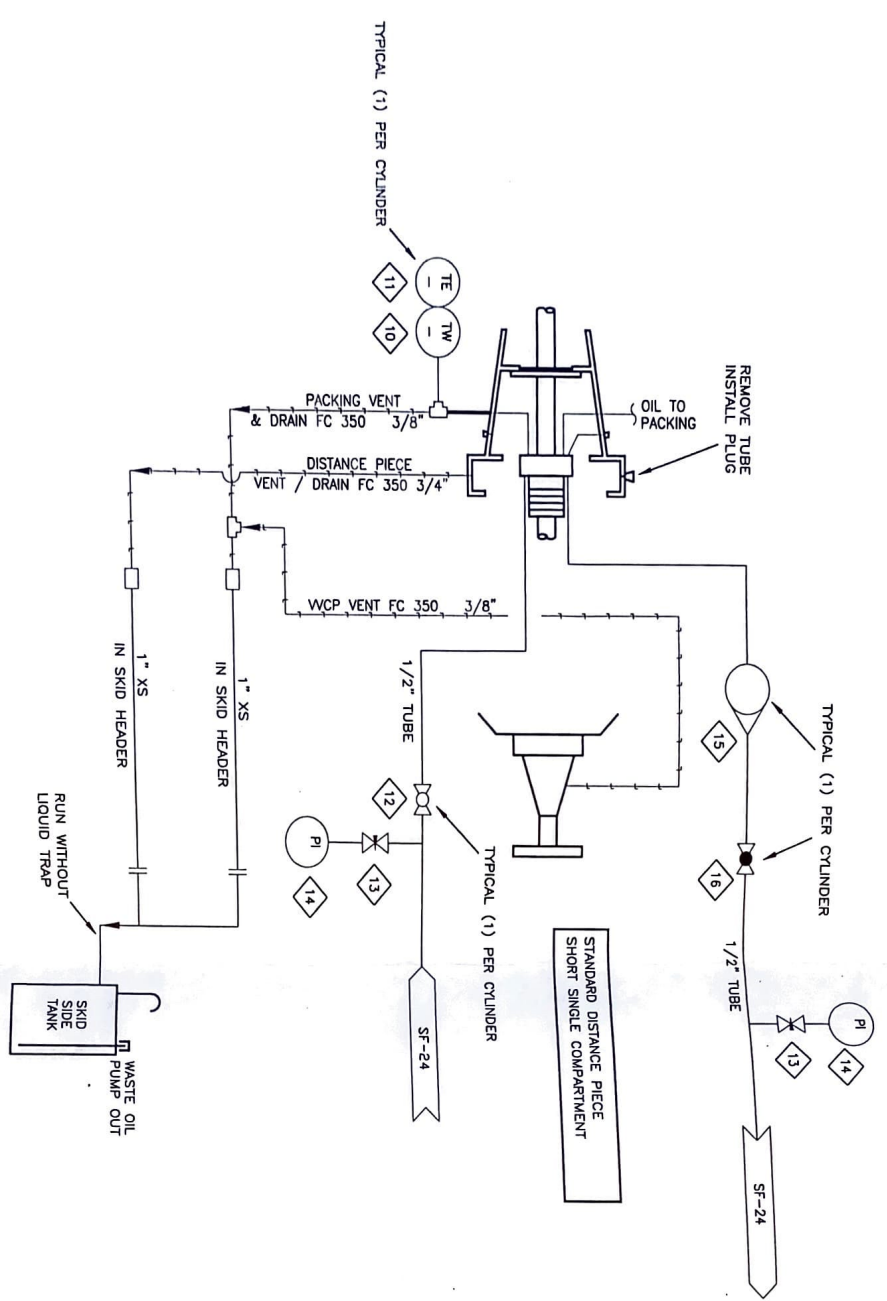

© 2004 Enerflex Systems Ltd.
ENERFLEX is a registered trademark of Enerflex Systems Ltd.
All rights reserved. No part of this publication may be reproduced, stored in a retrieval system, or transmitted, in any form or by any means, electronic, mechanical, photocopying, recording, or by any information storage and retrieval system, without the prior written permission of Enerflex Systems Ltd.

MATERIAL LIST

ITEM	QTY	PLANT #	DESCRIPTION
1	1	11	EXPANSION JOINT
2	1	12	1/2" AIR INTAKE TUBING C/W 2" COLLAR & SS LINER 1/2" LONG
3	1	13	1/2" AIR INTAKE TUBING C/W 2" COLLAR & SS LINER 1/2" LONG
4	1	14	1/2" AIR INTAKE TUBING C/W 2" COLLAR & SS LINER 1/2" LONG
5	1	15	1/2" AIR INTAKE TUBING C/W 2" COLLAR & SS LINER 1/2" LONG
6	1	16	1/2" AIR INTAKE TUBING C/W 2" COLLAR & SS LINER 1/2" LONG
7	1	17	1/2" AIR INTAKE TUBING C/W 2" COLLAR & SS LINER 1/2" LONG
8	1	18	1/2" AIR INTAKE TUBING C/W 2" COLLAR & SS LINER 1/2" LONG
9	1	19	1/2" AIR INTAKE TUBING C/W 2" COLLAR & SS LINER 1/2" LONG
10	1	20	1/2" AIR INTAKE TUBING C/W 2" COLLAR & SS LINER 1/2" LONG
11	1	21	1/2" AIR INTAKE TUBING C/W 2" COLLAR & SS LINER 1/2" LONG
12	1	22	1/2" AIR INTAKE TUBING C/W 2" COLLAR & SS LINER 1/2" LONG
13	1	23	1/2" AIR INTAKE TUBING C/W 2" COLLAR & SS LINER 1/2" LONG
14	1	24	1/2" AIR INTAKE TUBING C/W 2" COLLAR & SS LINER 1/2" LONG
15	1	25	1/2" AIR INTAKE TUBING C/W 2" COLLAR & SS LINER 1/2" LONG
16	1	26	1/2" AIR INTAKE TUBING C/W 2" COLLAR & SS LINER 1/2" LONG
17	1	27	1/2" AIR INTAKE TUBING C/W 2" COLLAR & SS LINER 1/2" LONG
NOTE:
1. MAXIMUM PERMISSIBLE BACK PRESSURE
(1775 BHP @1000 RPM IS 12.00 INCHES
H2O)

AS-BUILT

DATE FEB 14 2005

BPX Compression

4700 47 Street SE Calgary AB Canada T2B 3R1 Canada Tel: +1.403.236.8800 Fax: +1.403.279.0367
www.enrfitex.com

TOLMAN
AIR & EXHAUST SYSTEMS
ARIEL JACK/B, CAT. G35167ALE, AXC 132EH

FOR: TOLMAN
JUSKY OIL

CONSULTANT:
P.O.:
DRAWN BY: JUSKY
CHECKED BY: JUSKY
DATE: 04/10/20
SCALE: NTS

REVISION BY: JUSKY
DATE: 04/10/20
SCALE: NTS

JOB No.: 040656
DWG. No.:
SF-040656-26
OP# 26

