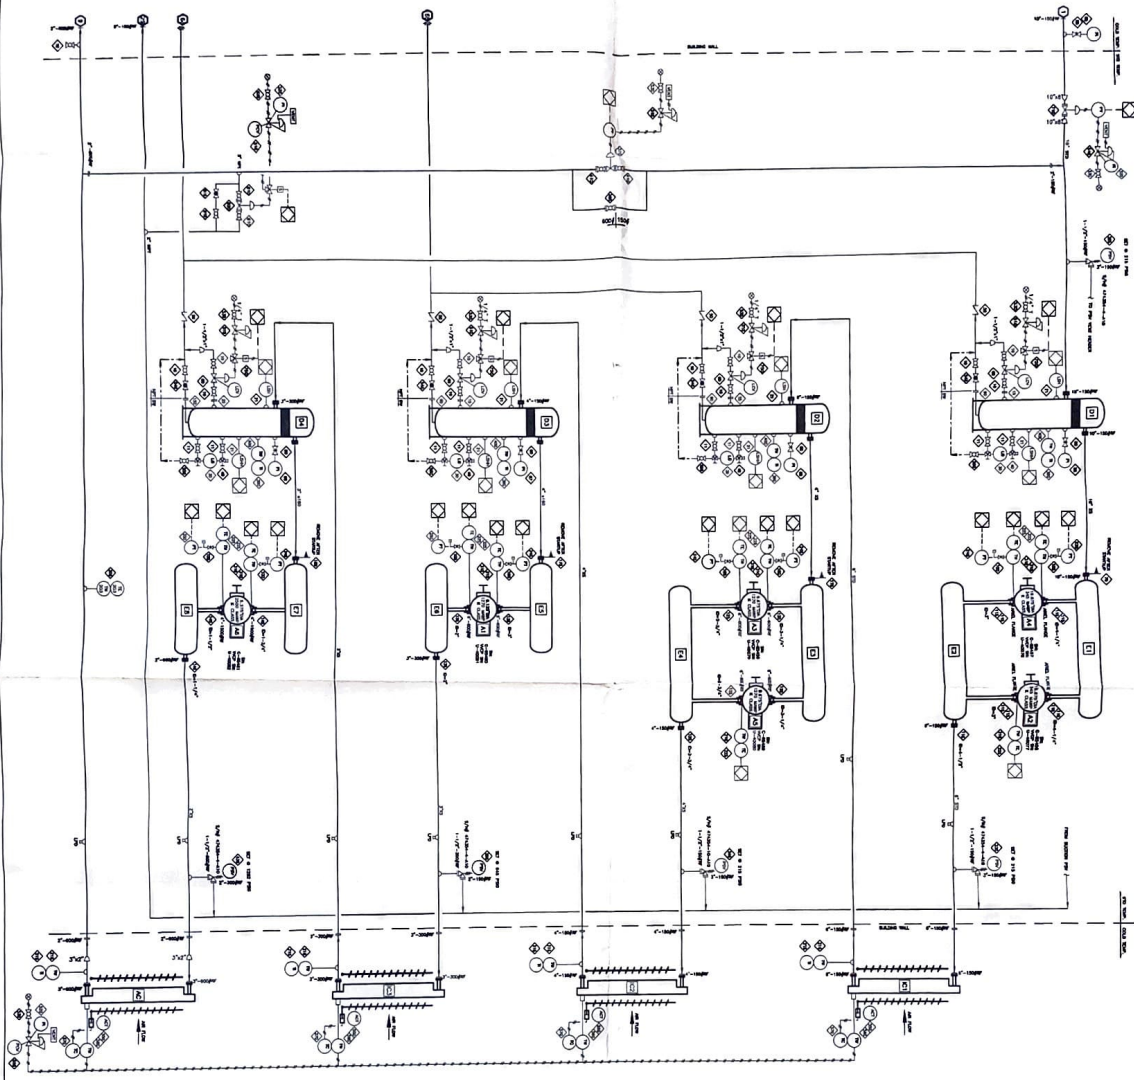


[illegible]

AS-BUILT
DATE FEB 14, 1962

[illegible]