


A	B	C	D
21	3-1/2	6	30

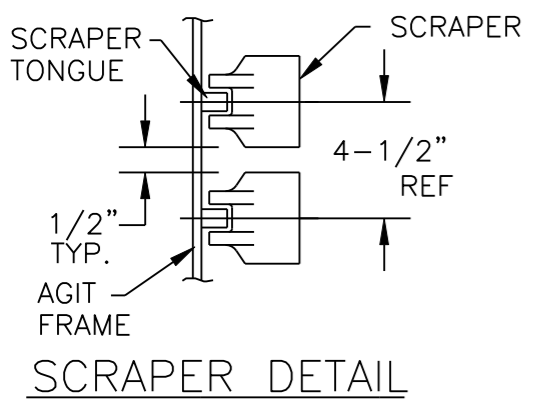

THIS DRAWING IS THE PROPERTY OF LEE INDUSTRIES, INC. DO NOT PRINT, COPY, PHOTOGRAPH, DISCLOSE TO OTHERS, OR USE FOR ANY PURPOSE OTHER THAN THAT FOR WHICH IT IS SPECIFICALLY FURNISHED.

**PROCESS SYSTEMS & EQUIPMENT**

DIVISION OF LEE INDUSTRIES, INC.

PHILIPSBURG, PA.

9M AGITATOR FOR 1000 GALLON TANKS			
SCALE: NONE	DATE: 10-10-05		
DRAWN BY: STRICEK	DRAWING NO.		REV.
APPROVED BY: JEB	B-16653		1
REV.	DESCRIPTION	DATE	PLOT: 1"=1'

	⚠ AS-BUILT ADDED 4 SCRAPERS WAS 42	12-8-05 D.S./SRT
	⚠	