

SPECIFICATIONS

RECIRC - JAN-AIR 13.5x5x1.69 M.S., FAN WHEEL TO DELIVER
3350 CFM WITH A 5 HP 1725 RPM MOTOR

HEAT SOURCE - JIB-236 BURNER, RATED 350,000 BTU/HR

EXHAUST - PQ-1 550 CFM WITH 0.75 HP MOTOR

VOLTAGE - SUPPLY - 208/3/60
- CONTROL - 110/1/60


CONTROL ENCLOSURE - NEMA 1

MAXIMUM TEMPERATURE 850°F


OPERATING TEMPERATURE 780°F. UNIFORMITY +/-10°F.

PAINT - SILVER VEIN POWDER COATED OVEN AND CONTROL PANEL


INTERIOR -#20ga. ALZ. STEEL

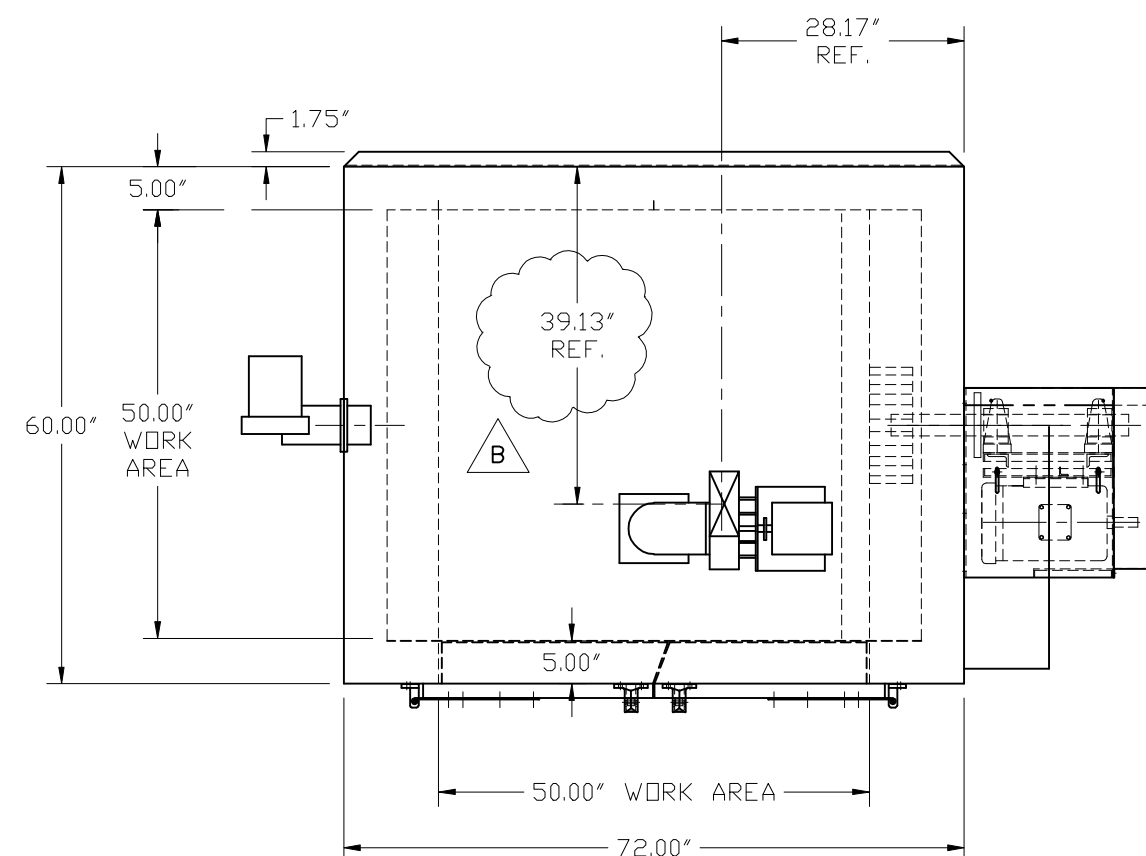

PLAN VIEW

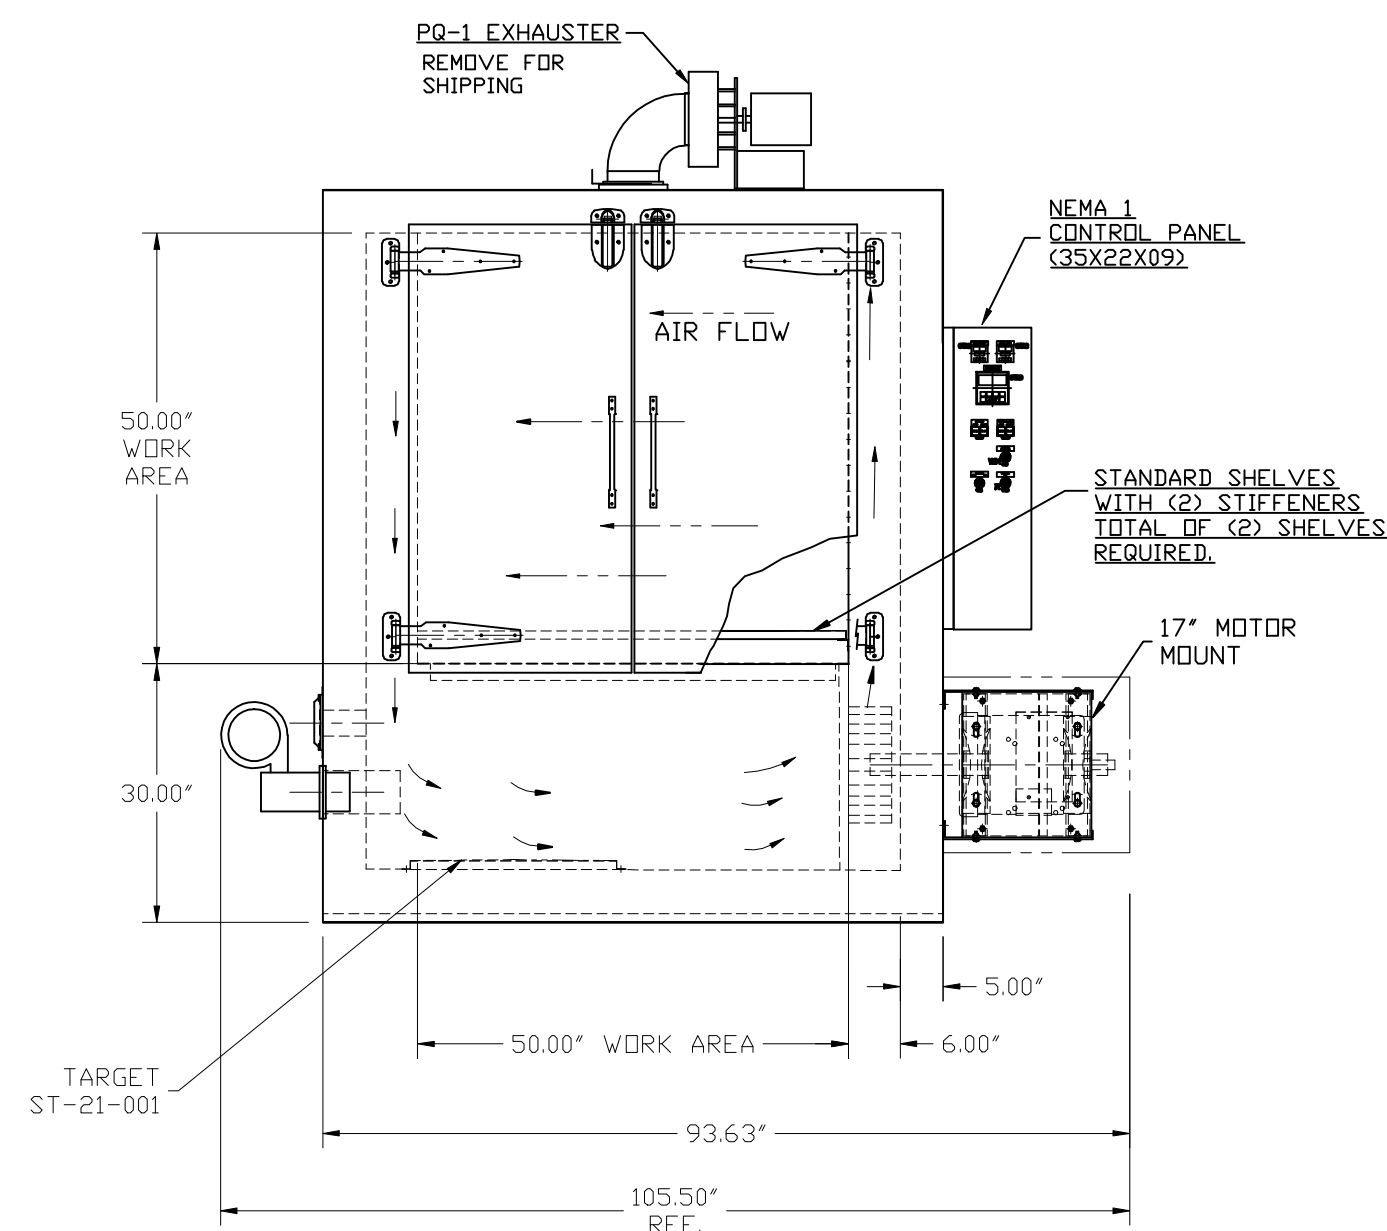

FRONT VIEW

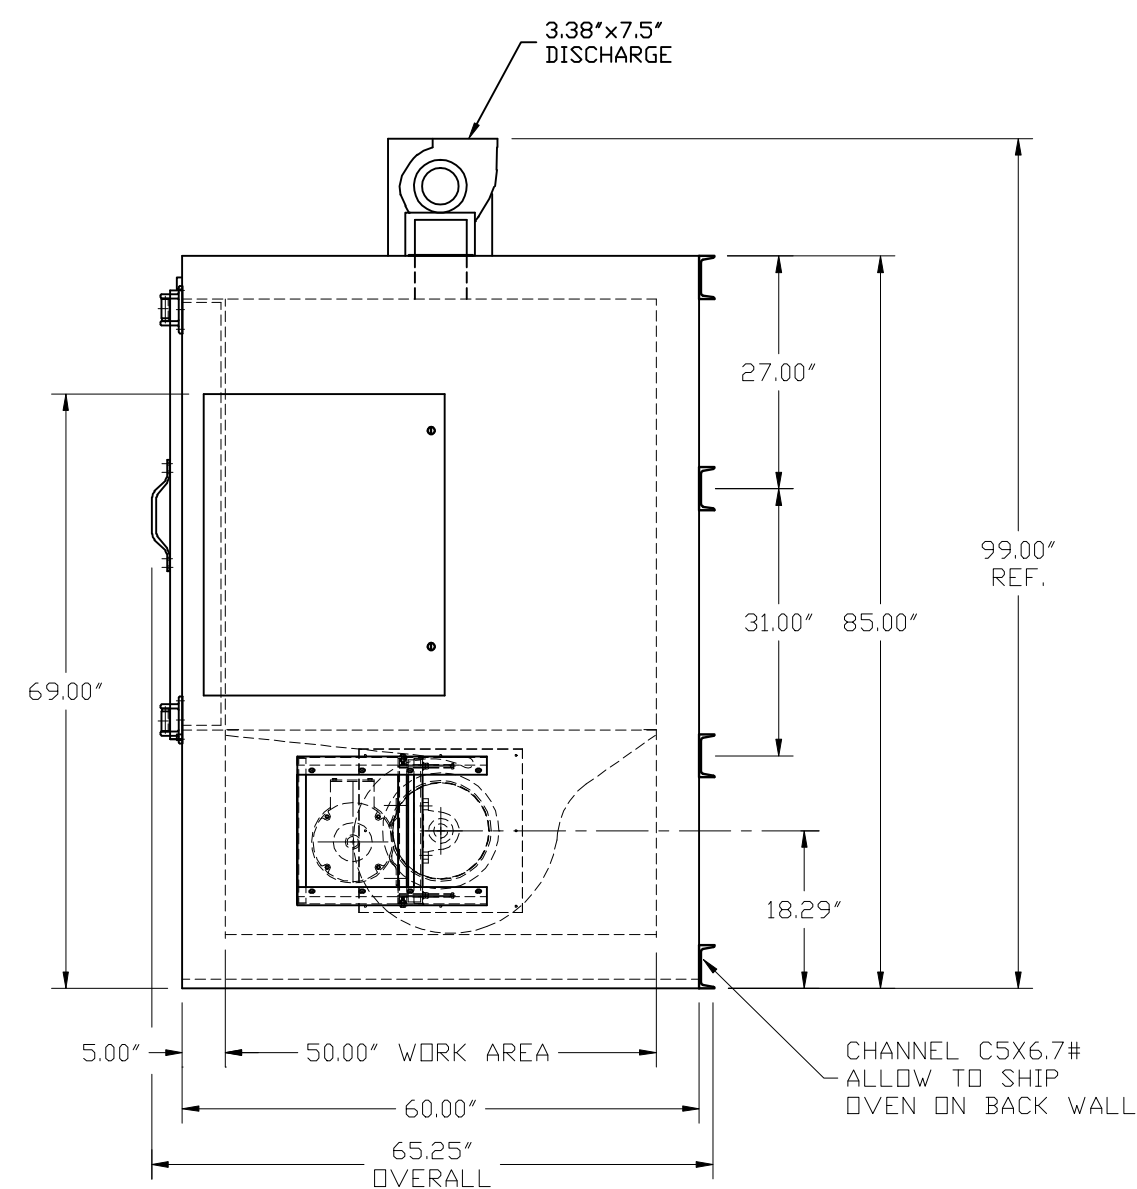

RIGHT SIDE VIEW

NOTE:
SHIP OVEN LAYING ON IT'S BACK
WITH EXHAUST FAN REMOVED.

B	REVISED AS BUILT	VIS	09/25/09	ASSEMBLY: X2-8-505050 GAS FIRED CL."A" OVEN			
A	REVISED DIM. (WAS 15.19")	VIS	09/17/09	TITLE: GENERAL ARRANGEMENT			
REV.	DESCRIPTION	BY	DATE				
ACAD #:	PLOT SCALE: 1=24	BY: VIS	DATE: 09/14/09	SCALE: 1/2"=1'	ORDER #: 19197	DWG #: 19197-00-00	SHEET 1 OF 1