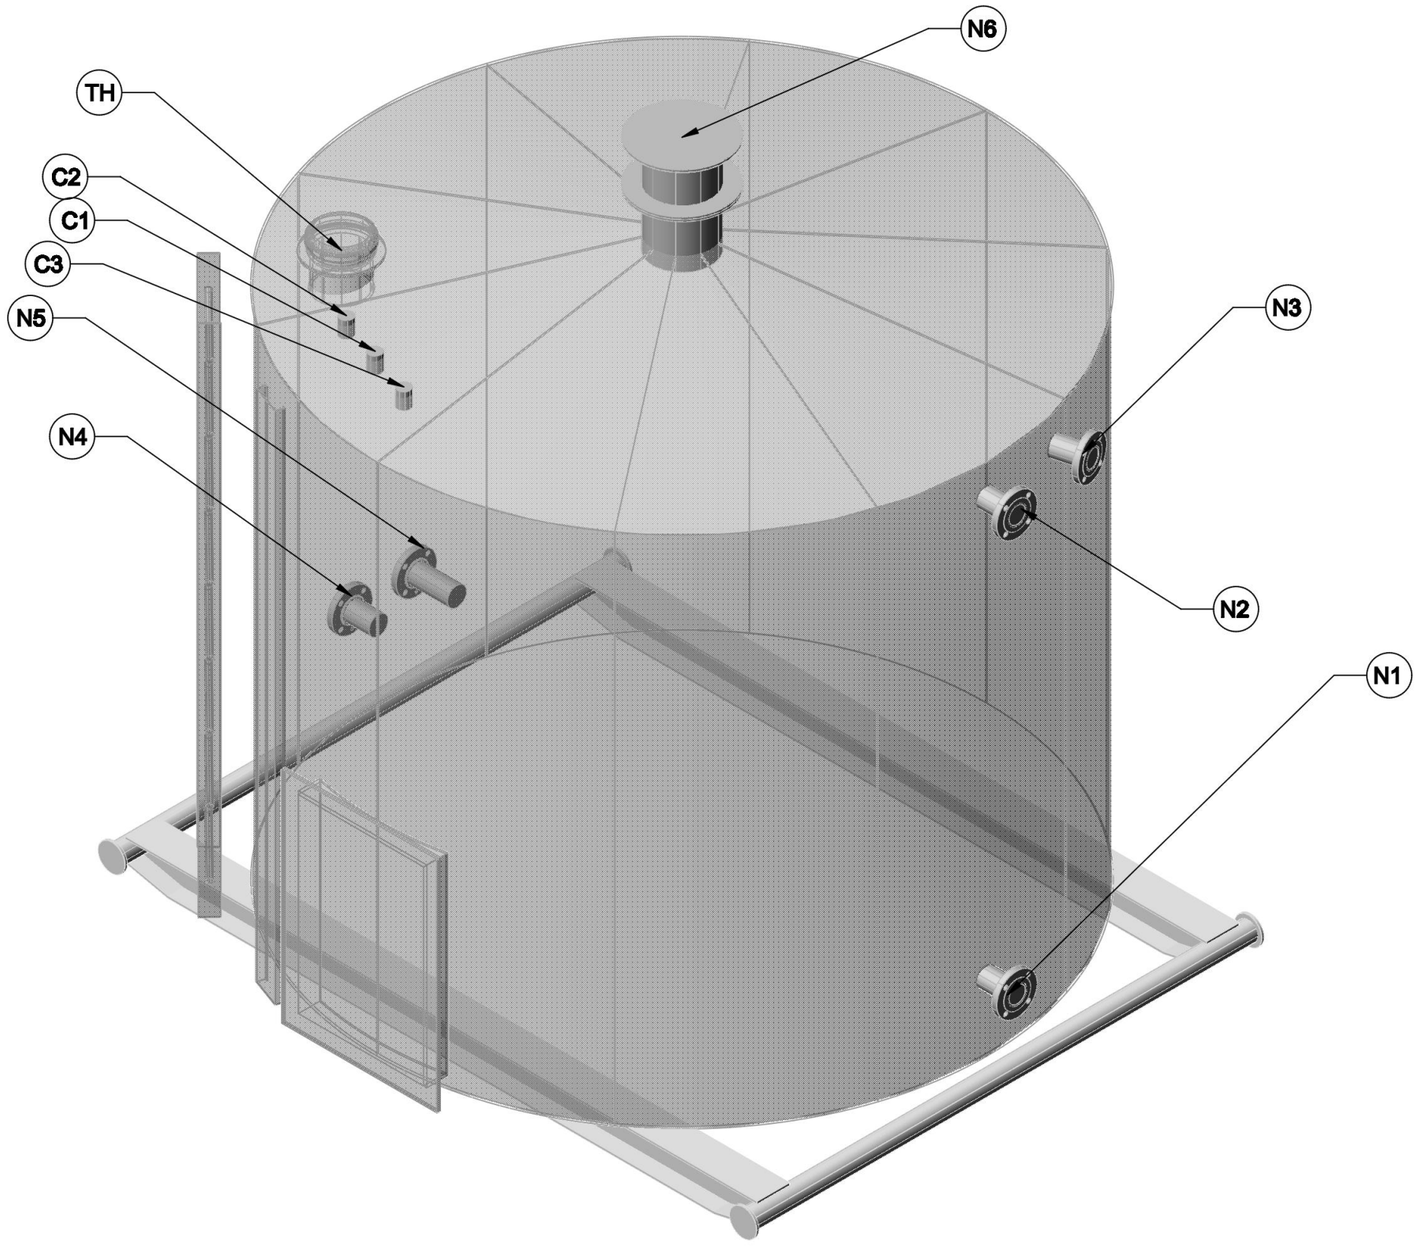


SKID CROSS BEAM UNKNOWN
UNTIL WE PICK PACKAGE UP.

REV	DESC	BY	DATE
REVISIONS			

RARE OILFIELD SERVICES
502 MITCHELL DRIVE SE
REDCLIFF, ALBERTA,
T0J 2P0

RARE EQUIPMENT #
16232 - 100 BBL TANK

DATE
OCT 9, 2026

DRAWN BY
K HOBMAN

DRAWING TITLE
16232 - 100BBL TANK
GENERAL ARRANGENT
SHT 2 OF 2

FILE NAME
16232 100 BBL TANK AS BUILT

LAYOUT NAME
SHT 2

REVISION
A

REVISION DATE