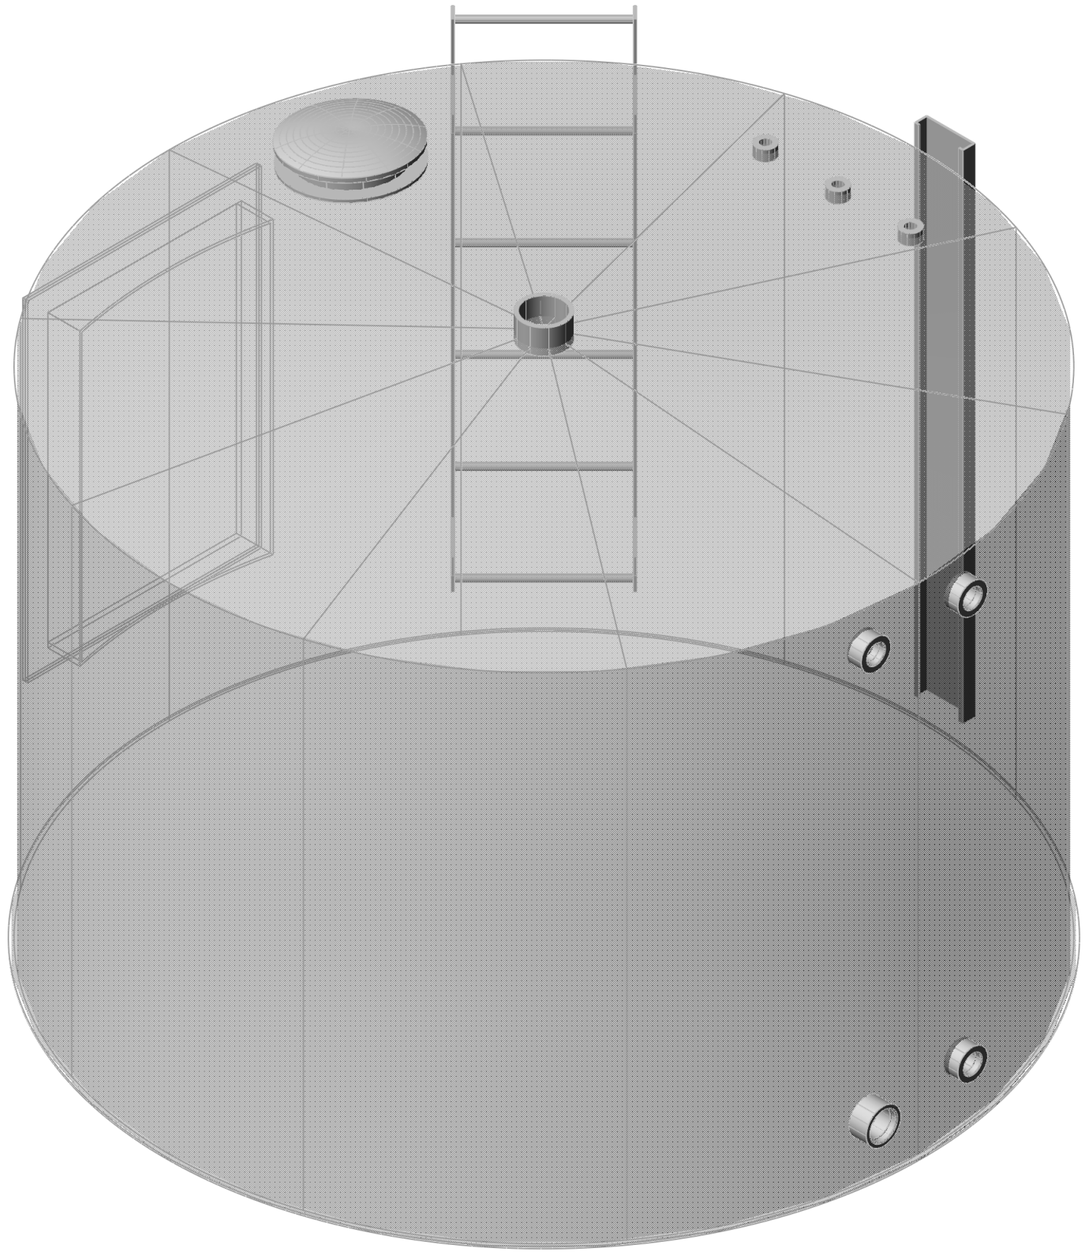

REV	DESC	BY	DATE
REVISIONS			

RARE OILFIELD SERVICES
502 MITCHELL DRIVE SE
REDCLIFF, ALBERTA,
T0J 2P0

RARE EQUIPMENT #
16287 - 50 BBL TANK BY BOOMERS

DATE
Oct 26, 2026

DRAWN BY
K HOBMAN

DRAWING TITLE
16287 - 50BBL TANK
GENERAL ARRANGEMENT
SHT 2 OF 2

FILE NAME
16287 50 BBL TANK AS BUILT

LAYOUT NAME
SHT 2

REVISION
A

REVISION DATE