TAG	SIZE	TYPE	CONNECTION
C1	3"	3000# HC	PUMP OUT
C2	2"	3000# HC	HIGH LEVEL
C3	2"	3000# HC	SPARE
C4	2"	3000# HC	SPARE
C5	1 1/4"	3000# HC	GUIDE CABLE
C6	2"	3000# HC	LEVEL INDICATOR
C7	2"	3000# HC	CUIDE CABLE
C8	4"	3000# HC	CENTER VENT
TH	4"	NOT API	FLAPPER CLOSURE
MW		STANDARD	MANWAY

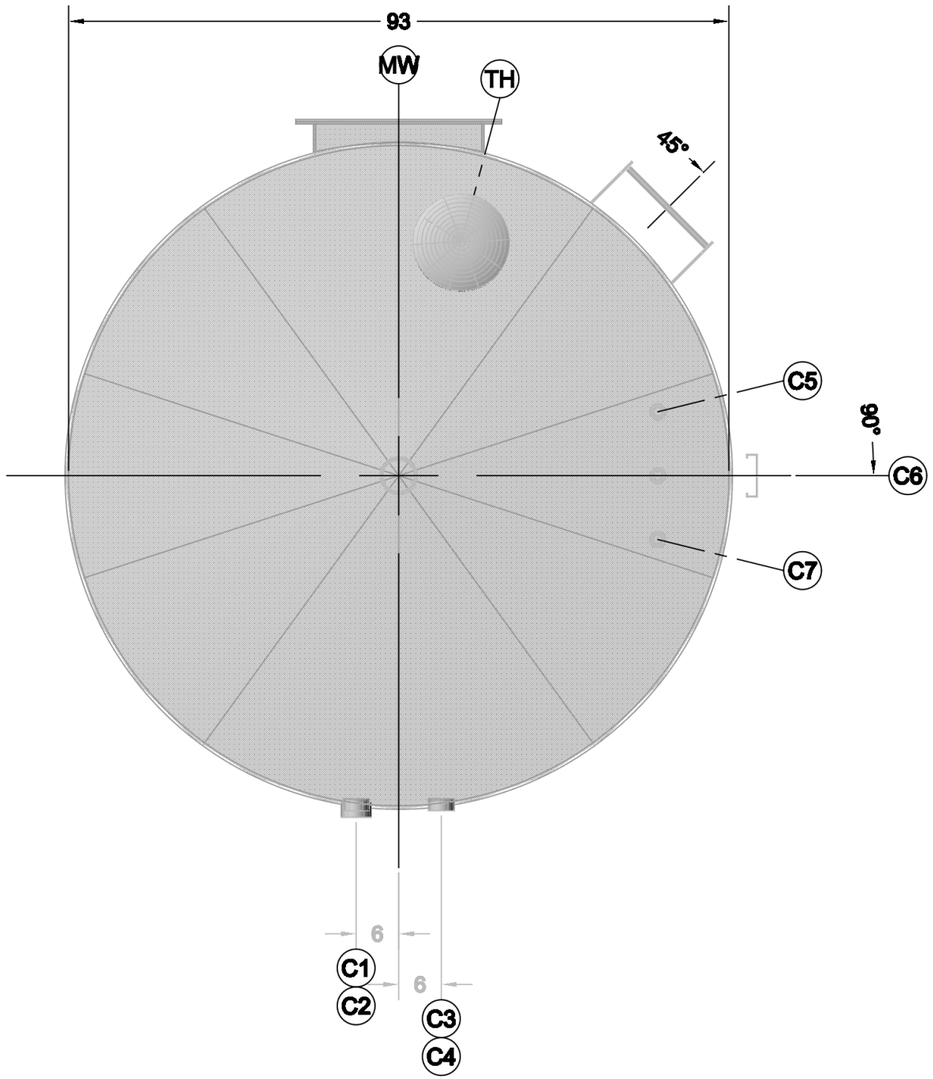

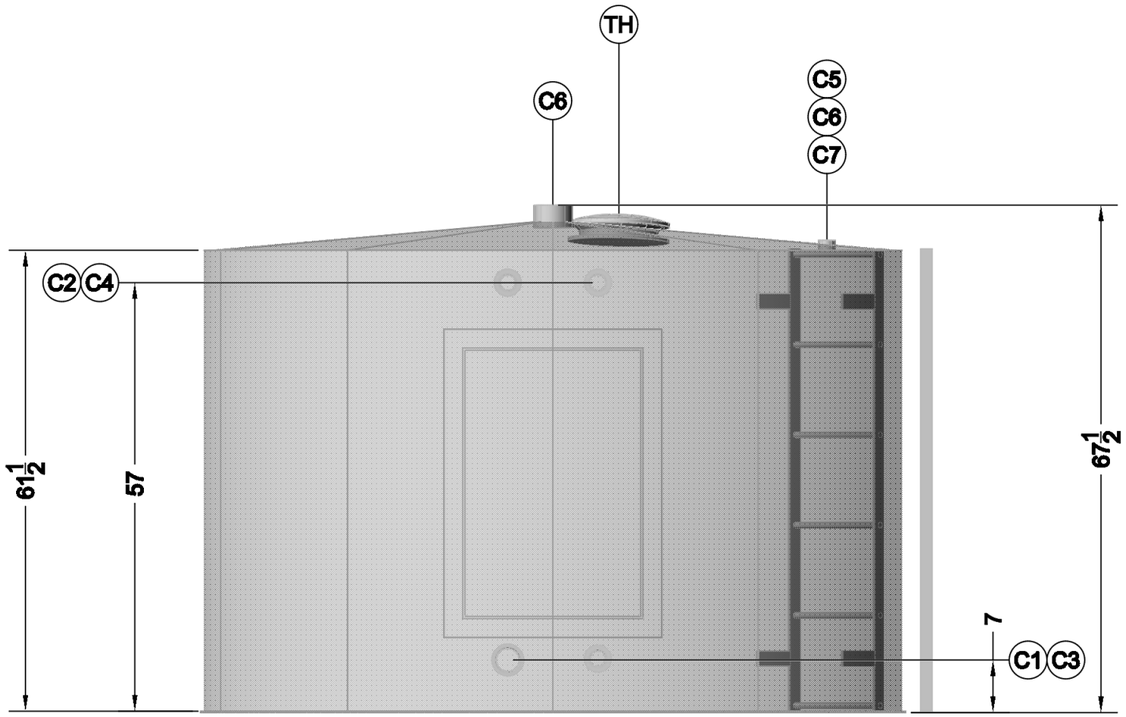

REV	DESC	BY	DATE
REVISIONS			

RARE OILFIELD SERVICES
502 MITCHELL DRIVE SE
REDCLIFF, ALBERTA,
T0J 2P0

RARE EQUIPMENT #
16287 - 50 BBL TANK BY BOOMERS

DATE
Oct 26, 2026

DRAWN BY
K HOBMAN

DRAWING TITLE
16287 - 50BBL TANK
GENERAL ARRANGEMENT
SHT 1 OF 2

FILE NAME
16287 50 BBL TANK AS BUILT

LAYOUT NAME
SHT 1

REVISION
A

REVISION DATE