

TAG	SIZE	TYPE	CONNECTION
N1	3"	150# RF	SPARE
N2	3"	150# RF	HIGH LEVEL
N3	3"	150# RF	SPARE
N4	3"	150# RF	PUMP OUT
N5	3"	150# RF	SPARE
N6	8"	NON API	CENTER VENT
C1	1 1/4"	3000# CPLR	FLOAT CABLE
C2	1 1/4"	3000# CPLR	GUIDE CABLE
C3	1 1/4"	3000# CPLR	GUIDE CABLE
TH	8"		THIEF HATCH
MW		STANDARD	MANWAY

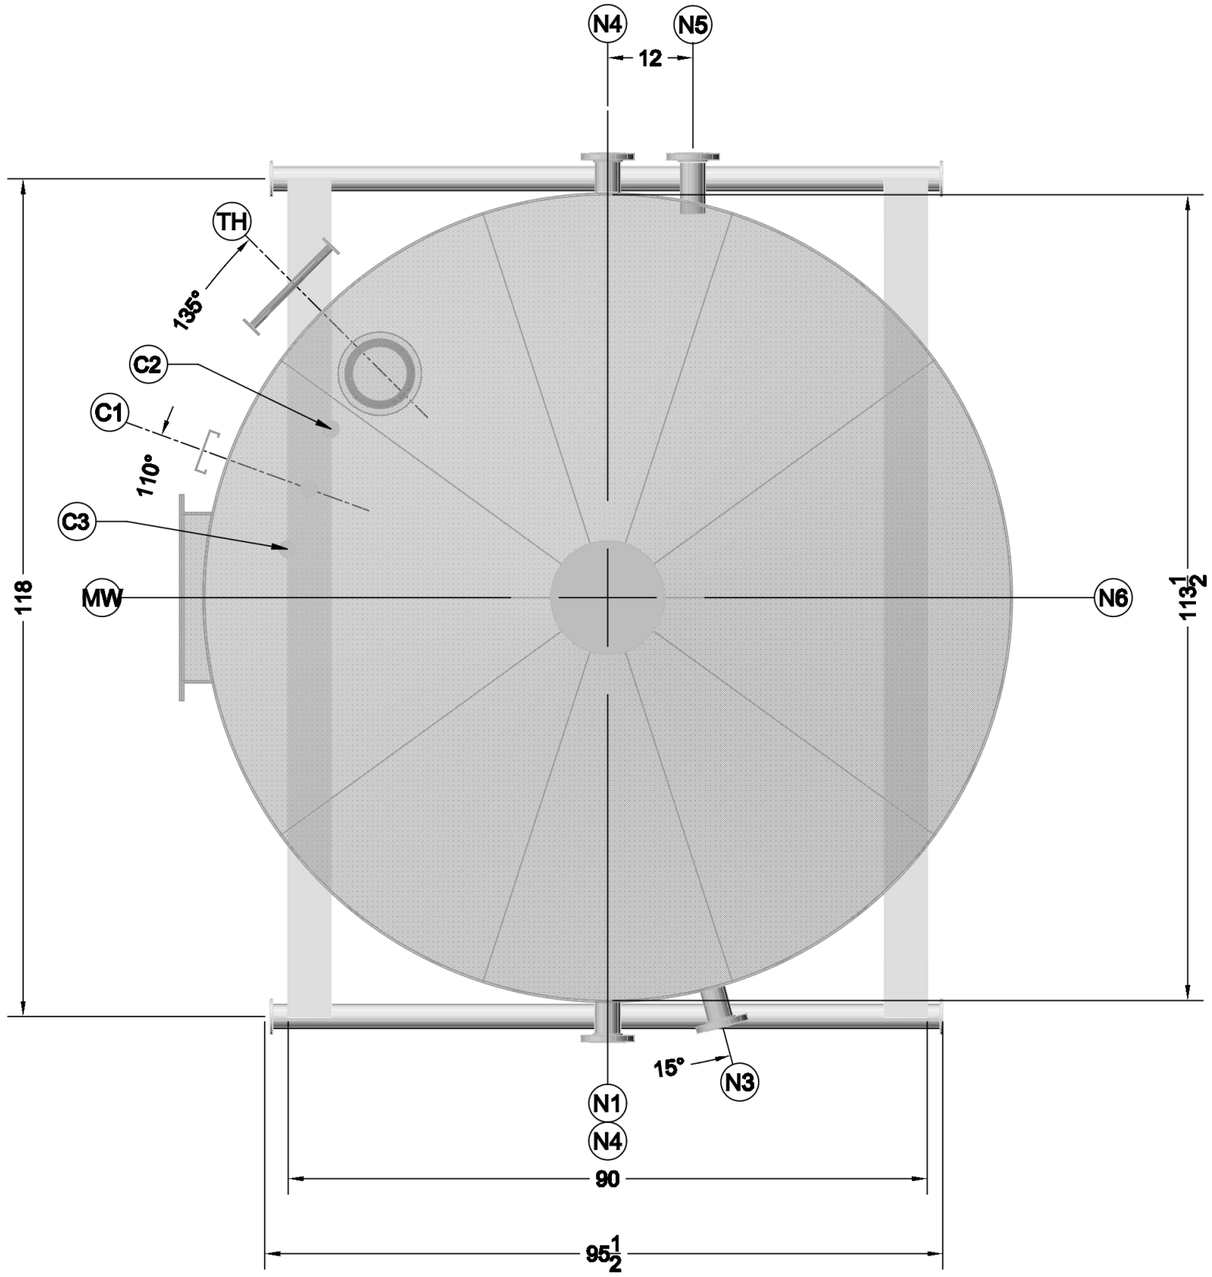

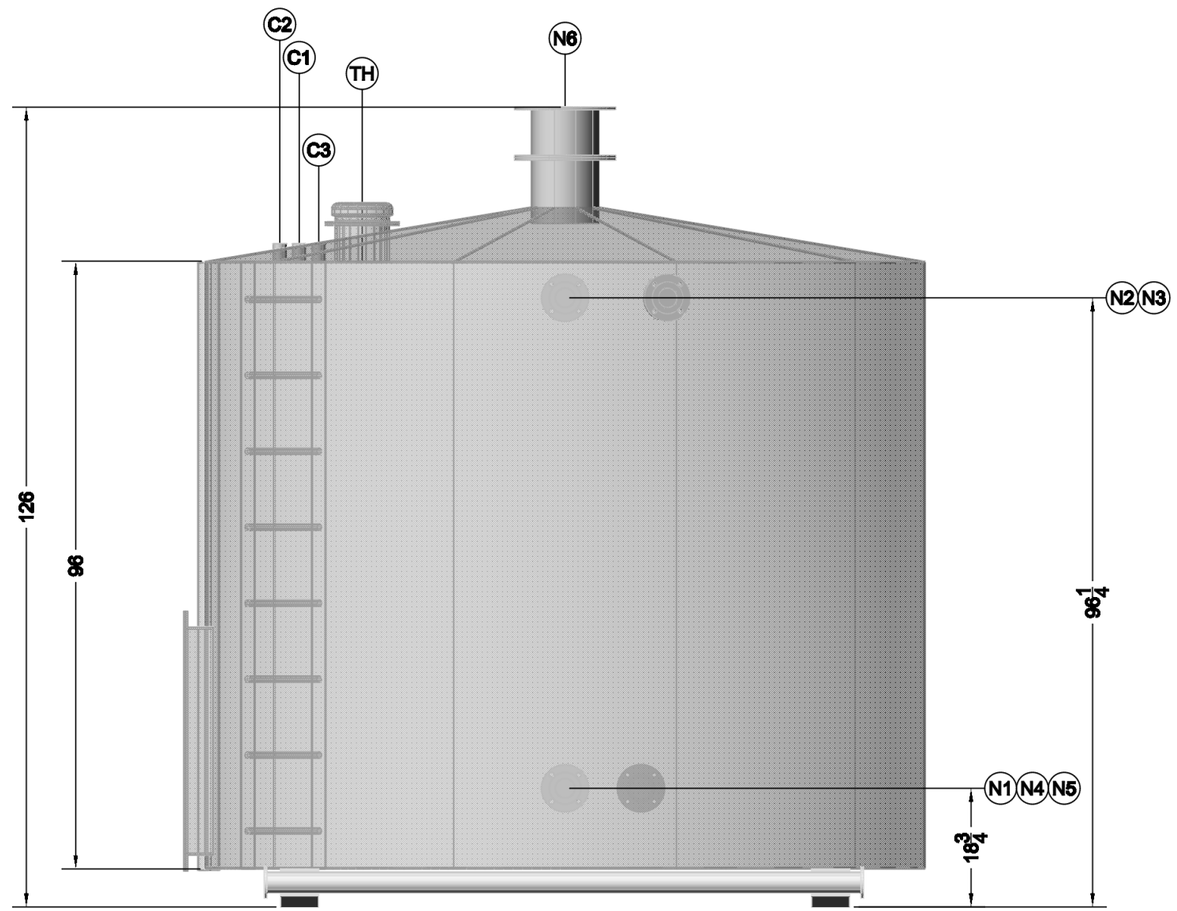

REV	DESC	BY	DATE
REVISIONS			

RARE OILFIELD SERVICES
502 MITCHELL DRIVE SE
REDCLIFF, ALBERTA,
T0J 2P0

RARE EQUIPMENT #
16232 - 100 BBL TANK

DATE
Oct 9, 2026

DRAWN BY
K HOBMAN

DRAWING TITLE
16232 - 100BBL TANK
GENERAL ARRANGENT
SHT 1 OF 2

FILE NAME
16232 100 BBL TANK AS BUILT

LAYOUT NAME
SHT 1

REVISION
A

REVISION DATE