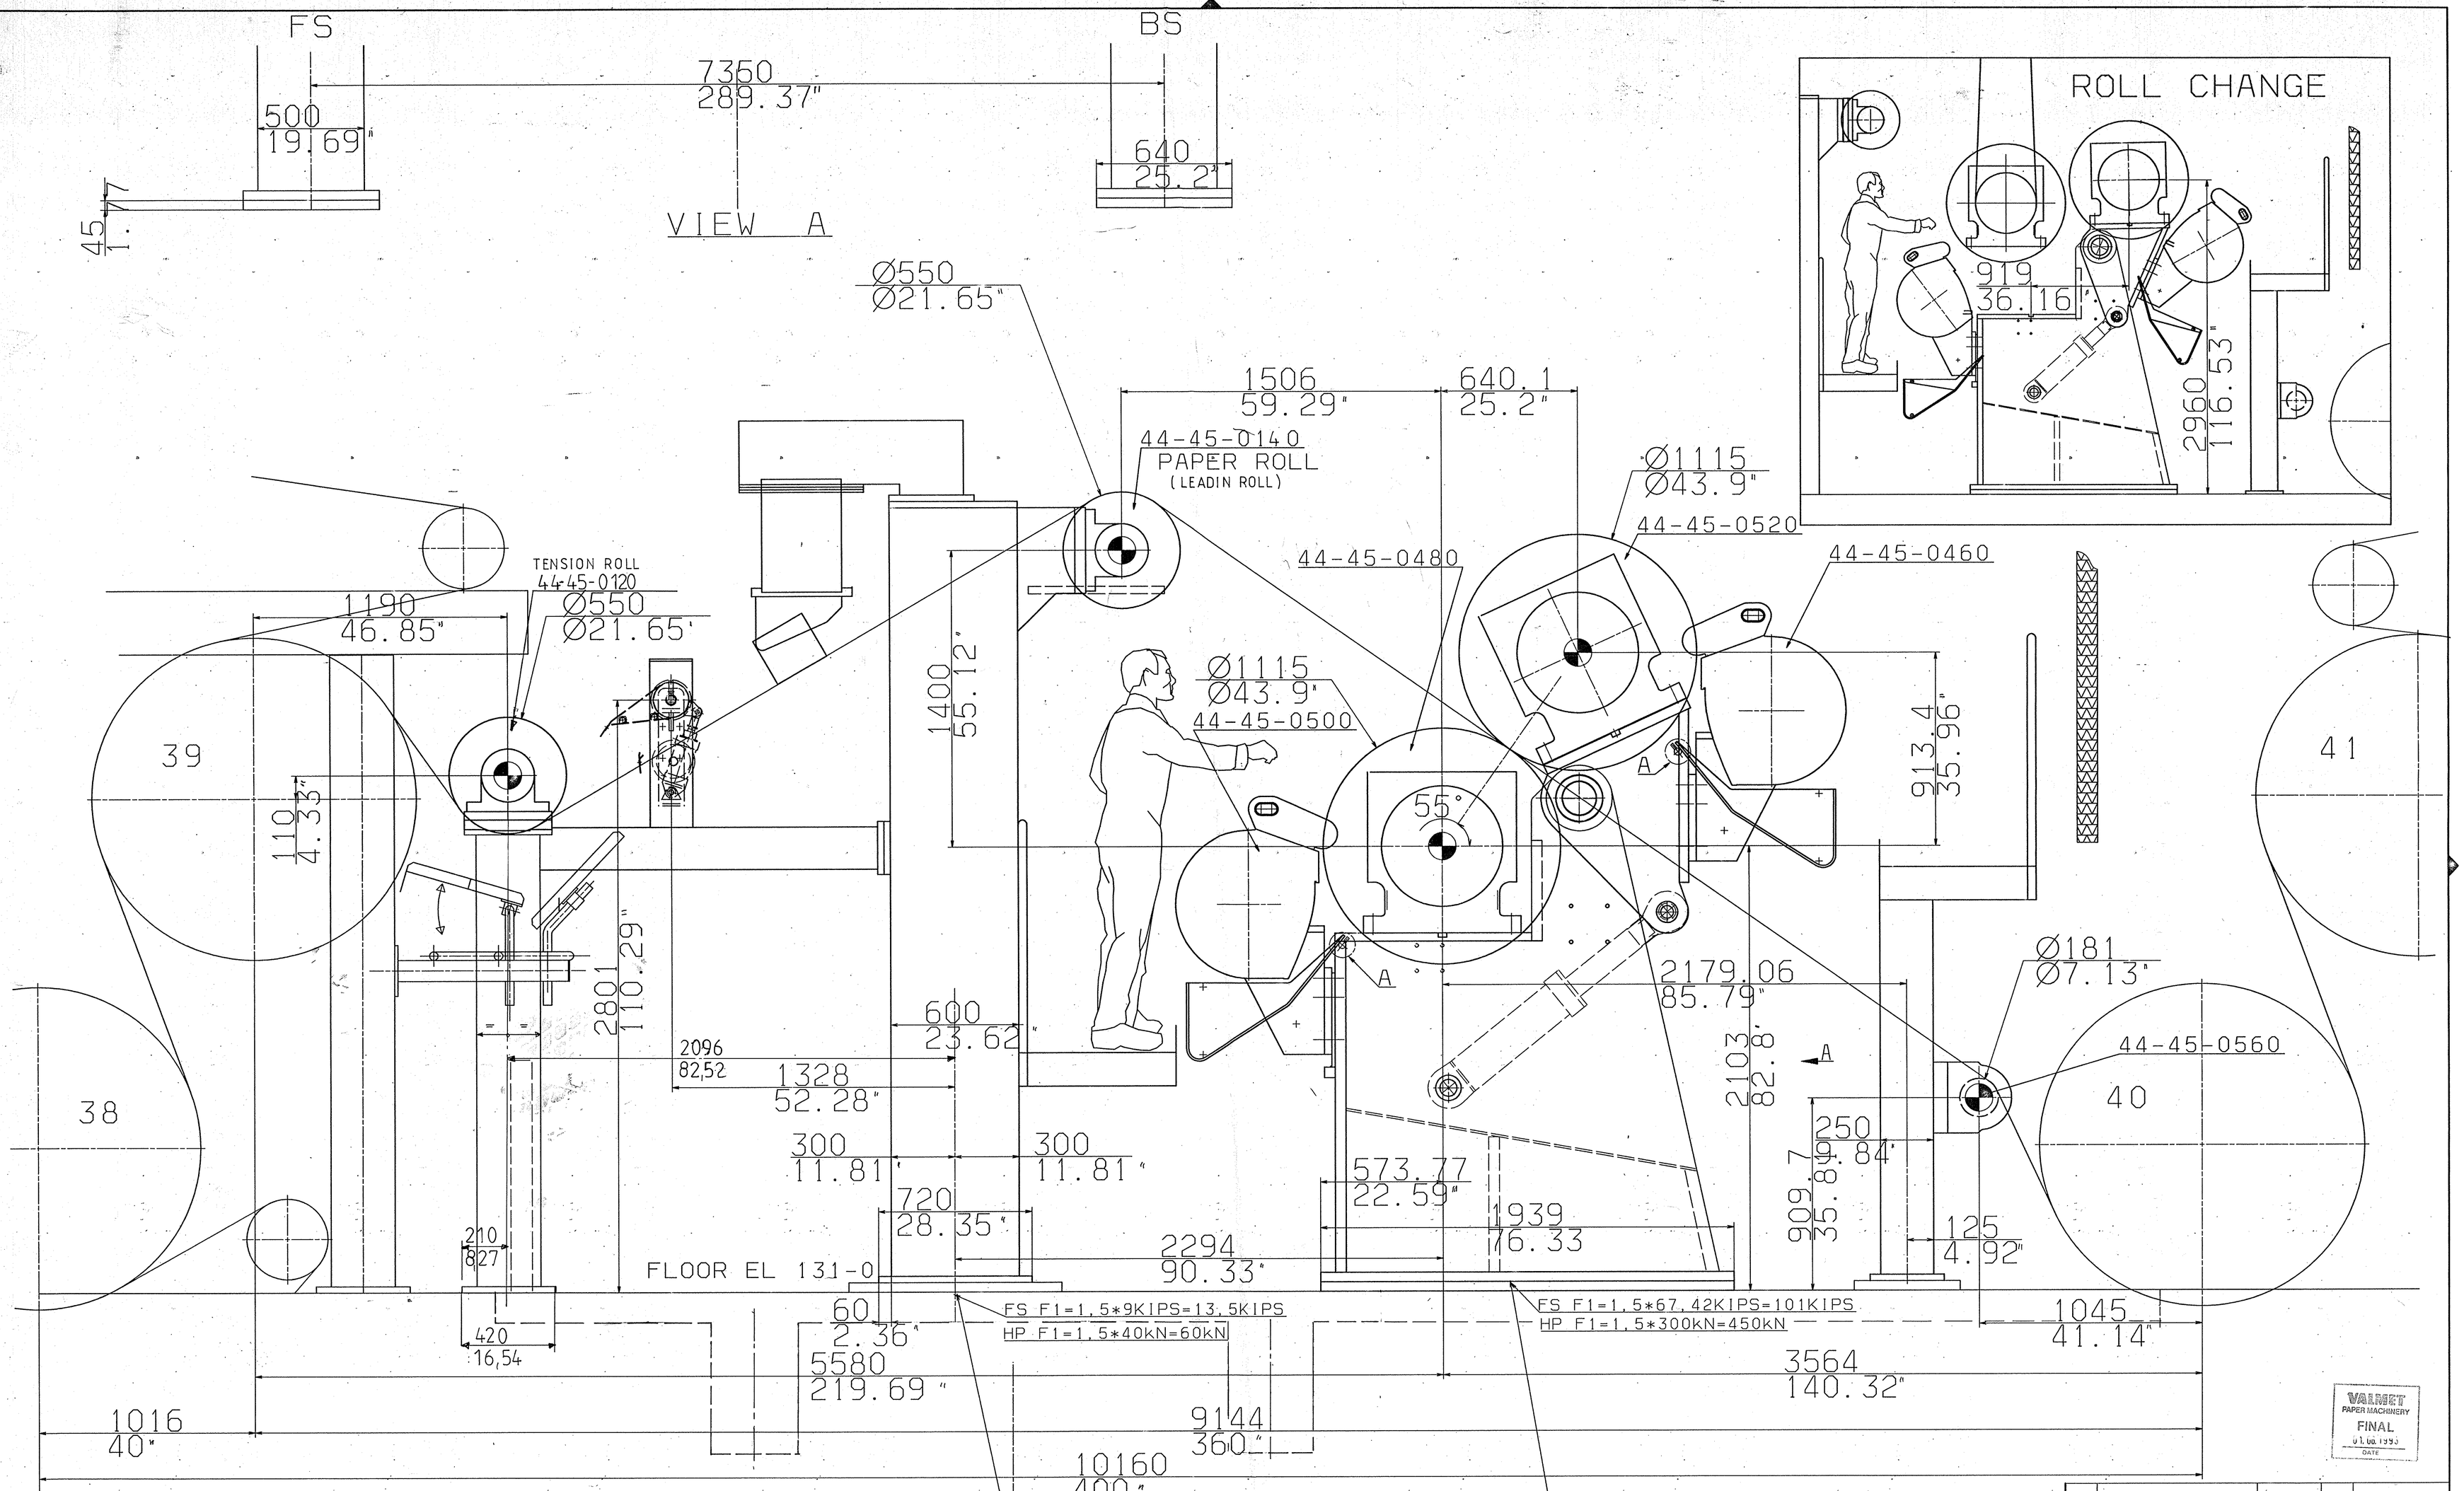

CRS SIRRINE ENGINEERS, INC.
- REJECTED, NOT RELEASED FOR FABRICATION, SEE COMMENTS ON DRAWING
- REVIEWED, COMMENTS NOTED, RELEASED FOR FABRICATION, REVISED AND RESUBMIT CERTIFIED
- REVIEWED, NO COMMENTS, RELEASED FOR FABRICATION, RESUBMIT CERTIFIED
- REVIEWED, RELEASED FOR FABRICATION, CERTIFIED, RESUBMITAL NOT REQUIRED

Review is only for conformance with the design concept of the goods and compliance with the information given in the Procurement Documents.

DATE 7-6-93 BY JLS

WEYERHAEUSER - PLYMOUTH, NC
MC-4 P.M. UPGRADE / SIRRINE JOB NO. R-2989

JUN 10 '93 97 56000

DATE RECEIVED P.O.#

Equipment No. 44-45-0100

PVM	KUVAUS DESCRIPTION	AINES DIMENSIONS	RAWA-AINE MATERIAL	PIIRUSTUSNRO DRAWING	RIV. REV'D	HYVÄKSYJÄSTÄ NOTES
31.05.93	TO		LAY-OUT MODIFIED		I	
19.04.93	TO		LAY-OUT MODIFIED		H	
14.01.93	T.O		LAY-OUT MODIFIED		G	
21.12.92	T.O		LAY-OUT MODIFIED		F	
01.12.92	T.O		LAY-OUT MODIFIED		E	
28.10.92	TO		LAY-OUT MODIFIED		D	
20.10.92	TO		DIMENSIONS ADDED		C	
28.9.92	PL		LOADS ADDED; PAPERROLL AND SCANNER CHANGED		B	
3.9.92	PL		LAY-OUT MODIFIED		A	
PÄIVÄYS DATE	KUITTAJA NAME	TARK. CHKD BY	KUVAUS REVISION	LUV CHANGES	HYVÄKS APPR BY	

ÄLÄ KÄYTÄ ALUSTA ILMAN VALMISTAJAN LUPAA.
THE INFORMATION CONTAINED HEREIN IS PROPRIETARY TO VALMET PAPER MACHINERY INC. AND IS NOT TO BE REPRODUCED, COMMUNICATED TO A THIRD PERSON, OR USED IN ANY MANNER WHATSOEVER WITHOUT THE EXPRESS WRITTEN PERMISSION OF VALMET PAPER MACHINERY INC. OR A DULY AUTHORIZED REPRESENTATIVE THEREOF

VALMET Paper Machinery
Rautpohja

PIIRUSTUSNRO DRAWING NO		PIIRUSTUS DRAWING NO	SIVU PAGE 1/1
PIIRT DRAWN BY	A. Rousu	PVM DATE	92-08-21
DIMENSIONS	ISO		
SCALE	1:10		
TARK. CHKD BY	H. Salo		93-01-13
HYV. APPD BY	— " —		
PALLI REFERENCE	SSA #6		
HYVÄKS. APPROVED			

NIMIKE TITLE SYM-SIZER LAY-OUT

RYHMÄ GROUP SIZING EQUIPMENT

TUOTE PRODUCT

RAU0500009 1

VALMET PAPER MACHINERY
FINAL
01.06.1993
DATE

WEYERHAEUSER
PLYMOUTH PM4