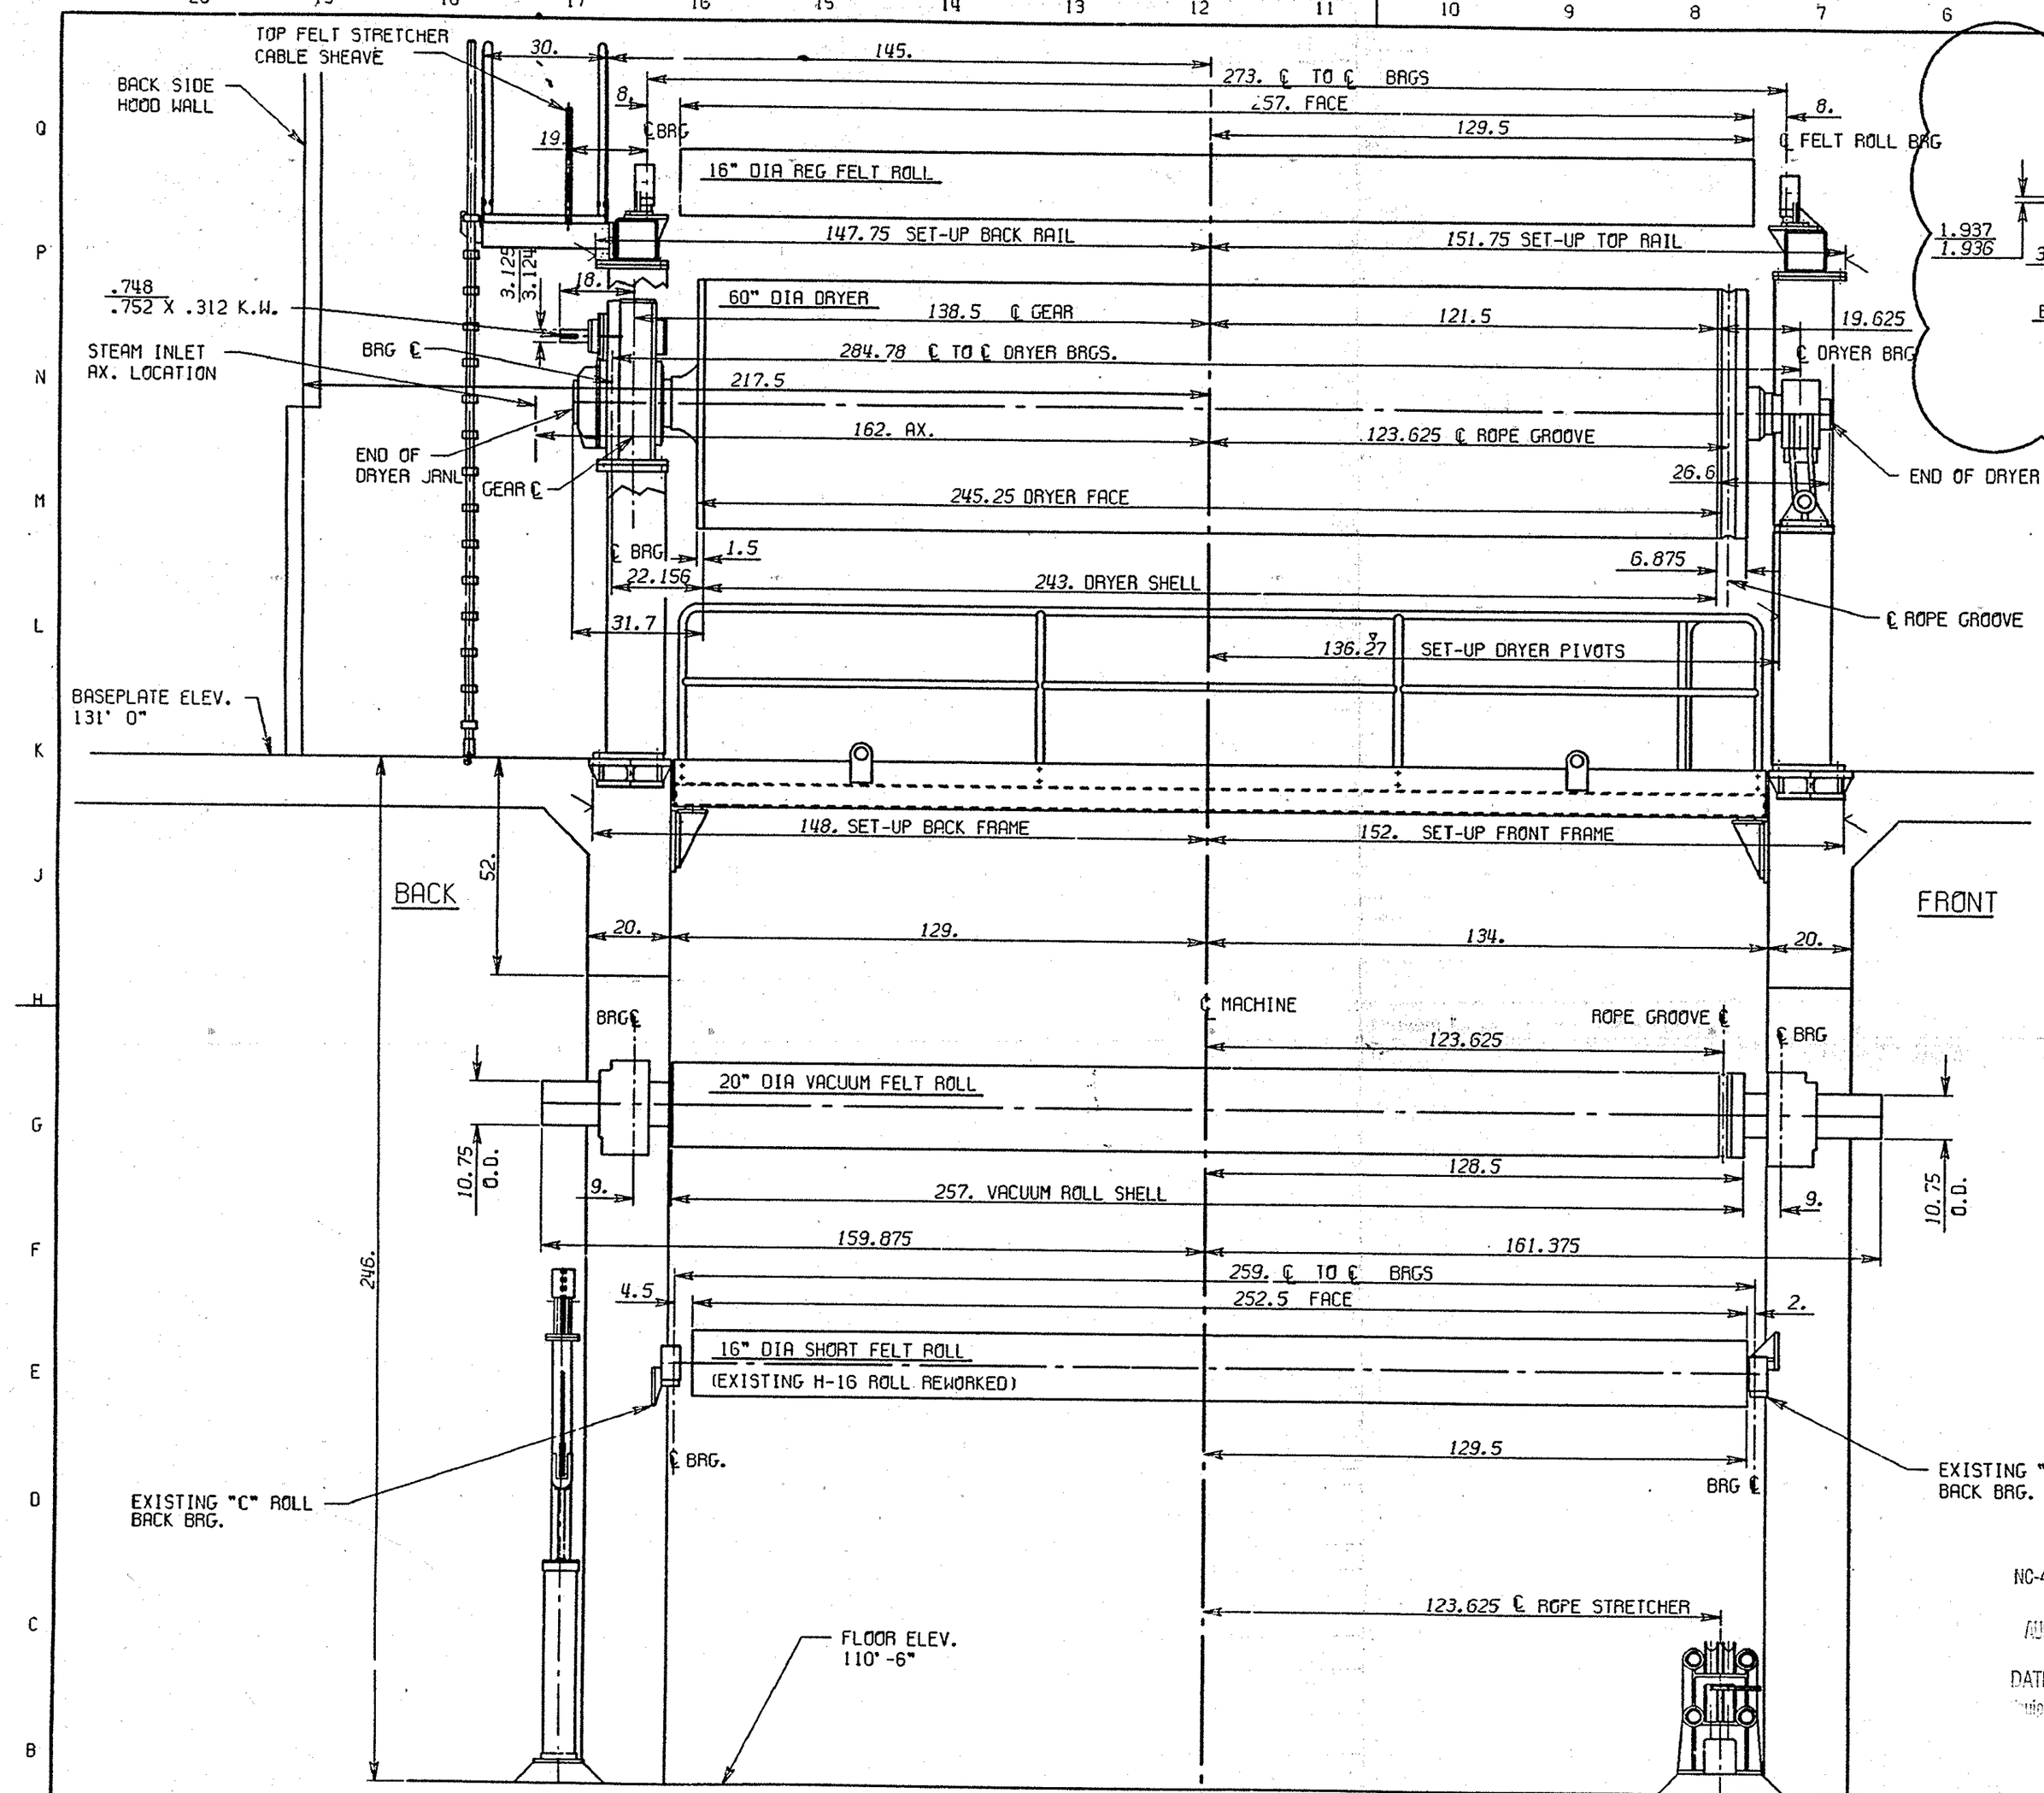

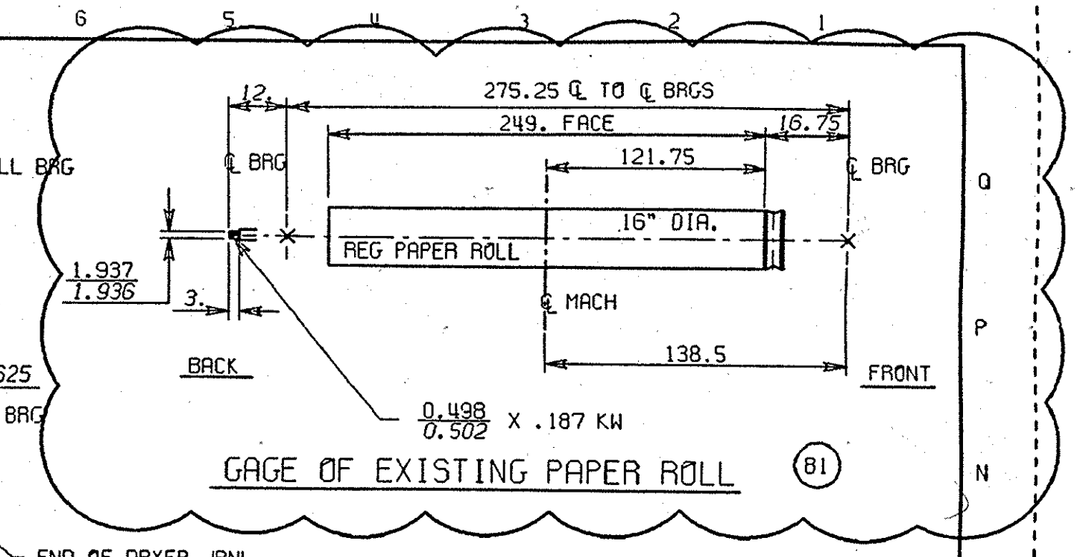

CRS SIRRINE ENGINEERS, INC.

☐ SUBMITTED, NOT RELEASED FOR FABRICATION, SEE COMMENTS ON DRAWING

☐ REVIEWED, COMMENTS NOTED, RELEASED FOR FABRICATION, REVISED AND RESUBMIT CERTIFIED

☐ REVIEWED, NO COMMENTS, RELEASED FOR FABRICATION, RESUBMIT CERTIFIED

☒ REVIEWED, RELEASED FOR FABRICATION, CERTIFIED, RESUBMITTAL NOT REQUIRED

Review is only for conformance with the design concept of the goods and compliance with the information given in the Procurement Documents.

Date 9-22-91 BY JLS

NOTES:
THIS DRAWING IS ONE OF A SERIES OF SHEETS -0 THRU -4

ITEMS SHOWN THUS ⬭ PER L/C

ASSY HARDWARE PER: MA-A499-4-10-5

ITEMS SHOWN THUS ◯ PER: MA-A499-4-10-0-0

FOOTWALKS AND CROSSWALKS PER 4-2254-0001, 4-2284-0005

FELT ROLL DIA'S: 14", 16"
VACUUM FELT ROLL DIA: 20"
DRYERS ARE 60" DIA

GRADE: ENVELOPE
40#-80#/3300 SQ FT

MACHINE SPEED: 2750 DESIGN
3000 BALANCE

LIST OF COMPONENTS PER: LC-A499-4-10-0
LC-A499-39-0-0, LC-A499-44-0-0

WEYERHAEUSER - PLYMOUTH, NC
NC-4 P.M. UPGRADE / SIRRINE JOB NO. R-2989

AUG 25 '93 97 56005

DATE RECEIVED P.O.#

Equipment No. 44-40-1400 (A1)

542-42

CERTIFIED 03-AUG-93

© 1993. BELOIT CORPORATION. THE INFORMATION ON THIS PRINT IS SUBMITTED IN CONFIDENCE AND MAY NOT BE COPIED.

REVISION		
B1	03-AUG-93	
A1	23-APR-93	

U OF M: IN	CLASS. OF CHAR.: CRITICAL	ORDER NO.: B5959	CUSTOMER NAME: WEYERHAEUSER PA.			BELOIT CORPORATION
DRPA DATE: 17-MAR-93	C-0	FILE NO.	MILL: PLYMOUTH, N.C.		MACH. NO.: 4	BELOIT PAPER MACHINE DIVISION BELOIT, WISCONSIN U.S.A. 53511
BUC	MAJOR	DEPT. NO.: 632	DRAWN: TBB	CHK'D.: TBB	APP'D.1: GSF	APP'D.2: ER	SCALE: 1:15	REFERENCE DRAWING: LC-A499-4-10-0
BNC: 04-9922	M-0	DATE: 11-DEC-92	TITLE: DRYER GAGE, BEL-CHAMP			IDENTIFICATION NUMBER: MA-A499-4-10-0

BEL-CADD® [INFO AI PLOT TIME: NOT: 3 AUG 93: SULD=BPMD: E-2-7-162: 18C=MA-A499-4-10-0]

BASE 88

542 BPMD 42 BPMD DRPA LIST