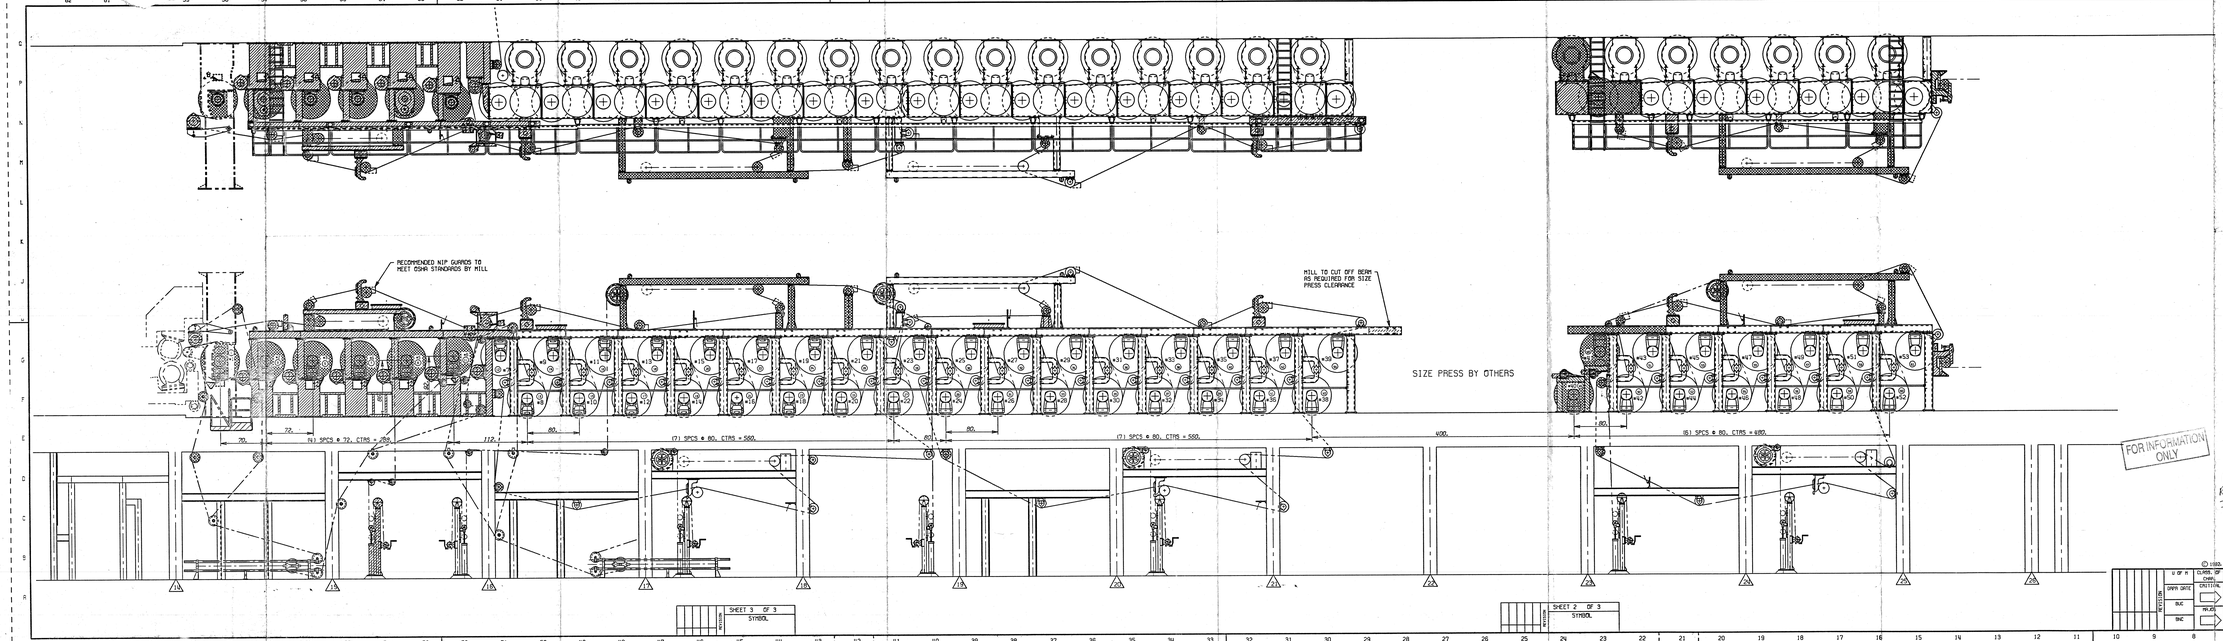

ALL BACKSIDE FOOTWALKS NEW BY BELOIT

EXISTING EQUIPEMENT AT MILL.

NEW EQUIPEMENT BY BELOIT.

RELOCATED EQUIPEMENT AT MILL.

REWORKED EQUIPEMENT BY MILL.

CRG OPTIMUM ENGINEERING, INC.
☐ REJECTED; NOT RELEASED FOR FABRICATION
☐ REVISE & RESUBMIT; NOT RELEASED FOR FABRICATION
☐ REVISED & RESUBMITTED; NOT RELEASED FOR FABRICATION
☐ RELEASED AS NOTED
☐ RELEASED AS NOTED; NOT RELEASED FOR FABRICATION
☐ RELEASED; NOT RELEASED
☐ RELEASED; NOT RELEASED
Responsibility for conformance with the design concept of the goods and compliance with the information given in the Procurement Documents.
1/13/93 BY FEJ

FOR INFORMATION ONLY

PRELIMINARY
REVIEWED FOR
INFORMATION ONLY

PRELIMINARY - NOT ISSUED

INSTITUTIONS - PLYMOUTH, NC
TO 232.92 OF 56004
PROJECT NUMBER F04
44-40-1400

SHEET 1 OF 3

© 1993, BELOIT CORPORATION. THE INFORMATION ON THIS PRINT IS SUBMITTED IN CONFIDENCE AND MAY NOT BE COPIED.

REVISION	U OF M	CLASS OF CHAR.	ORDER NO.	CUSTOMER NAME	BELOIT CORPORATION
	DRFR DATE	DRFTSM	B5959	WEYERHAEUSER PAPER CO.	BELOIT WORLD HEADQUARTERS, BELOIT, WISCONSIN, U.S.A. 53511
			FILE NO.	MILL	MACH. NO.
				PLYMOUTH,N.C.	M1
	BJC		SEPT.16 632	DRAWN BY C.T. TBB 777	DFT.D.I. DFT.D.2 SCALE 1:30
			DATE		REFERENCE DRAWING
	PR.DS.		24-NOV-90	DRYER ELEVATION	IDENTIFICATION NUMBER B5959-004-1
	BAC				SHEET NO. 1 OF 3

BEL-CROP

C:INFO AF PLOT"TIME:" KTR:"21 DEC 92: SULO=BPMO: AF-122-44-17: T6C=99" PRESENT